
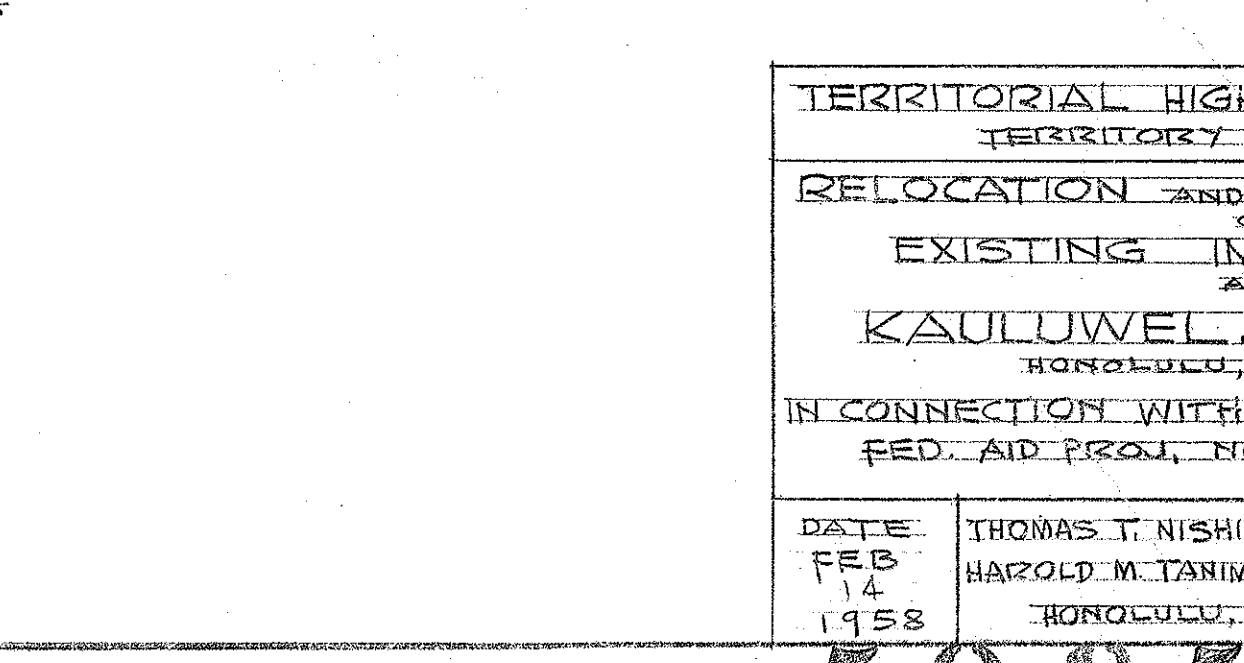
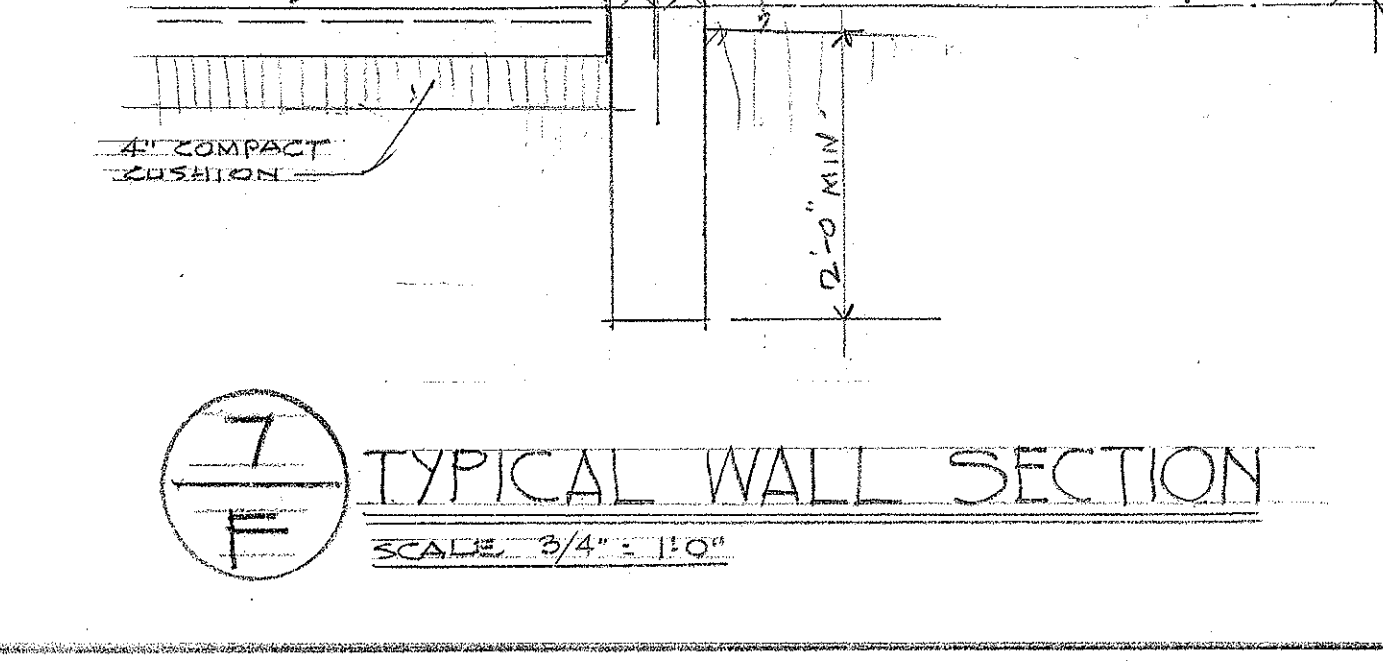
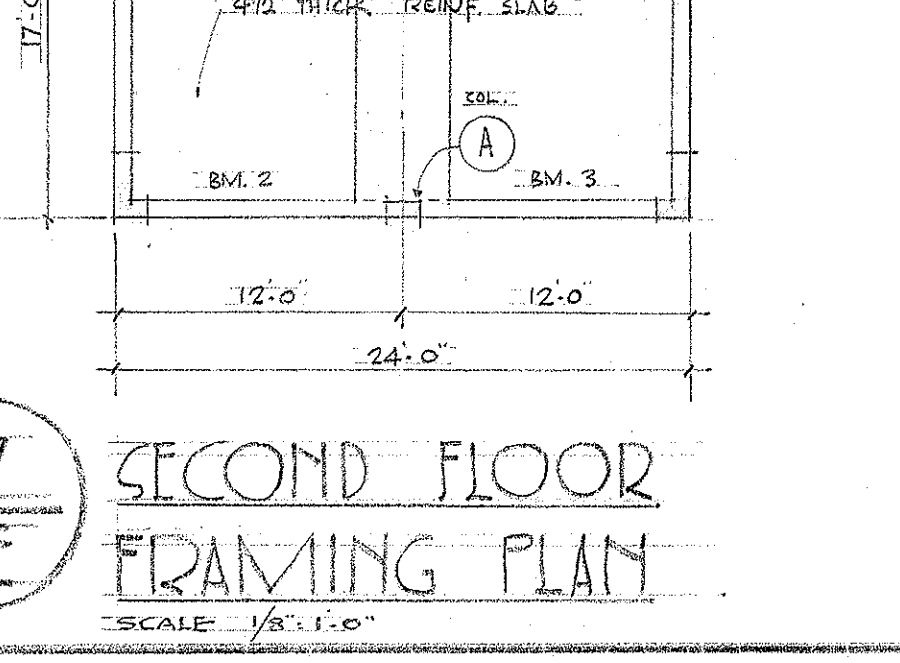
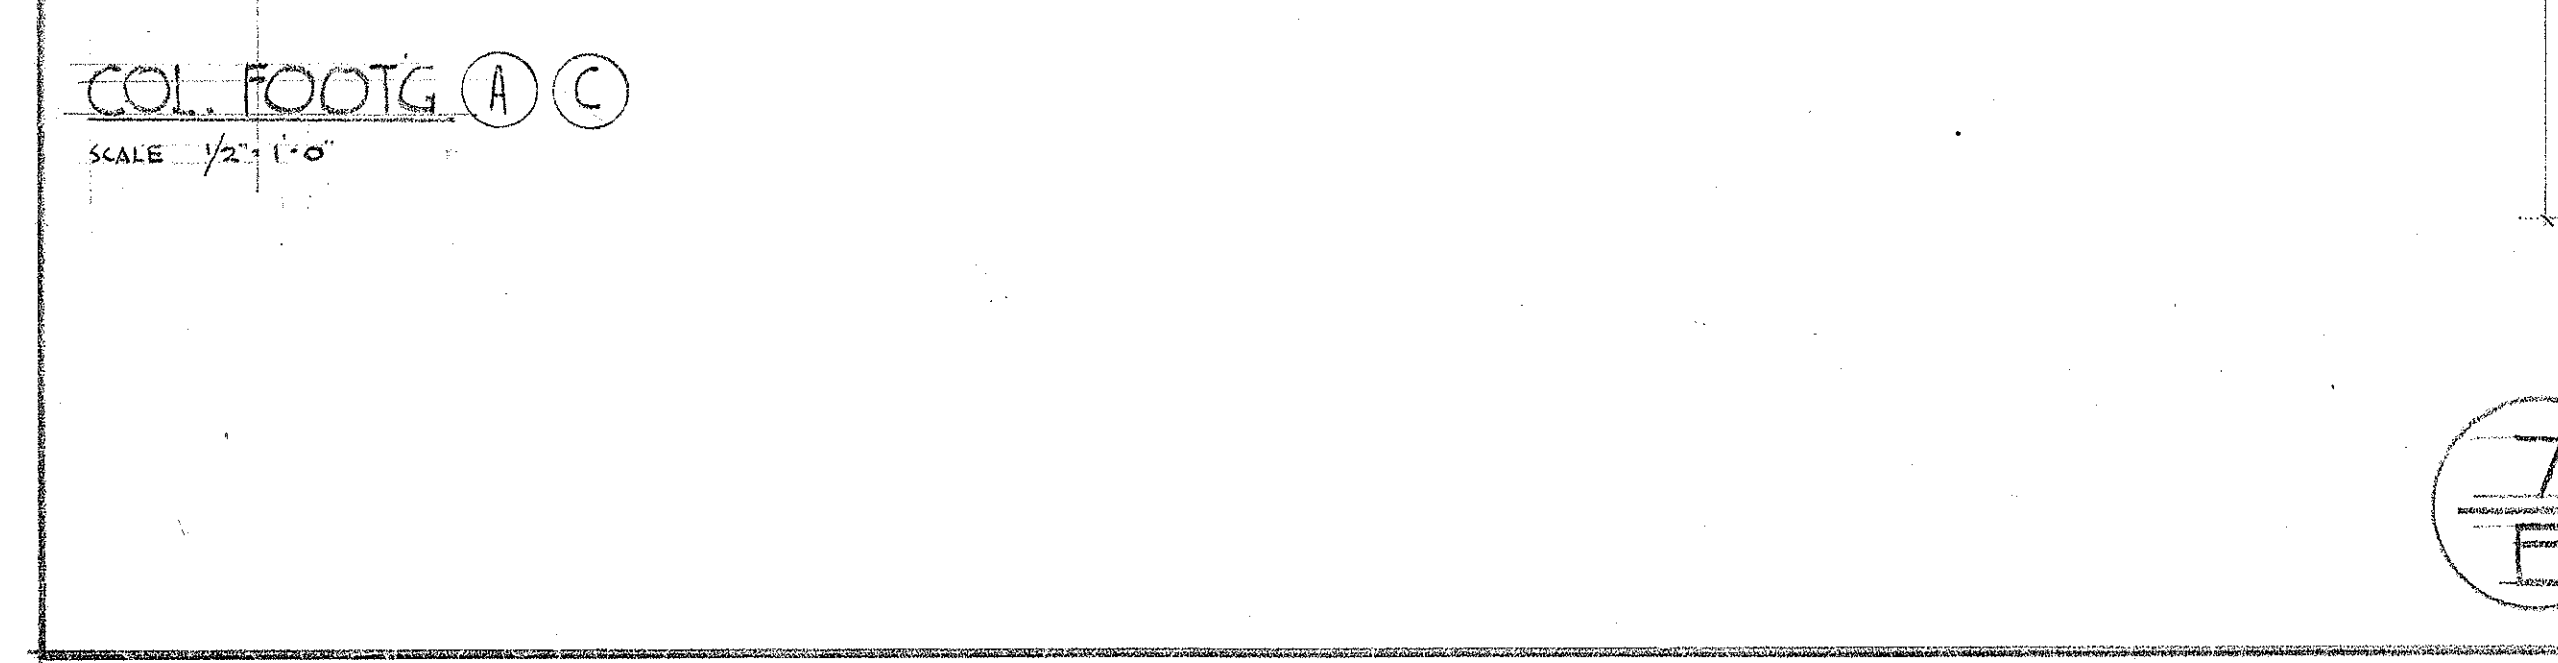
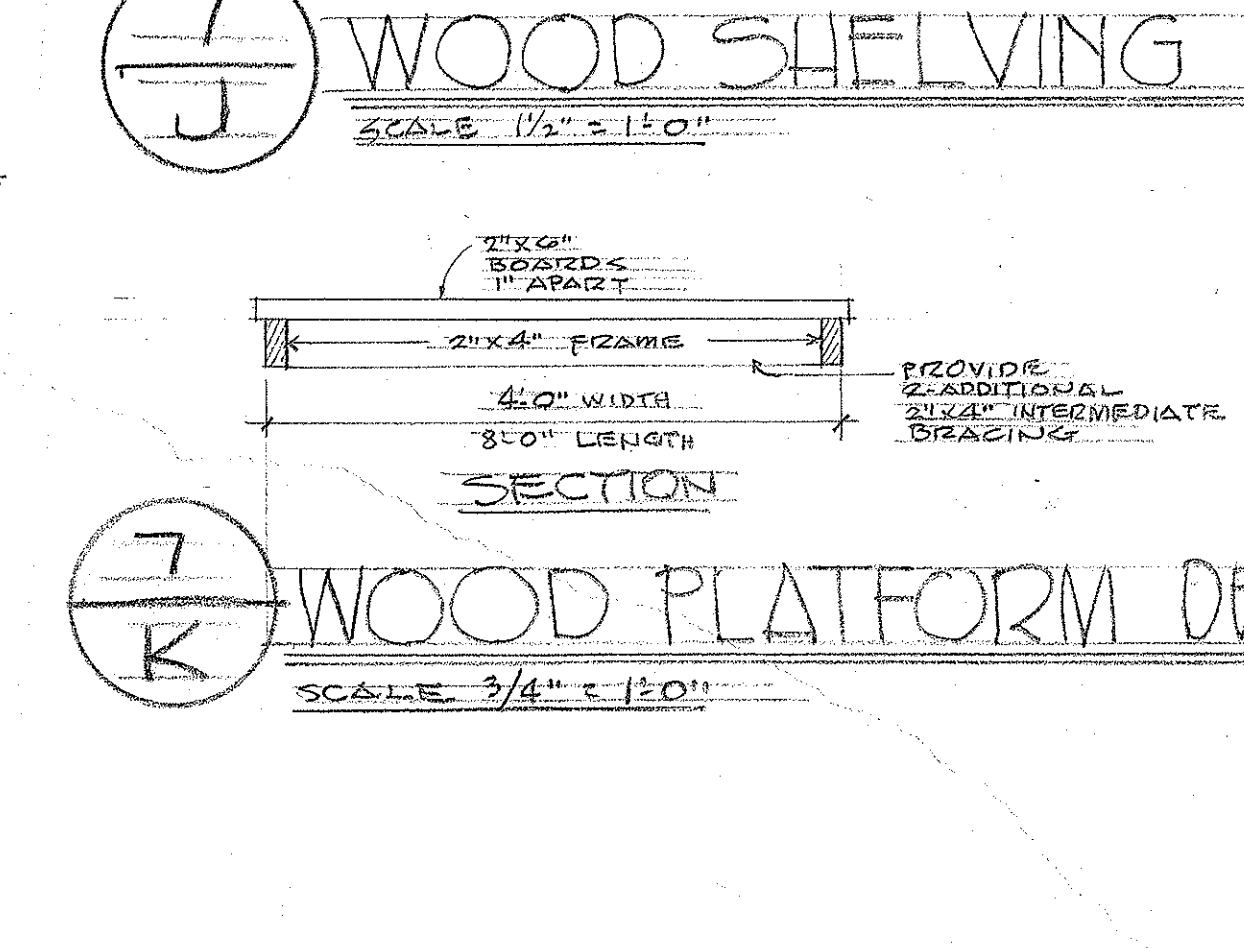
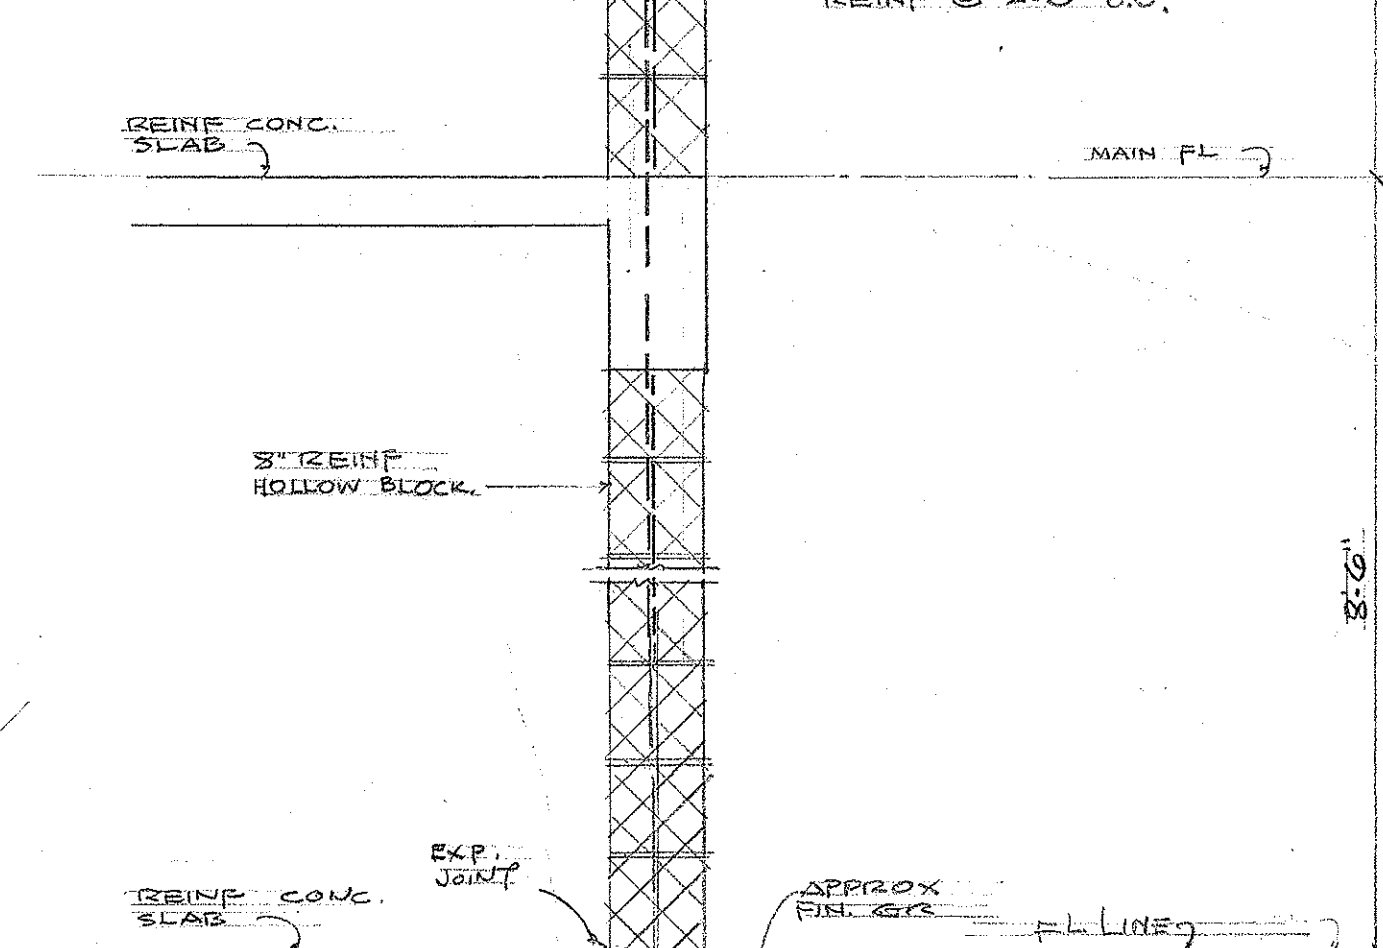
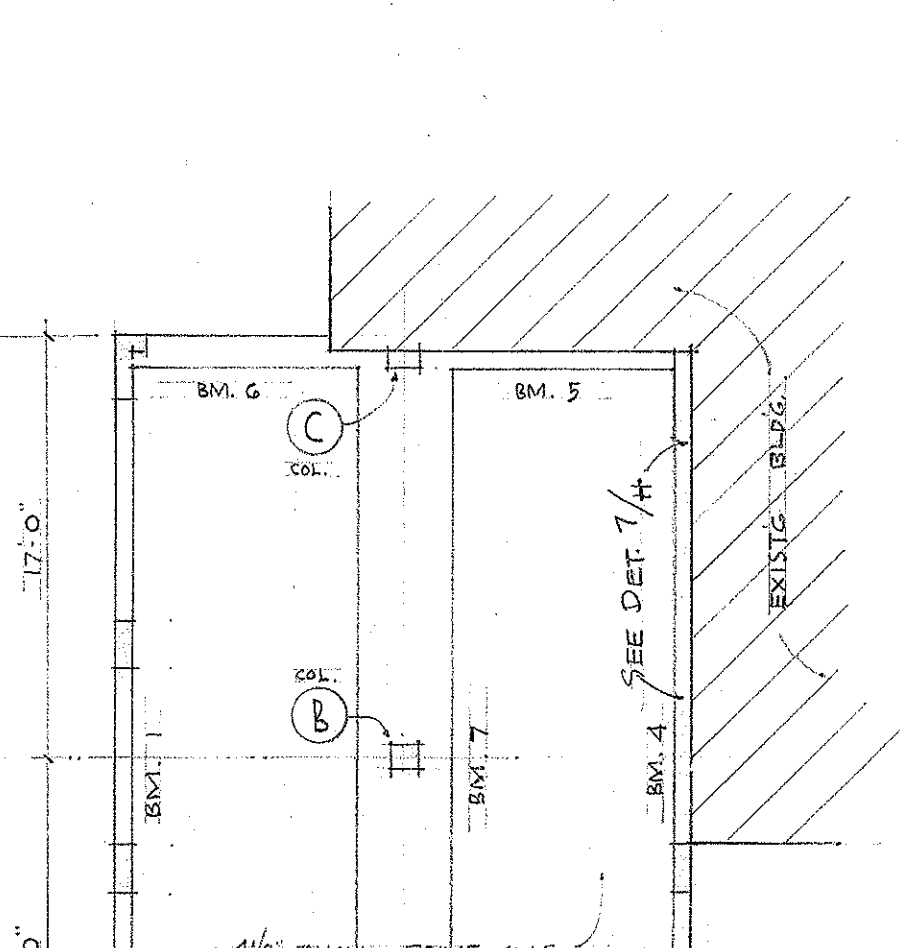
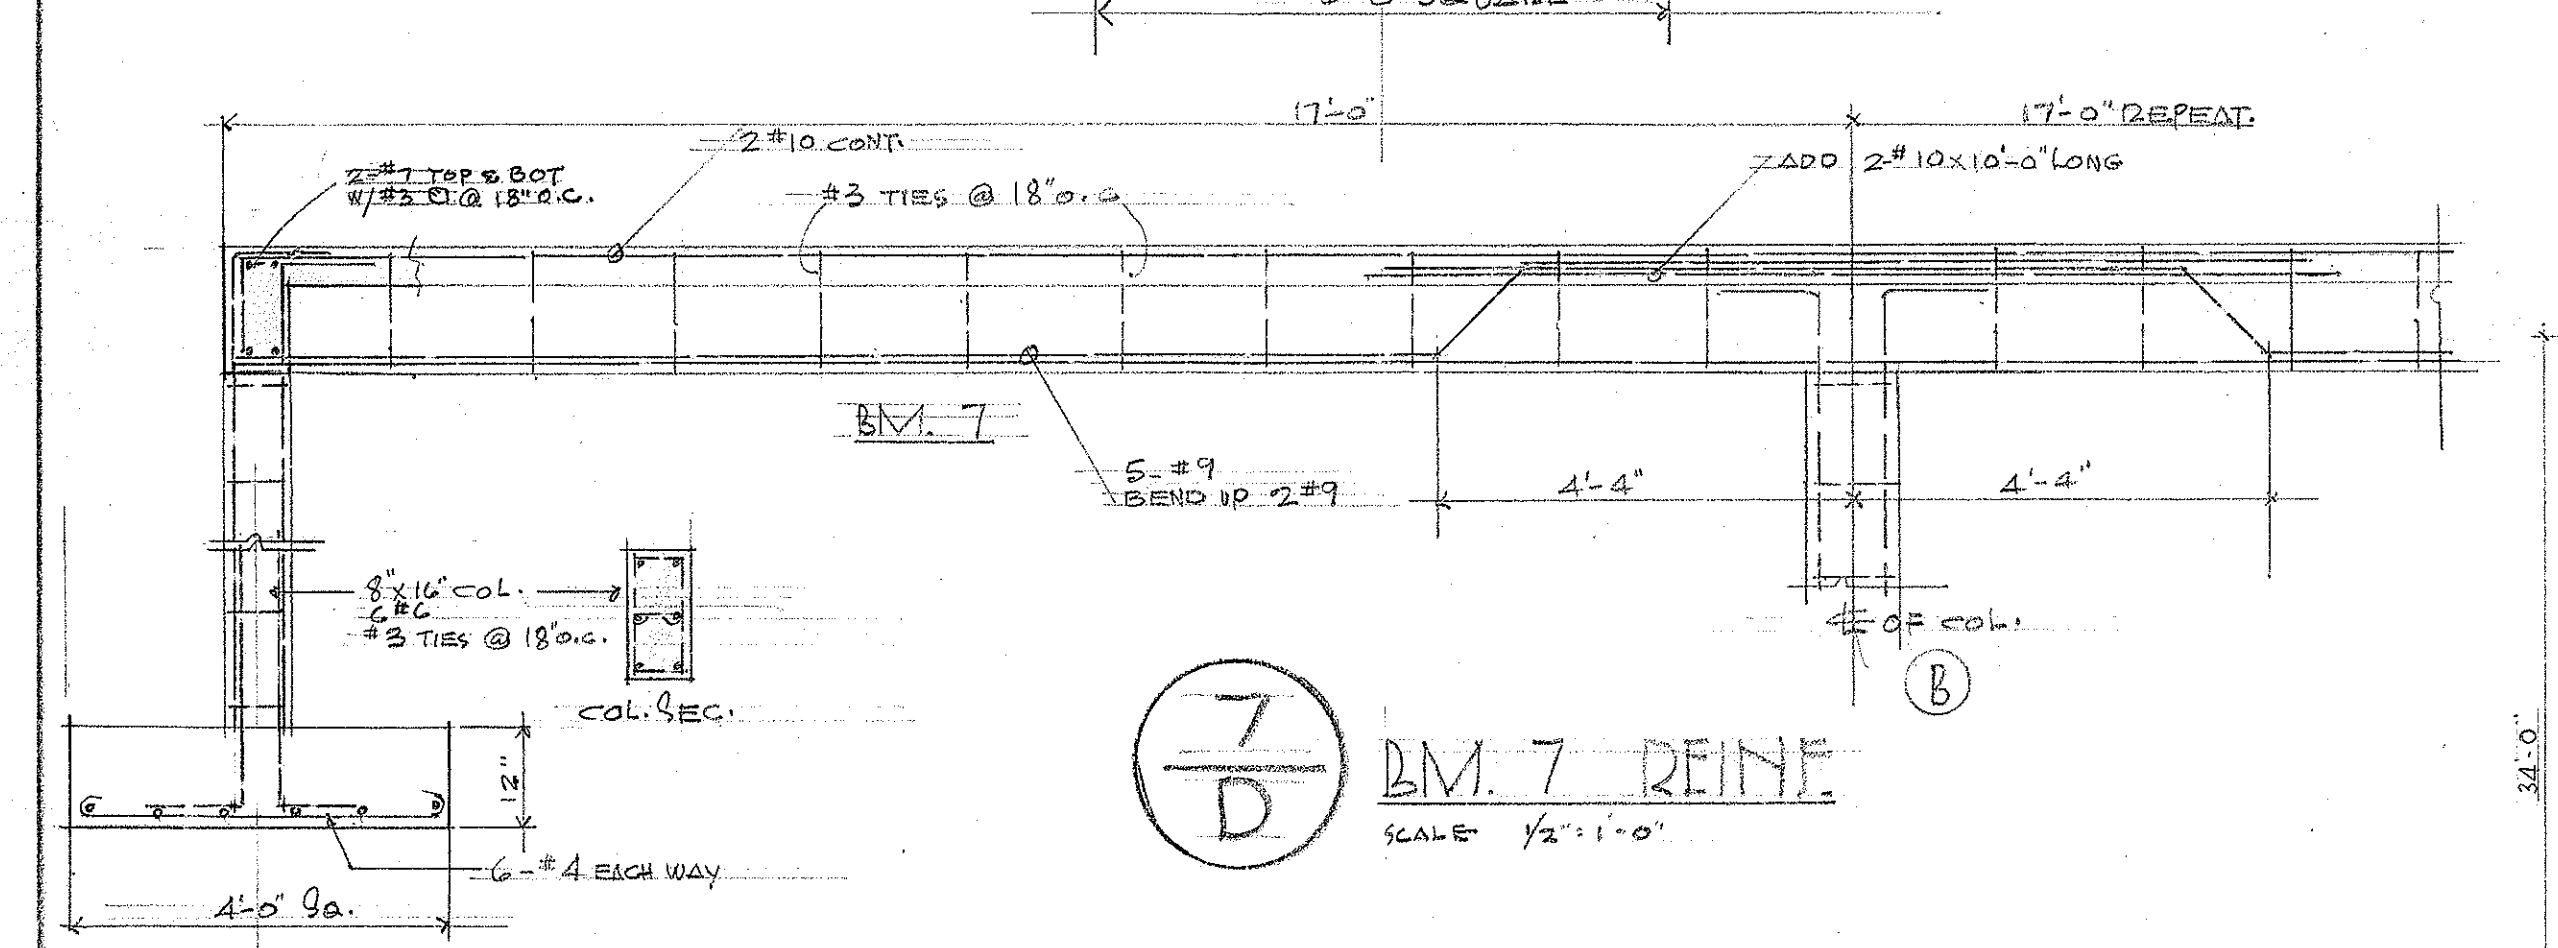
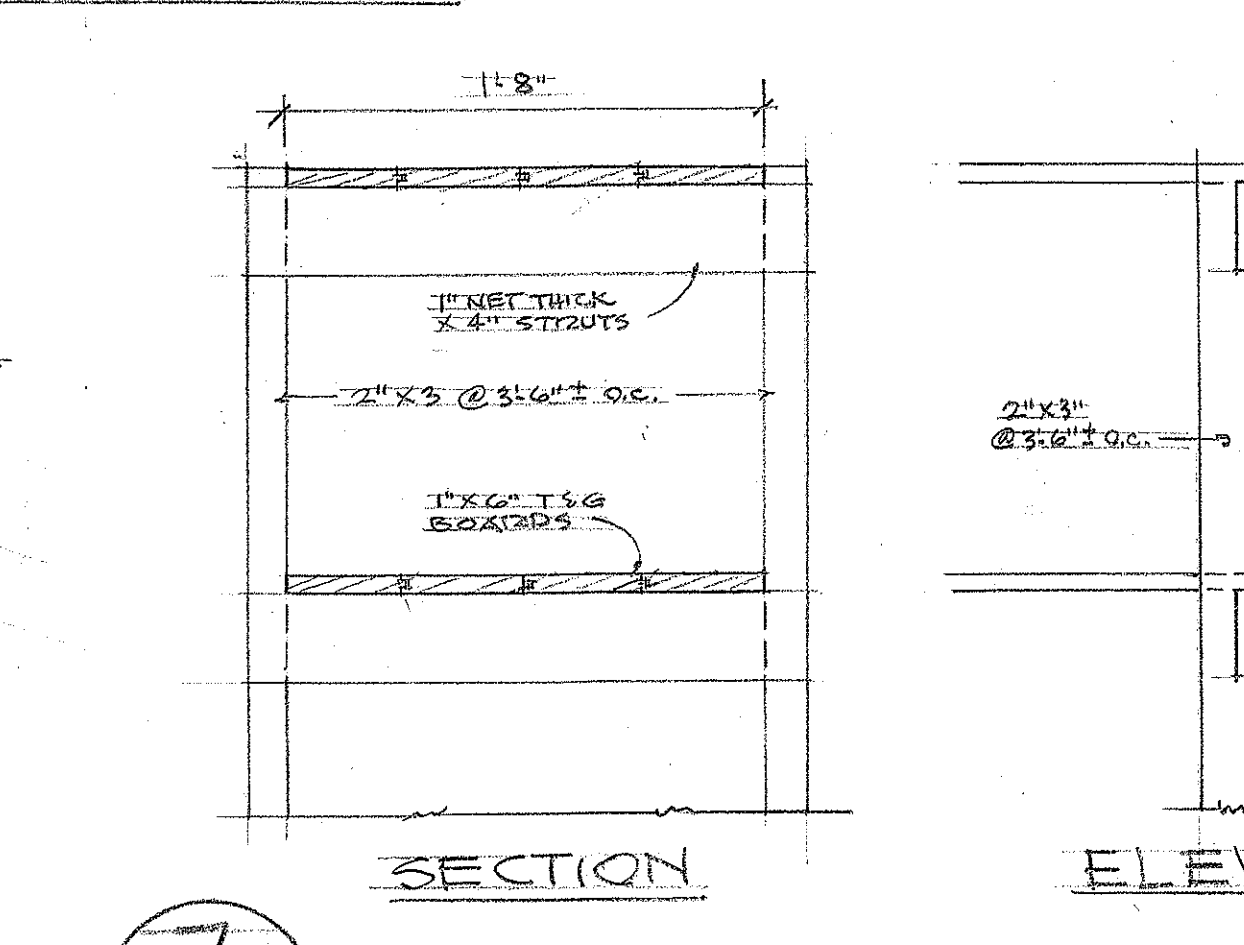
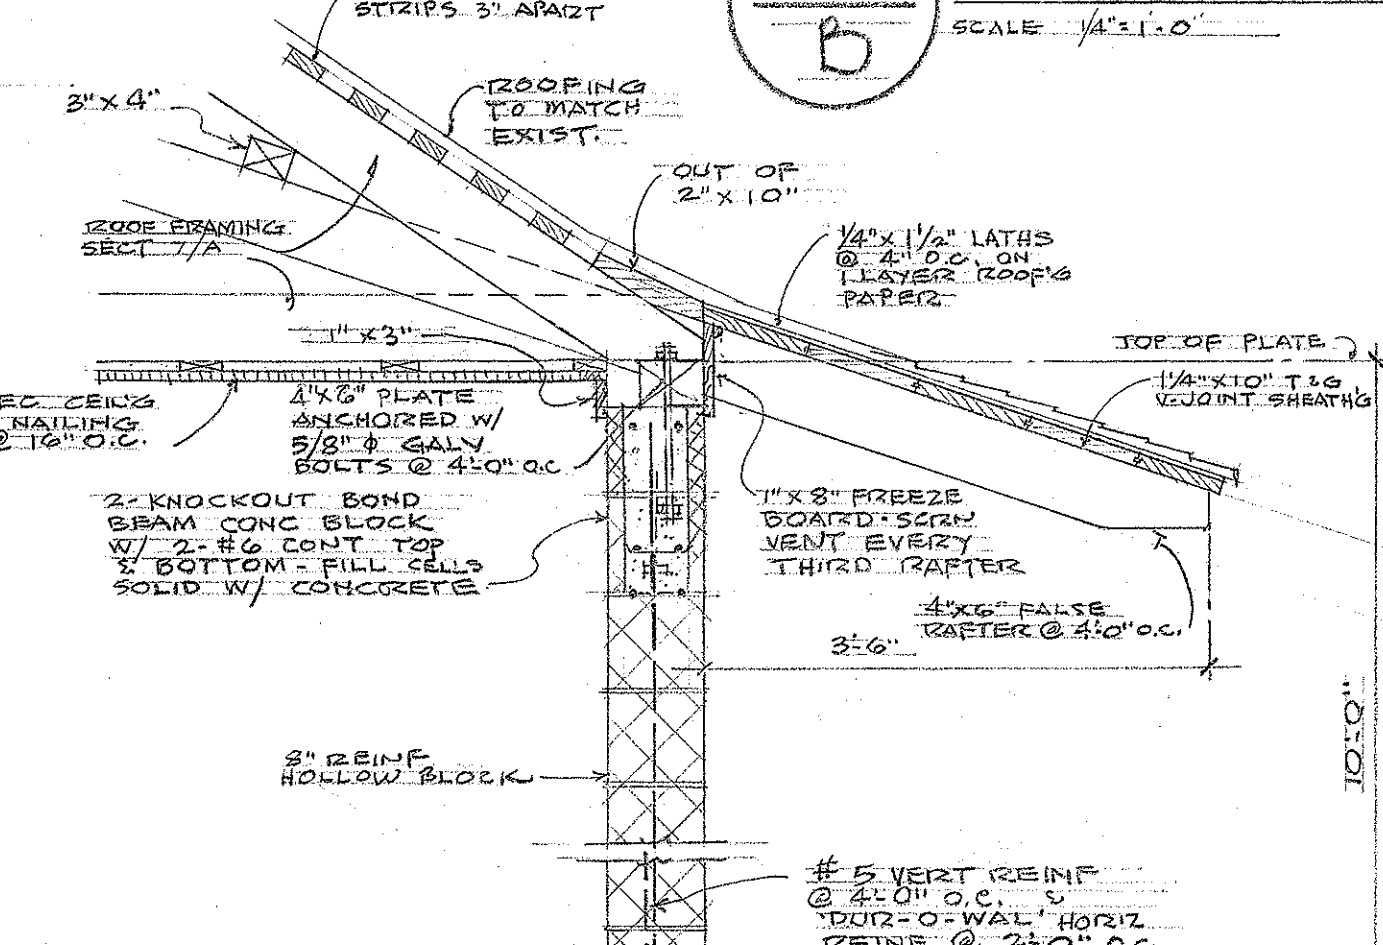
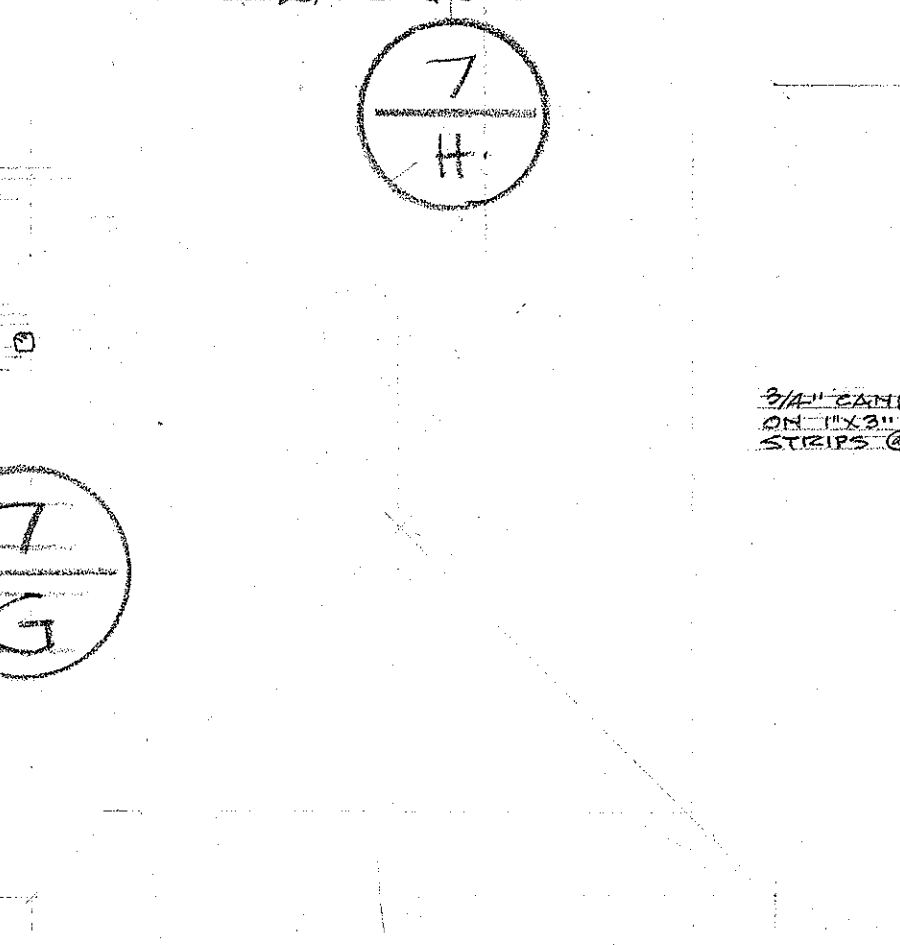
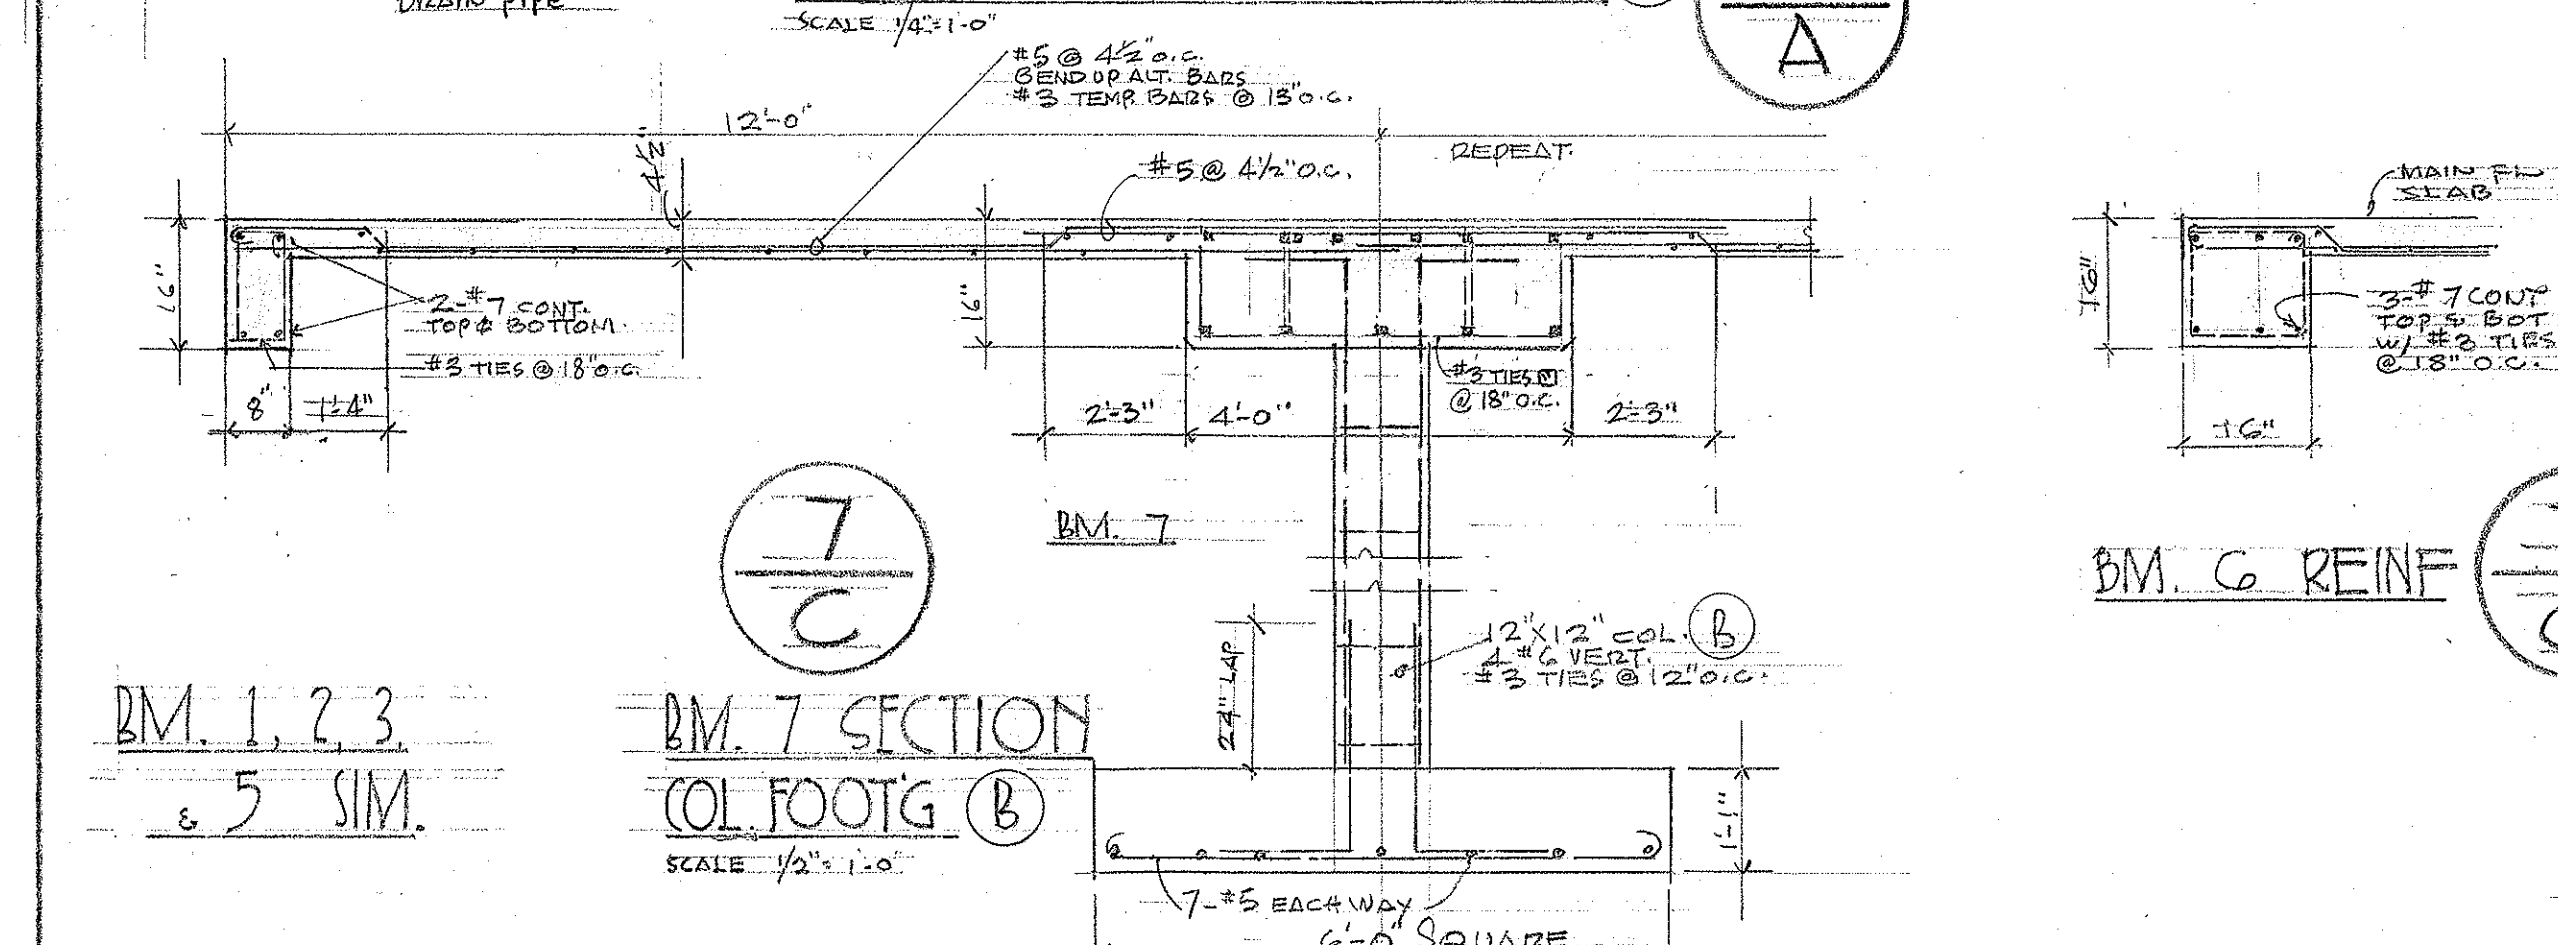
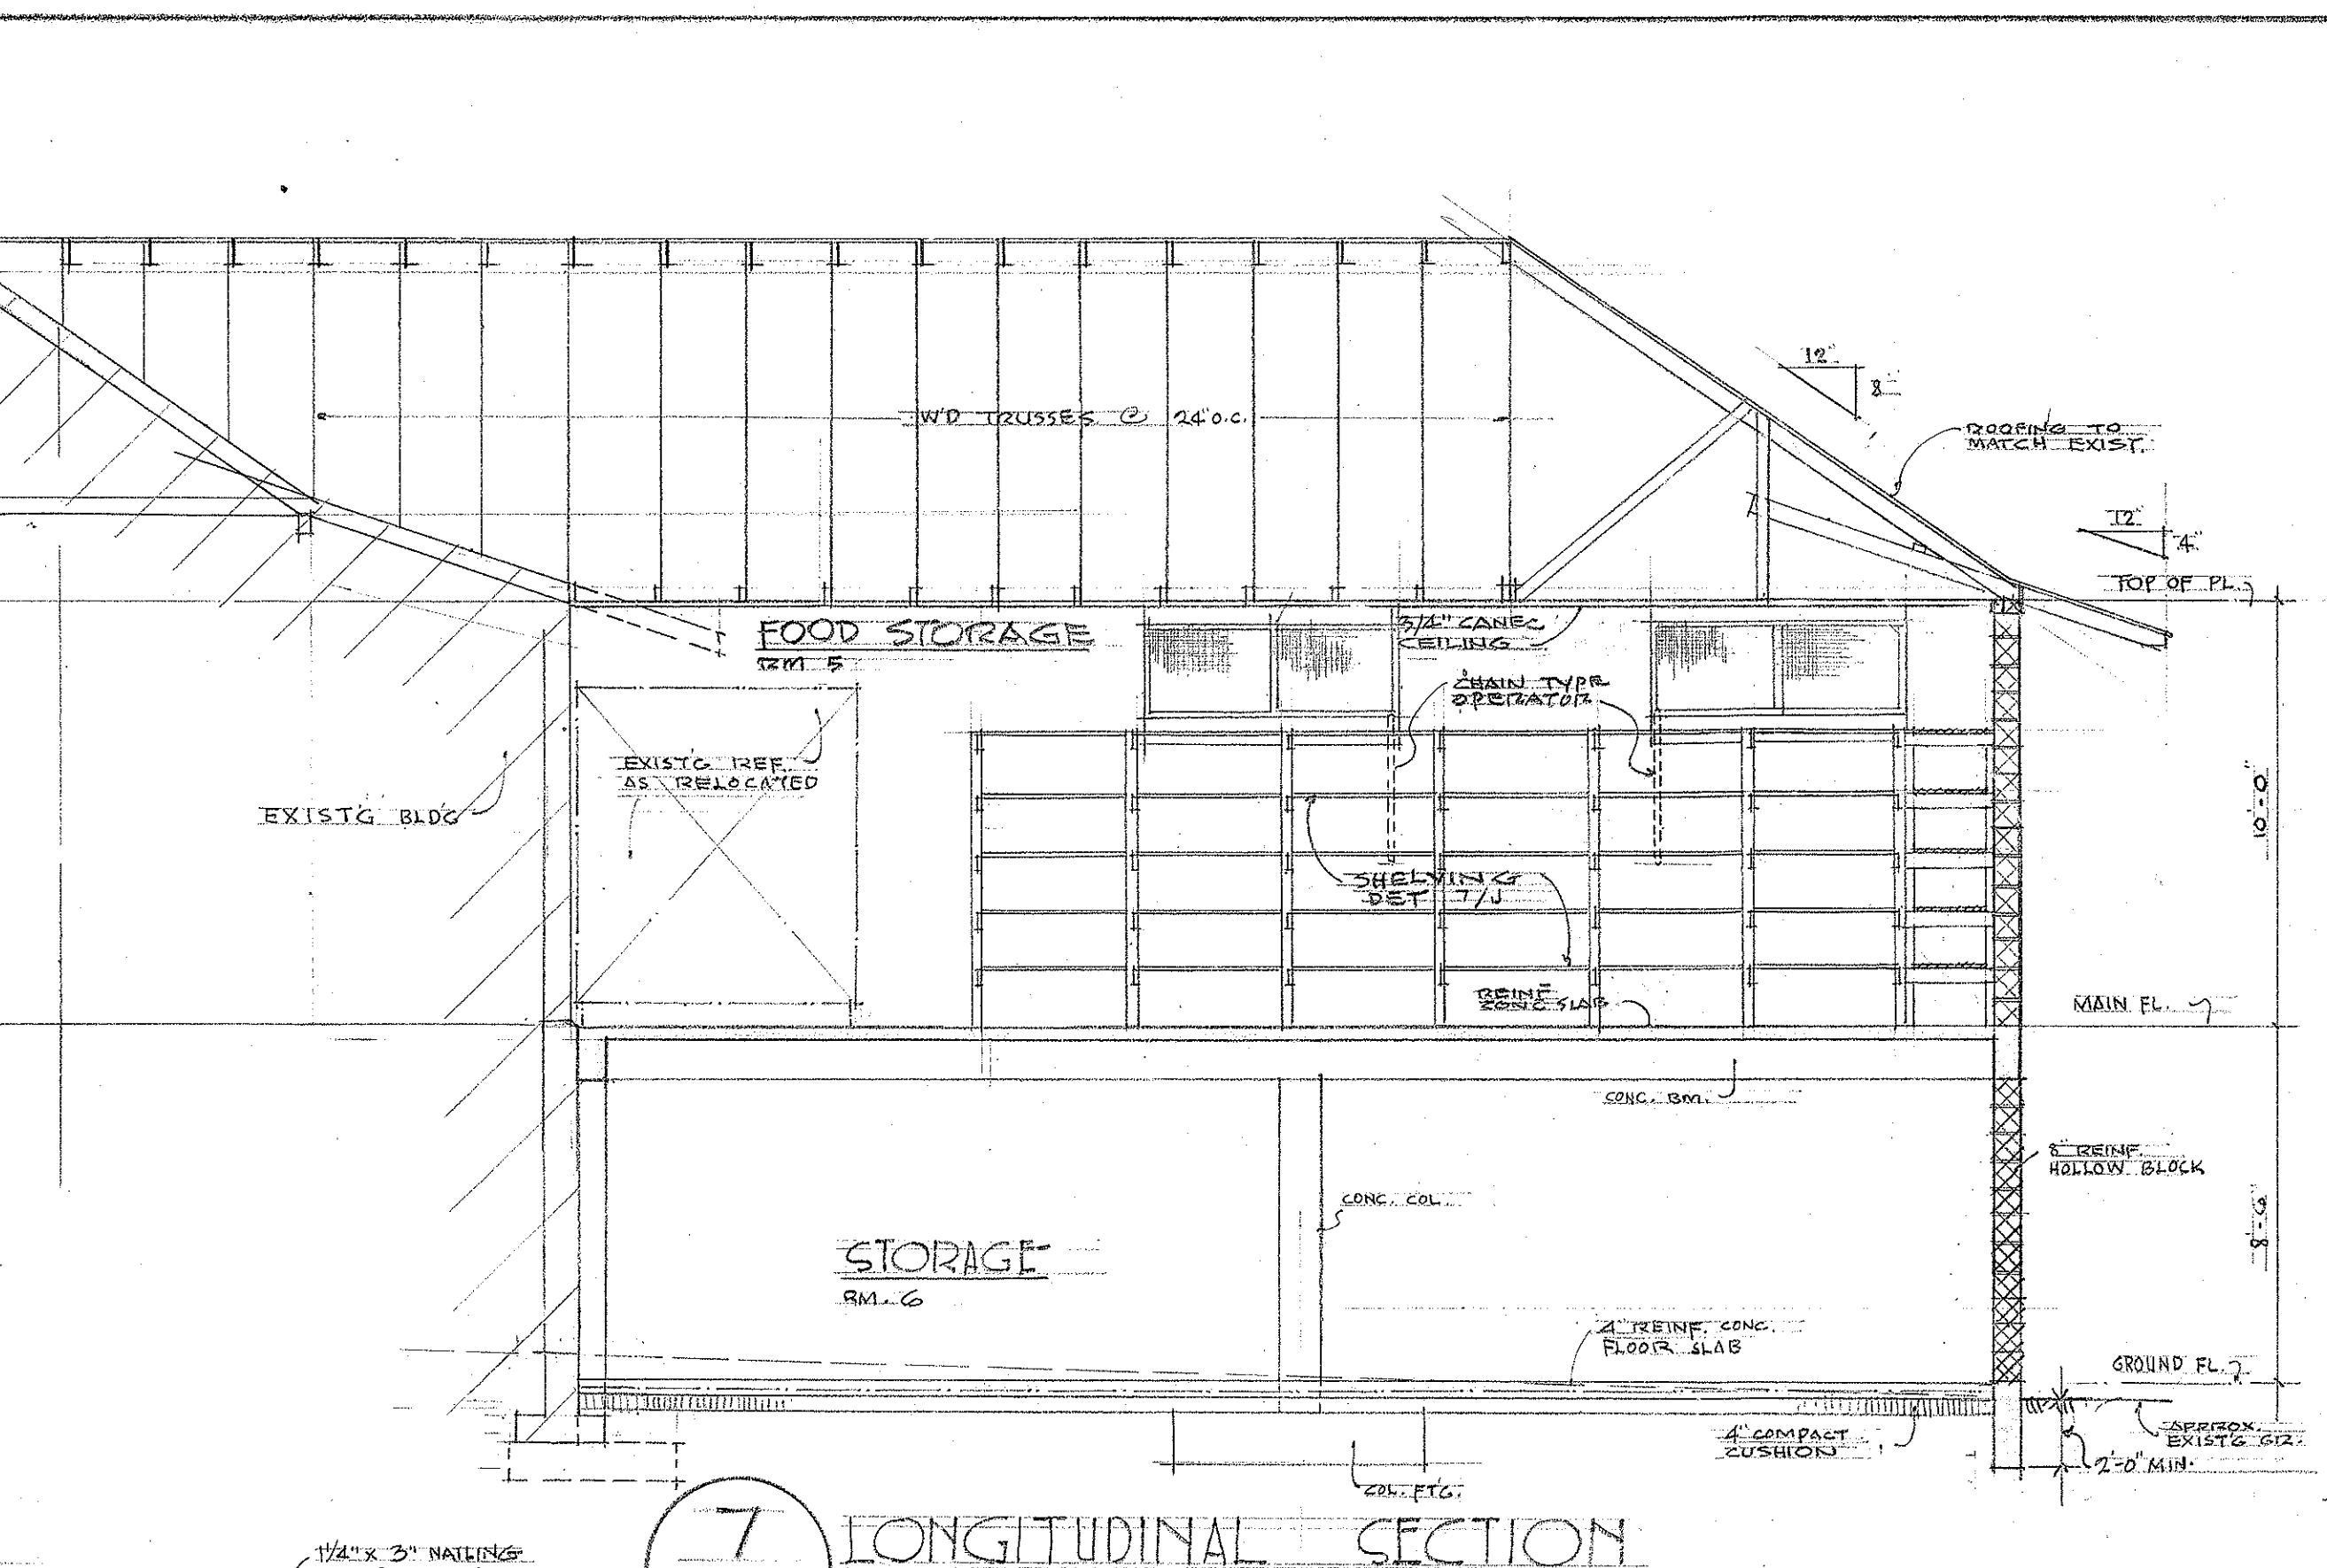
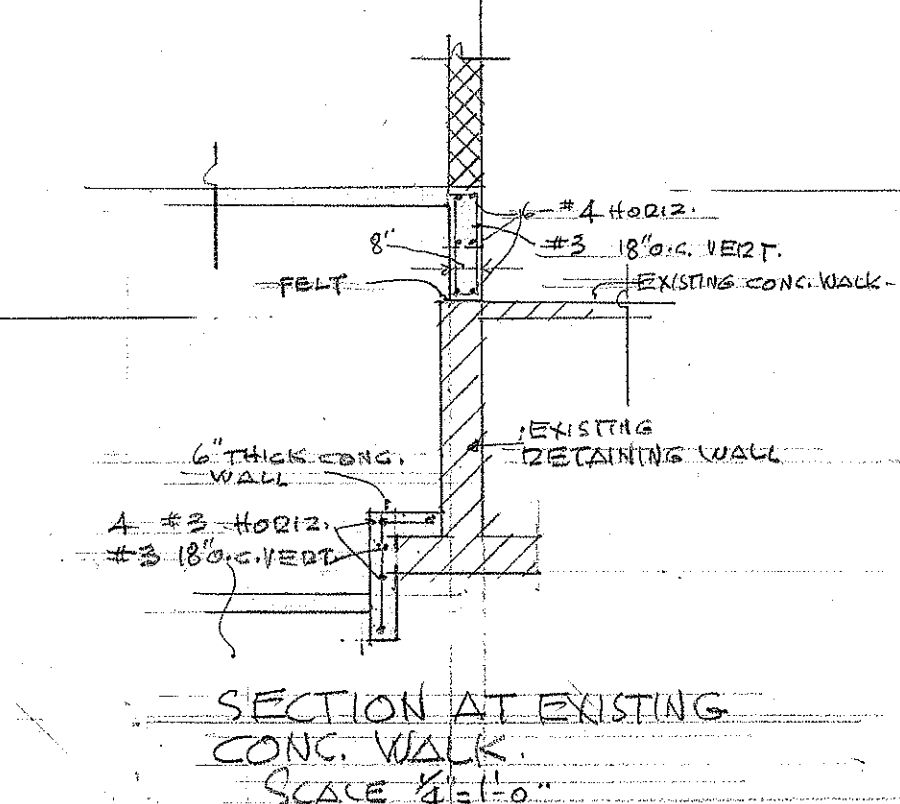


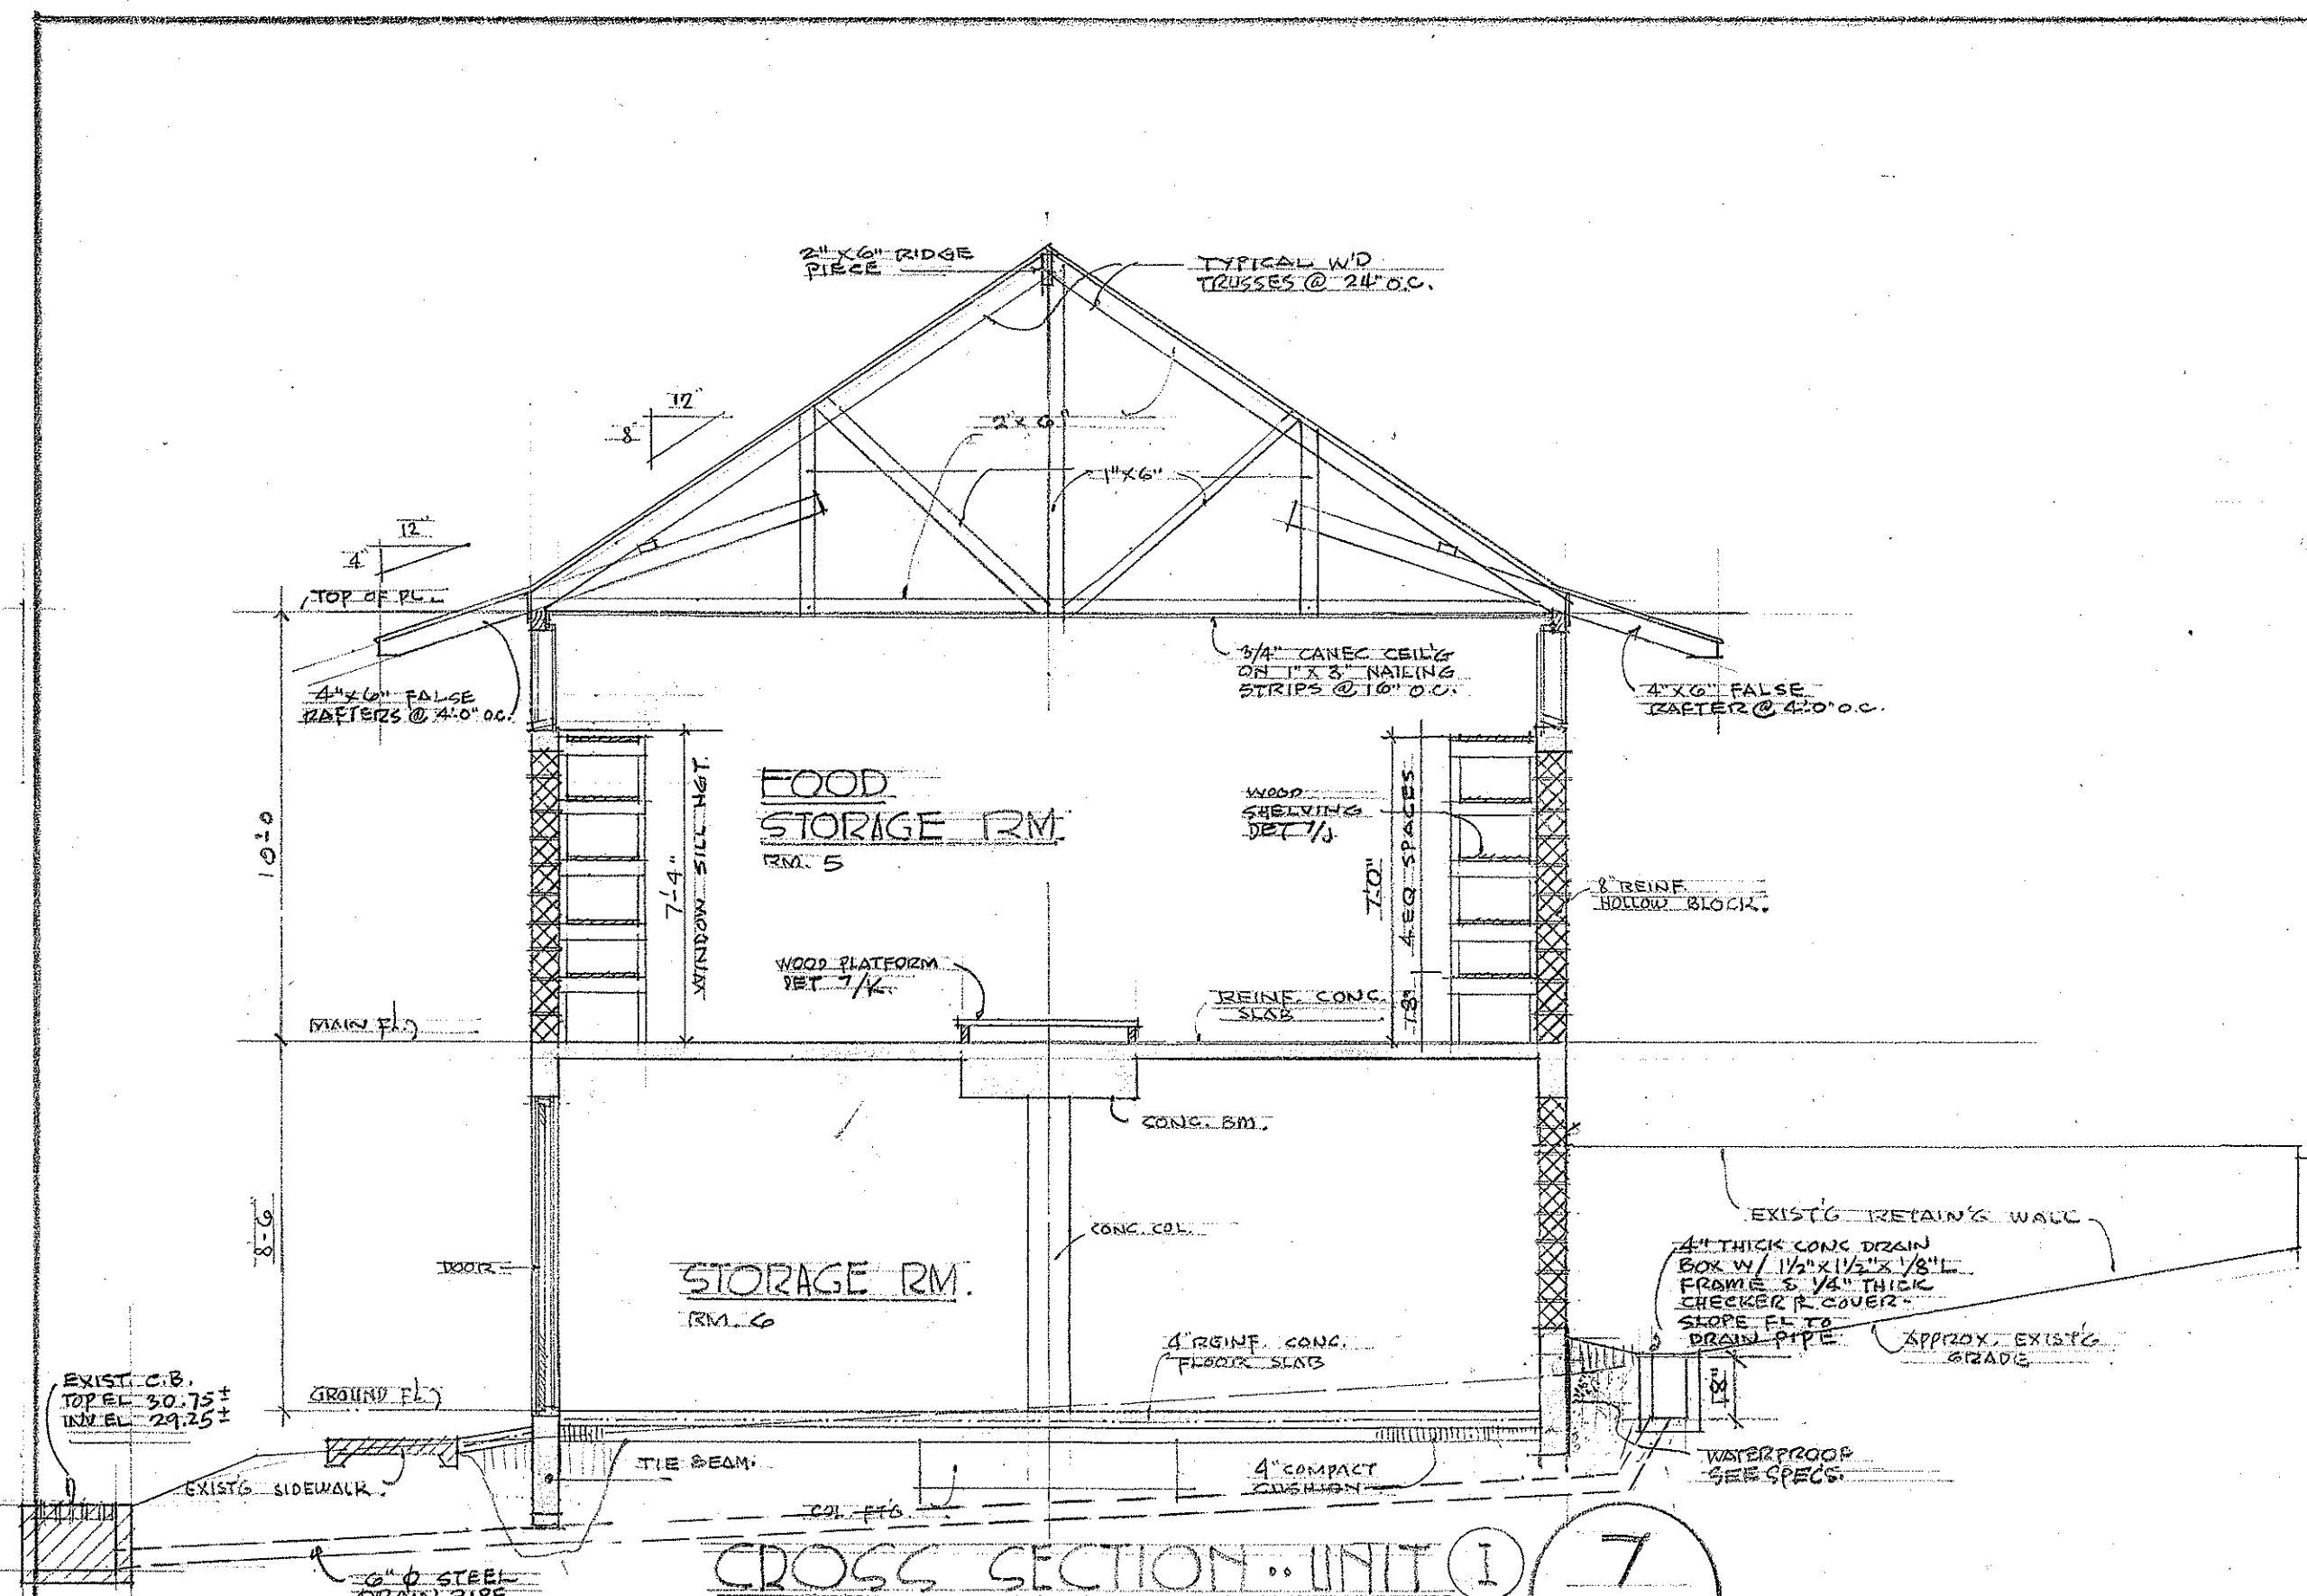

TERRITORIAL HIGHWAY DEPARTMENT		
RELOCATION AND REHABILITATION		
EXISTING IMPROVEMENTS		
AT		
KAULUWELA SCHOOL		
HONOLULU, OAHU, T.H.		
IN CONNECTION WITH LUNALILO FREEWAY		
FED. AID PROJ. NO. 66-072-1-(3)		
DATE	THOMAS J. NISHIDA ARCHITECT	SHEET
FEB 14 1958	HAROLD M. TANIMURA ENGINEER	7
	HONOLULU, OAHU, T.H.	OF 13 SHEETS

5985.8