
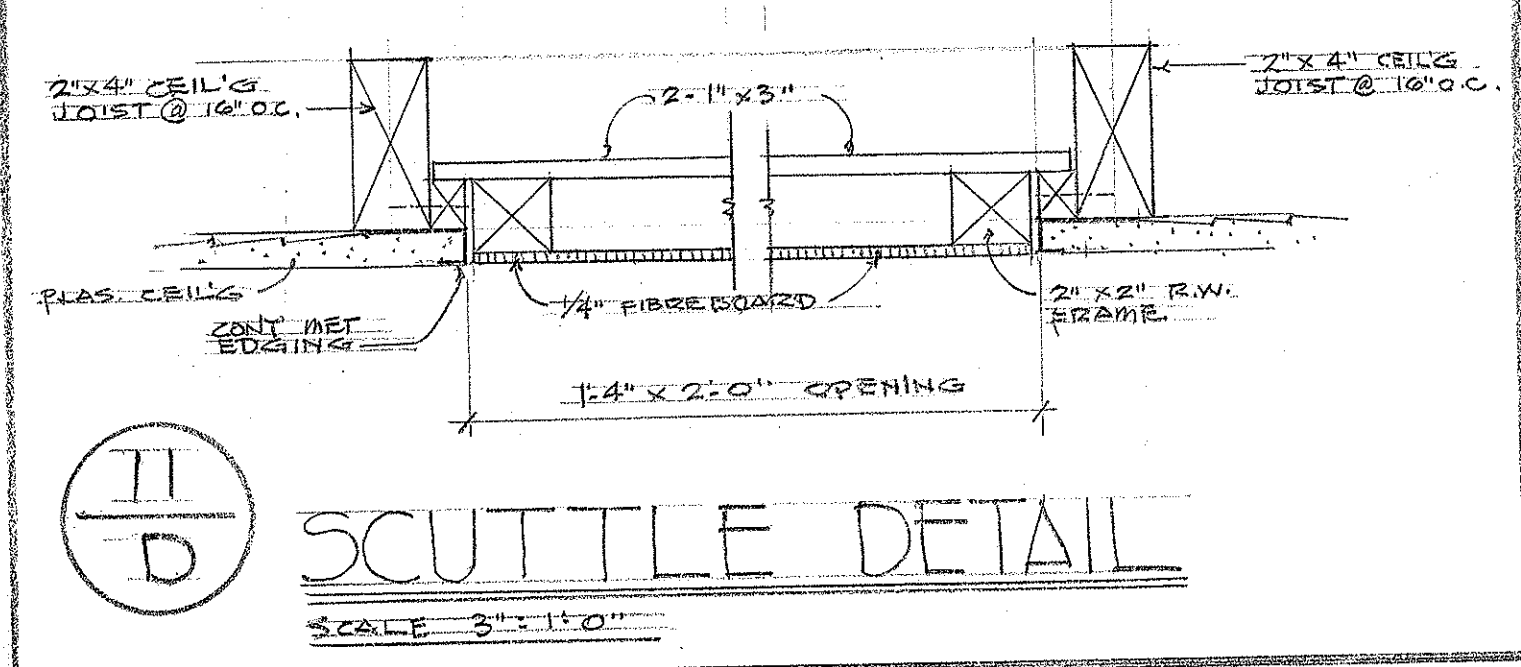
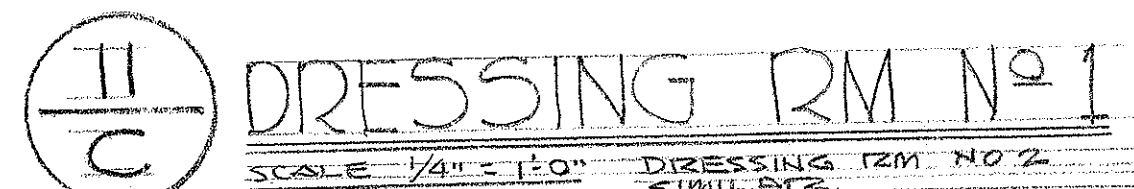
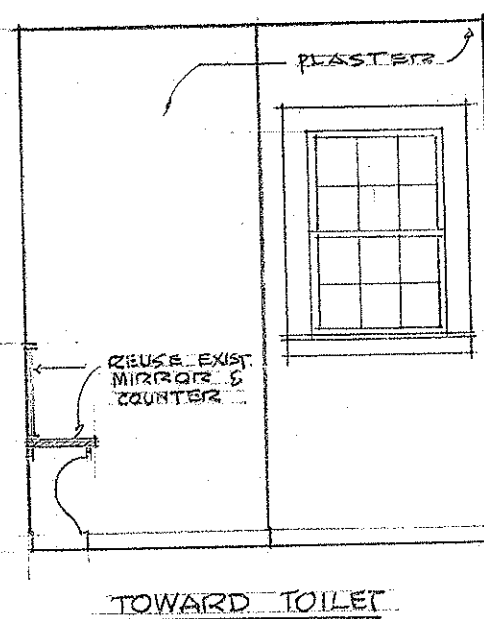
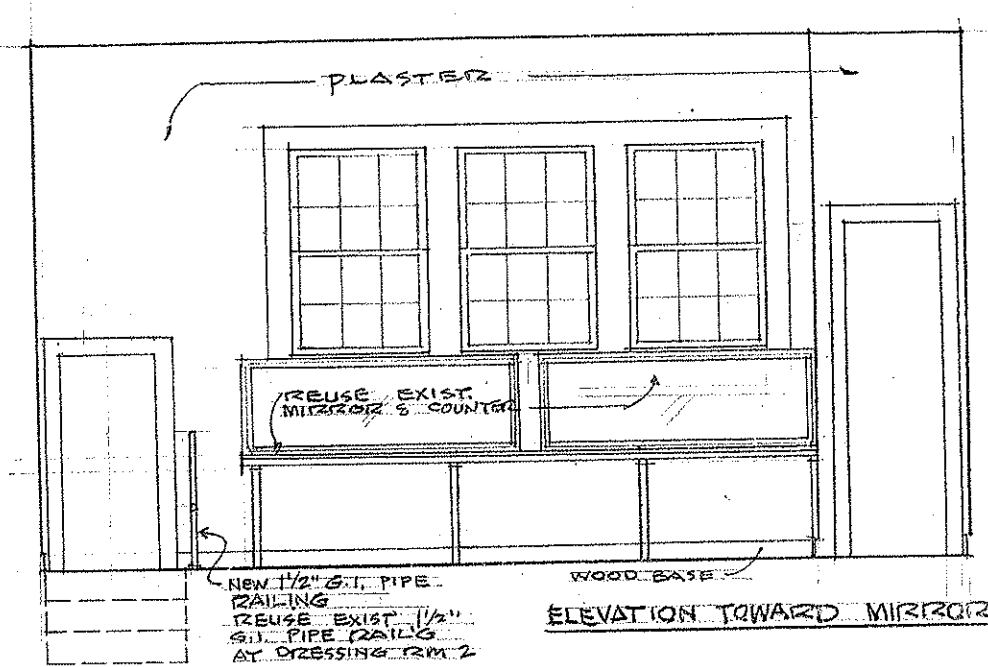
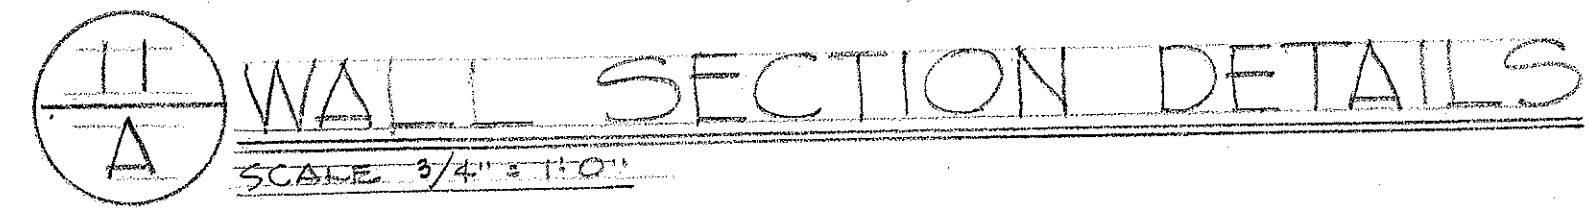
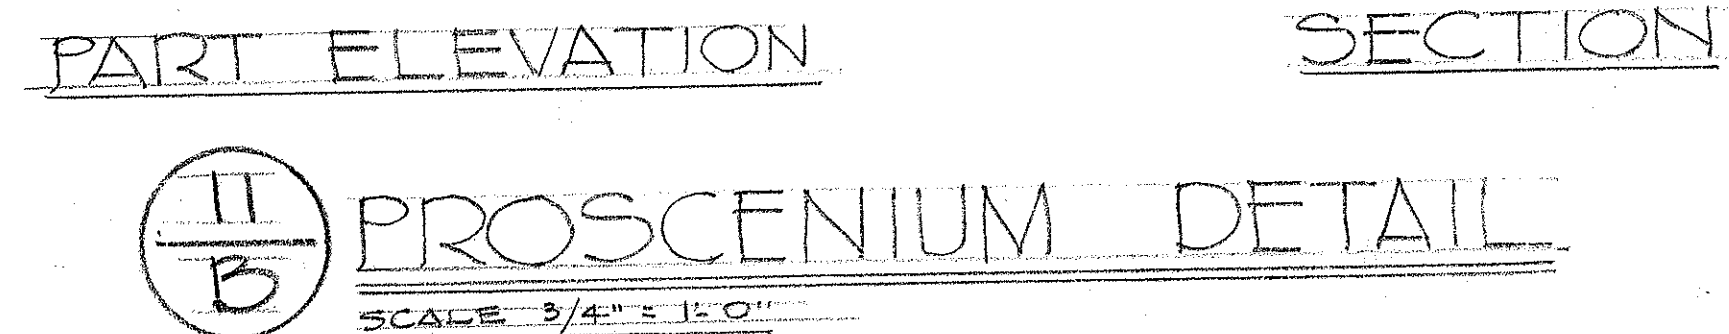
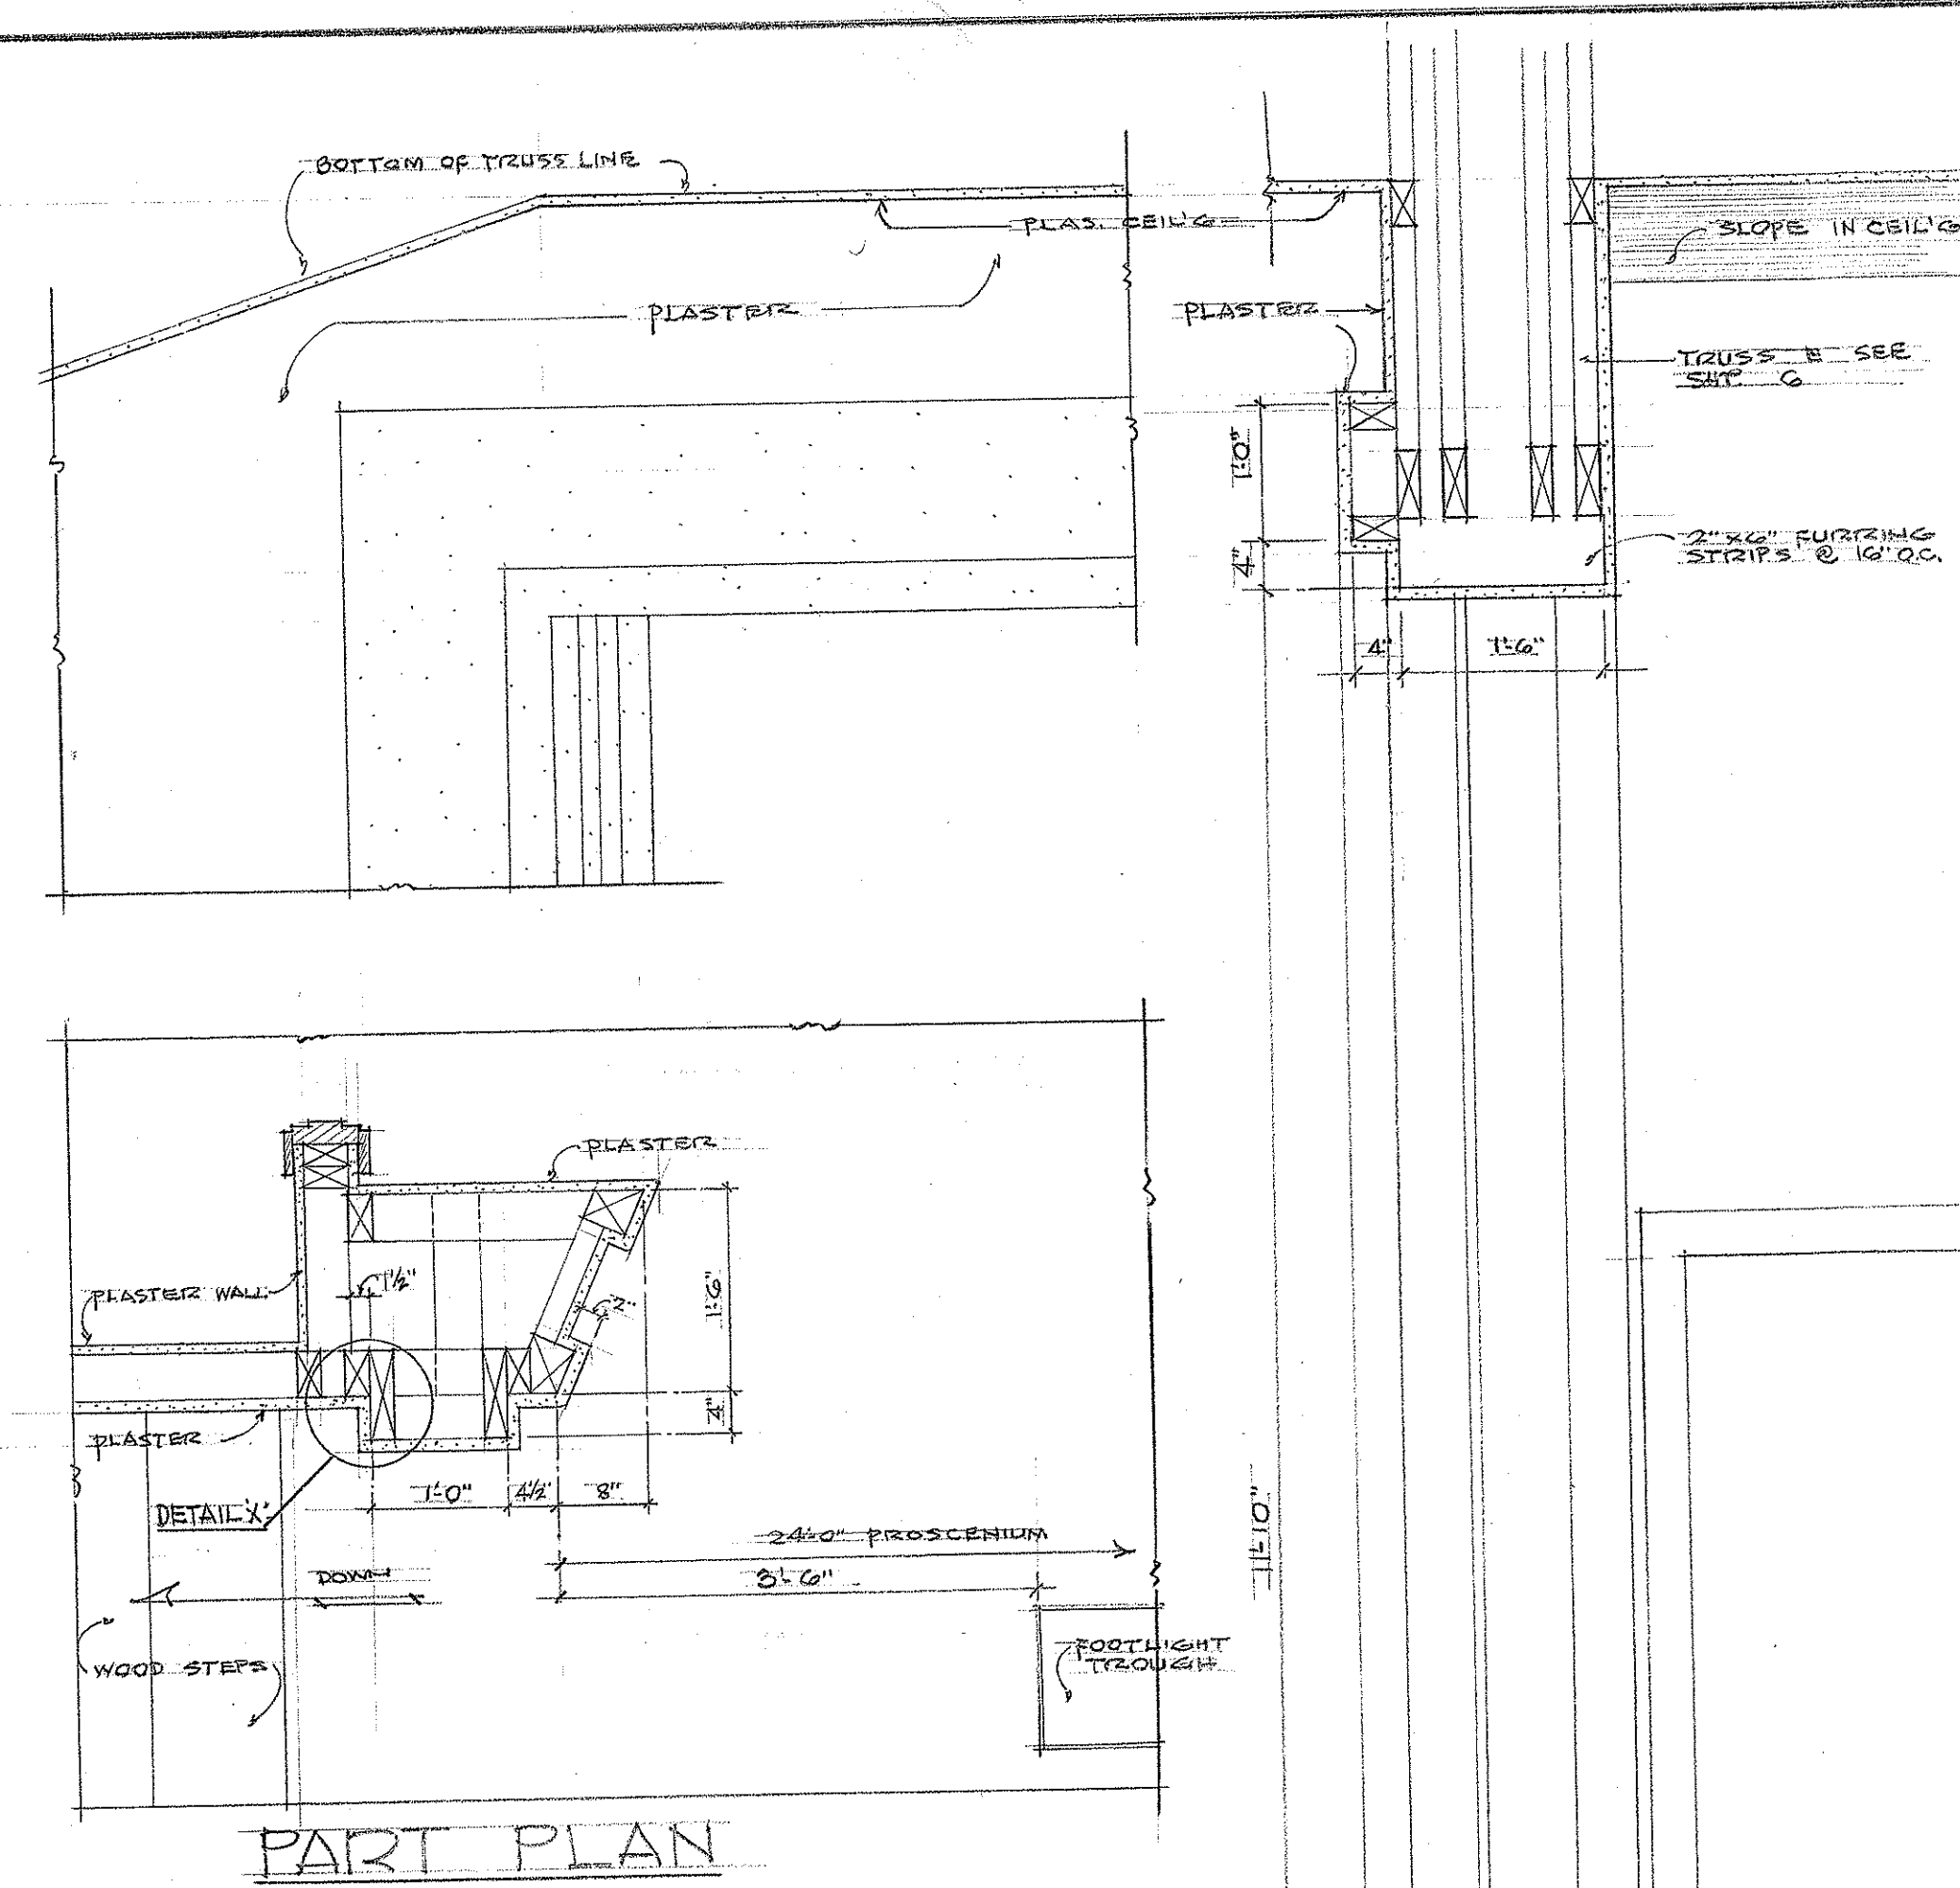
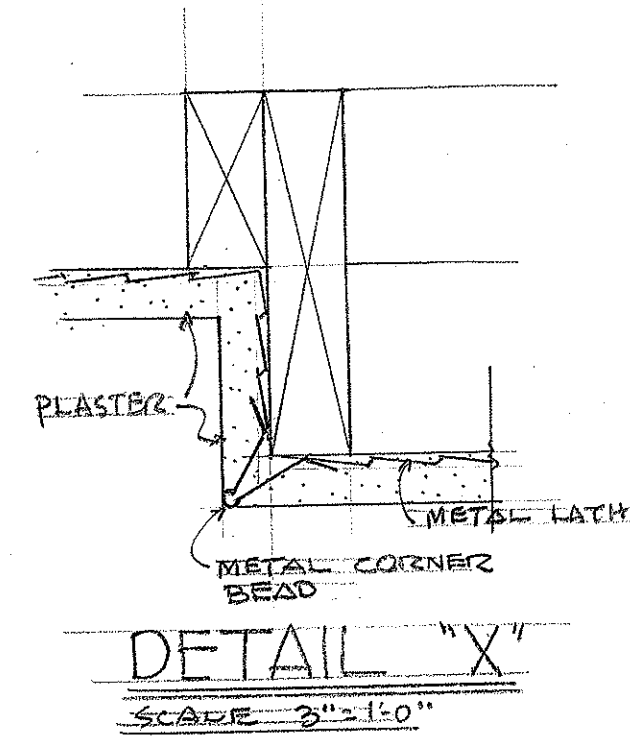


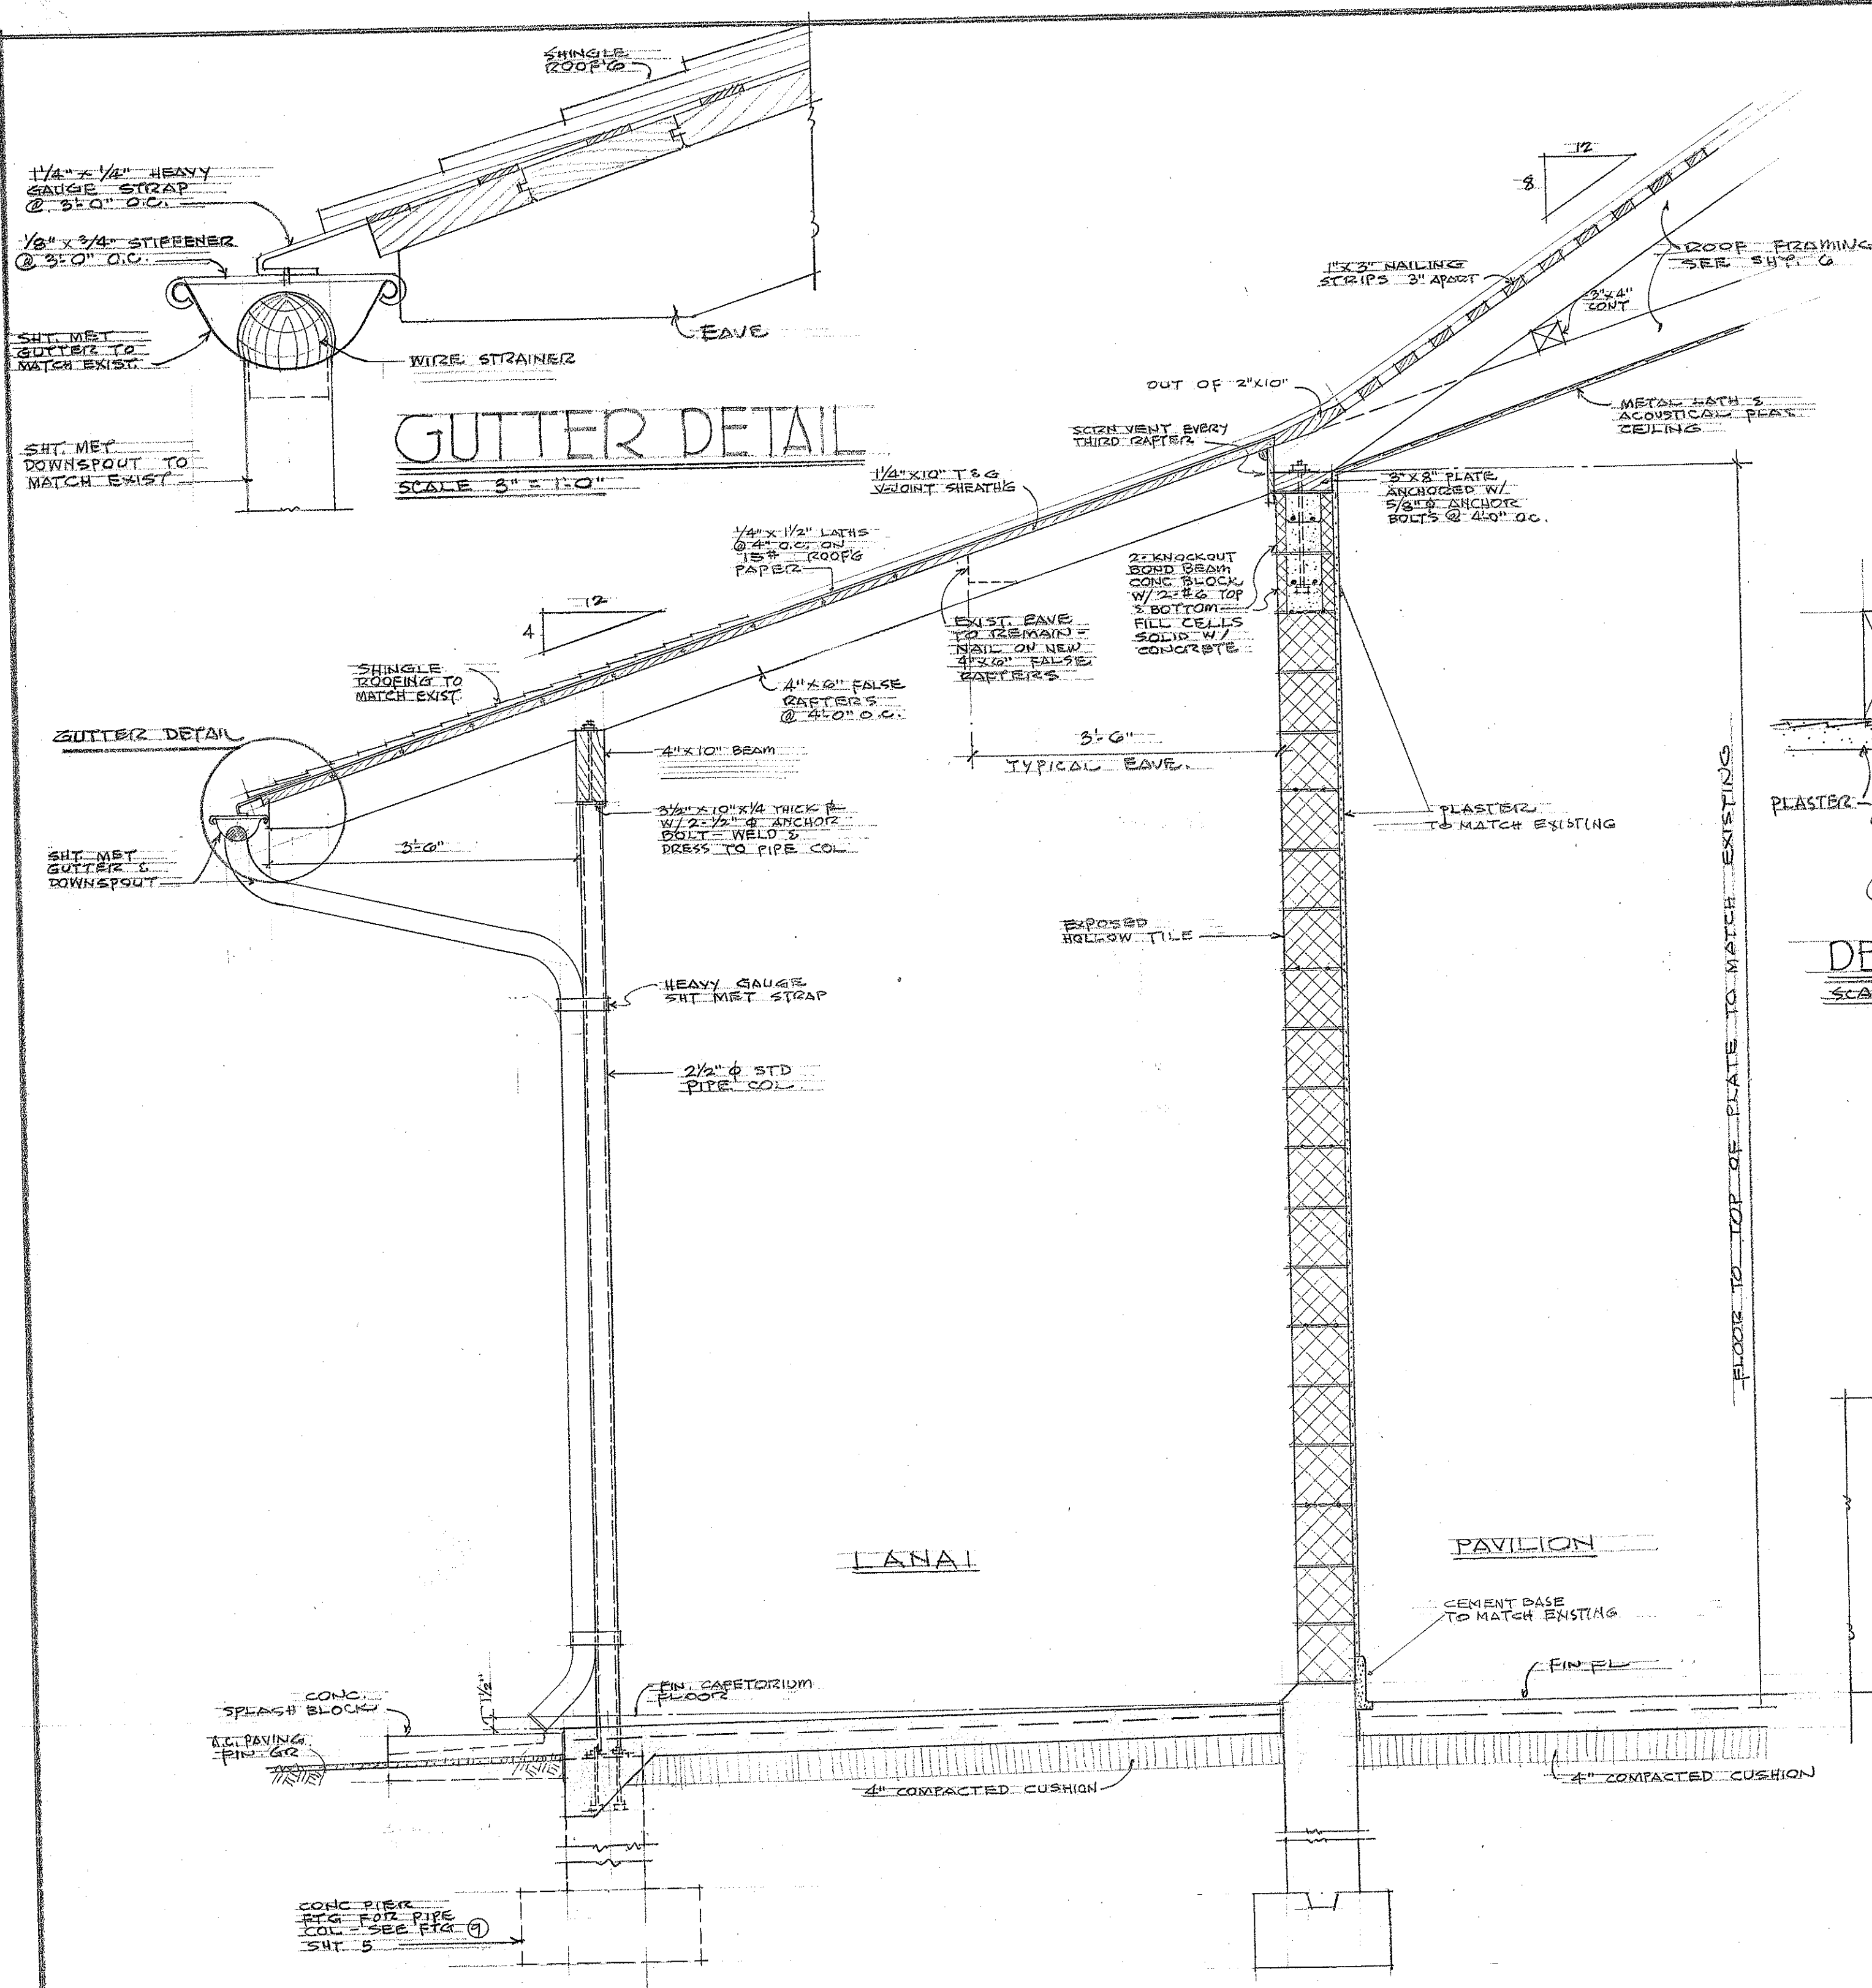

TERRITORIAL HIGHWAY DEPARTMENT TERRITORY OF HAWAII			
RELOCATION AND REHABILITATION OF EXISTING IMPROVEMENTS AT KAULUWELA SCHOOL HONOLULU, OAHU, T.H.			
IN CONNECTION WITH LUALA FIREWAY FED. AID PROJ. NO. 8F-072-1-1(3)			
DATE FEB 14 1958	THOMAS C. NISHIDA ARCHITECT	HAROLD M. TANIMURA ENGINEER	SHEET 11 OF 13 SHEETS

3985.12