

FED. ROAD DIST. No.	STATE	FED. AID PROJ. No.	FISCAL YEAR	SHEET No.	TOTAL SHEETS
HAWAII	HAW.	F-59(2) Sec. G	1958	1	4


"AS BUILT" PLANS

GENERAL NOTES

- 1 The Contractor shall verify all dimensions on job site.
- 2 The Contractor shall connect the water and sewer lines of relocated Building "O" to the nearest available existing sewer and water line.

NOTES ON MOVING OF HOT HOUSE

- 1 All plants on the outside of the Hot House that are in the way of construction operations (foundation work) shall be moved by the contractor.
- 2 The contractor shall complete all work on the foundation before moving the Hot House frame so as to cause minimum of delay.
- 3 All plants in the Hot House will be removed by the owner, however all cost involved in the moving of the plants by the owner shall be borne by the Contractor and such cost shall be included in the item of Relocating Hot House.
- 4 The Contractor shall replace any plants damaged by his moving operations.

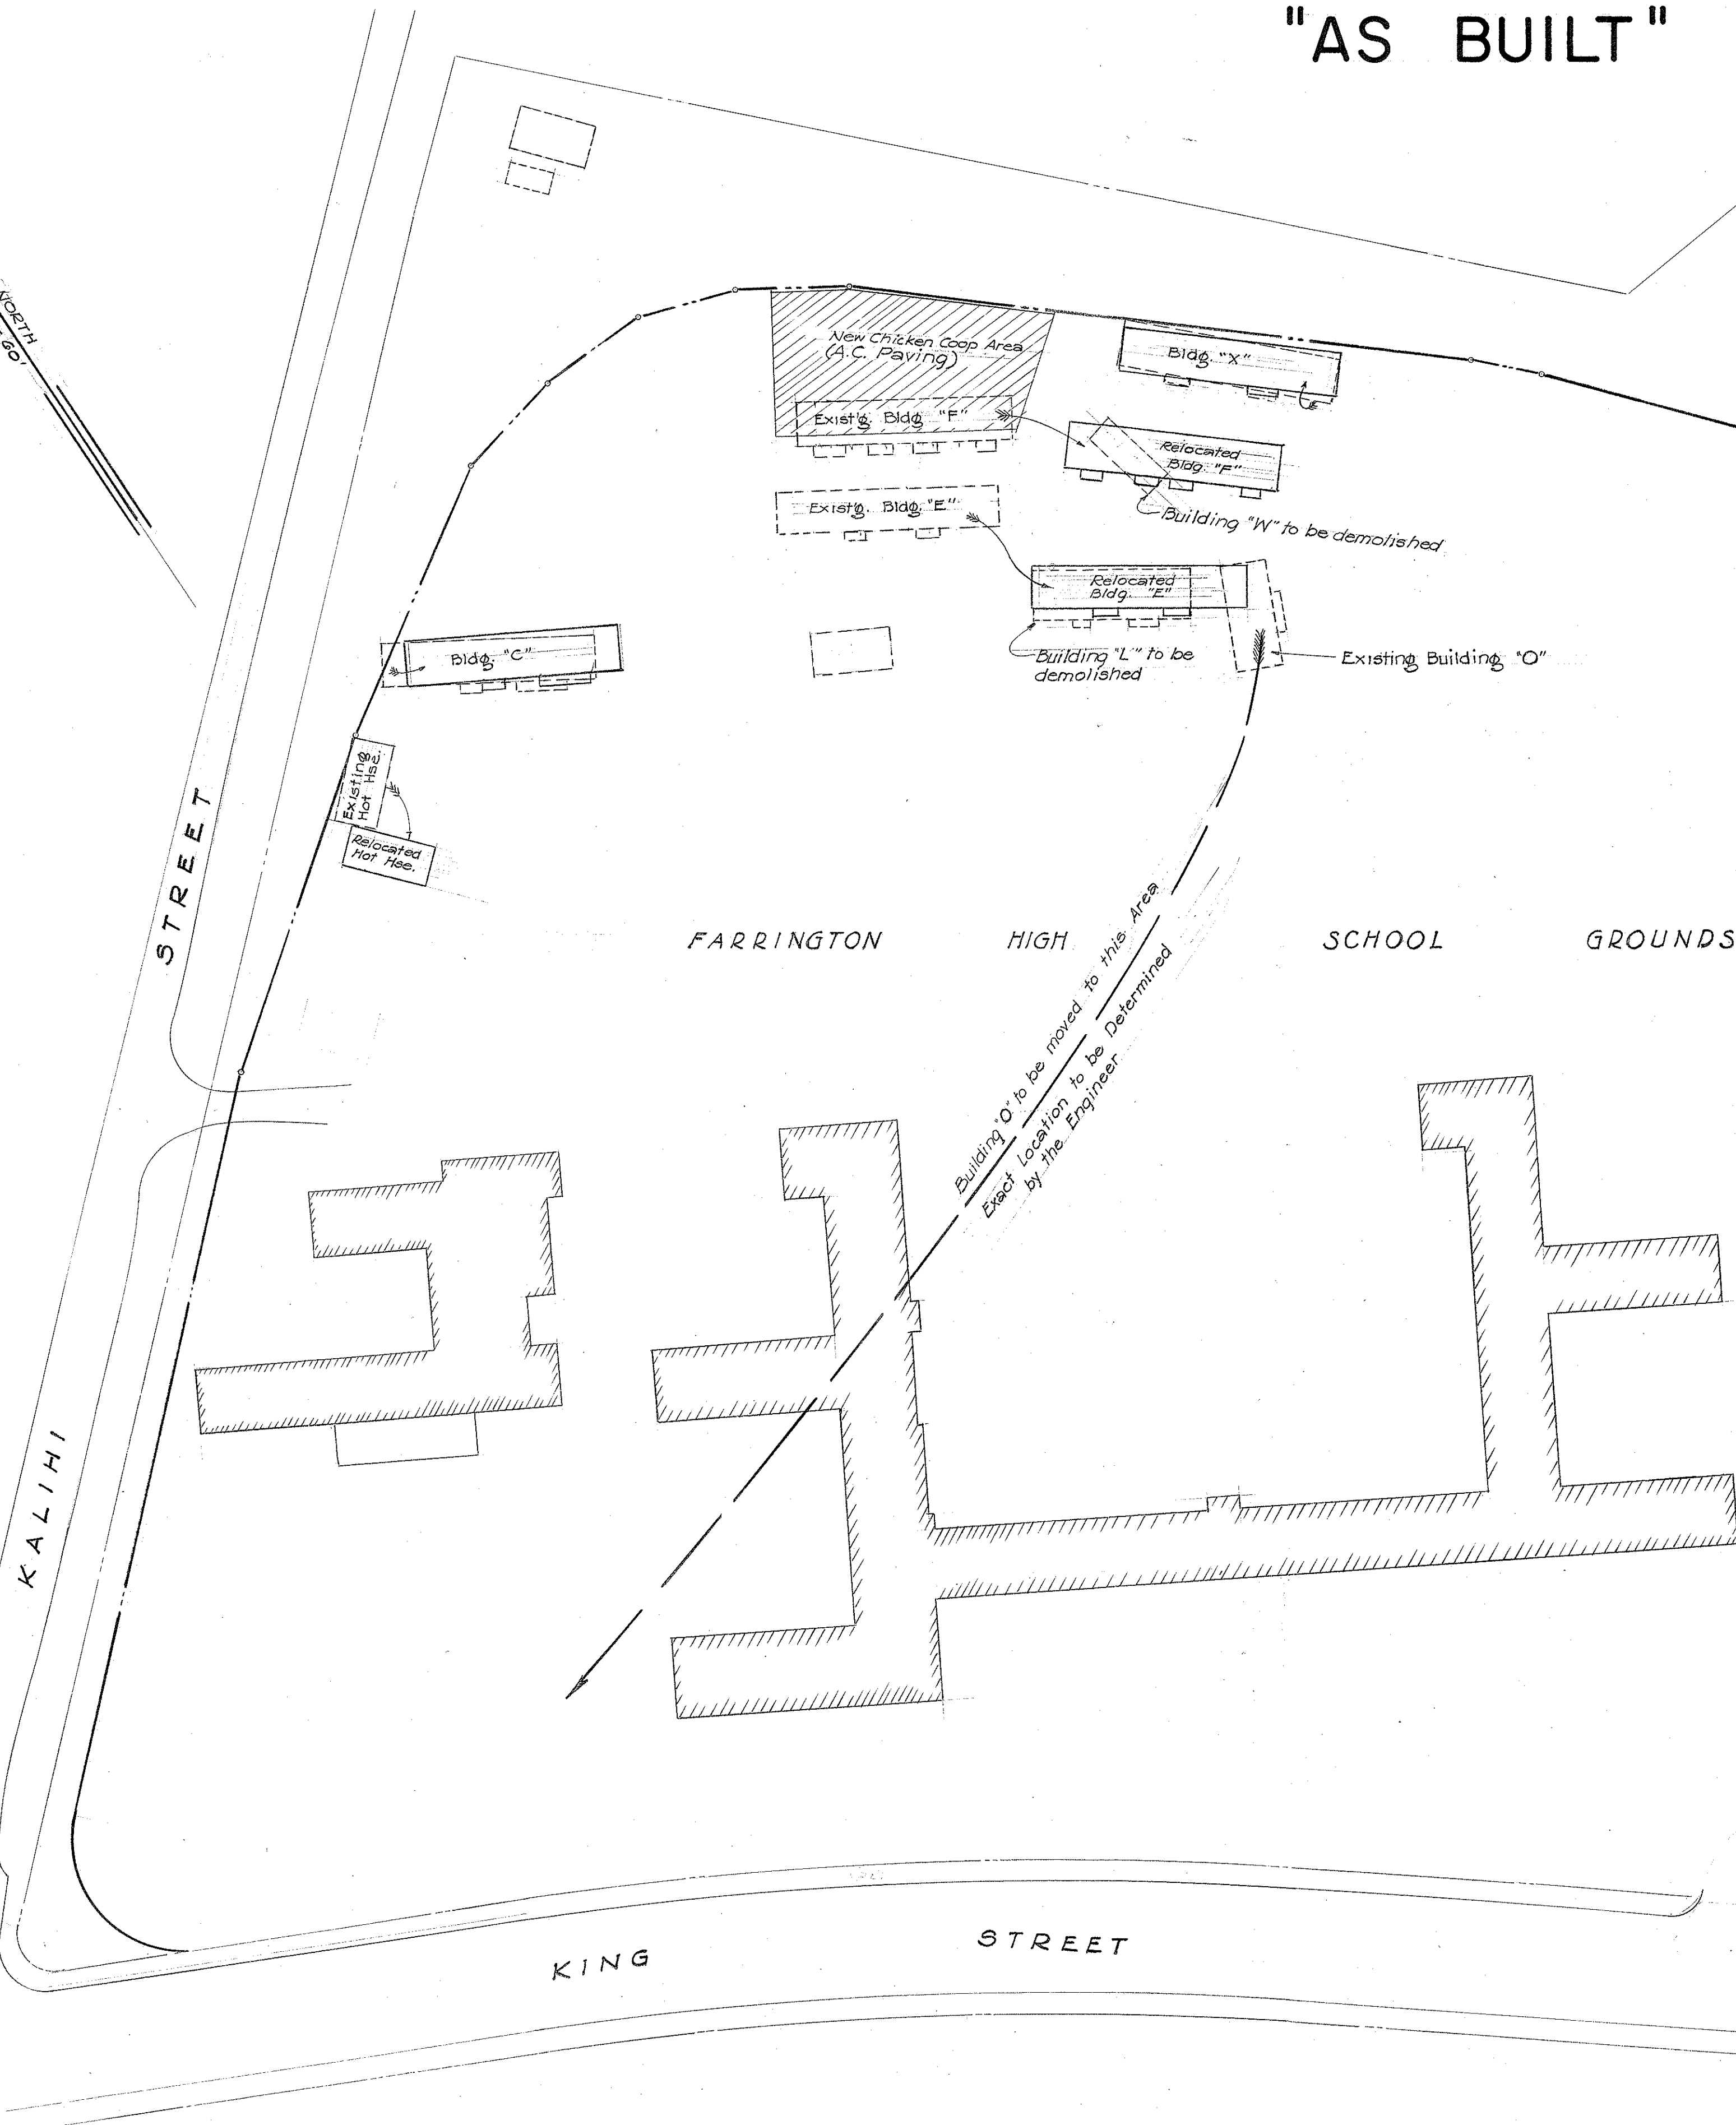

NO CHANGE WAS MADE DURING CONSTRUCTION OF THIS PROJECT.

R-T. Sander 11-10-81
 for RESIDENT ENGINEER DATE

APPROVED: DATE 6/23/58

Wm. Wachtel
 TERRITORIAL HIGHWAY ENGINEER

TERRITORIAL HIGHWAY DEPARTMENT
 TERRITORY OF HAWAII
 RELOCATION OF BUILDINGS
 AND OTHER IMPROVEMENT ON
 FARRINGTON HIGH SCHOOL GROUNDS


Lunalilo Freeway F-59 (2)
 Scale: 1" = 60' June 1958

SHEET No. 1 OF 4 SHEETS


6012.1

ORIGINAL PLAN	SURVEY PLOTTED BY	DATE
NOTE BOOK	DRAWN BY	
No.	QUANTITIES CHECKED BY	
	CHECKED BY	


FED. ROAD DIST. NO.	STATE	FED. AID PROJ. NO.	FISCAL YEAR	SHEET No.	TOTAL SHEETS
HAWAII	HAW.	F-59(2) SEC. G	1958	3	4

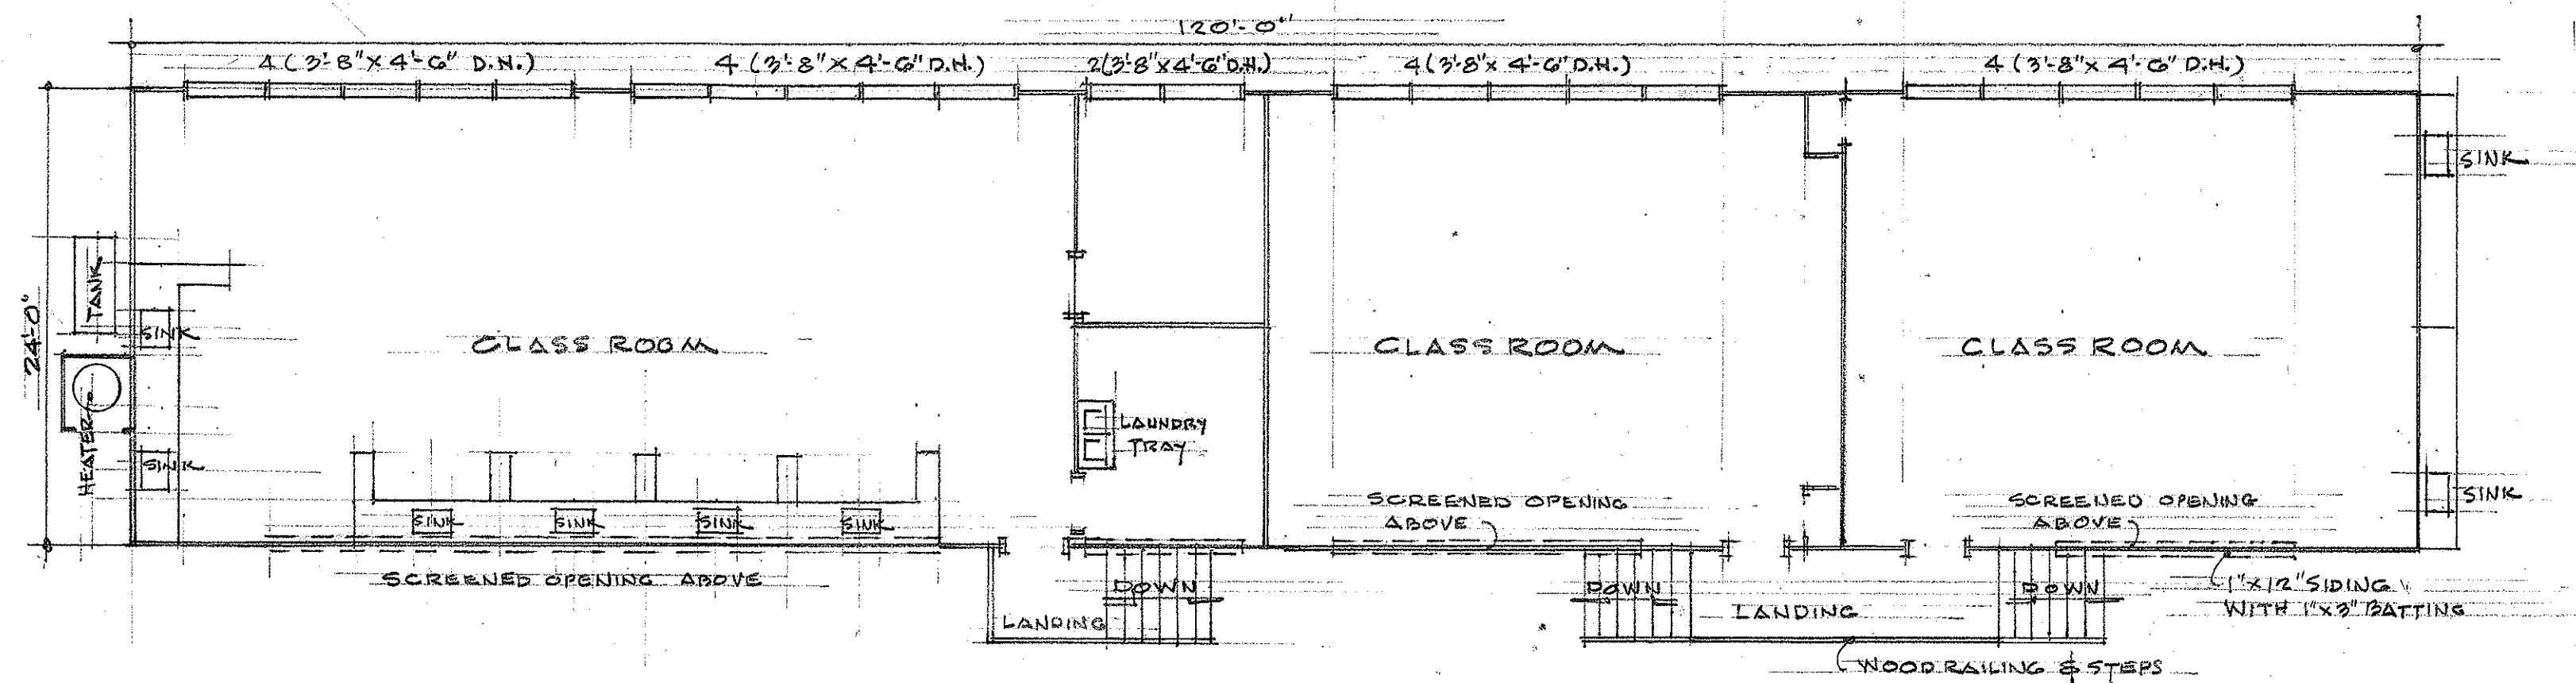


EXISTING FLOOR PLAN BUILDING "C"

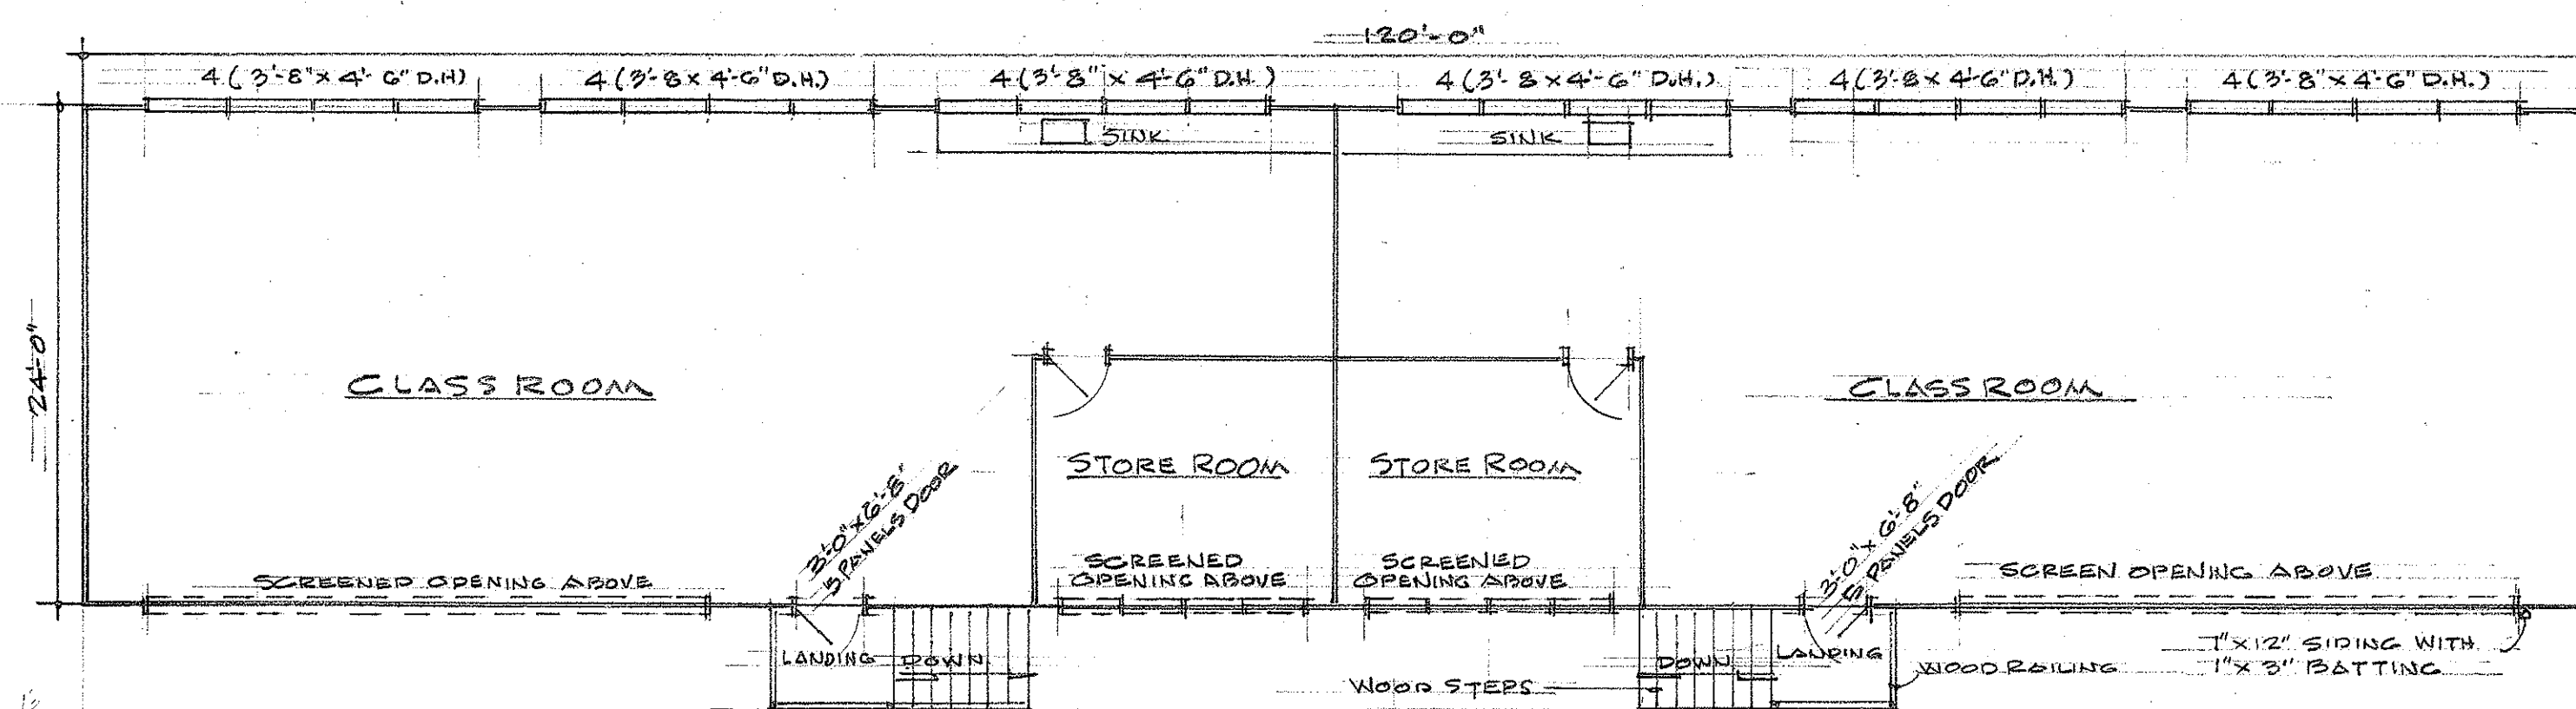


EXISTING FLOOR PLAN BUILDING "E"

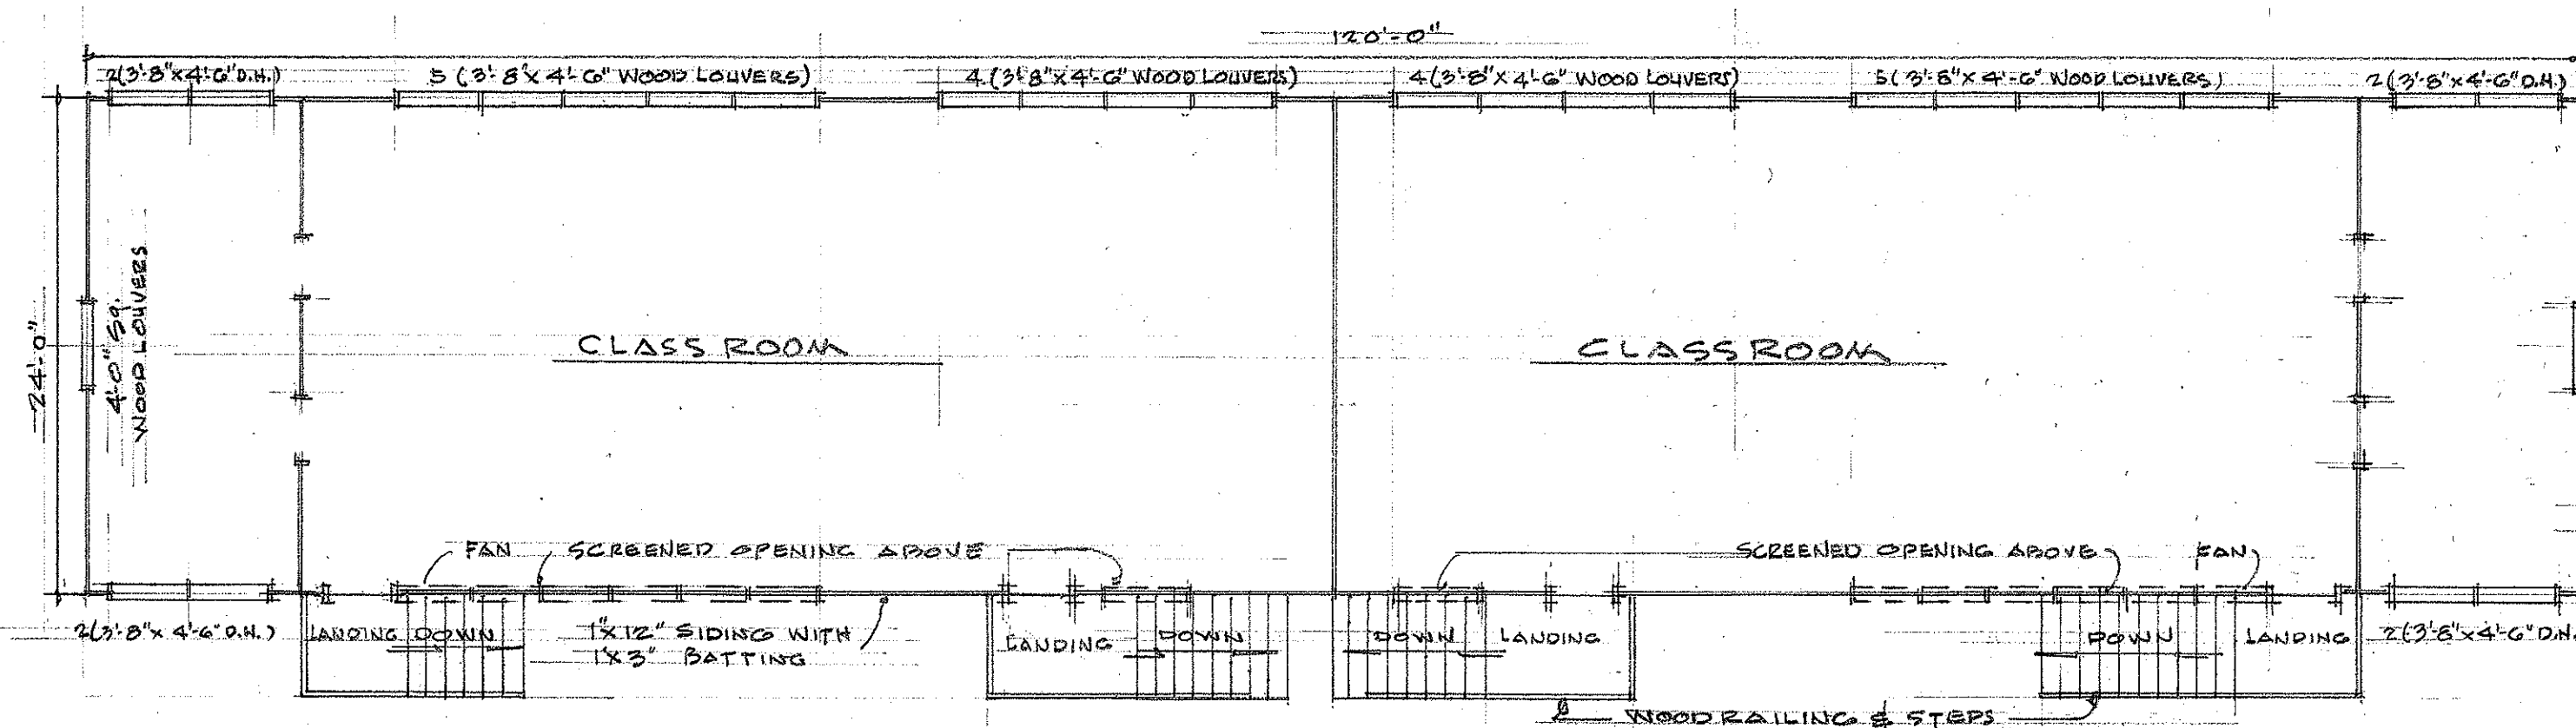


EXISTING FLOOR PLAN BUILDING "F"

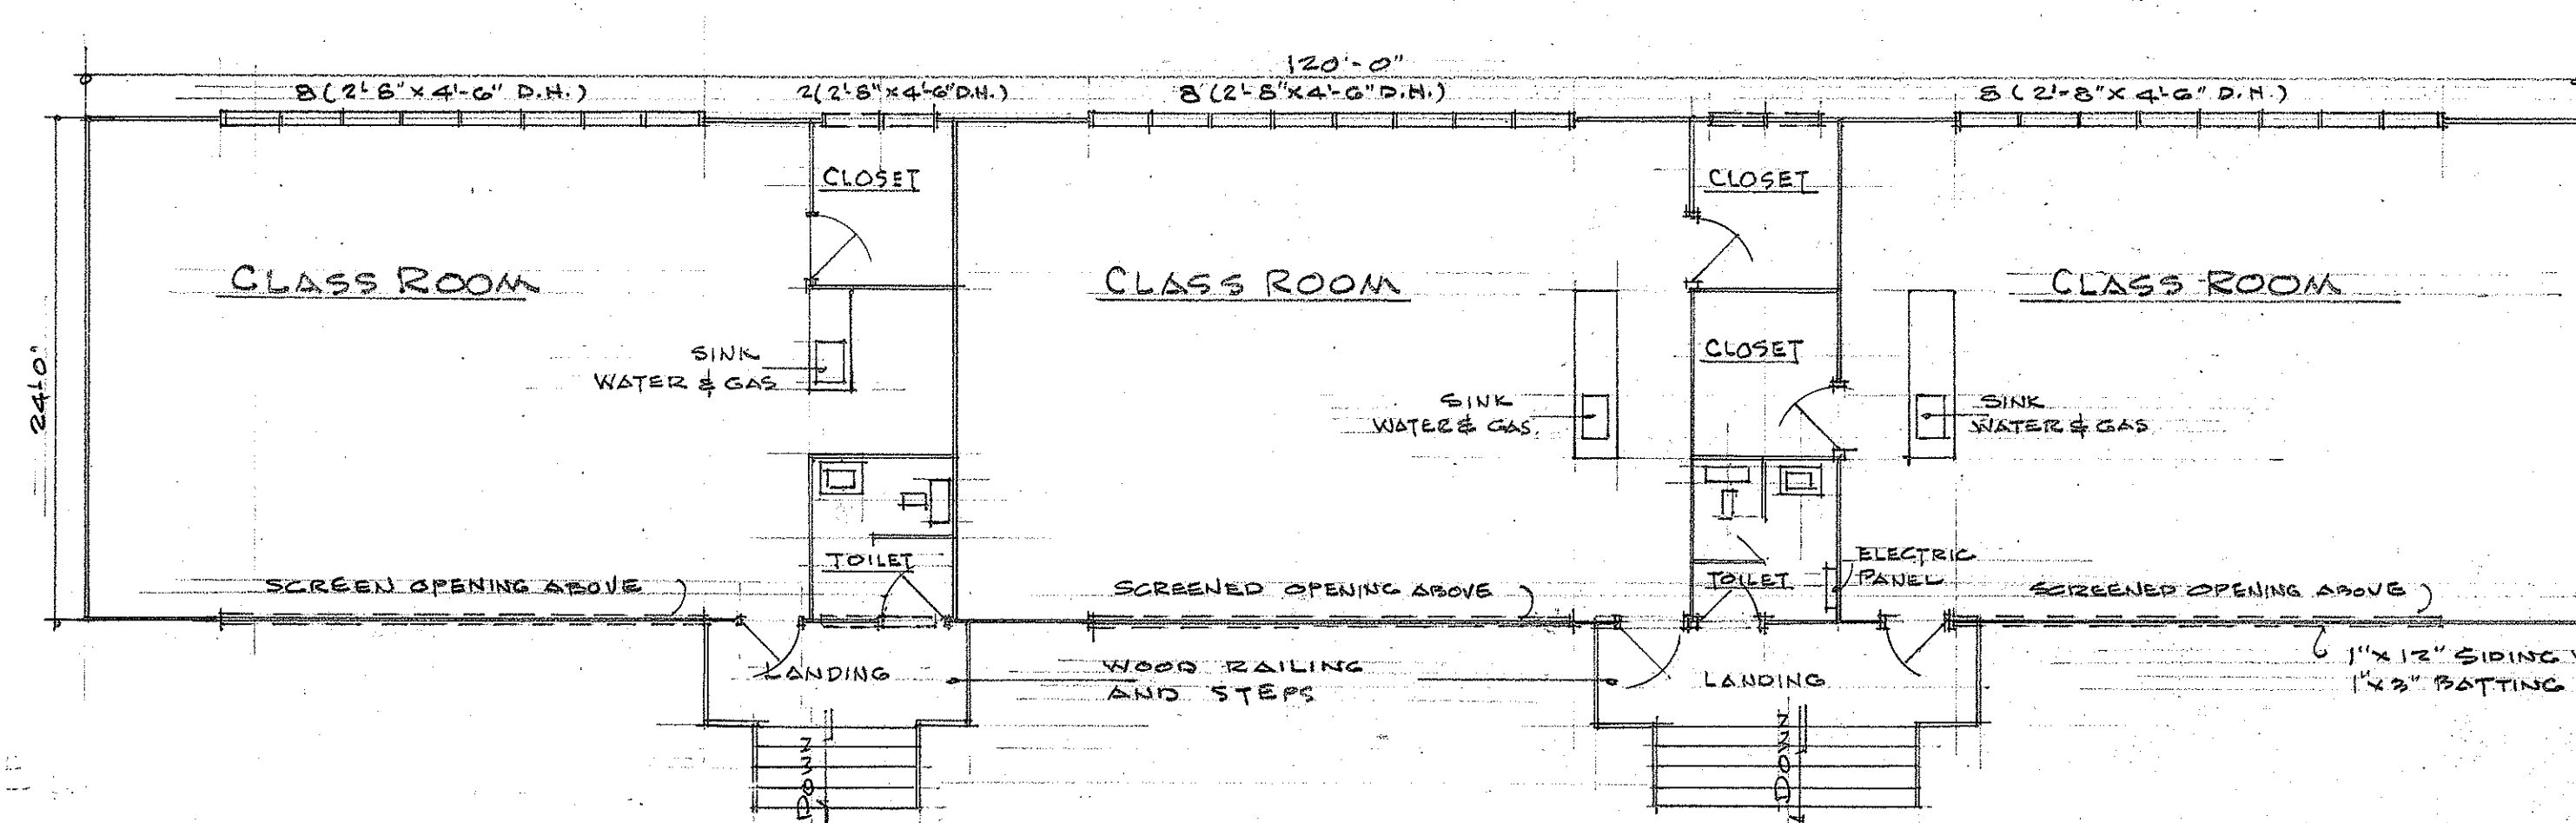

EXISTING FLOOR PLAN BUILDING "X"

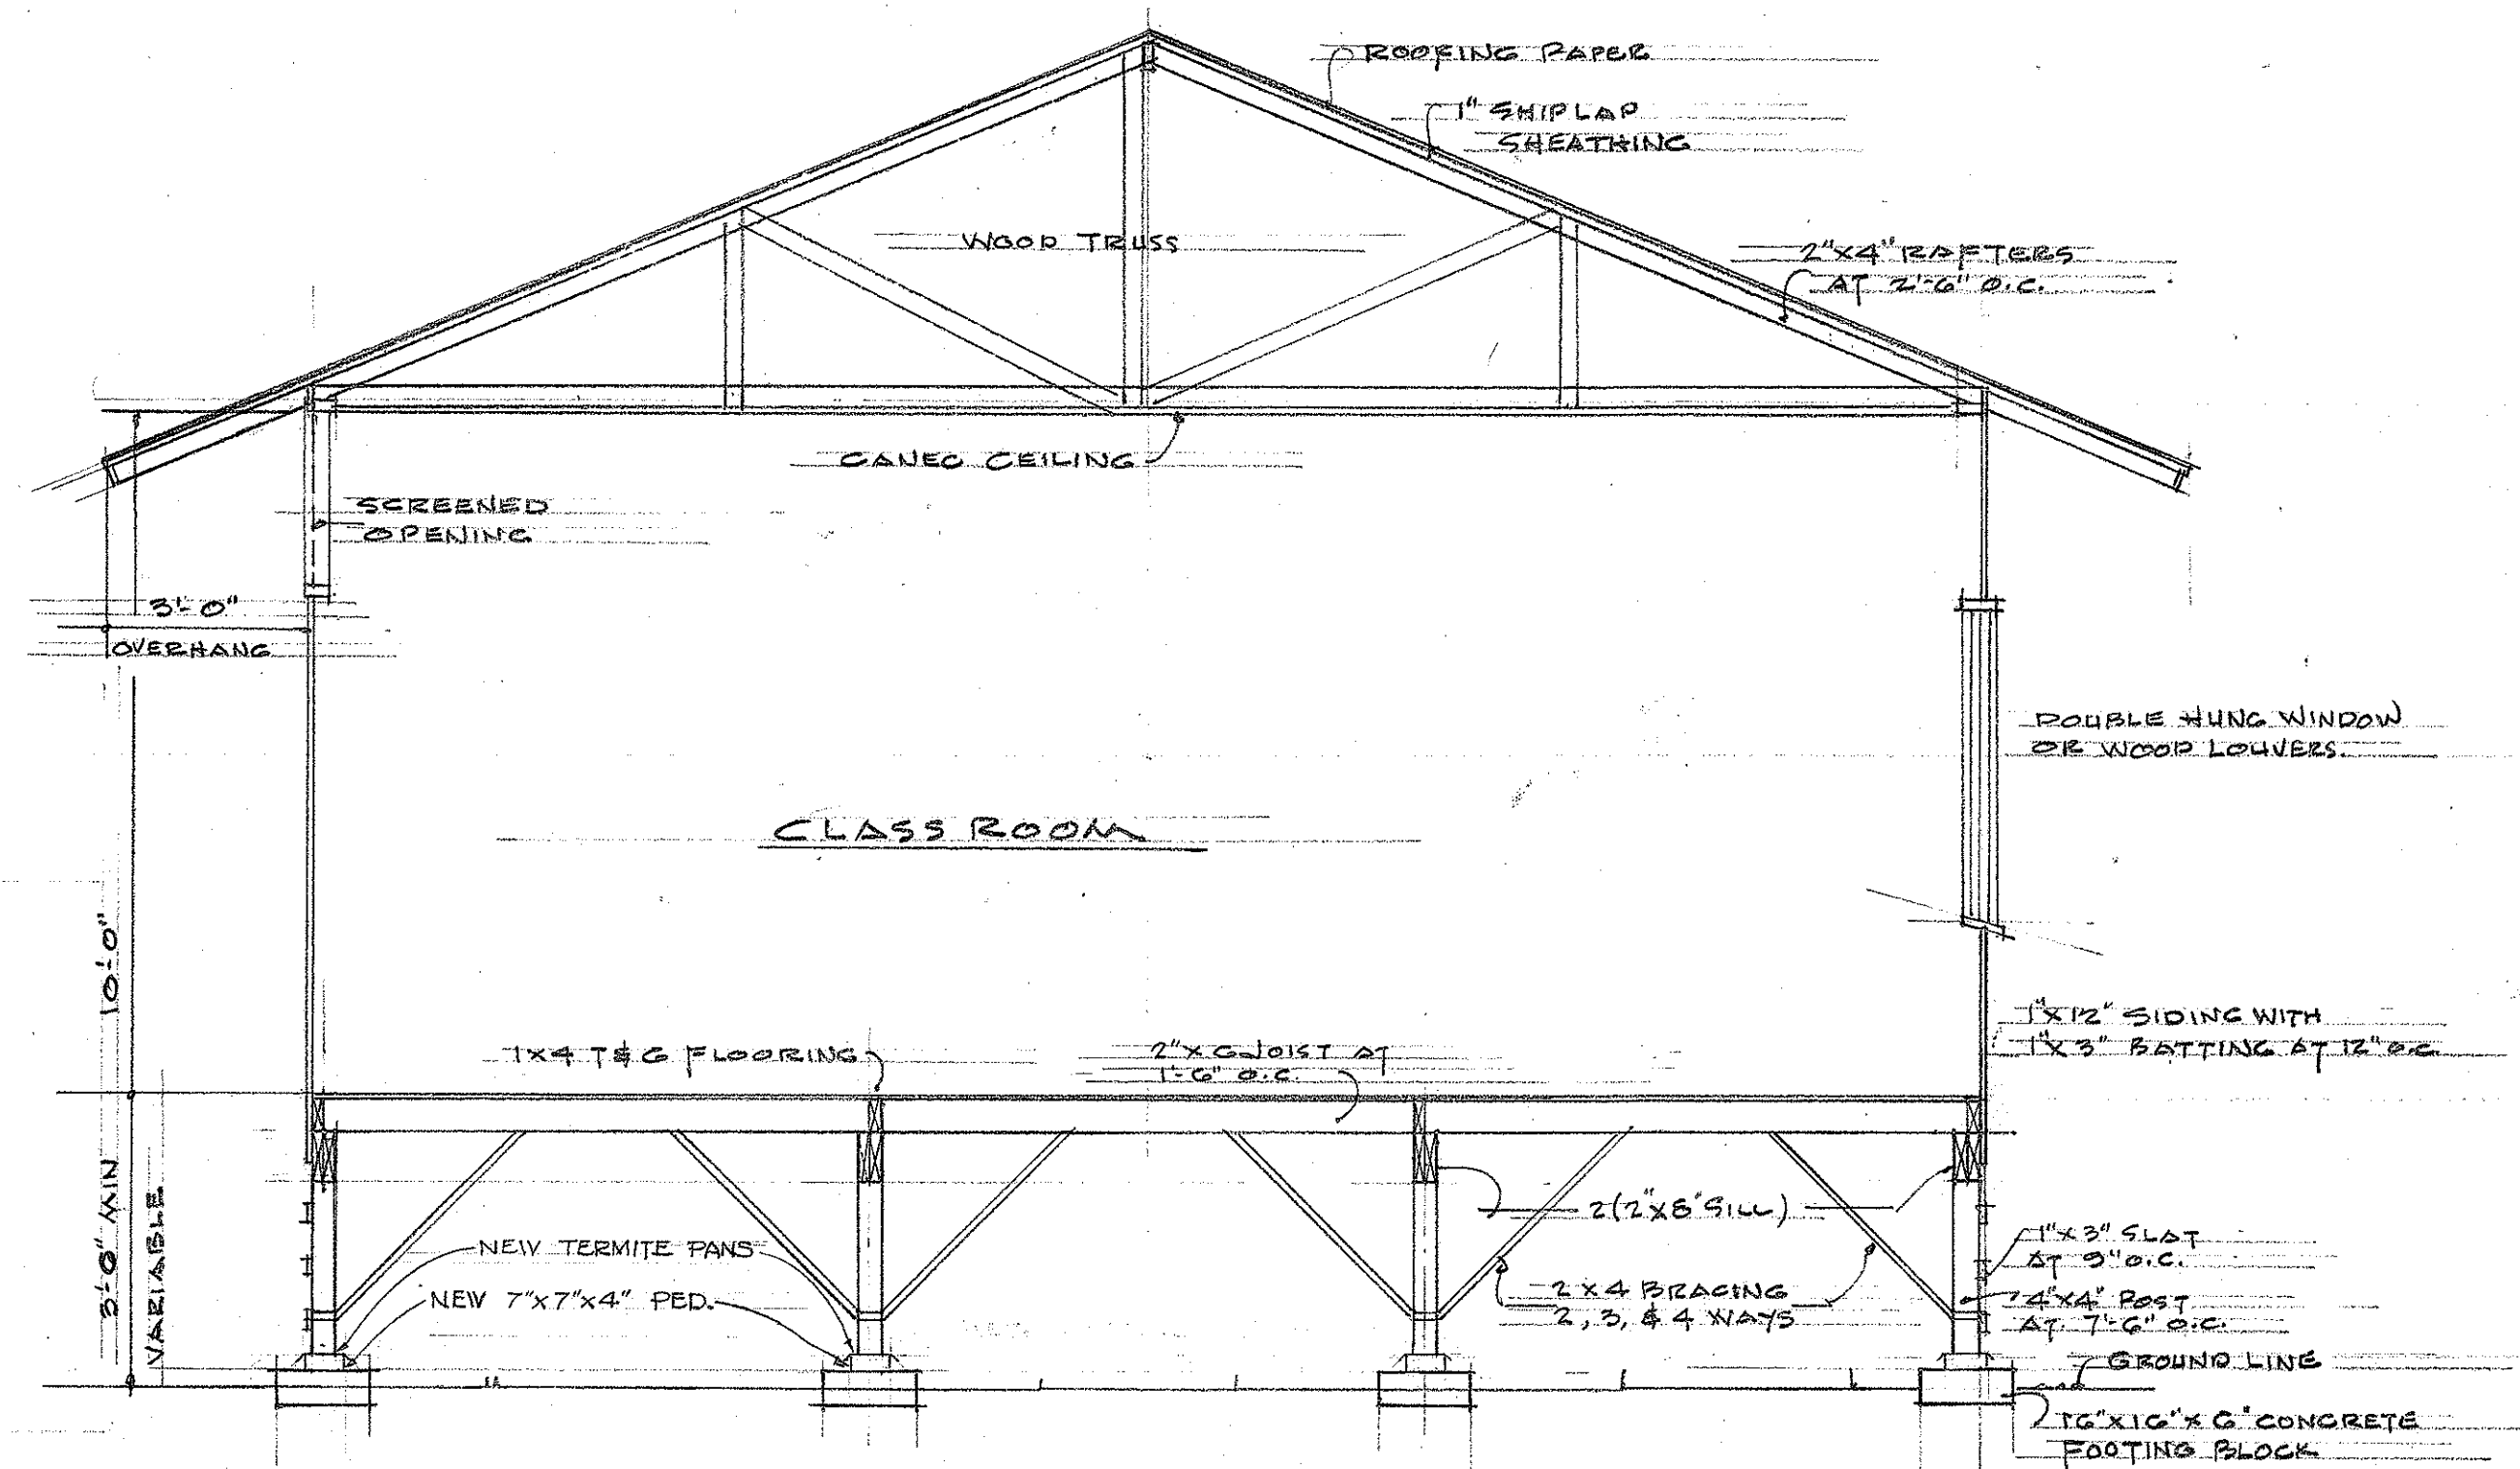

TYPICAL CROSS SECTION

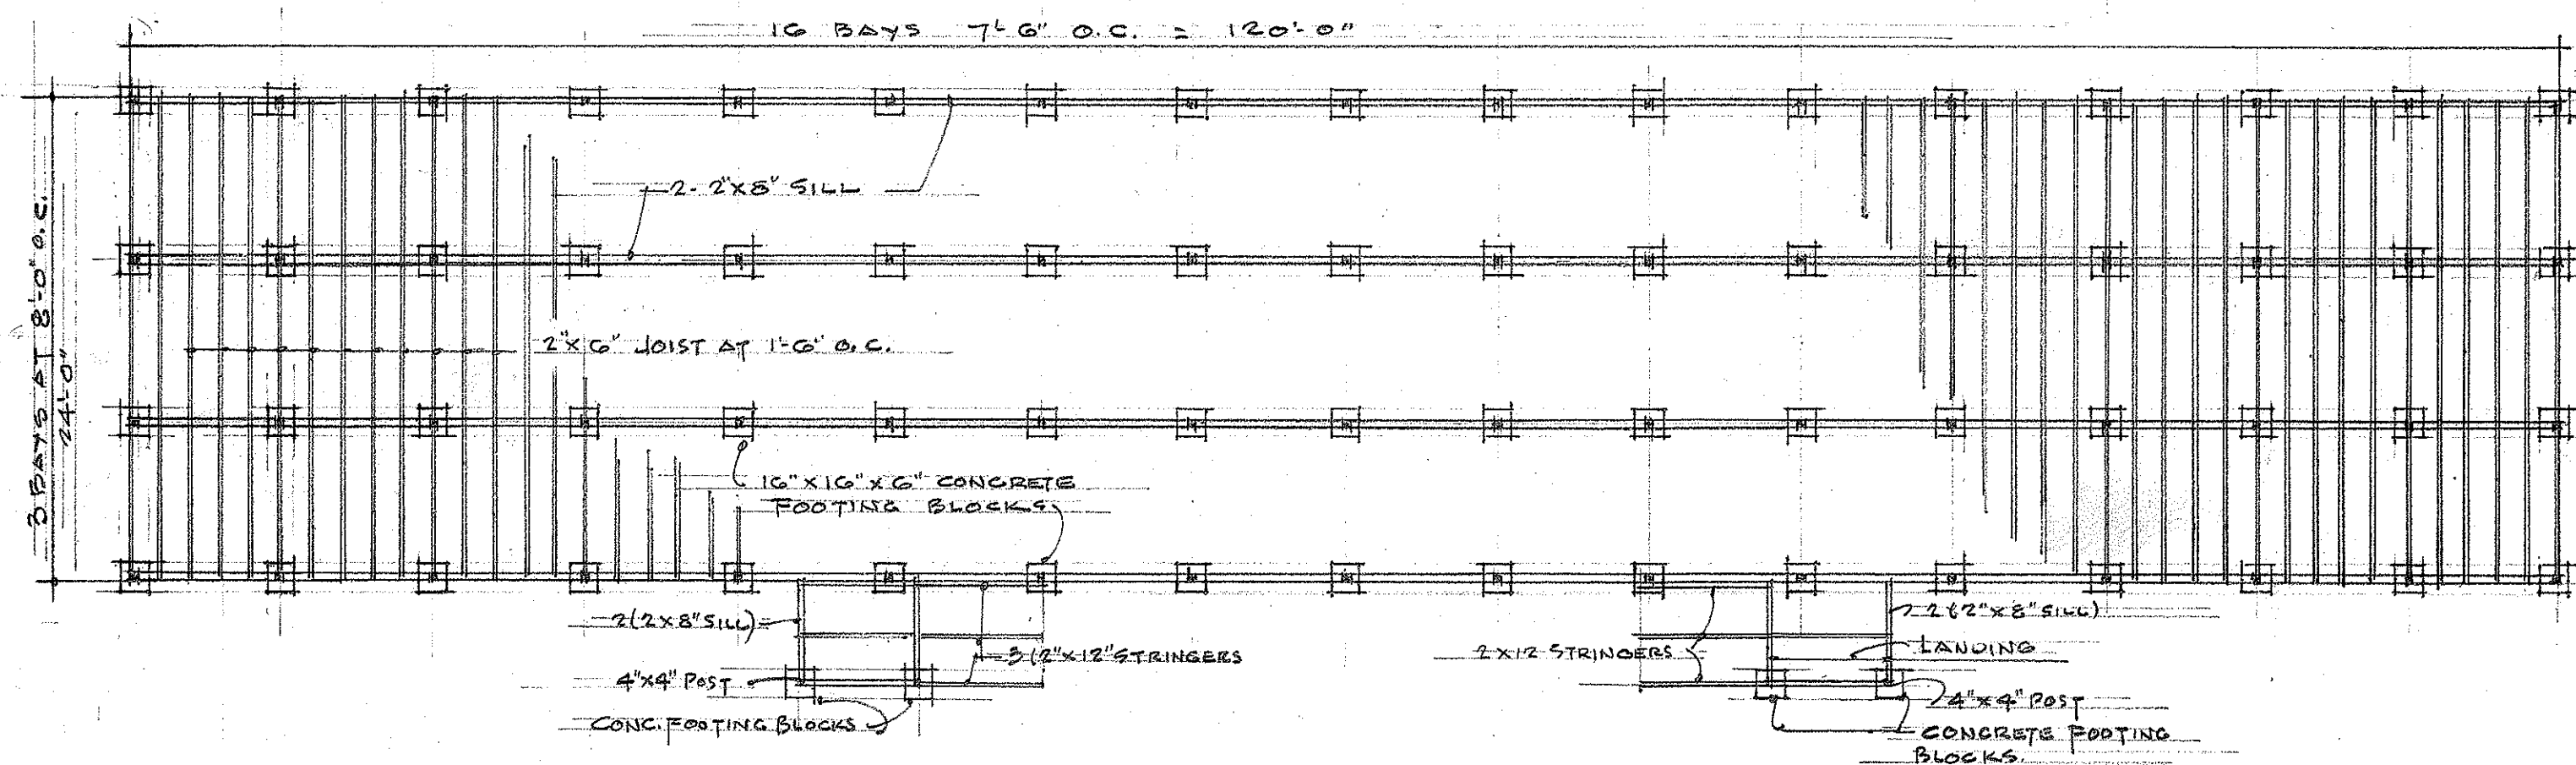

TYPICAL FOUNDATION PLAN


DESIGNED BY	DATE
DRAWN BY	9/58
CHECKED BY	
NOTED BY	
QUANTITIES CHECKED BY	
NO.	

TERRITORIAL HIGHWAY DEPARTMENT
TERRITORY OF HAWAII
RELOCATION OF BUILDINGS
AND OTHER IMPROVEMENTS ON
FARRINGTON HIGH SCHOOL GROUNDS
Lunalilo Freeway F-59(2)
Scale: As Noted June 1958


SHEET No. 3 OF 4 SHEETS

6012.3

FED. ROAD DIST. No.	STATE	FED. AID PROJ. No.	FISCAL YEAR	SHEET No.	TOTAL SHEETS
HAWAII	HAW.	F-59(2) Sec. G	1958	4	4

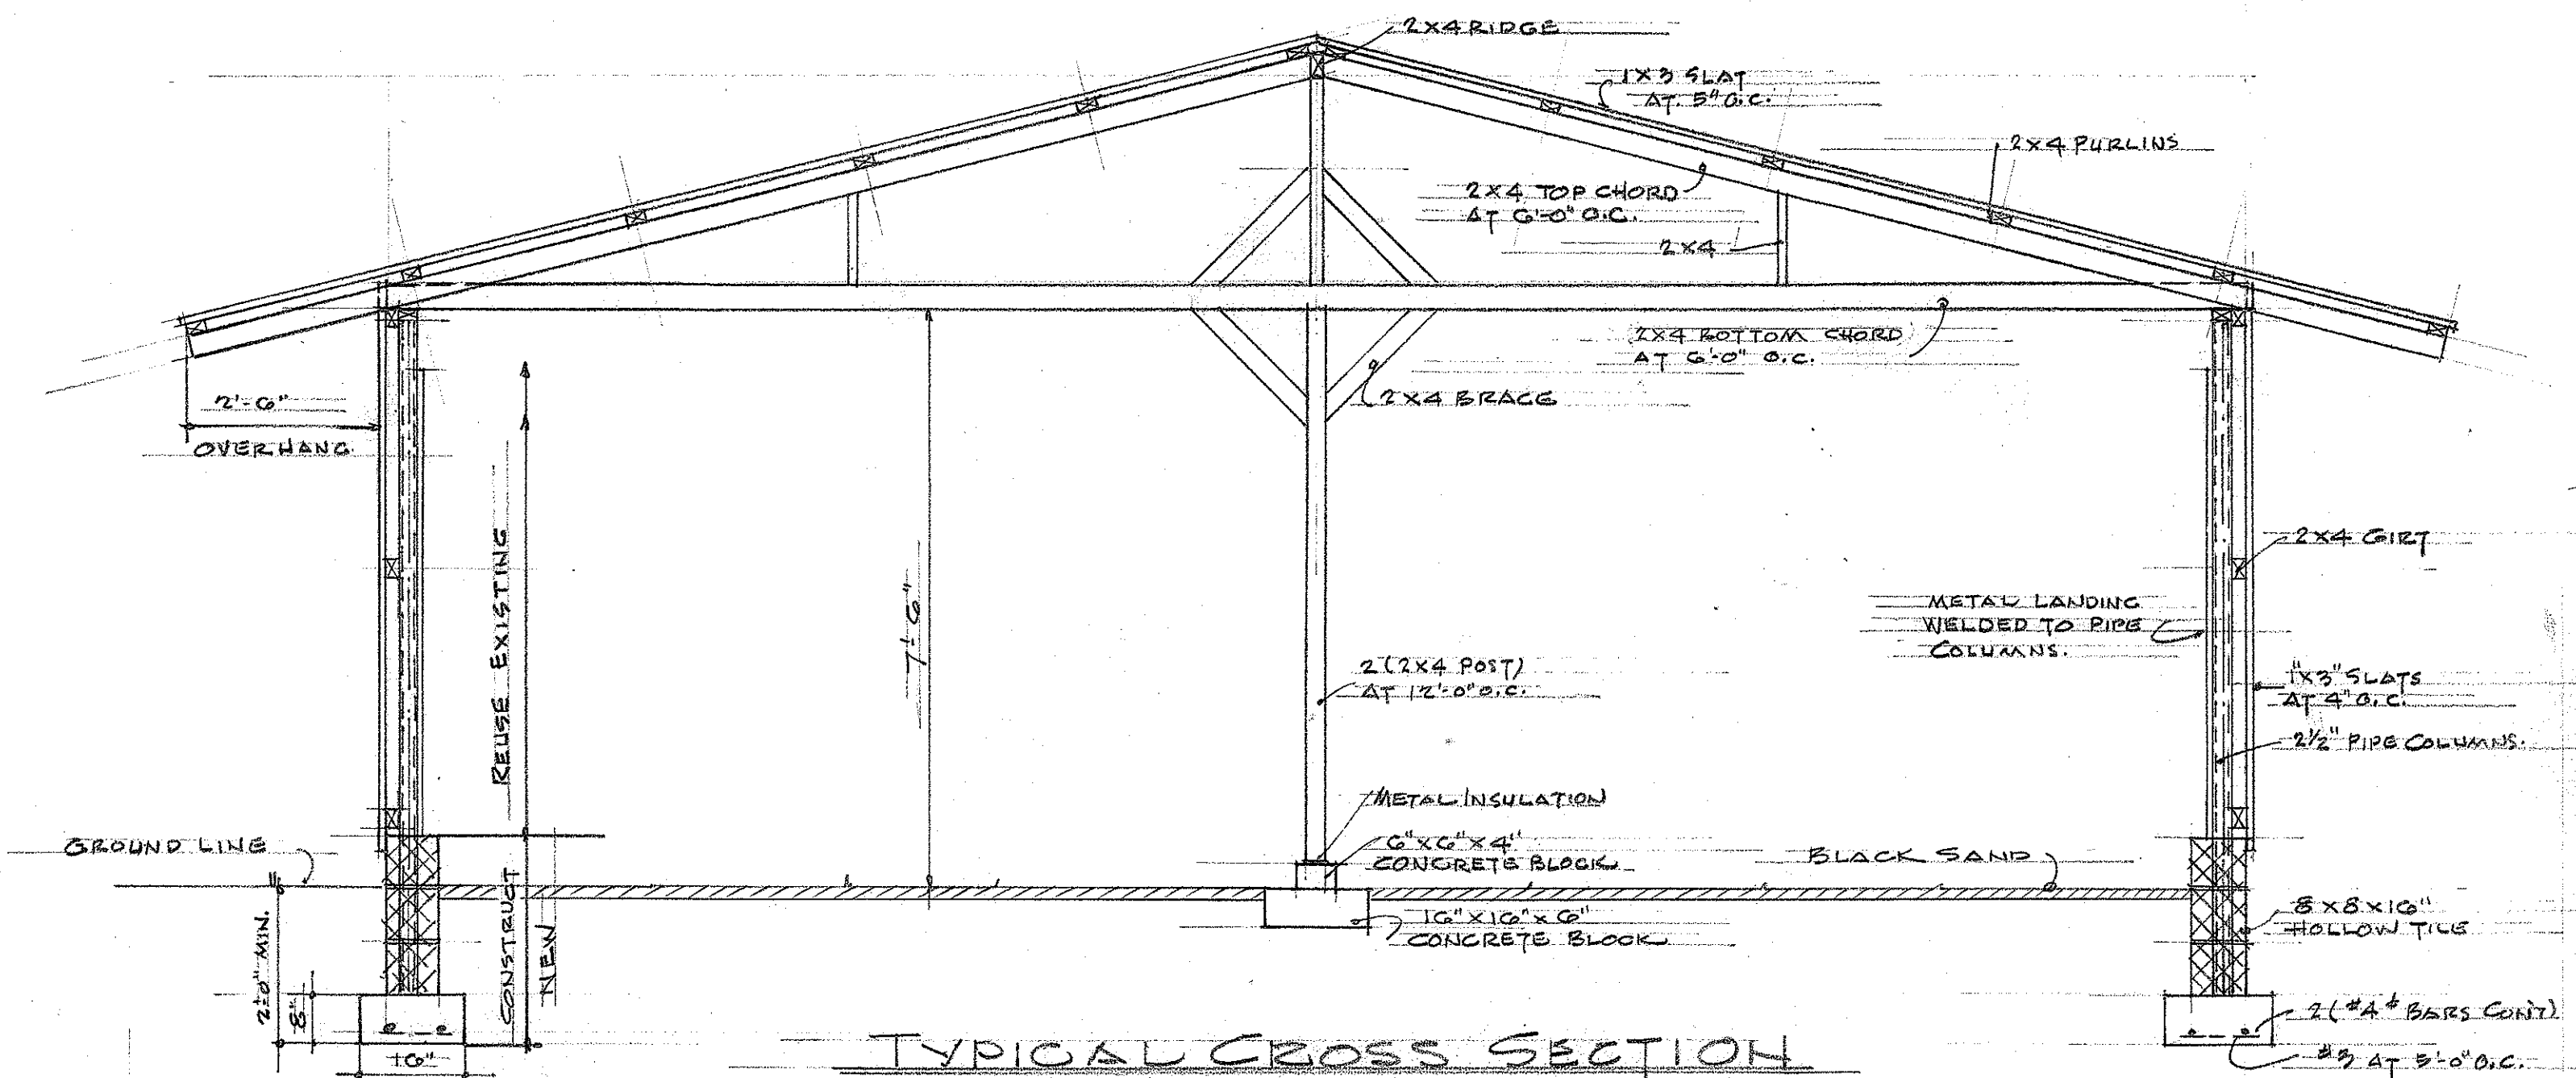


TYPICAL CROSS SECTION

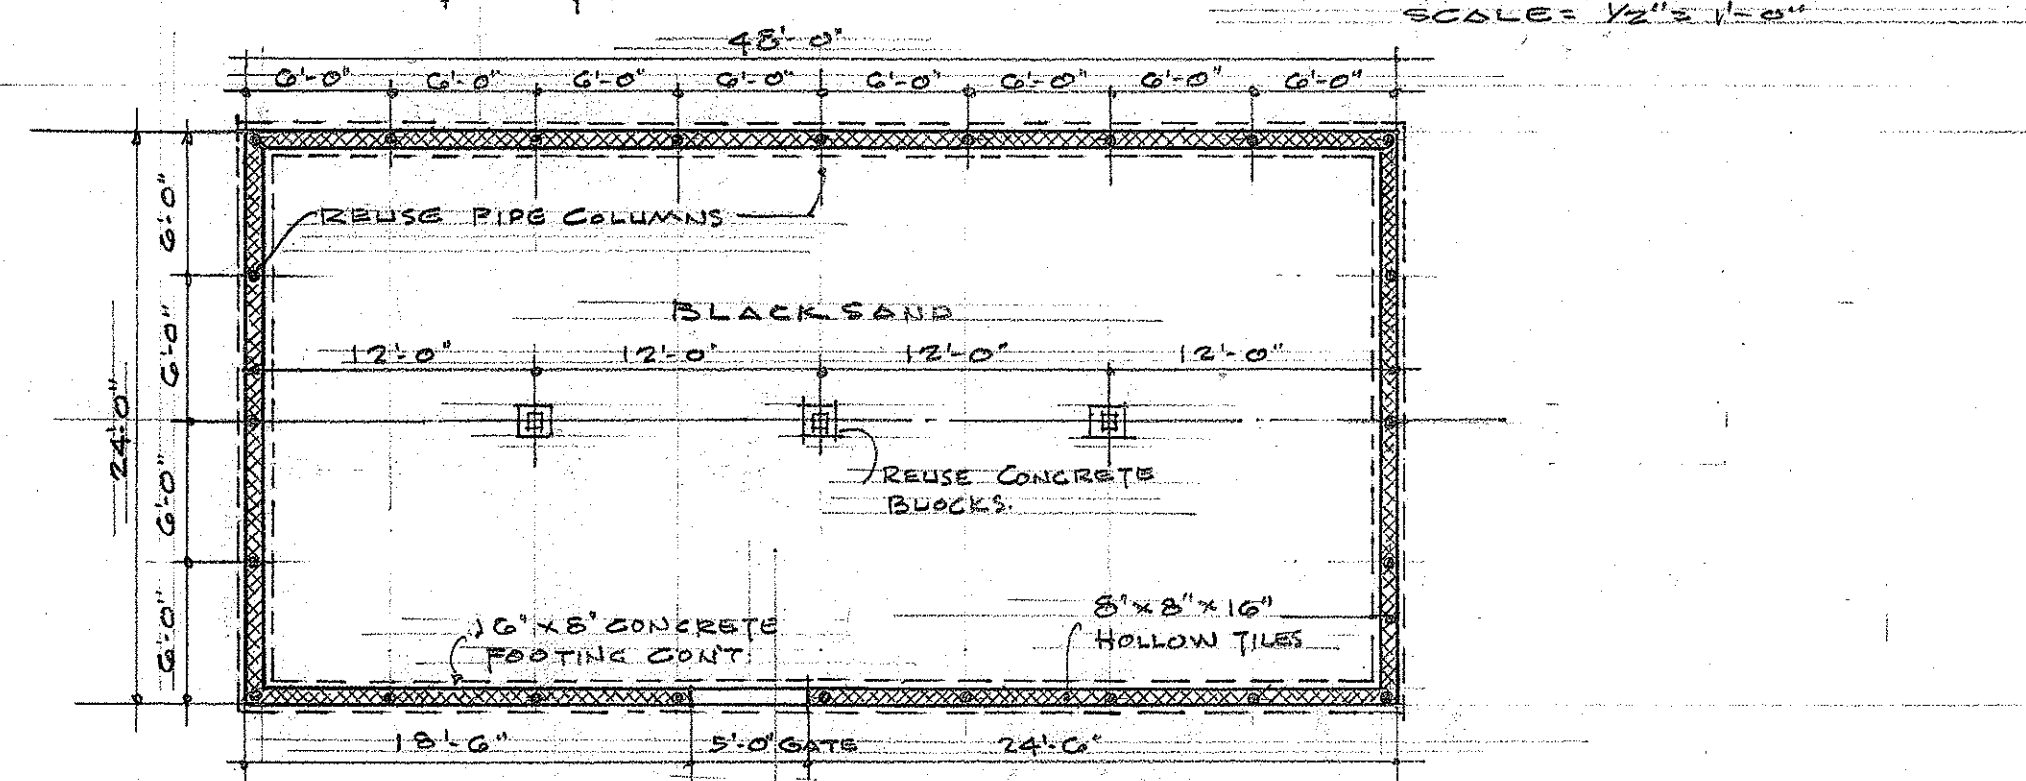


FOUNDATION PLAN

NOTE
FOUNDATION TO BE CONSTRUCTED NEW

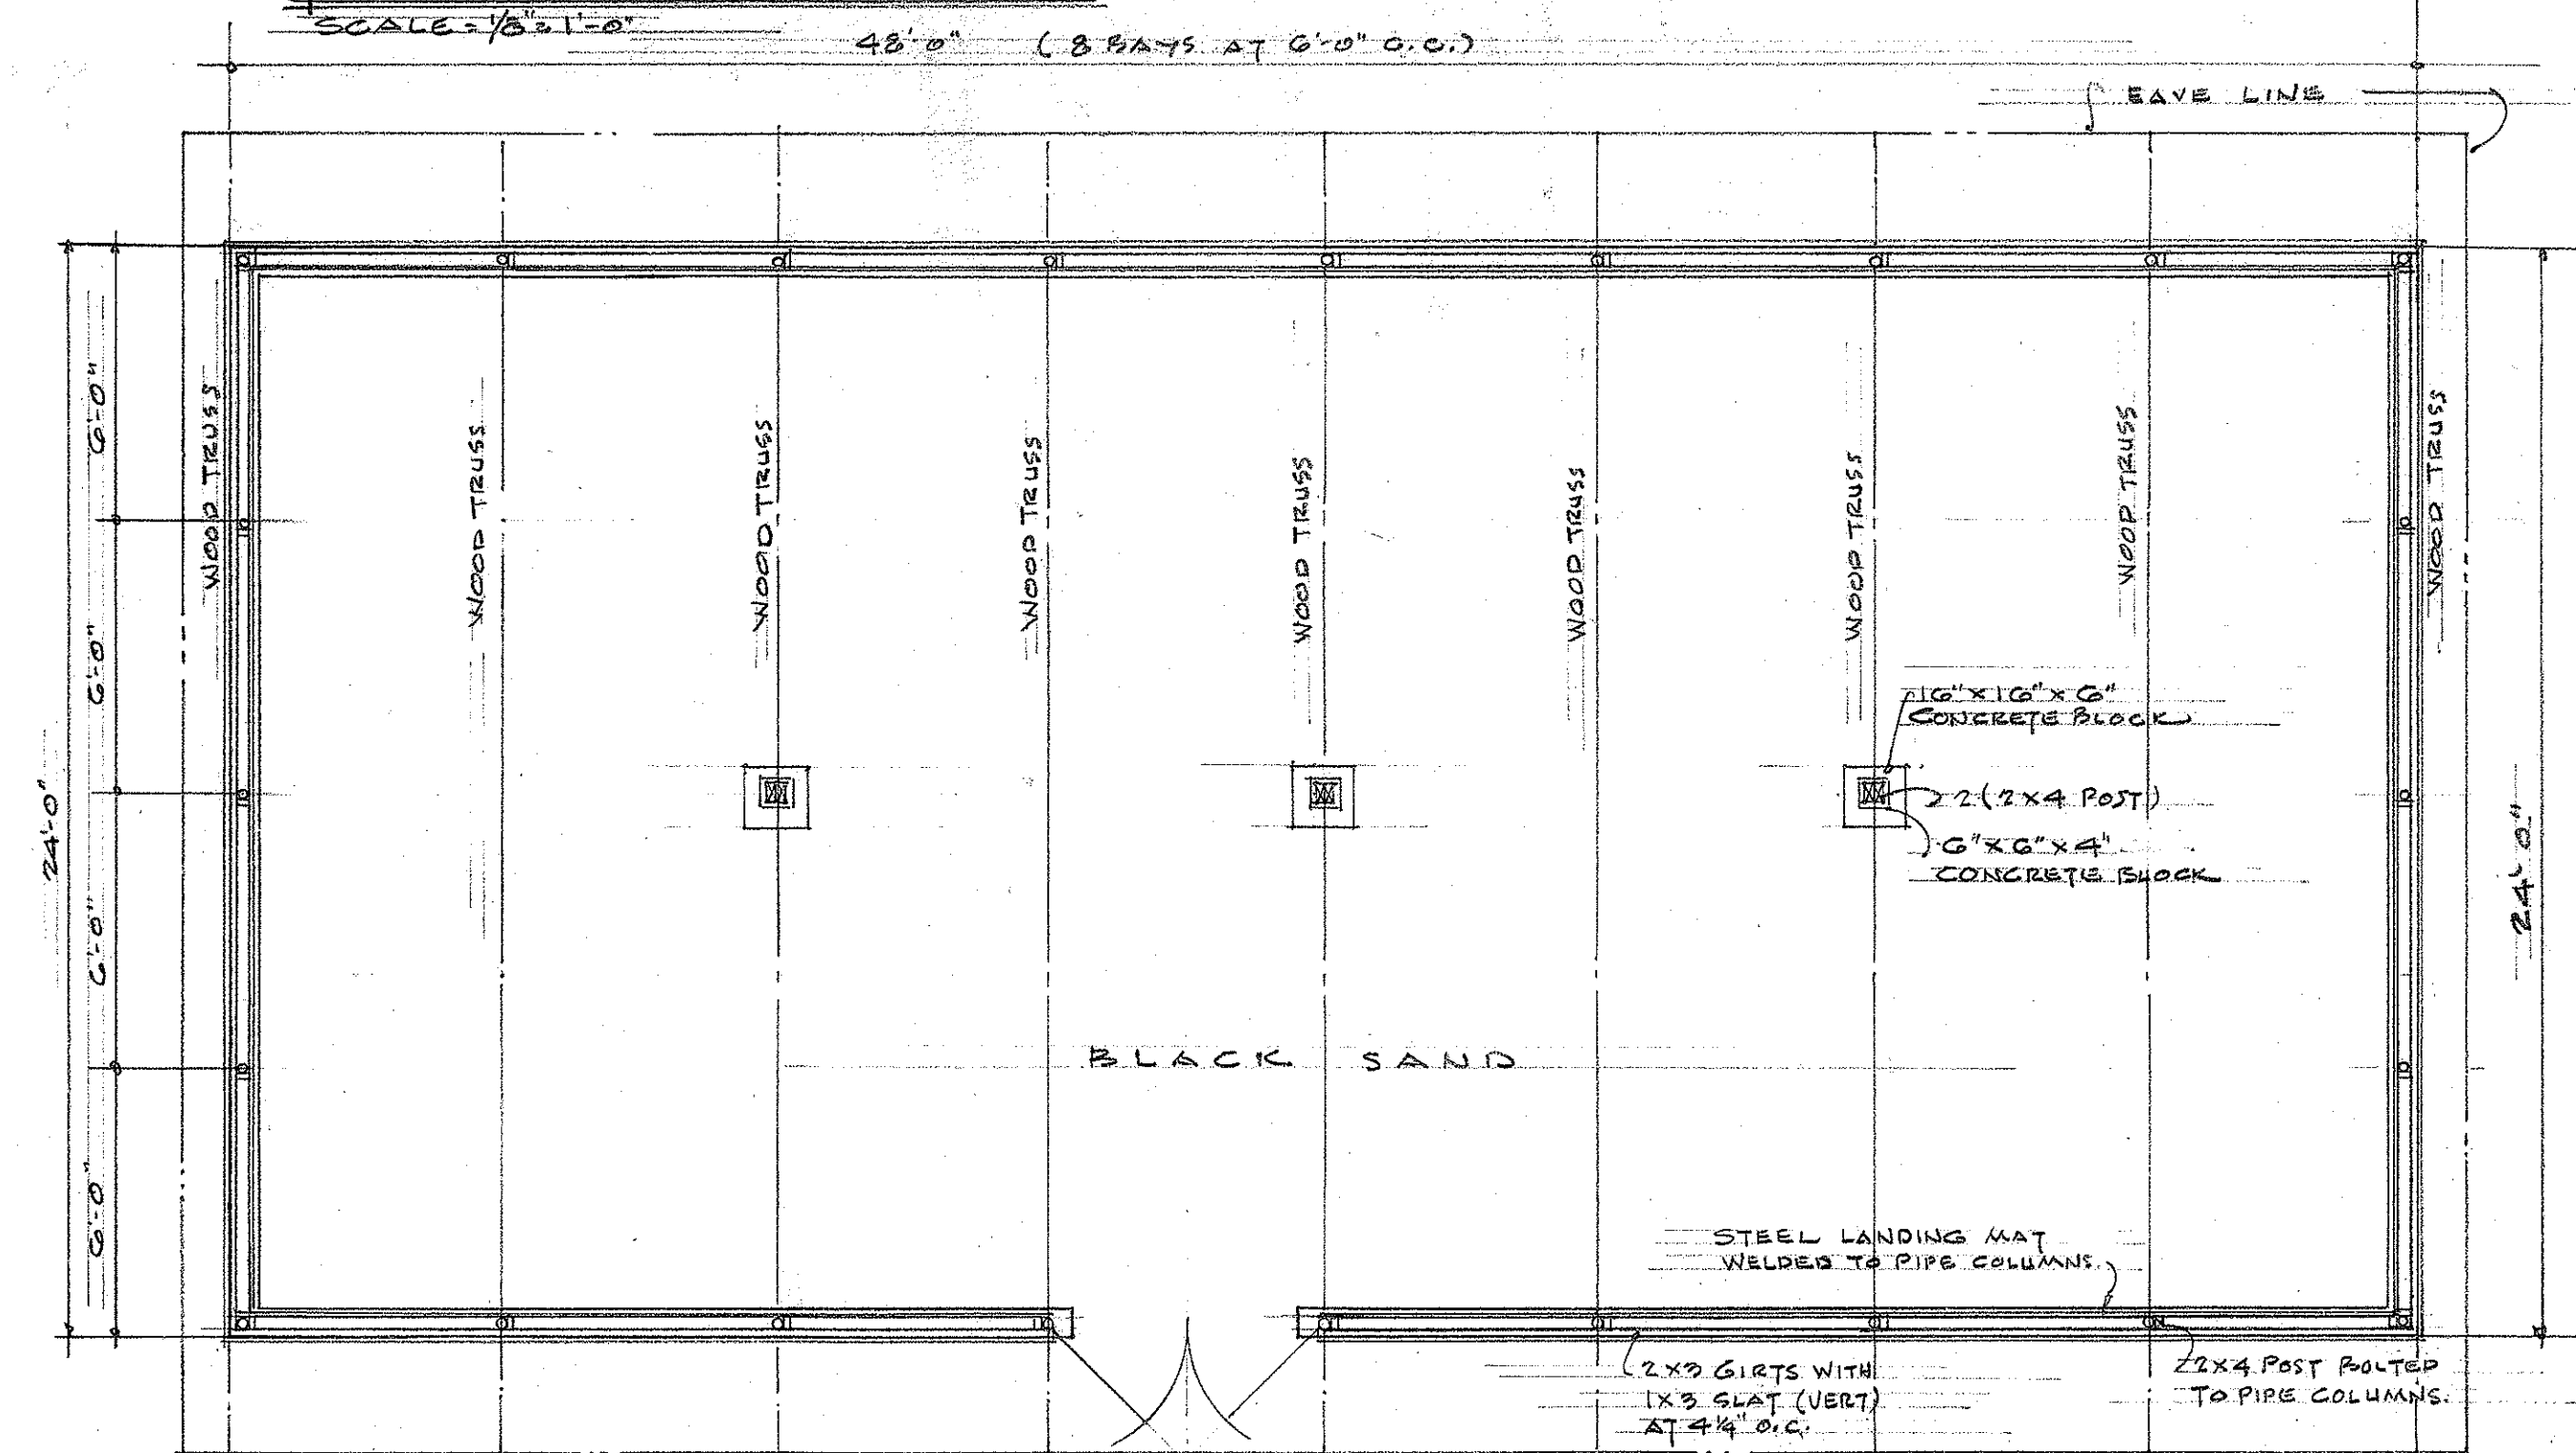


FLOOR PLAN

SCALE = $1/4" = 1' - 0"$

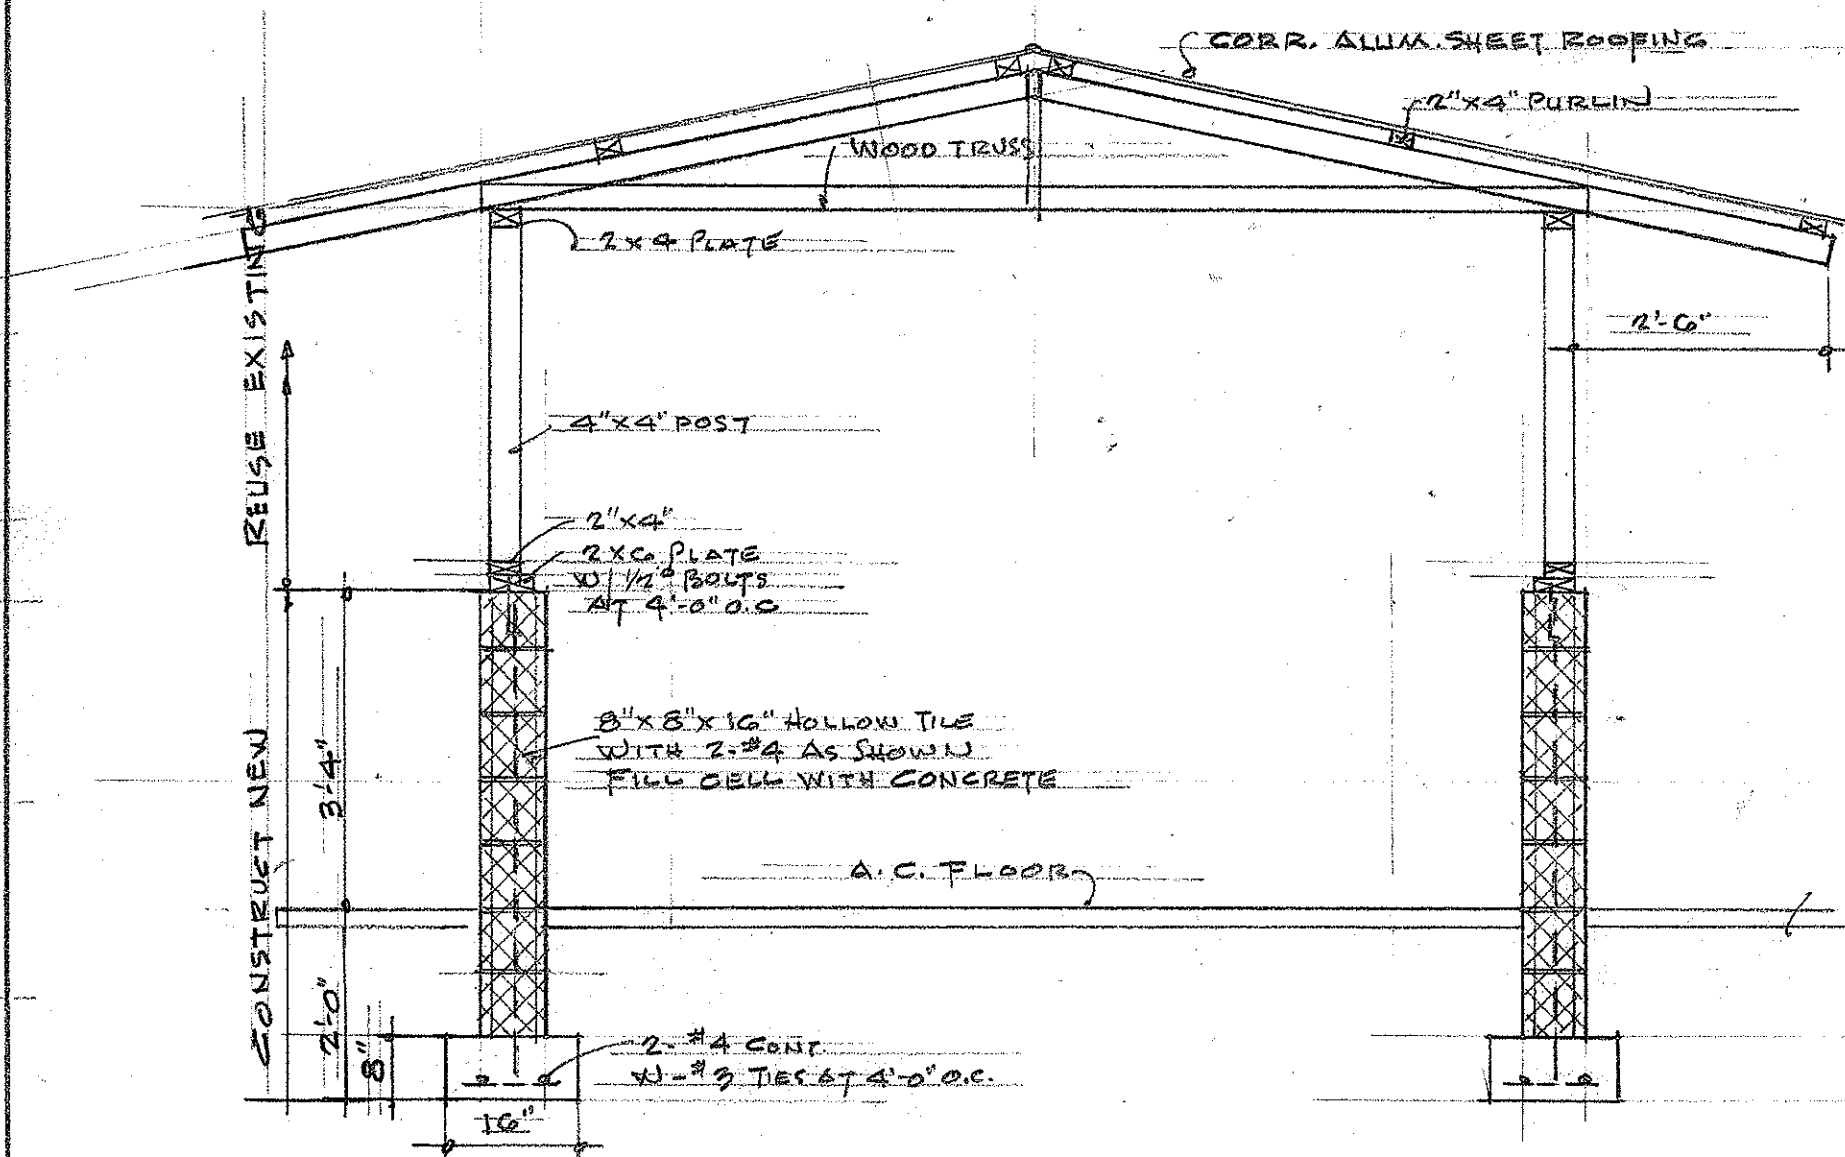

TYPICAL CROSS SECTION

SCALE = 1/2" = 1'-0"

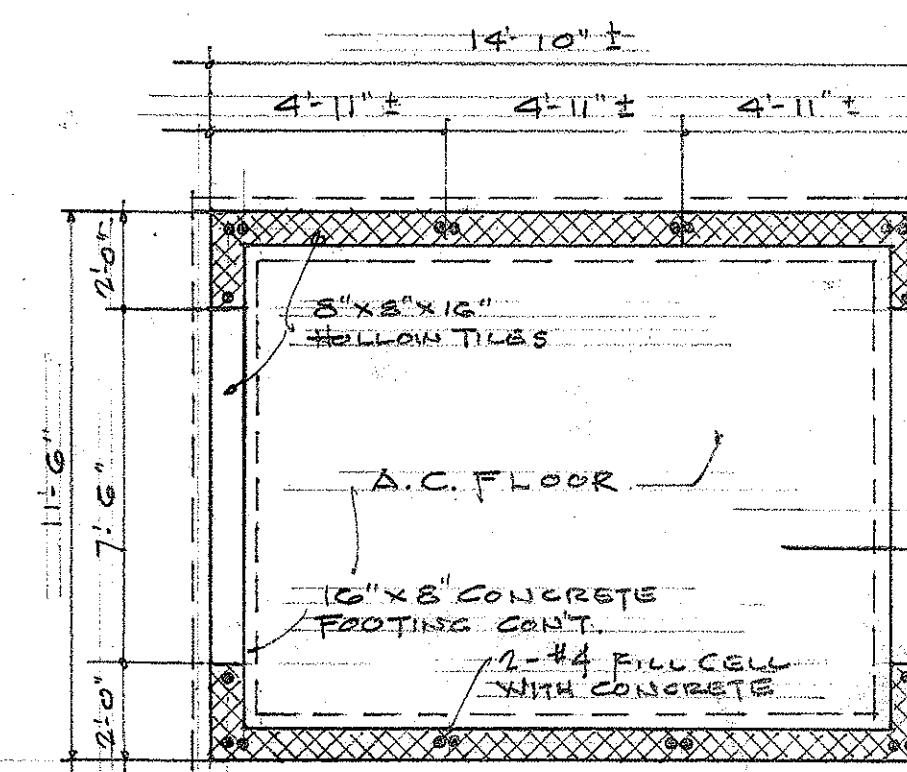


FOUNDATION PLAN

SCALE = 1/4" = 1' - 0"


NOTE

(FOUNDATION TO BE CONSTRUCTED NEW)

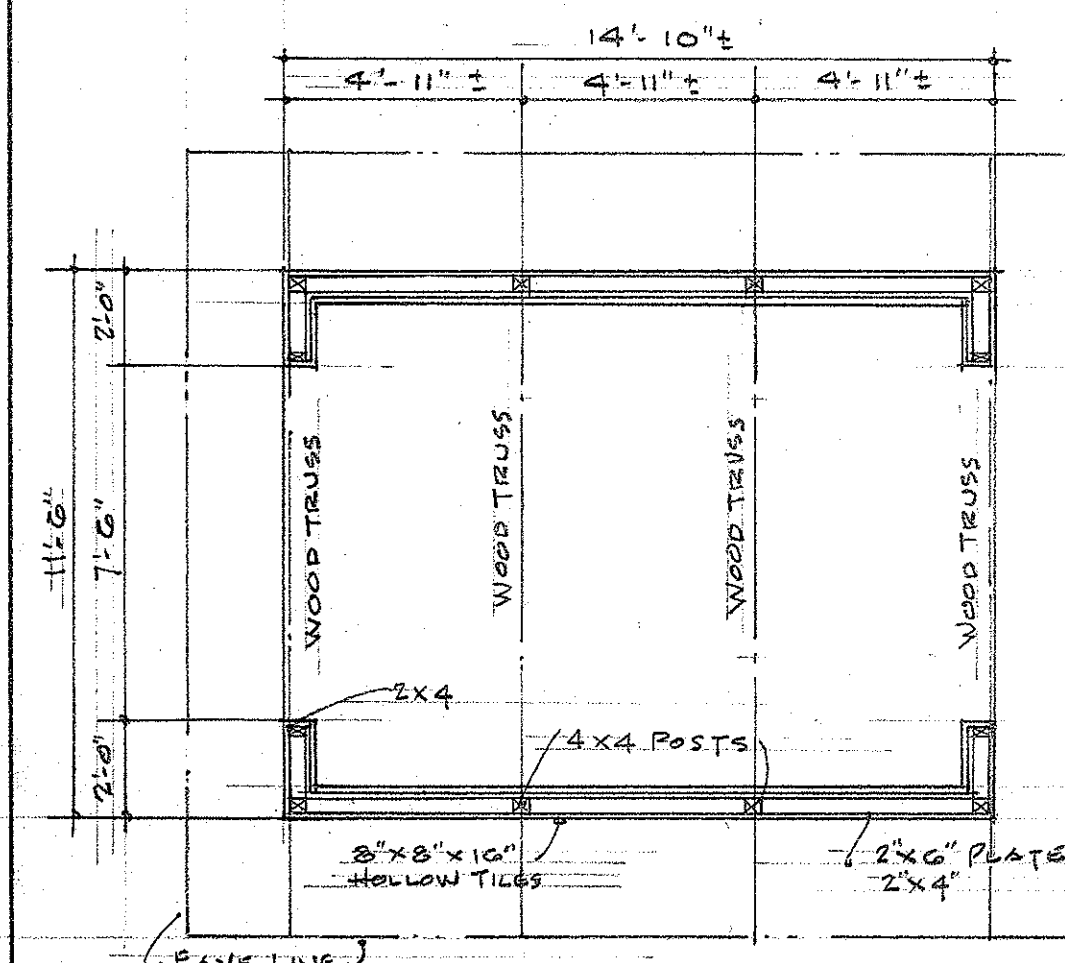

FLOOR PLAN

SCALE = 1/4" = 1'-0"

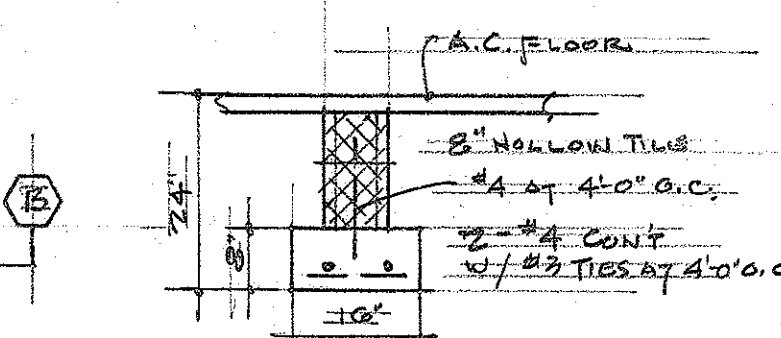

SECTION B

SCALE = $\frac{1}{2}$ " = 1'-0"

GENERAL NOTES:

- ① CONTRACTOR TO VERIFY ALL DIMENSIONS AT JOB SITE.
- ② ALL MASONRY FOUNDATION WORK TO BE CONSTRUCTED NEW.

ORIGINAL PLAN	SURVEY PLOTTED BY _____	DATE _____
NOTE BOOK	DESIGNED BY _____	" _____
	DRAWN BY <i>Philip Wong</i>	" <i>2/58</i>
	TRACED BY _____	" _____
	QUANTITIES BY _____	" _____
	QUANTITIES CHECKED BY _____	" _____
No. _____	CHECKED BY <i>P. Nishida</i>	" <i>2/58</i>

TERRITORIAL HIGHWAY DEPARTMENT
TERRITORY OF HAWAII
RELOCATION OF BUILDINGS
AND OTHER IMPROVEMENTS ON
FARRINGTON HIGH SCHOOL GROUNDS

Lunalilo Freeway

F-59(2)

Scale: As Noted

June 1958

SHEET No. 4 OF 4 SHEETS

6012.41