

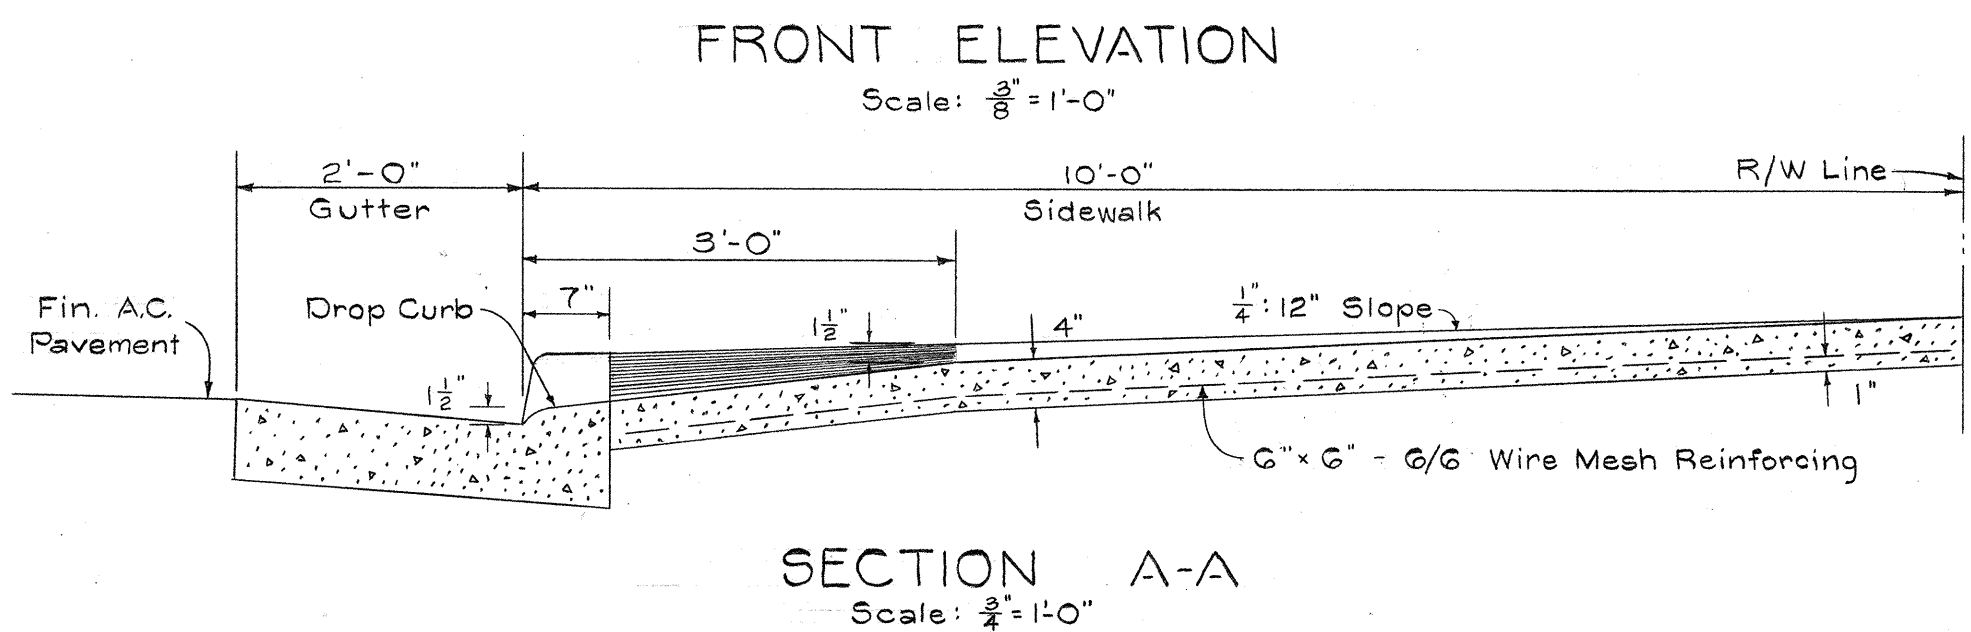



FED. ROAD DIST. NO.	STATE	FED. AID PROJ. NO.	FISCAL YEAR	SHEET NO.	TOTAL SHEETS
HAWAII	HAW.	BU-061-1(6) UNIT 3	1958	34	148
HAWAII	HAW.	F-072-1(1) UNIT 3	1958	36	148

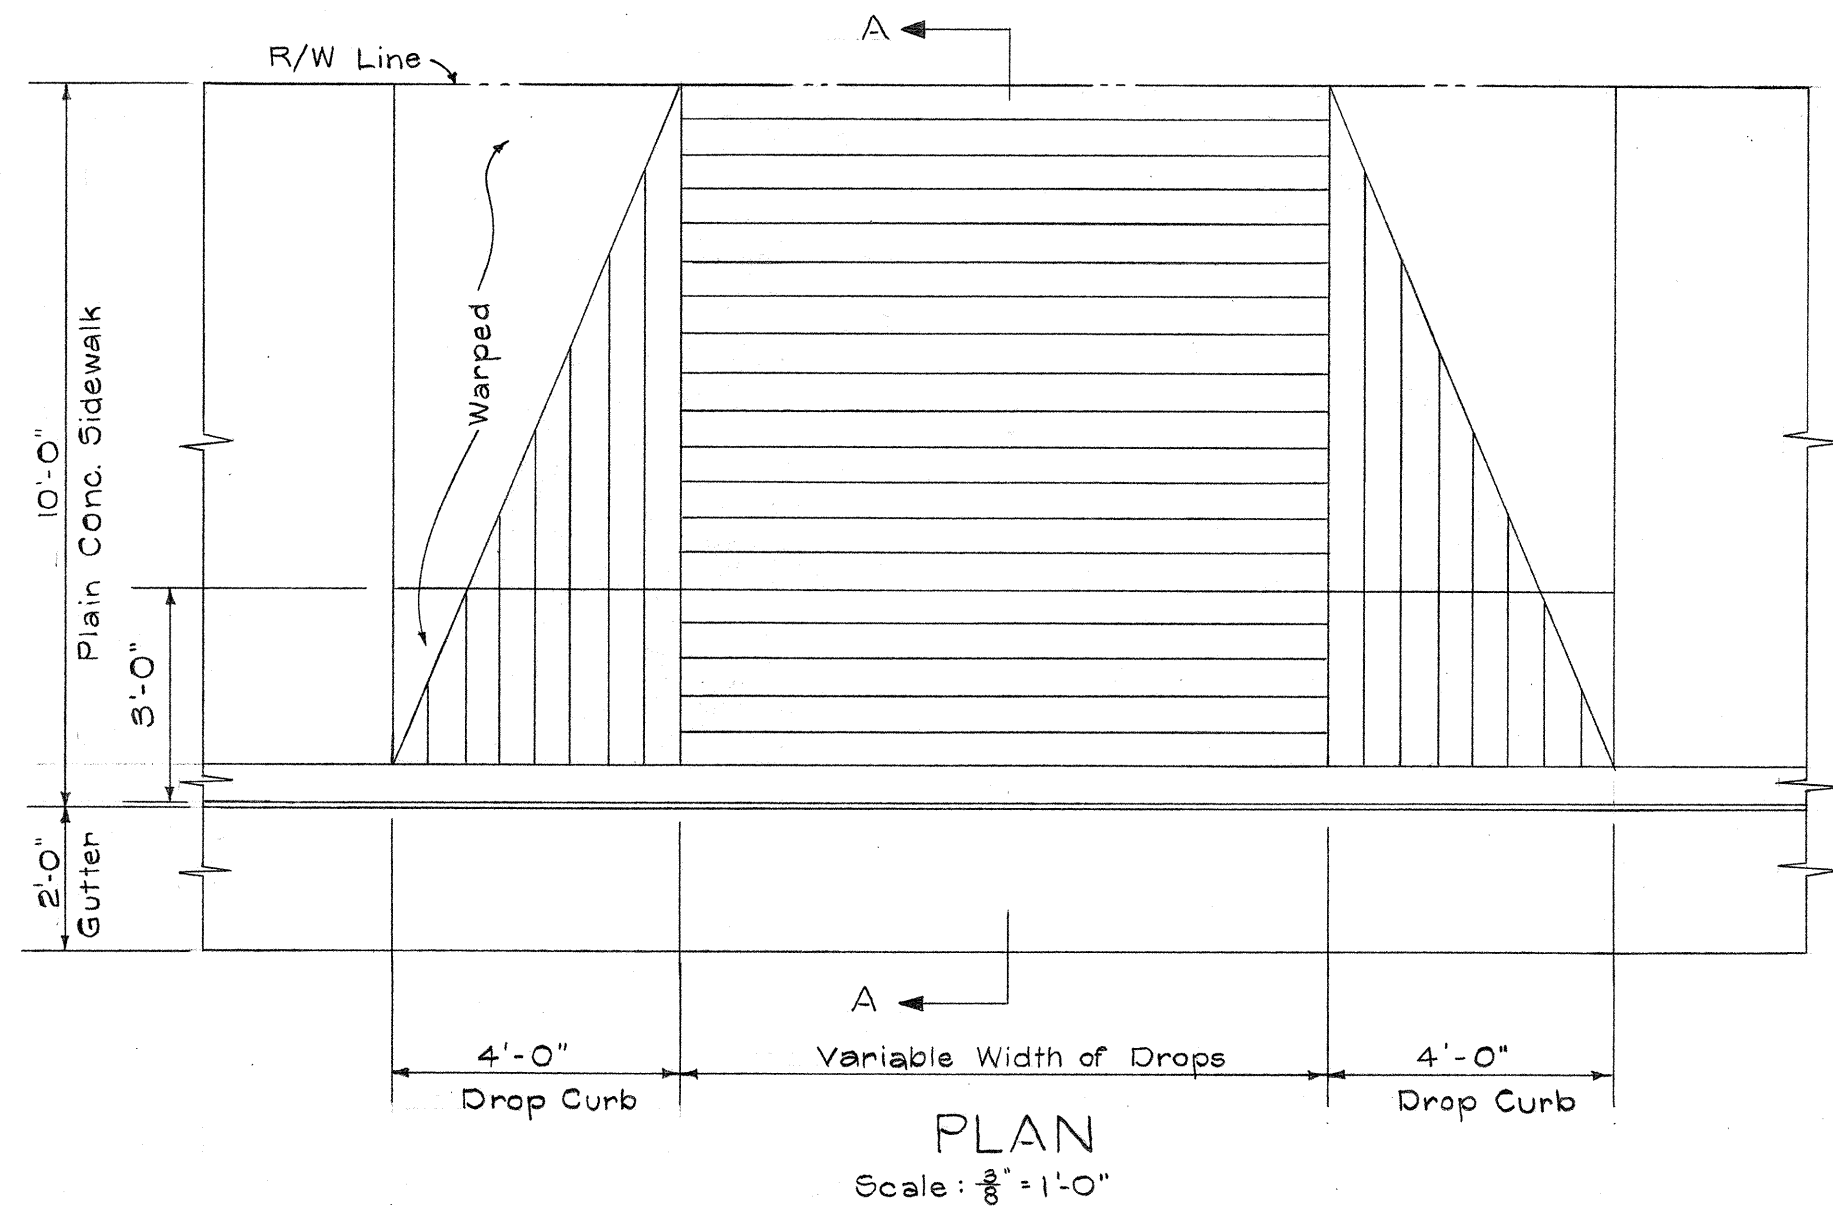


DETAIL of REINFORCED CONC. DRIVEWAY
Scale: As Noted

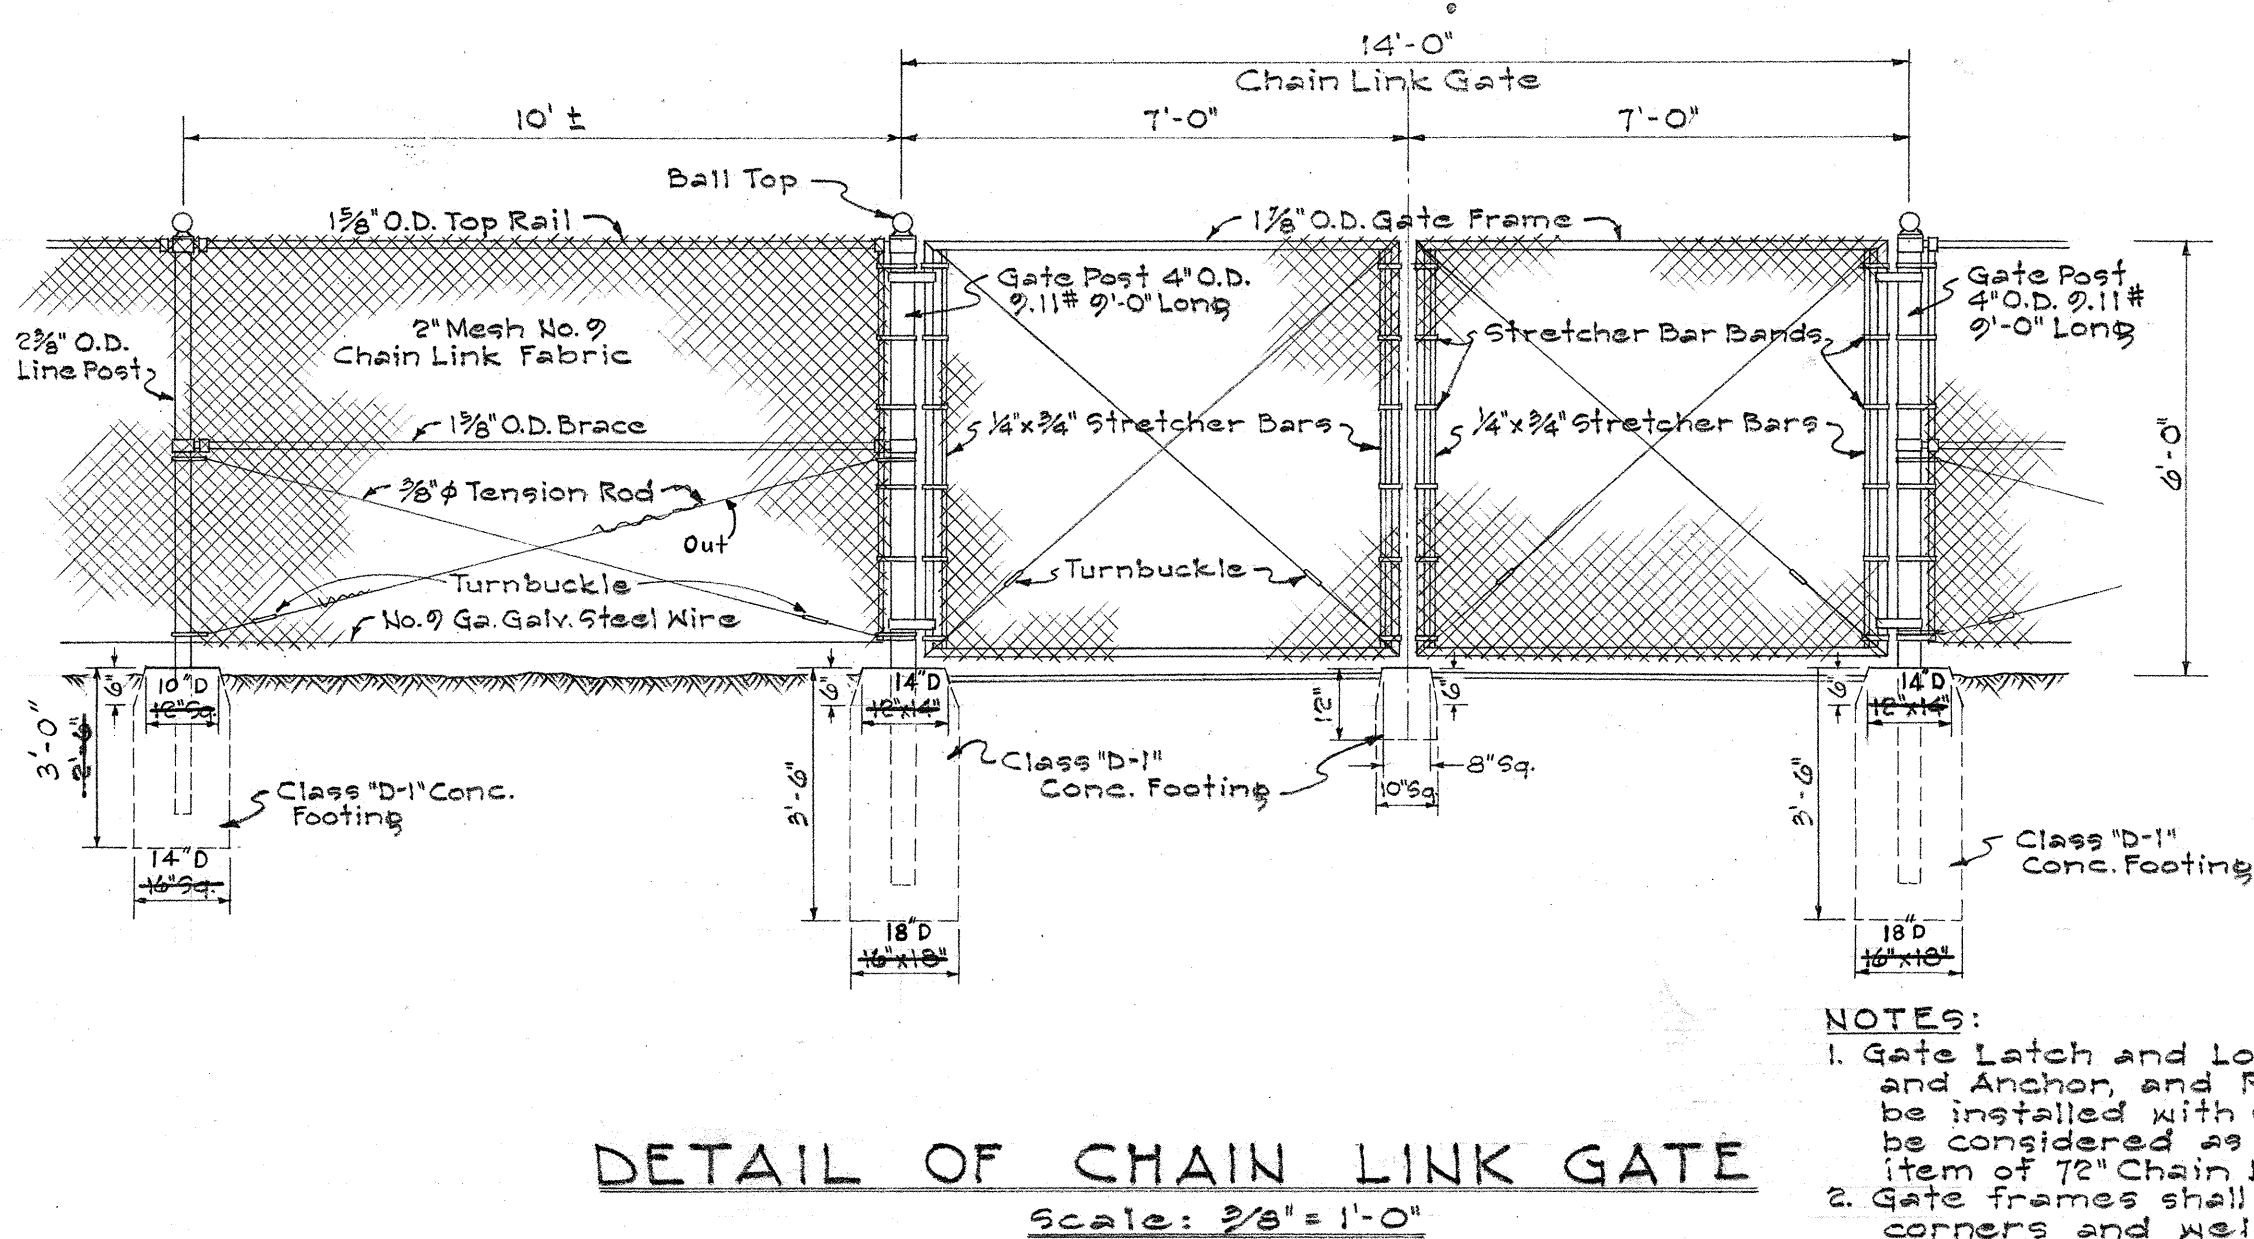



- NOTES:
- Gate Latch and Lock, Flush Plate and Anchor, and Plunger Bar shall be installed with Gates, and shall be considered as included with item of 72" Chain Link Gate.
 - Gate frames shall be mitered at corners and welded.
 - Fence details not shown are to be in accordance with standard Specification.

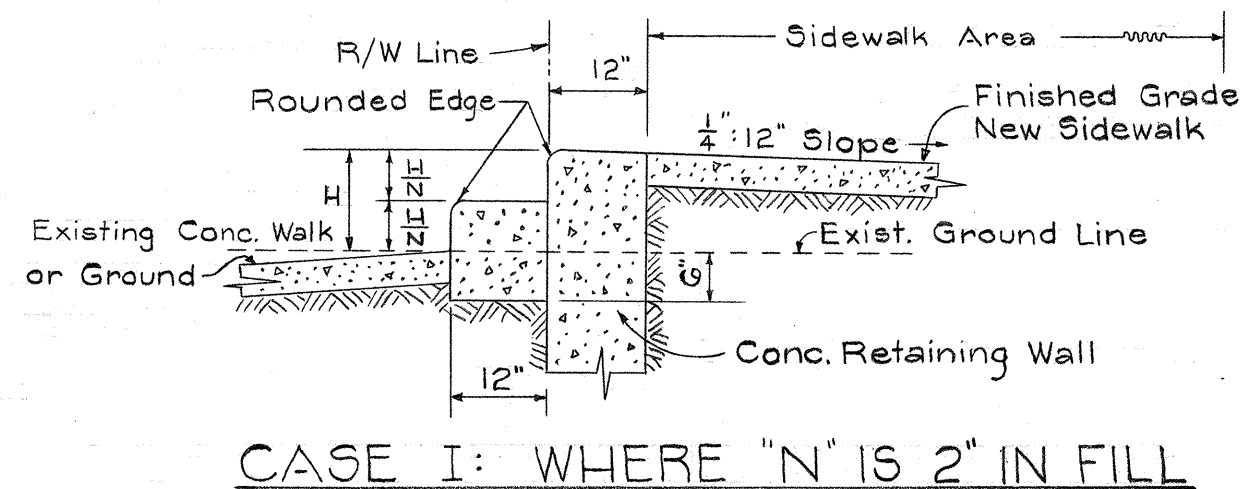


- NOTES:
- H = Difference in elevation.
 - N = Number of risers (Varies to fit actual conditions)
 - H = As nearly 6" as possible, but at no time greater than 7"
 - Top surface of concrete steps (Threads) shall have a rough wearing surface produced by sprinkling 1/2 sq. ft. #3, #16 Aloxi or equal in fresh concrete and finishing it with a wood trowel. This item is considered incidental to class A-1 concrete. All other exposed surface shall have Class 2 rubbed finish.

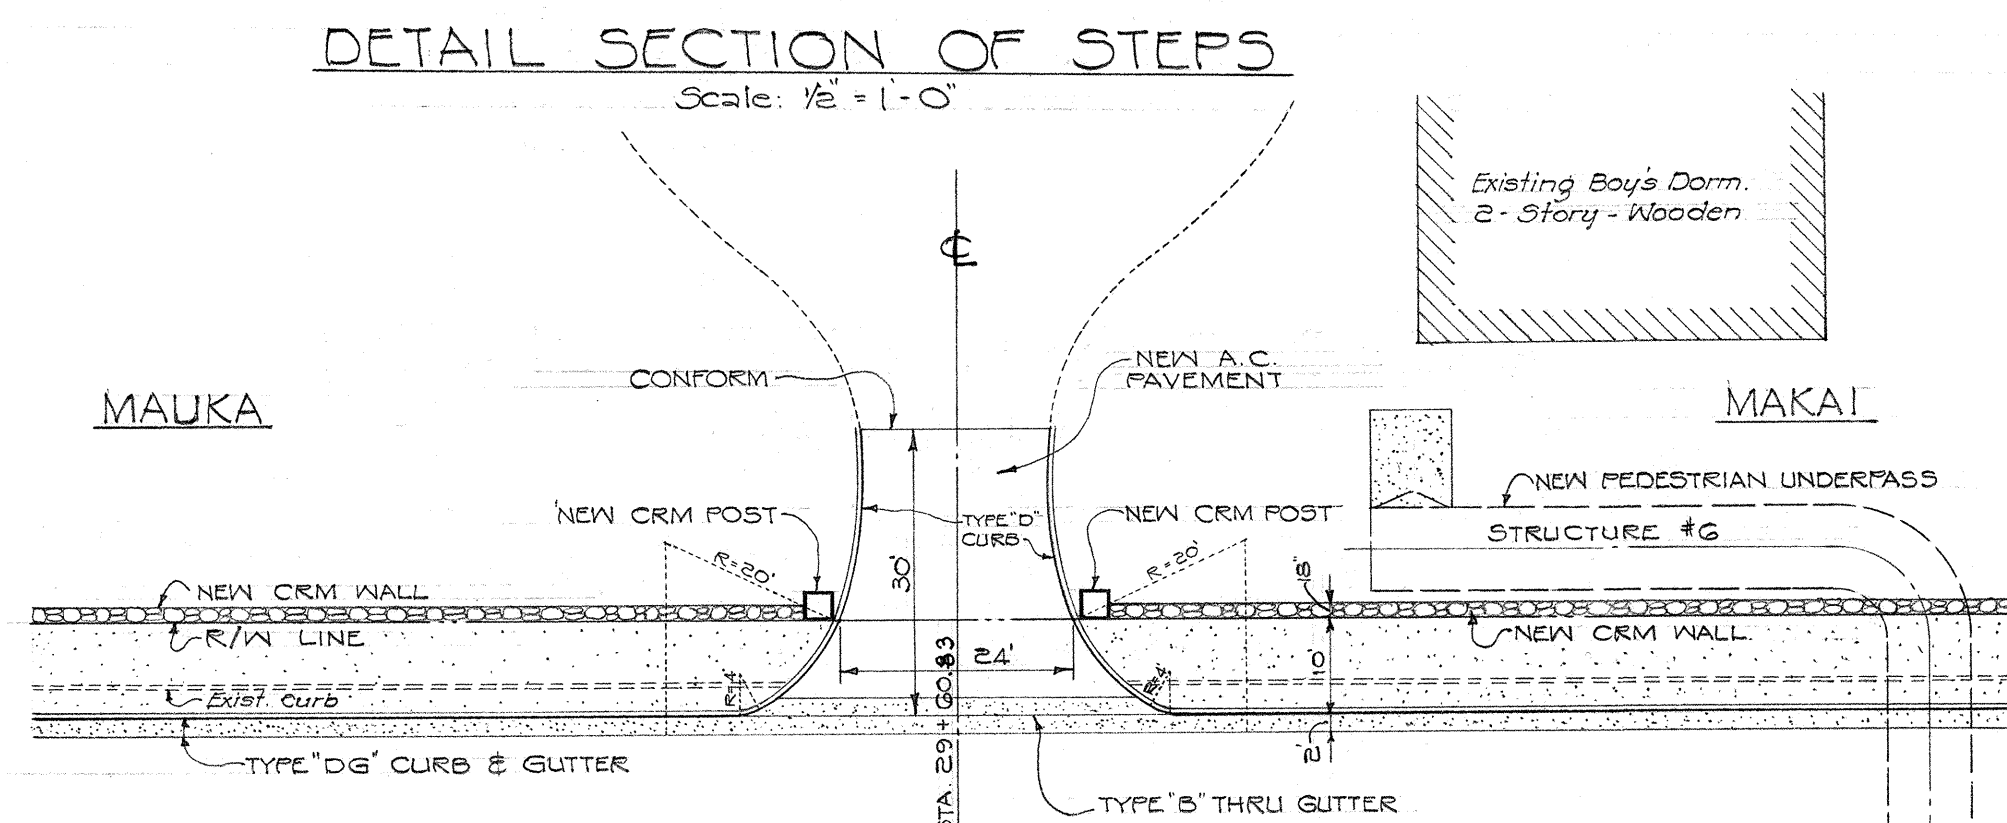


LOCATION PLAN - ENTRANCE TO HONGWANJI TEMPLE
Scale: 1" = 20'

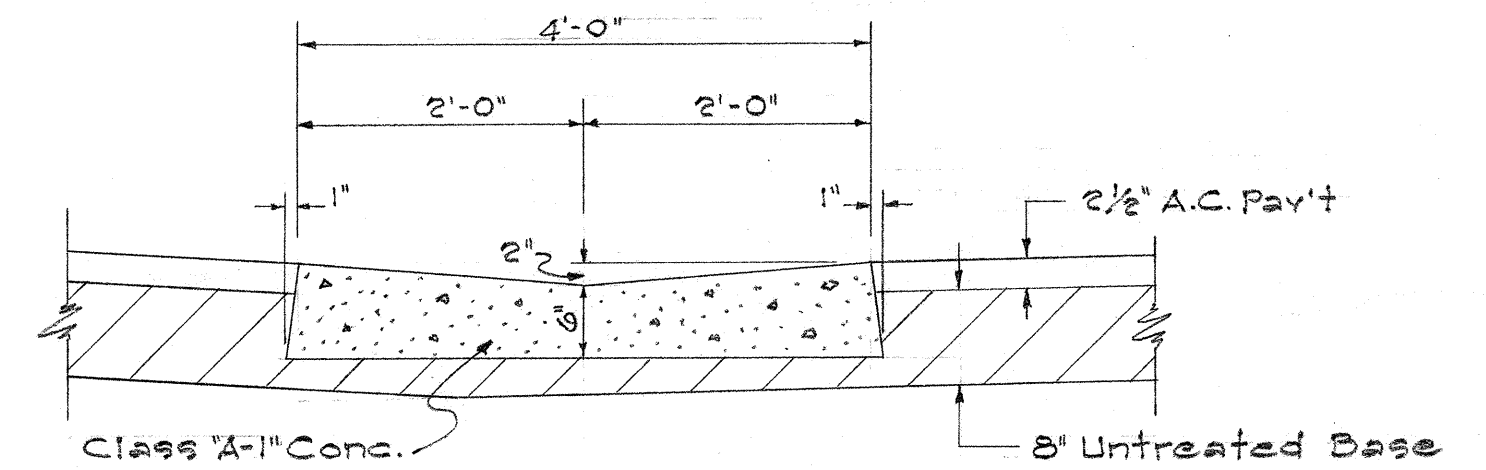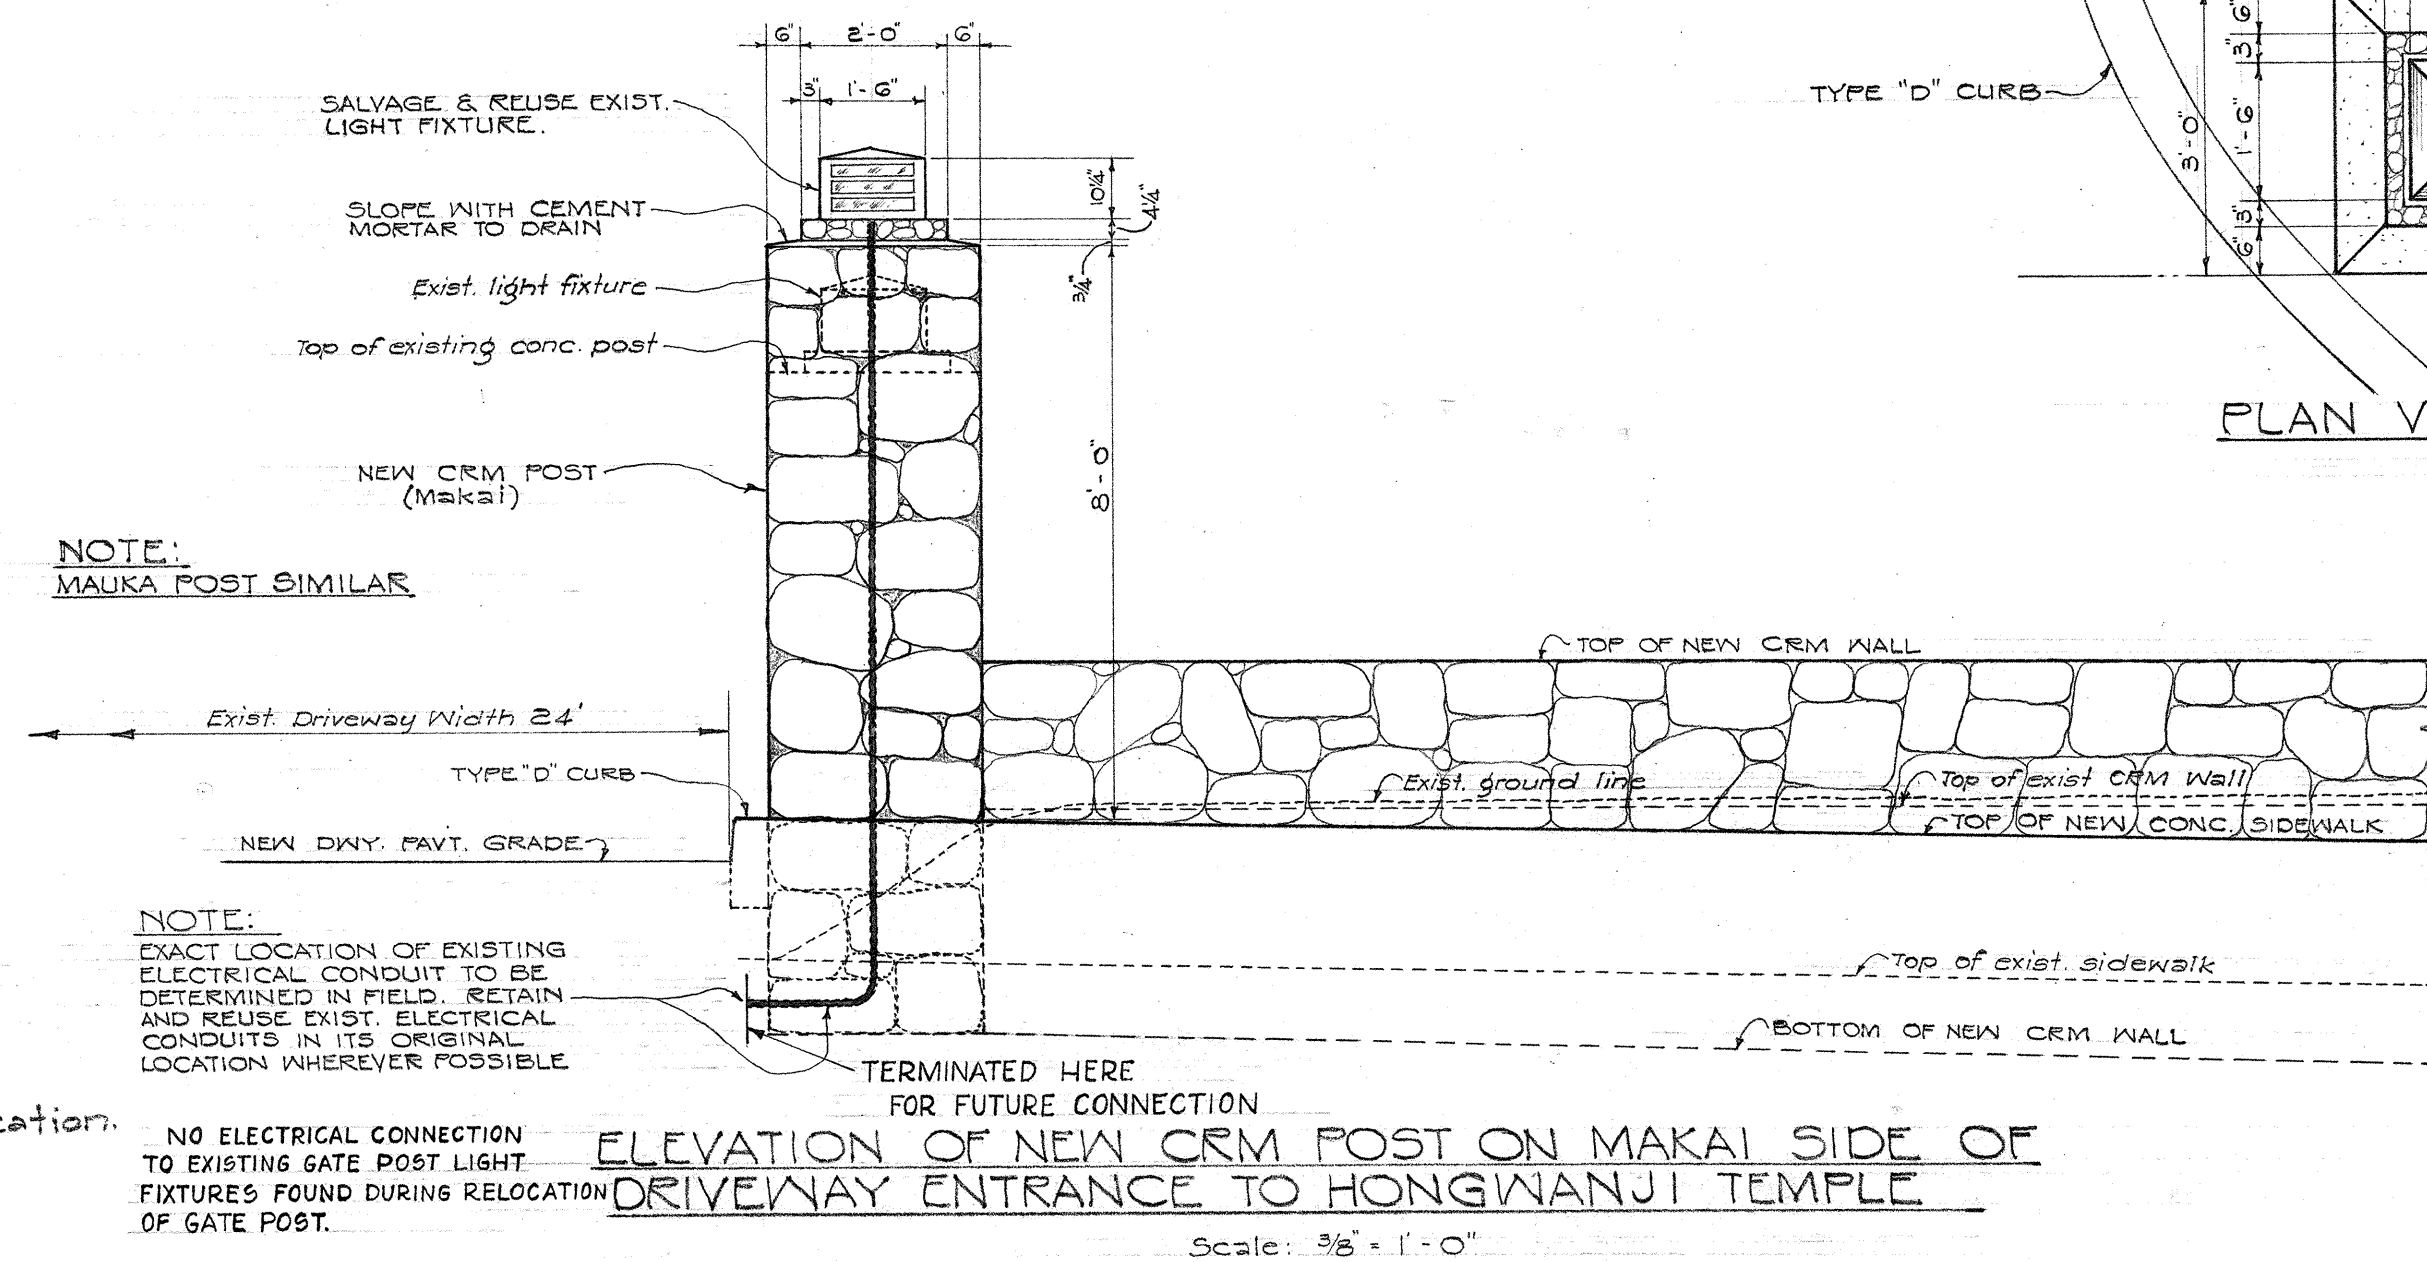


DETAIL OF TYPE "B" CONC. GUTTER
Scale: 3/4" = 1'-0"

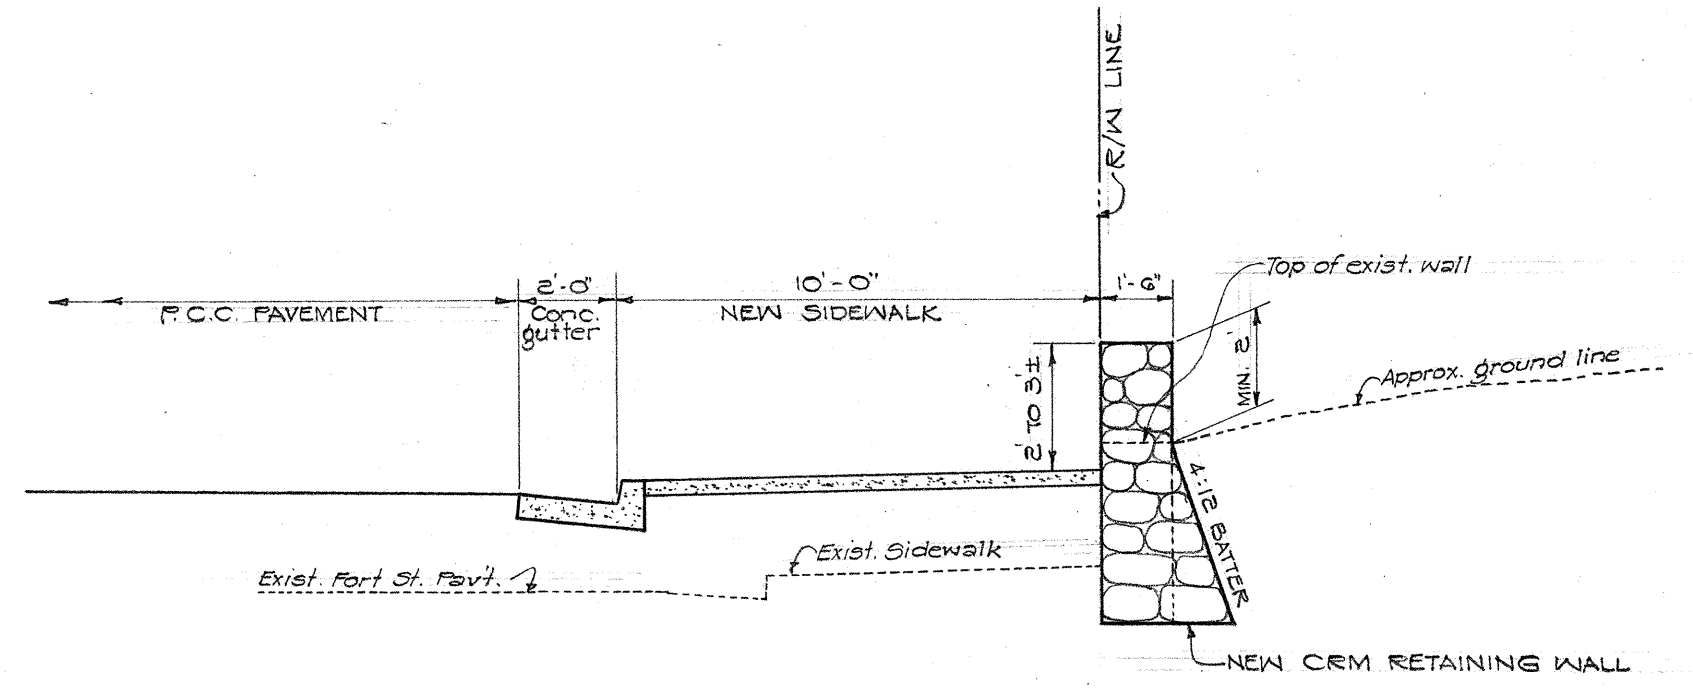

MAKAI TYPICAL WALL SECTION
Scale: 1/4" = 1'-0"

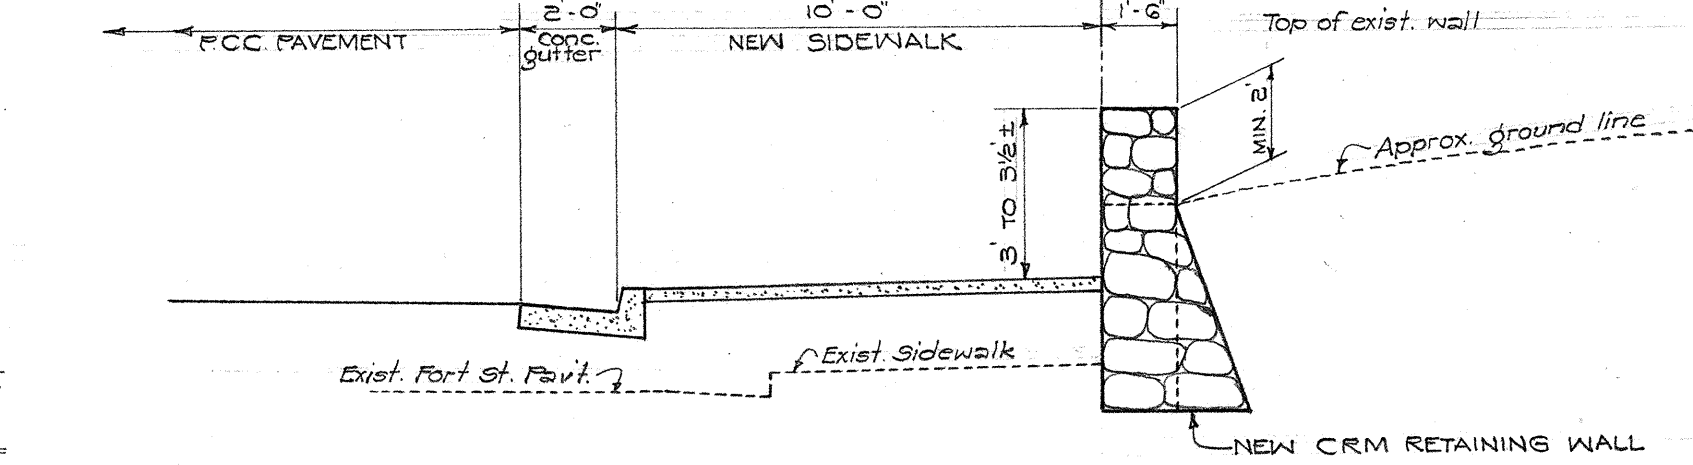

MAUKA TYPICAL WALL SECTION
Scale: 1/4" = 1'-0"

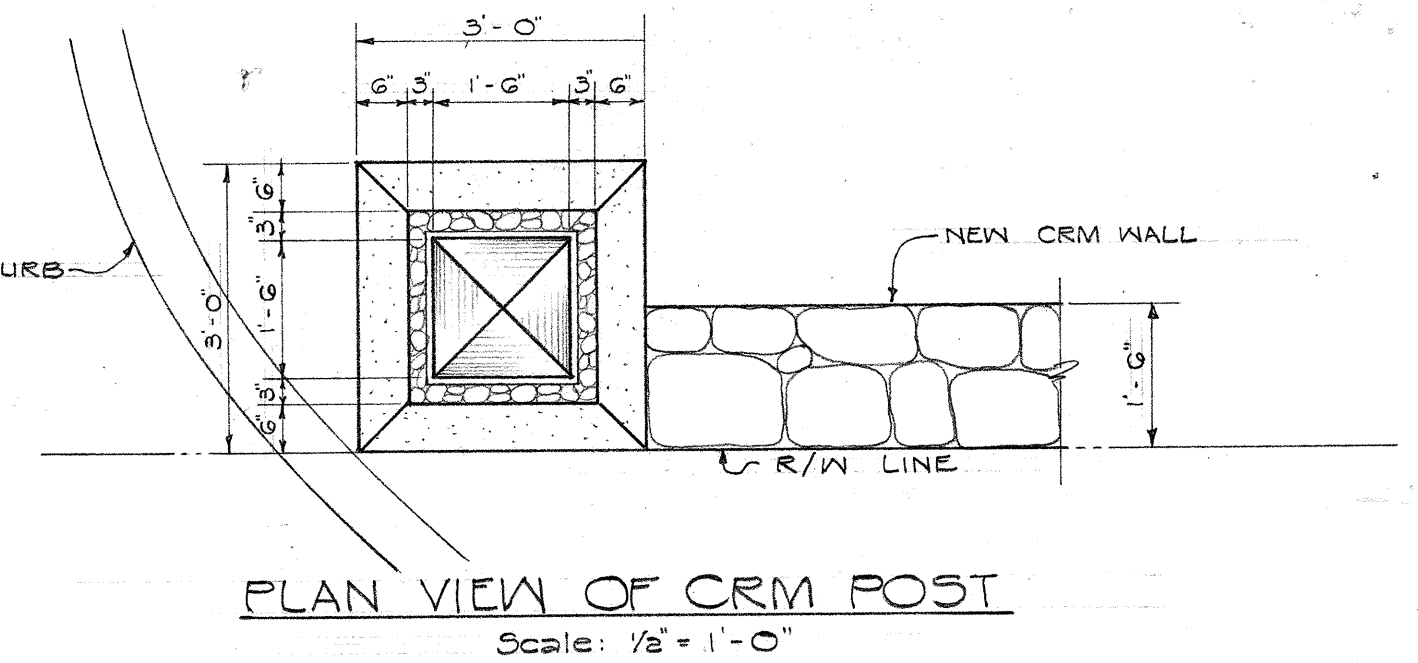

TERRITORIAL HIGHWAY DEPARTMENT
TERRITORY OF HAWAII
MISCELLANEOUS DETAILS
LUNALILO FREEWAY
PROJECT NO. F-072-1(1) UNIT 3
INUUANU HIGHWAY
PROJECT NO. BU-061-1(6) UNIT 4
SCALE: AS NOTED
SEPT. 1958

SHEET No. OF SHEETS