


• FREEWAY PROFILE •

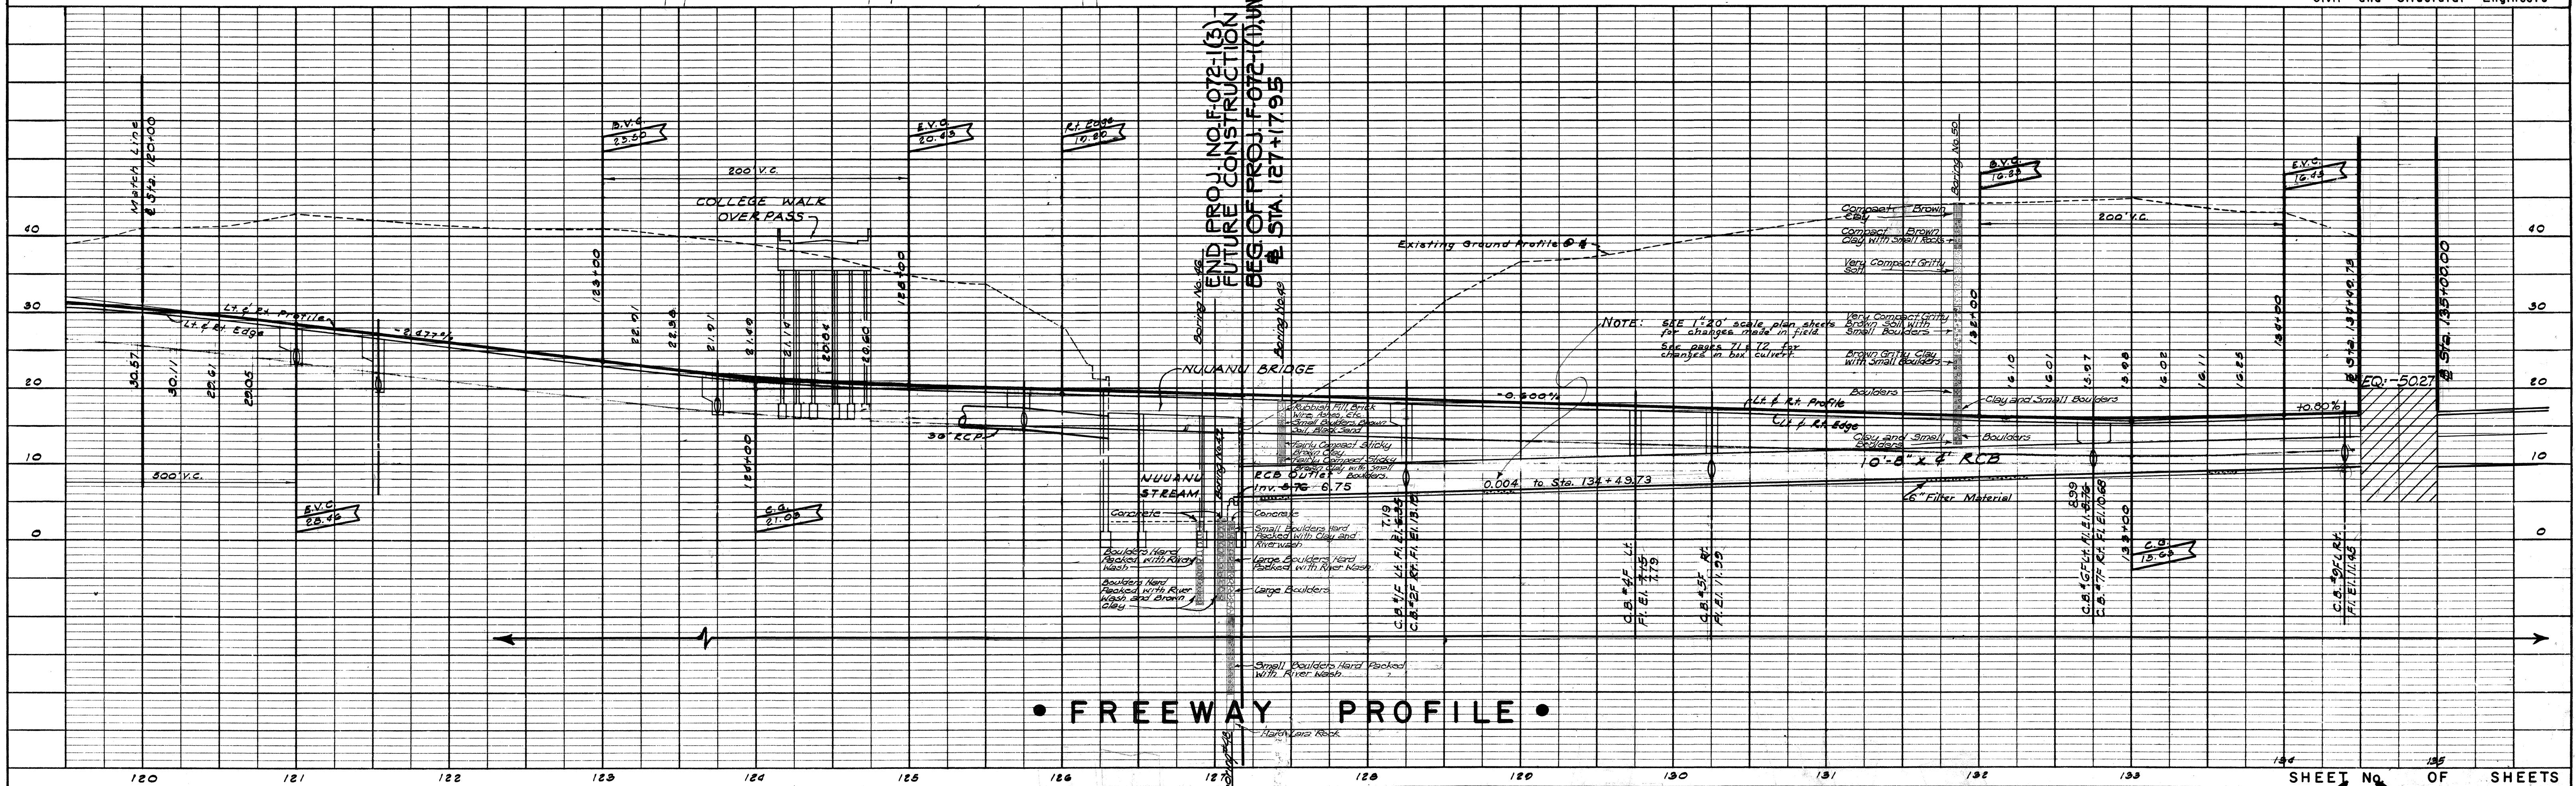

BELT, COLLINS & ASSOC., LTD.
Civil and Structural Engineers

NOTE:
AZIMUTH & COORDINATES ARE
REFERRED TO PUNCHBOWL Δ.
BENCHMARKS ARE REFERRED
TO M.S.L. DATUM.

LEGEND


- EXISTING STREETS, SIDEWALKS, DRIVEWAYS, ETC.
- SLAB, CONCRETE EXIST.
- WALL, ROCK, C.R.M., BRICK, ETC.
- FENCE, CHAIN LINK
- FENCE, OTHER
- TREES, IDENTIFIED AS FOLLOWS: M.P.-MONKEY
POD S-SHOWER, G.S.-GOLDEN SHOWER,
B-BANYAN, C-COCONUT
- BP-2 BORING LOCATIONS
- BP-32

Note: See 1"=20' Scale
Plan Sheet For
Changes Made in
Field.

FED. ROAD DIST. NO.	STATE	FED. AID PROJ. NO.	FISCAL YEAR	SHEET NO.	TOTAL SHEETS
HAWAII	HAW.	F07210	1958	8	178

PLAN	DATE	BY	DATE
SURVEYED		R.B.T.	
NOTED			
NO.			

PROFILE	DATE	BY	DATE
SURVEYED		R.B.T.	
NOTED			
NO.			

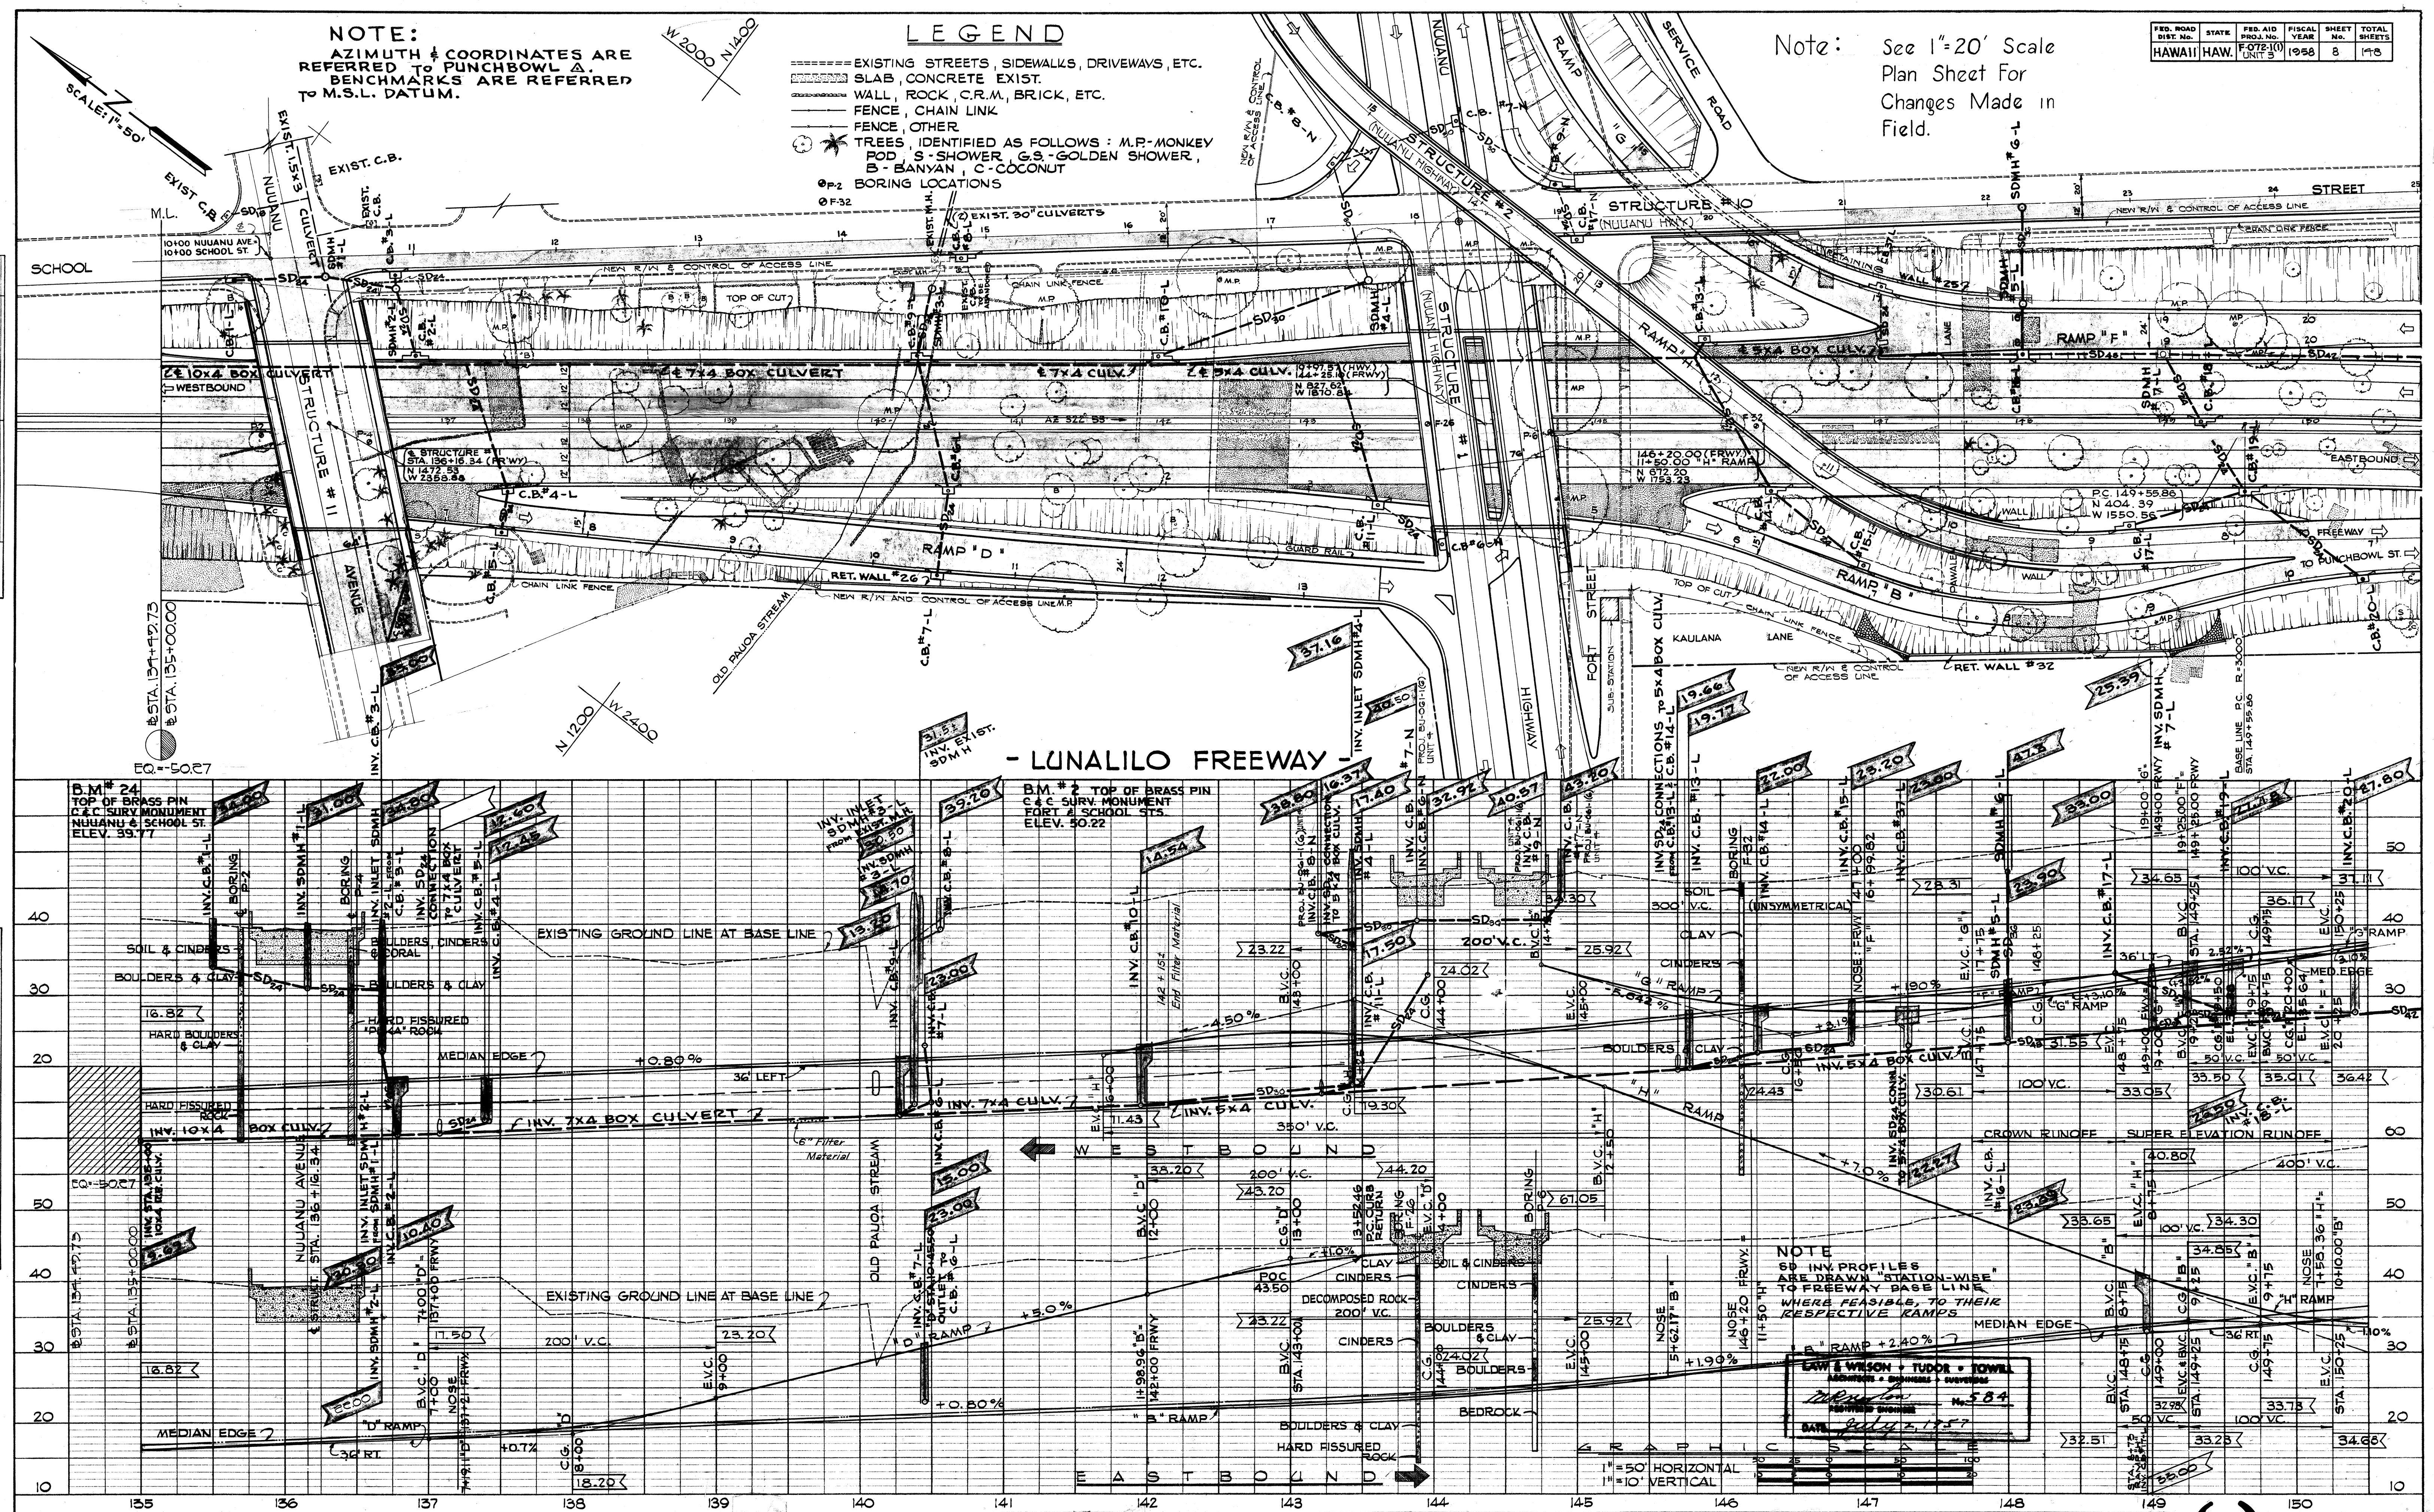


- LUNALILO FREEWAY -

NOTE
SO INV. PROFILES
ARE DRAWN "STATION-WISE"
TO FREEWAY BASE LINE
WHERE FEASIBLE, TO THEIR
RESPECTIVE RAMP

DATE: July 12, 1957
No. 584



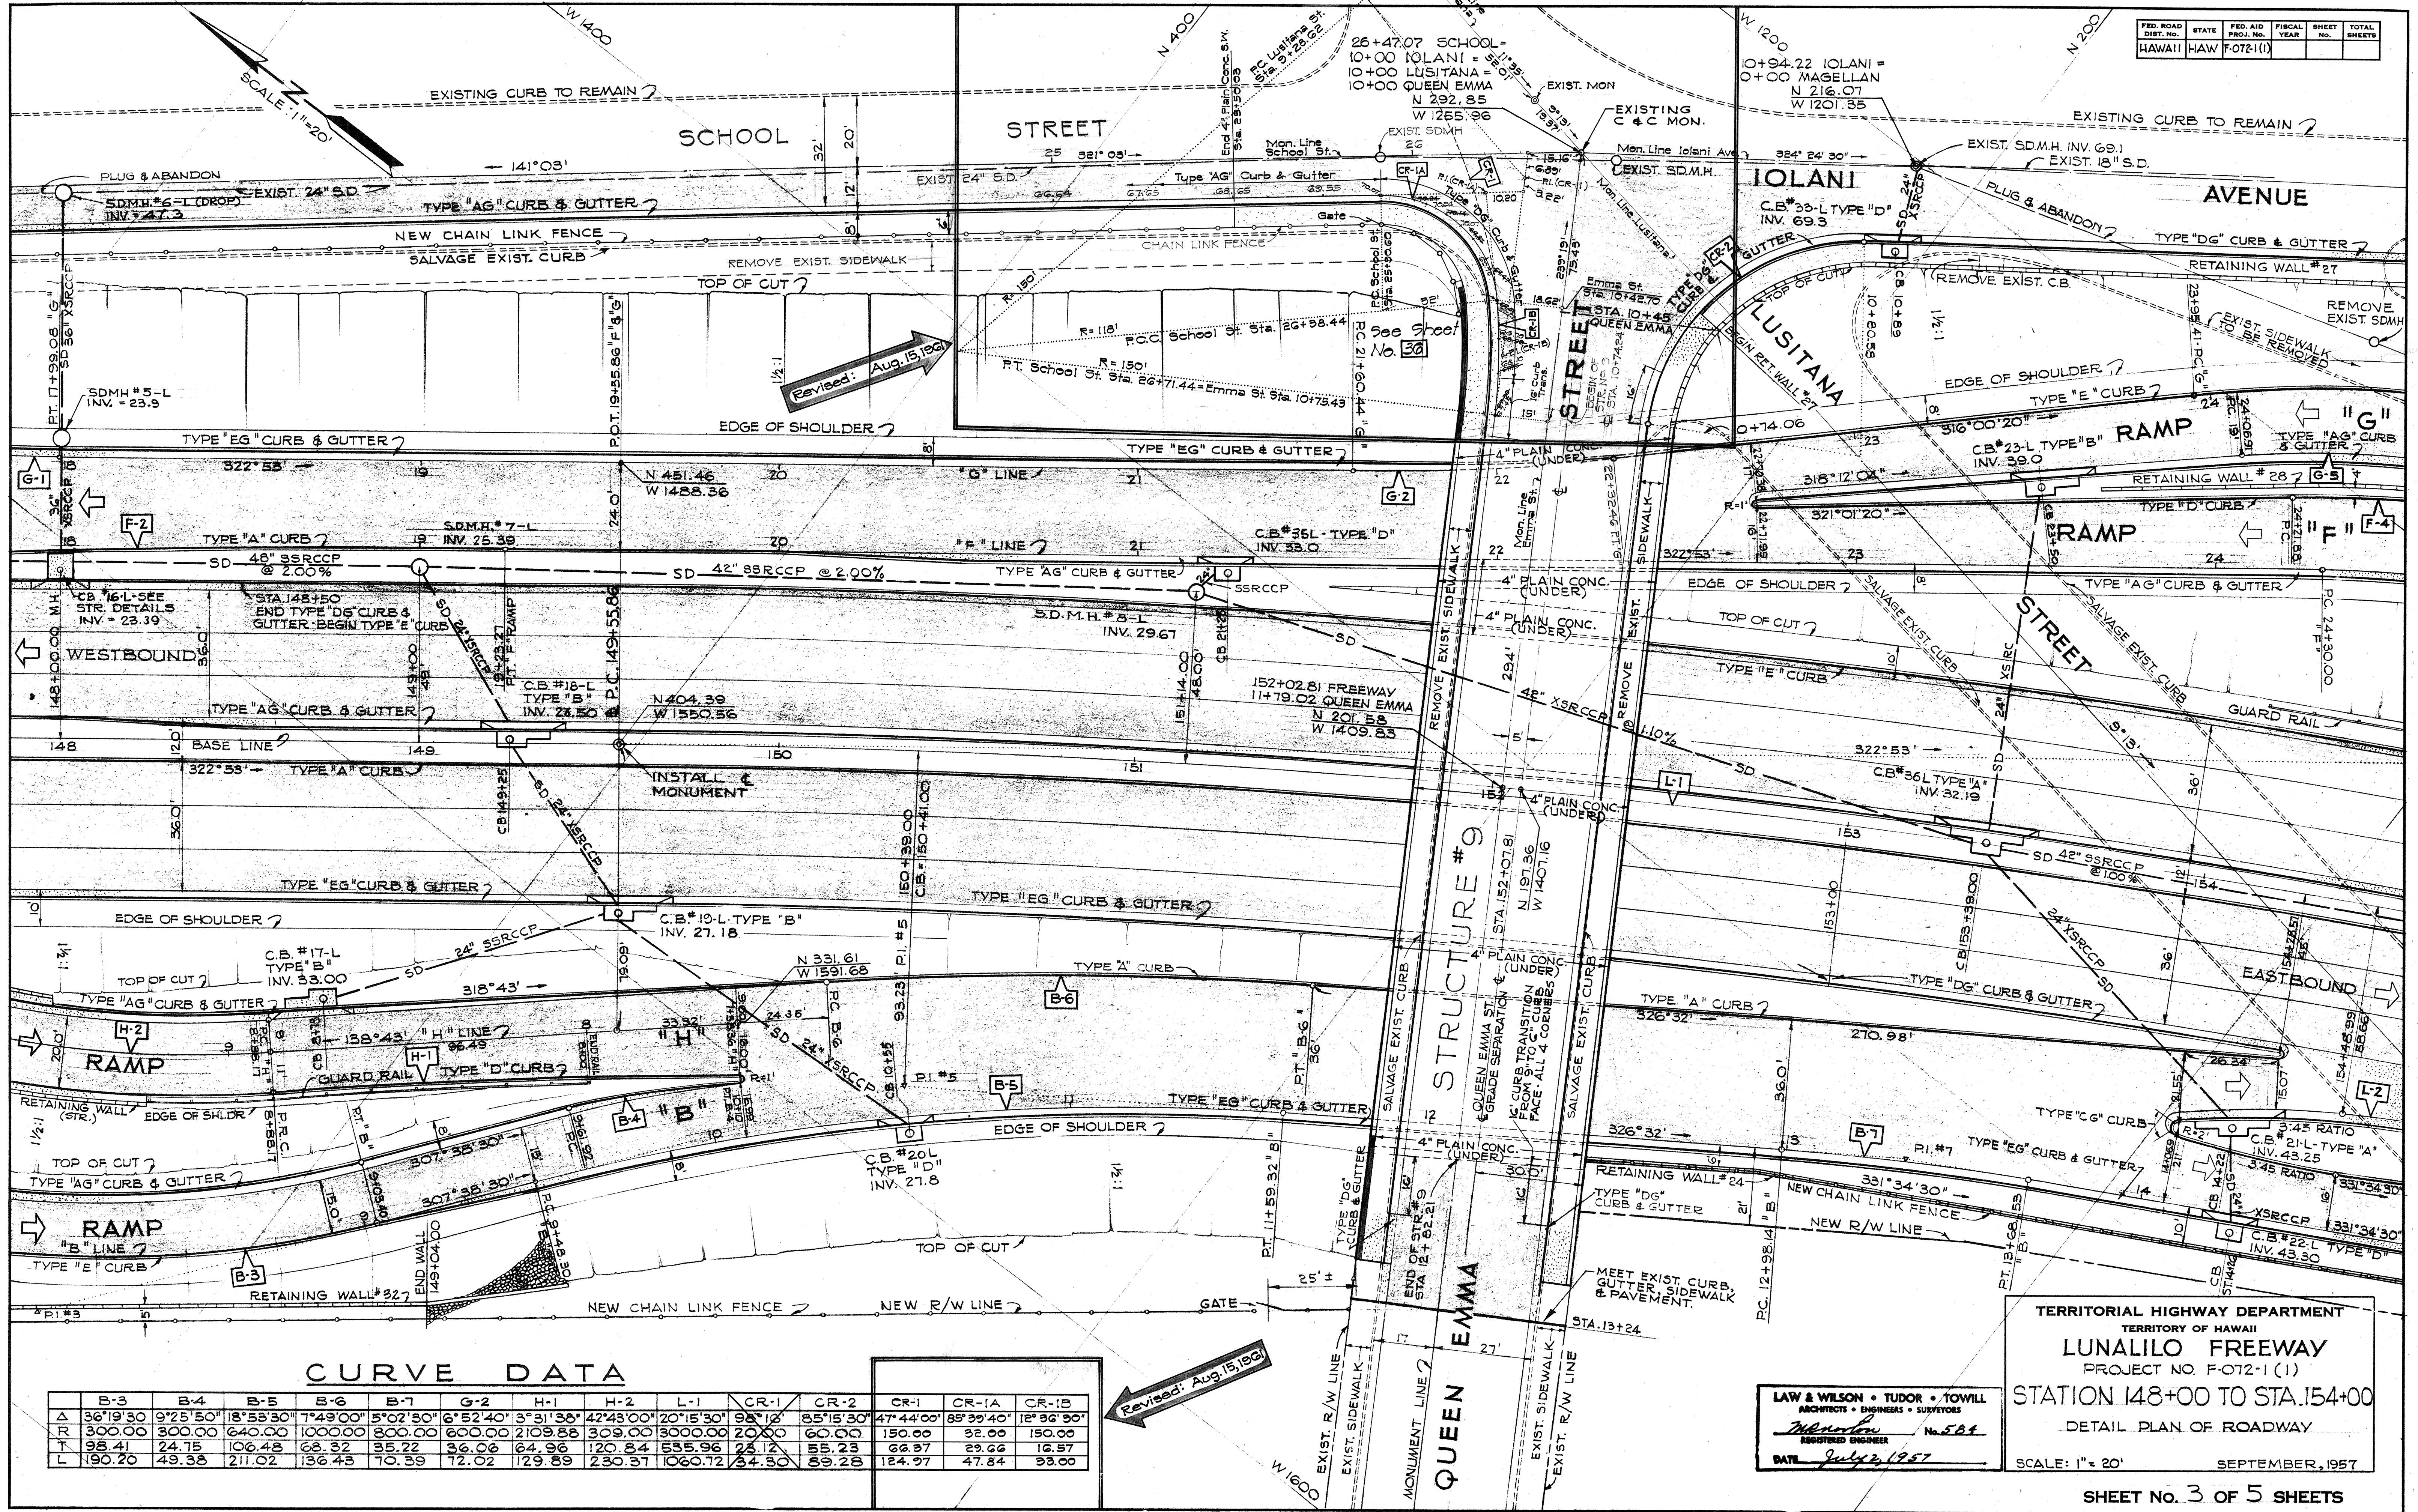

SURVEY PLOTTED BY: _____
 DESIGNED BY: _____
 DRAWN BY: _____
 CHECKED BY: _____
 DATE: 1/15/57
 NOTE BOOK NO. _____
 QUANTITIES CHECKED BY: _____
 NO. _____

CURVE DATA

	B-3	B-4	B-5	B-6	B-7	G-2	H-1	H-2	L-1	CR-1	CR-2	CR-1	CR-1A	CR-1B
Δ	36°19'30"	9°25'50"	18°55'30"	7°49'00"	5°02'30"	6°52'40"	3°31'38"	42°43'00"	20°15'30"	98°12'	85°15'30"	47°44'00"	85°39'40"	18°36'30"
R	300.00	300.00	640.00	1000.00	800.00	600.00	2109.88	309.00	3000.00	20.00	60.00	150.00	32.00	150.00
T	98.41	24.75	106.48	68.32	35.22	36.06	64.96	120.84	535.96	23.12	55.23	62.97	29.66	16.57
L	190.20	49.38	211.02	136.43	70.39	72.02	129.89	230.37	1060.72	24.30	89.28	124.97	47.84	93.00

TERRITORIAL HIGHWAY DEPARTMENT
 TERRITORY OF HAWAII
LUNALILO FREEWAY
 PROJECT NO. F-072-1(1)
STATION 148+00 TO STA. 154+00
 DETAIL PLAN OF ROADWAY

LAW & WILSON • TUDOR • TOWILL
 ARCHITECTS • ENGINEERS • SURVEYORS
 REGISTERED ENGINEER No. 584
 DATE July 2, 1957

SCALE: 1"=20' SEPTEMBER, 1957

SHEET NO. 3 OF 5 SHEETS

PLAN SHOWING REVISION AT CORNER OF QUEEN EMMA AND SCHOOL STS.

SHEET NO. A