


LEGEND

- 54 EXISTING CONTOUR
- 53.2 EXISTING SPOT ELEV.
- 51 NEW FINISHED CONTOUR
- EXIST. BLDGS, EQUIPMENT WALK, WALL, ETC. TO BE DEMOLISHED OR RELOCATED SEE NOTES
- EXIST. BLDGS, EQUIPMENT WALK, WALL ETC. TO REMAIN, SEE NOTES
- SHOWN SHADED, NEW OR RELOCATED WORK SEE NOTES
- EXIST. WATER LINE & EXIST. HOSE B.B.
- NEW WATER LINE & NEW HOSE B.B.
- THIS SHOWN ARE EXIST. STRUCTURES SEE SCOPE OF WORK
- THIS SHOWN ARE NEW OR RELOCATED STRUCTURES SEE SCOPE OF WORK

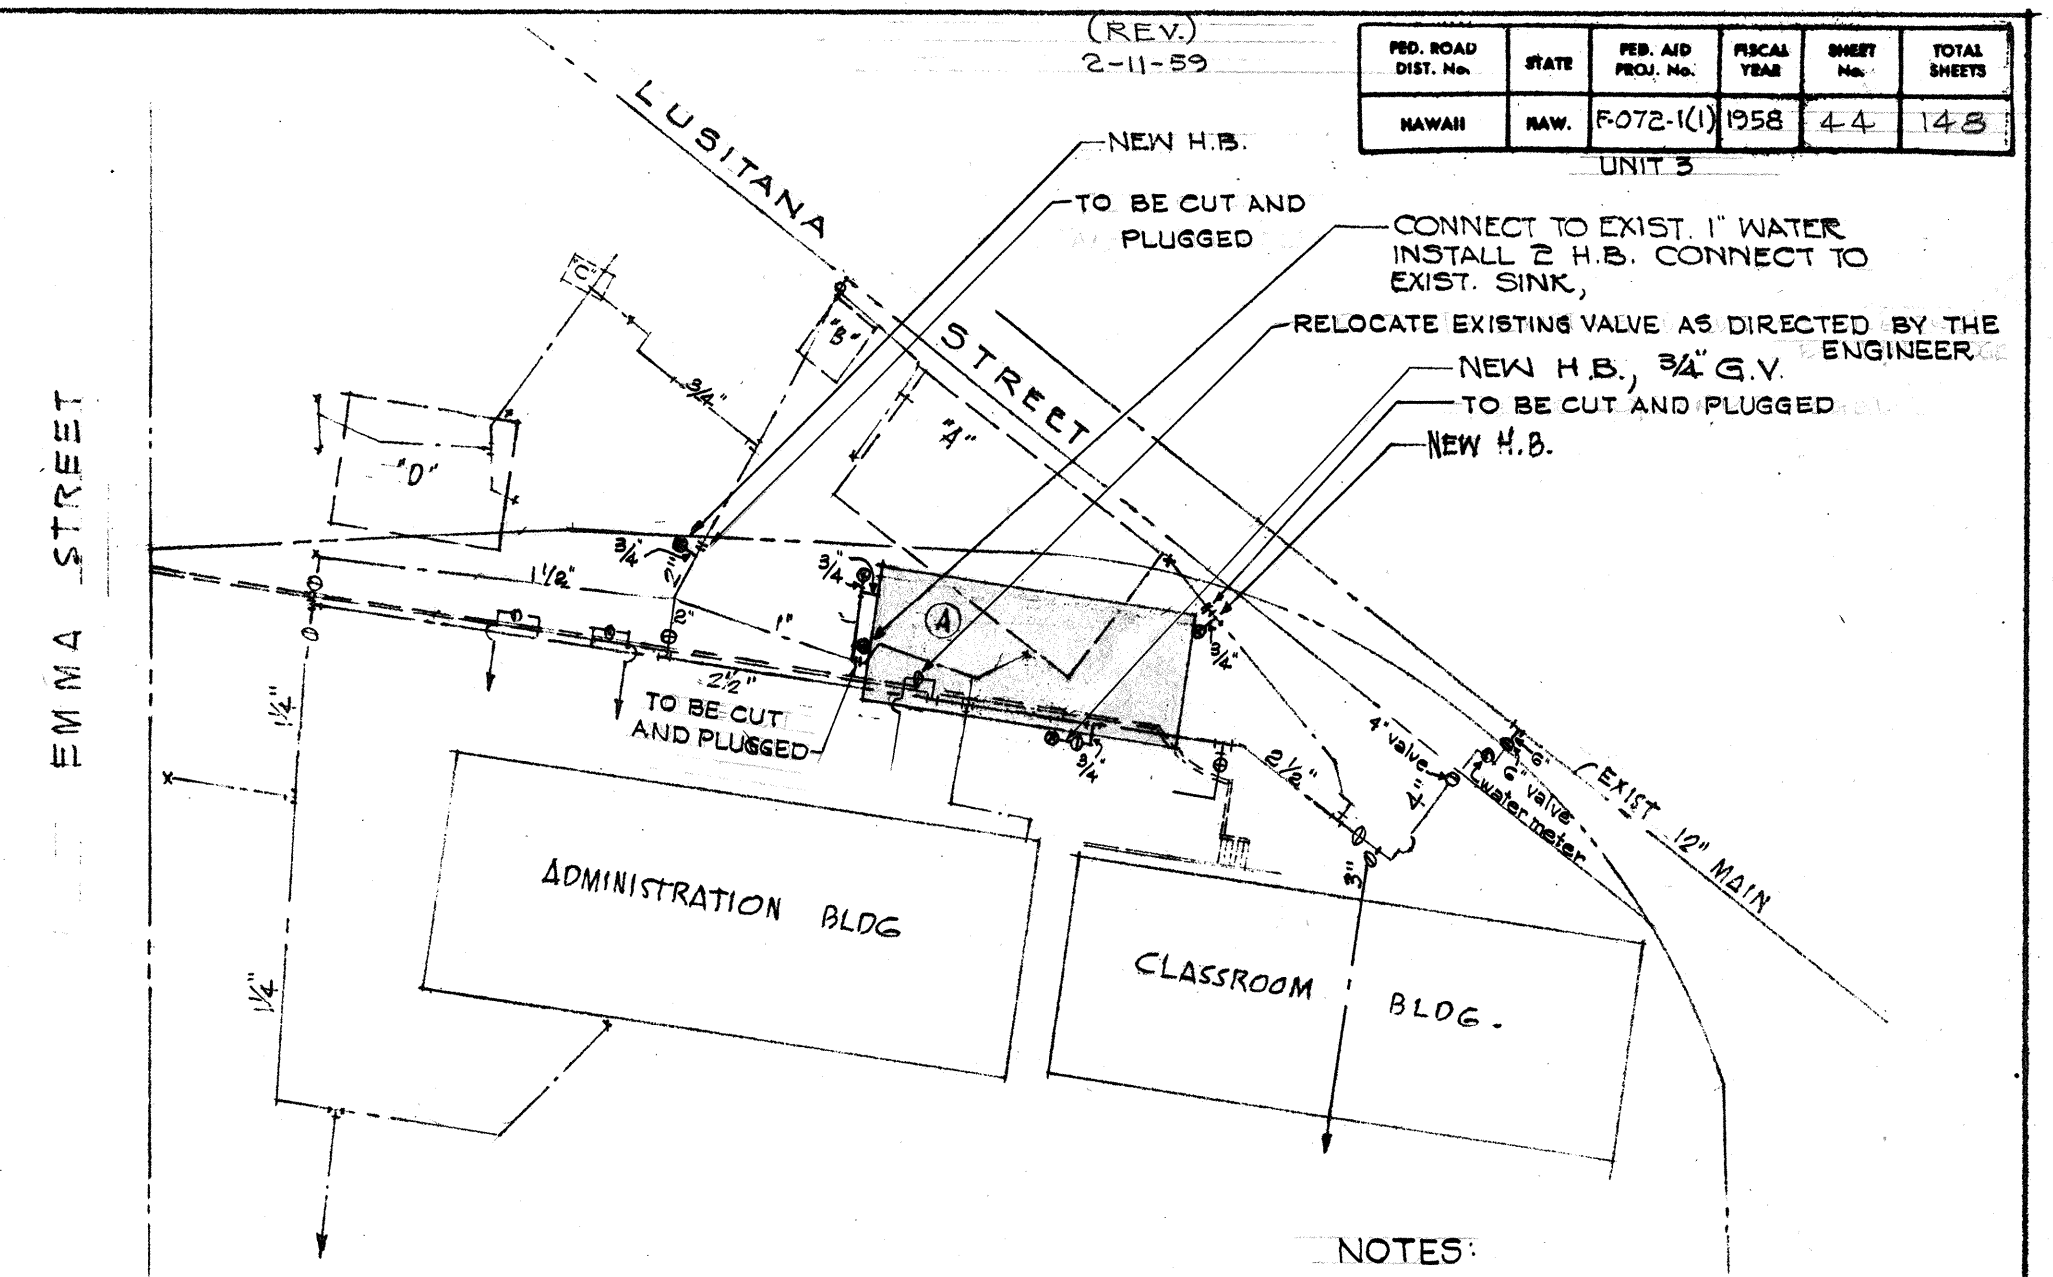

- NOTES:
- UNLESS OTHERWISE SHOWN, THE WATER LINES SHOWN ABOVE ARE EXISTING
 - THE WATER LINES SHOWN ABOVE ARE LOCATED FROM THE BEST SOURCES AVAILABLE. THE CONTRACTOR SHALL CHECK AND VERIFY THE EXACT LOCATION AND DEPTH OF SAME.
 - WATER LINES AND VALVE BOXES ARE TO BE LOWERED TO NEW GRADES WHERE AFFECTED.
 - WATER LINES REQUIRING LOWERING SHALL HAVE A COVER OF 24" MINIMUM, PIPE INVERT TO FINISHED GRADE.

GENERAL SCOPE OF WORK

DESIGNATION	TYPE OF STRUCTURE	SCOPE OF WORK				REMARK
		RELOCATE	RAZE	NEW	ADJUST	
"A"	CLASSROOM BLDG.	●				RELOCATE FROM "A" TO "A", RECONNECT SEWER, WATER, ELECTRIC
"B"	WOOD STORAGE BLDG.		●			REMOVE AND/OR DEMOLISH
"C"	GREEN HOUSE		●			" " " "
"1"	STEEL PIPE FRAME JUNGLE GYM.	●				RELOCATE FROM "1" TO "1" SEE SHT. 2 FOR DET
"2"	SWINGS					EXIST. TO REMAIN IN PLACE
"3"	TEETER BOARD	●				RELOCATE FROM "3" TO "3"
"4"	" "				●	ADJUST TO NEW GRADE
"5"	CHINNING BAR				●	" " " "
"6"	GARBAGE STORAGE		●			RAZE "6", BUILD NEW @ 1/2" & 1/2" 41 L.F. 48" CHAIN LINK FENCE
"7"	4' HIGH FENCE				●	15 ± L.F. OF 48" CHAIN LINK FENCE
"8"	6' HIGH FENCE				●	260 ± L.F. OF 72" CHAIN LINK FENCE, & GATE
"9"	C.R.M. WALL				●	ADJUST TO NEW GRADE SEE 2/c, 2/d
"10"	TREE STUMP					REMOVE (INCIDENTAL TO GRADING WORK)

NOTE:
BUILDING (A) TO BE RELOCATED PARALLEL TO ADMINISTRATION BLDG. S. AS INDICATED BY DISTANCES.

APPROVED BY:
Wm. H. Hester
TERRITORIAL HIGHWAY ENGINEER
DATE 5/21/58

APPROVED BY:
Ray B. Kinyon
SUPERINTENDENT OF BUILDINGS
CITY & COUNTY OF HONOLULU
DATE 5-1-58

Richard E. Meyer
S.U.P.T. OF PUBLIC INSTRUCTION
TERRITORY OF HAWAII
DATE 29 April 58












Joseph J. Symmes
BY *Philo L. Kwan*
DEPUTY FIRE MARSHAL
TERRITORY OF HAWAII
DATE 4-22-58

A. J. McManus
DISTRICT S.U.P.T. OF PUBLIC INSTRUCTION
DATE 4-24-58

B. J. McManus
DIRECTOR, DIV. OF SANITATION
BOARD OF HEALTH
DATE 4/23/58

TERRITORIAL HIGHWAY DEPARTMENT TERRITORY OF HAWAII		
RELOCATION & REHABILITATION OF EXISTING IMPROVEMENTS AT ROYAL SCHOOL		
LUALABU FREEWAY		
PROJ. NO. F-072-1(1), UNIT 3		
DATE APRIL 16 1958	THOMAS T. NISHIDA HAROLD M. TANIMURA HONOLULU, OAHU, T. H.	ARCHITECT ENGINEER 1 OF 3 SHTS.

FED. ROAD DIST. No.	STATE	FED. AID PROJ. No.	FISCAL YEAR	SHEET No.	TOTAL SHEETS
HAWAII		F. 072-101	1958	45	148

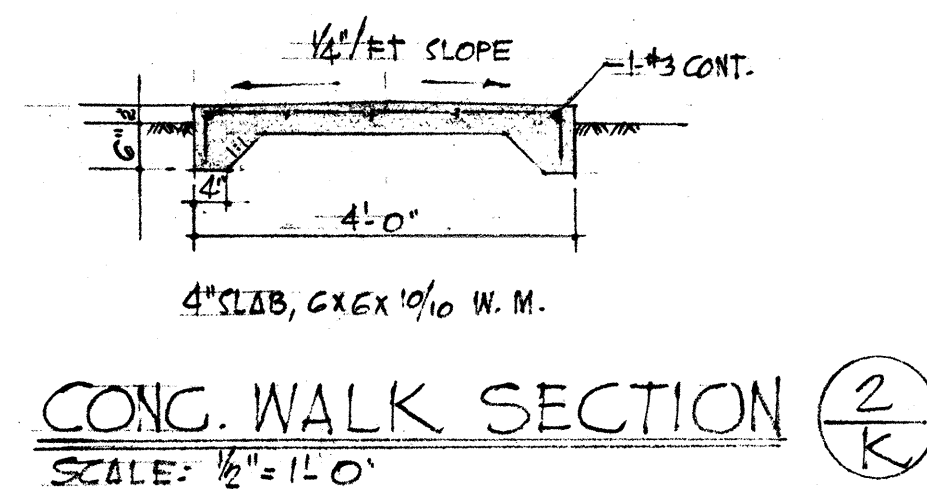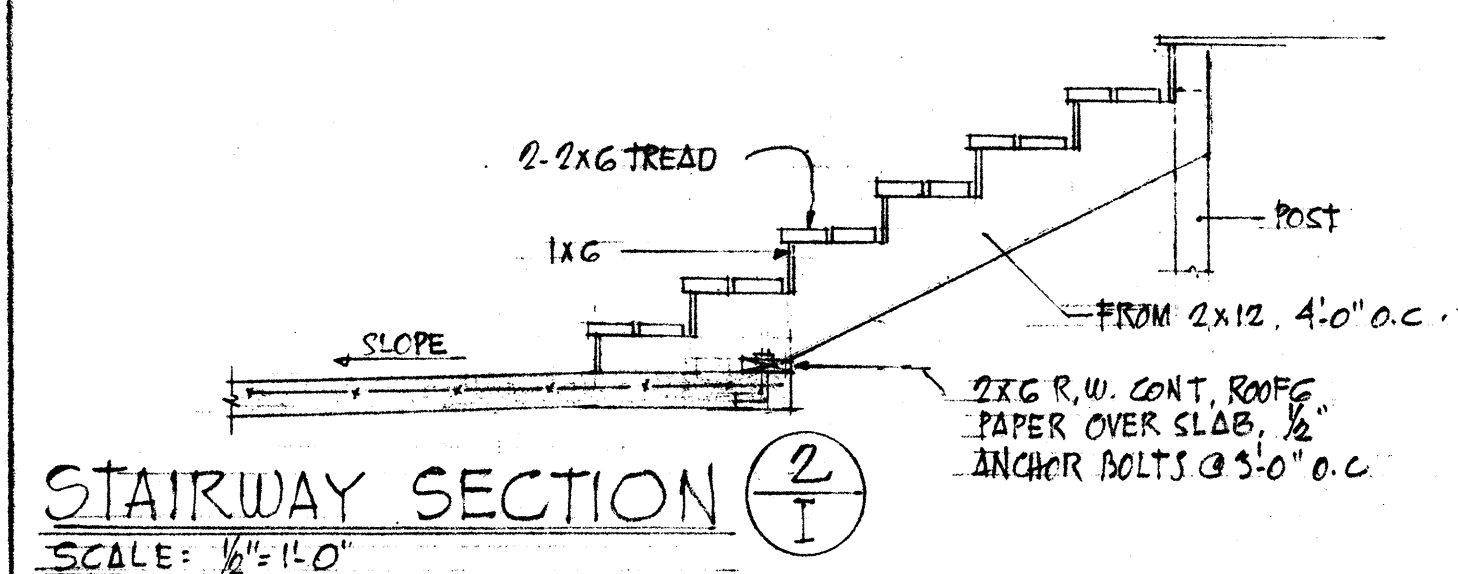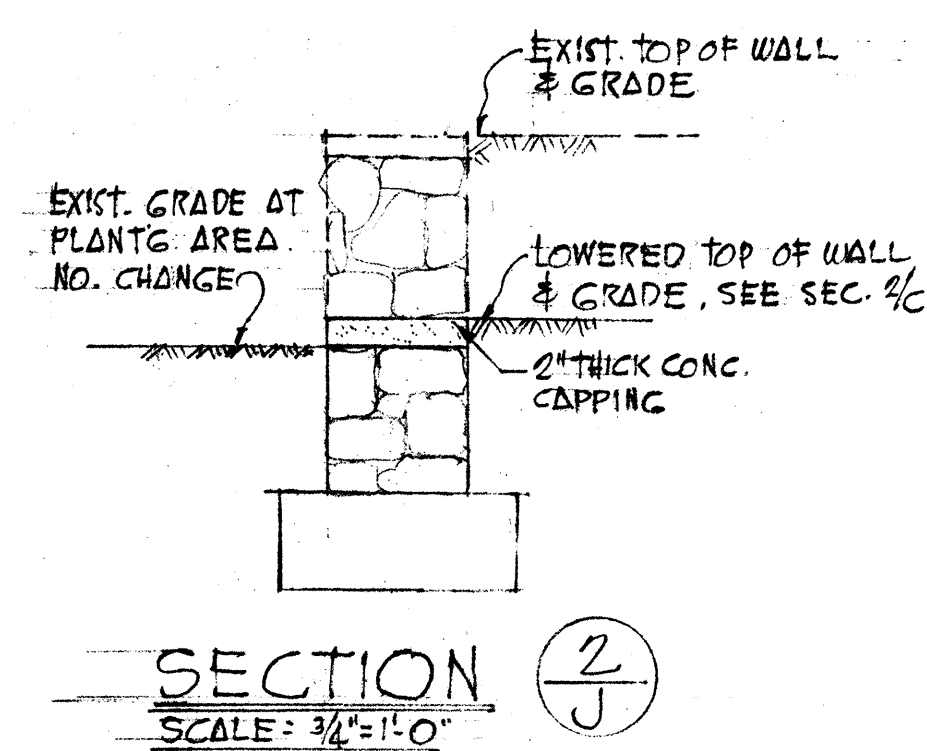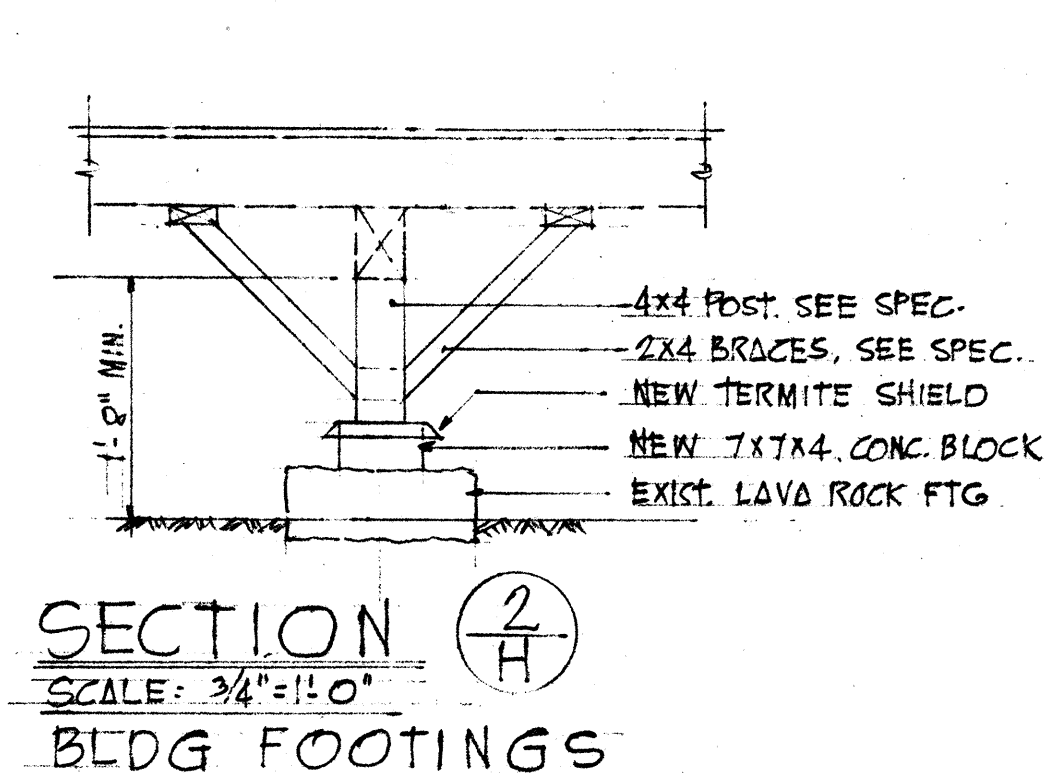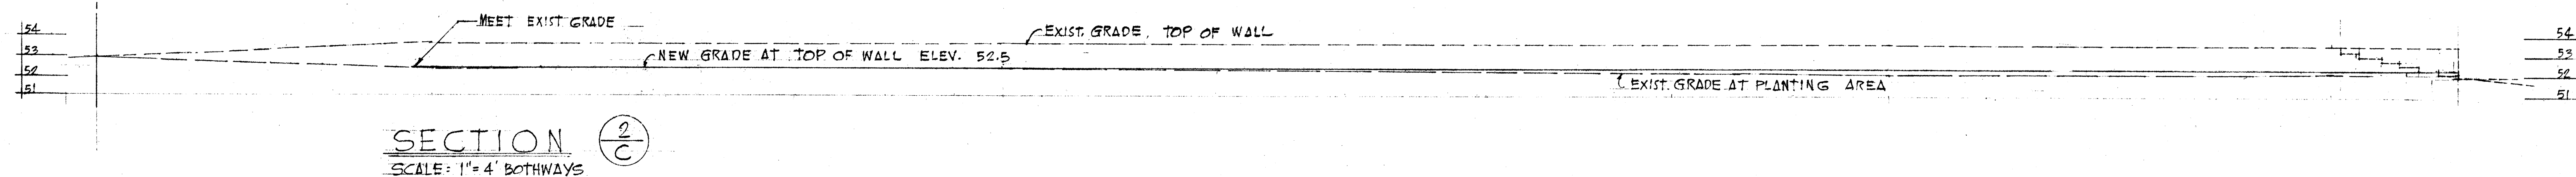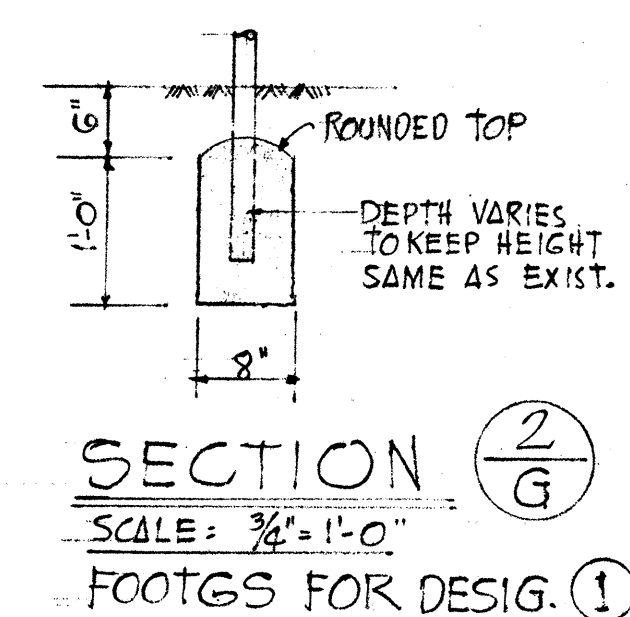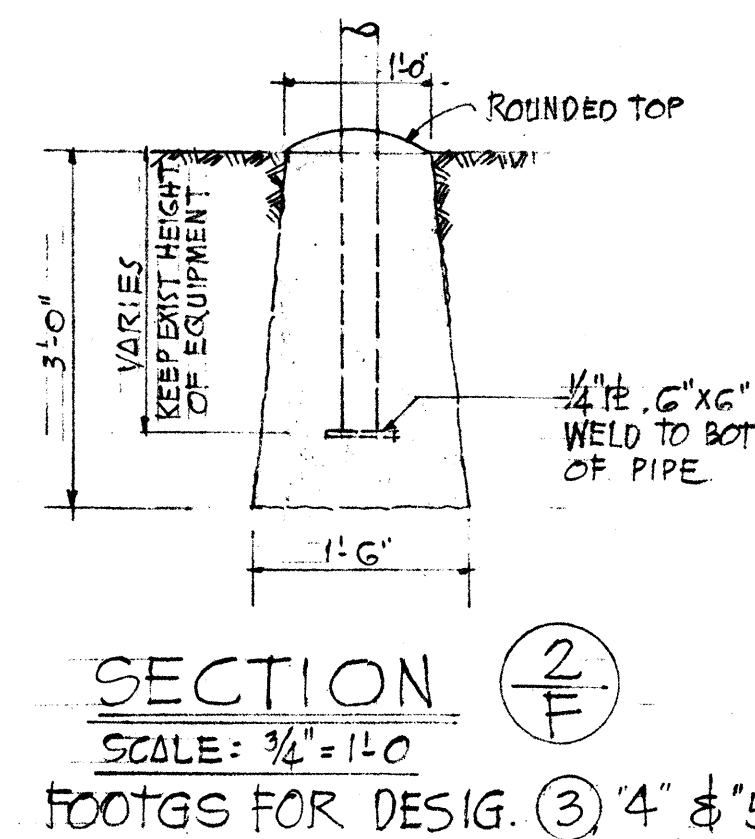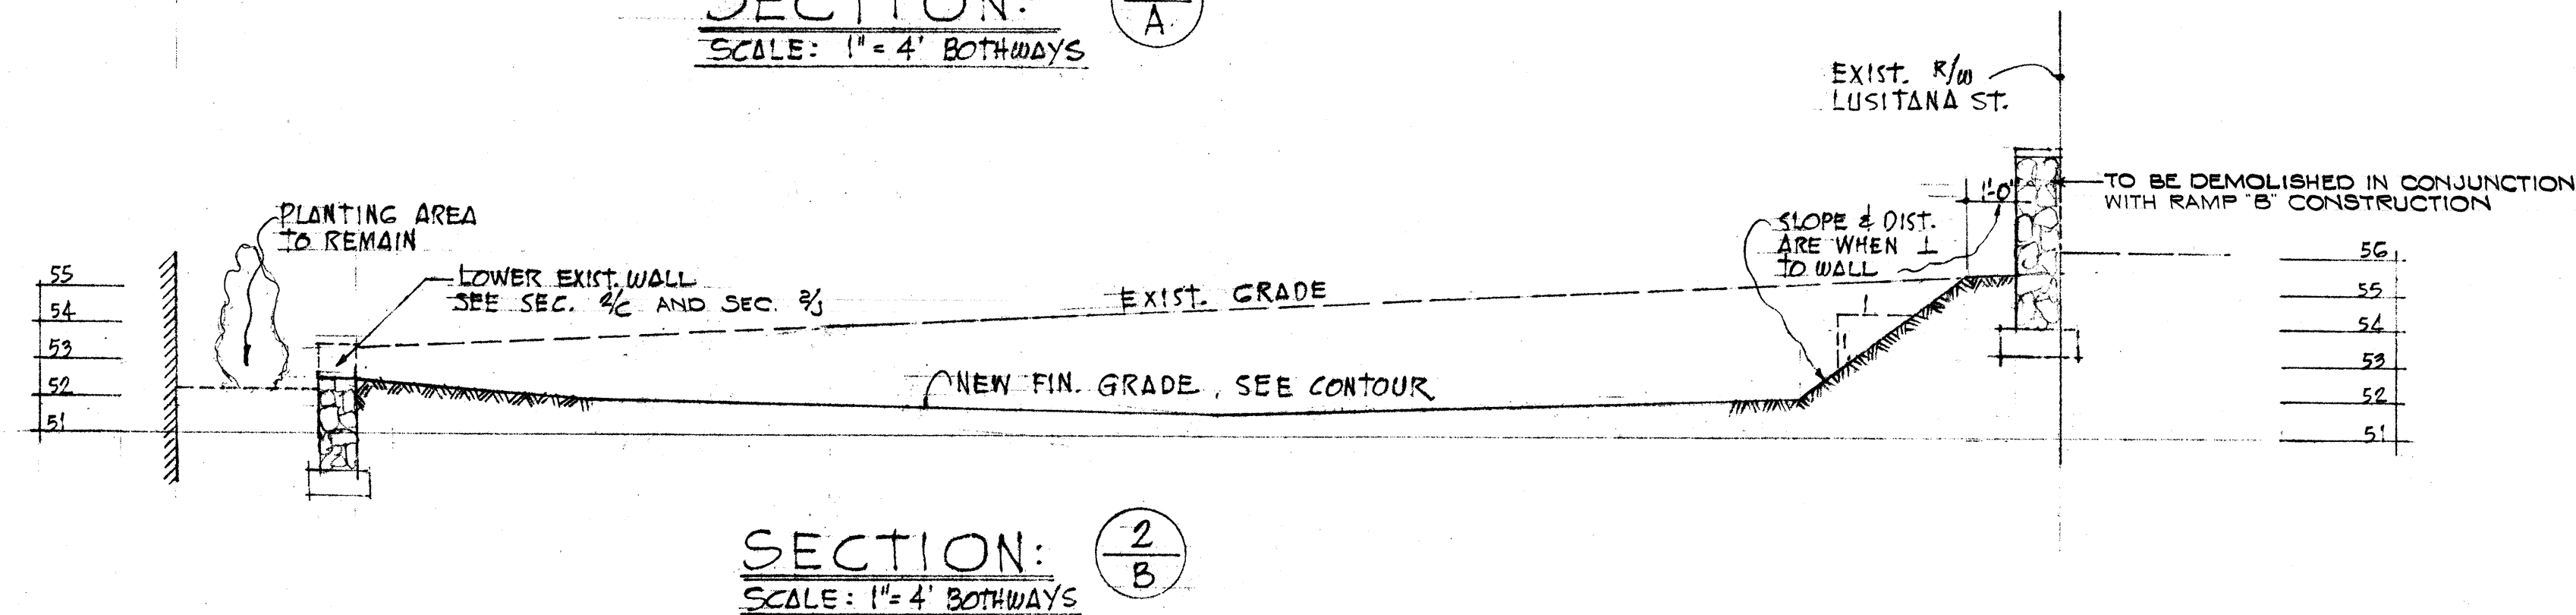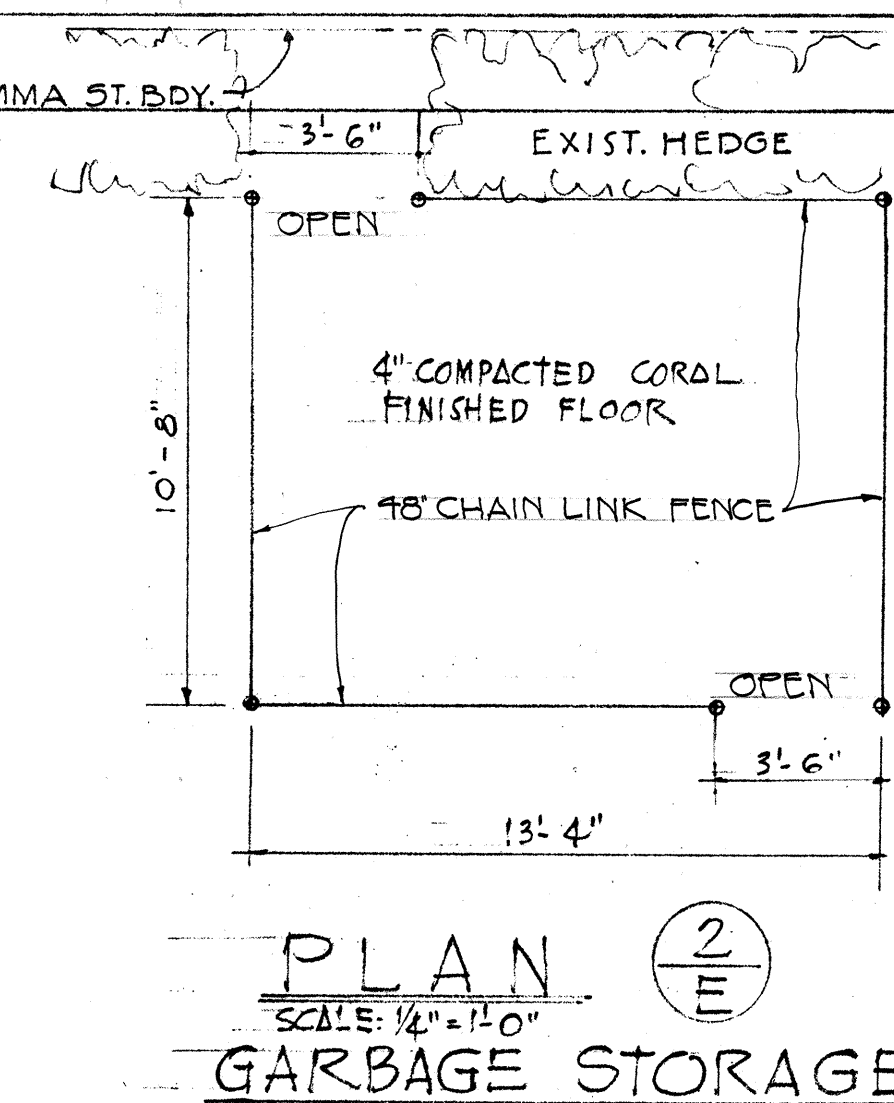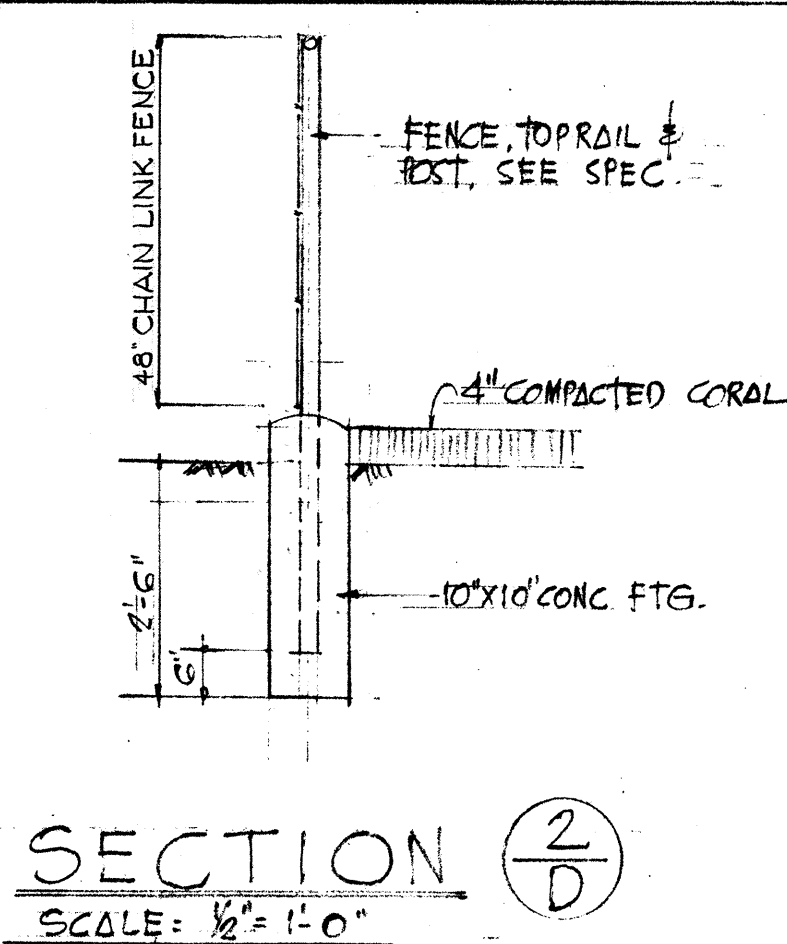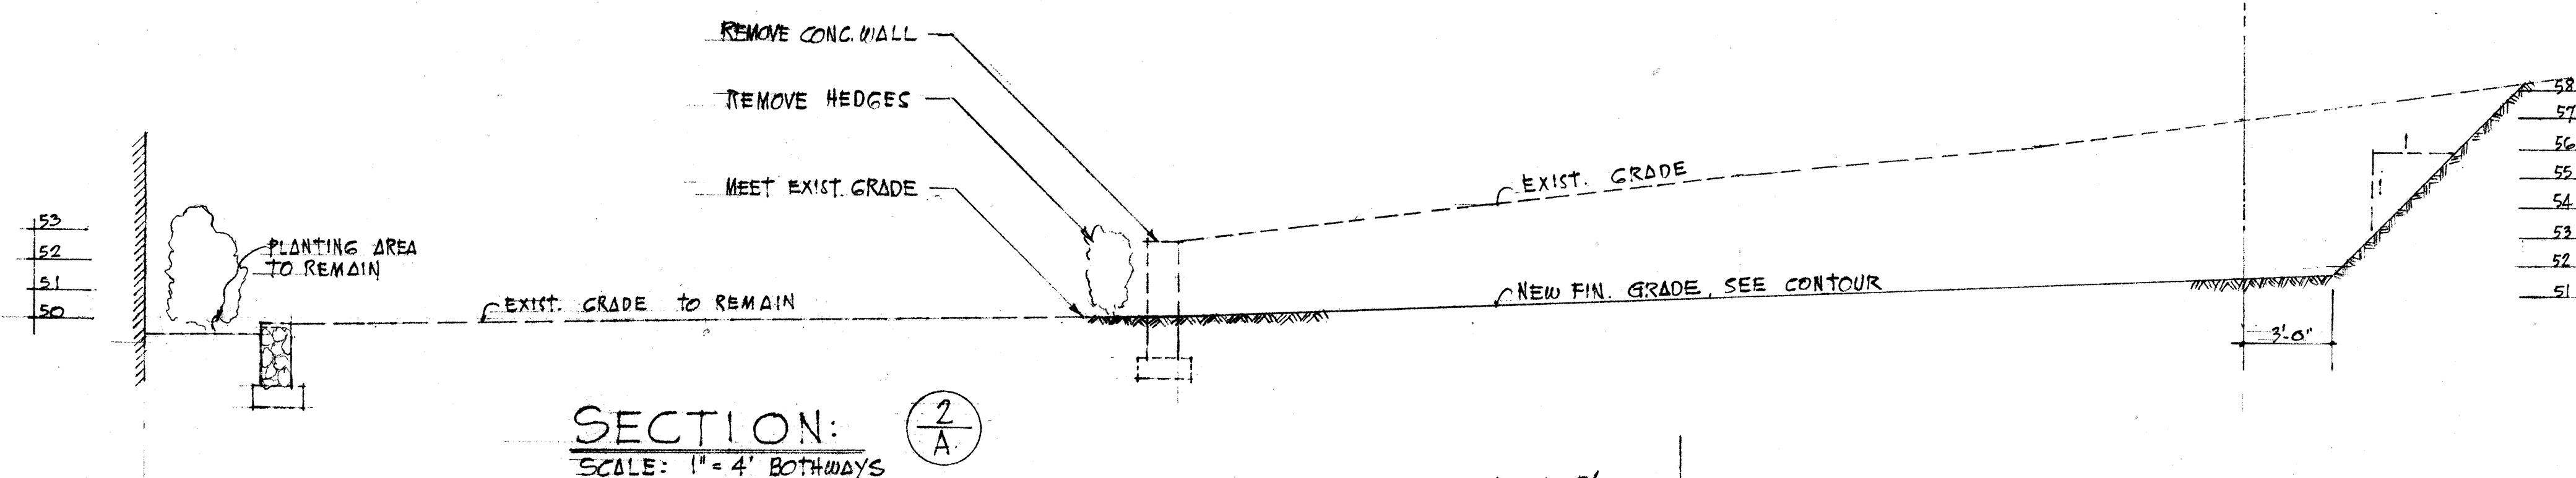

TERRITORIAL HIGHWAY DEPARTMENT TERRITORY OF HAWAII		
RELOCATION & REHABILITATION OF EXISTING IMPROVEMENTS AT <u>ROYAL SCHOOL</u> <u>LUNALILO FREEWAY</u> PROJ. NO. F-072-1(1), UNIT 3		
DATE APRIL 16 1958	THOMAS T. NISHIDA ARCHITECT HAROLD M. TANIMURA ENGINEER HONOLULU, OAHU, I. H.	SHEET 2 OF 3 SHEETS

FINAL SURVEY
 SURVEYED BY
 PLOTTED BY
 NOTE BOOK NO.
 DATE
 AREA CHECKED

ORIGINAL SURVEY
 SURVEYED BY
 PLOTTED BY
 NOTE BOOK NO.
 DATE
 AREA CHECKED

CROSS SECTIONS for ROYAL SCHOOL GROUND GRADING

SCALES: HOR. 1"=10'
 VER. 1"=10'

FED. ROAD DIST. NO.	STATE	FED. AID PROJ. NO.	FISCAL YEAR	SHEET NO.	TOTAL SHEETS
HAWAII	HAW.	F-072-1(1)	1958	46	148
UNIT 3 100					

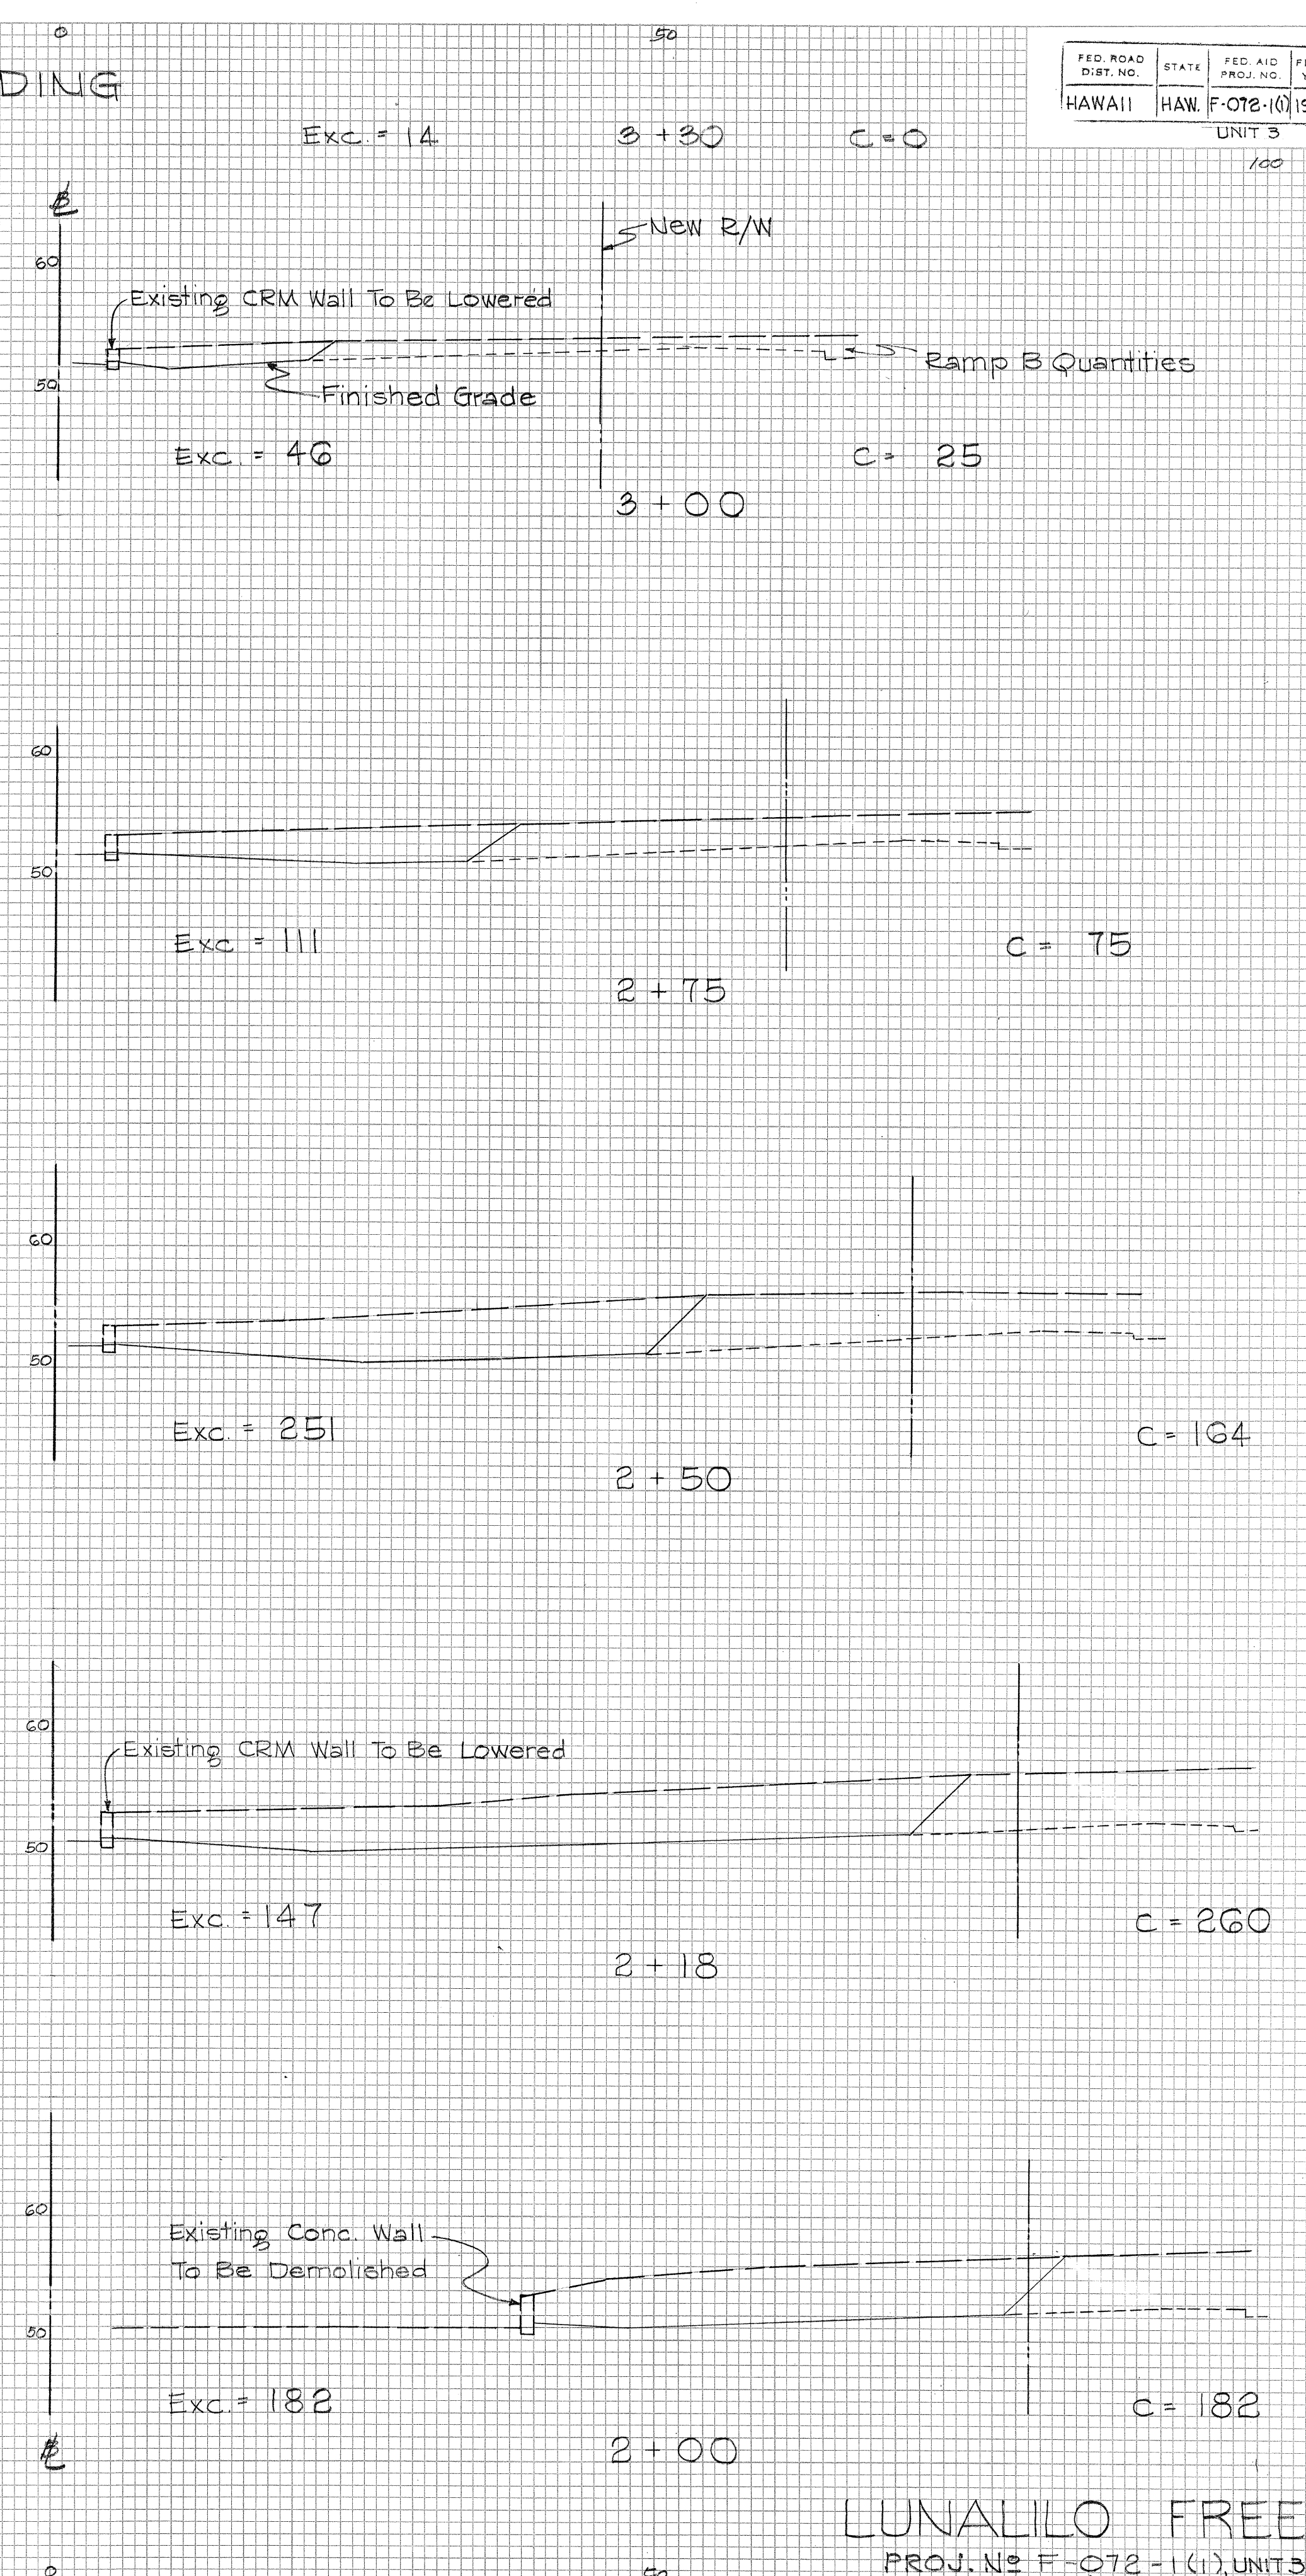
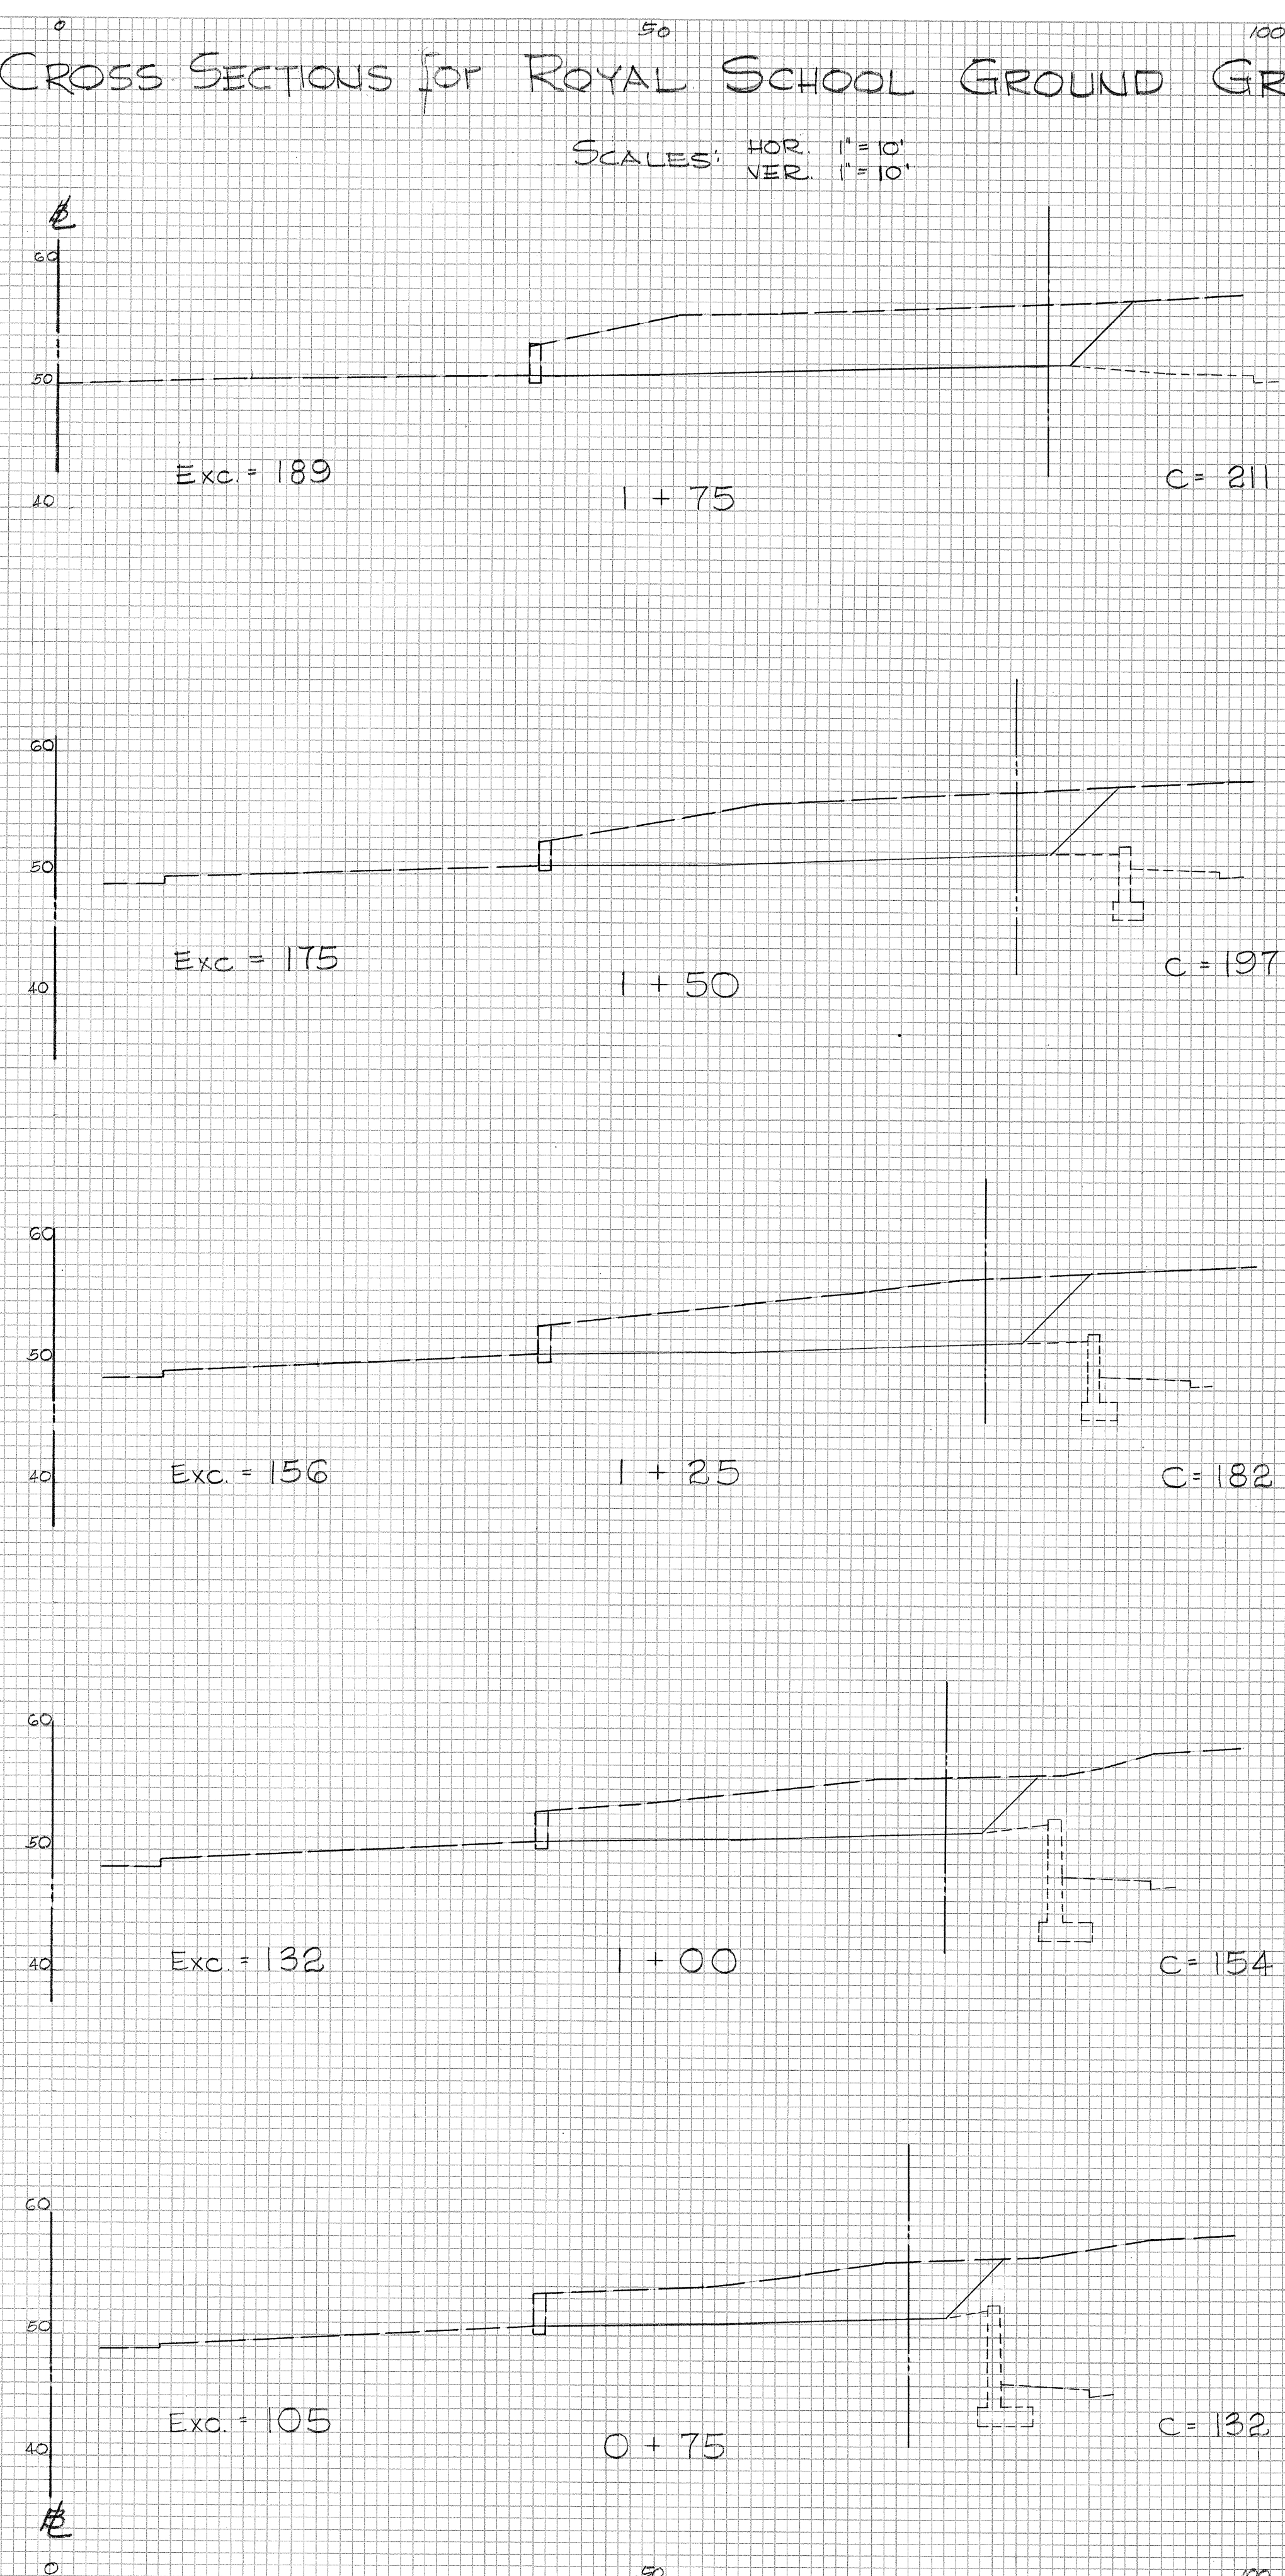
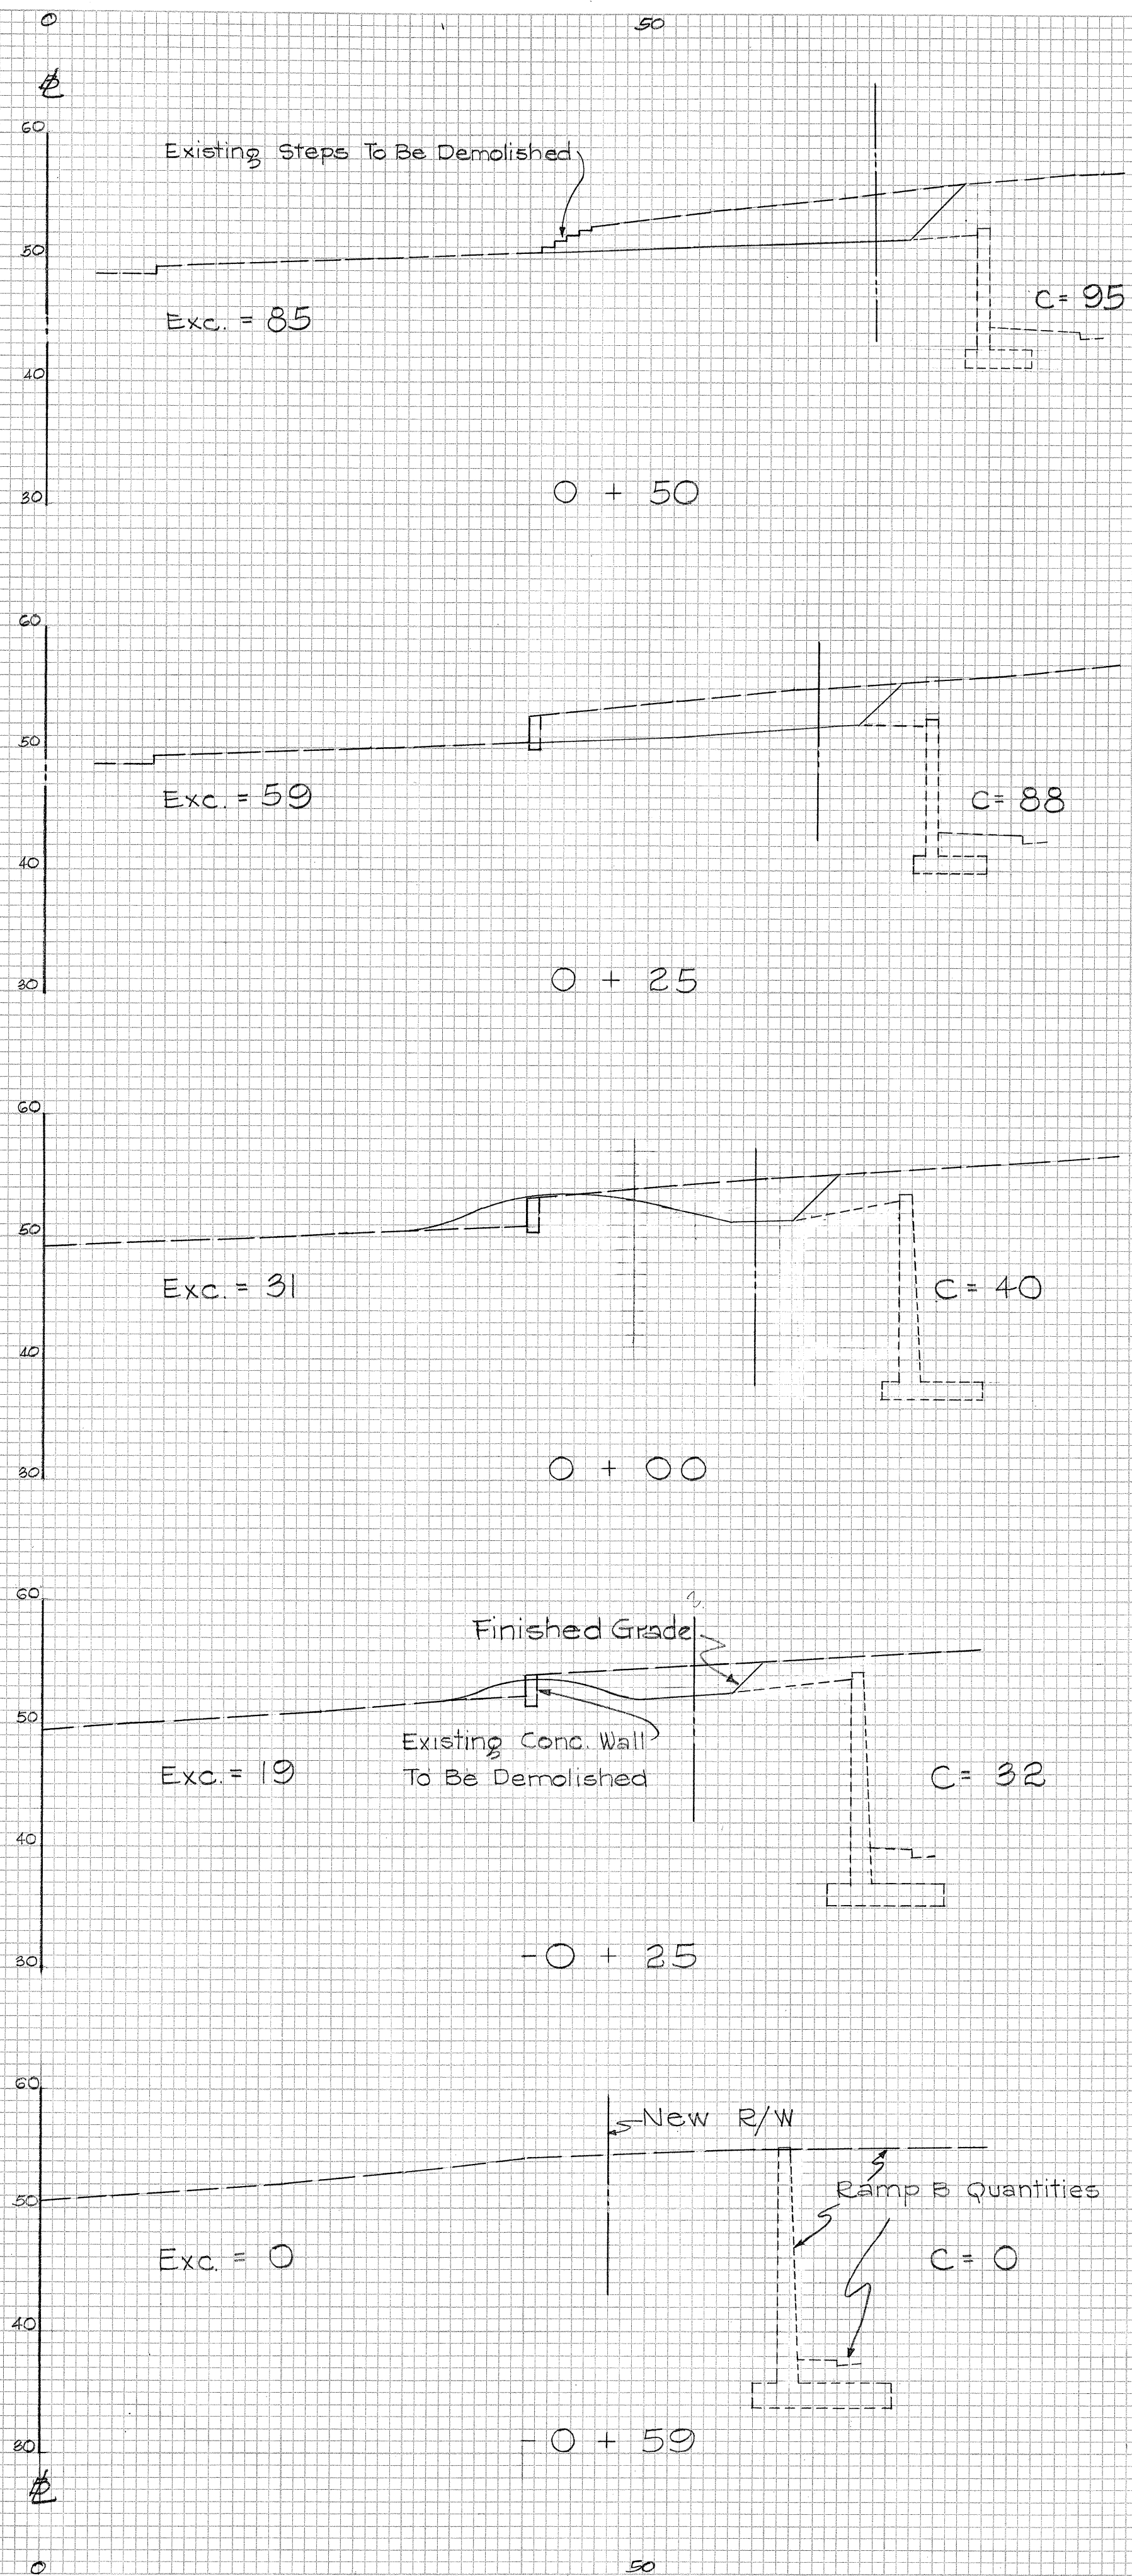


PLATE 3 CROSS SECTION O. P. R. & R. E. STANDARD
 100% RAIL PAPER, MADE AND PRINTED IN U. S. A.
 EUGENE DIETZEN CO.

LUNALILO FREEWAY
 PROJ. NO. F-072-1(1), UNIT 3 sheet 3 of 3