

ORIGINAL SURVEY	SURVED	BY	DATE
NOTE BOOK	TEMPLATE		
AREAS CHECKED			
NO.			

FINAL SURVEY	SURVED	BY	DATE
NOTE BOOK	TEMPLATE		
AREAS CHECKED			
NO.			

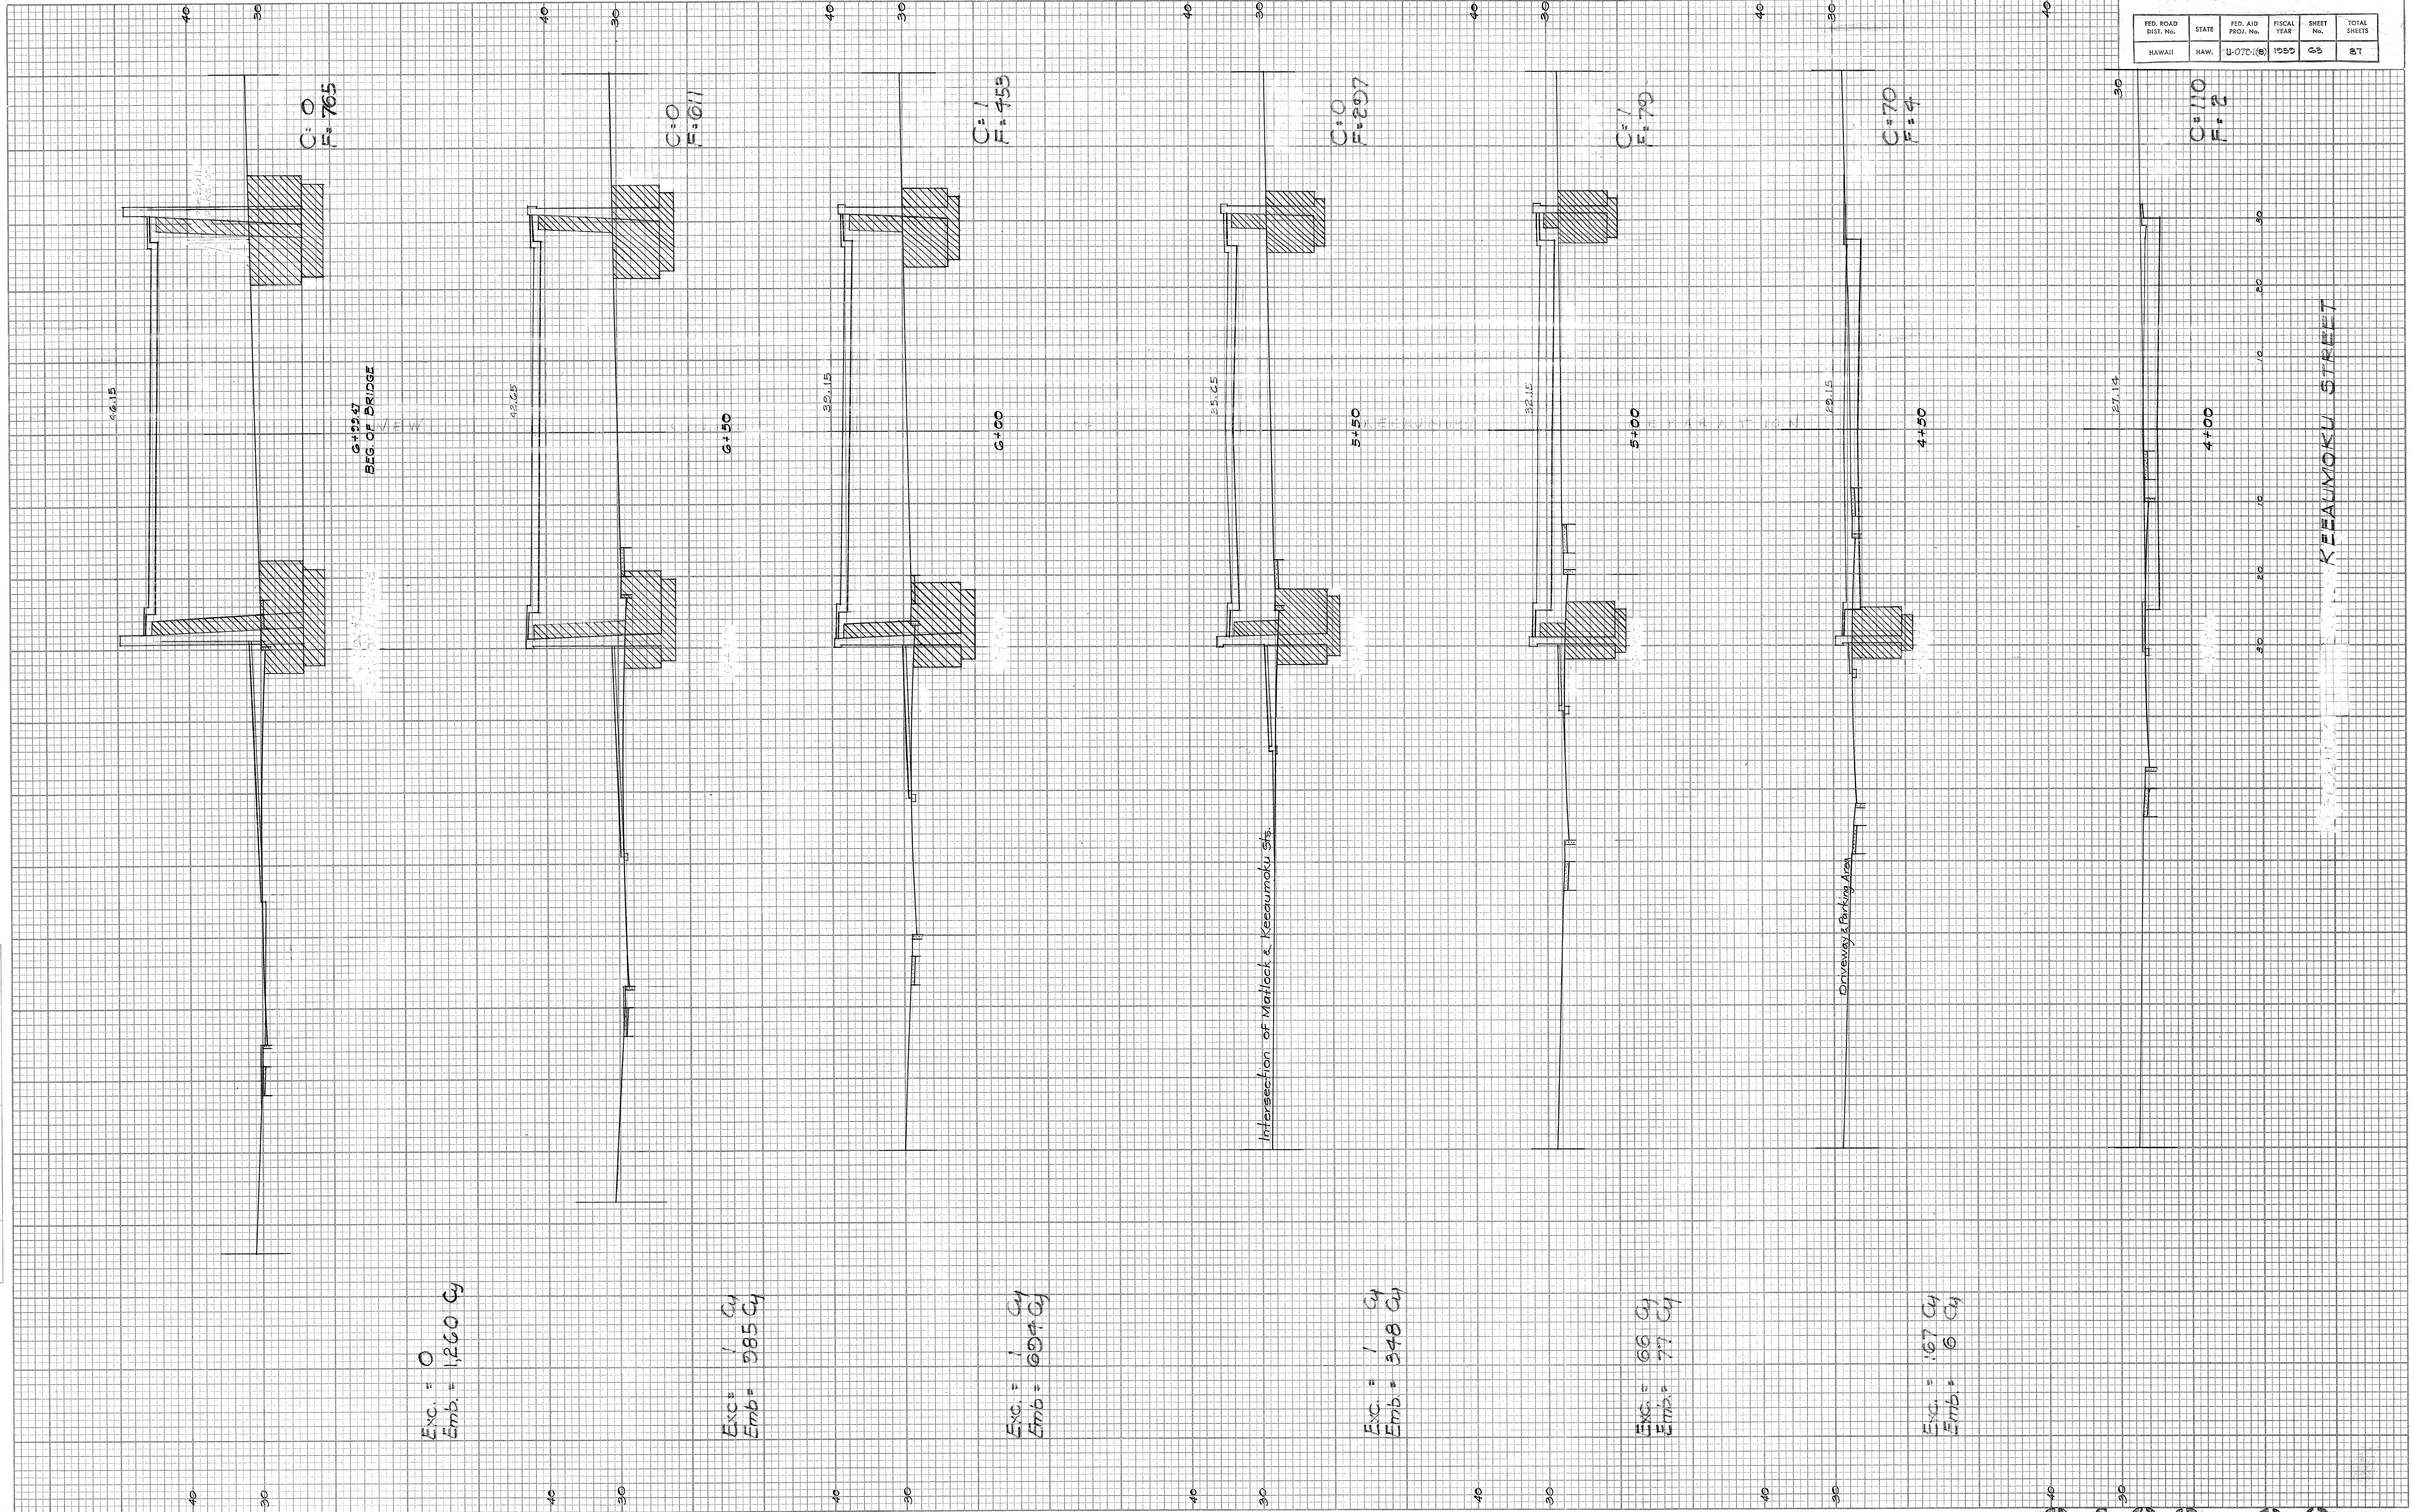



PLATE 3 CROSS SECTION D, P, R, & R, E.
100% RAS PAPER-MADE AND PRINTED IN U. S. A.
CHARLES BRUNING COMPANY

FED. ROAD DIST. NO.	STATE	FED. AID PROJ. NO.	FISCAL YEAR	SHEET NO.	TOTAL SHEETS
HAWAII	HAW.	11-07-11	1950	63	87

183.63

ORIGINAL SURVEY	SURVEYED PLOT NOTE BOOK	BY	DATE
NO.	NO.		

FINAL SURVEY	SURVEYED PLOT NOTE BOOK	BY	DATE
NO.	NO.		

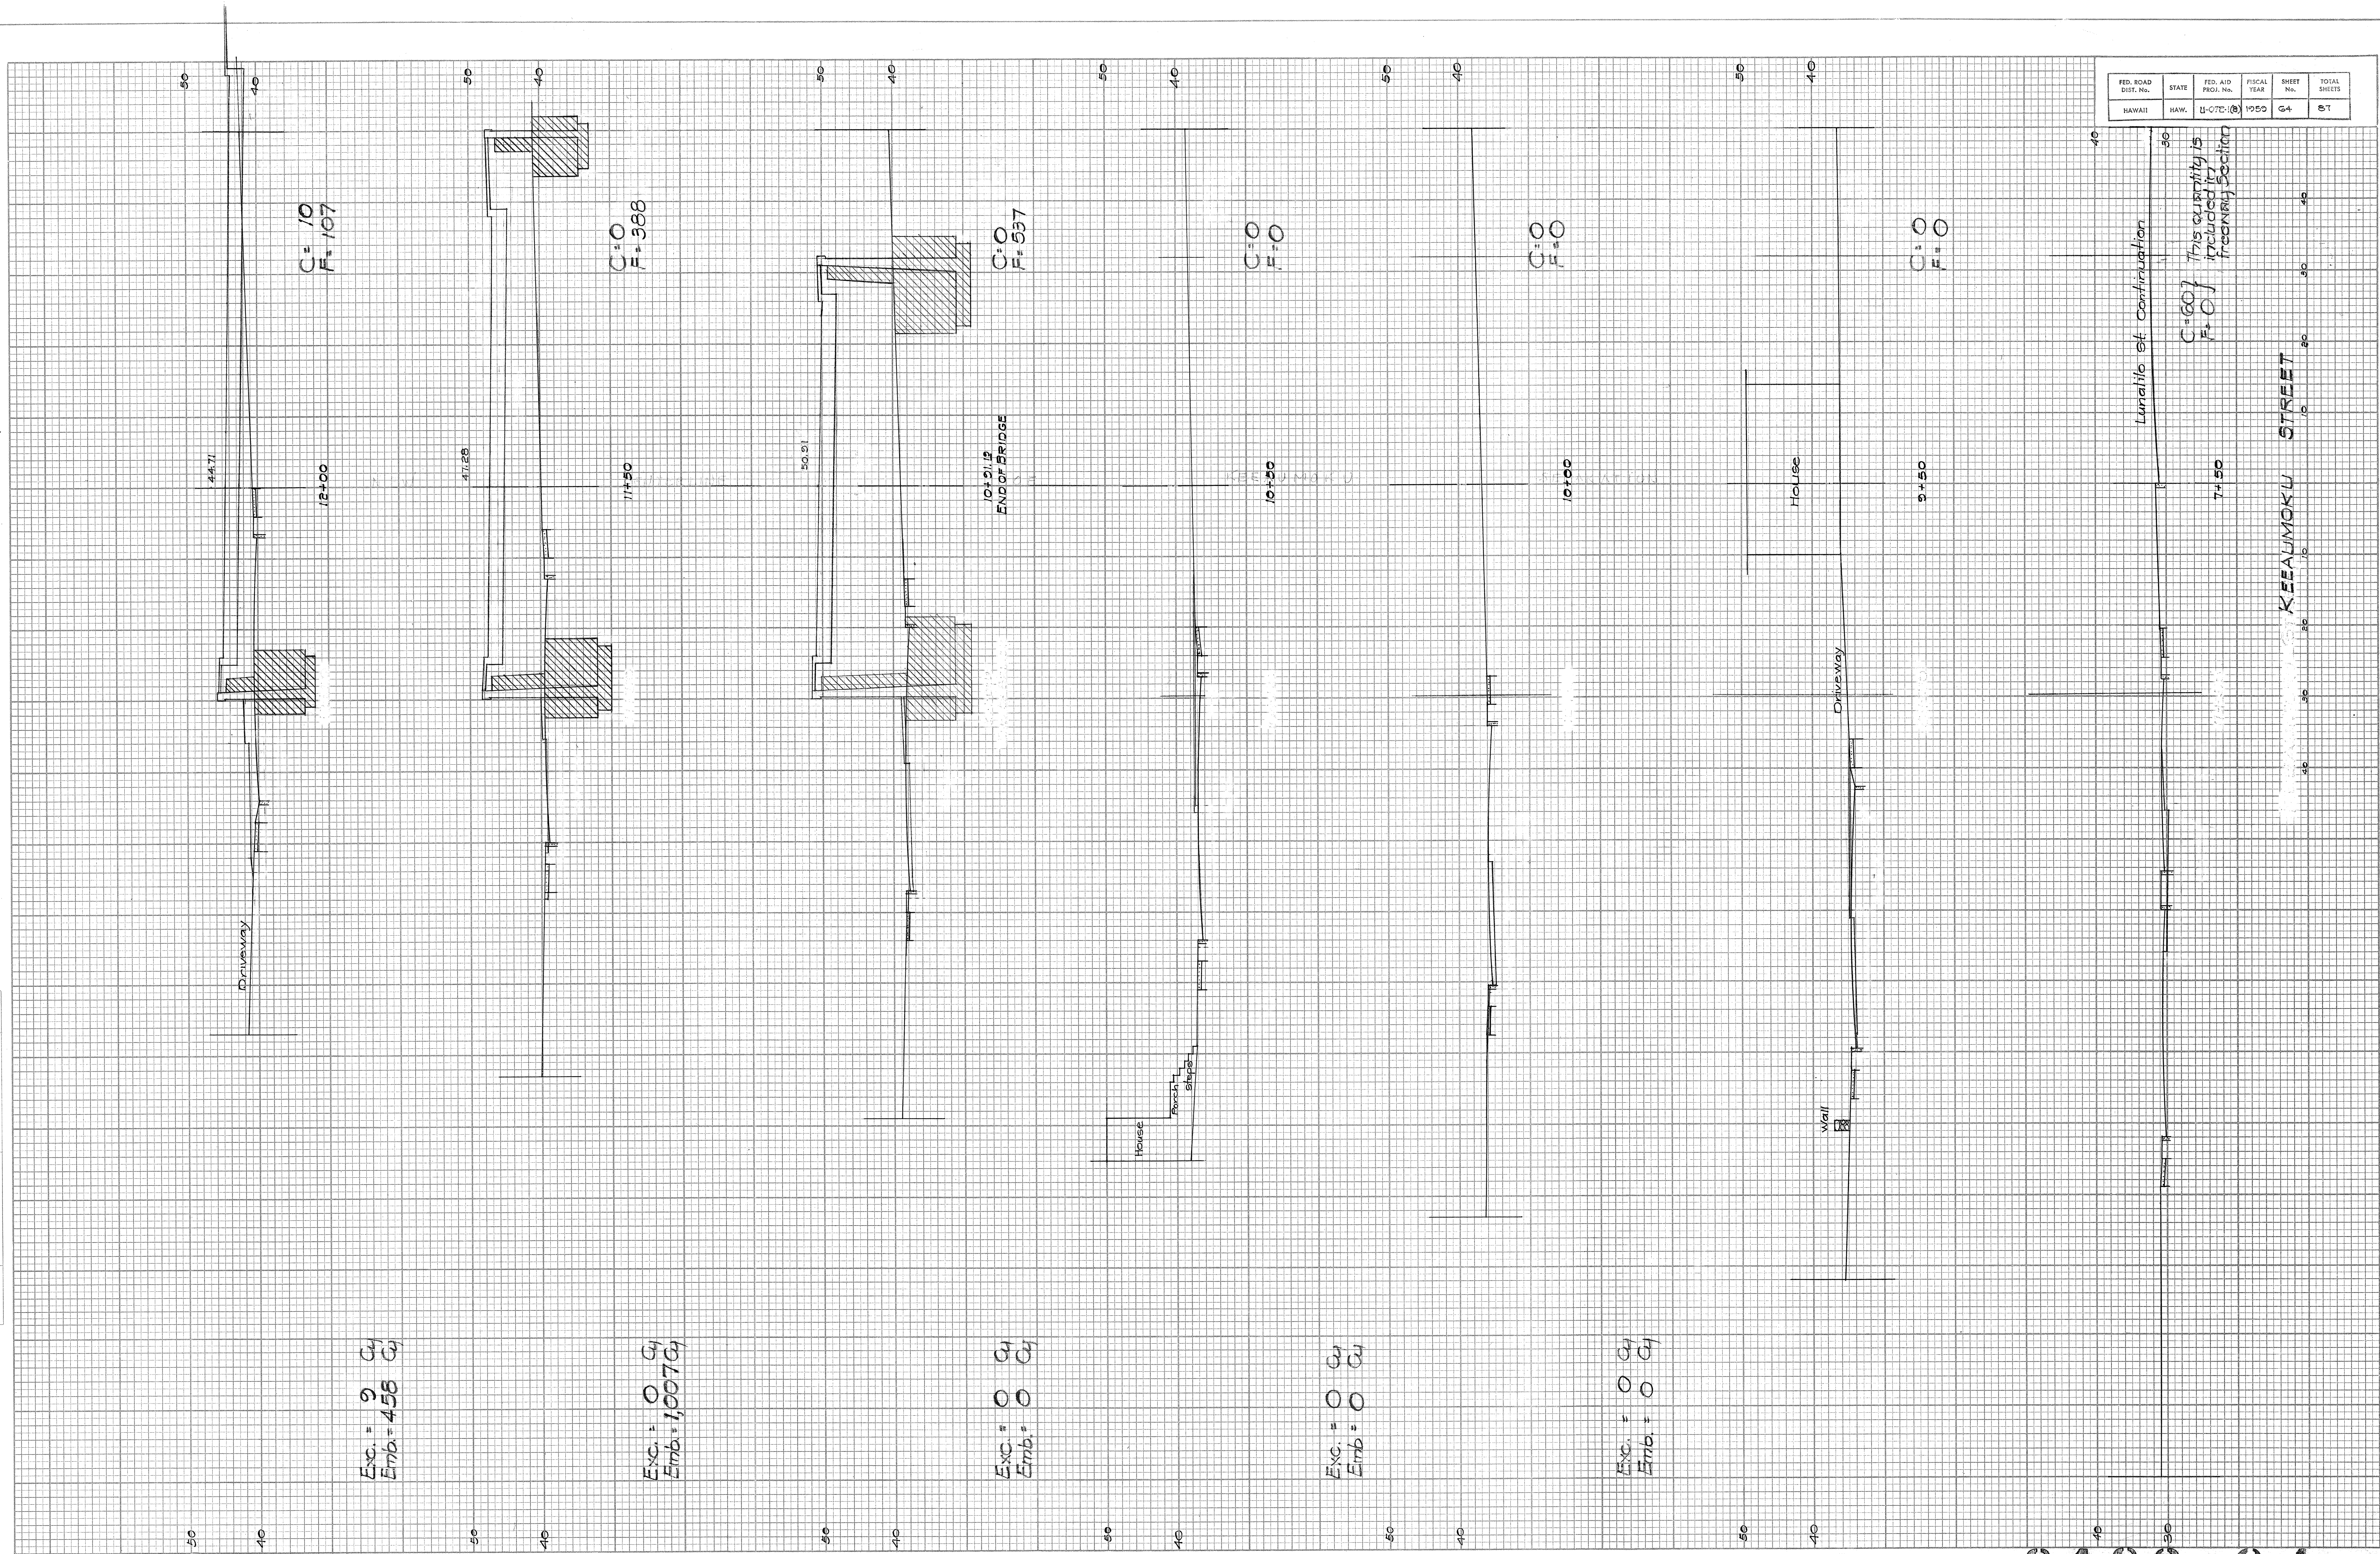

FED. ROAD DIST. No.	STATE	FED. AID PROJ. No.	FISCAL YEAR	SHEET No.	TOTAL SHEETS
HAWAII	HAW.	U-072-18	1950	64	87

FINAL SURVEY	SURVEYED PLOTTED TEMPLATE AREAS AREAS CHECKED	BY _____	DATE _____
NOTE BOOK			
NO. _____			

FED. ROAD DIST. No.	STATE	FED. AID PROJ. No.	FISCAL YEAR	SHEET No.	TOTAL SHEETS
HAWAII	HAW.	U-072-18	1950	65	87

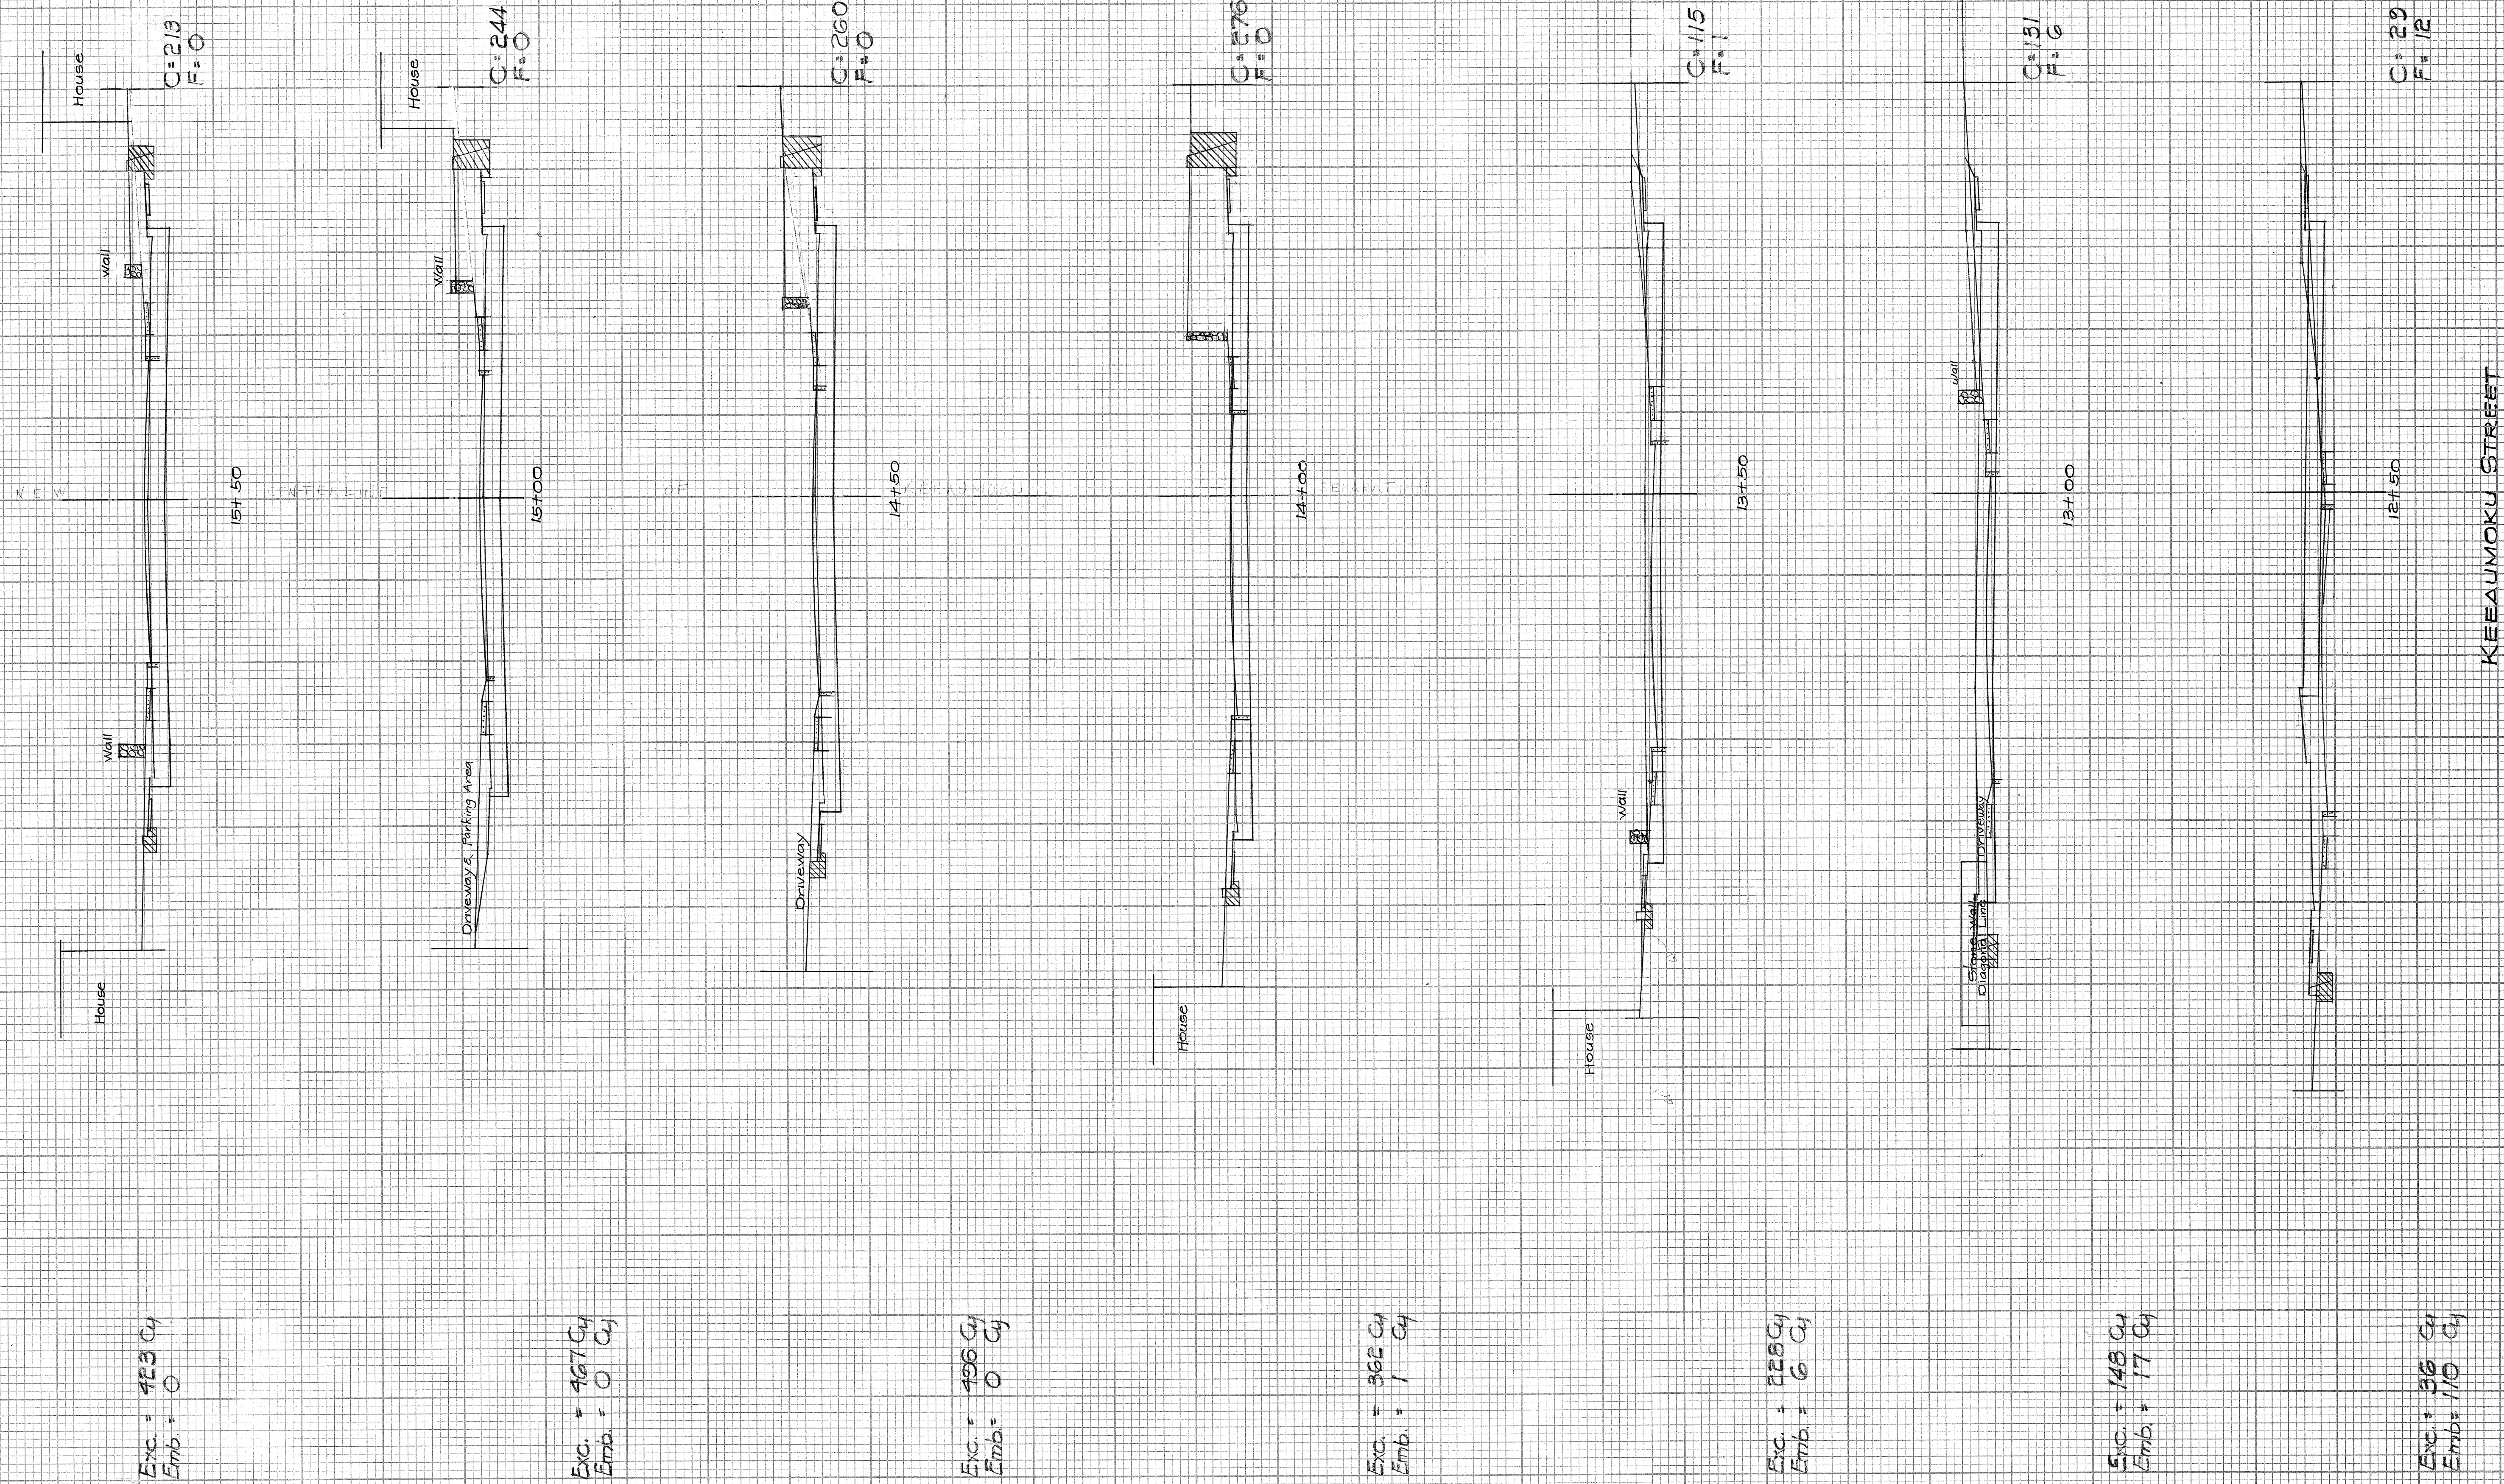



PLATE 3 CROSS SECTION O. P. R. & R. E.
100% RAG PAPER—MADE AND PRINTED IN U. S. A.
CHARLES BRUNING COMPANY

\$183.65

FED. ROAD DIST. No.	STATE	FED. AID PROJ. No.	FISCAL YEAR	SHEET No.	TOTAL SHEETS
HAWAII	HAW.	11-072-1(8)	1959	66	87

FINAL SURVEY	DATE	
	BY	
	SURVEYED	
	NOTE BOOK	
	NO.	

ORIGINAL SURVEY	DATE	
	BY	
	SURVEYED	
	NOTE BOOK	
	NO.	

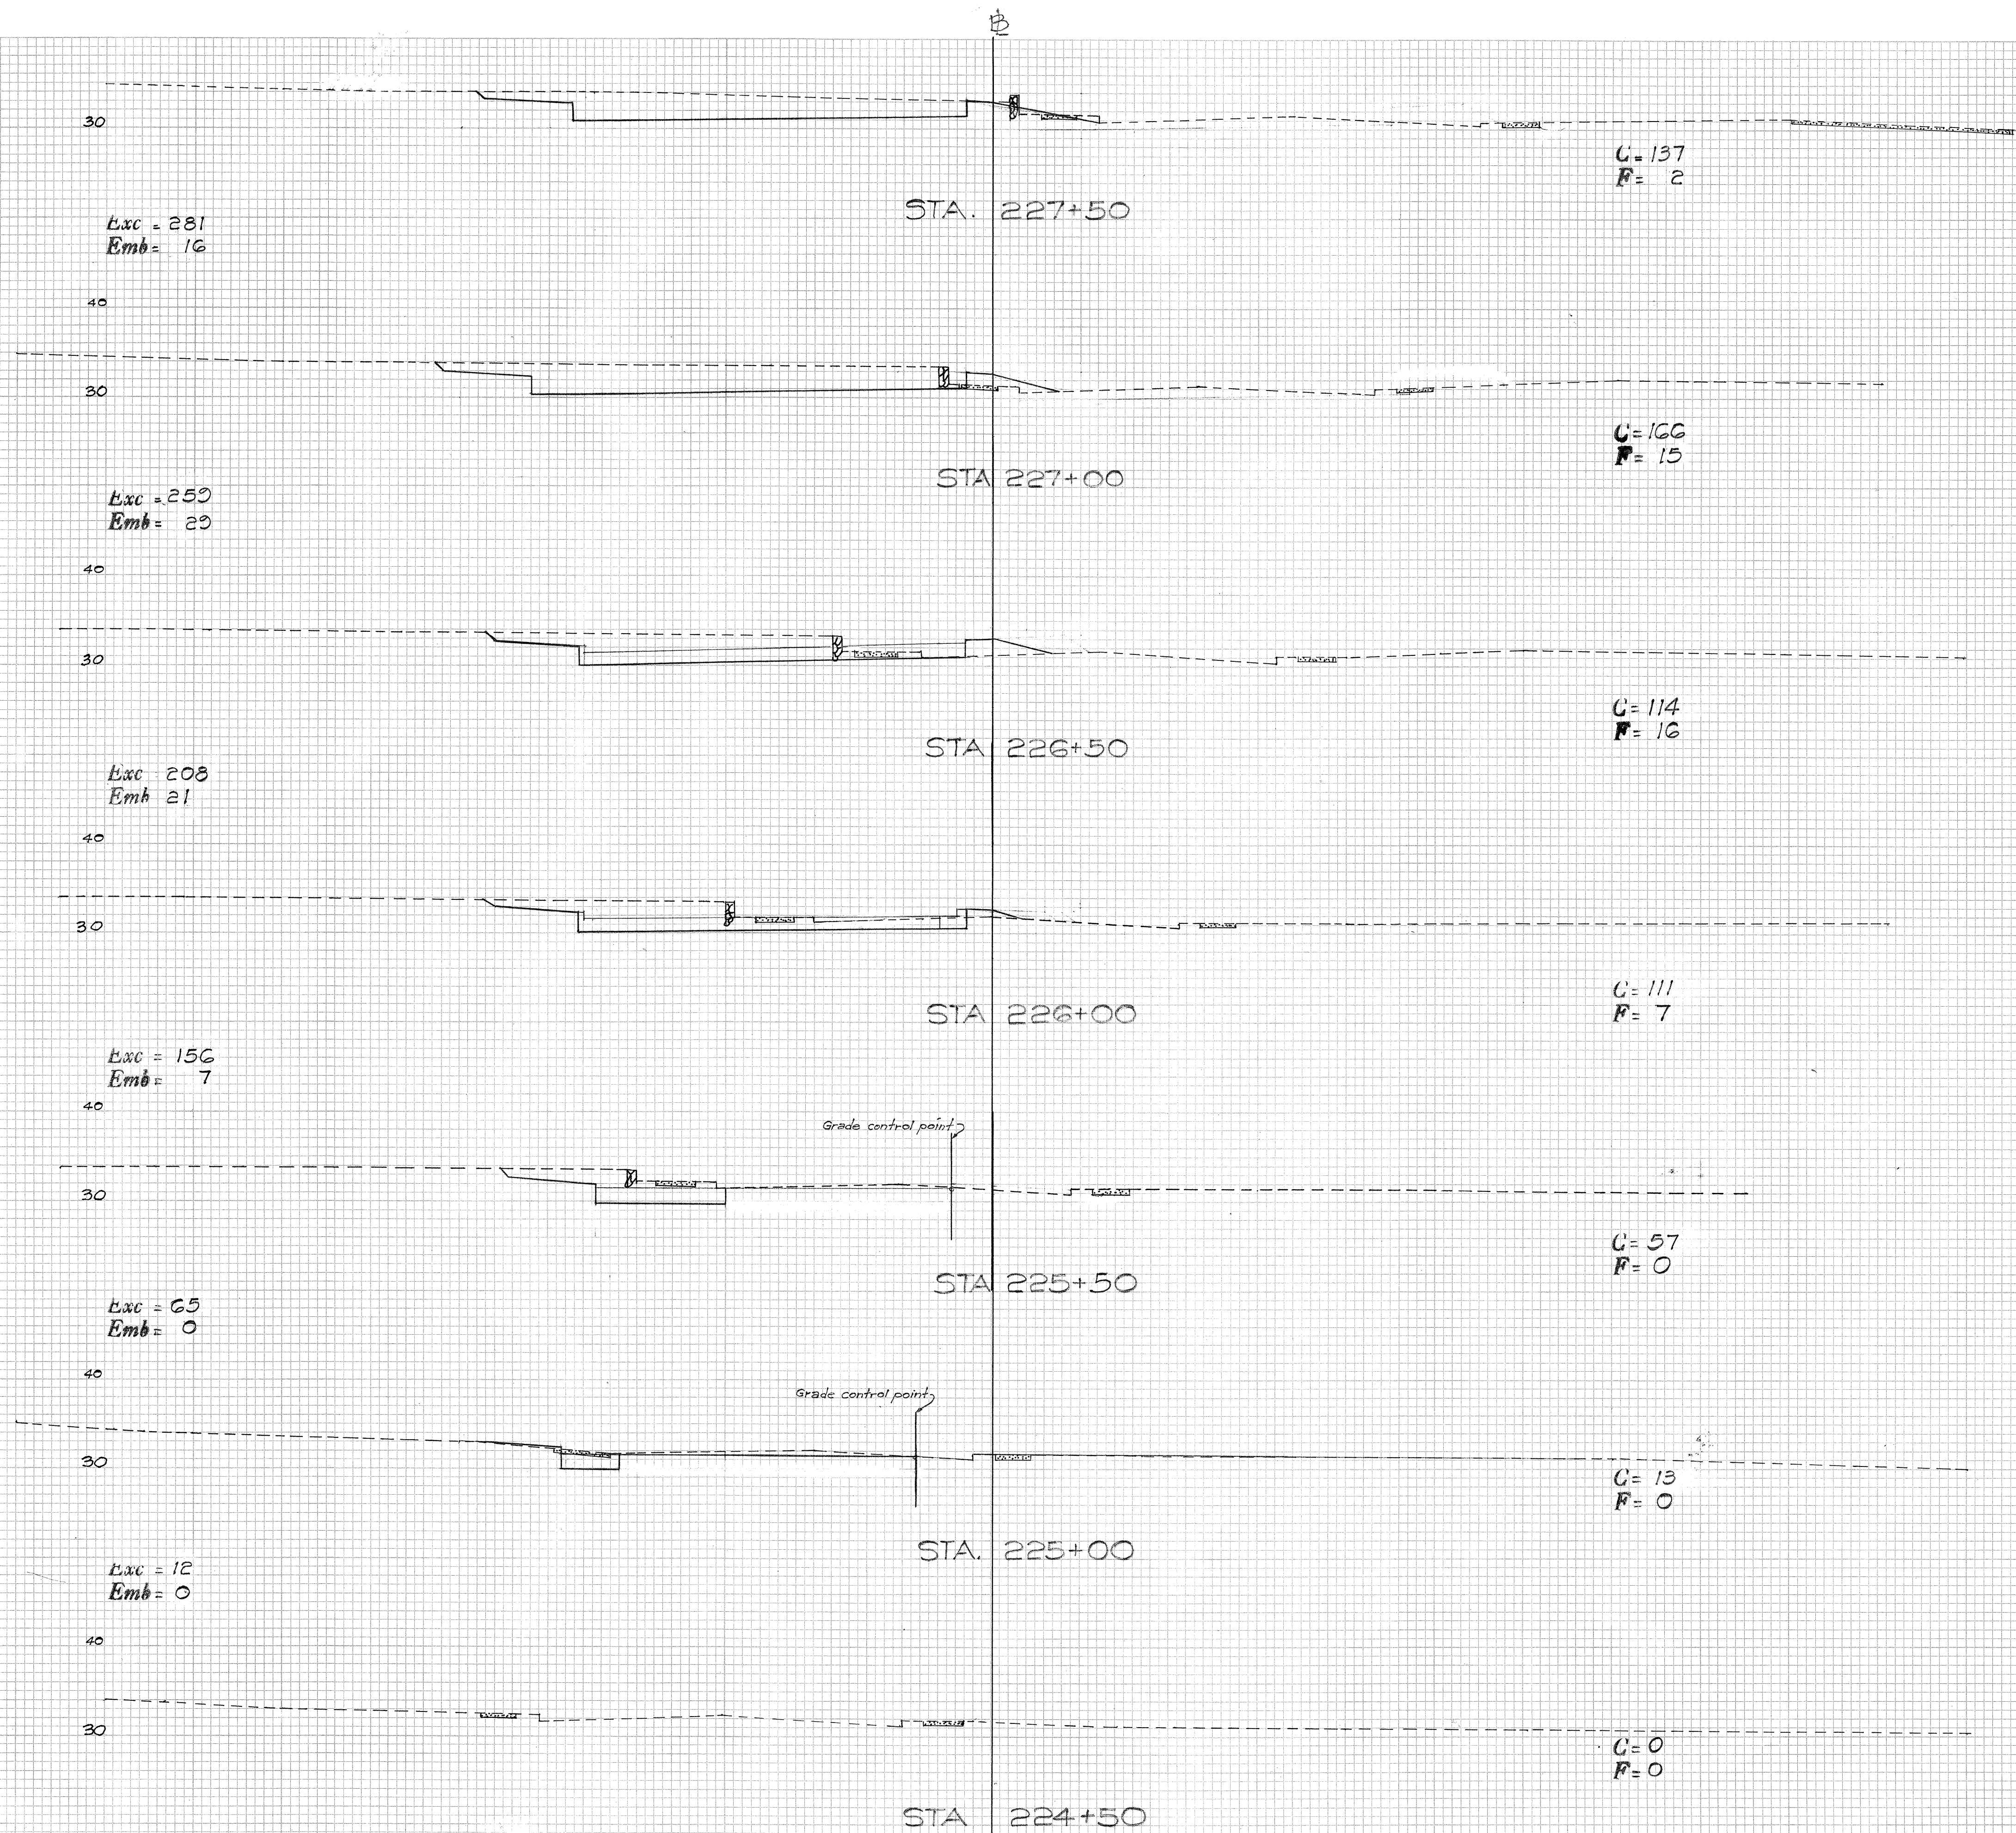

FED. ROAD DIST. No.	STATE	FED. AID PROJ. No.	FISCAL YEAR	SHEET No.	TOTAL SHEETS
HAWAII	HAW.	U-072-1(8)	1959	67	87

FINAL SURVEY	SURVEYED	DATE
NO. _____	BY _____	_____
NOTE BOOK	PLATTED	_____
NO. _____	TEMP. PLATE	_____
	AREAS CHECKED	_____

ORIGINAL SURVEY	SURVEYED	DATE
NO. _____	BY _____	_____
NOTE BOOK	PLATTED	_____
NO. _____	TEMP. PLATE	_____
	AREAS CHECKED	_____

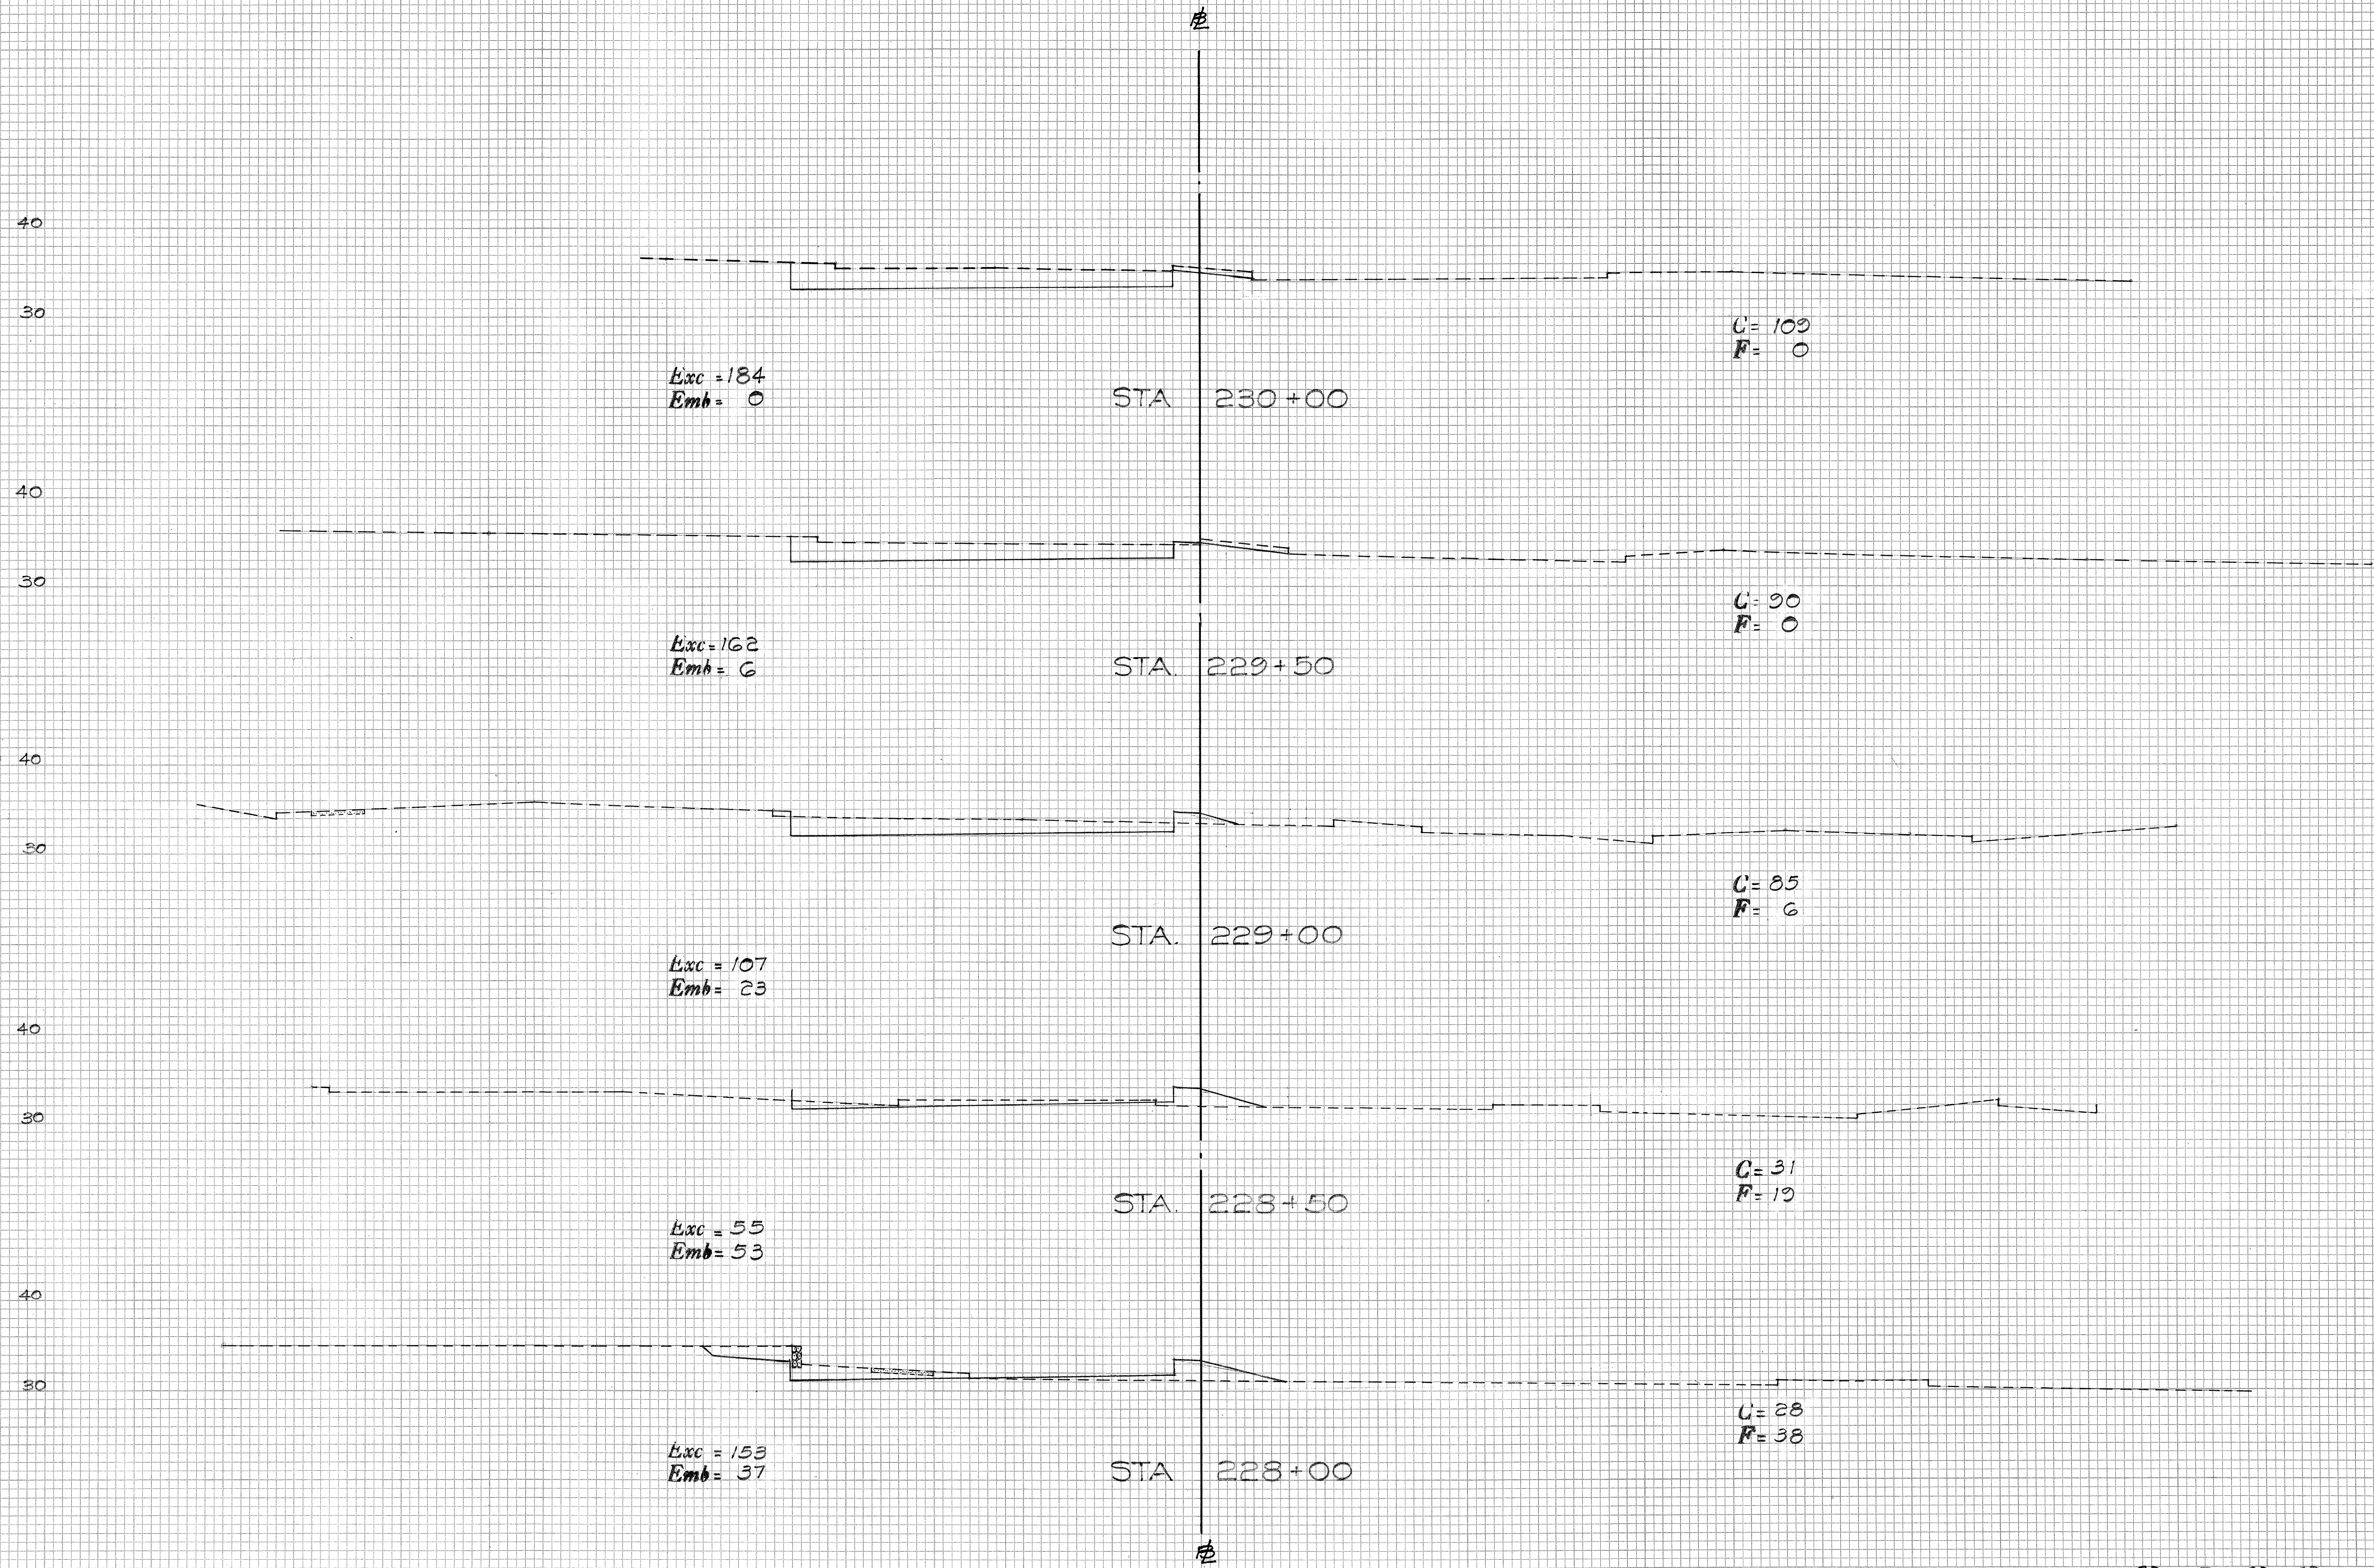


PLATE 20 CROSS SECTION O. P. R. & R. E. STANDARD
100% RAS PAPER-MADE AND PRINTED IN U. S. A.
EUGENE DIETZGEN CO.

\$183.67

FED. ROAD DIST. No.	STATE	FED. AID PROJ. No.	FISCAL YEAR	SHEET No.	TOTAL SHEETS
HAWAII	HAW.	U-072-1(8)	1950	68	87

FINAL SURVEY	SURVEYED	DATE
NOTE BOOK	PLOTTED	BY
NO.	TEMPLATE	
	AREAS CHECKED	

ORIGINAL SURVEY	SURVEYED	DATE
NOTE BOOK	PLOTTED	BY
NO.	TEMPLATE	
	AREAS CHECKED	

Exc =
Emb =

Exc =
Emb =

FRONTAGE ROAD "L"

Exc = 35
Emb = 18

Exc = 32
Emb = 63

Exc = 19
Emb = 88

Exc = 6
Emb = 34

Exc =
Emb =

Exc =
Emb =

C = 25
F = 30

C = 10
F = 38

C = 10
F = 57

C = 0
F = 0

C =
F =

C =
F =

Exc =
Emb =

Exc =
Emb =

Exc =
Emb =

Exc = 33
Emb = 0

Exc = 30
Emb = 4

C =
F =

C =
F =

C =
F =

C = 0
F = 0

C = 36
F = 0


C = 50
F = 3

FED. ROAD DIST. NO.	STATE	FED. AID PROJ. NO.	FISCAL YEAR	SHEET NO.	TOTAL SHEETS
HAWAII	HAW.	U-072-1(8)	1950	60	87


DATE	BY	DATE	BY
FINAL SURVEY	SURVEYED	PLOTTED	REVIEWED
NOTE BOOK	NO. _____	AREAS CHECKED	NO. _____

DATE	BY	DATE	BY
ORIGINAL SURVEY	SURVEYED	PLOTTED	REVIEWED
NOTE BOOK	NO. _____	AREAS CHECKED	NO. _____


Exc = 42
Emb = 13

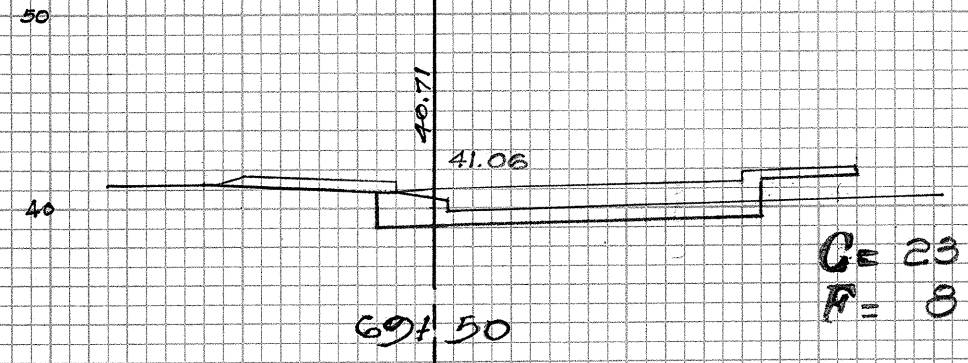


Exc = 60
Emb = 7

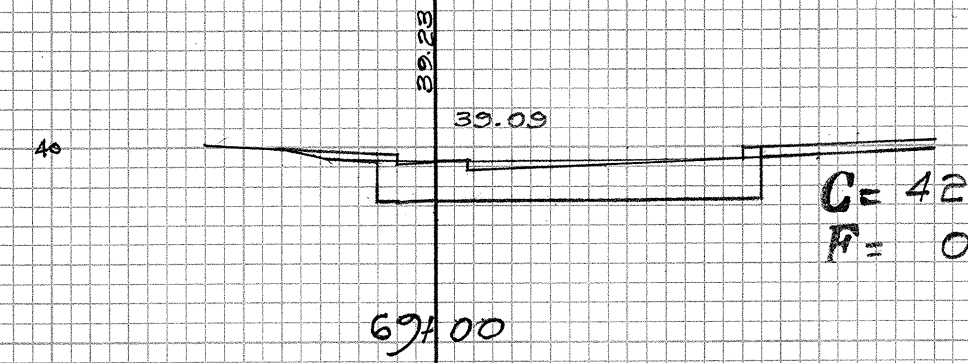


Exc = 39
Emb = 0

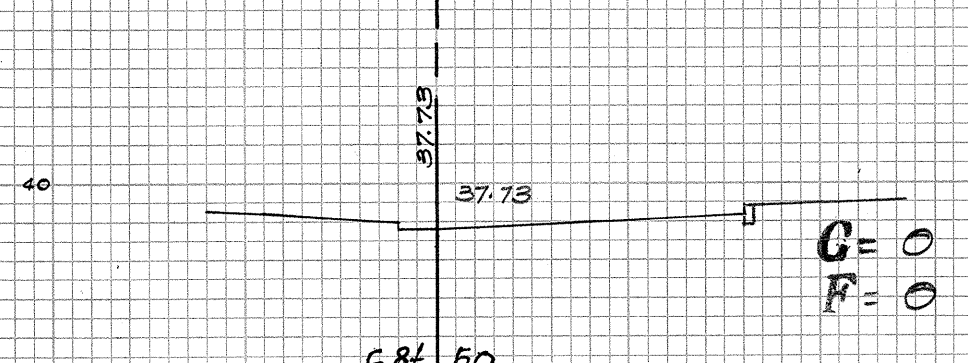


Exc = 0
Emb = 0

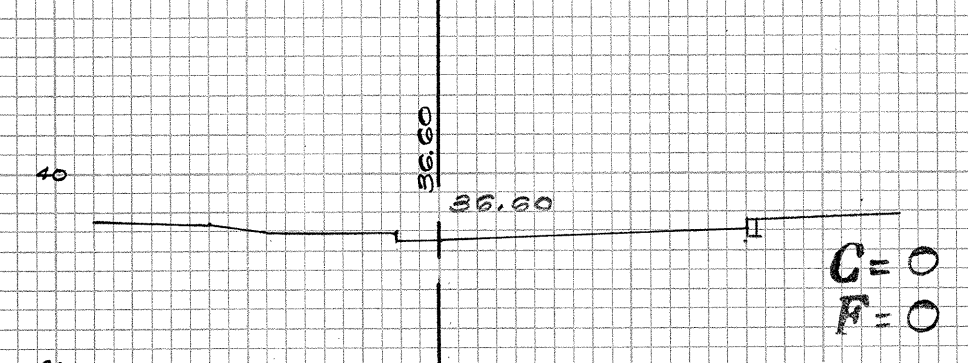


Exc = 0
Emb = 0

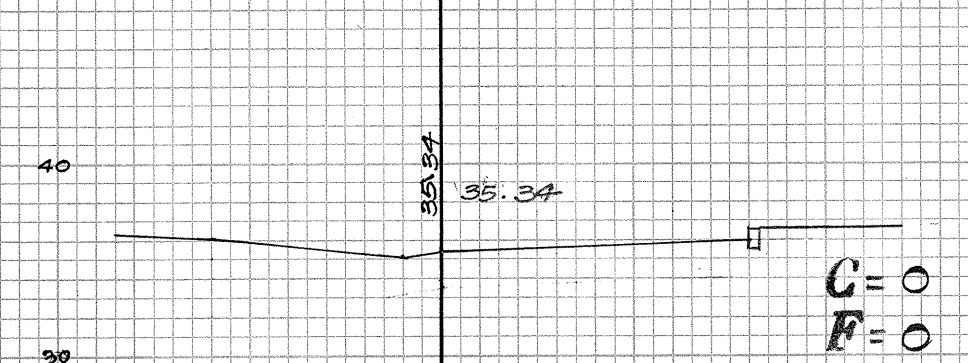


Exc = 0
Emb = 0

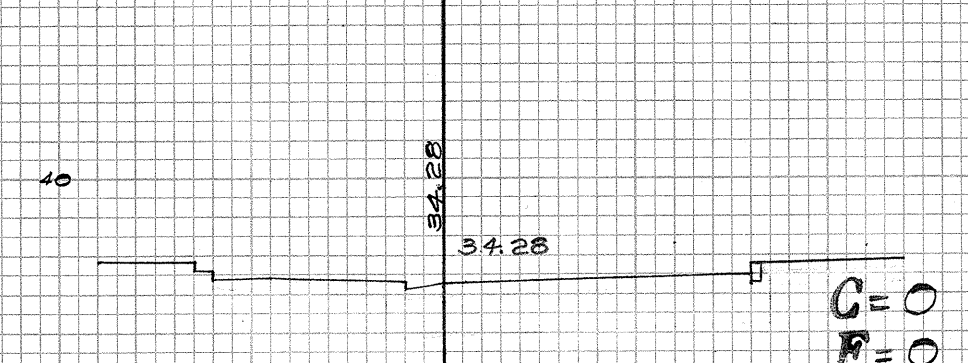


Exc =
Emb =

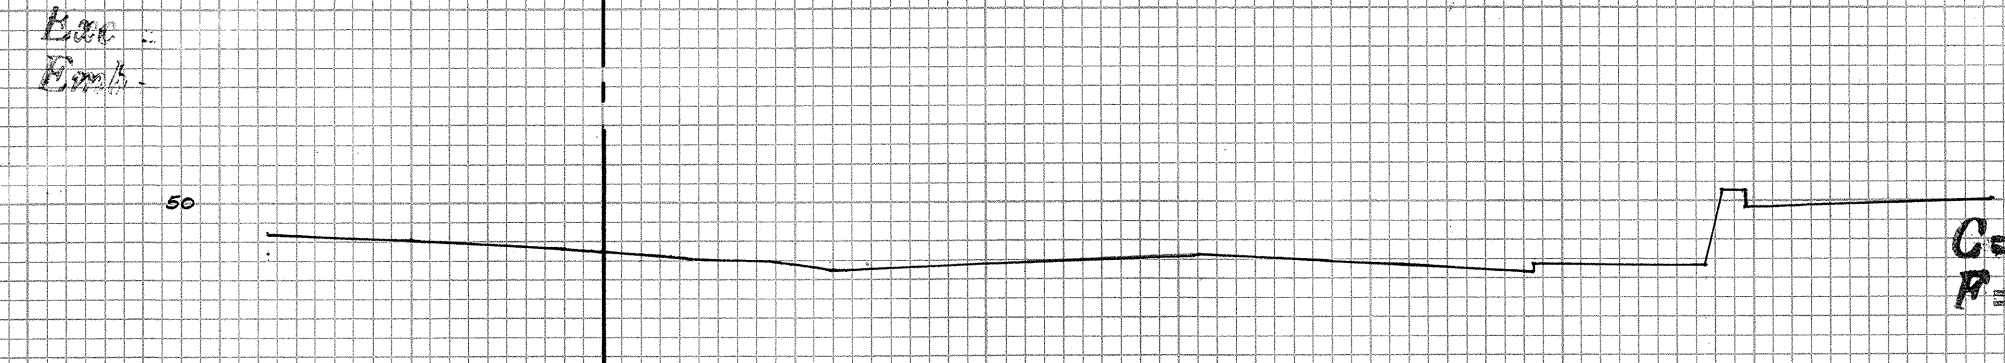


Exc =
Emb =

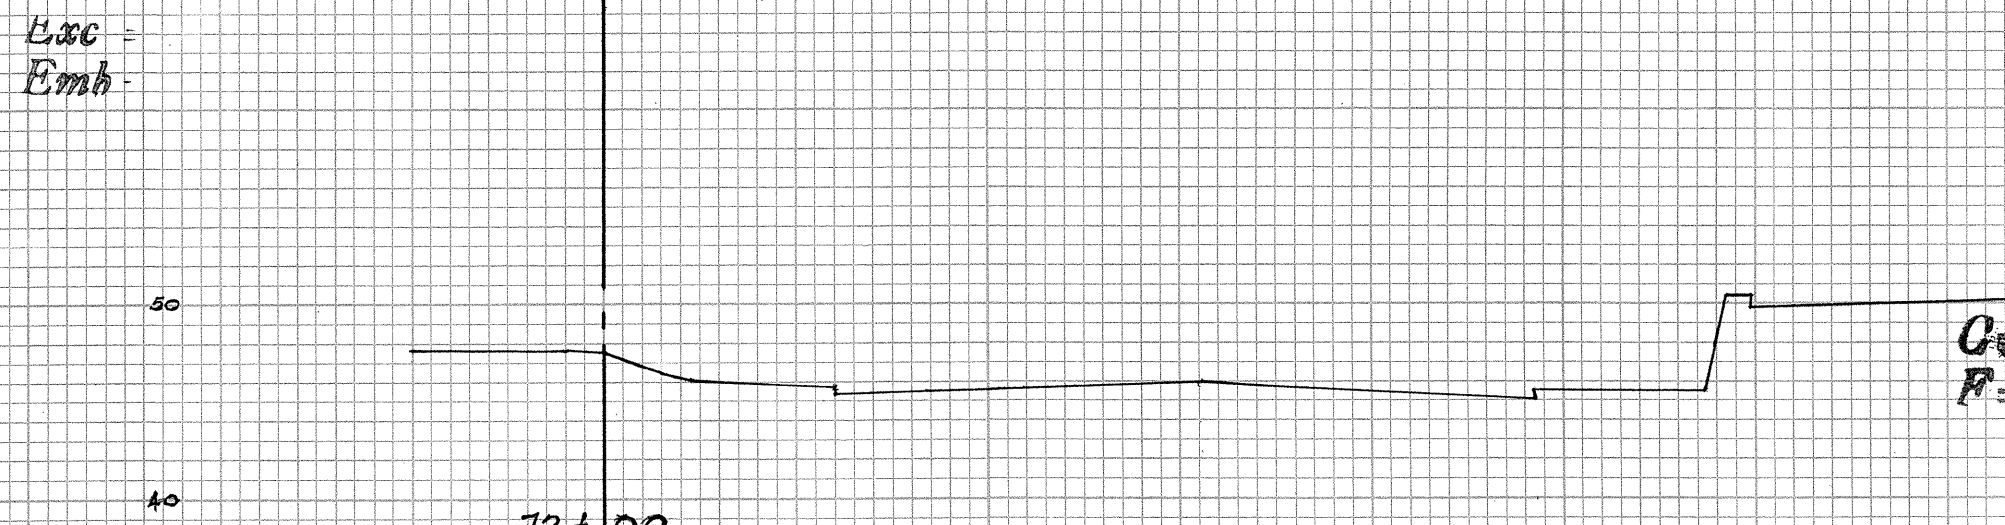


Exc =
Emb =

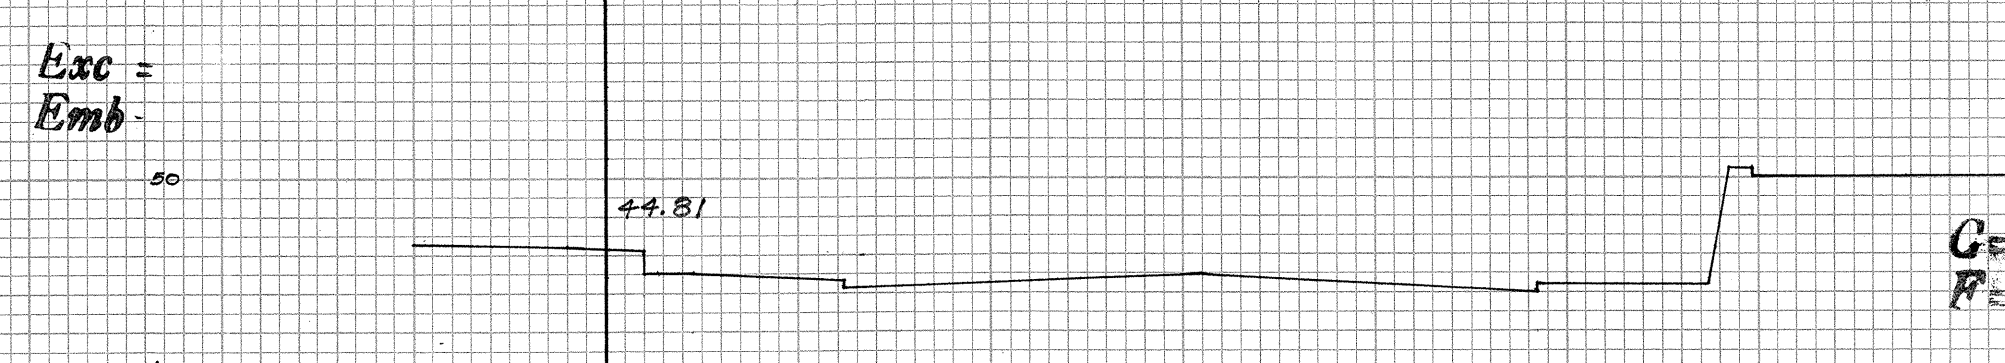


Exc =
Emb =

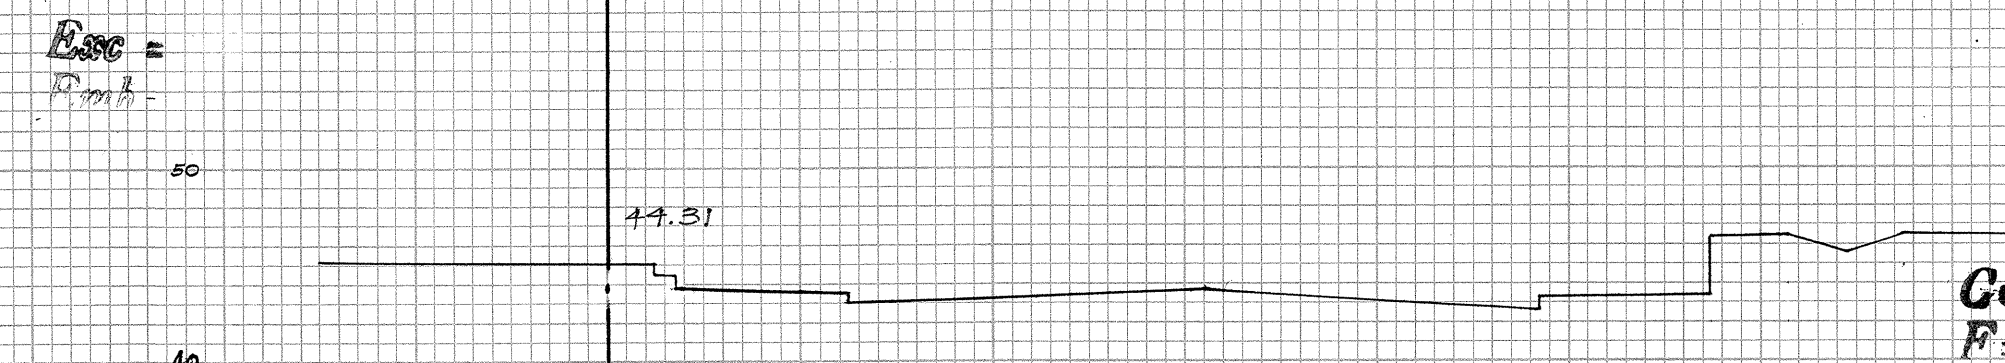


Exc = 10
Emb = 8

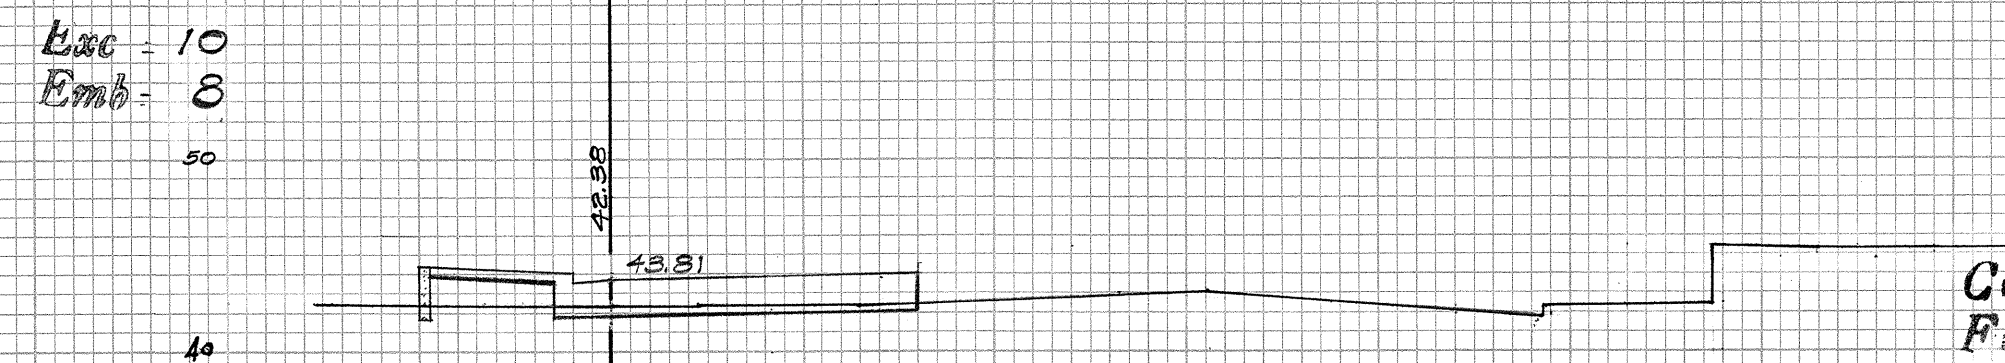


Exc = 38
Emb = 13

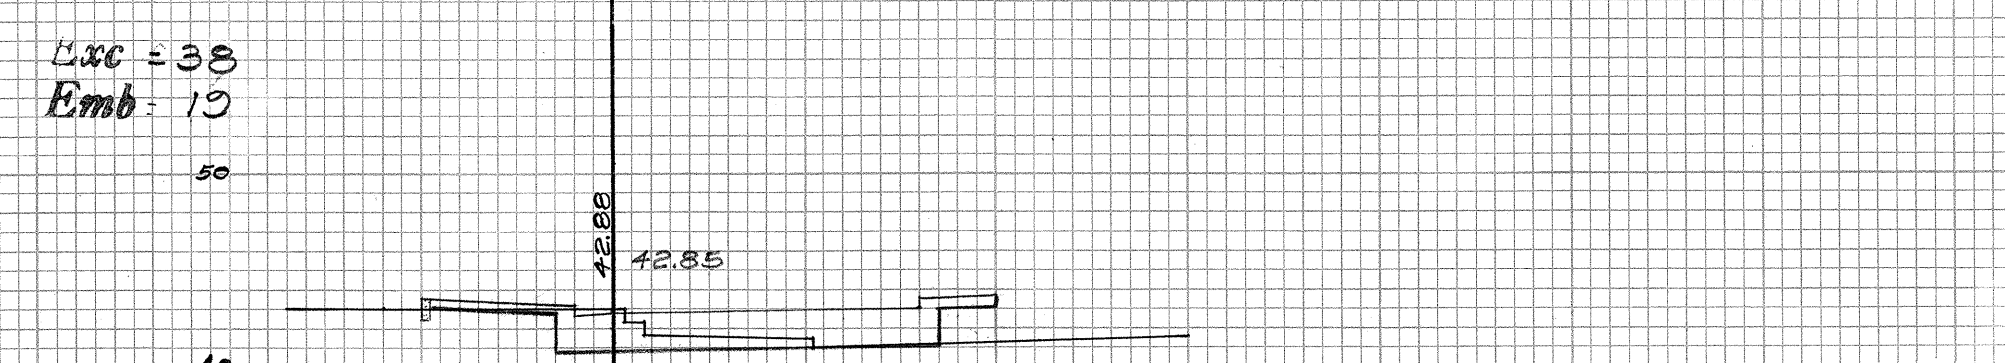


Exc = 22
Emb = 0

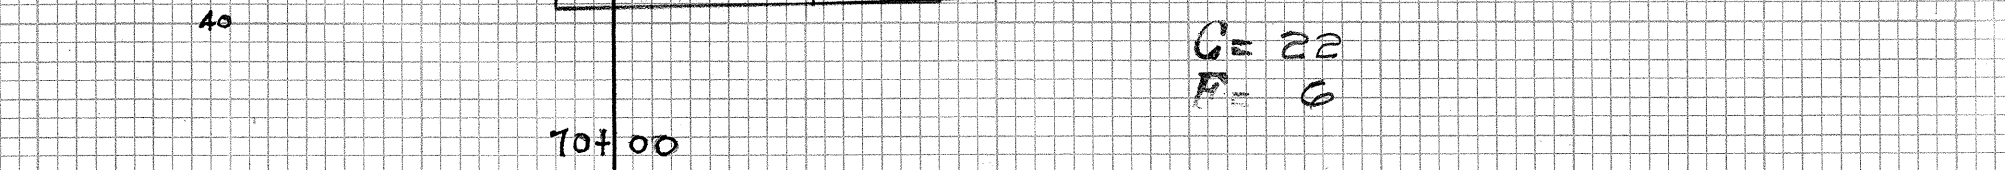

Exc =
Emb =

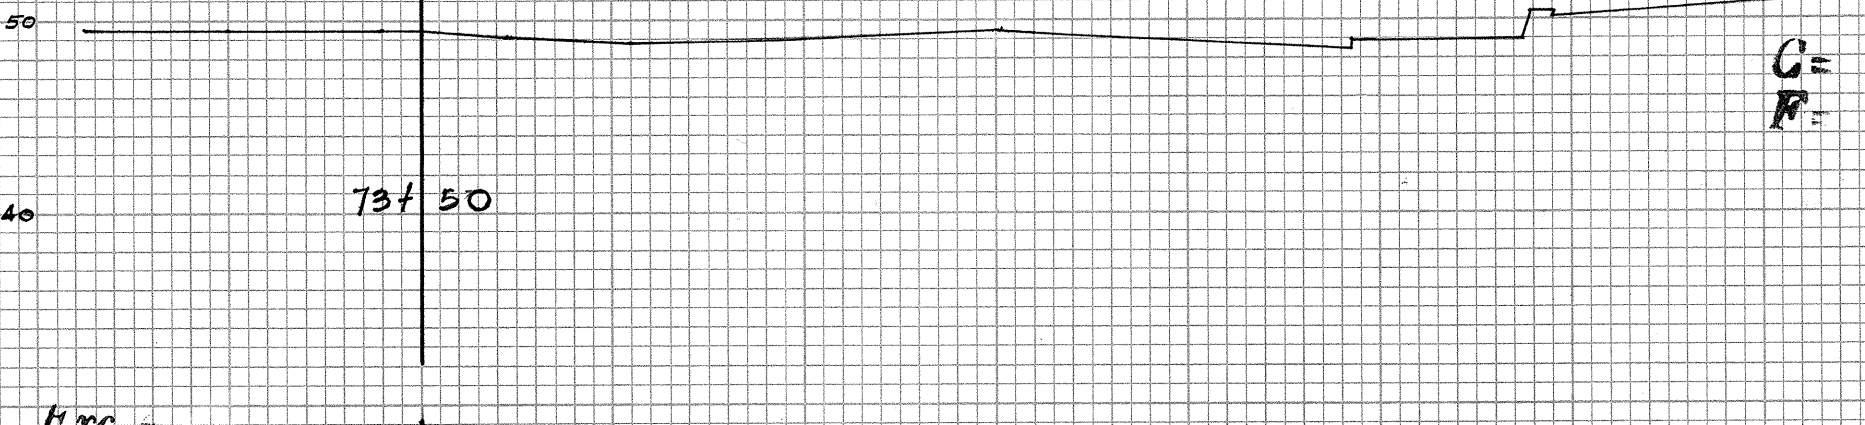

Exc =
Emb =

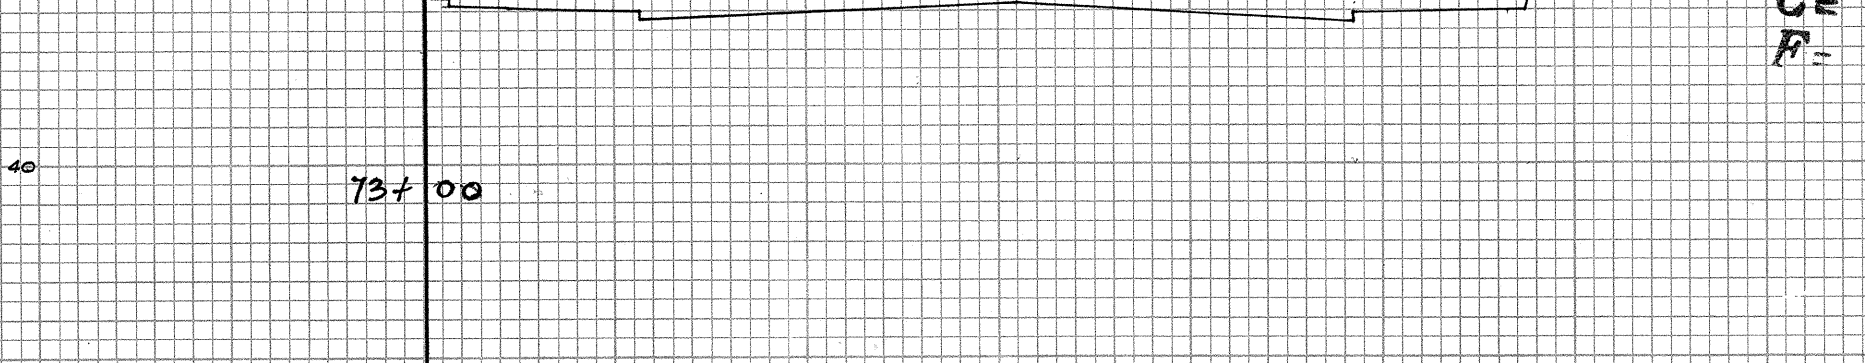


FRONTAGE ROAD "J"

FED. ROAD DIST. No.	STATE	FED. AID PROJ. No.	FISCAL YEAR	SHEET No.	TOTAL SHEETS
HAWAII	HAW.	U-072-1(8)	1959	70	87


FINAL SURVEY	DATE	BY
SURVEYED		
NOTED		
PLOTTED		
AREAS CHECKED		

ORIGINAL SURVEY	DATE	BY
SURVEYED		
NOTED		
PLOTTED		
AREAS CHECKED		


Exc = 31
Emb = 3

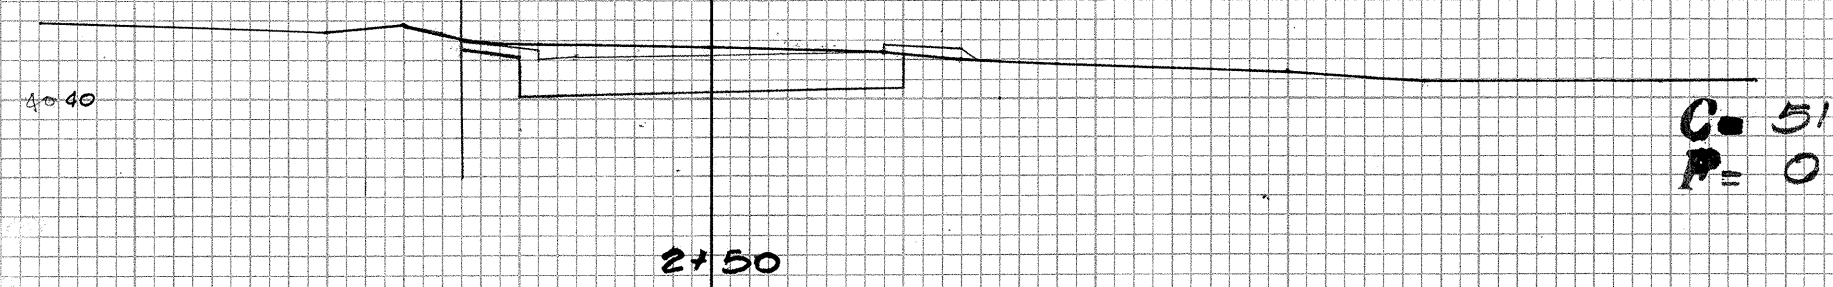


Exc = 35
Emb = 0

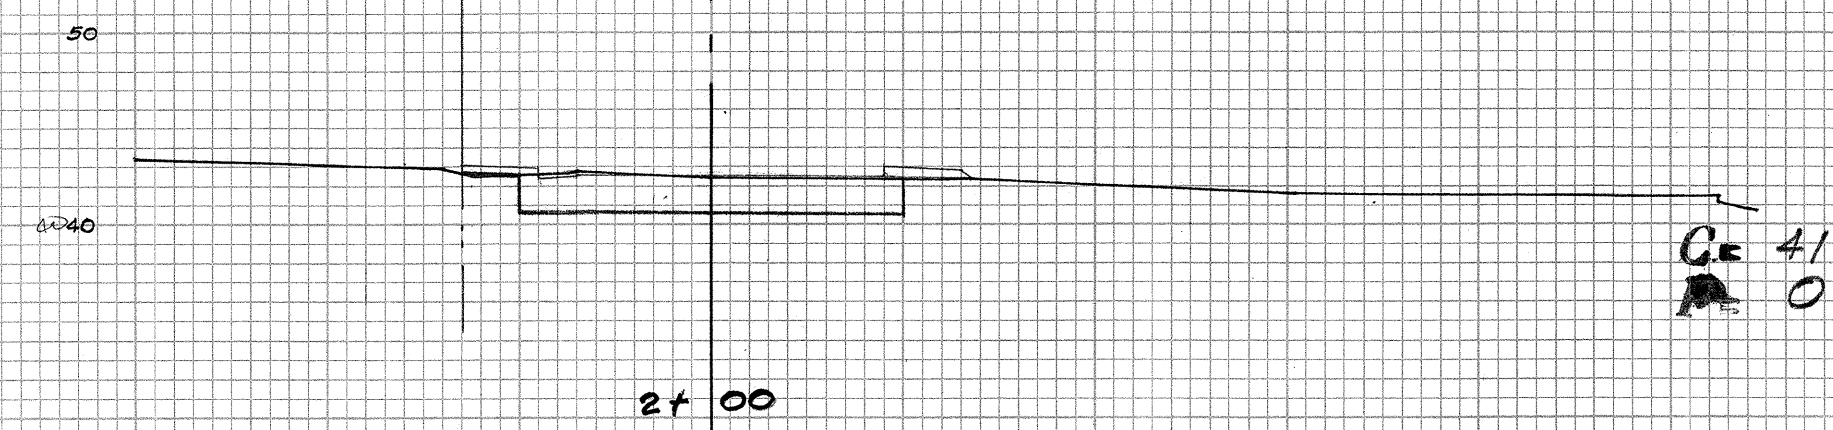


Exc = 37
Emb = 2

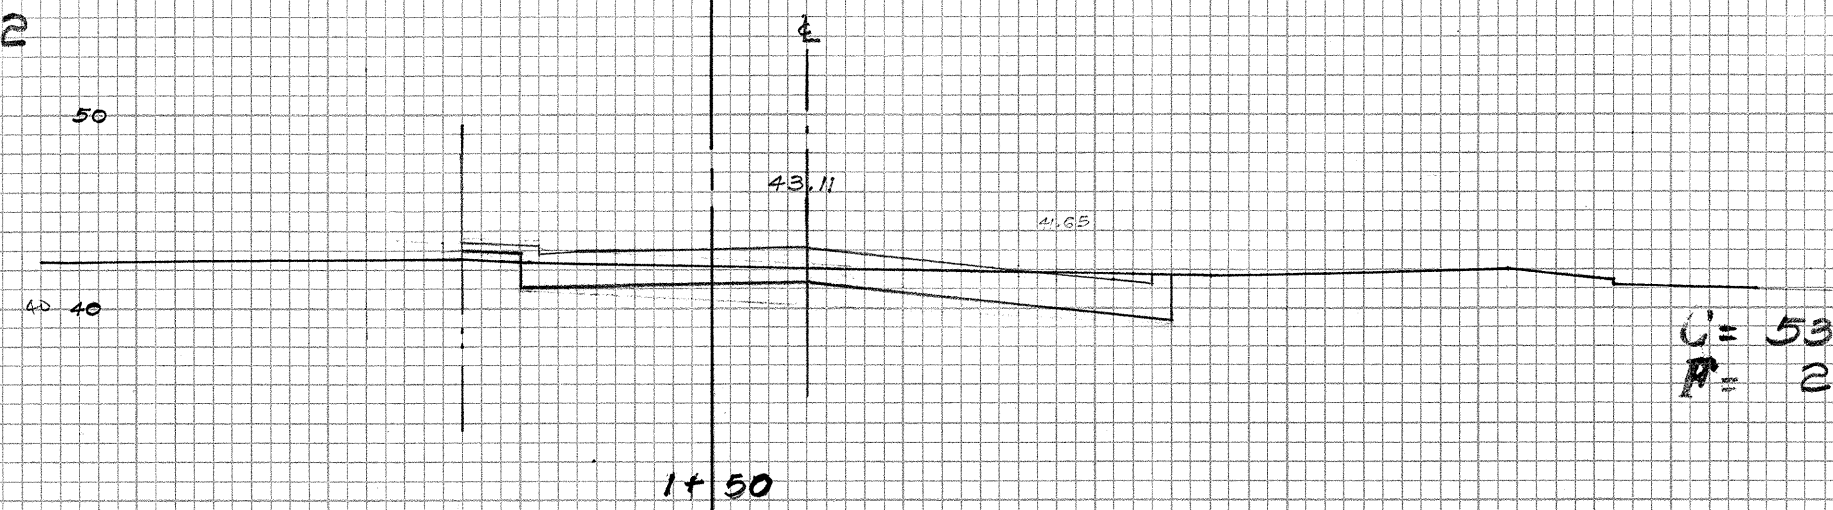


Exc = 63
Emb = 13

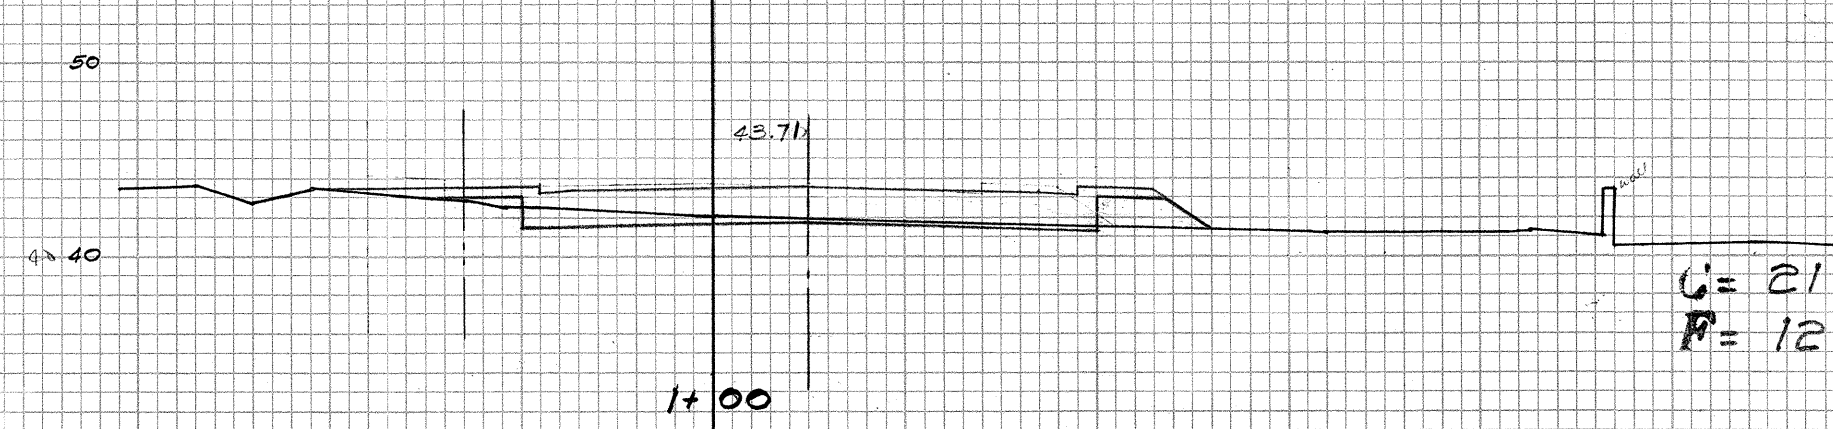


Exc = 13
Emb = 11

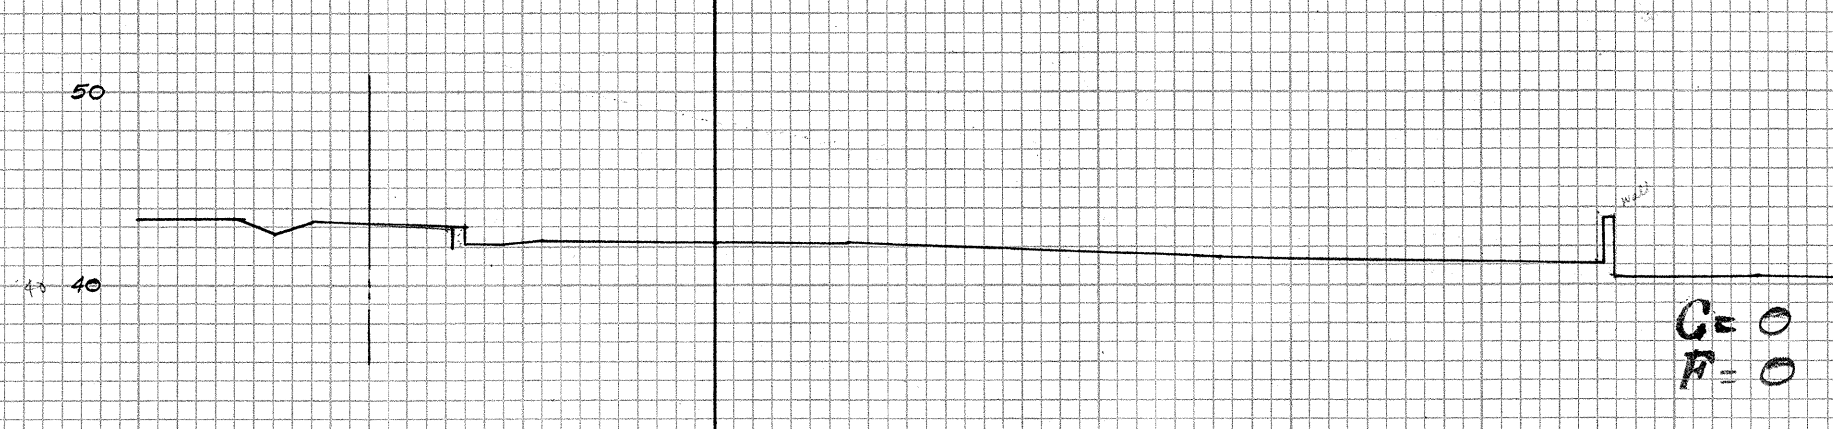


Exc = 0
Emb = 0

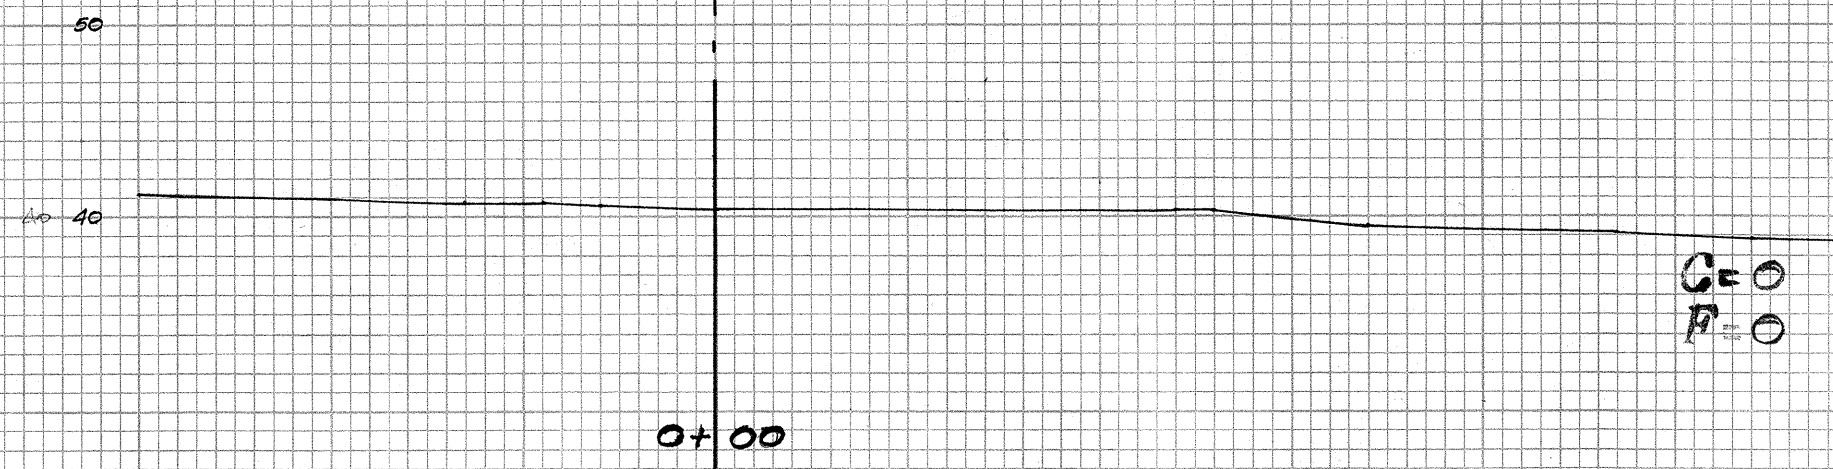


FRONTAGE ROAD "M"

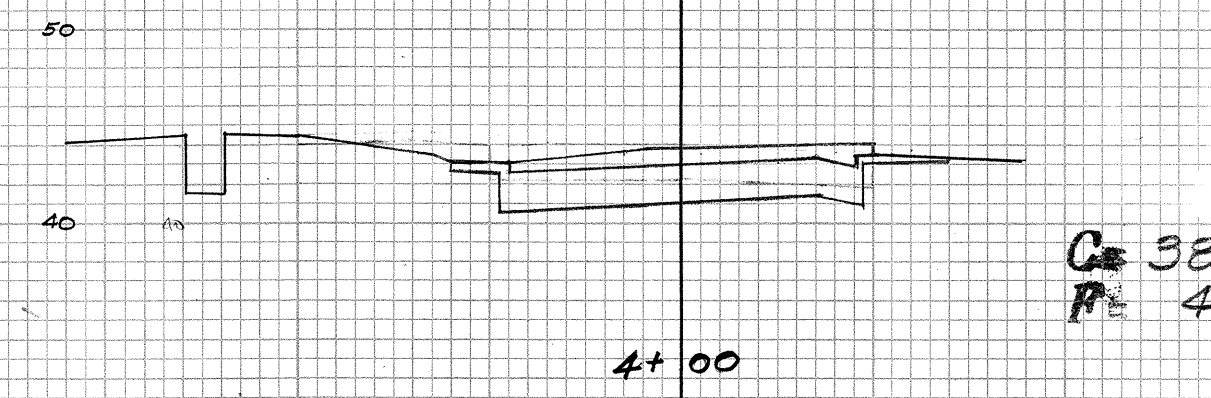


Exc = 57
Emb = 14

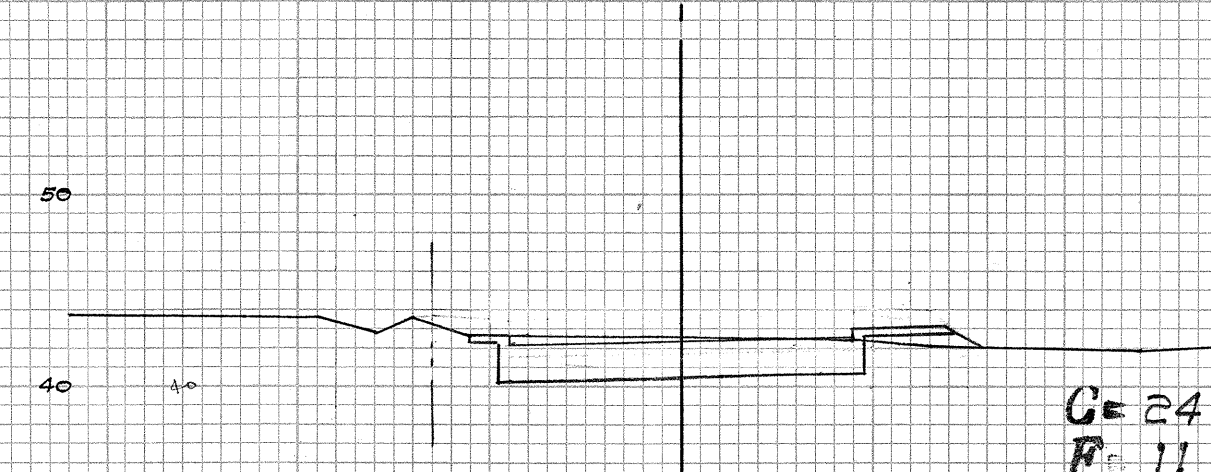


Exc = 50
Emb = 13

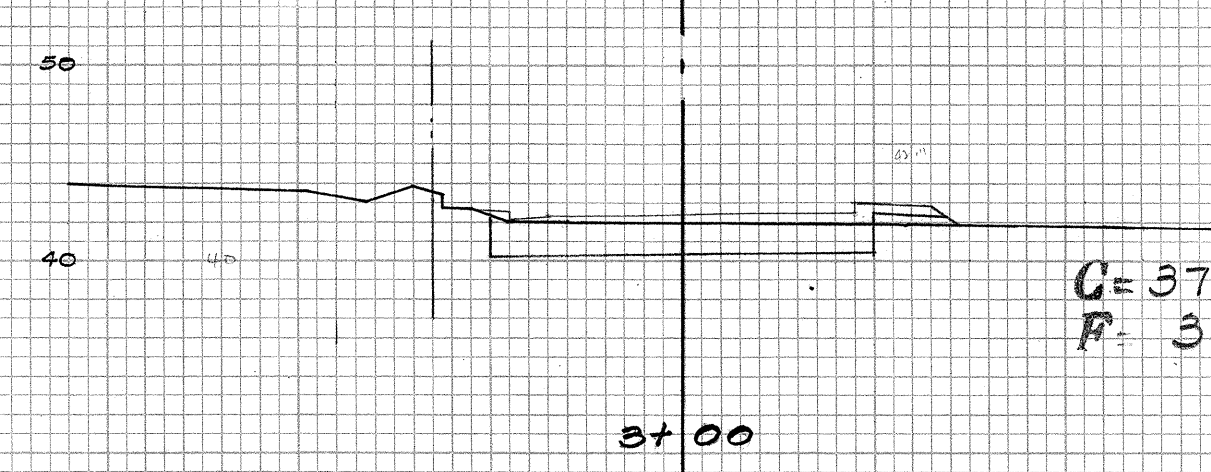


3+00

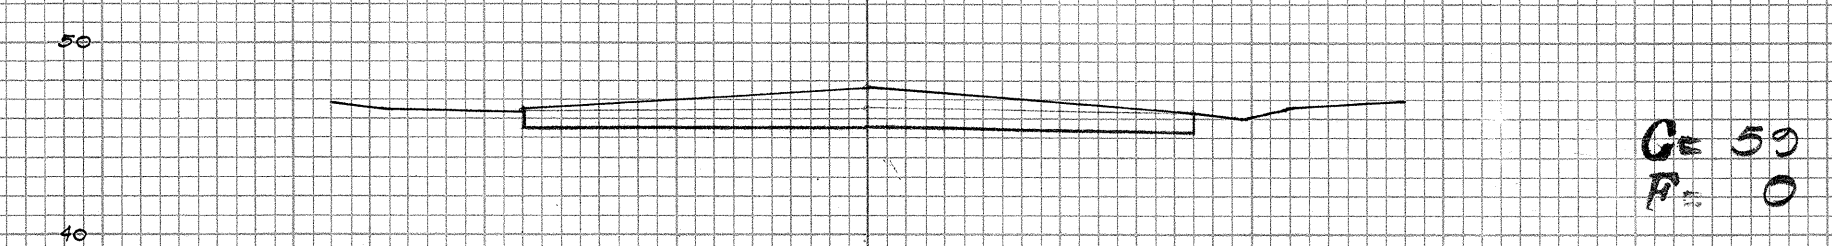


Exc = 31
Emb = 0

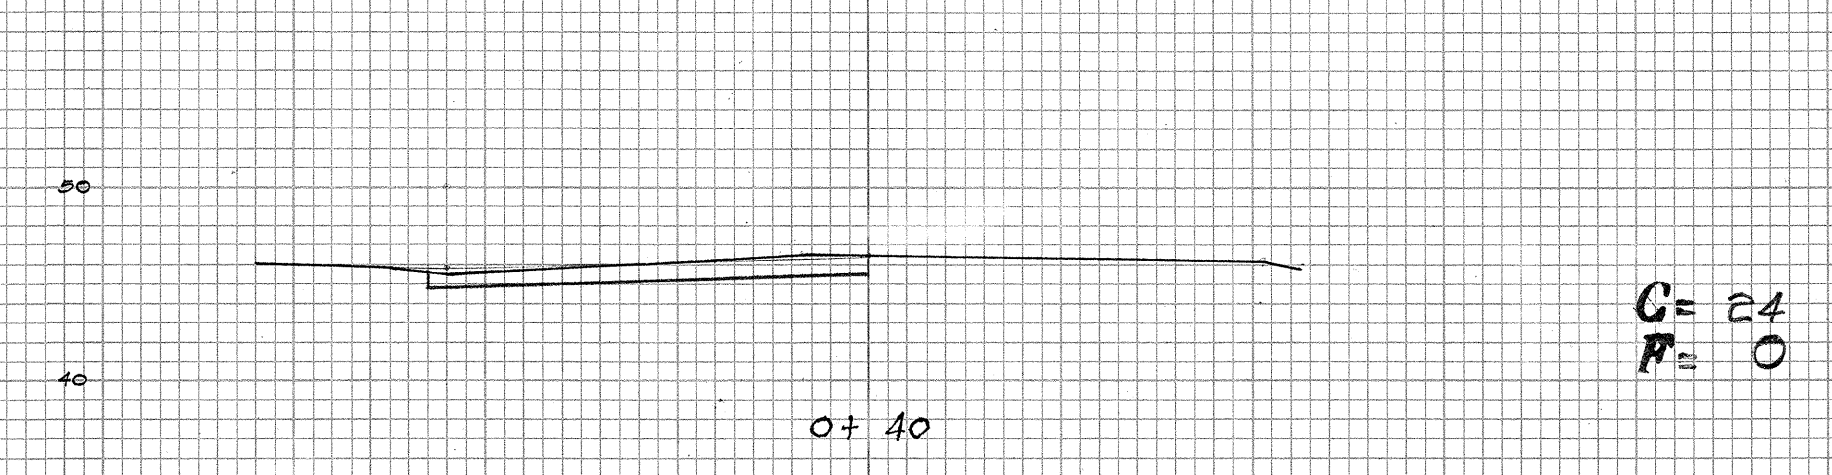

Exc = 50
Emb = 0

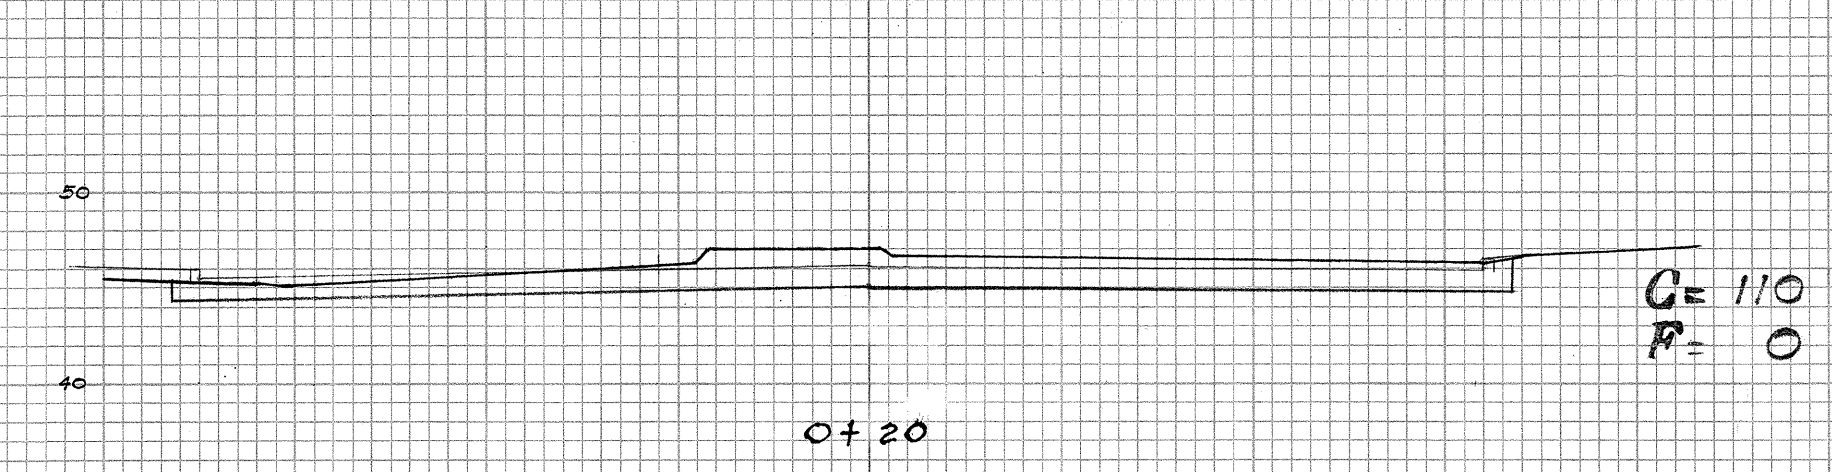

Exc = 105
Emb = 0

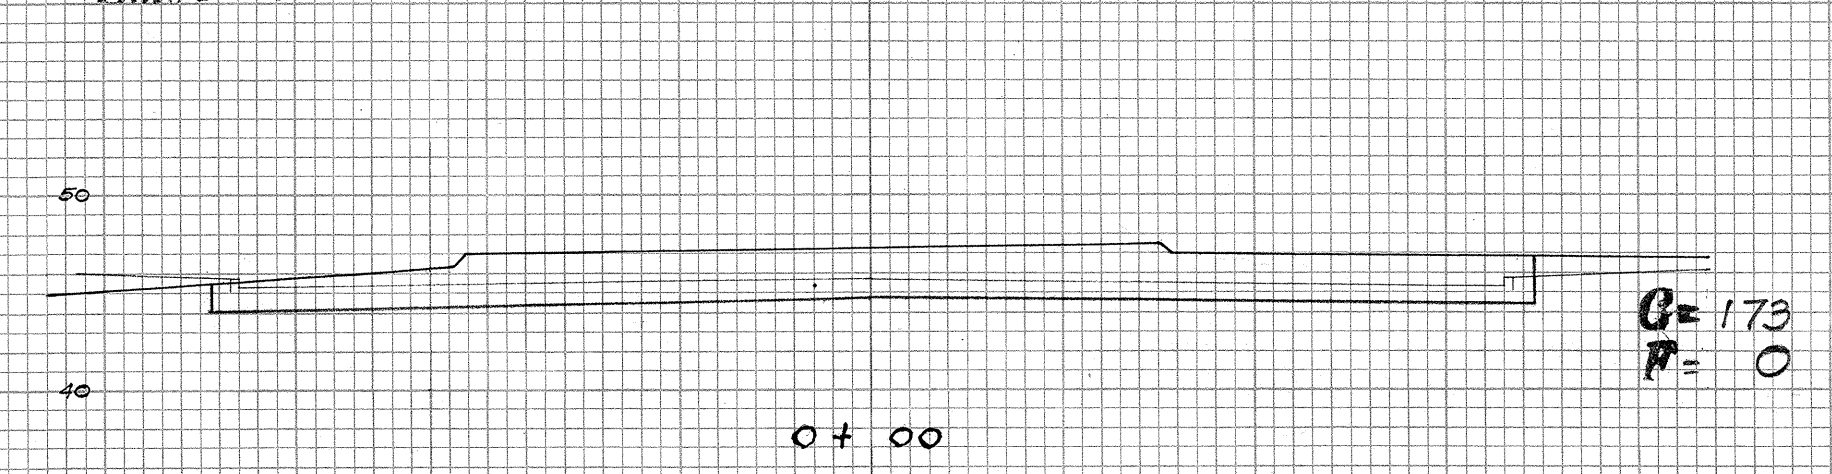

0+00

MAKIKI STREET TURN AROUND

8183.70