
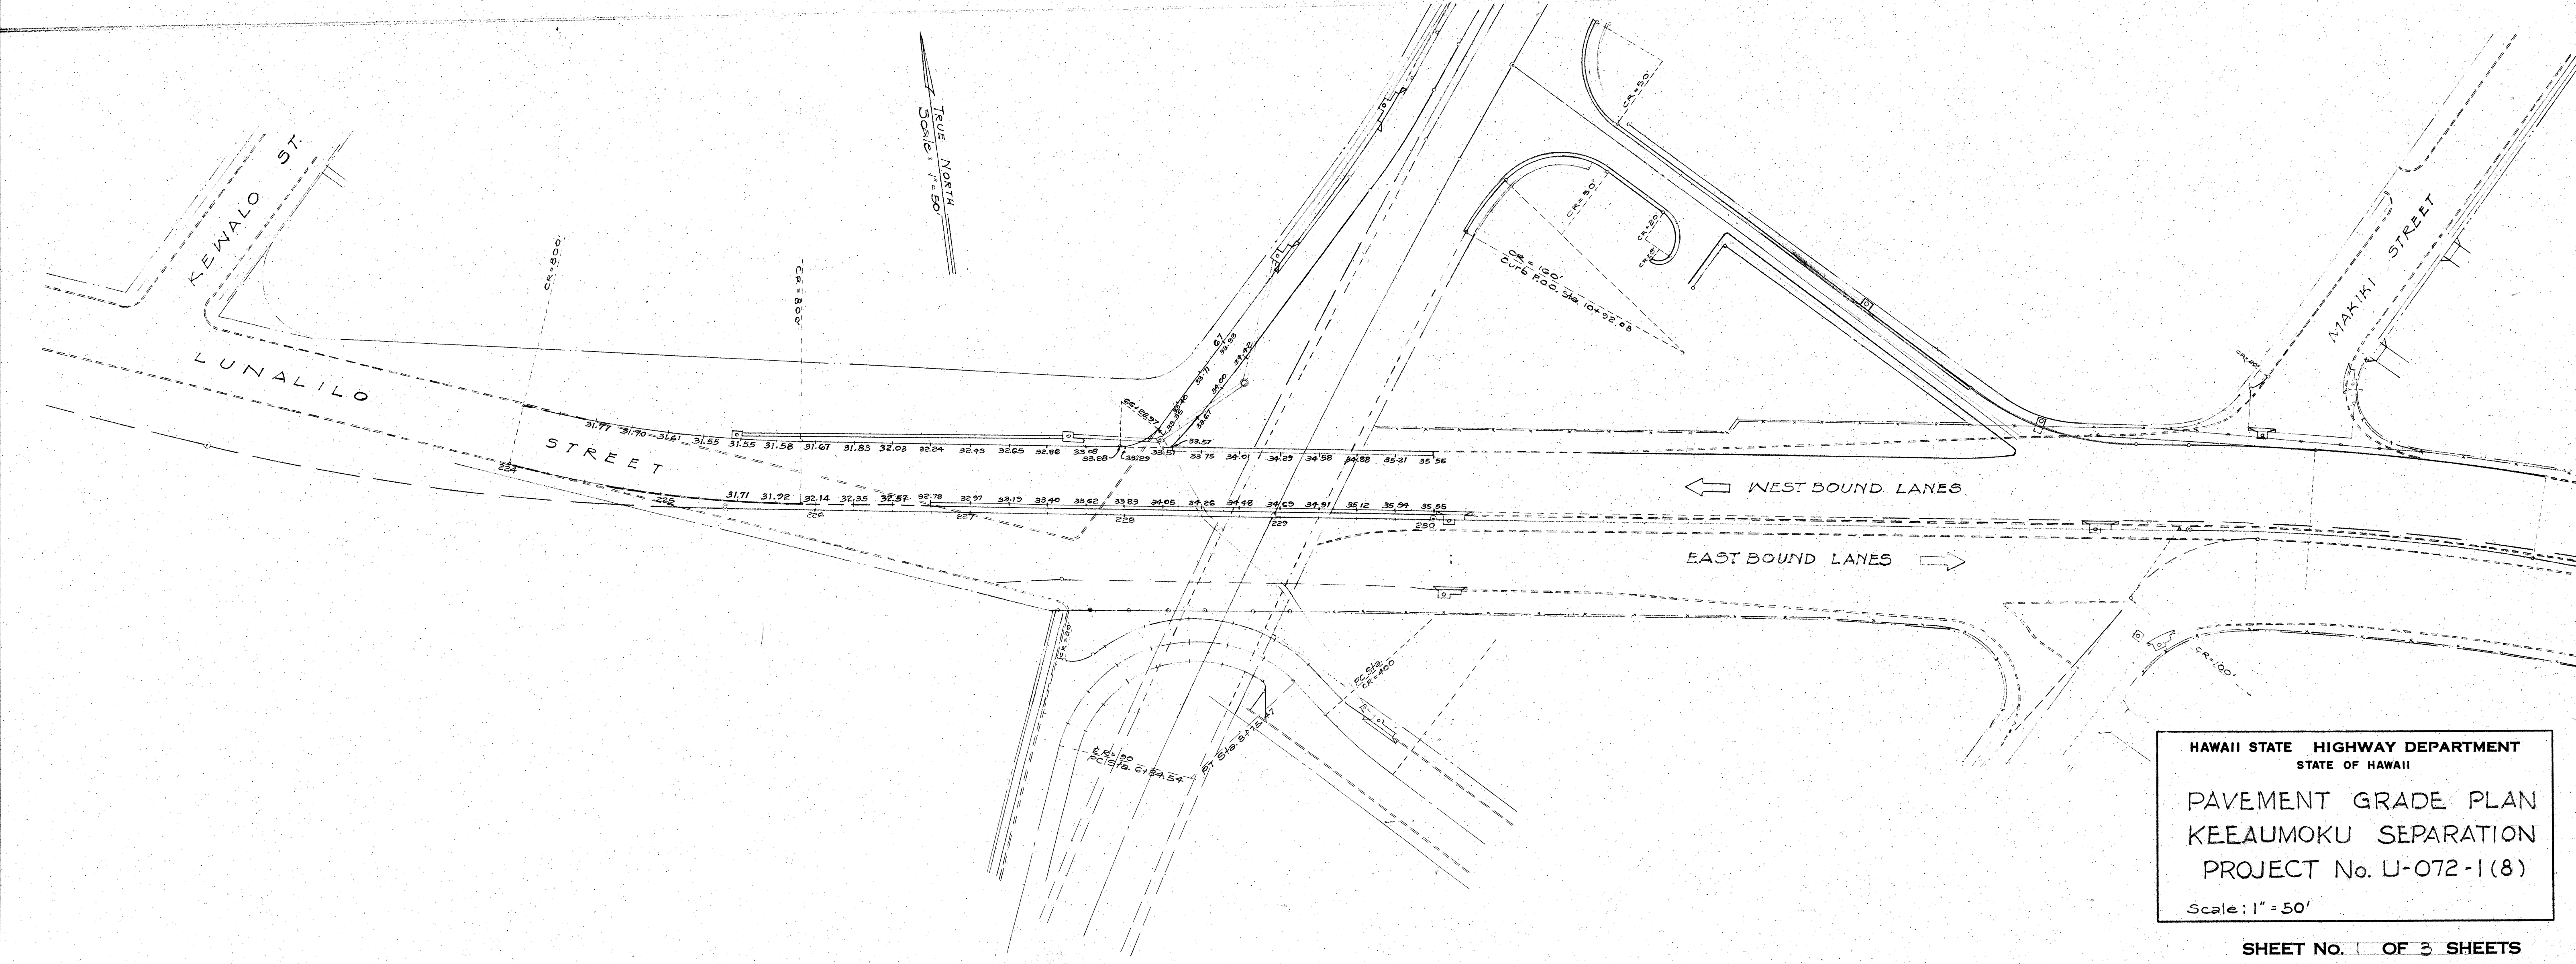


FED. ROAD DIST. NO.	STATE	FED. AID PROJ. NO.	FISCAL YEAR	SHEET NO.	TOTAL SHEETS
Hawaii	Haw.	U-072-1(8)	1959	10	81

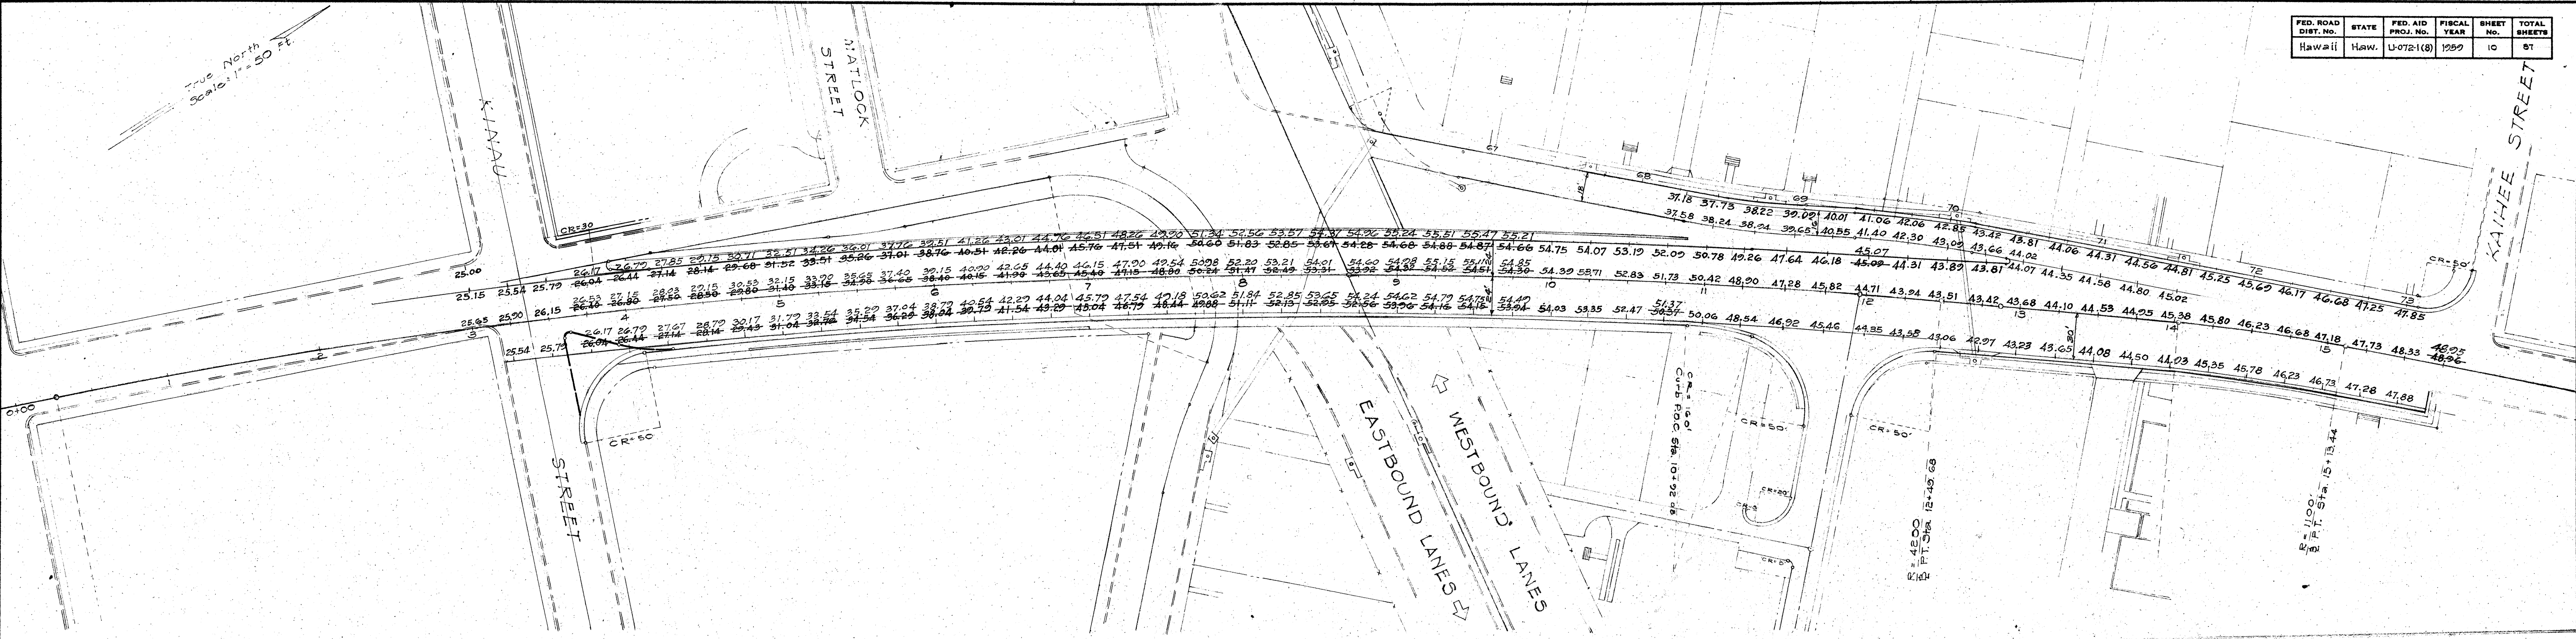

ORIGINAL PLAN	DATE
DESIGNED BY	
DRAWN BY	
CHECKED BY	
NOTE BOOK	
QUANTITIES CHECKED BY	
NO.	

HAWAII STATE HIGHWAY DEPARTMENT
STATE OF HAWAII


PAVEMENT GRADE PLAN
KEEAUMOKU SEPARATION
PROJECT No. U-072-1(8)

Scale: 1" = 50'

SHEET NO. 10 OF 81 SHEETS

\$183.10






FED. ROAD DIST. No.	STATE	FED. AID PROJ. No.	FISCAL YEAR	SHEET No.	TOT SHE
HAWAII	HAW.	U-072-1(8)	1959	11	8

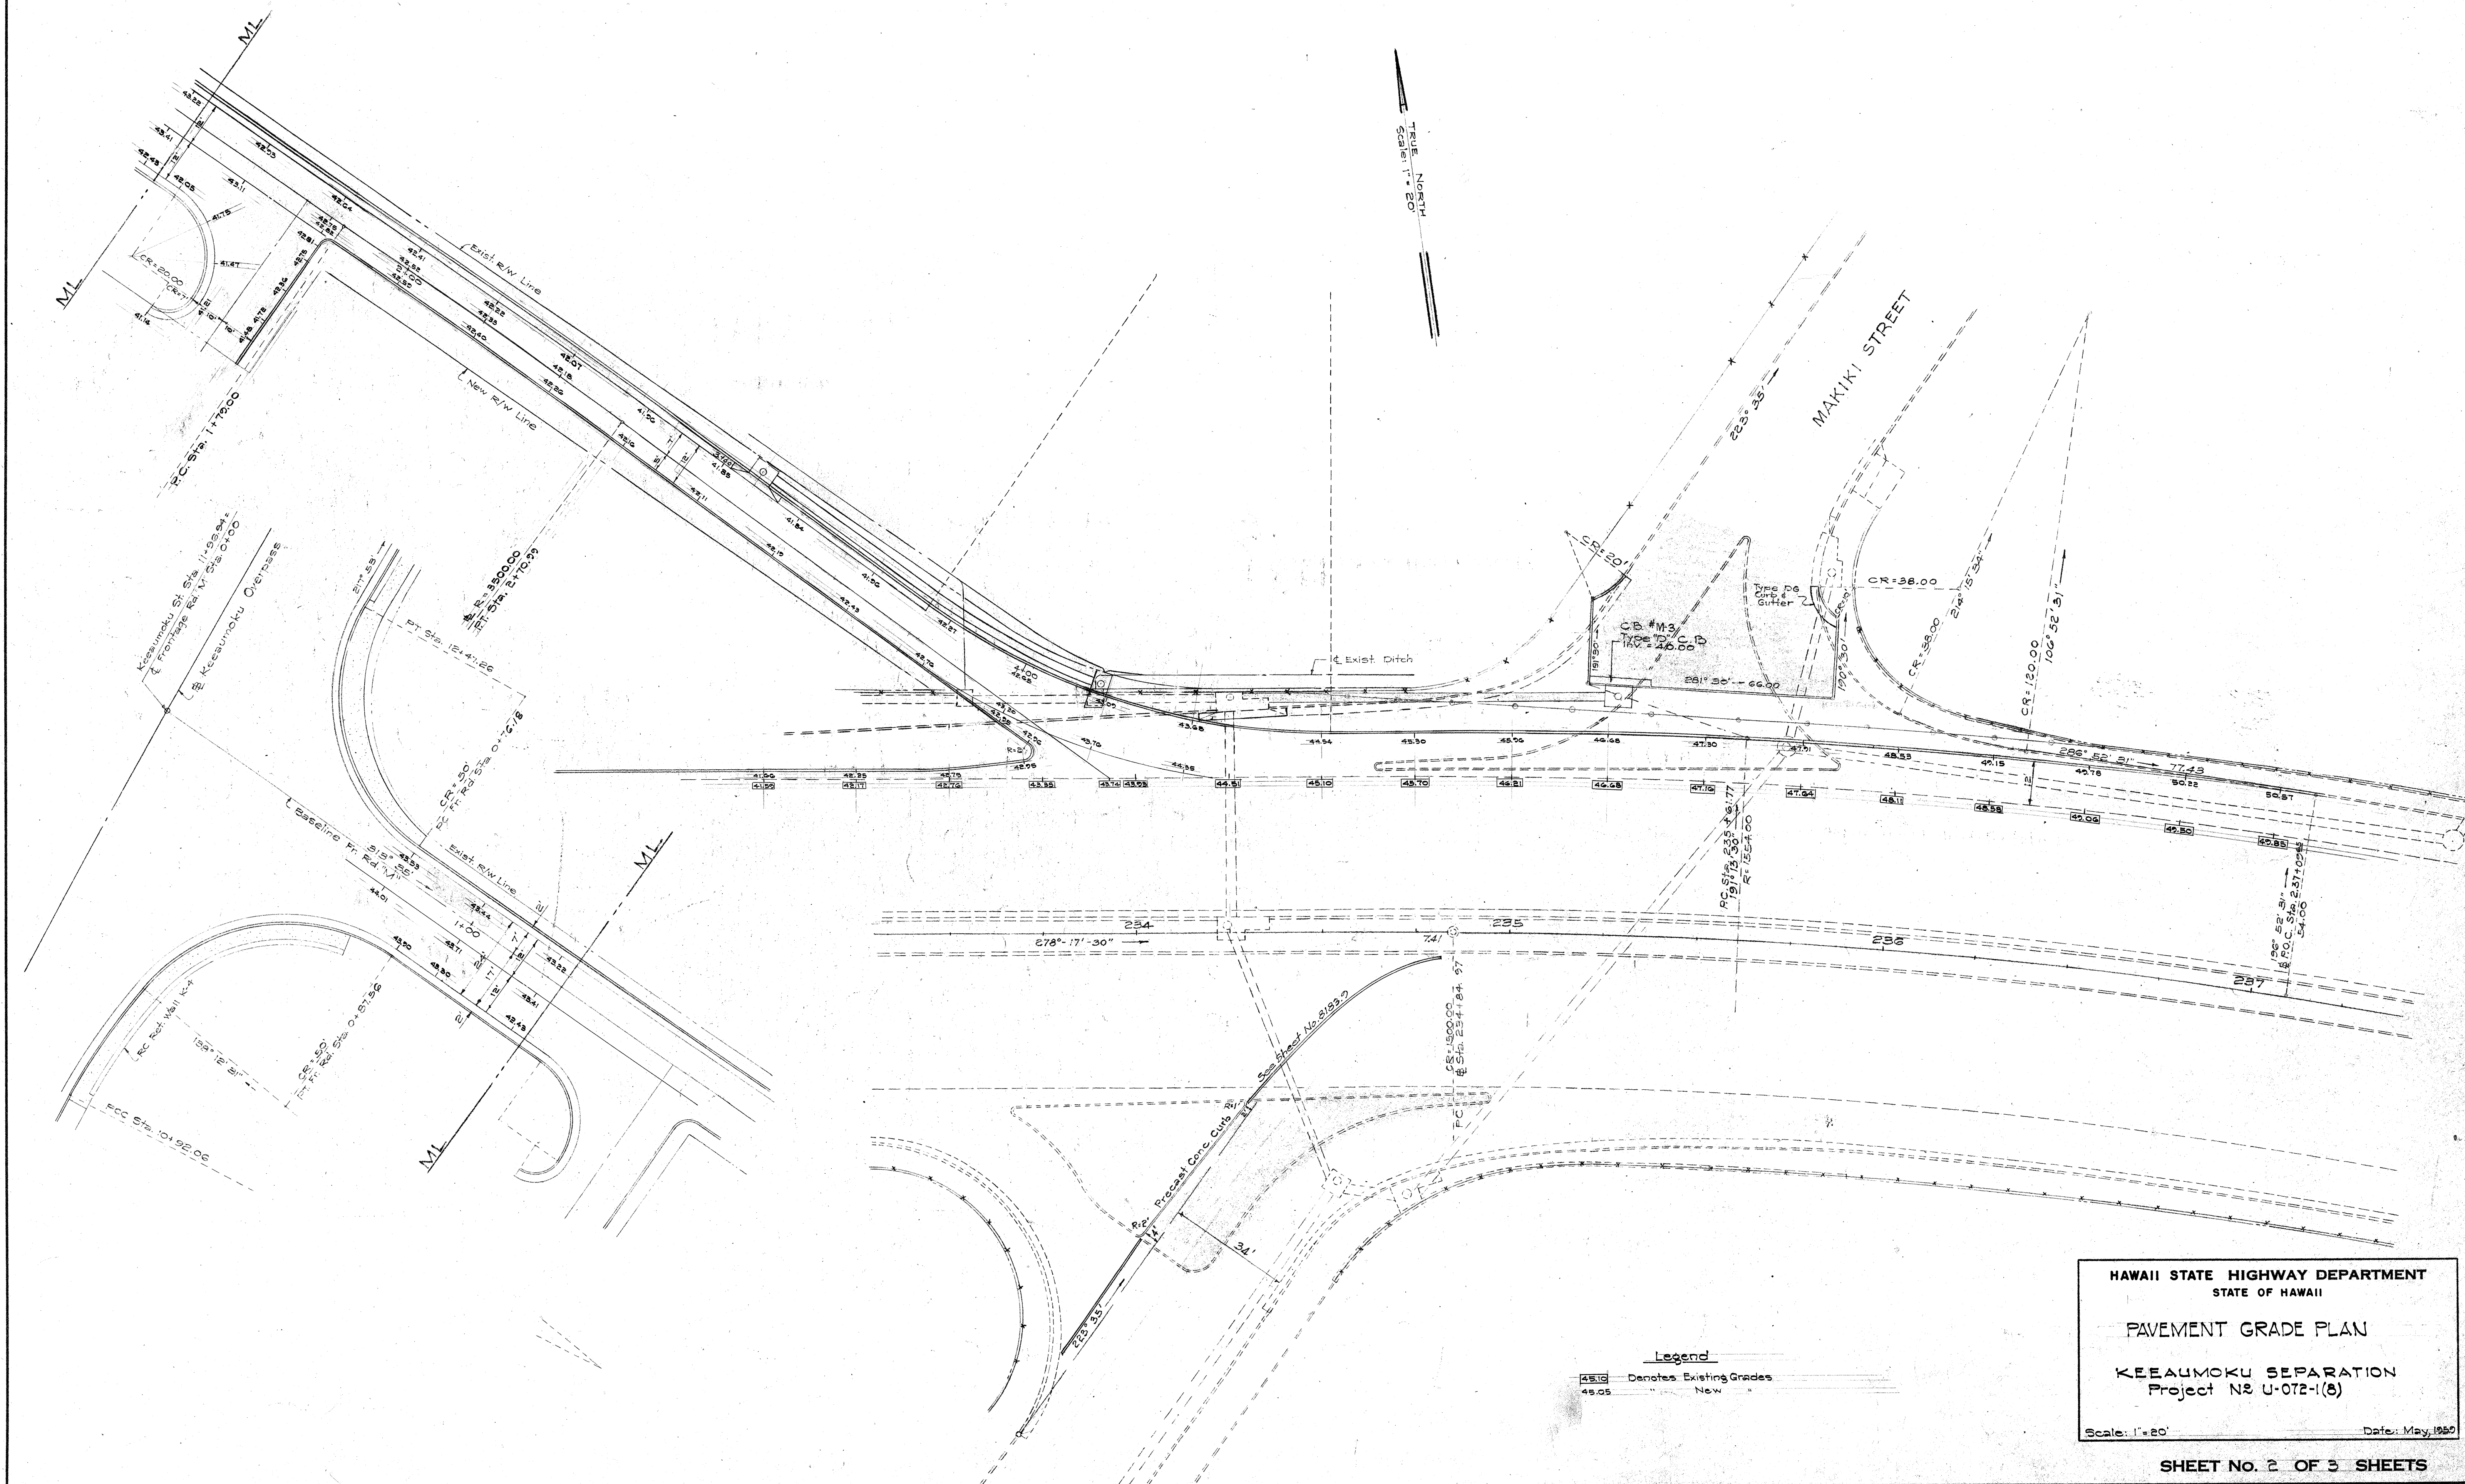

HAWAII STATE HIGHWAY DEPARTMENT
STATE OF HAWAII
PAVEMENT GRADE PLAN
KEEAUMOKU SEPARATION
Project N2 U-072-1(8)
Scale: 1"=20' Date: May, 1981

§ 183.11

FED. ROAD DIST. NO.	STATE	FED. AID PROJ. NO.	FISCAL YEAR	SHEET NO.	TOTAL SHEETS
HAWAII	HAW.	U-072-1(6)	1959	12	67

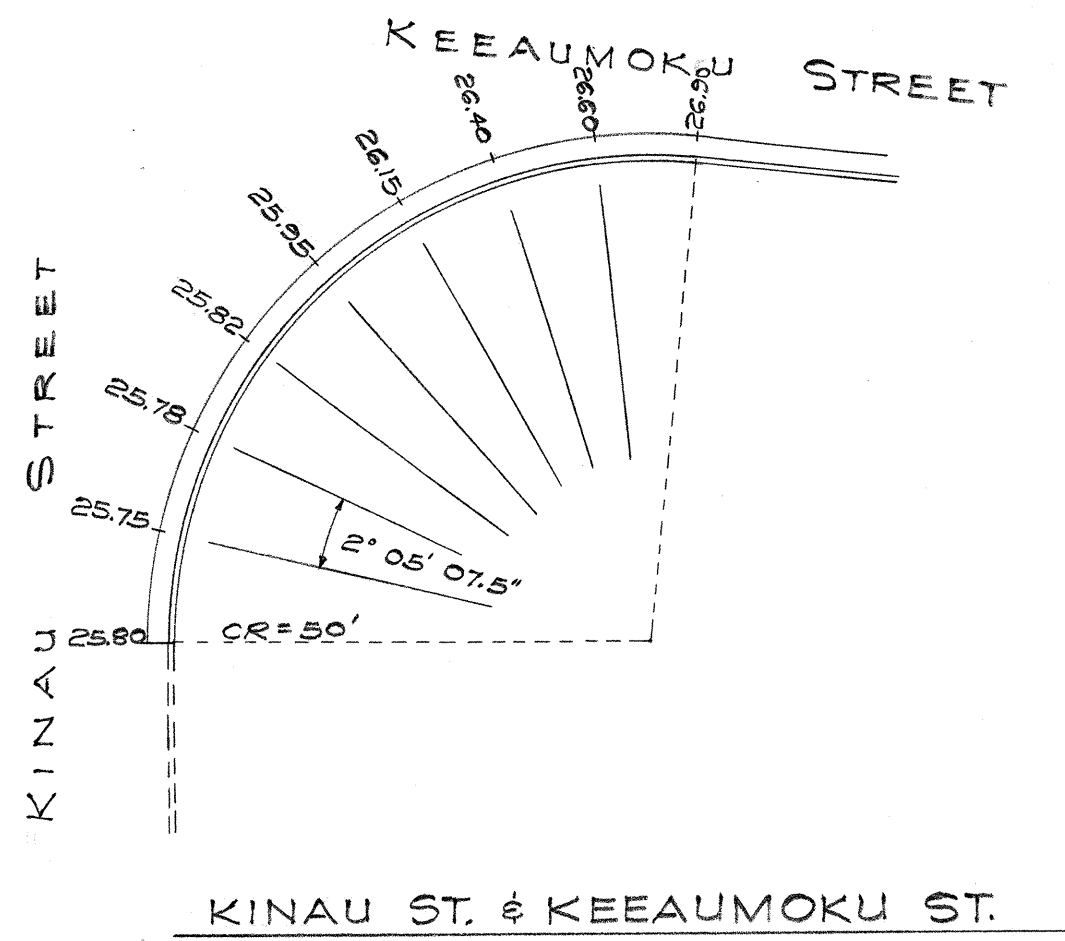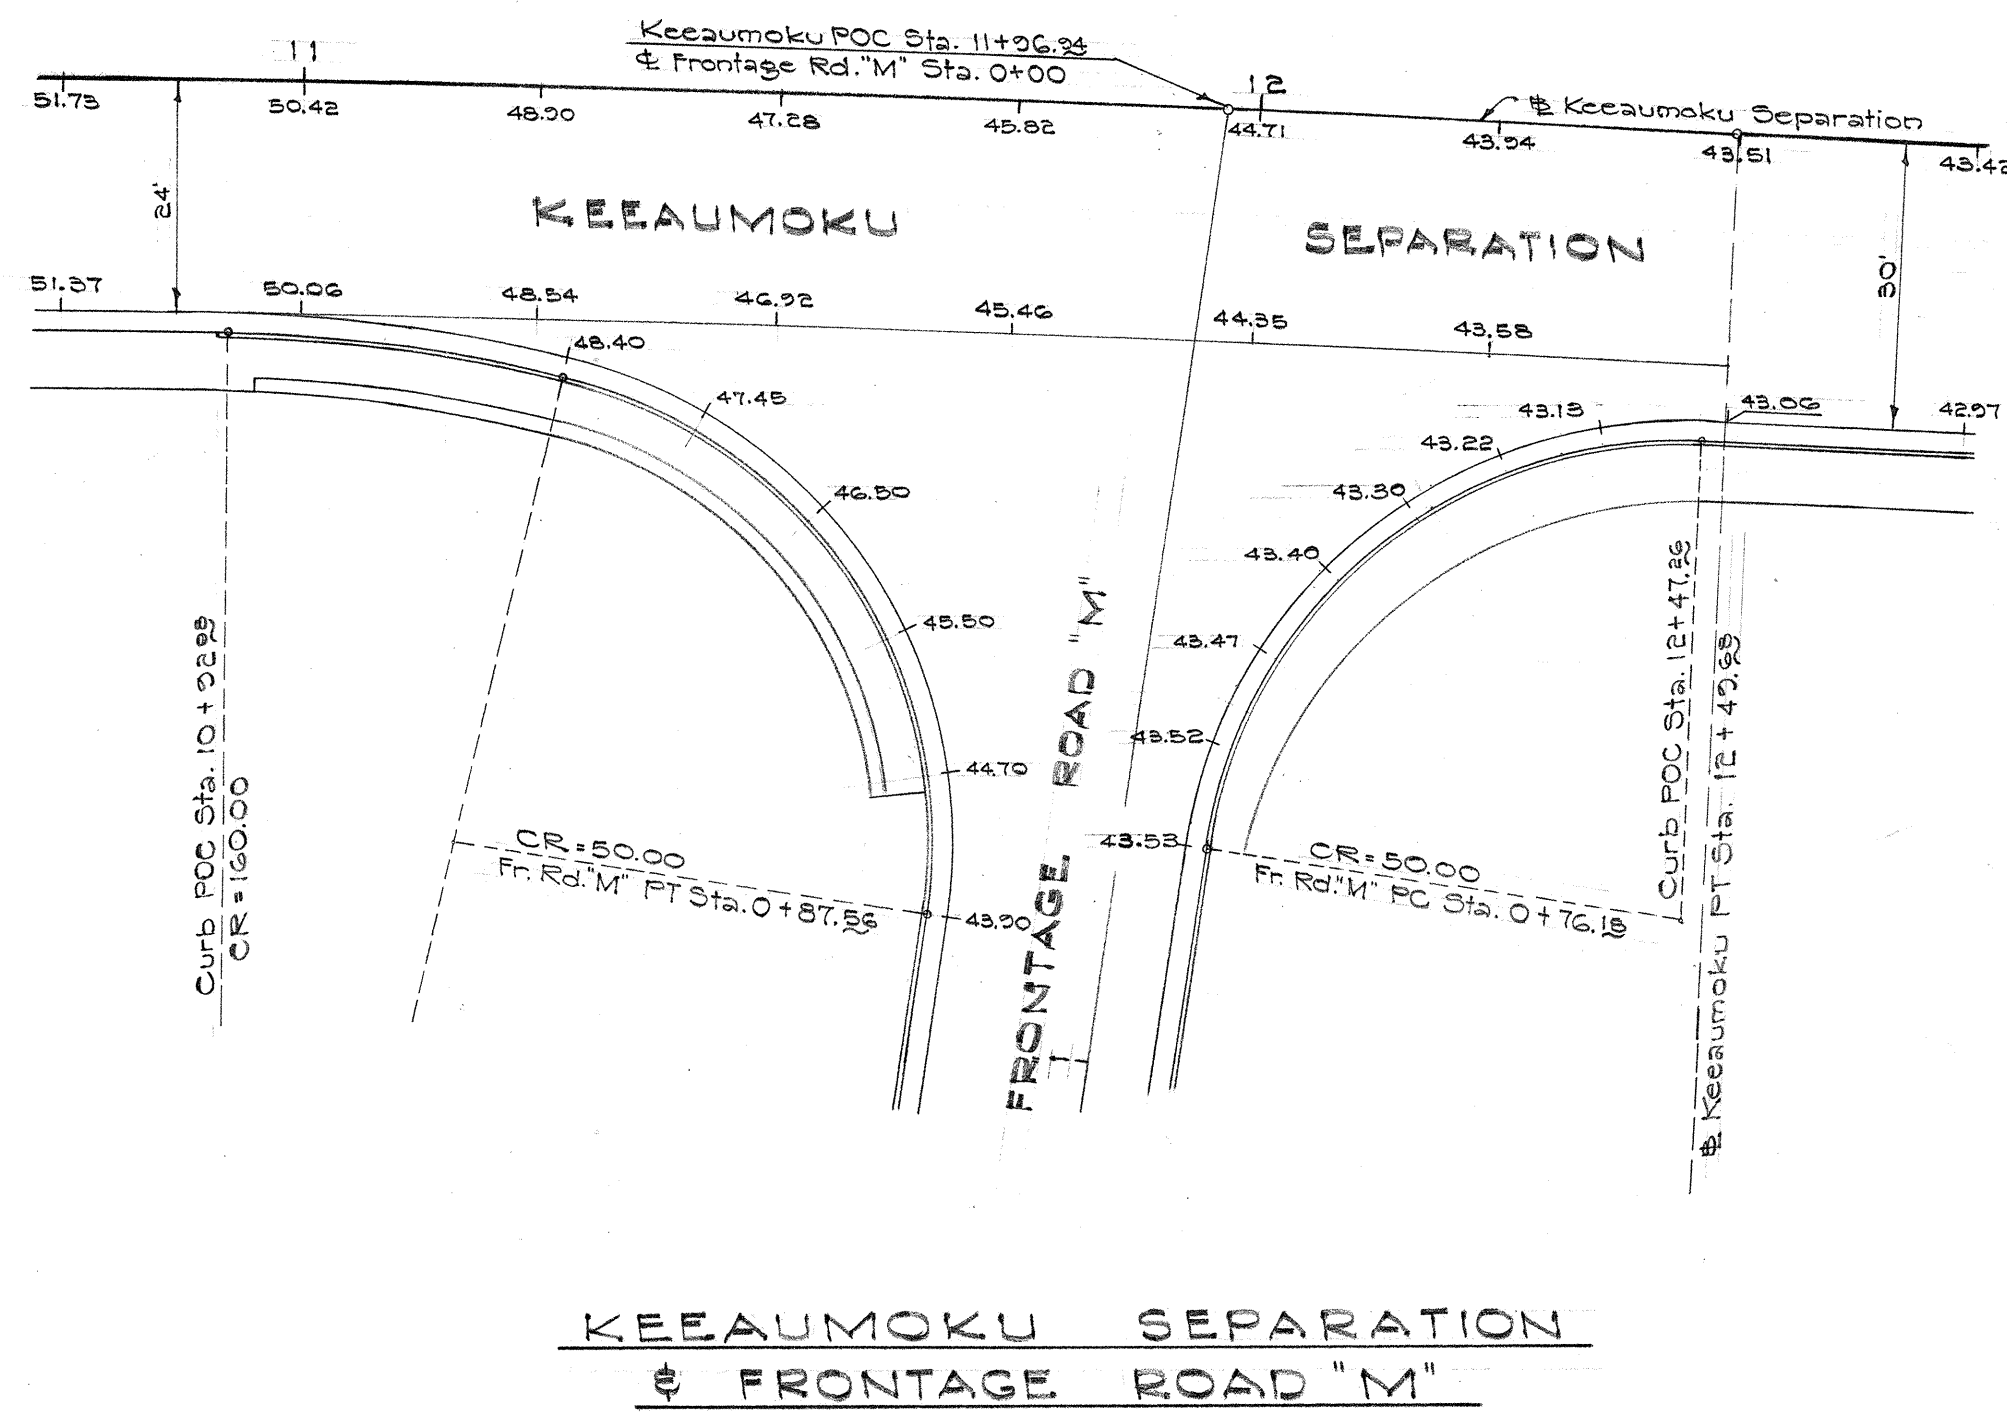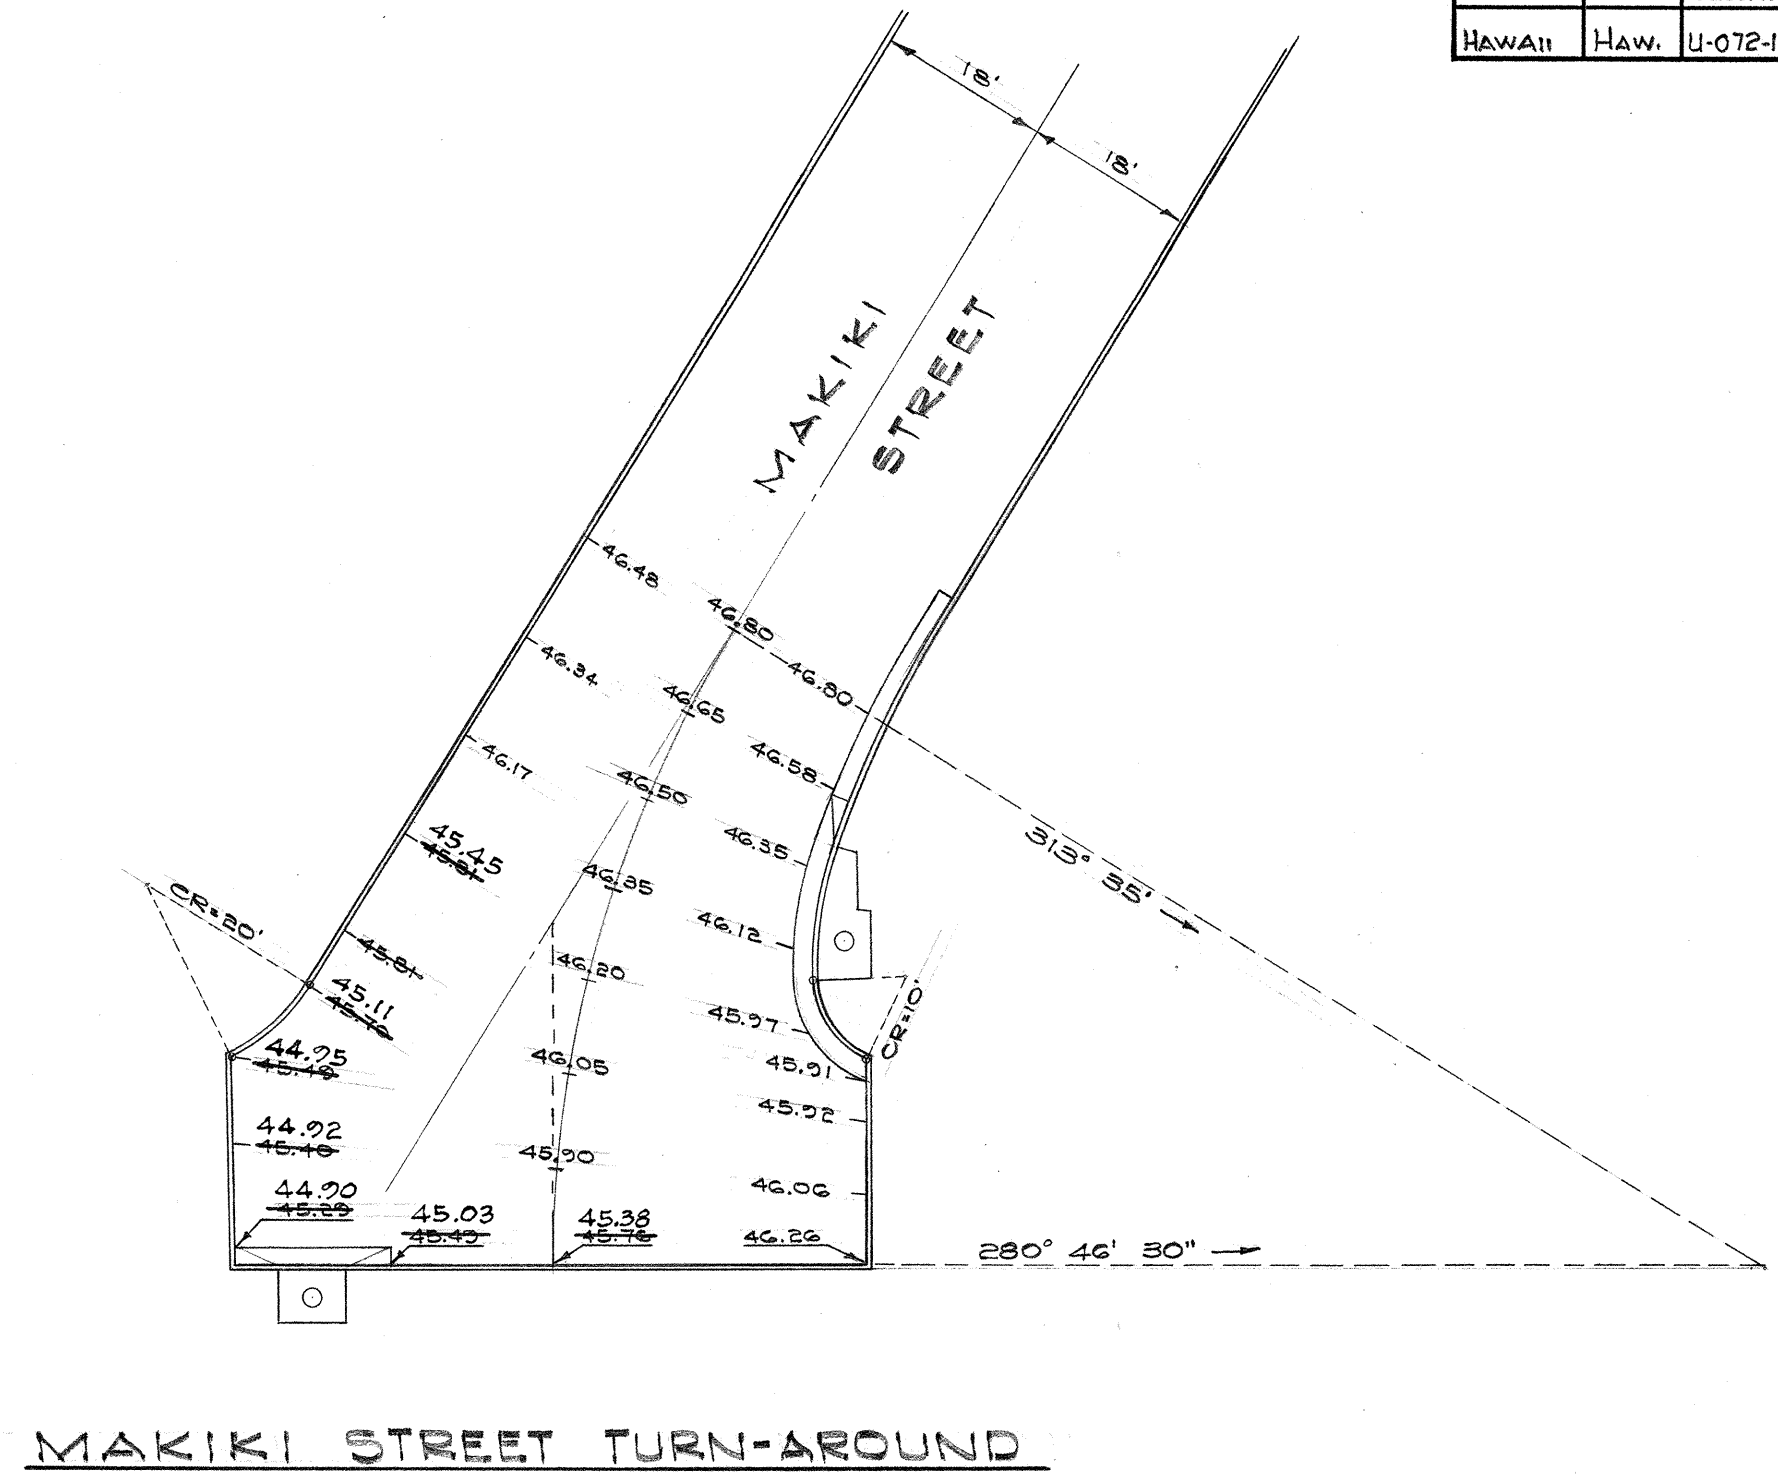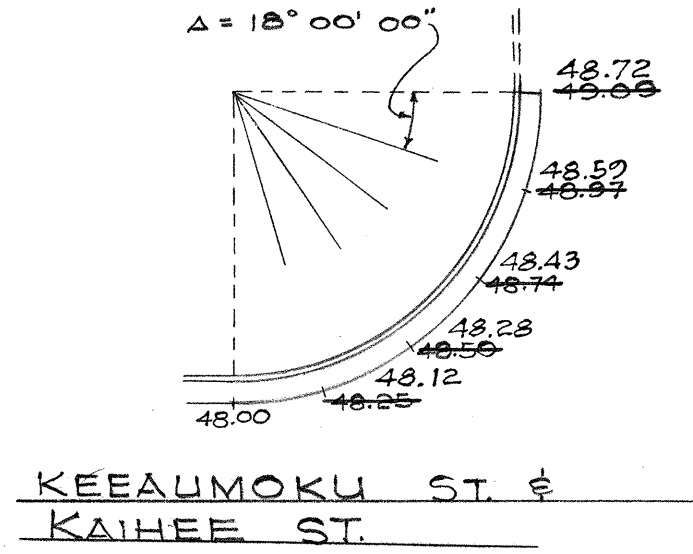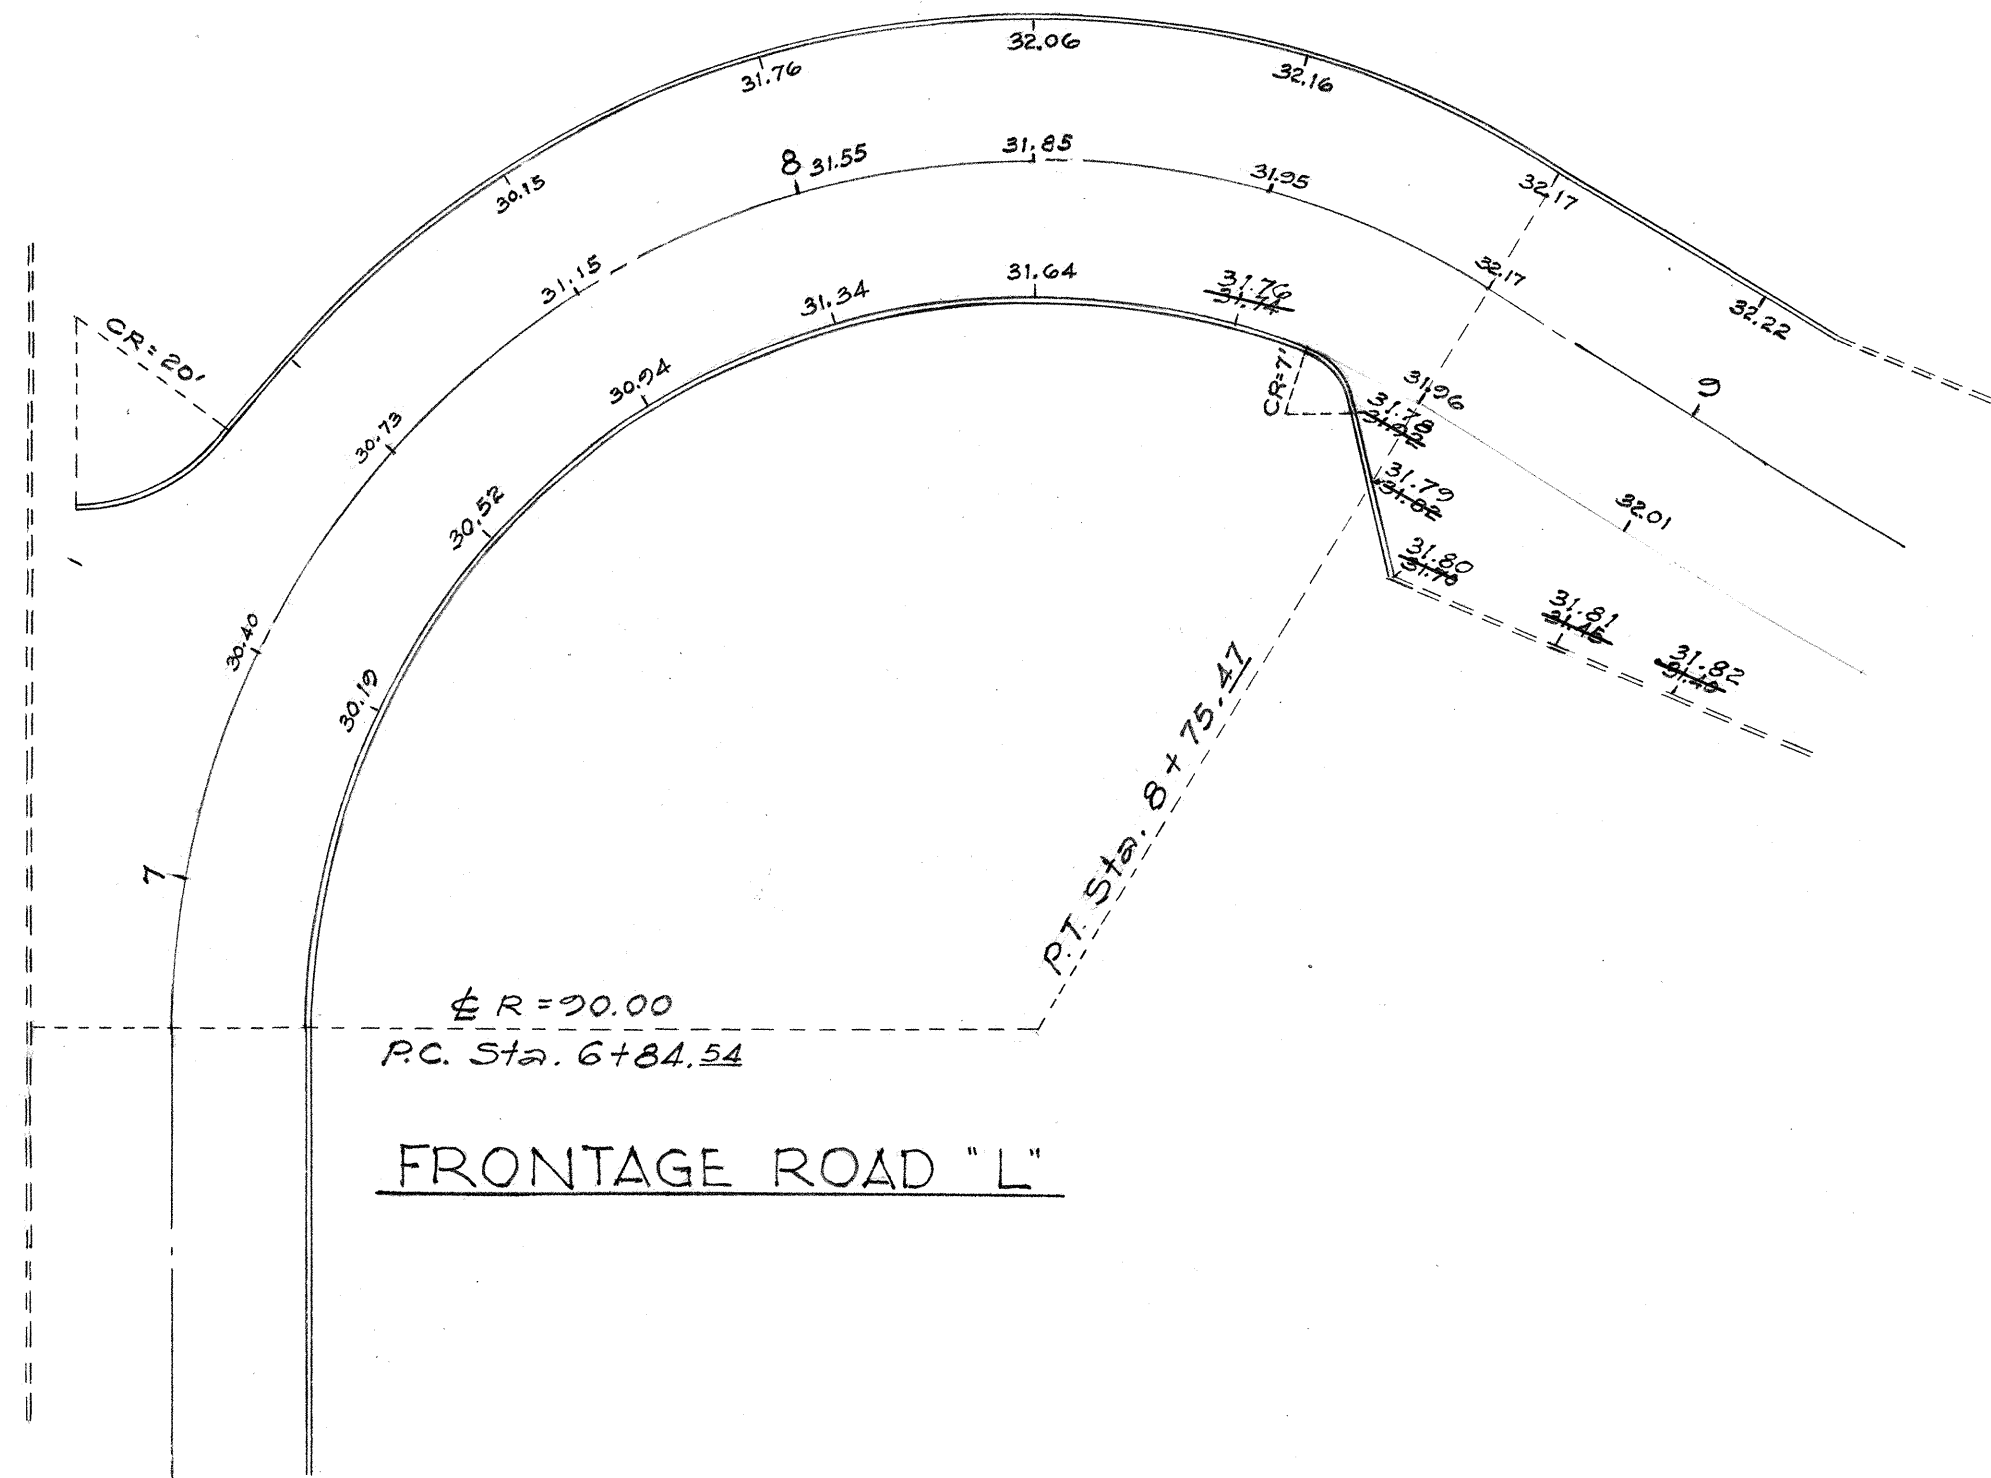

ORIGINAL PLAN	DESIGNED BY	DATE
NOTE BOOK	DRAWN BY	
NO.	CHECKED BY	

HAWAII STATE HIGHWAY DEPARTMENT
STATE OF HAWAII

PAVEMENT GRADE PLAN
KEEAUMOKU SEPARATION
Project N2 U-072-1(8)

Scale: 1" = 20'
Date: May, 1959

SHEET NO. 3 OF 3 SHEETS

8183.12