



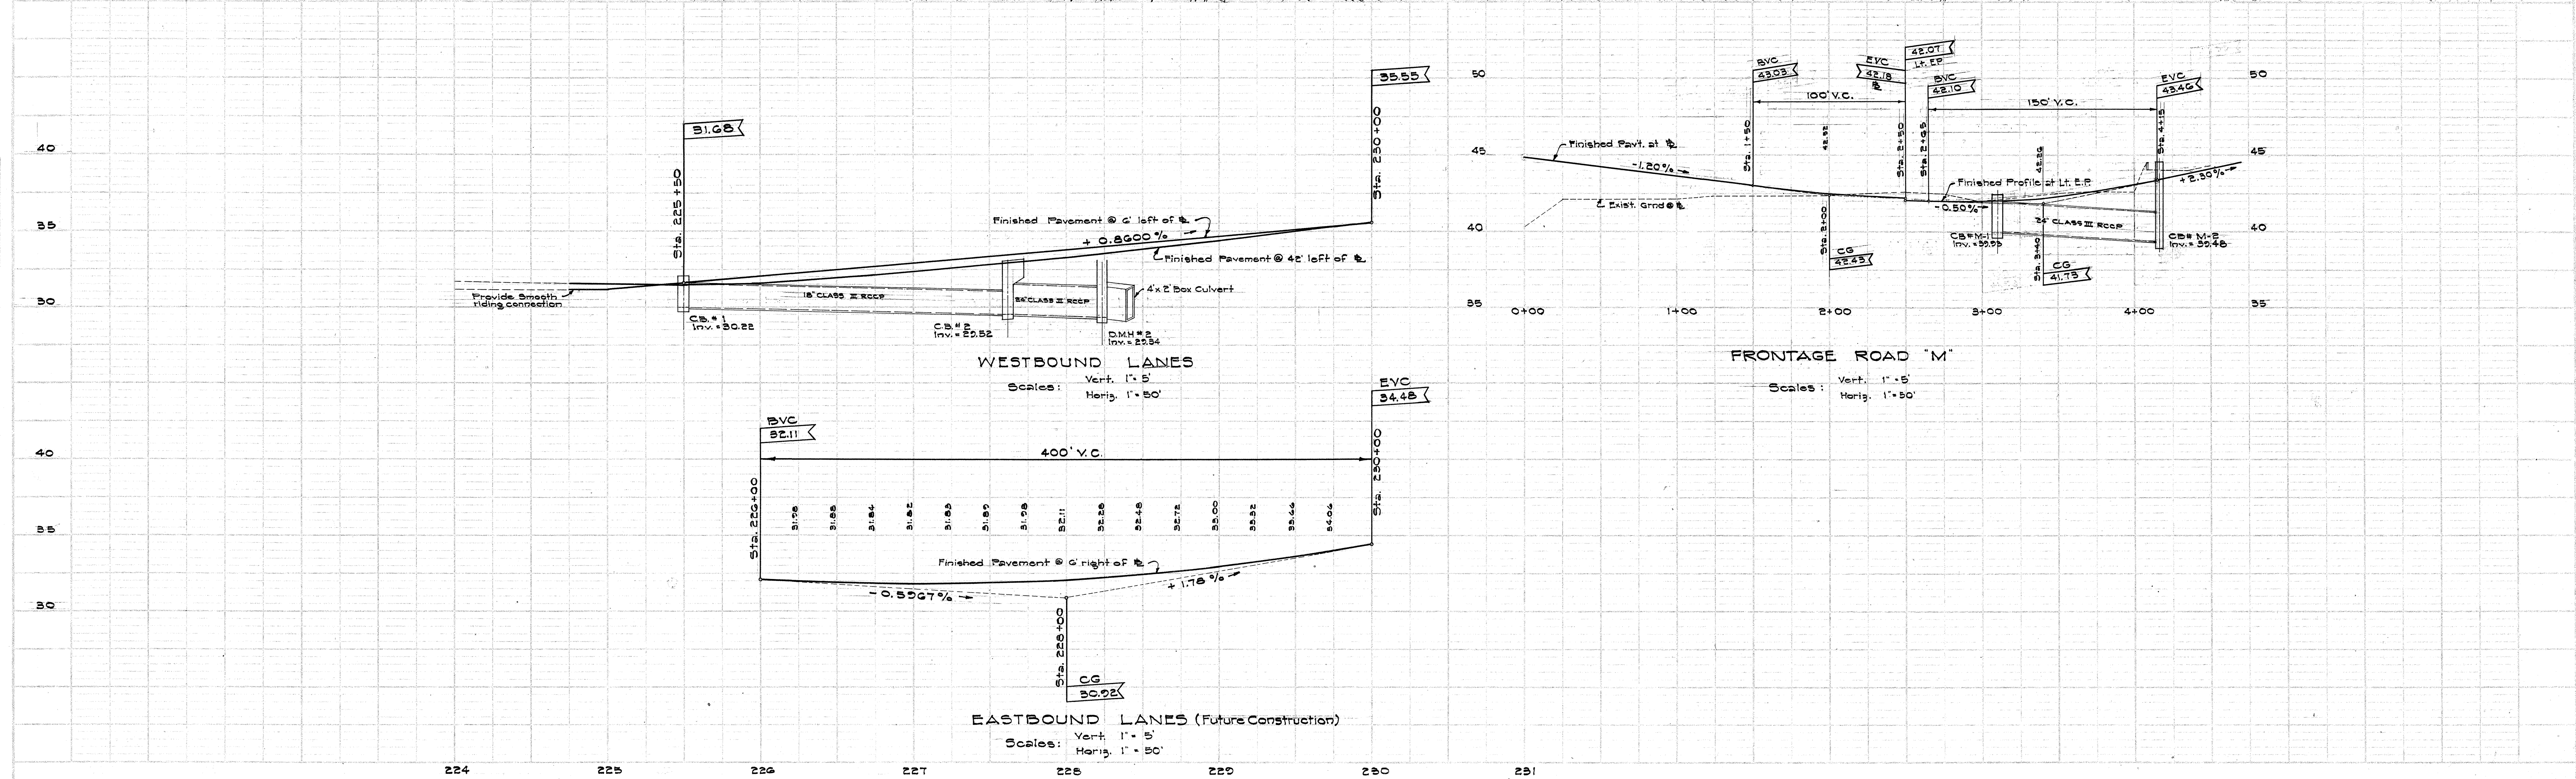

PLAN	SUBMITTED	BY	DATE
NOTE BOOK	ALIGNED CHECKED		
NO.	FT. OF WAY CHECKED		

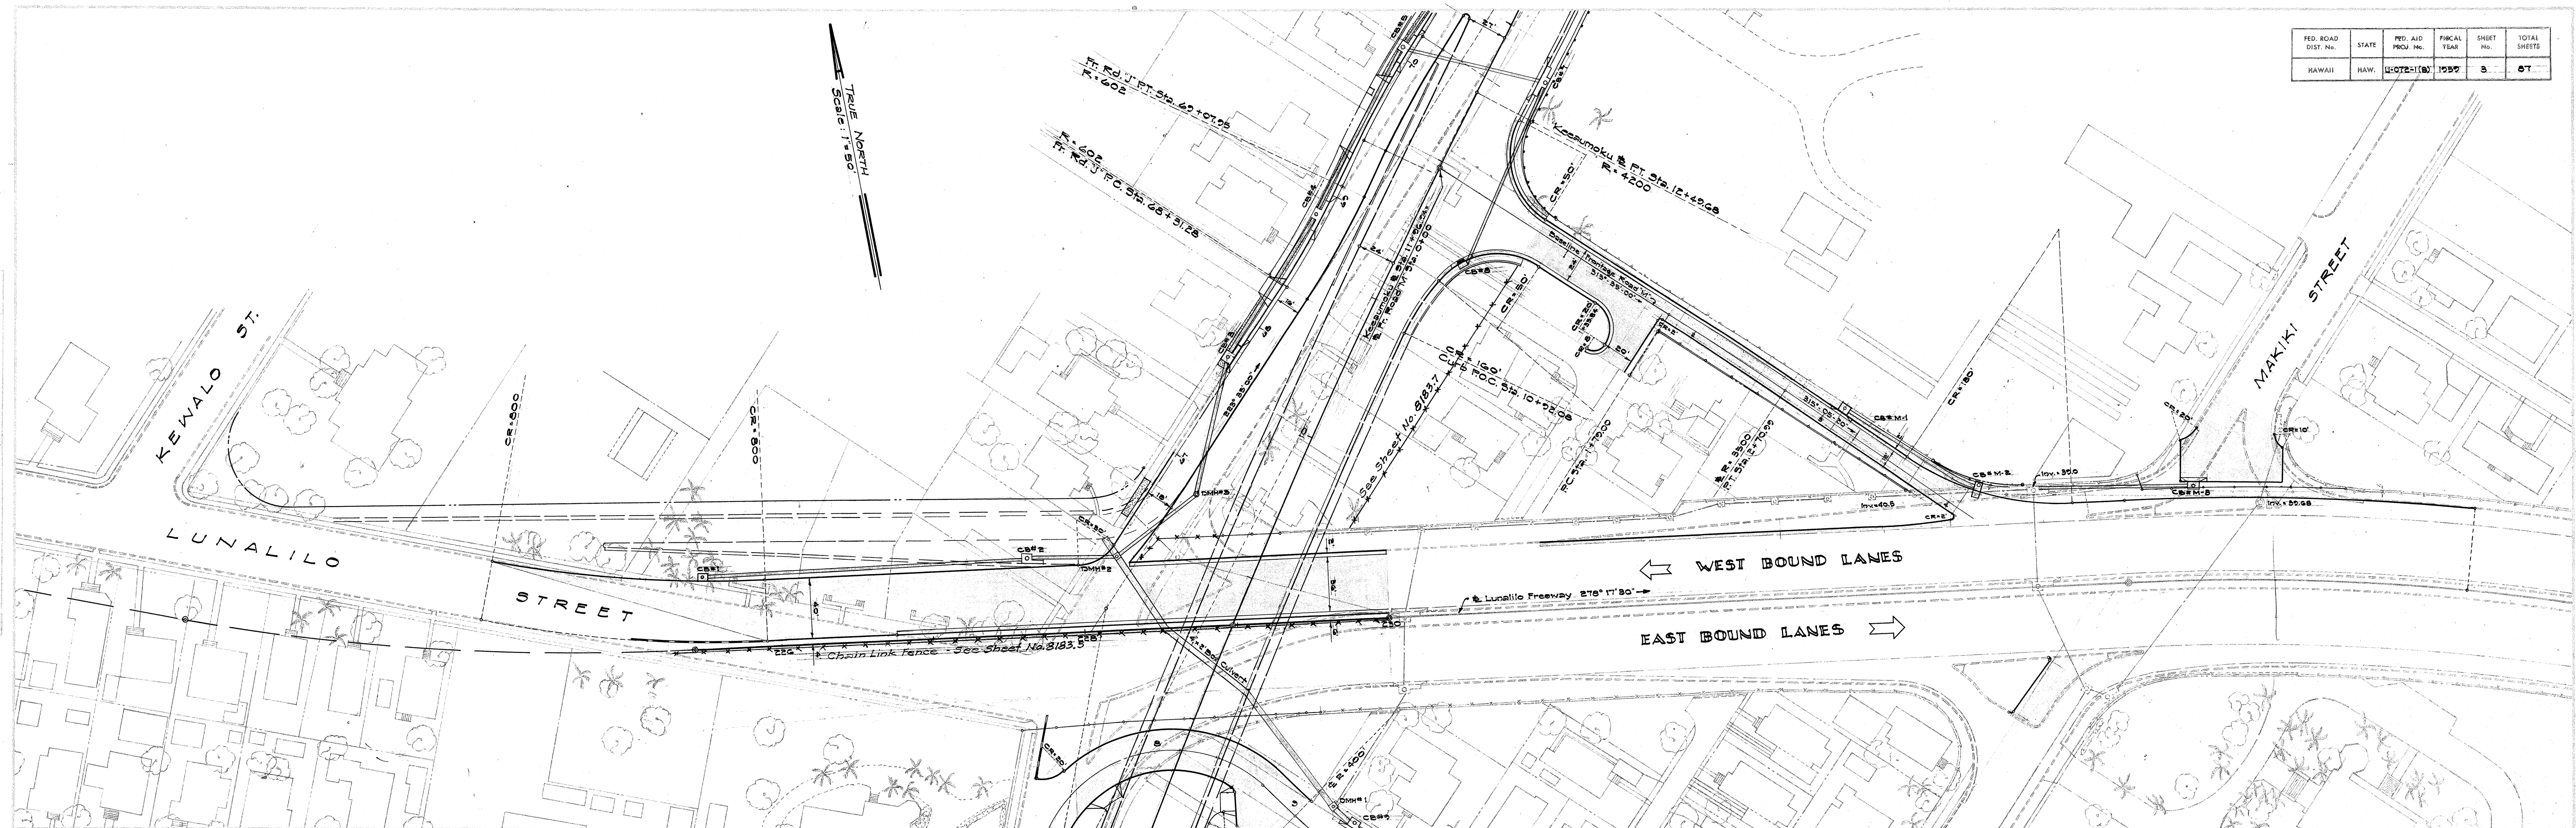