


INDEX TO DRAWINGS	
SHEET NO.	DESCRIPTION
1	TITLE SHEET
2	TYPICAL SECTIONS
3 - 4	PLAN AND PROFILE
5 - 9	DETAIL PLAN OF ROADWAY
10 - 12	PAVEMENT GRADE PLAN
13 - 19	MISCELLANEOUS DETAILS
20 - 22	WATER SYSTEM
23 - 26	SEWER SYSTEM
27 - 31	ELECTRIC, TELEPHONE AND GAS UTILITIES
32 - 34	HIGHWAY LIGHTING
35	TRAFFIC SIGNAL
36 - 37	TRAFFIC SIGNS
38	LANDSCAPE PLAN
39 - 42	SPRINKLER SYSTEM
43 - 62	STANDARD DETAILS
63 - 70	CROSS SECTIONS
71 - 87	STRUCTURES

STATE OF HAWAII  
HAWAII STATE HIGHWAY DEPARTMENT  
HONOLULU, HAWAII  
"AS BUILT"  
PLANS OF

LUNALILO FREEWAY  
KEEAUMOKU SEPARATION  
FEDERAL AID URBAN PROJECT NO. U 072-1(8)  
DISTRICT OF HONOLULU  
ISLAND OF OAHU

SCALES  
PLAN & PROFILE  
CROSS SECTION

HORIZ. 1 INCH = 50 FEET  
VERT. 1 INCH = 5 FEET, 10 FEET  
HORIZ. 1 INCH = 10 FEET  
VERT. 1 INCH = 10 FEET

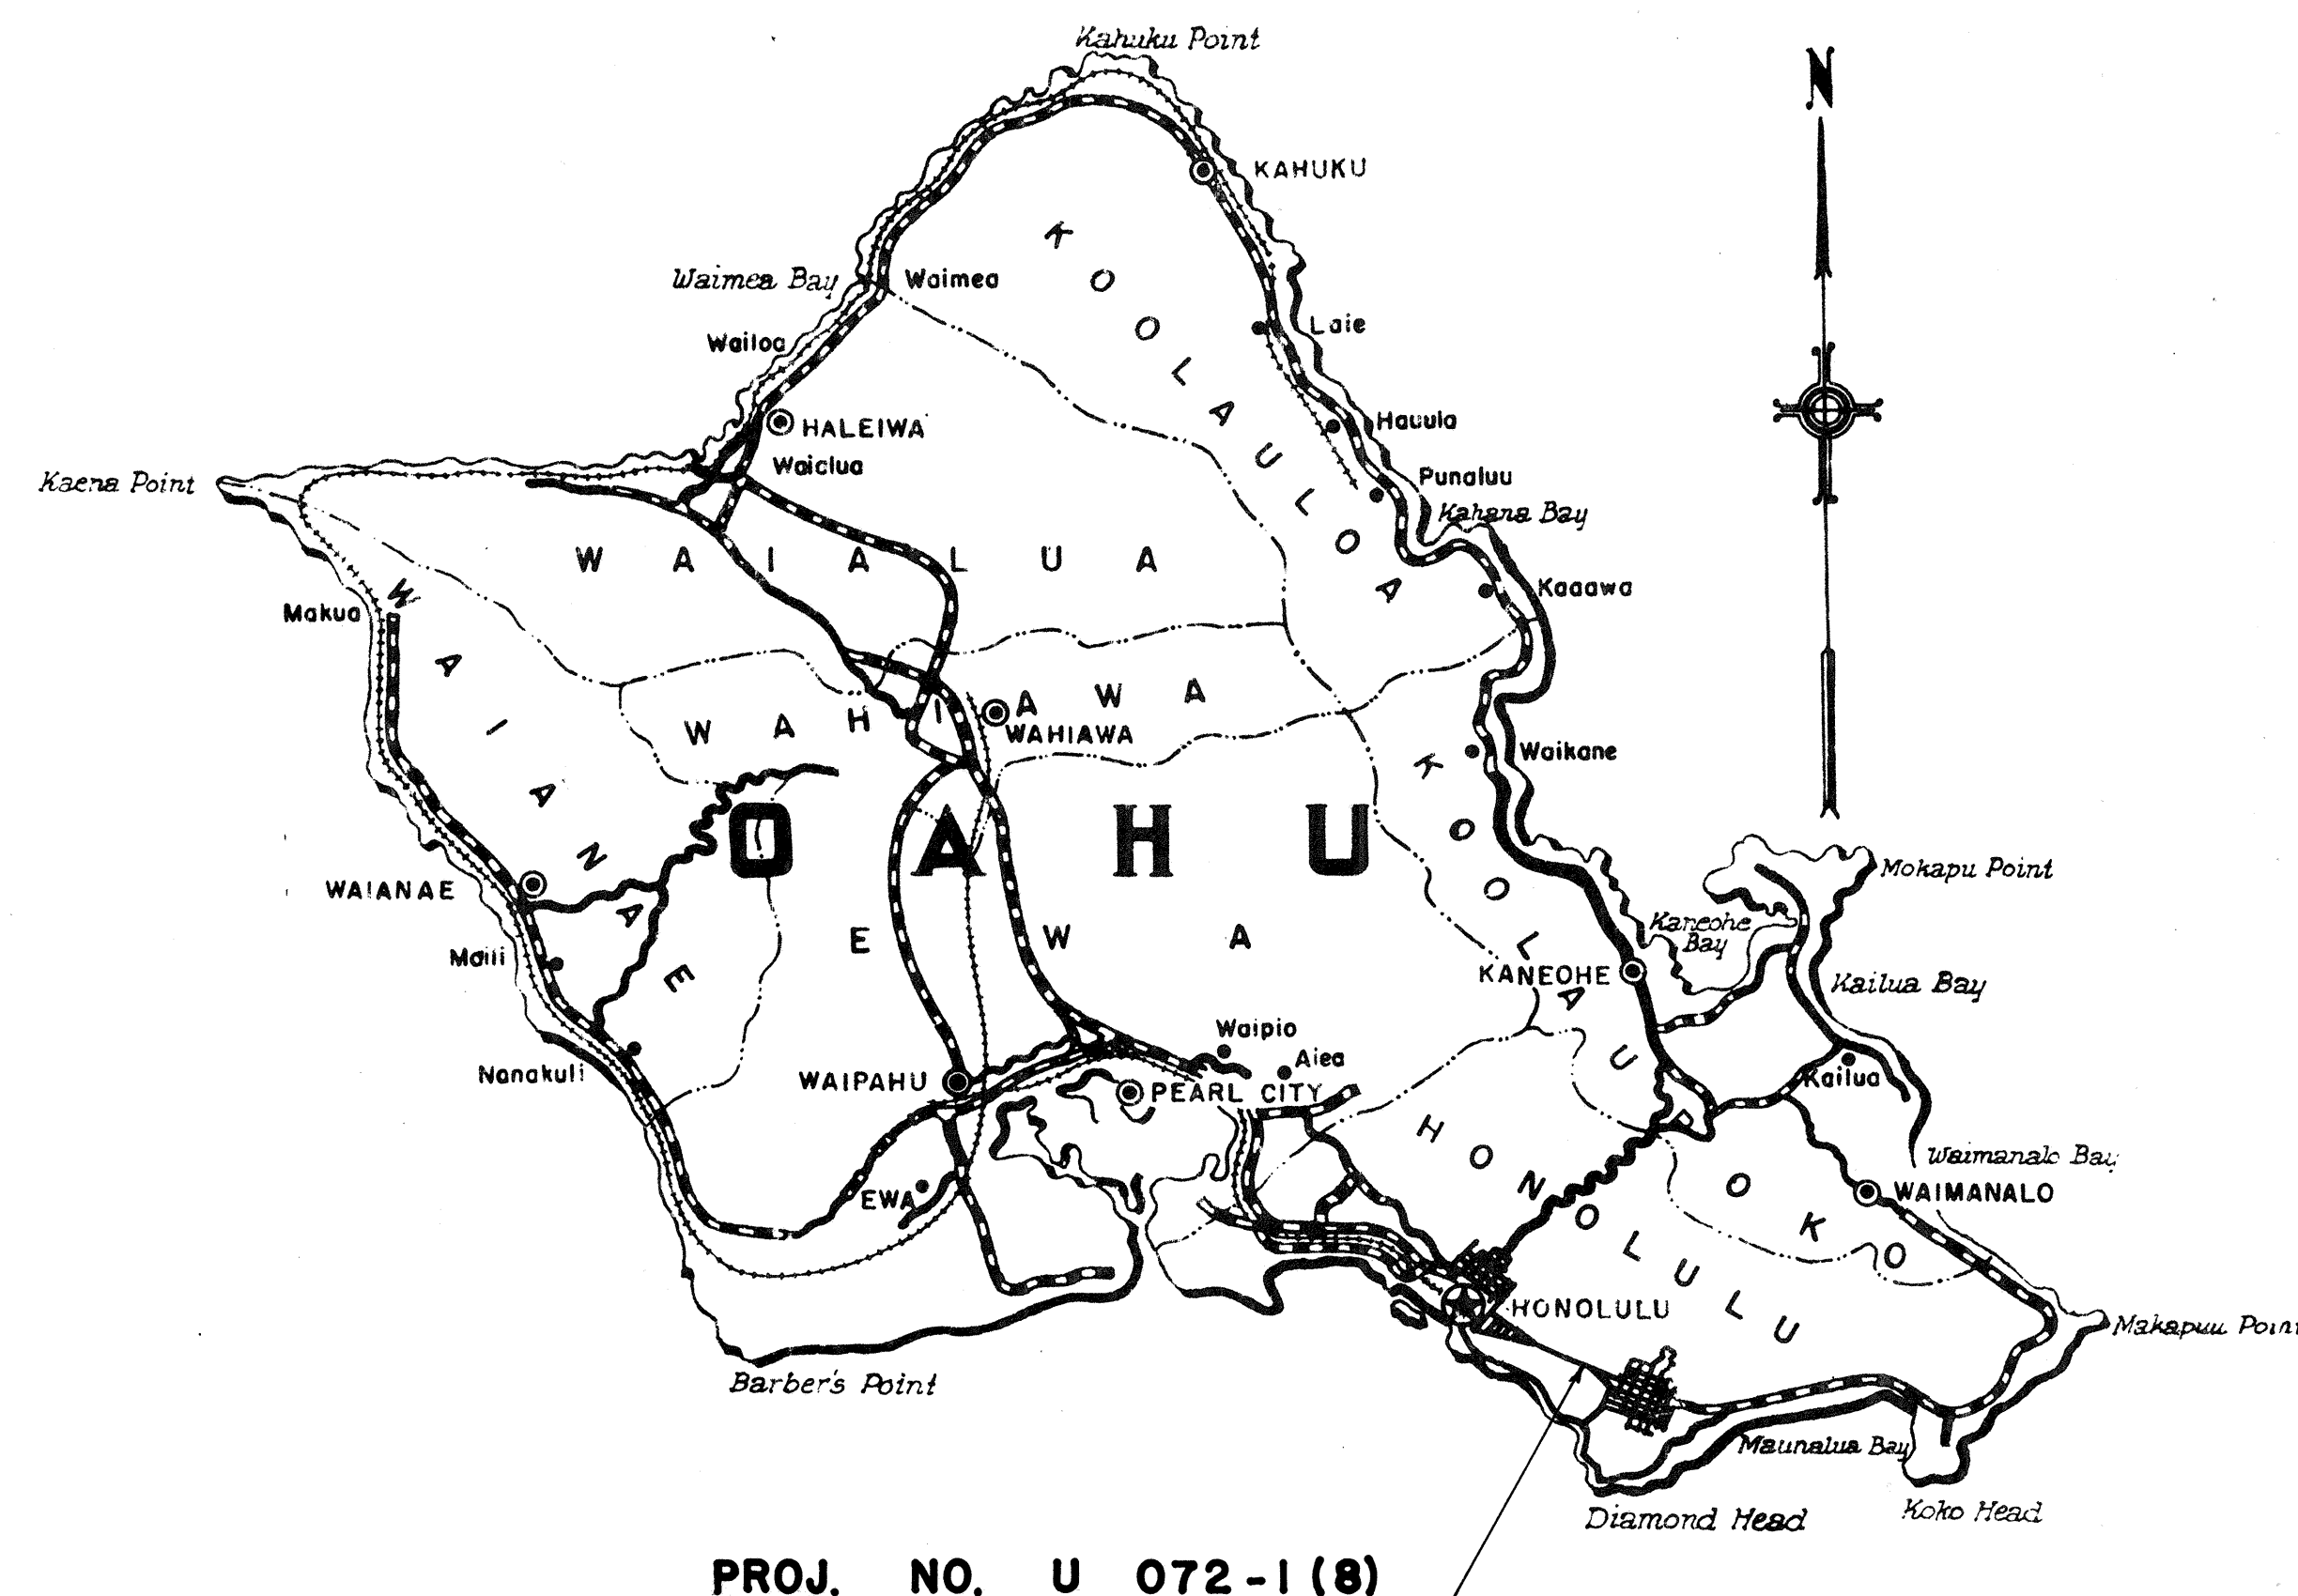

Federal Aid Projects Previously Constructed Or Under Construction

NOTE:  
ALL CHANGES MADE DURING  
CONSTRUCTION HAVE BEEN  
NOTED IN RED ON THESE  
TRACINGS AND CHECKED  
BY:


*B. W. Hendry*  
DISTRICT ENGINEER  
1/27/61  
DATE

GROSS LENGTH OF PROJECT = 0.235 MILES  
LENGTH OF BRIDGE = 0.074 MILES  
NET LENGTH OF PROJECT = 0.161 MILES

PLAN SHEETS IN THIS SET WHICH HAVE BEEN  
CHANGED INCLUDE NOS. 8183.2A, 2B, 2C, 2D, 3,  
4, 5, 6, 7, 8, 9, 10, 12, 13, 15, 17, 20, 23, 27, 32, 38, 42, 71, 73, 74,  
80, 82.

APPROVED: *[Signature]* DATE Aug. 23, 1959  
STATE HIGHWAY ENGINEER

DEPARTMENT OF COMMERCE  
BUREAU OF PUBLIC ROADS  
APPROVED: *[Signature]*  
DIVISION - ENGINEER DATE

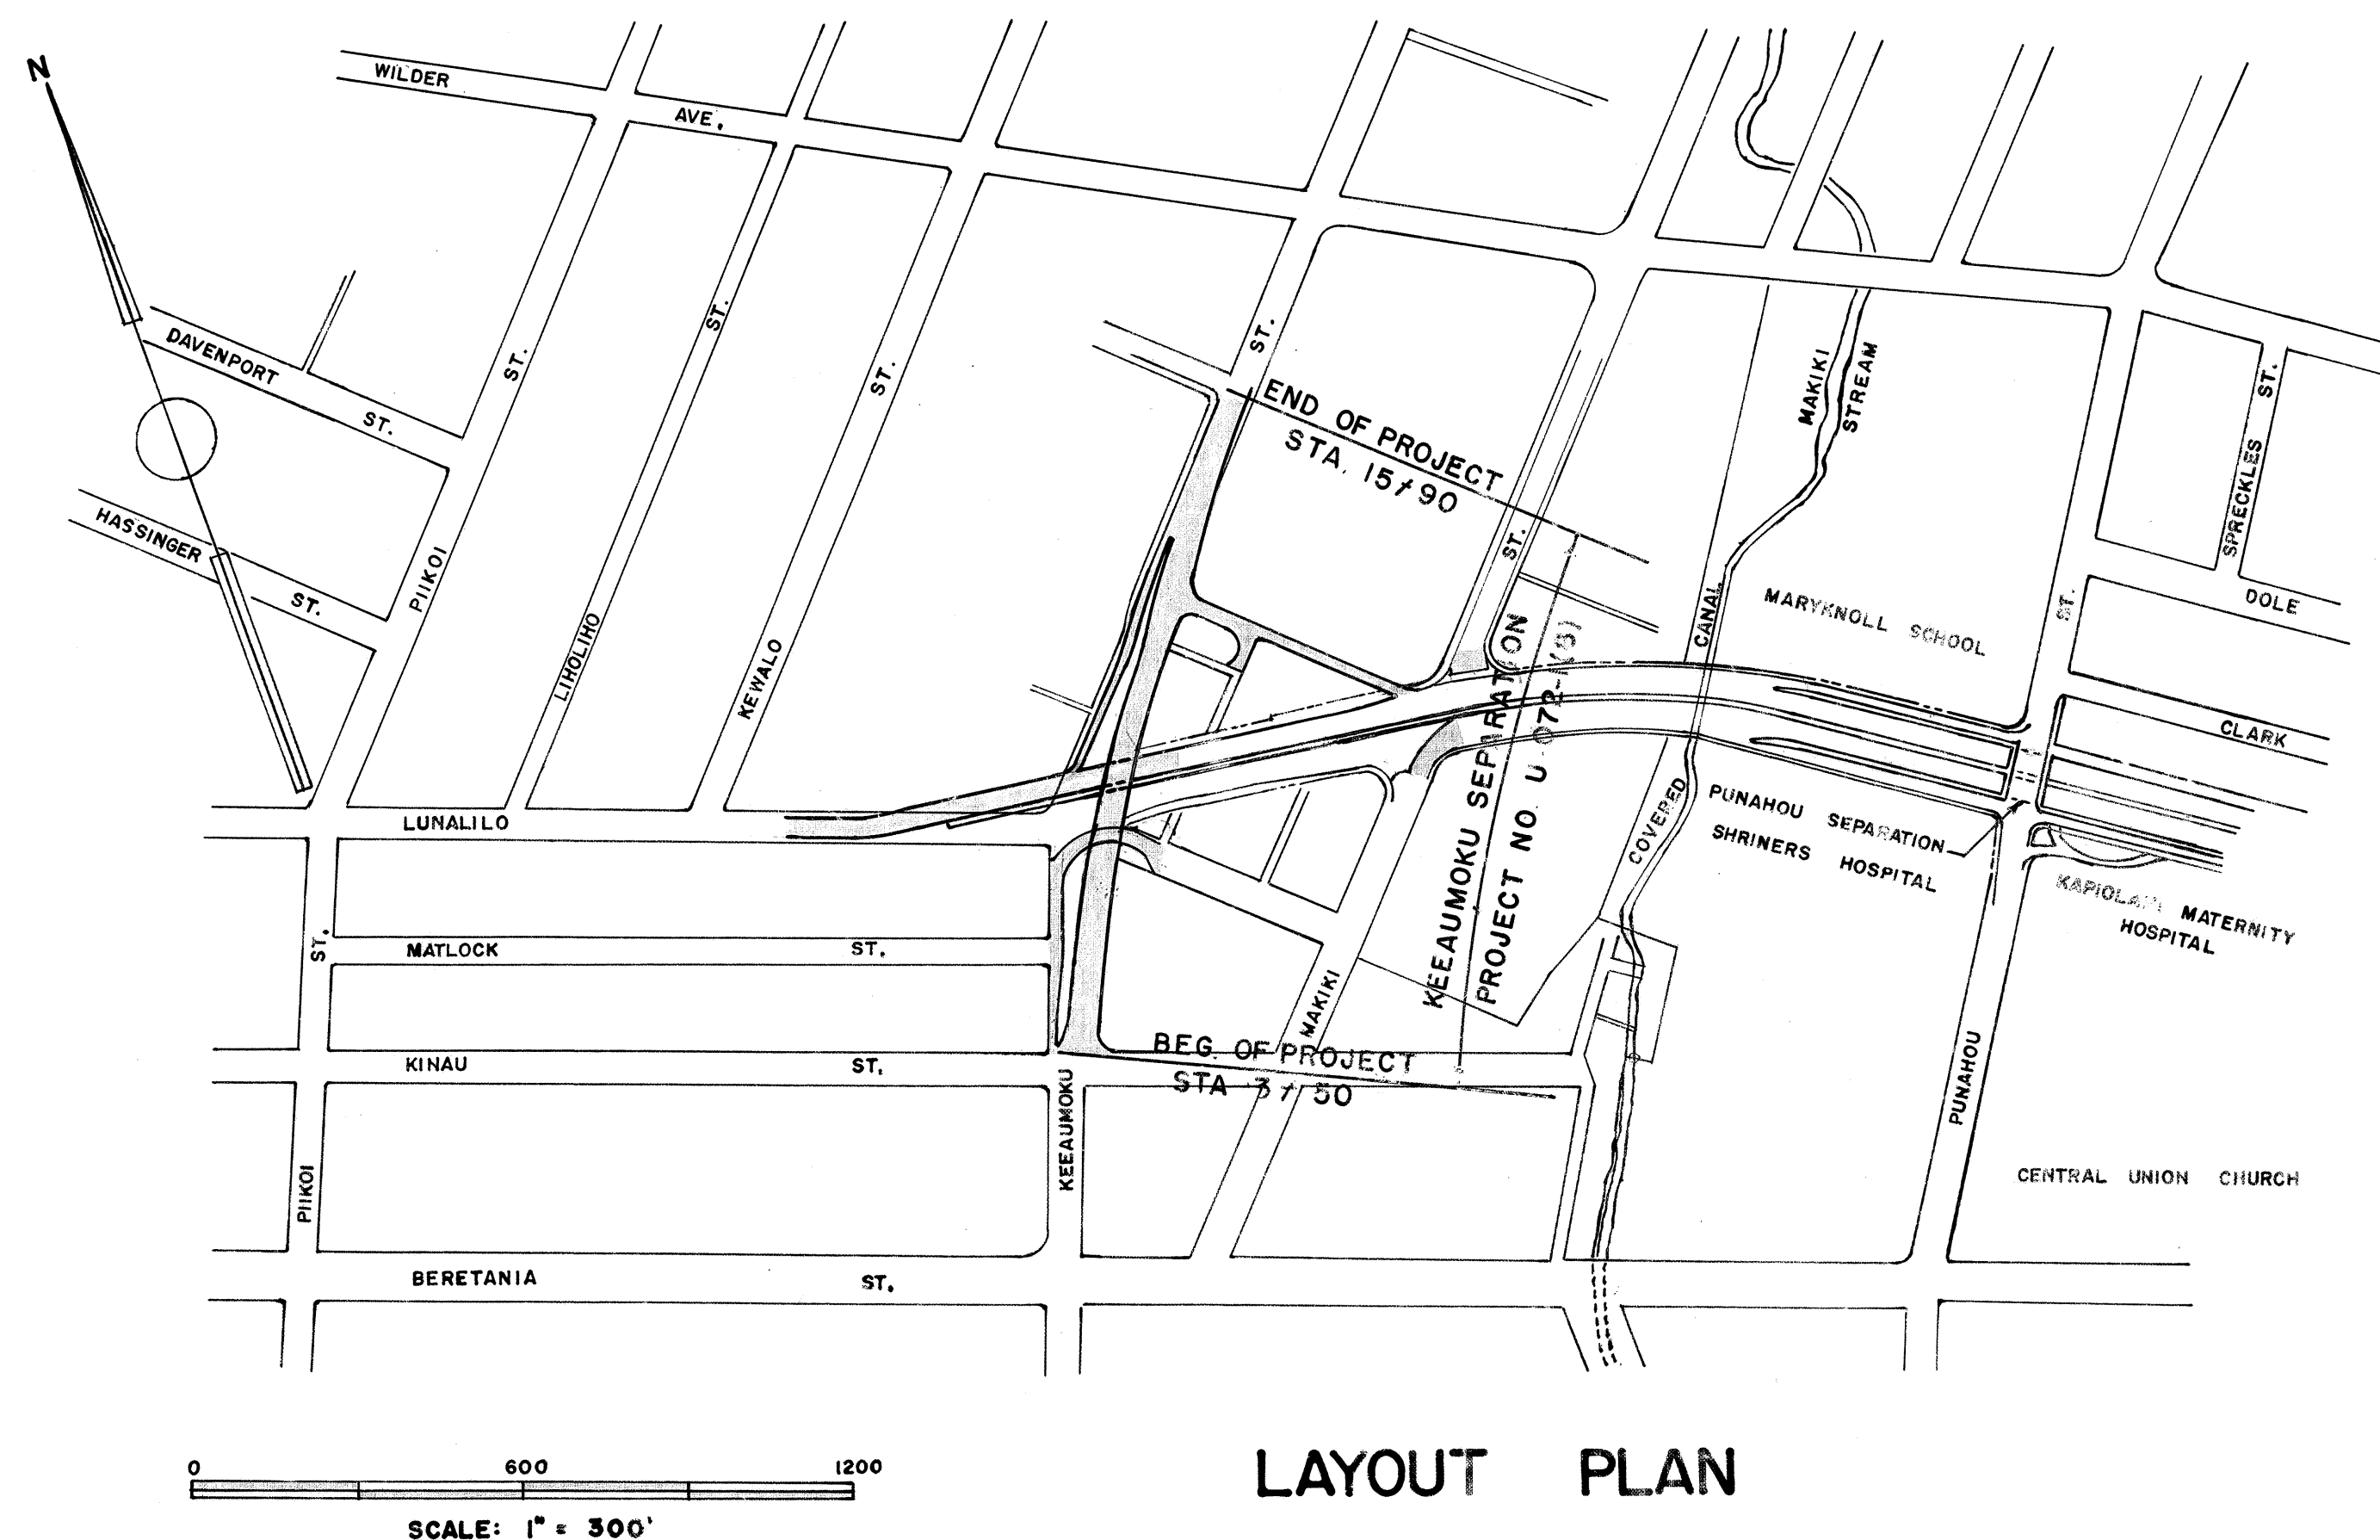

ORIGINAL PLAN	DATE
DESIGNED BY	
DRAWN BY	
CHECKED BY	
NOTED BY	
QUANTITIES CHECKED BY	
NO.	