


1. The Contractor shall notify the Engineer whenever he requires regulatory and/or warning signs to be removed.
2. All signs that are to be removed but not re-used shall be removed and returned to the T.H. Highway Maintenance Base Yard, 721 Kekiki St., Honolulu, by the Oahu District Maintenance Crew.
3. All G.I. Pipe sign posts shall be salvaged & re-used whenever feasible.

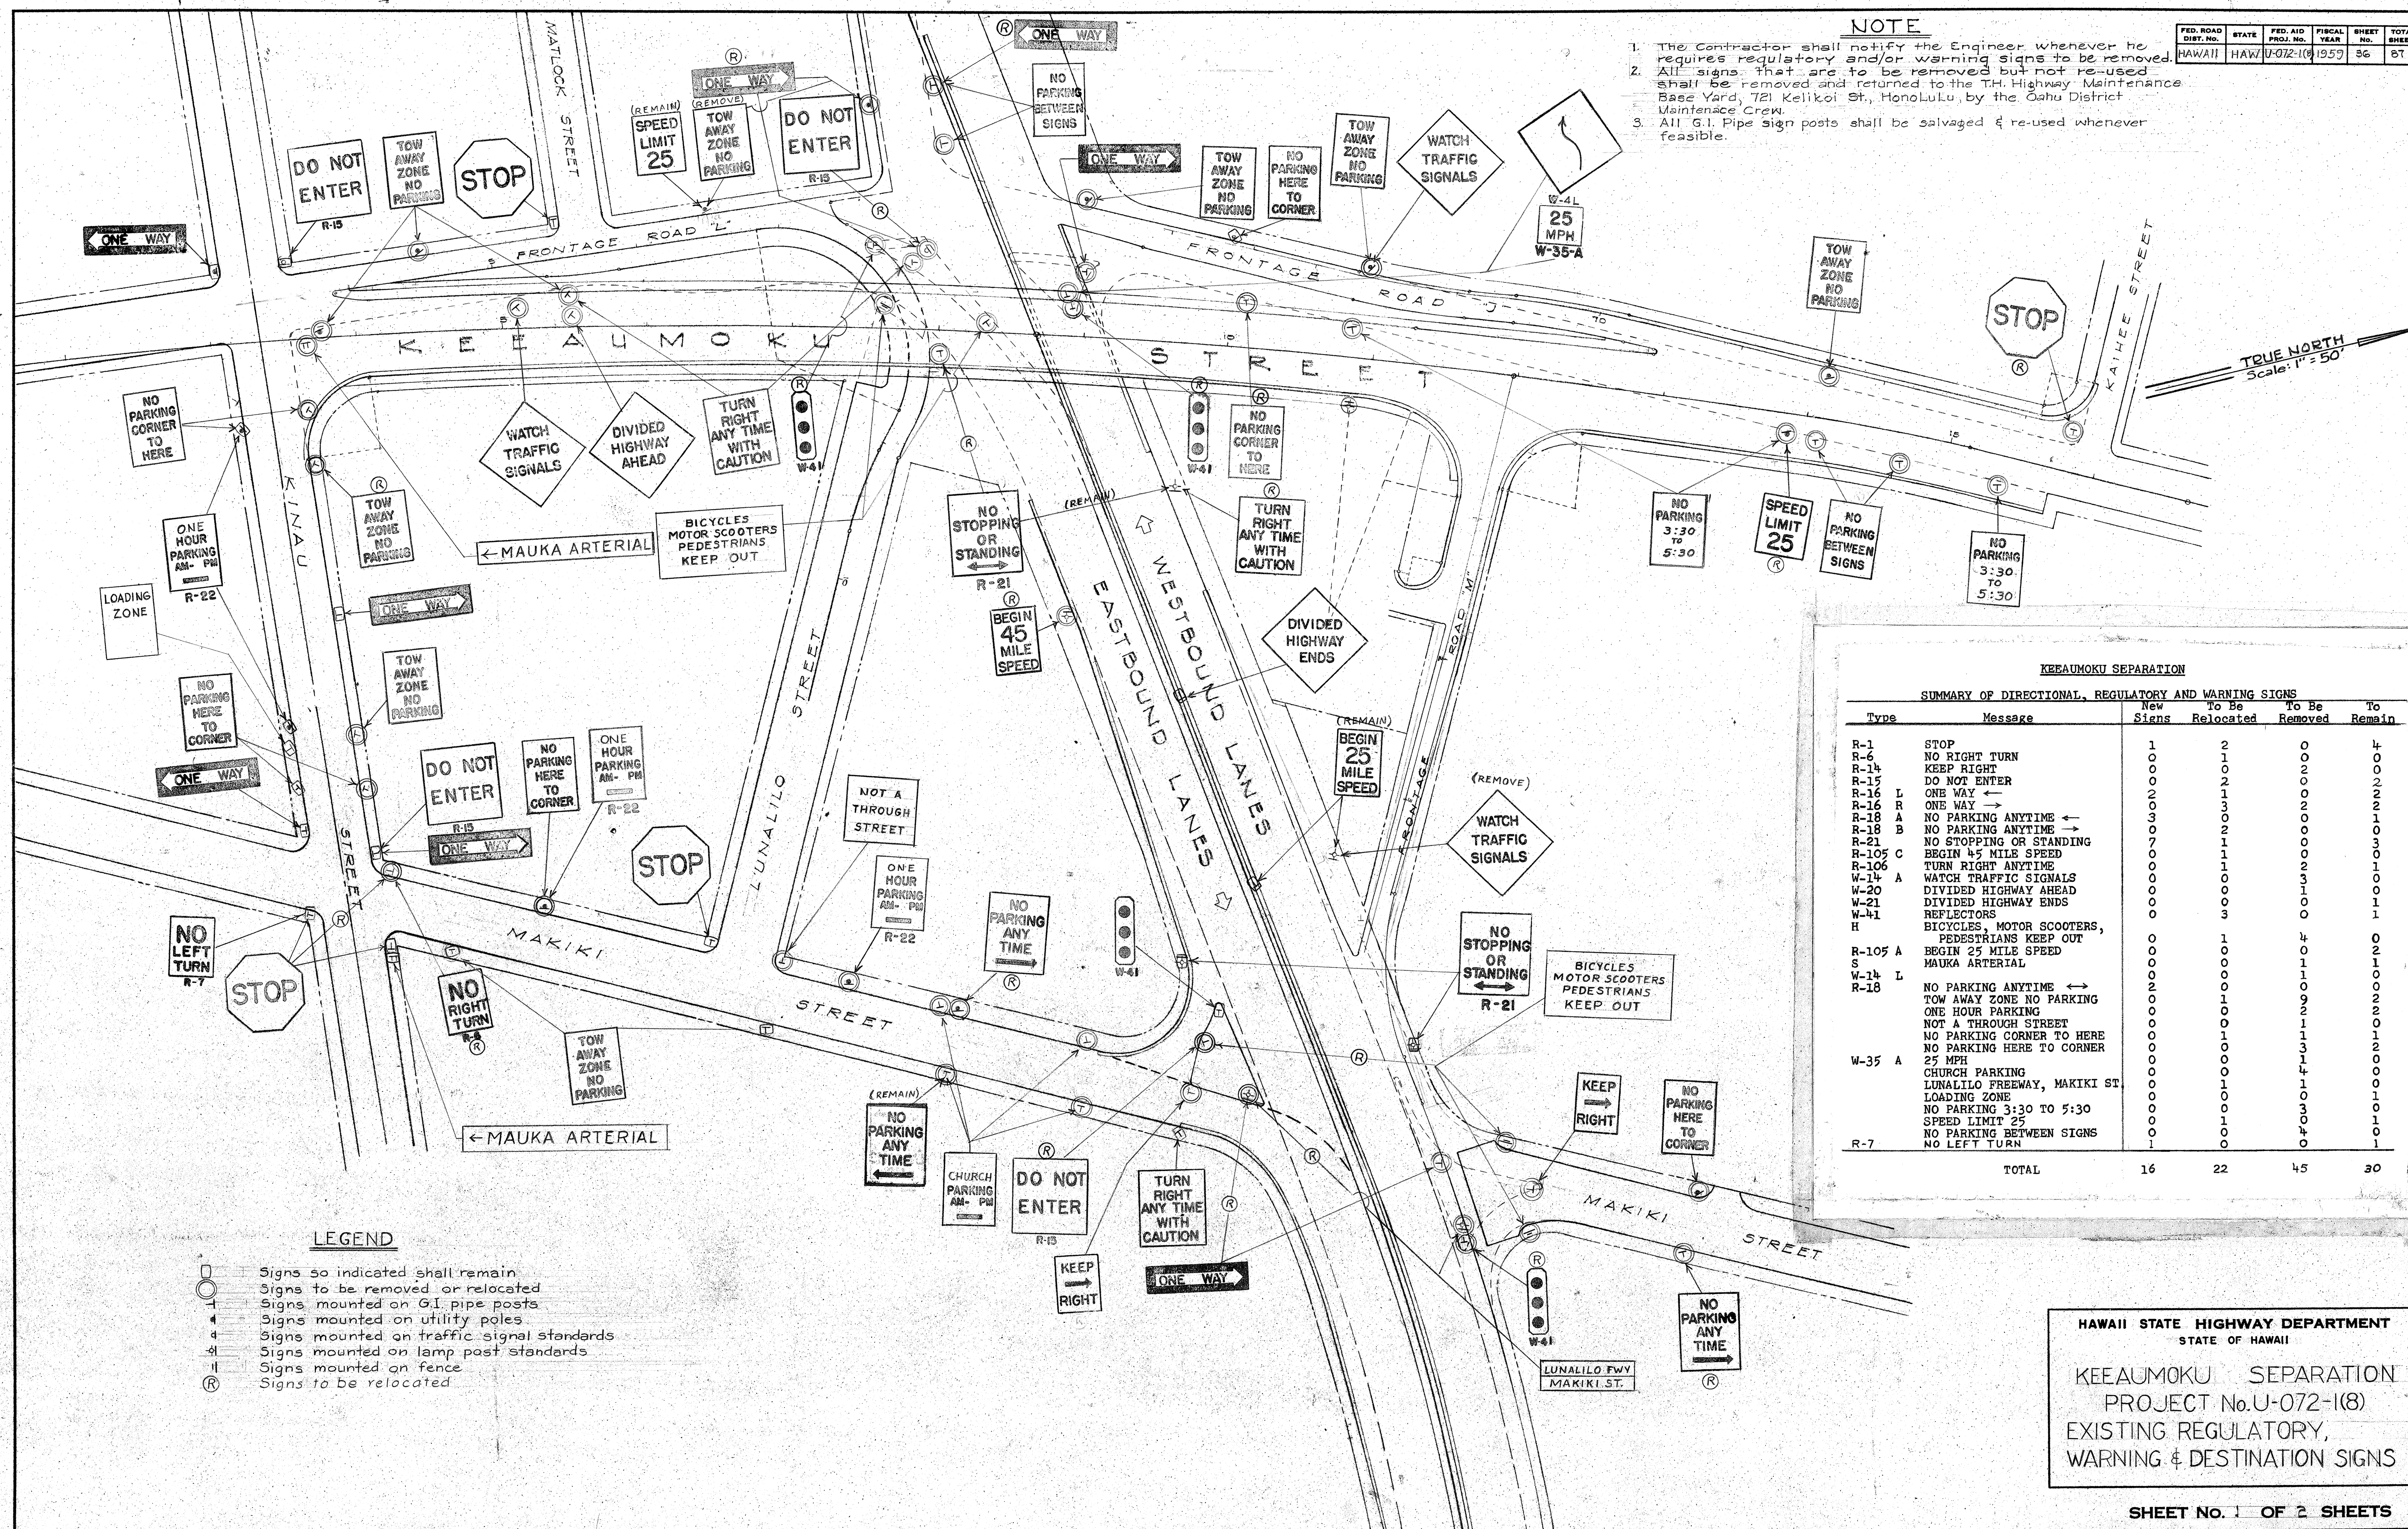

KETAUMOKU SEPARATION

SUMMARY OF DIRECTIONAL, REGULATORY AND WARNING SIGNS					
Type	Message	New Signs	To Be Relocated	To Be Removed	To Remain
R-1	STOP	1	2	0	4
R-6	NO RIGHT TURN	0	1	0	0
R-14	KEEP RIGHT	0	0	2	0
R-15	DO NOT ENTER	0	2	0	2
R-16 L	ONE WAY ←	0	1	0	2
R-16 R	ONE WAY →	0	3	0	2
R-18 A	NO PARKING ANYTIME ←	2	0	0	0
R-18 B	NO PARKING ANYTIME →	0	2	0	0
R-21	NO STOPPING OR STANDING	7	1	0	3
R-105 C	BEGIN 45 MILE SPEED	0	1	0	0
R-106	TURN RIGHT ANYTIME	0	1	2	1
W-14 A	WATCH TRAFFIC SIGNALS	0	0	3	0
W-20	DIVIDED HIGHWAY AHEAD	0	0	1	0
W-21	DIVIDED HIGHWAY ENDS	0	0	0	1
W-41	REFLECTORS	0	3	0	1
H	BICYCLES, MOTOR SCOOTERS, PEDESTRIANS KEEP OUT	0	1	4	0
R-105 A	BEGIN 25 MILE SPEED	0	0	0	2
S	MAUKA ARTERIAL	0	0	1	1
W-14 L	NO PARKING ANYTIME ↔	0	0	1	0
R-18	TOW AWAY ZONE NO PARKING	2	0	9	2
	ONE HOUR PARKING	0	0	2	0
	NOT A THROUGH STREET	0	0	1	0
	NO PARKING CORNER TO HERE	0	1	1	1
	NO PARKING HERE TO CORNER	0	0	3	2
W-35 A	25 MPH	0	0	1	0
	CHURCH PARKING	0	0	4	0
	LUNALILO FREEWAY, MAKIKI ST.	0	1	1	0
	LOADING ZONE	0	0	0	1
	NO PARKING 3:30 TO 5:30	0	0	3	0
	SPEED LIMIT 25	0	1	0	1
	NO PARKING BETWEEN SIGNS	0	0	4	0
R-7	NO LEFT TURN	1	0	0	1
TOTAL		16	22	45	30

HAWAII STATE HIGHWAY DEPARTMENT
STATE OF HAWAII

KEEAUMOKU SEPARATION
PROJECT No.U-072-1(8)
EXISTING REGULATORY,
WARNING & DESTINATION SIGNS

SHEET No. 1 OF 2 SHEETS



\$183.36

GENERAL NOTES G24L SERIES SIGNS


1. 18 inch upper case Series "E" letters shall be in accordance with "Standard Alphabets for Highway Signs" Department of Commerce, Bureau of Public Roads, 1952.
2. 12" lower case letters shall be in accordance with "Standard Details, Lower Case Letters."
3. Directional Arrows shall conform to "Standard Arrows for Directional Signs."
4. Structural Details of Sign Frames, Crossarms, Posts and Footings shall be in accordance with "Standard Details, Expressway Signs."
5. Fluorescent sign lighting shall conform to "Standard Details, Expressway Signs, Fluorescent Luminaire Supports."

FED. ROAD DIST. NO.	STATE	FED. AID PROJ. NO.	FISCAL YEAR	SHEET NO.	TOTAL SHEETS
HAWAII	HAWAII	U-072-1(8)	1953	57A	57


Revised: March 8, 1953

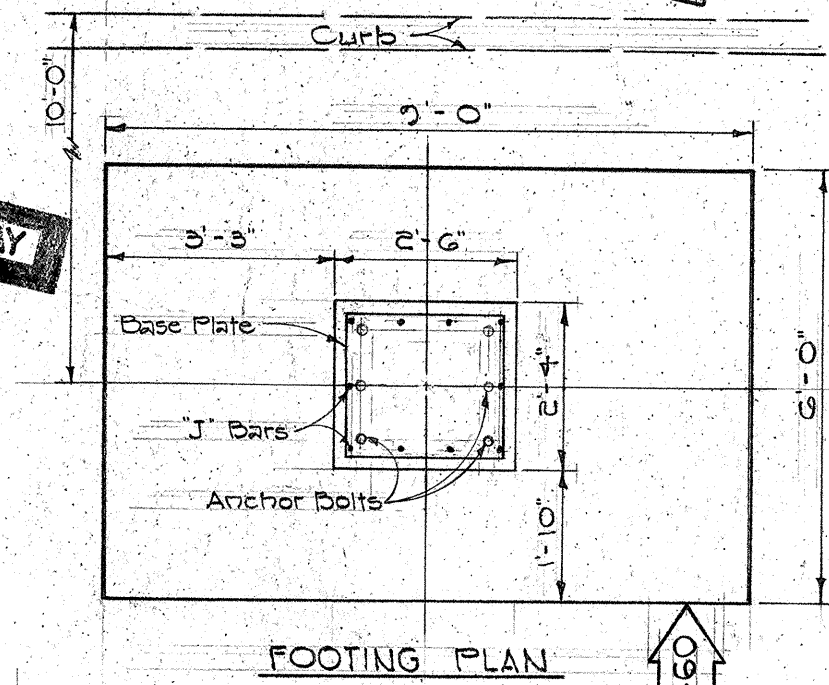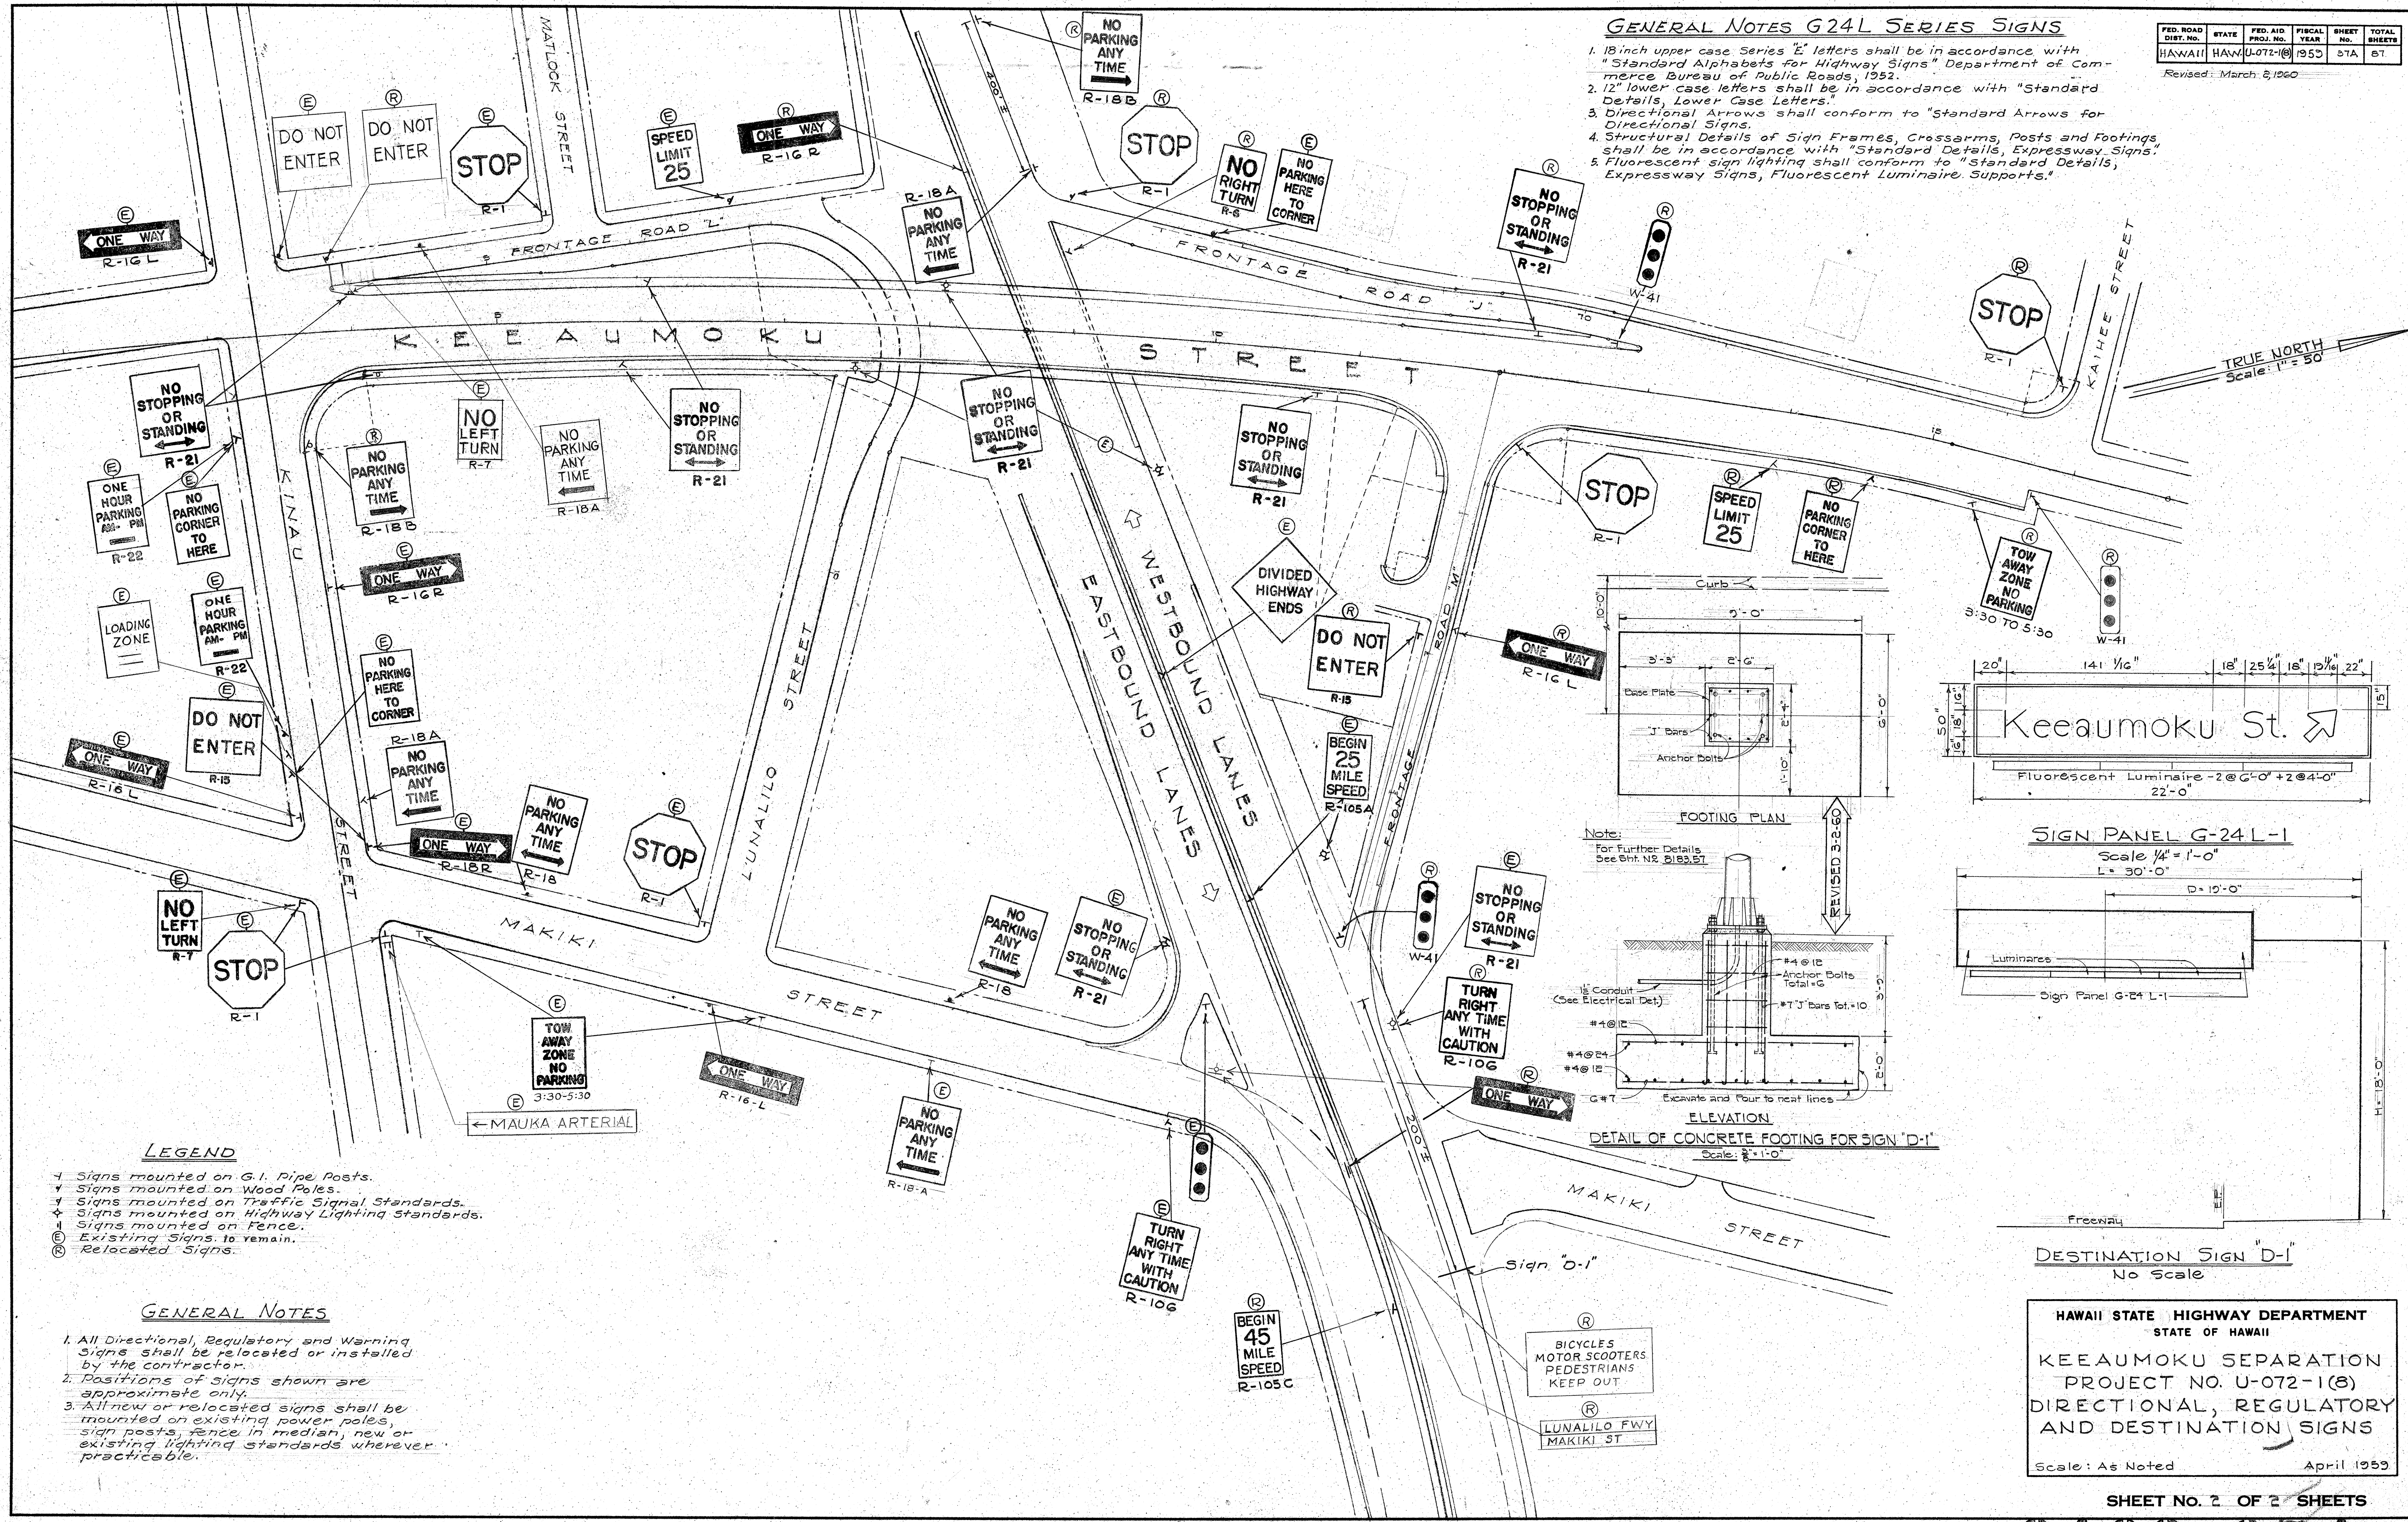


Note: For Further Details See Sht. N2, 2183, 57.

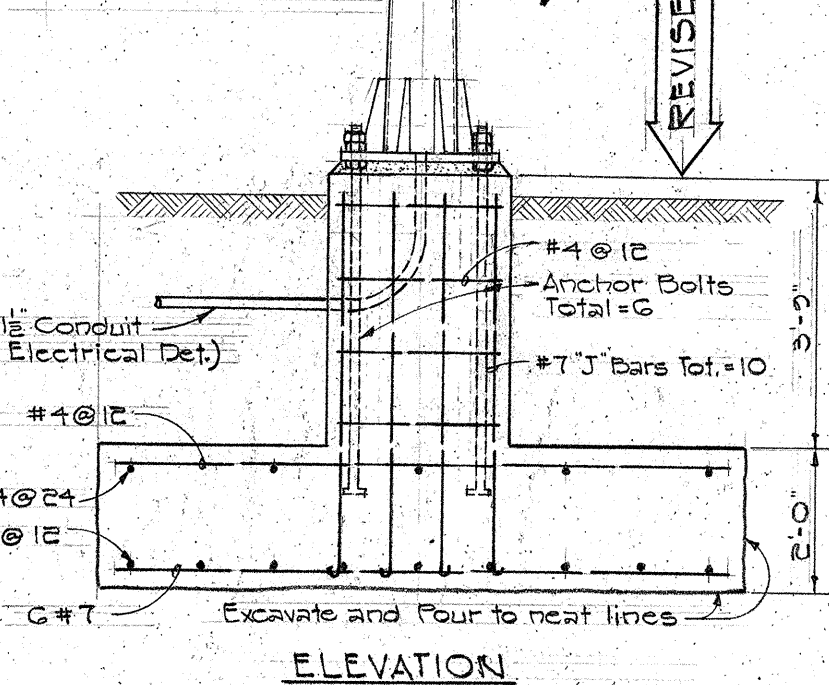

DETAIL OF CONCRETE FOOTING FOR SIGN "D-1" Scale: 3/8" = 1'-0"

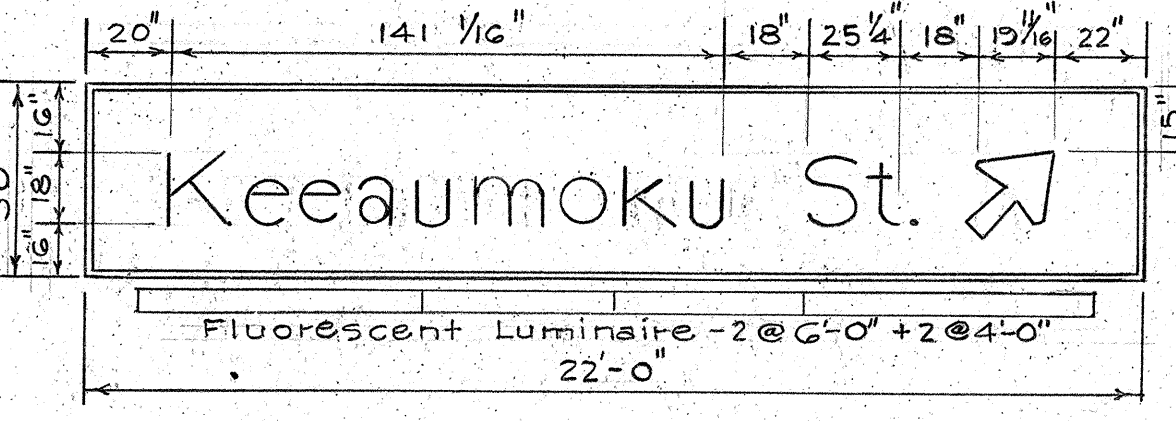

SIGN PANEL G-24 L-1 Scale: 1/4" = 1'-0"

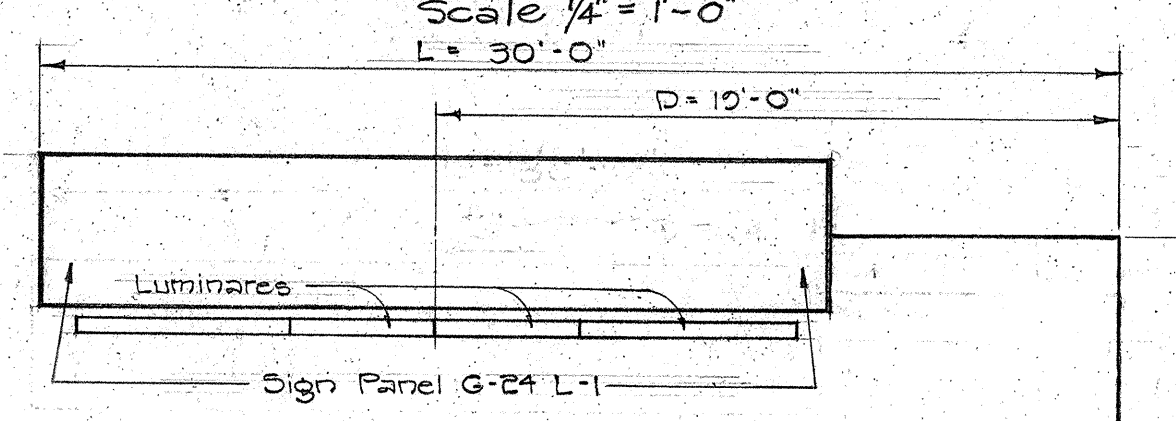

Sign Panel G-24 L-1

DESTINATION SIGN "D-1" No Scale

HAWAII STATE HIGHWAY DEPARTMENT
STATE OF HAWAII
KEEAUMOKU SEPARATION
PROJECT NO. U-072-1(8)
DIRECTIONAL, REGULATORY
AND DESTINATION SIGNS
Scale: As Noted April 1953

8183.37A

LEGEND

- 1. Signs mounted on G.I. Pipe Posts.
- 2. Signs mounted on Wood Poles.
- 3. Signs mounted on Traffic Signal Standards.
- 4. Signs mounted on Highway Lighting Standards.
- 5. Signs mounted on Fence.
- 6. Existing Signs to remain.
- 7. Relocated Signs.

GENERAL NOTES

1. All Directional, Regulatory and Warning Signs shall be relocated or installed by the contractor.
2. Positions of signs shown are approximate only.
3. All new or relocated signs shall be mounted on existing power poles, sign posts, fence in median, new or existing lighting standards wherever practicable.

DATE	
SURVEY PLOTTED BY	
DESIGNED BY	
DRAWN BY	
CHECKED BY	
ORIGINAL PLAN	
NOTE BOOK	
NO.	