





FED. ROAD DIST. No.	STATE	FED. AID PROJ. No.	FISCAL YEAR	SHEET No.	TOTAL SHEETS
HAWAII	HAW	BU-065-1(1)	1960	27	79

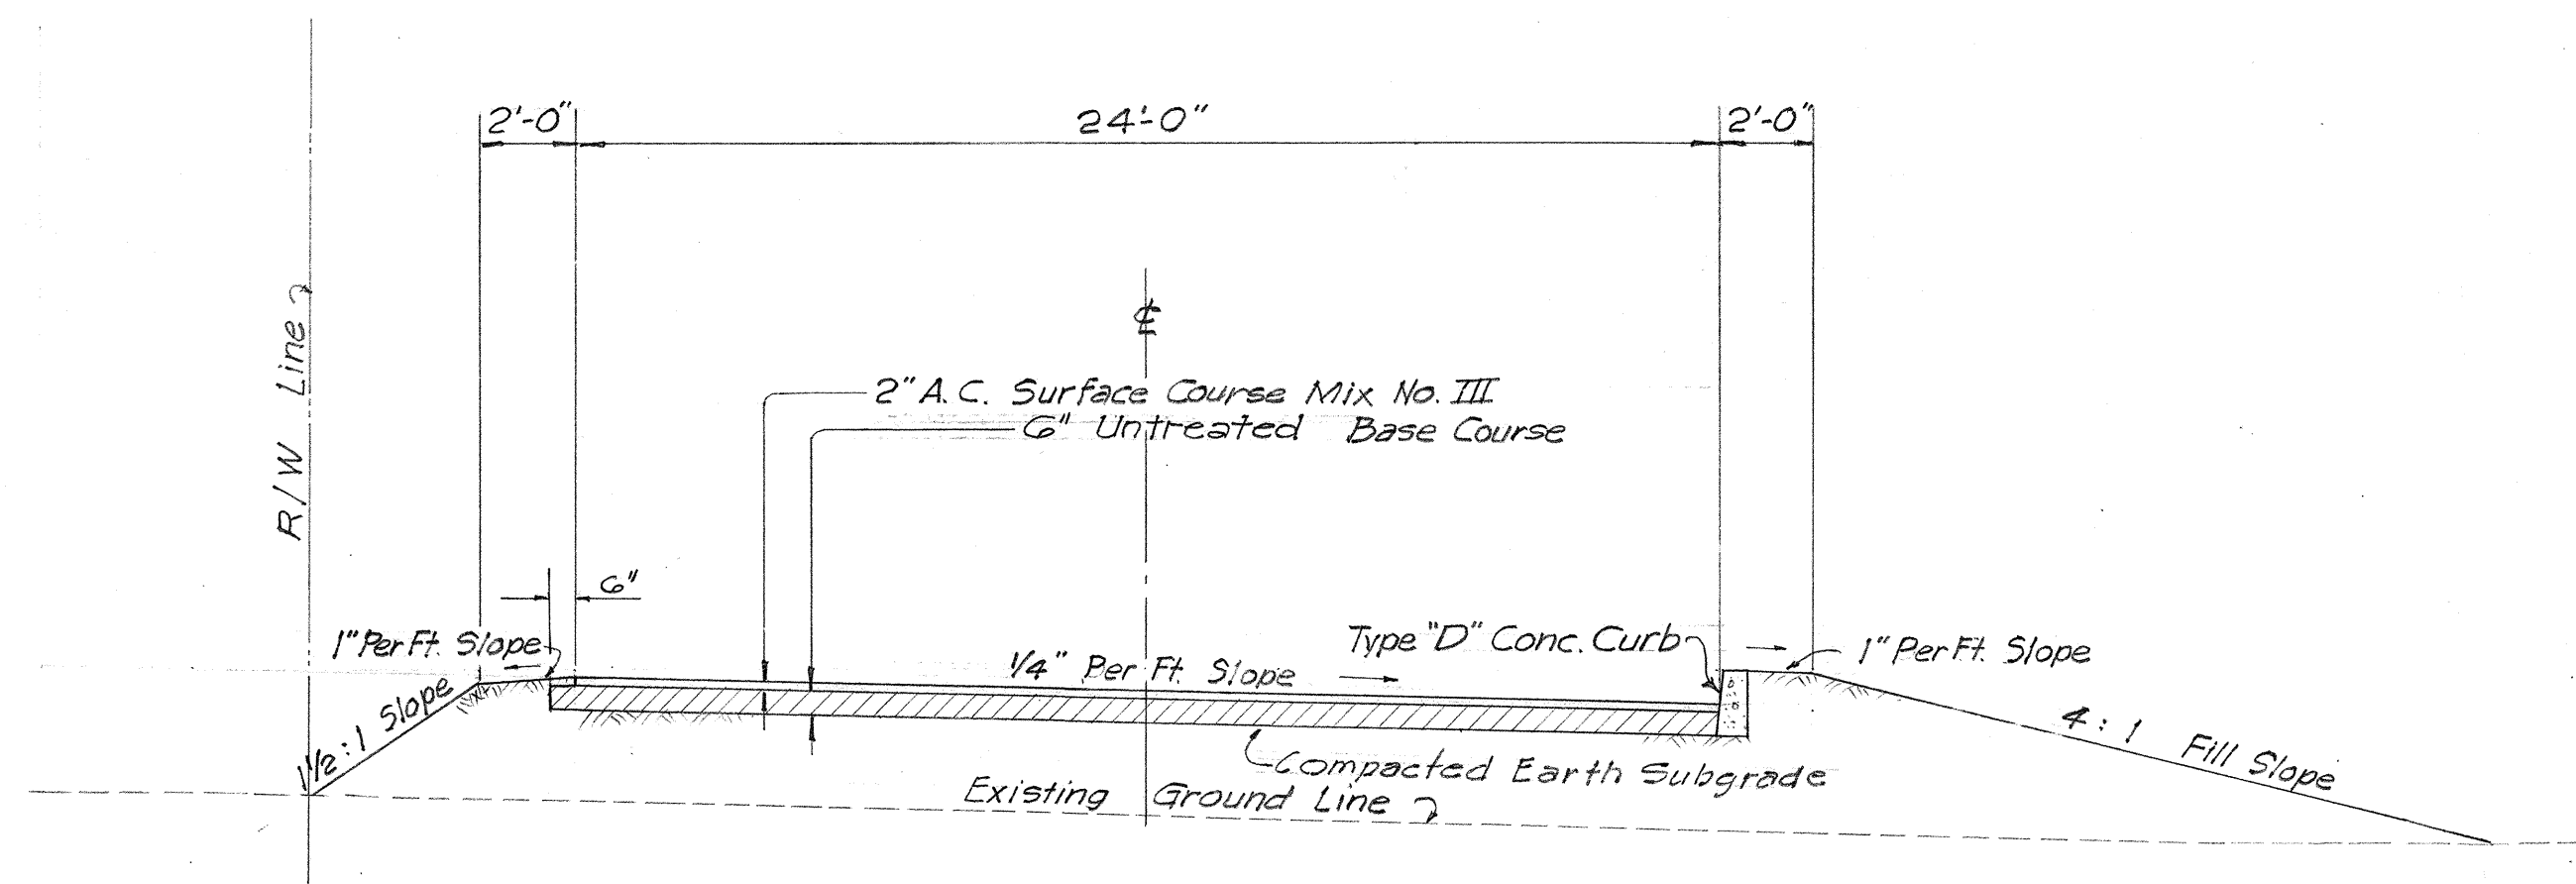

TYPICAL SECTION
Scale: 1/4" = 1'-0"

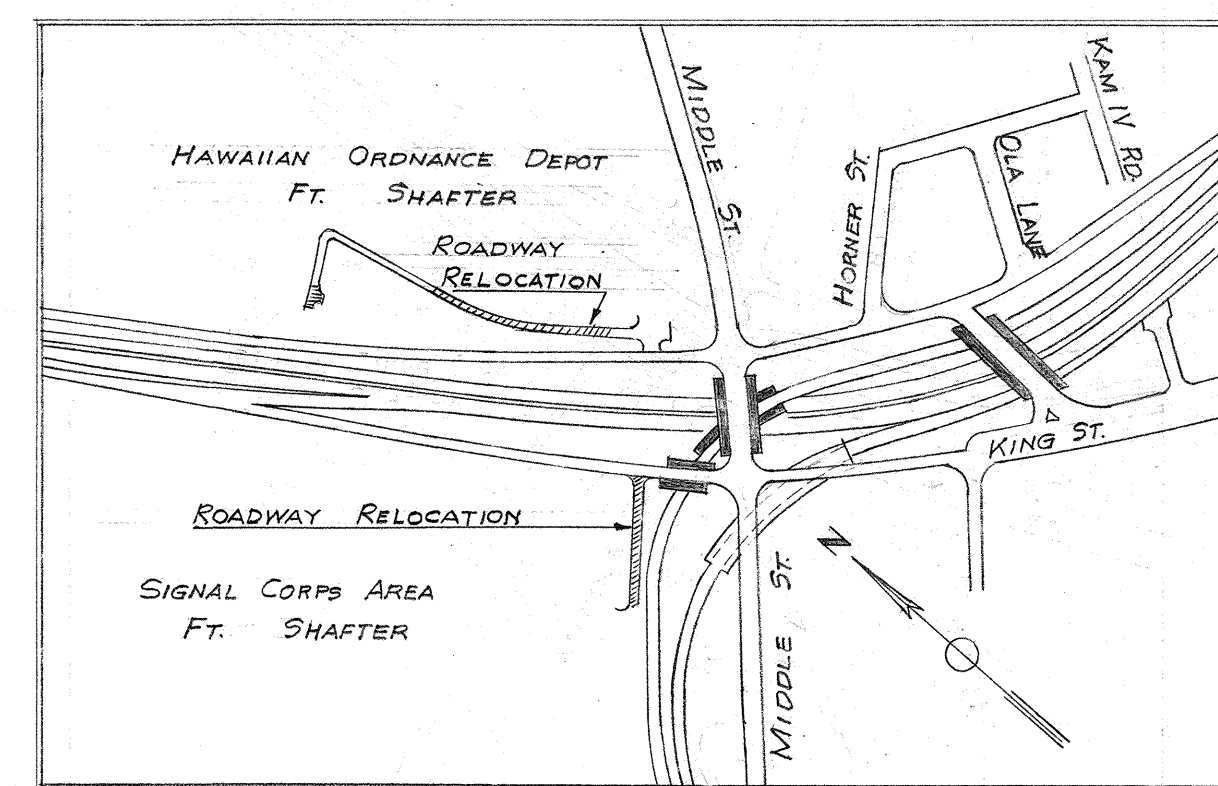

KEY MAP

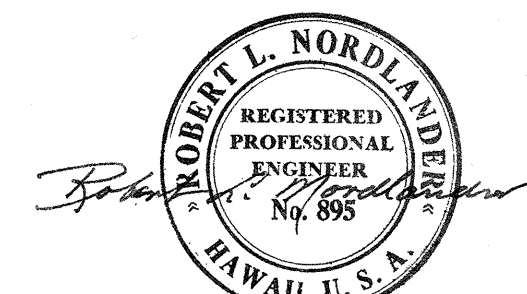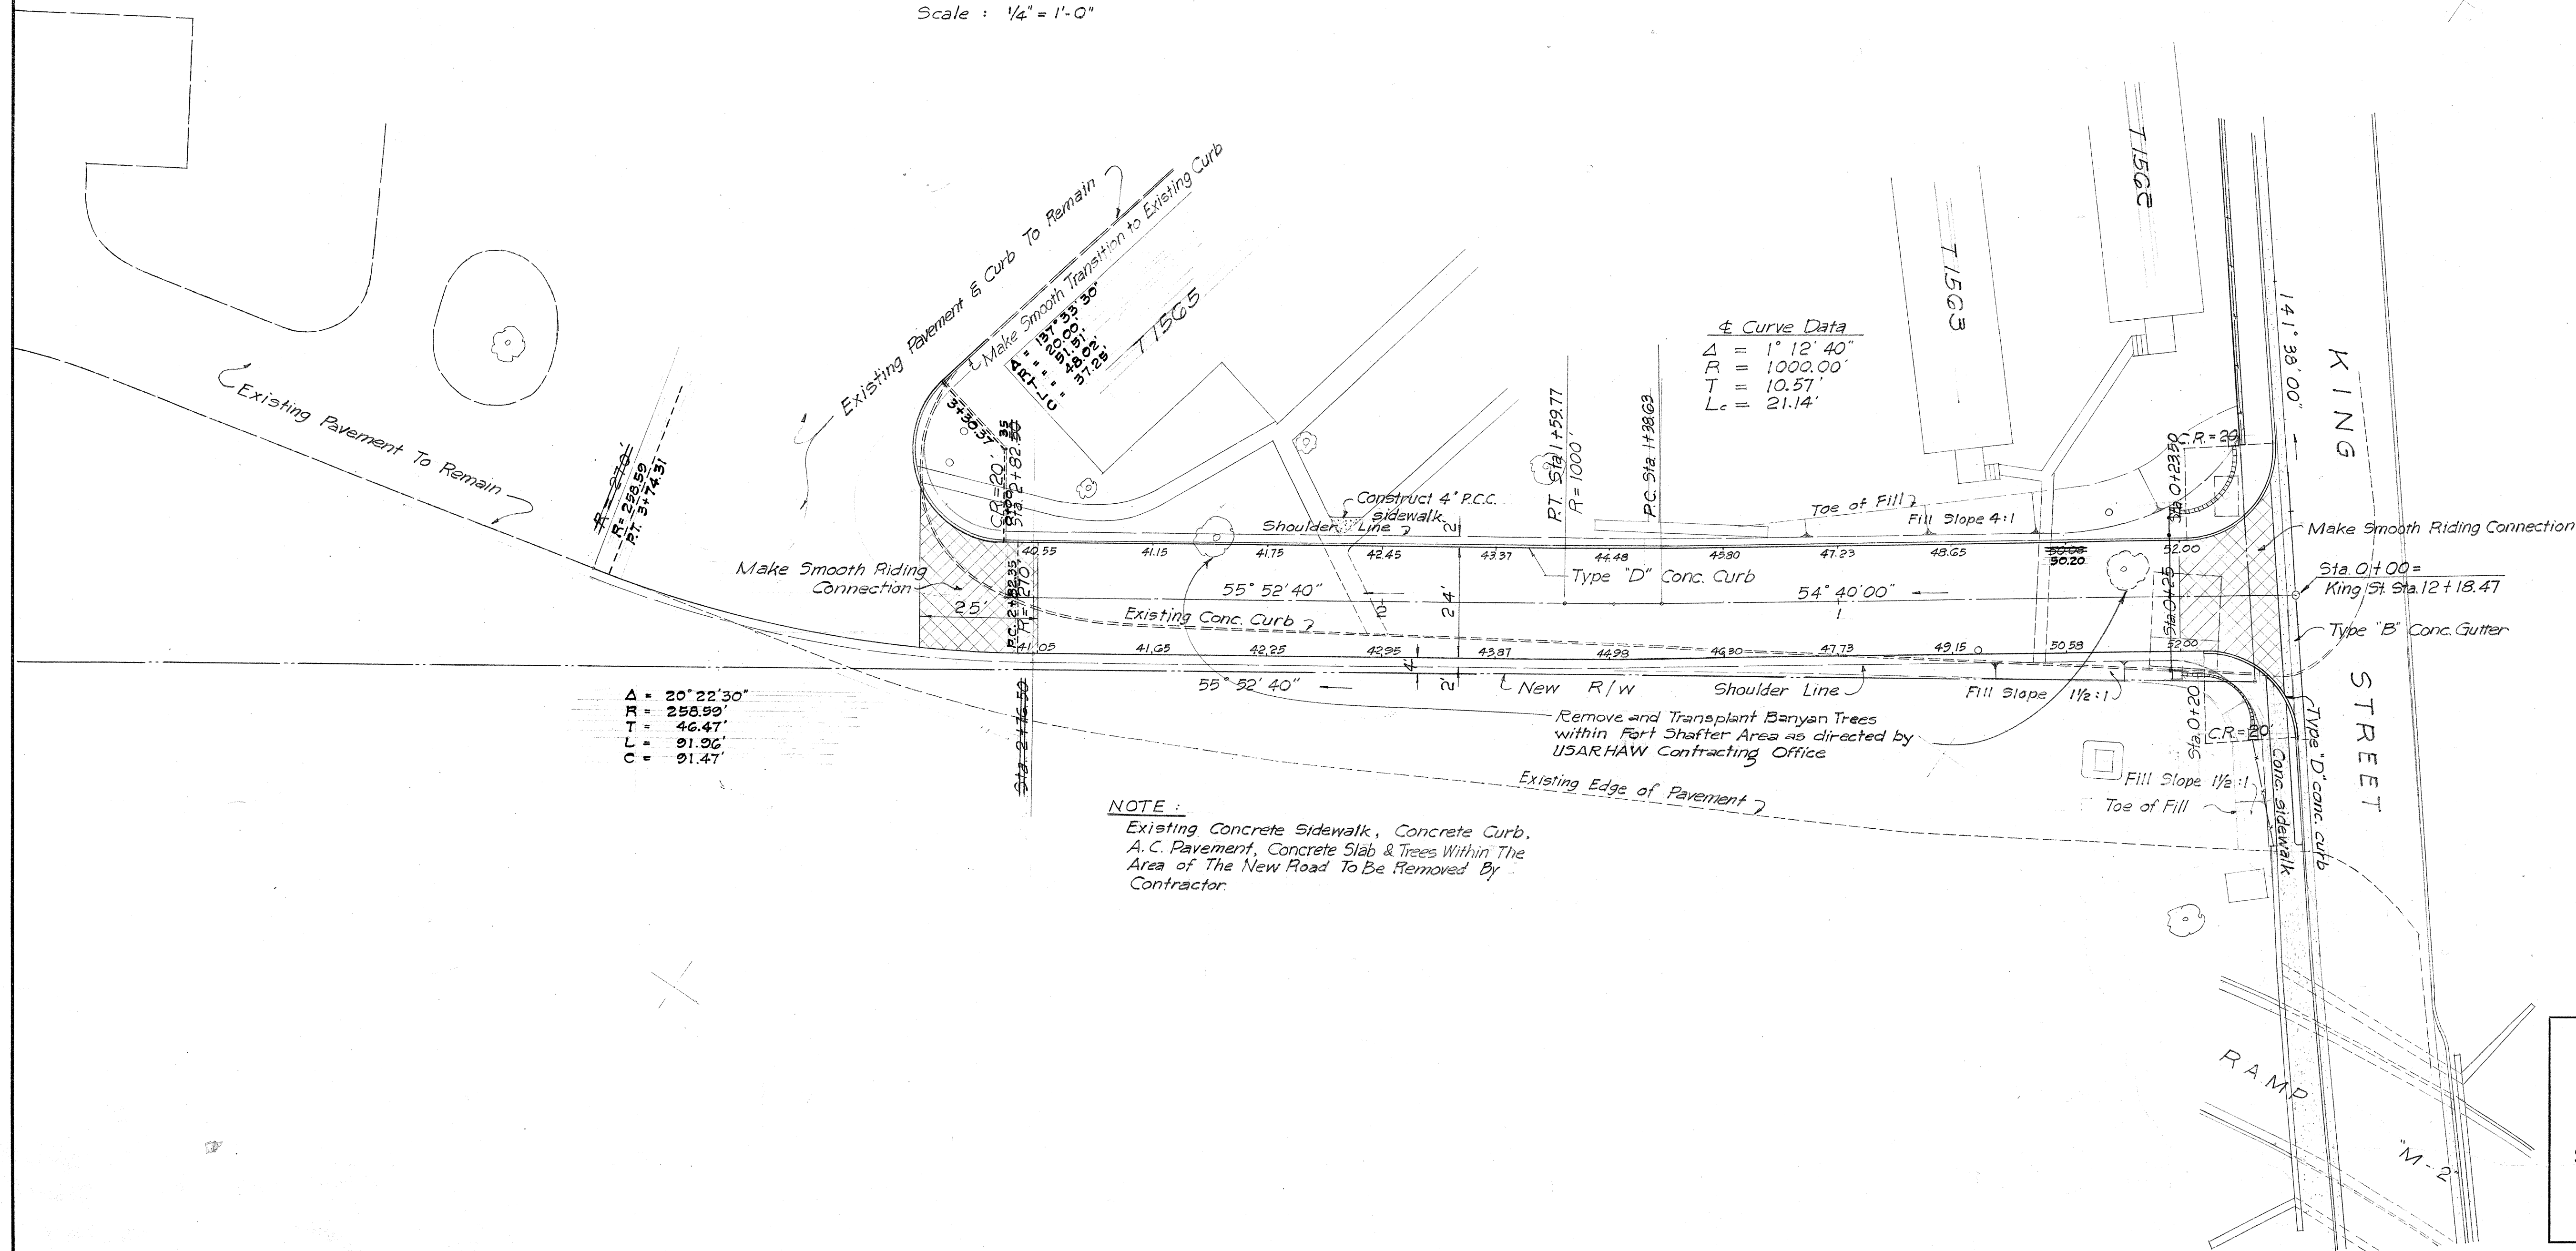

BELT, COLLINS & ASSOC., LTD.
Civil and Structural Engineers

HAWAII STATE HIGHWAY DEPARTMENT
STATE OF HAWAII

ROADWAY RELOCATION
SIGNAL CORPS AREA - FT. SHAFTER

MIDDLE STREET BU-065-1(1) UNIT 3

SHEET NO. 2 OF 2 SHEETS

\$161.27 40

SURVEY PLOTTED BY: M. M. M.	DATE: 1/15/61
DRAWN BY: M. M. M.	
TRACED BY: M. M. M.	
QUANTITIES CHECKED BY: M. M. M.	
NOTE BOOK No.:	