


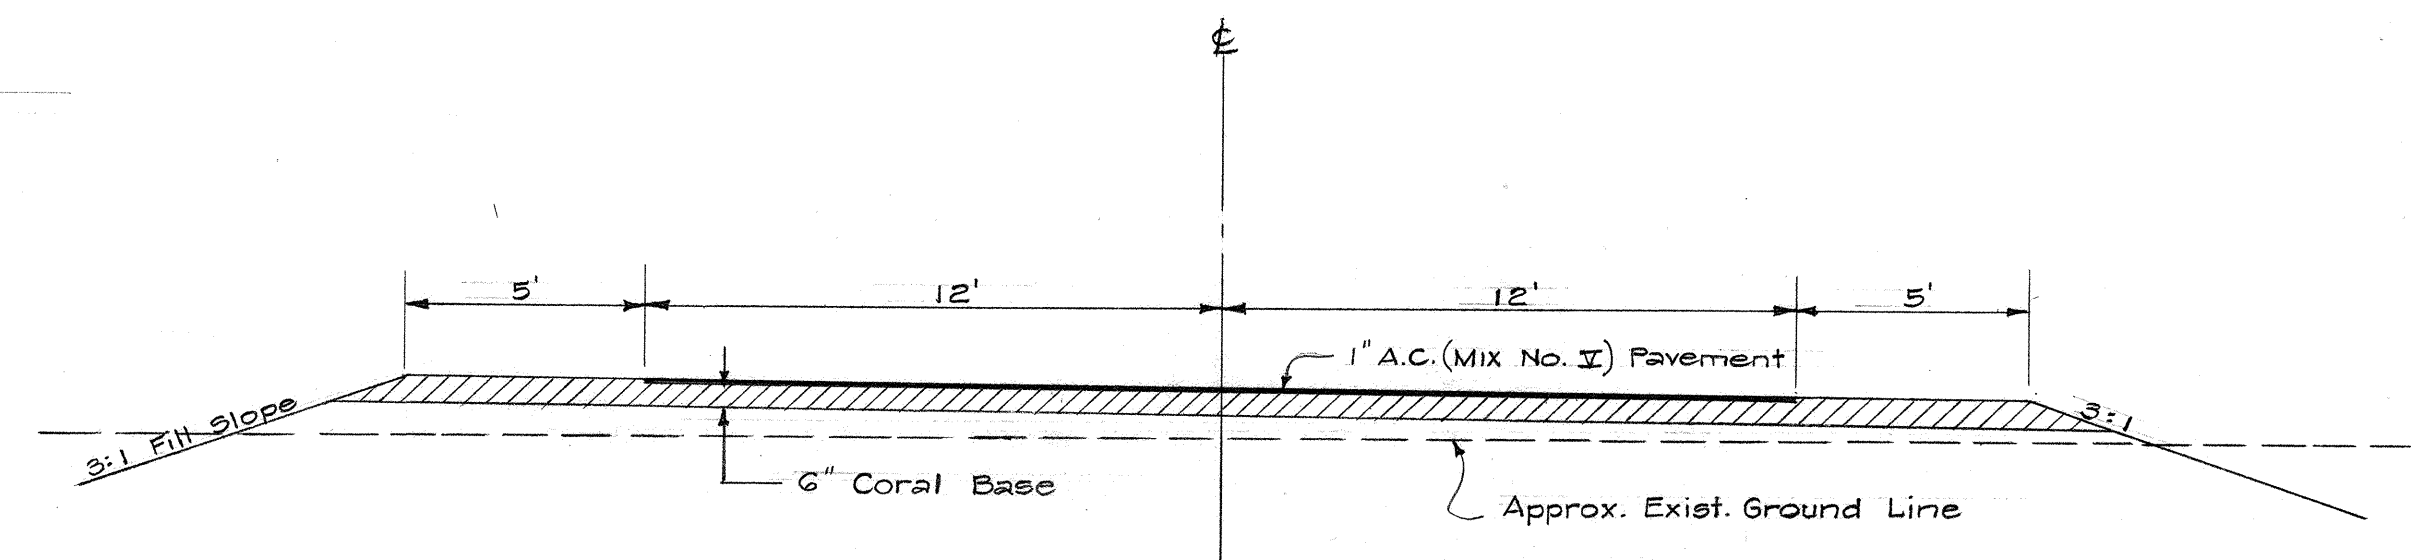

TYPICAL SECTION
Scale: $\frac{1}{4}" = 1'-0"$
(FOR C/1, C/2 AND C/3)

SHEET No. 5 OF 5 SHEETS

