



FED. ROAD DIST. No.	STATE	FED. AID PROJ. No.	FISCAL YEAR	SHEET No.	TOTAL SHEETS
HAWAII	HAW.	U-072-(3)	1963	15	246
		U-098-1(4)	1963	6	88

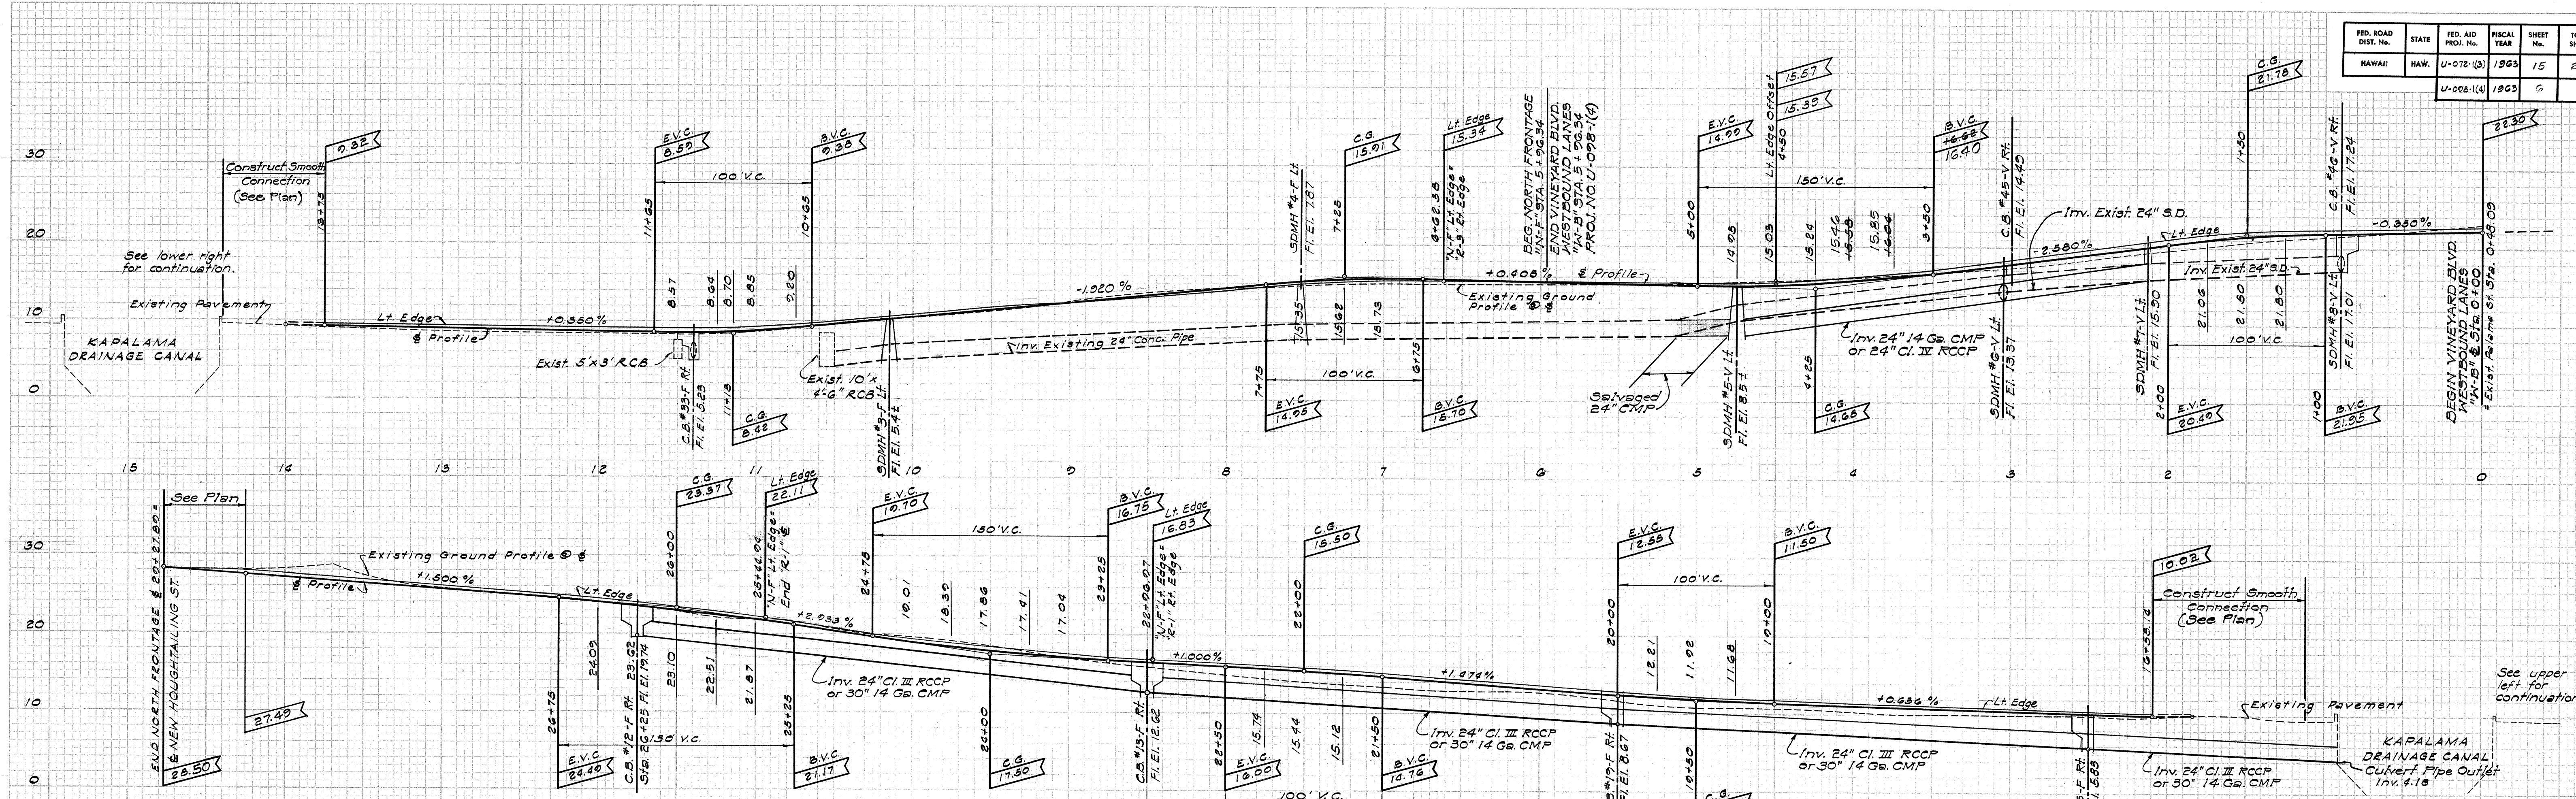

· PROFILE NORTH FRONTAGE AND VINEYARD BLVD. WEST BOUND LANES ·

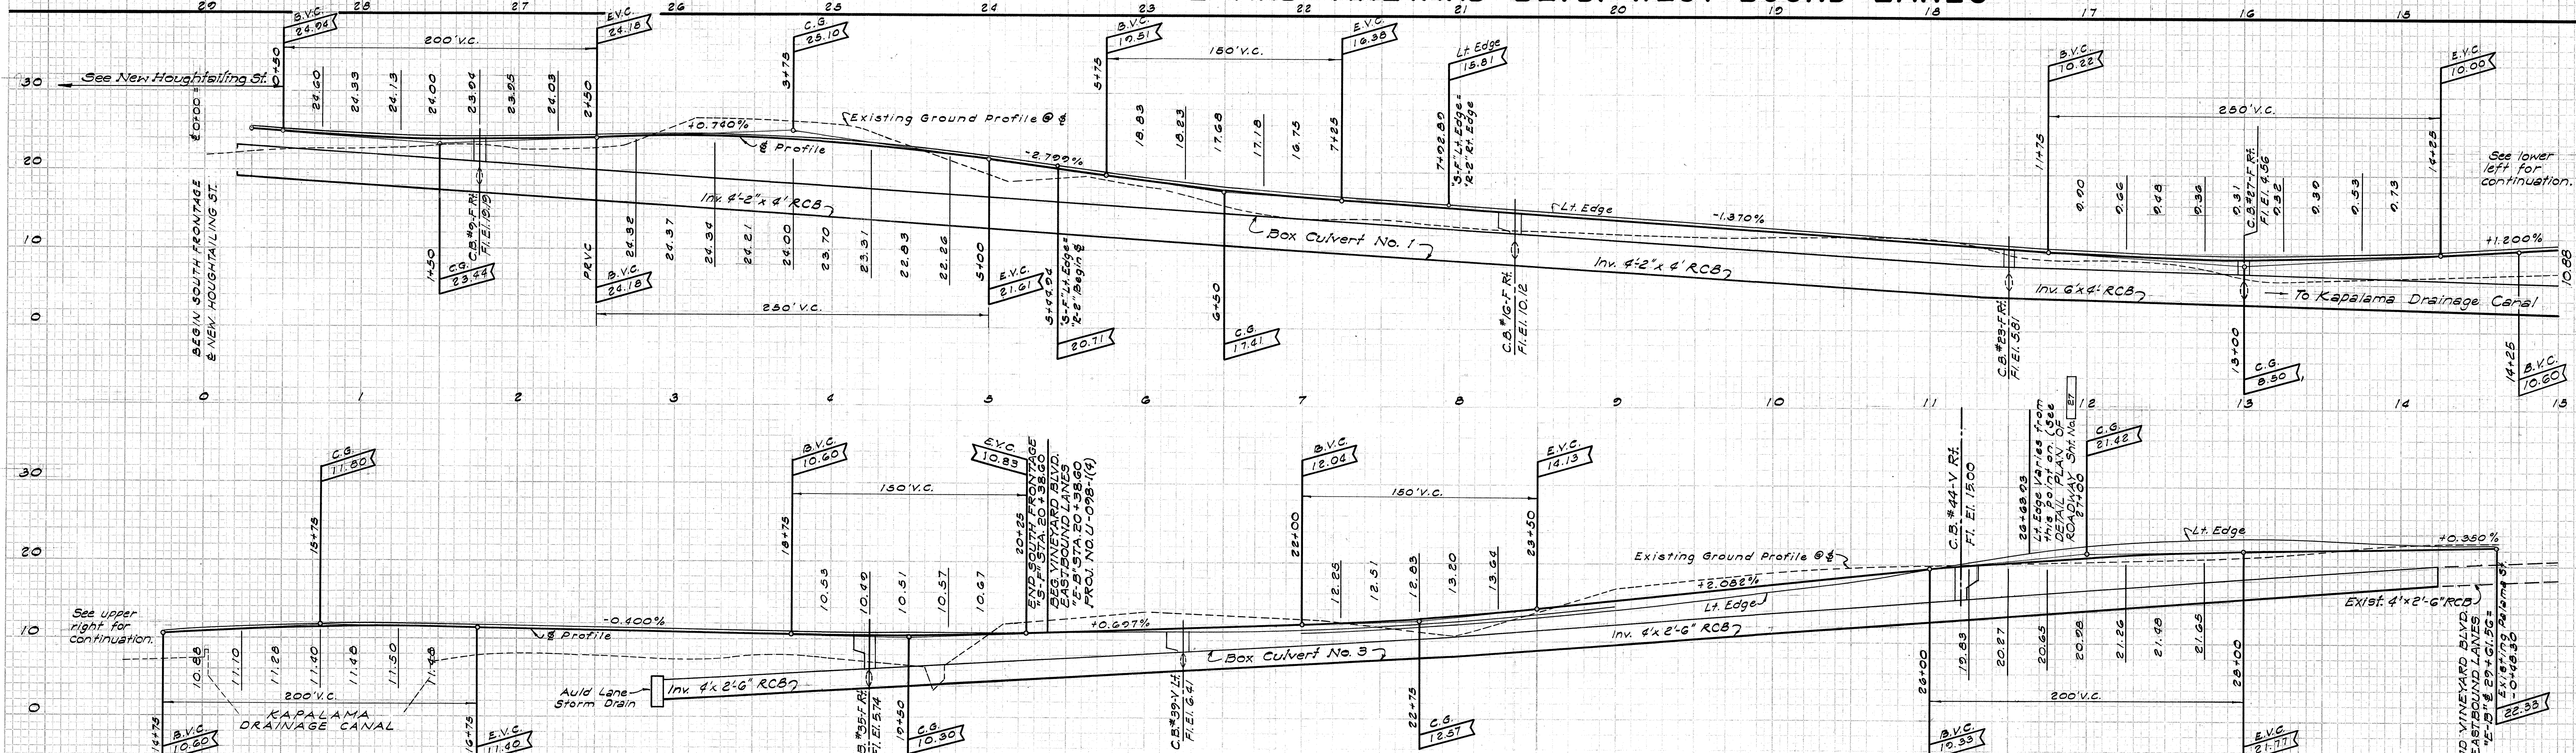

· PROFILE SOUTH FRONTAGE AND VINEYARD BLVD. EAST BOUND LANES ·

U09810400.0 U07210300.15 18

FED. ROAD DIST. No.	STATE	FED. AID PROJ. No.	FISCAL YEAR	SHEET No.	TOTAL SHEETS
HAWAII	HAW.	U-072-13	1963	16	246

• RAMP "1" PROFILE •

• RAMP "2" PROFILE •

• RAMP "3" PROFILE •

• RAMP "4" PROFILE •

• RAMP "5" PROFILE •

• RAMP "6" PROFILE •

PLATE 3 CROSS SECTION 0.6, 2.0, 2.5 STANDARD
VERTICAL CURVE DATA FOR RAMP 1

U.S. OF M. 300-30
1961

SHEET No. 2 OF 3 SHEETS


U 0 7 2 1 0 3 0 0 . 1 6

(SUPERSEDED)

FINAL SURVEY	DATE
BY	
NOTED	
NOTE BOOK	
AREAS CHECKED	
NO.	

ORIGINAL SURVEY	DATE
BY	
NOTED	
NOTE BOOK	
AREAS CHECKED	
NO.	

FED. ROAD DIST. NO.	STATE	FED. AID PROJ. NO.	FISCAL YEAR	SHEET NO.	TOTAL SHEETS
HAWAII	HA	U-072-1(3)	1963	16	240

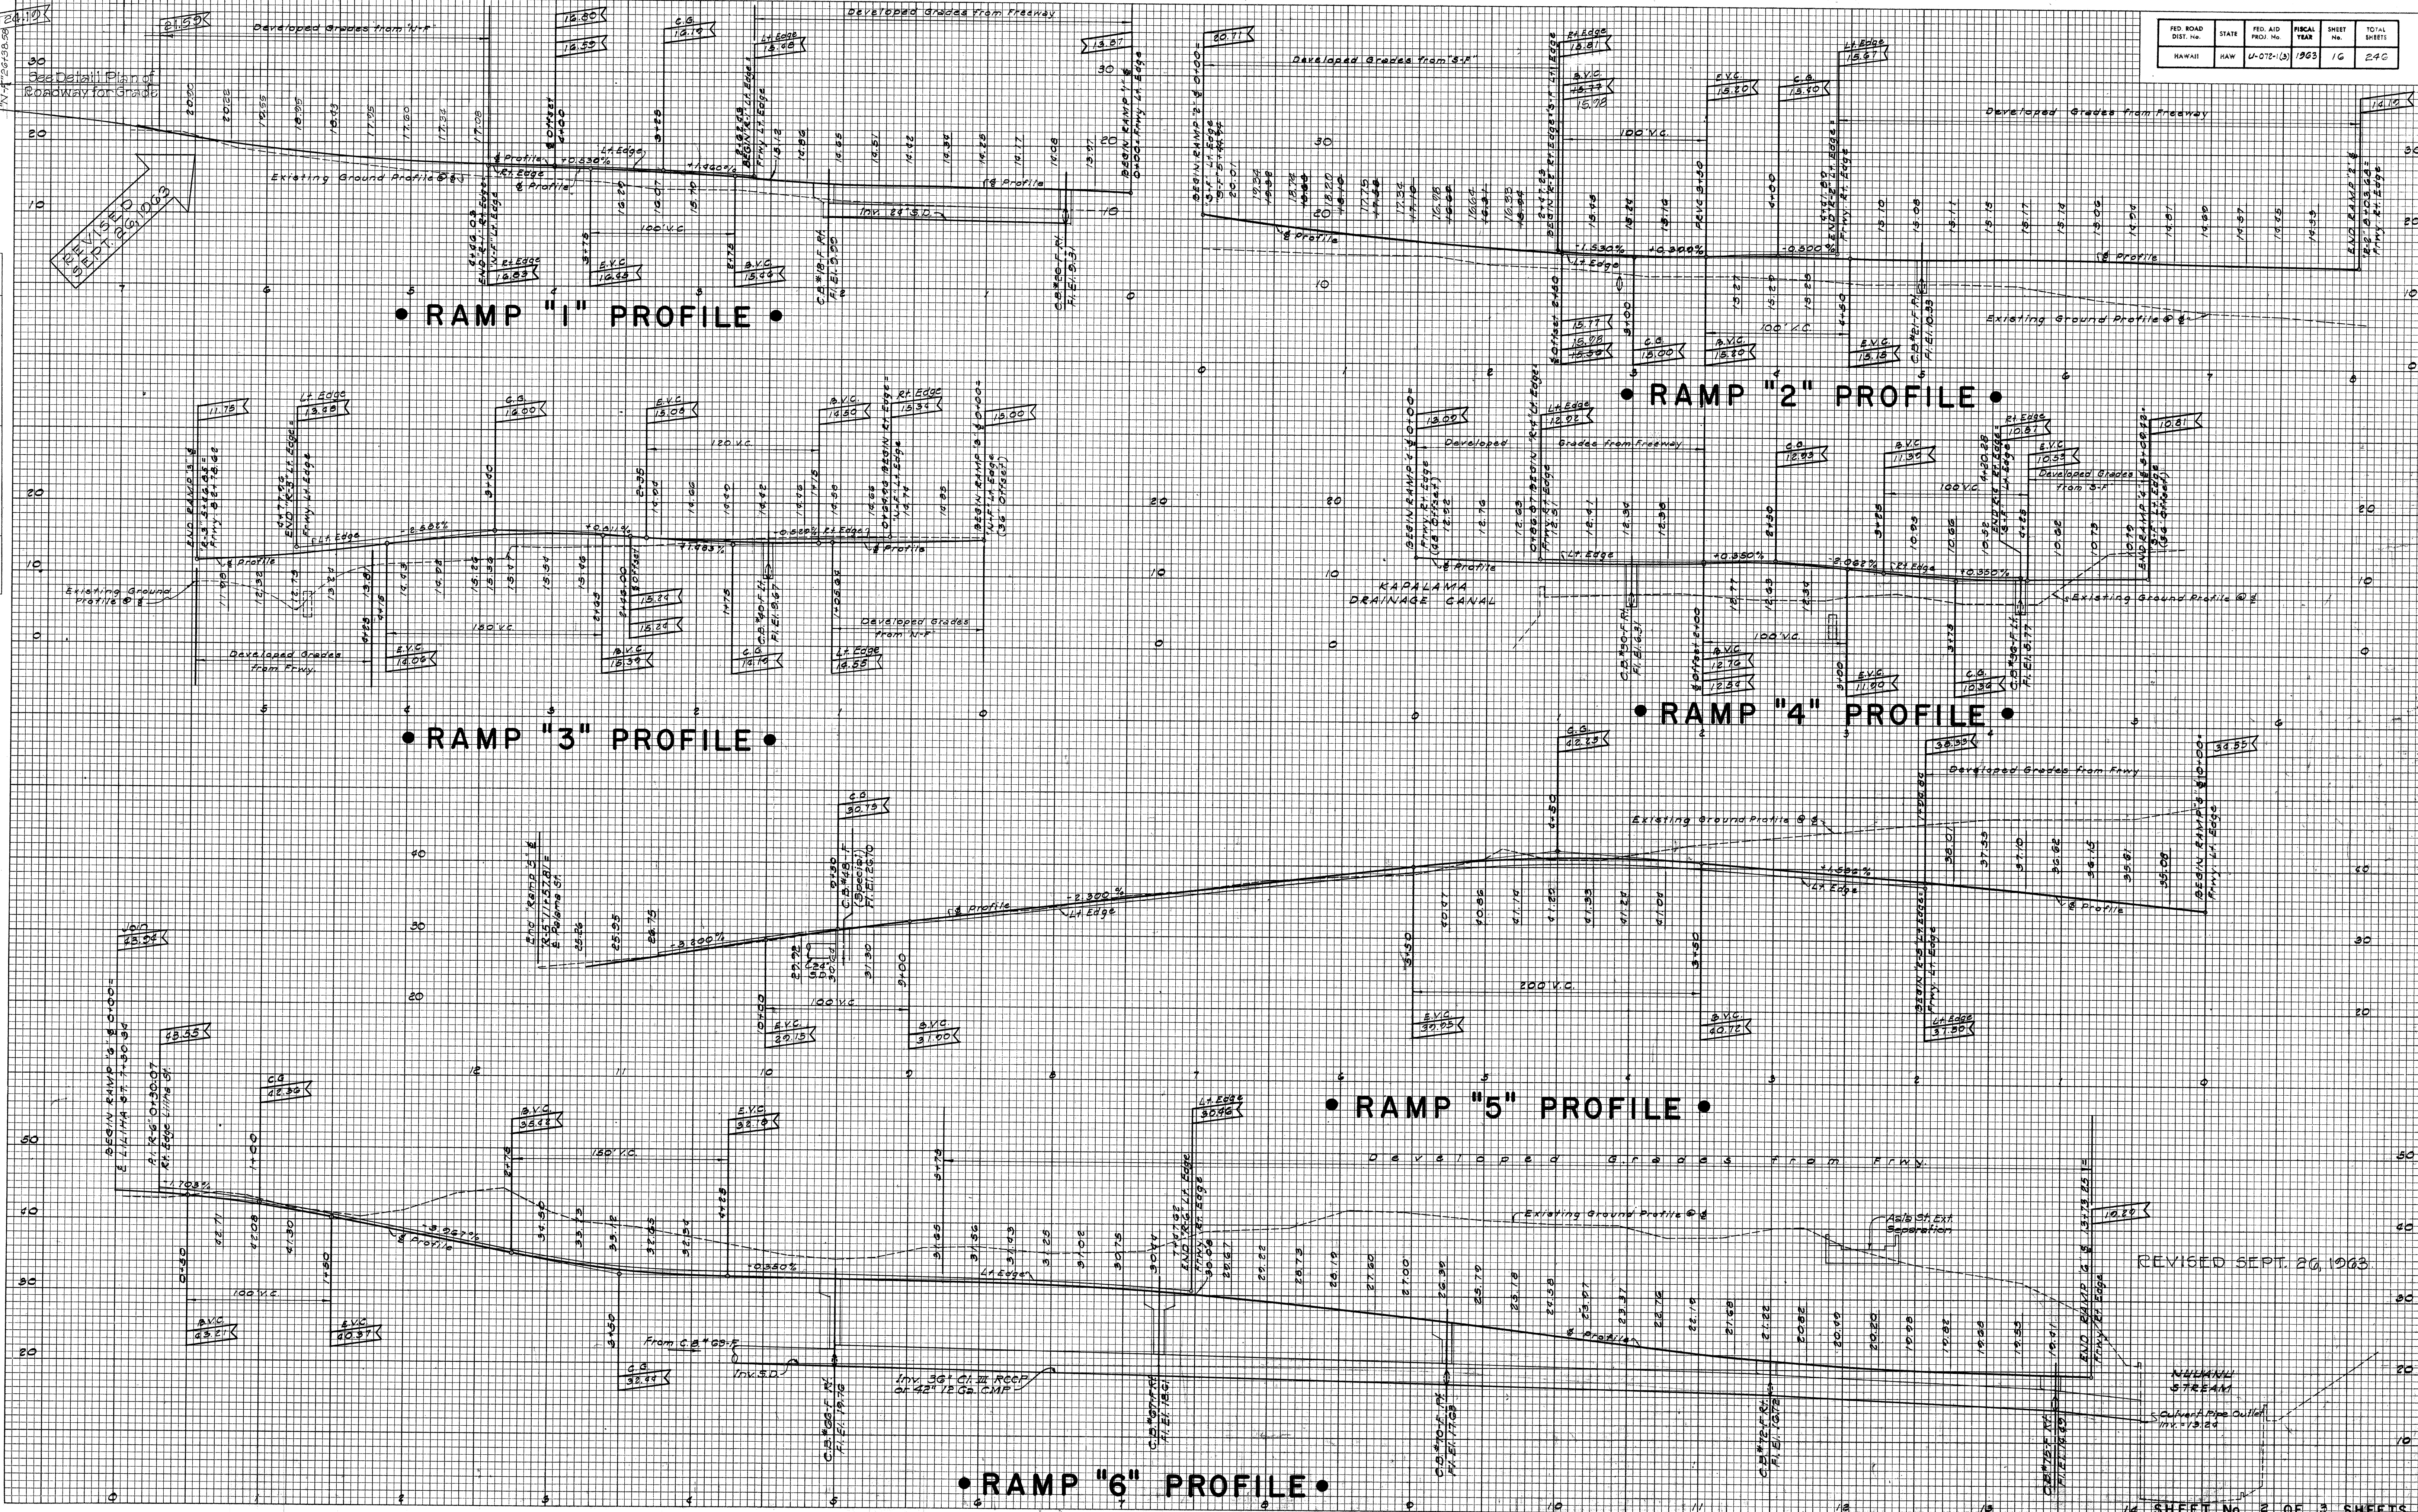

FED. ROAD DIST. No.	STATE	FED. AID PROJ. No.	FISCAL YEAR	SHEET No.	TOTAL SHEETS
HAWAII	HAW.	U-07518	1963	17	246

