


INDEX TO DRAWINGS		COMPOSITE SHEET NO.
SHEET NO.	DESCRIPTION	
1	TITLE SHEET	1
2-8	TYPICAL SECTIONS	4-10
9-14	PLAN AND PROFILE	11-16
15-17	MISC. ROADWAY PROFILES	18-20
18-30	DETAIL PLAN OF ROADWAY	21-33
31, 32	CONSTRUCTION PHASES	36, 37
33-36	DETOURS "D/1", "D/2", "D/3", "D/4" & "D/5"	38-41
37	CONNECTIONS "C/1" AND "C/2"	42
38	CRM RET. WALL NOS. 1, 2 & 3	43
39-42	MISC. ROADWAY DETAILS	44-47
43-45	PROFILES-DRIVEWAYS & SIDE LANES	49-51
46-53	STANDARD DETAILS-HIGHWAY	52-59
54-62	RETAINING WALLS NO. 1 TO NO. 10	60-68
63-65	BORING LOG	69-71
66-80	DRAINAGE SYSTEM	72-78 80-85 89-88
81	SUBSURFACE DRAINS	89
82-89	RELOC. & REHAB. OF BLDGS. & IMPROVEMENTS	90-94 97, 109, 110
90-98	UTILITIES - WATER	111-115 117-120
99-106	UTILITIES - SEWER	121-125 127-129
107-125	UTILITIES - ELECTRIC AND TELEPHONE	130-132 134-136 138, 139, 141-145 148-153
126-128	UTILITIES - GAS	154-156
129	SIGNAL CORP MANHOLE	158
130-135	HIGHWAY LIGHTING SYSTEM	159-164
136-140	TRAFFIC SIGNAL SYSTEM	165-169
141-143	TRAFFIC SIGNS	170-172
144-153	DESTINATION & EXPRESSWAY SIGNS	174-183
154-165	STANDARD DETAILS-TRAFFIC SIGNS	184-195
166-179	LANDSCAPE & SPRINKLER	196-209
180-204	CROSS SECTIONS	210-234
205-209	STRUCTURE NO. 1	237-241
210-219	STRUCTURE NO. 2 & NO. 3	242-251
220-231	STRUCTURE NO. 4	252-263
232-234	STRUCTURE NO. 5	264-266
235-238	STRUCTURE NO. 7	272-275
239, 240	STRUCTURE NO. 8	276, 277
241-246	STANDARD DETAILS - BRIDGE	278-283

STATE OF HAWAII
DEPARTMENT OF TRANSPORTATION
HIGHWAYS DIVISION
"AS BUILT" PLANS OF
LUNALILO FREEWAY
HOUGHTAILING STREET TO NUUANU STREAM
FEDERAL AID PROJECT NO. U-072-1(3)


DISTRICT OF HONOLULU
ISLAND OF OAHU

SCALES	
PLAN	1" = 50'-0"
PROFILE	HOR. 1" = 50'-0" VER. 1" = 10'-0"
CROSS SECTION	HOR. 1" = 10'-0" VER. 1" = 10'-0"

NOTE:
ALL CHANGES MADE DURING CONSTRUCTION
HAVE BEEN NOTED IN RED ON THESE TRACINGS
AND CHECKED BY:
Ronald T. Savat
PROJECT ENGINEER
10/30/68
DATE

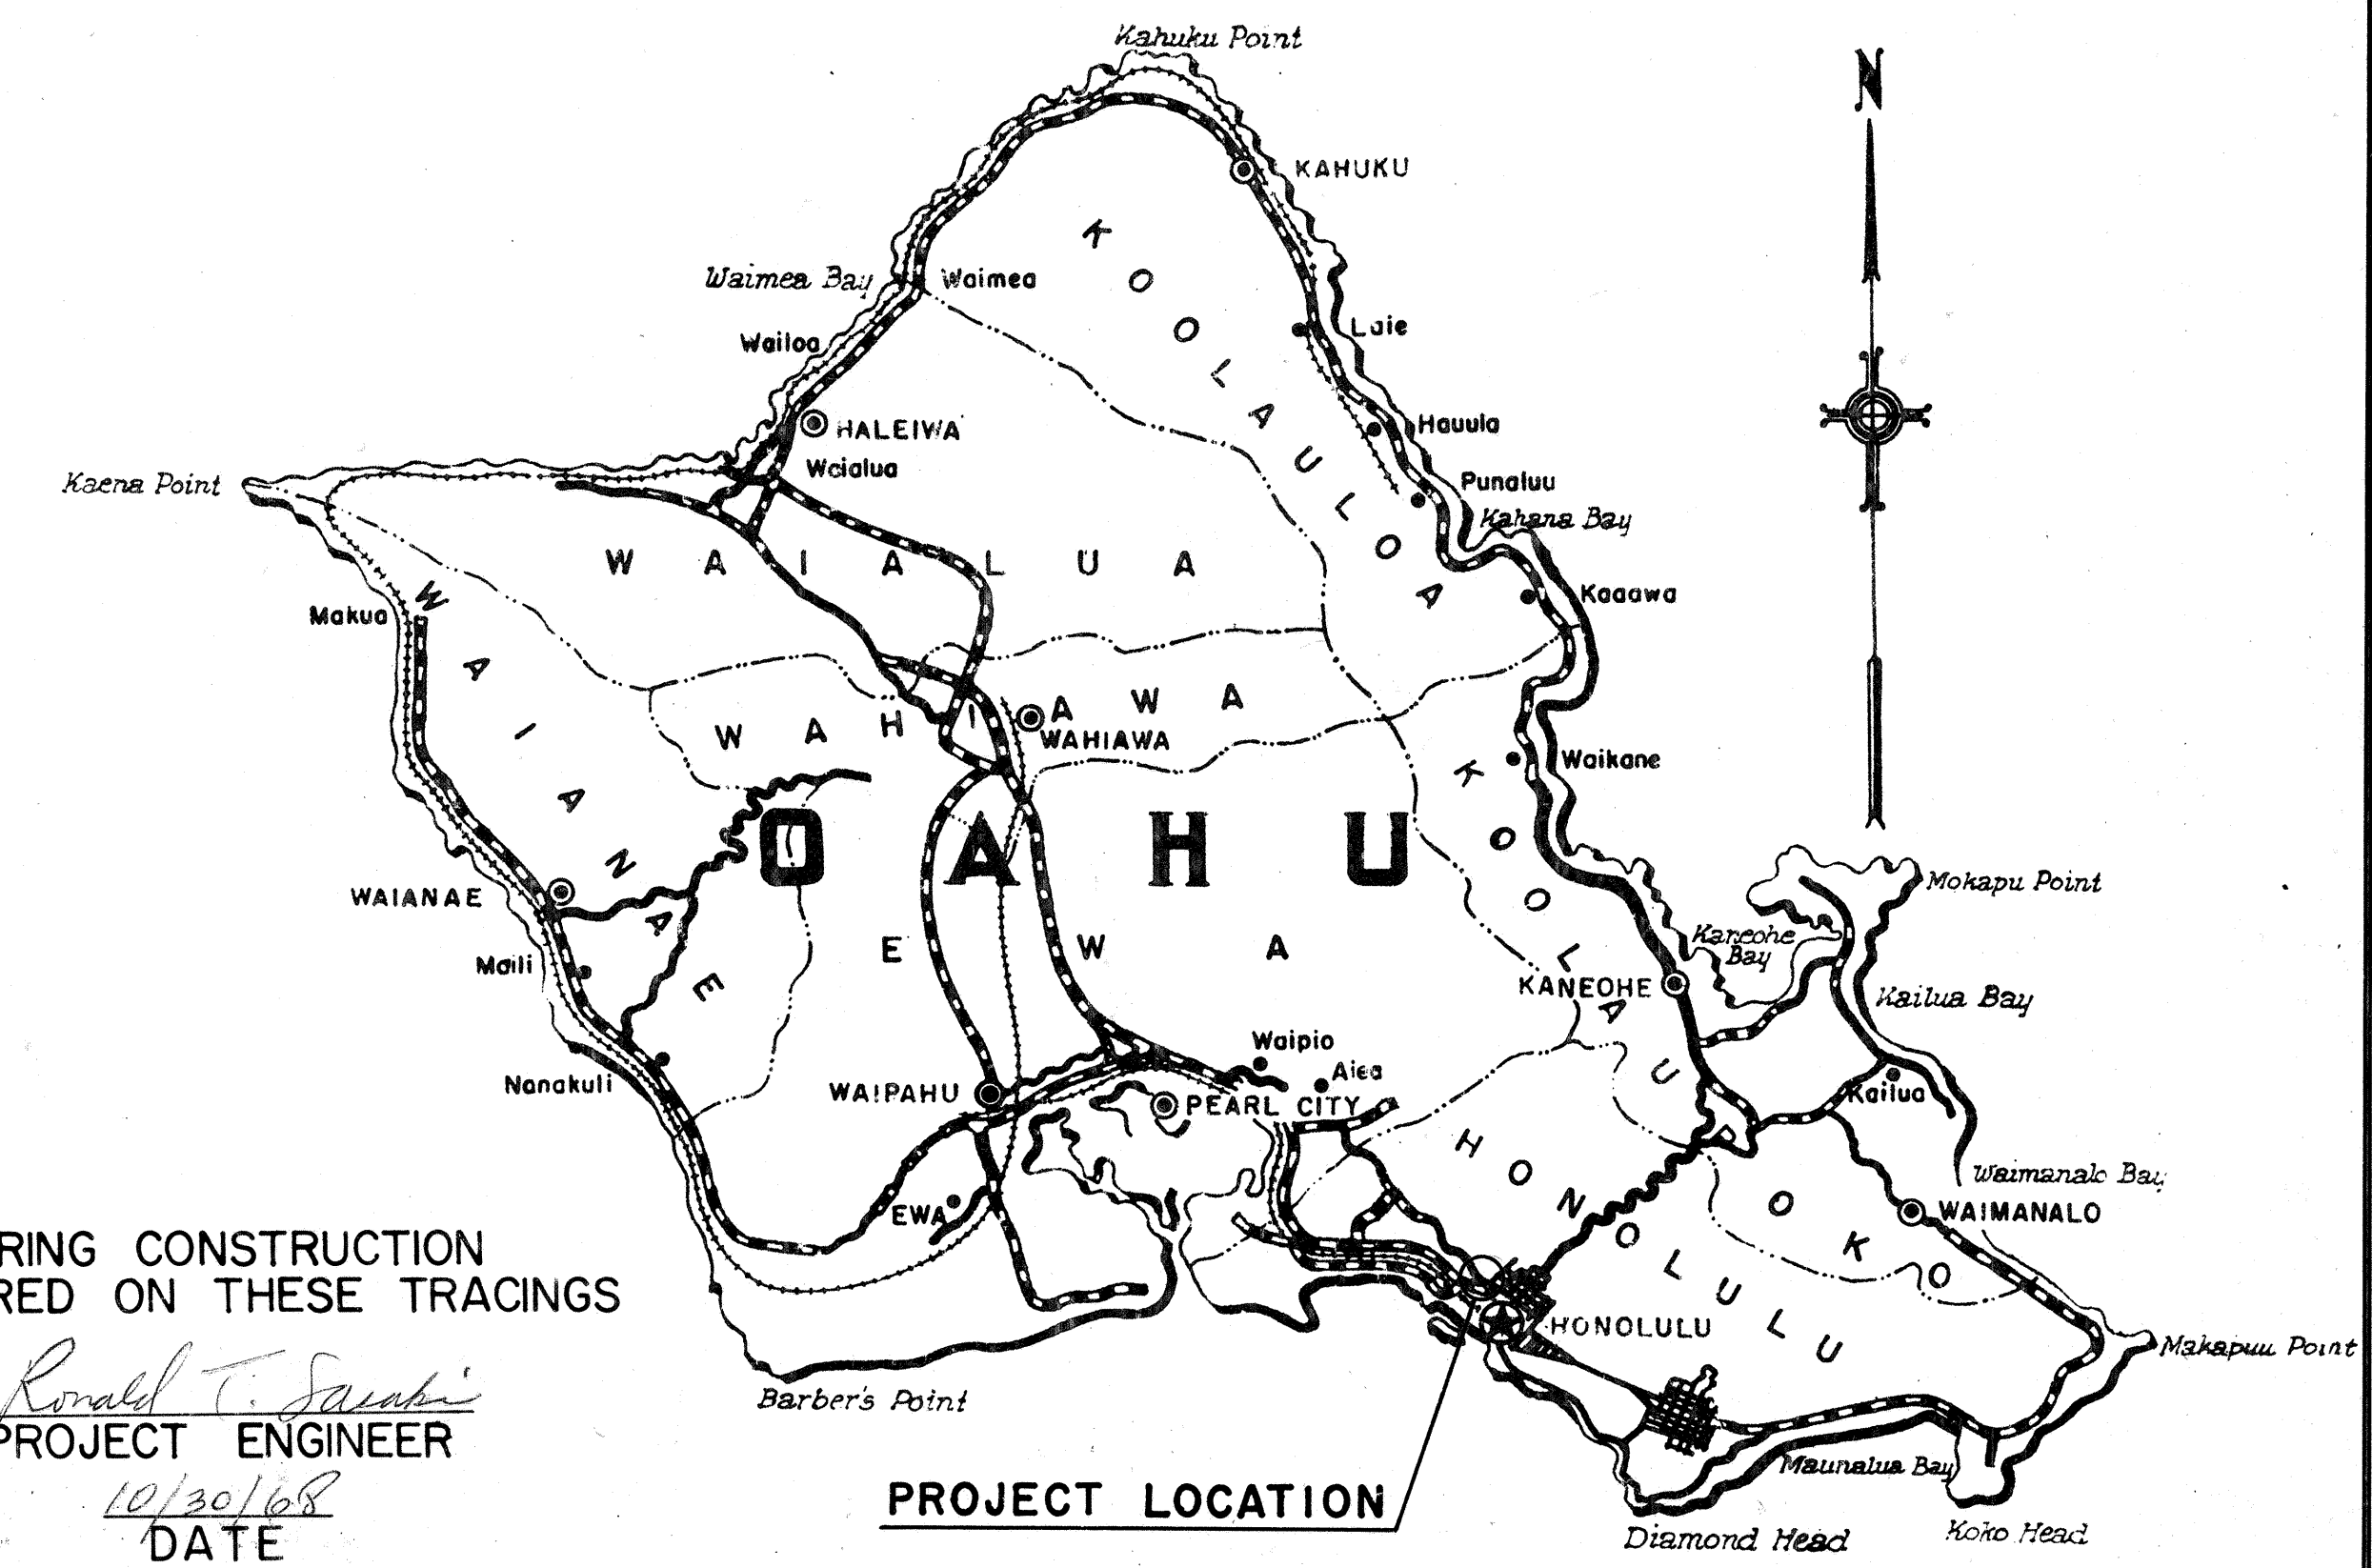

Federal Aid Projects Previously Constructed Or Under Construction

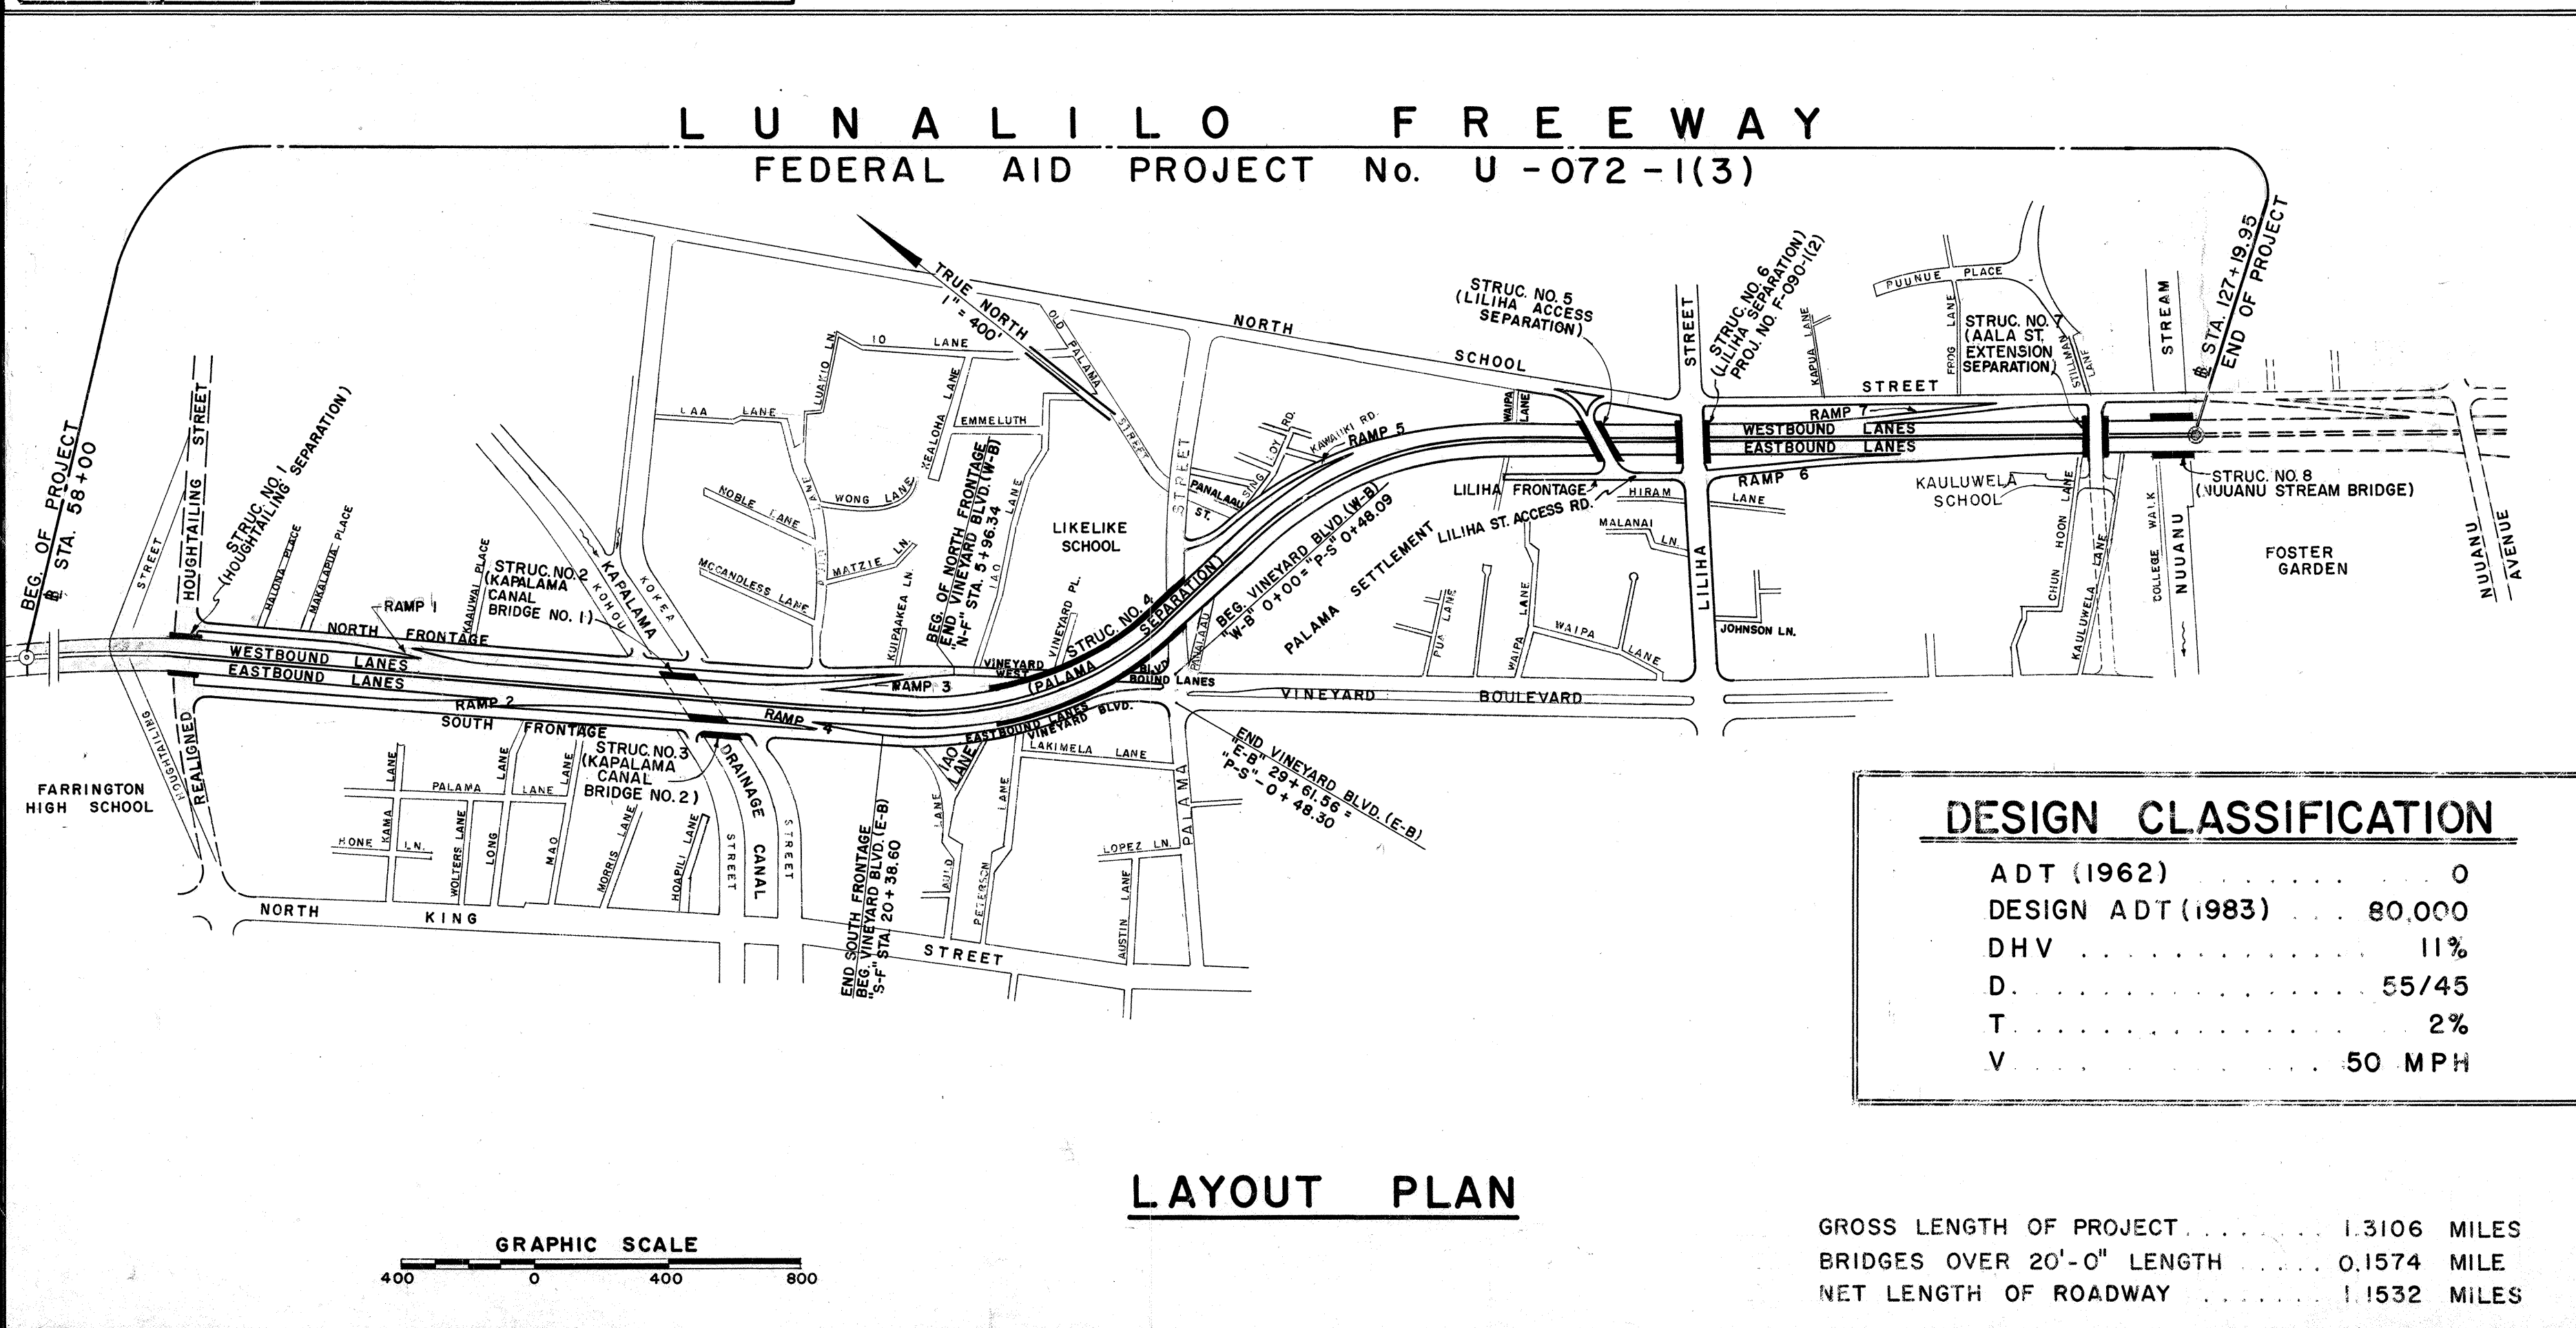

BELT, COLLINS & ASSOCIATES, LTD.
Civil and Structural Engineers

• ASSOCIATES •

- MOFFATT, NICHOL & TAYLOR - Structural Engineers
- WALTER P. THOMPSON - Surveyor
- PAUL R. WEISSICH - Landscape Architect
- WYNN NAKAMURA - Electrical Engineer

APPROVED: DATE 4/18/63
Leio Hatanaka
DIRECTOR OF TRANSPORTATION

DEPARTMENT OF COMMERCE
BUREAU OF PUBLIC ROADS
APPROVED:
DIVISION ENGINEER DATE

U 0 7 2 1 0 3 0 0 . 1