



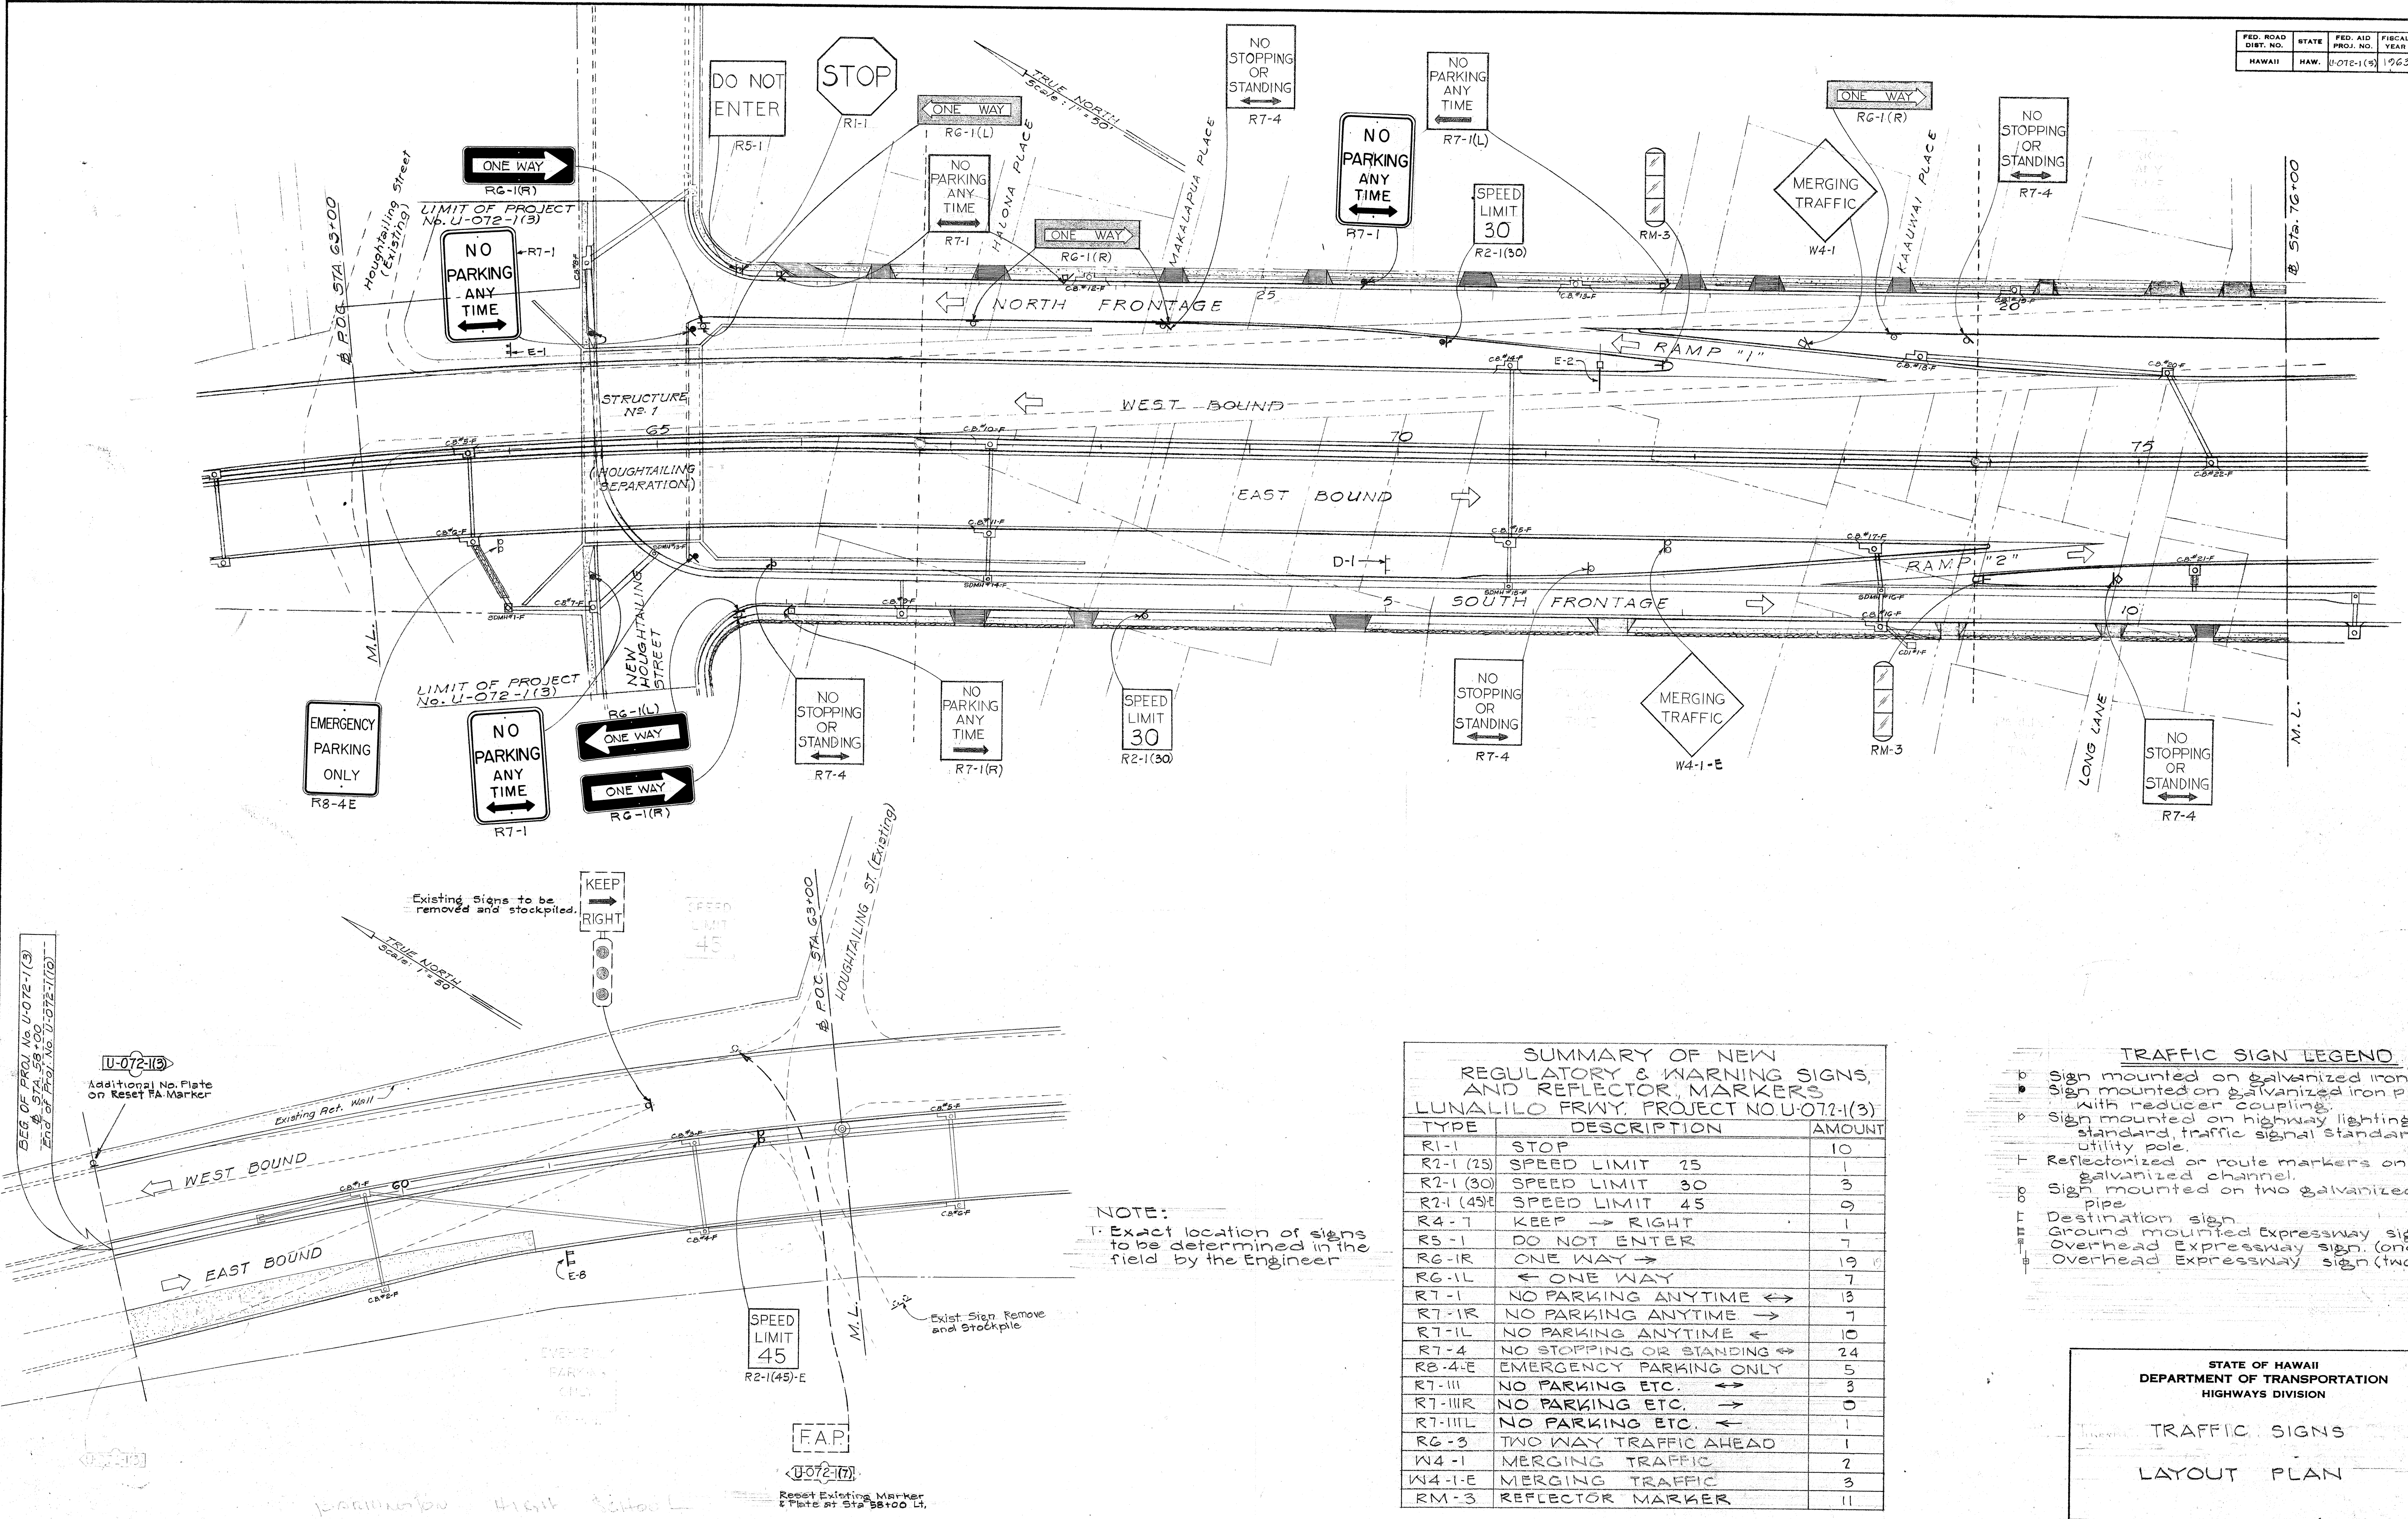

FED. ROAD DIST. NO.	STATE	FED. AID PROJ. NO.	FISCAL YEAR	SHEET NO.	TOTAL SHEETS
HAWAII	HAW.	U-072-1(3)	1963	142	246
		U-098-1(4)	1963	64	88

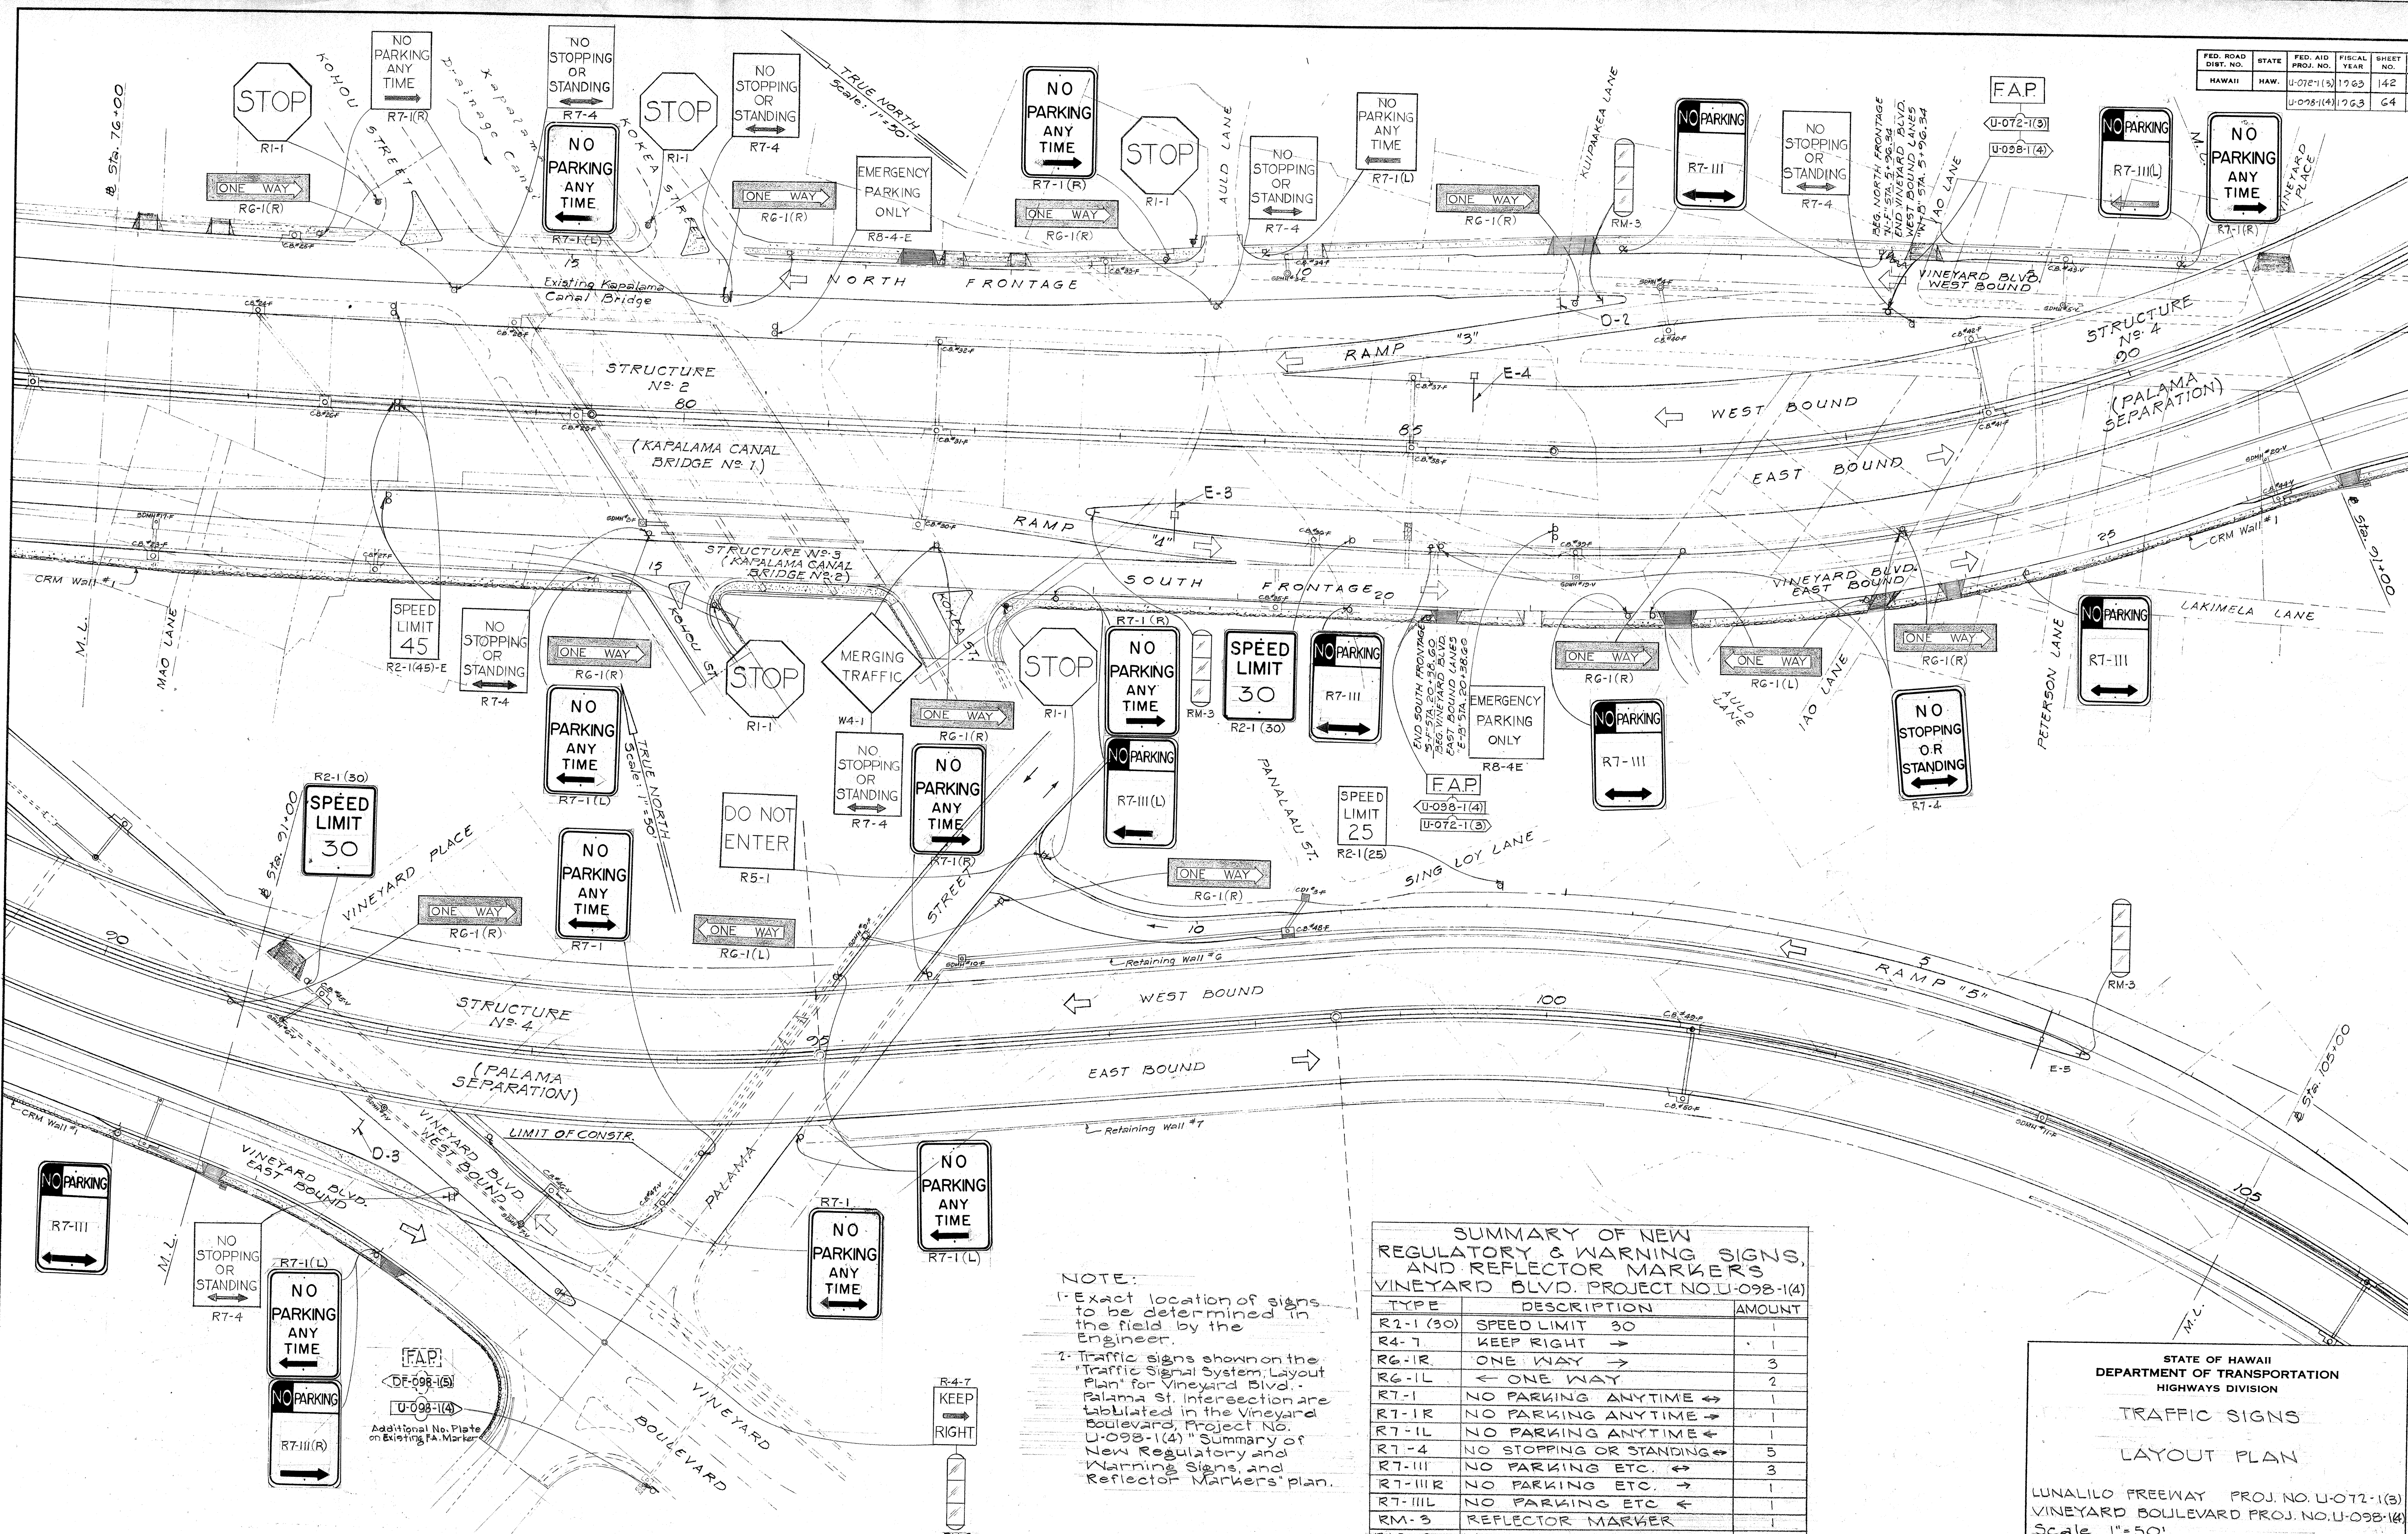

NOTE:
 1- Exact location of signs to be determined in the field by the Engineer.
 2- Traffic signs shown on the "Traffic Signal System Layout Plan" for Vineyard Blvd. - Palama St. Intersection are tabulated in the Vineyard Boulevard, Project No. U-098-1(4) "Summary of New Regulatory and Warning Signs, and Reflector Markers" plan.

SUMMARY OF NEW REGULATORY & WARNING SIGNS, AND REFLECTOR MARKERS, VINEYARD BLVD. PROJECT NO. U-098-1(4)		
TYPE	DESCRIPTION	AMOUNT
R2-1 (30)	SPEED LIMIT 30	1
R4-7	KEEP RIGHT	1
RG-1R	ONE WAY →	3
RG-1L	← ONE WAY	2
R7-1	NO PARKING ANYTIME ↔	1
R7-1R	NO PARKING ANYTIME →	1
R7-1L	NO PARKING ANYTIME ←	1
R7-4	NO STOPPING OR STANDING ↔	5
R7-III	NO PARKING ETC. ↔	3
R7-III R	NO PARKING ETC. →	1
R7-III L	NO PARKING ETC. ←	1
RM-3	REFLECTOR MARKER	1
R16-2	MOVE ONLY IN DIRECTION ETC.	2

STATE OF HAWAII
 DEPARTMENT OF TRANSPORTATION
 HIGHWAYS DIVISION
TRAFFIC SIGNS
LAYOUT PLAN
 LUNALILO FREEWAY PROJ. NO. U-072-1(3)
 VINEYARD BOULEVARD PROJ. NO. U-098-1(4)
 Scale, 1"=50'

ORIGINAL PLAN	SURVEY PLOTTED BY	DATE
NOTE BOOK	DRAWN BY	
	TRACED BY	
	DESIGNED BY	
	QUANTITIES BY	
No.	CHECKED BY	

