


FED. ROAD DIST. NO.	STATE	FED. AID PROJ. NO.	FISCAL YEAR	SHEET NO.	TOTAL SHEETS
HAWAII	HAW.	I-HI-1(4)	1963	134	217

PLAN	DATE	BY	DATE	BY
SURVEYED				
NOTE BOOK				
ALIGNMENT CHECKED				
RT. OF WAY CHECKED				
NO.				

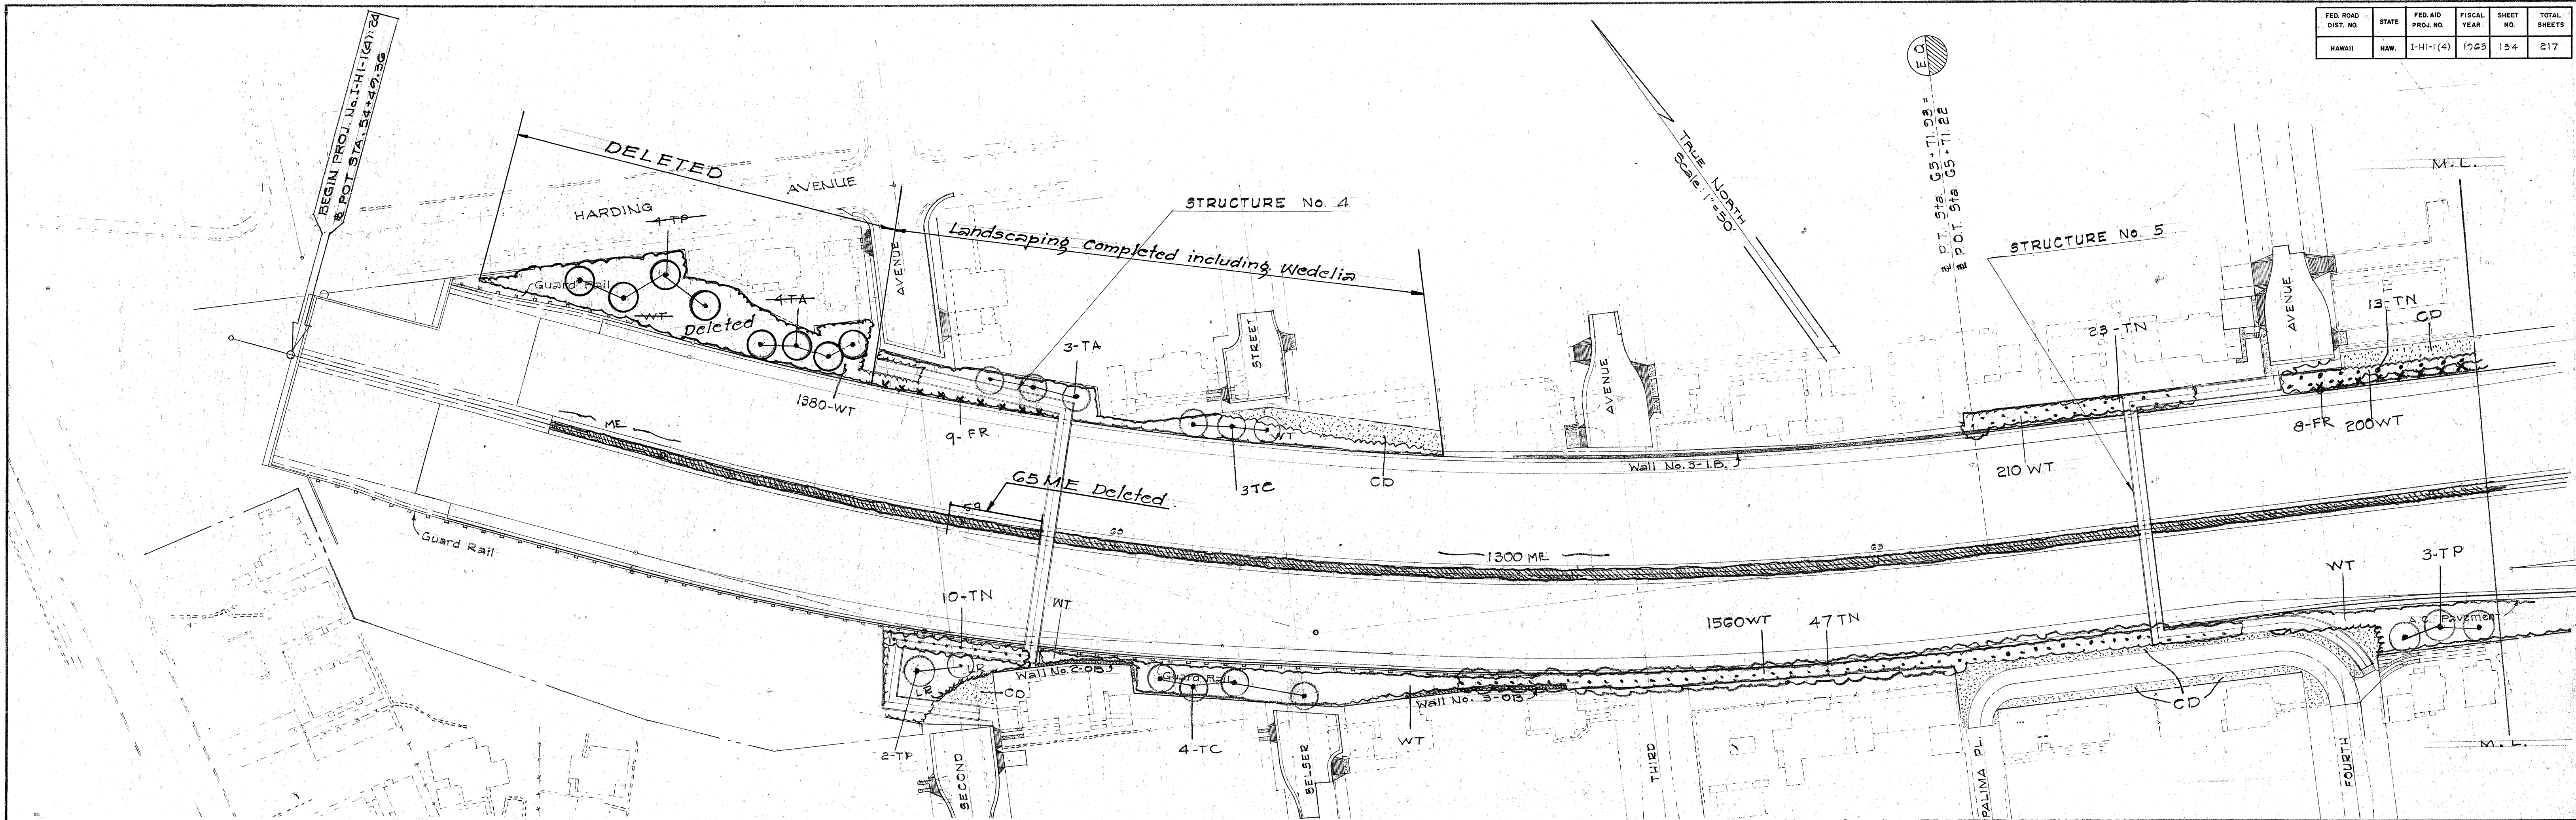

TOTAL PLANT LIST (PROJECT NO. I-HI-1(4):24)

KEY	BOTANICAL NAME	COMMON NAME	QUANT.	SPECIFICATIONS
BB	BAUHINIA BINATA	ALIBANGBANG	10	5-GAL. CAN - 5'-6" TALL - PLANT AS INDICATED - STAKE.
FR	FICUS REPENS	CREeping FIG	117	1-GAL. CAN - 10" RUNNER - PLANT AT BASE OF ROCK CUT.
HR	HIBISCUS ROSA-SINENSIS	RED HEDGE HIBISCUS	148	1-GAL. CAN - 2' TALL - PLANT 5' APART OR O.C.
HP	HIBISCUS (HYBRID)	DEEP PINK BUTTERFLY HIBISCUS	162	1-GAL. CAN - 2' TALL - PLANT 5' APART OR O.C.
HY	HIBISCUS (HYBRID)	COMMON YELLOW HIBISCUS	102	1-GAL. CAN - 2' TALL - PLANT 5' APART OR O.C.
LR	LIPPIDIA REPENS	CREeping LIPPIDIA	3810	8" CUTTINGS - PLANT 1' O.C. AS A GROUND COVER.
ML	MELALEUCA LEUCADENDRON	PAPER-BARK TREE	22	5-GAL. CAN - 6' TALL - PLANT AS INDICATED - STAKE.
ME	MURRAYA EXOTICA	MOCKORANGE	4850	15" TALL - PLANT 2' APART - DOUBLE ROW - STAGGER.
NO	NERIUM OLEANDER	SINGLE WHITE OLEANDER	336	1-GAL. CAN - 2' TALL - PLANT 5' APART OR O.C.
NS	NERIUM OLEANDER F.	SINGLE LIGHT-PINK OLEANDER	125	1-GAL. CAN - 2' TALL - PLANT 5' APART OR O.C.
TA	TABERBUA ARGENTIA	YELLOW TECOMA	7	5-GAL. CAN - 4'-6" TALL - PLANT AS INDICATED - STAKE.
TC	TABERBUA CHRYSANTHA	YELLOW-FLOWERING TABERBUA	14	5-GAL. CAN - 4'-6" TALL - PLANT AS INDICATED - STAKE.
TP	TABERBUA PENTAPHYLLA	PINK TECOMA	9	5-GAL. CAN - 4'-6" TALL - PLANT AS INDICATED - STAKE.
TN	THEVETIA NERIFOLIA	BE-STILL-TREE	163	1-GAL. CAN - 2' TALL - PLANT 8' APART.
WT	WEDELIA TRILOBATA	WEDELIA	11,674	10" RUNNERS - 6" CAN - PLANT 36" O.C. AS GROUND COVER.
CD	CYNODON DACTYLON	BERMUDA GRASS	\$ 33,033	SEE STANDARD SPECIFICATIONS

PLANT LIST (THIS SHEET - STA 55+50 - 63+00)

KEY	BOTANICAL NAME	COMMON NAME	QUANT.
FR	FICUS REPENS	CREeping FIG	117
LR	LIPPIDIA REPENS	CREeping LIPPIDIA	\$ 3810
ME	MURRAYA EXOTICA	MOCKORANGE	1300
TA	TABERBUA ARGENTIA	YELLOW TECOMA	7
TC	TABERBUA CHRYSANTHA	YELLOW-FLOWERING TABERBUA	7
TP	TABERBUA PENTAPHYLLA	PINK TECOMA	9
TN	THEVETIA NERIFOLIA	BE-STILL-TREE	23
WT	WEDELIA TRILOBATA	WEDELIA	3350
CD	CYNODON DACTYLON	BERMUDA GRASS	\$ 10,372

NOTE Quantities for Bermuda Grass (CD) includes area of sodding at 2nd Ave., Belser St., 3rd Ave. and 4th Ave. Cul-de-Sac. For Detail Plan of Cul-de-Sac See Plan Sheet Nos. 19 and 20.

STATE OF HAWAII
DEPARTMENT OF TRANSPORTATION

LANDSCAPE PLAN

LUNALILO FREEWAY

PROJ. NO. I-HI-1(4):24

MANSFIELD P. CLAFLIN
LANDSCAPE ARCH. A.S.L.A.
HONOLULU

PLAN	SURVEYED	BY	DATE
NOTE BOOK	PLOTTED		
NO.	ALIGNMENT CHECKED		
	RT. OF WAY CHECKED		




NOTE: Quantities for Bermuda Grass (CD) includes areas of sodding at 8th Ave. and 9th Ave. Cul-de-Sacs and on portions of 10th Avenue Widening. For detail plan of Cul-de-Sacs and 10th Avenue see Plan Sheet Nos. 25, 26 and 27.

PROJ. NO. I-HI-1 (4):24

FED. ROAD DIST. NO.	STATE	FED. AID PROJ. NO.	FISCAL YEAR	SHEET NO.	TOTAL SHEETS
HAWAII	HAW	I-HI-1 (4)	1963	137	217

PLAN	DATE	BY
DESIGNED		
PLOTTED		
NOTE BOOK		
ALIGNMENT CHECKED		
RT. OF WAY CHECKED		
NO.		

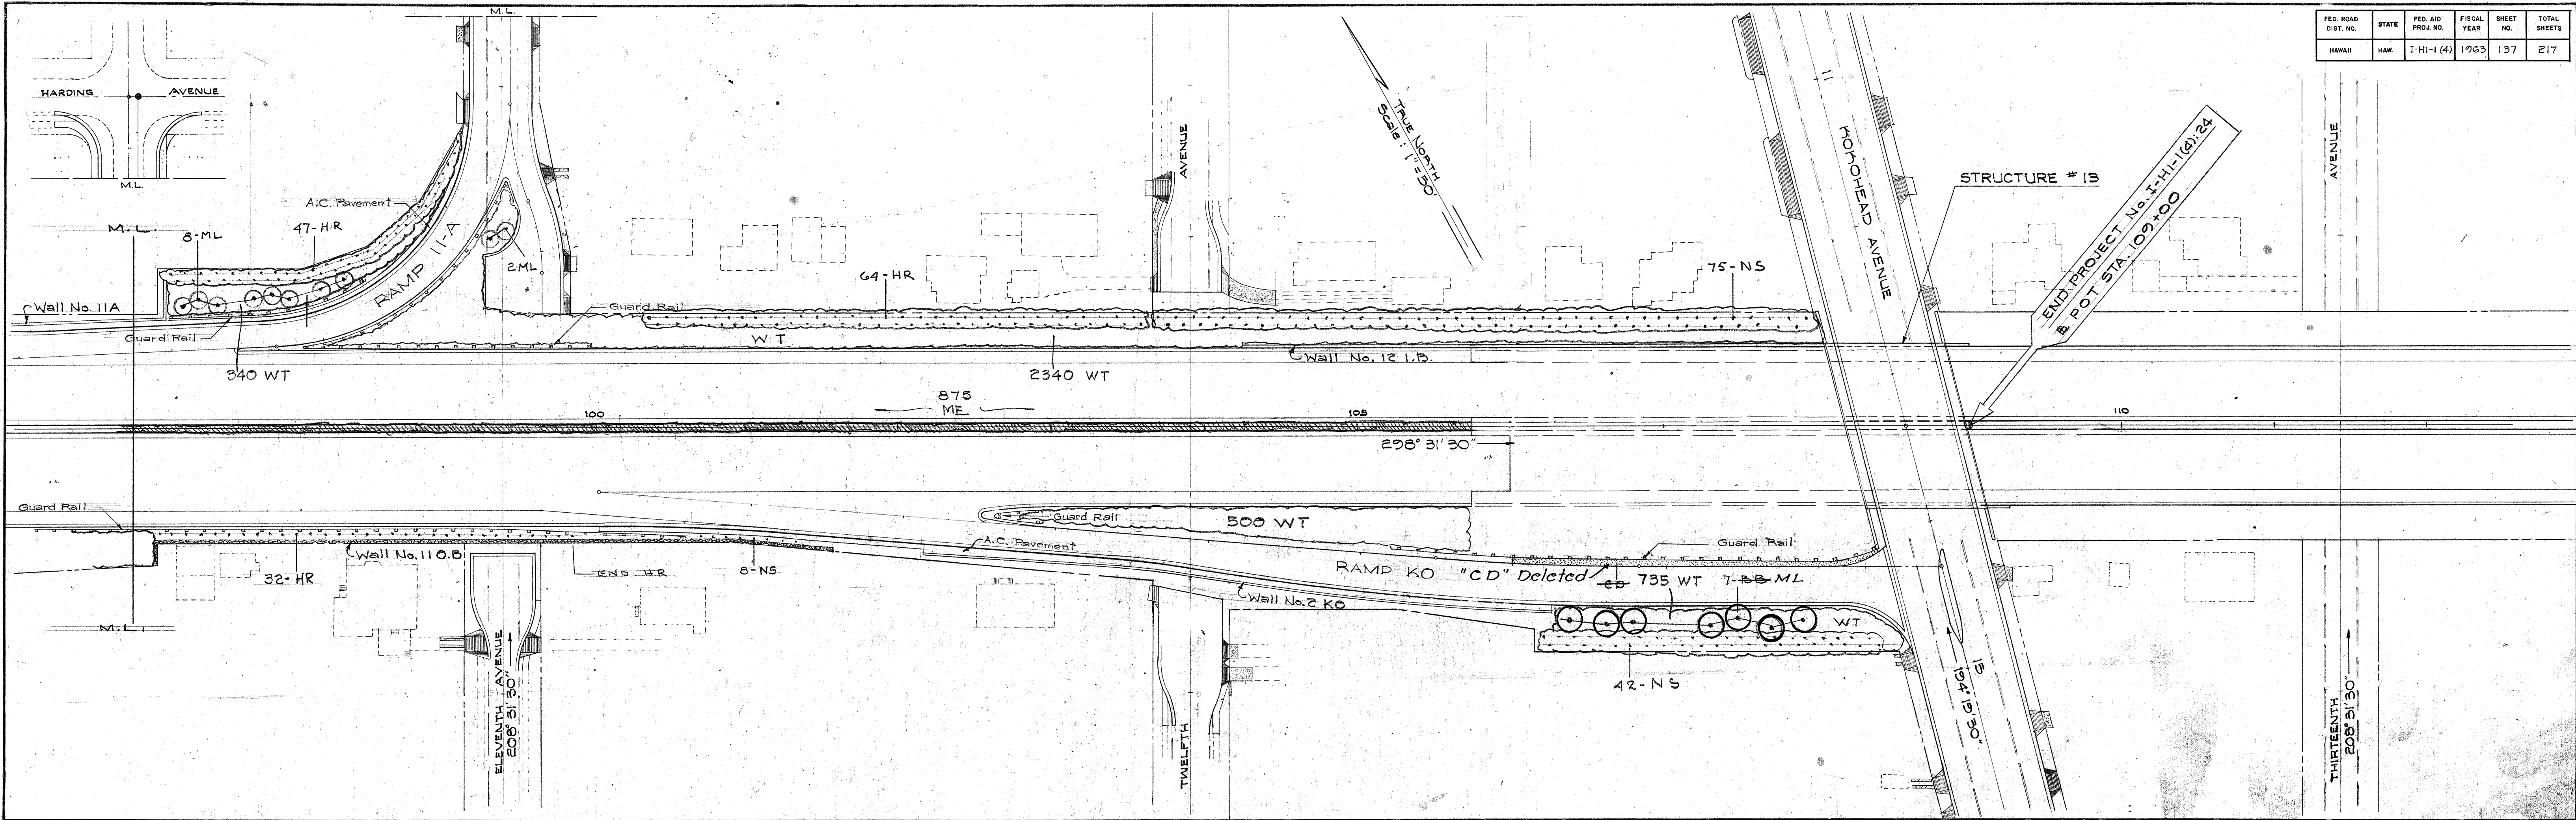

PLANT LIST (THIS SHEET)			
KEY	BOTANICAL NAME	COMMON NAME	QUANT.
B.B.	BAUHINIA PINATA	LIHONGRANG	7
HR	HIBISCUS ROSA-SINENSIS	RED HEDGE HIBISCUS	143
ML	MELALEUCA LEUCADENDRON	PAPER-BARK TREE	10
NS	NERIUM OLEANDER FORM	SINGLE PINK OLEANDER	125
ME	MURRAYA EXOTICA	MOCKORANGE	875
WT	WEDDIA TRILOBATA	WEDDIA	3915
CD	CYNODON DACTYLON	BERMUDA GRASS	# 4752

NOTE: Quantities for Bermuda Grass (CD) includes areas of sodding at 11th Ave. and 12th Ave. Cul-de-Sacs and along Koko Head Avenue. For Detail Plan of Cul-de-Sacs and Koko Head Avenue see Plan Sheet Nos. 27.28 and 29.

MANSFIELD P. CLAFLIN
LANDSCAPE ARCH. A.S.L.A.
HONOLULU

STATE OF HAWAII
DEPARTMENT OF TRANSPORTATION



LANDSCAPE PLAN

LUNALILO FREEWAY

PROJ. NO. I-HI-1(4):24

FED. ROAD DIST. NO.	STATE	FED. AID PROJ. NO.	FISCAL YEAR	SHEET NO.	TOTAL SHEETS
HAWAII	HAW.	I-HI-1(4)	1963	138	217

PLAN	BY	DATE
SURVEYED		
NOTE BOOK		
ALIGNMENT CHECKED		
RT. OF WAY CHECKED		
NO.		

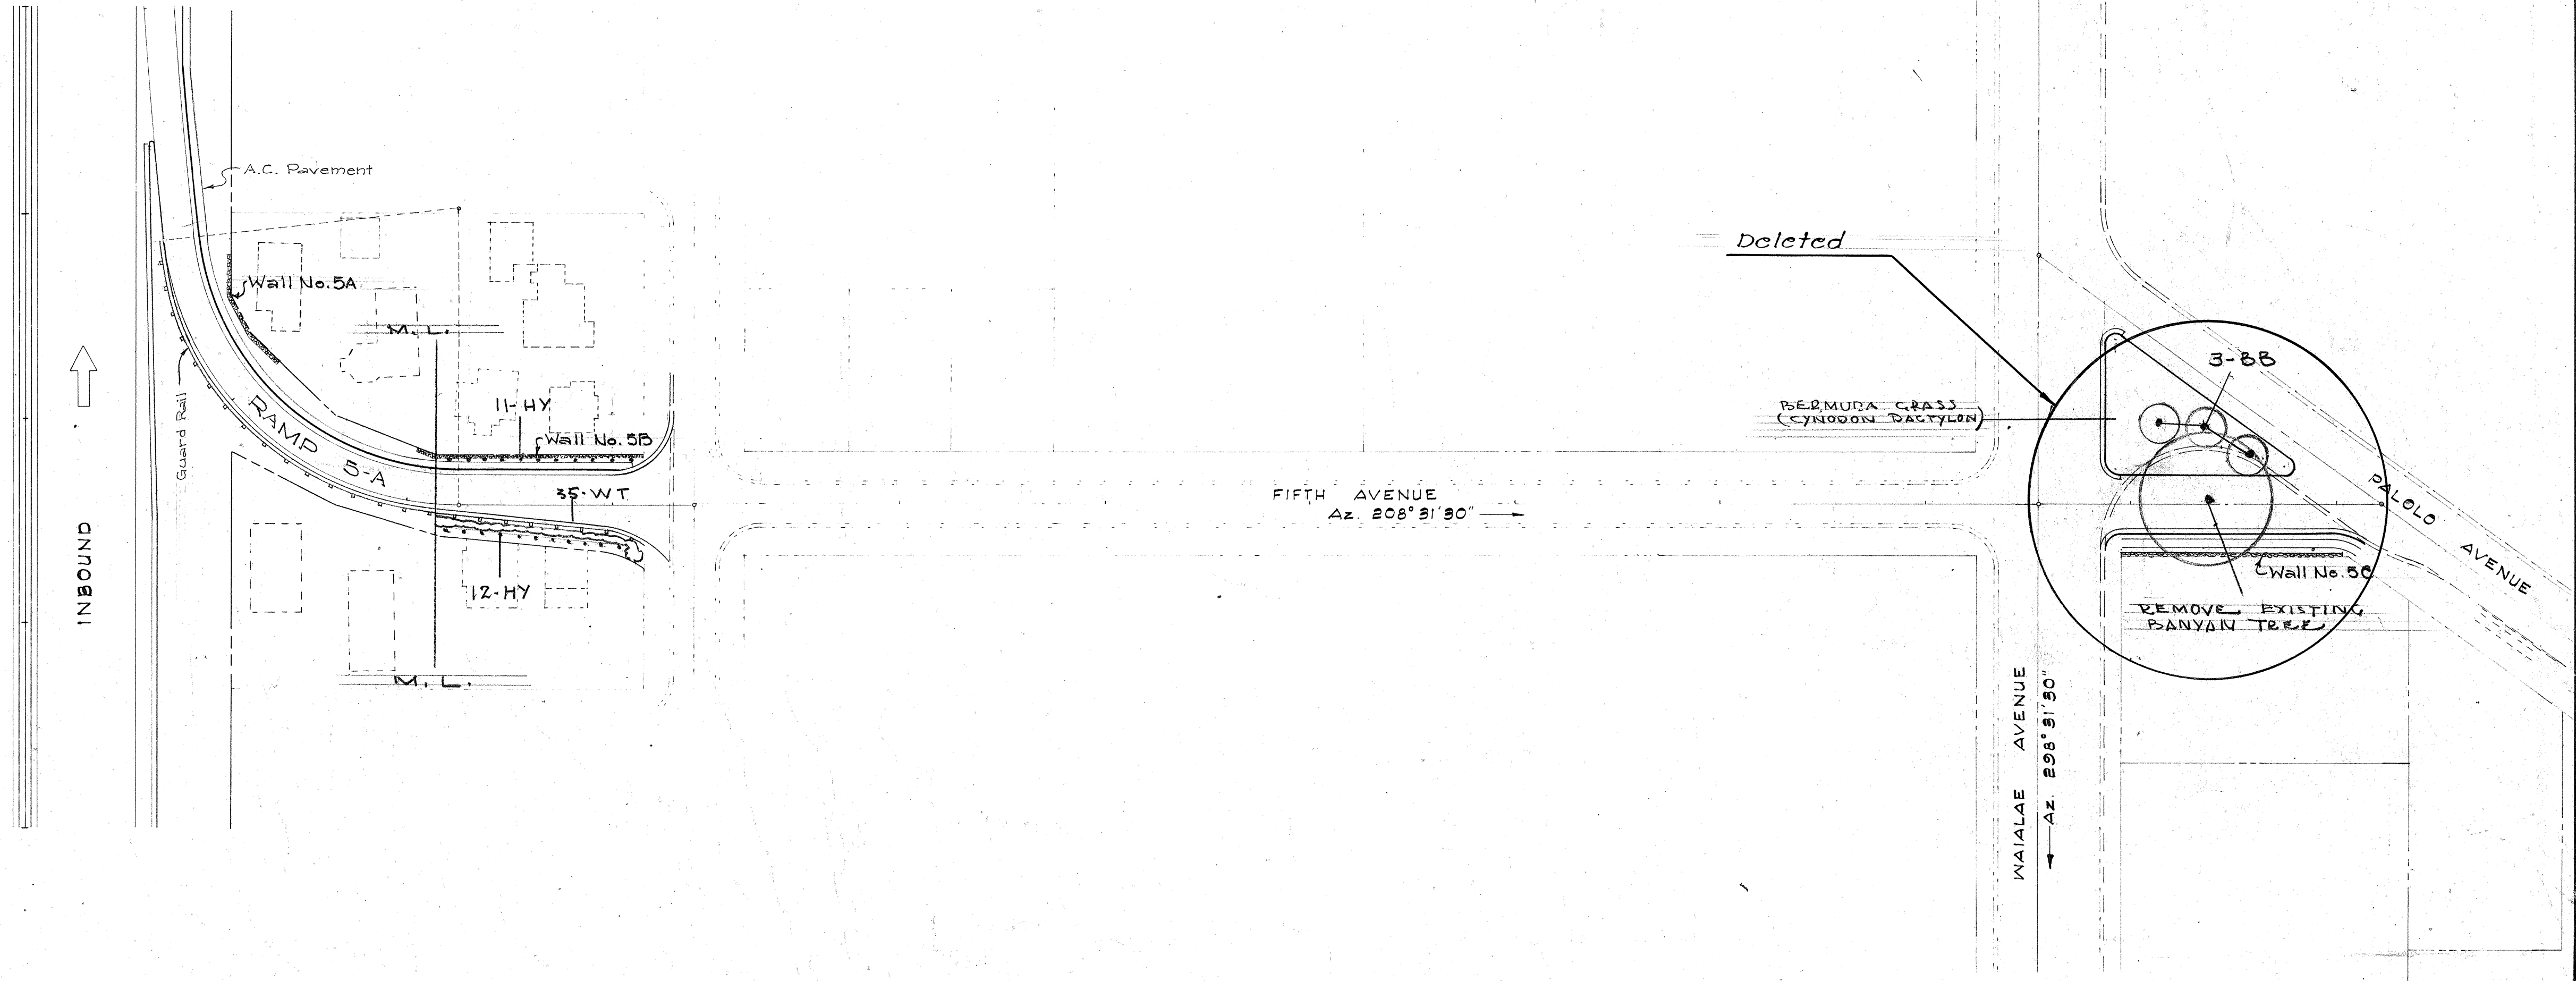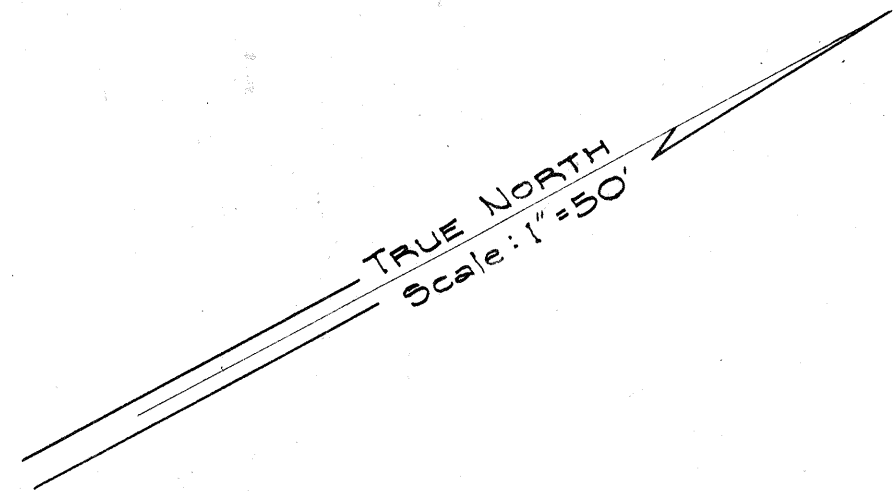

PLANT LIST (THIS SHEET)

KEY	BOTANICAL NAME	COMMON NAME	QUANT.
BB	BACHNIA PINATA	ALIBANGBANG	3
HY	HIBISCUS (HYBRID)	SINGLE YELLOW HIBISCUS	23
WT	WEDELIA TRILOBATA	WEDELIA	333
CD	CYNODON DACTYLON	BERMUDA GRASS	3,000 SF

MANSFIELD P. CLAPLIN
LANDSCAPE ARCH, AIA
HONOLULU

STATE OF HAWAII
DEPARTMENT OF TRANSPORTATION

LANDSCAPE PLAN

LUNALILO FREEWAY PROJ. NO. I-HI-1(4):24