




FED. ROAD DIST. NO.	STATE	FED. AID PROJ. NO.	FISCAL YEAR	SHEET NO.	TOTAL SHEETS
HAWAII	HAW.	I-HI-1(4)	1963	53	617

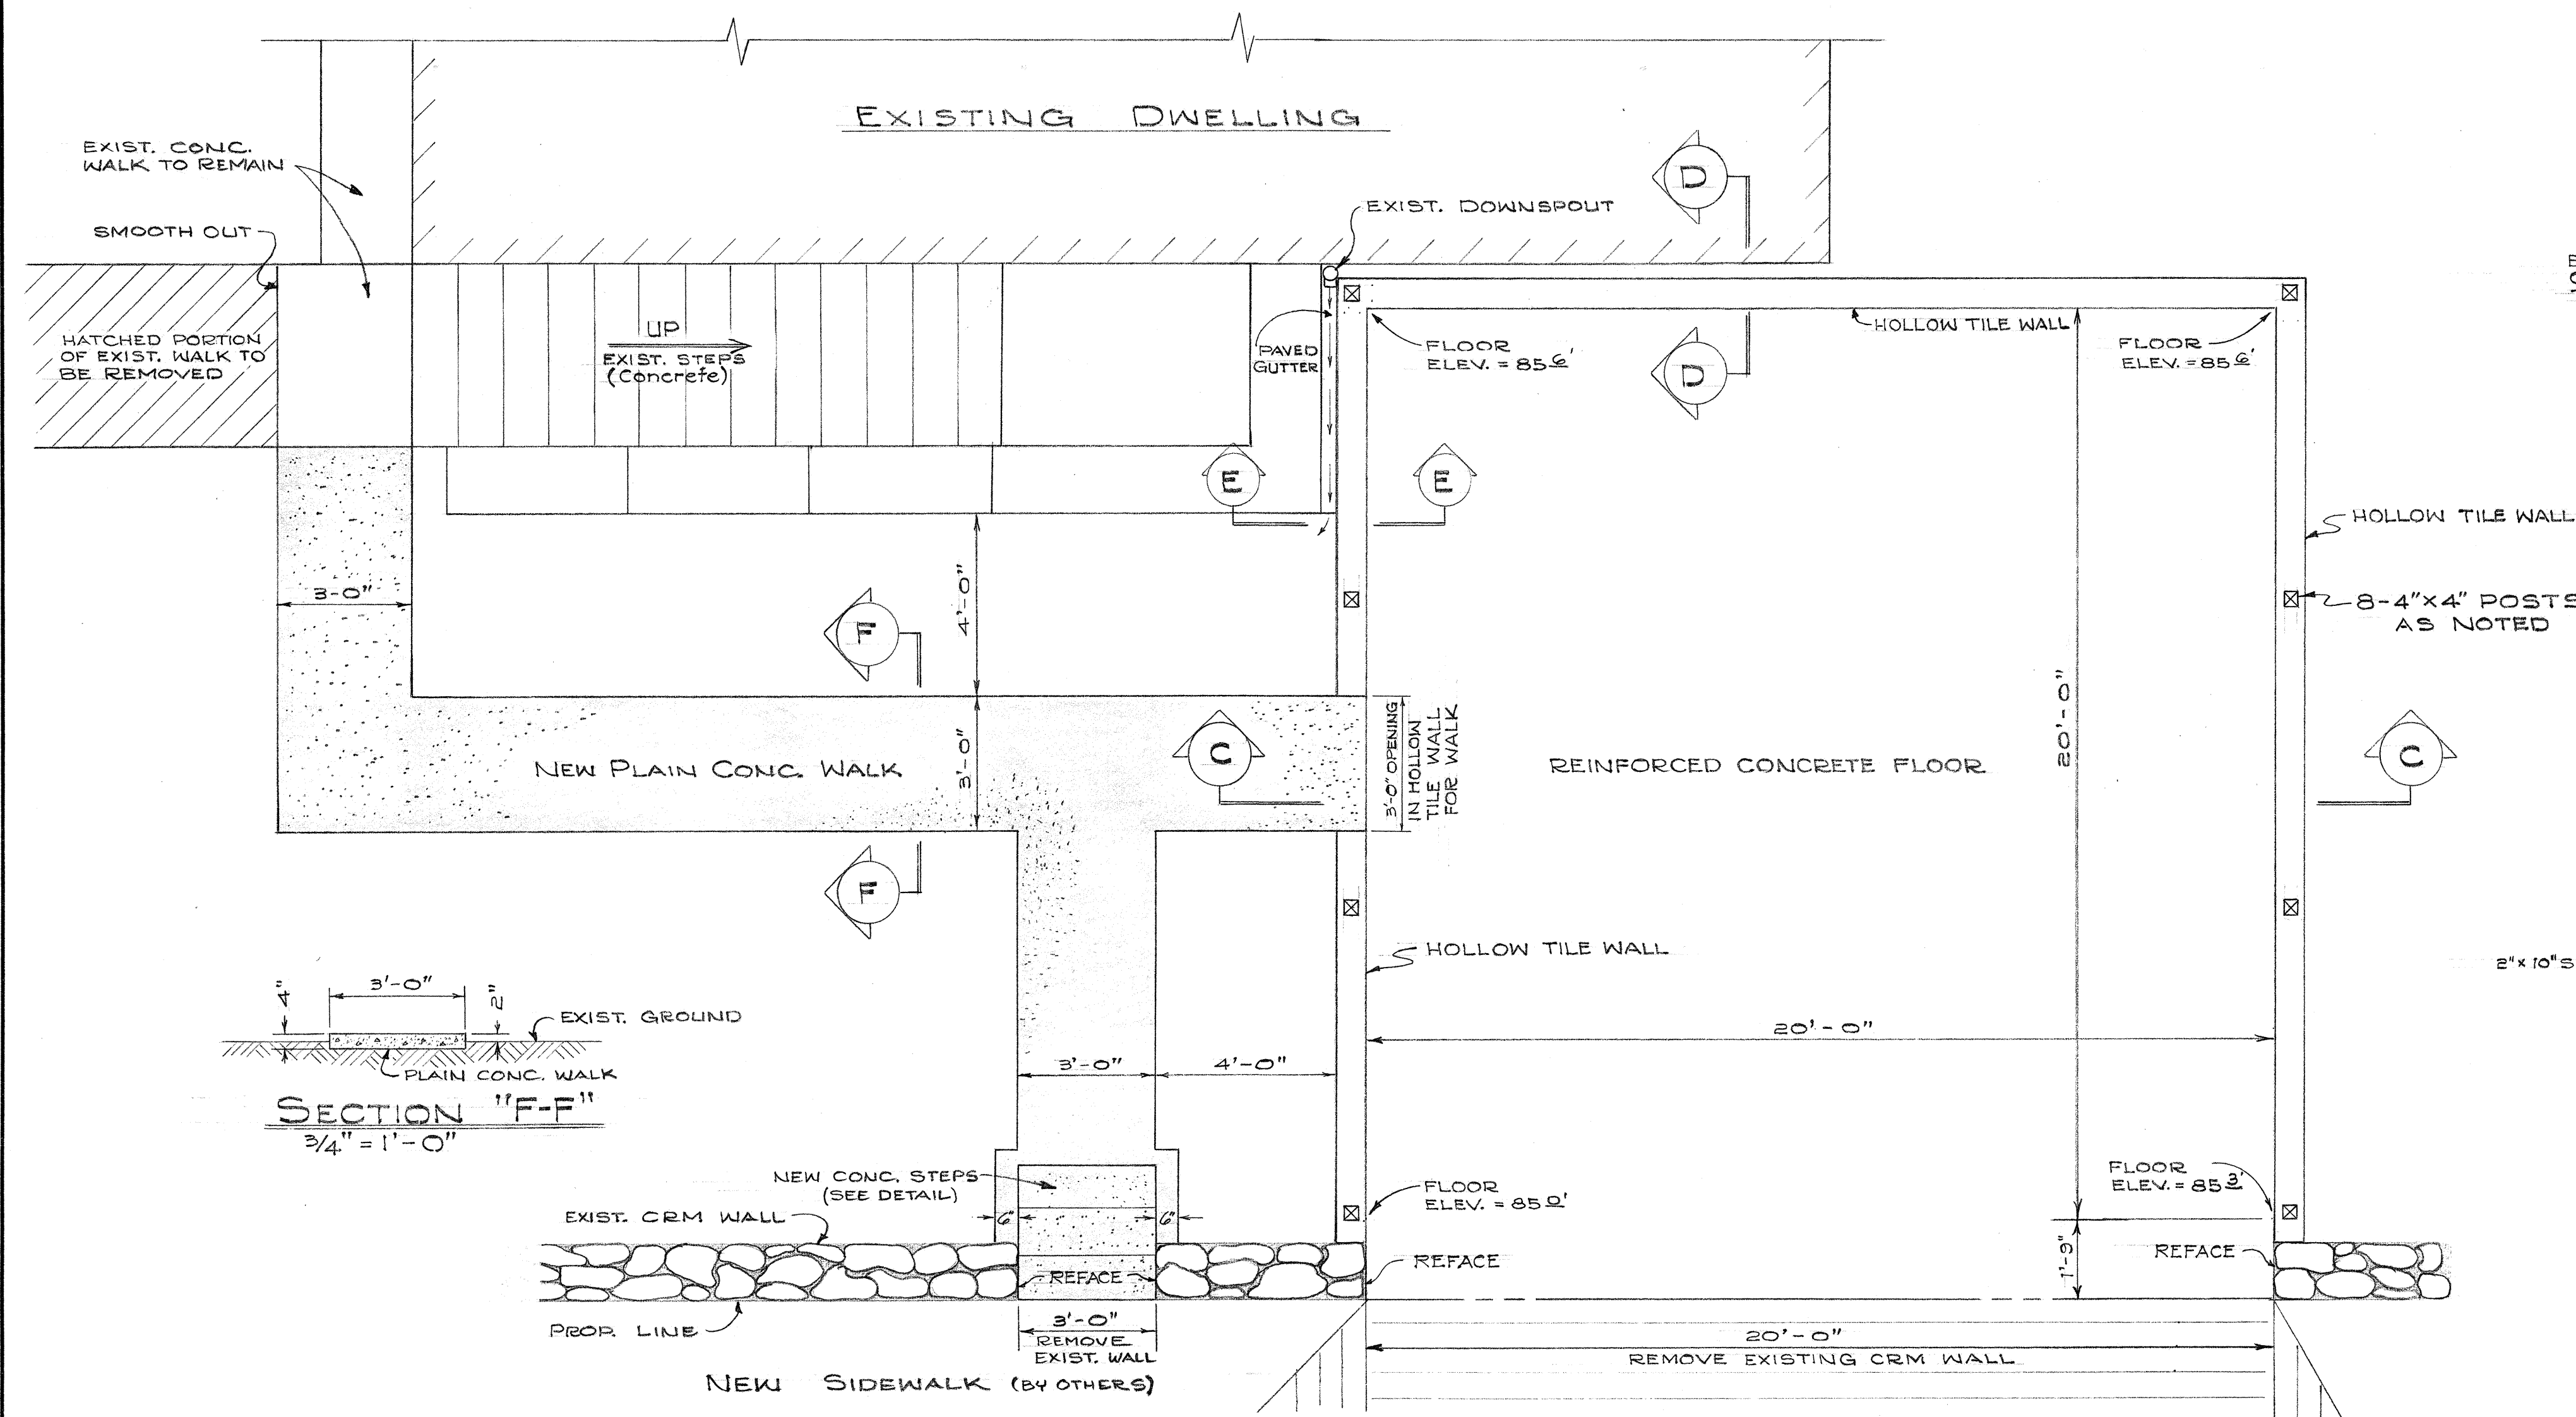

GARAGE FLOOR & NEW CONCRETE WALKWAY PLAN
3/8" = 1'-0"

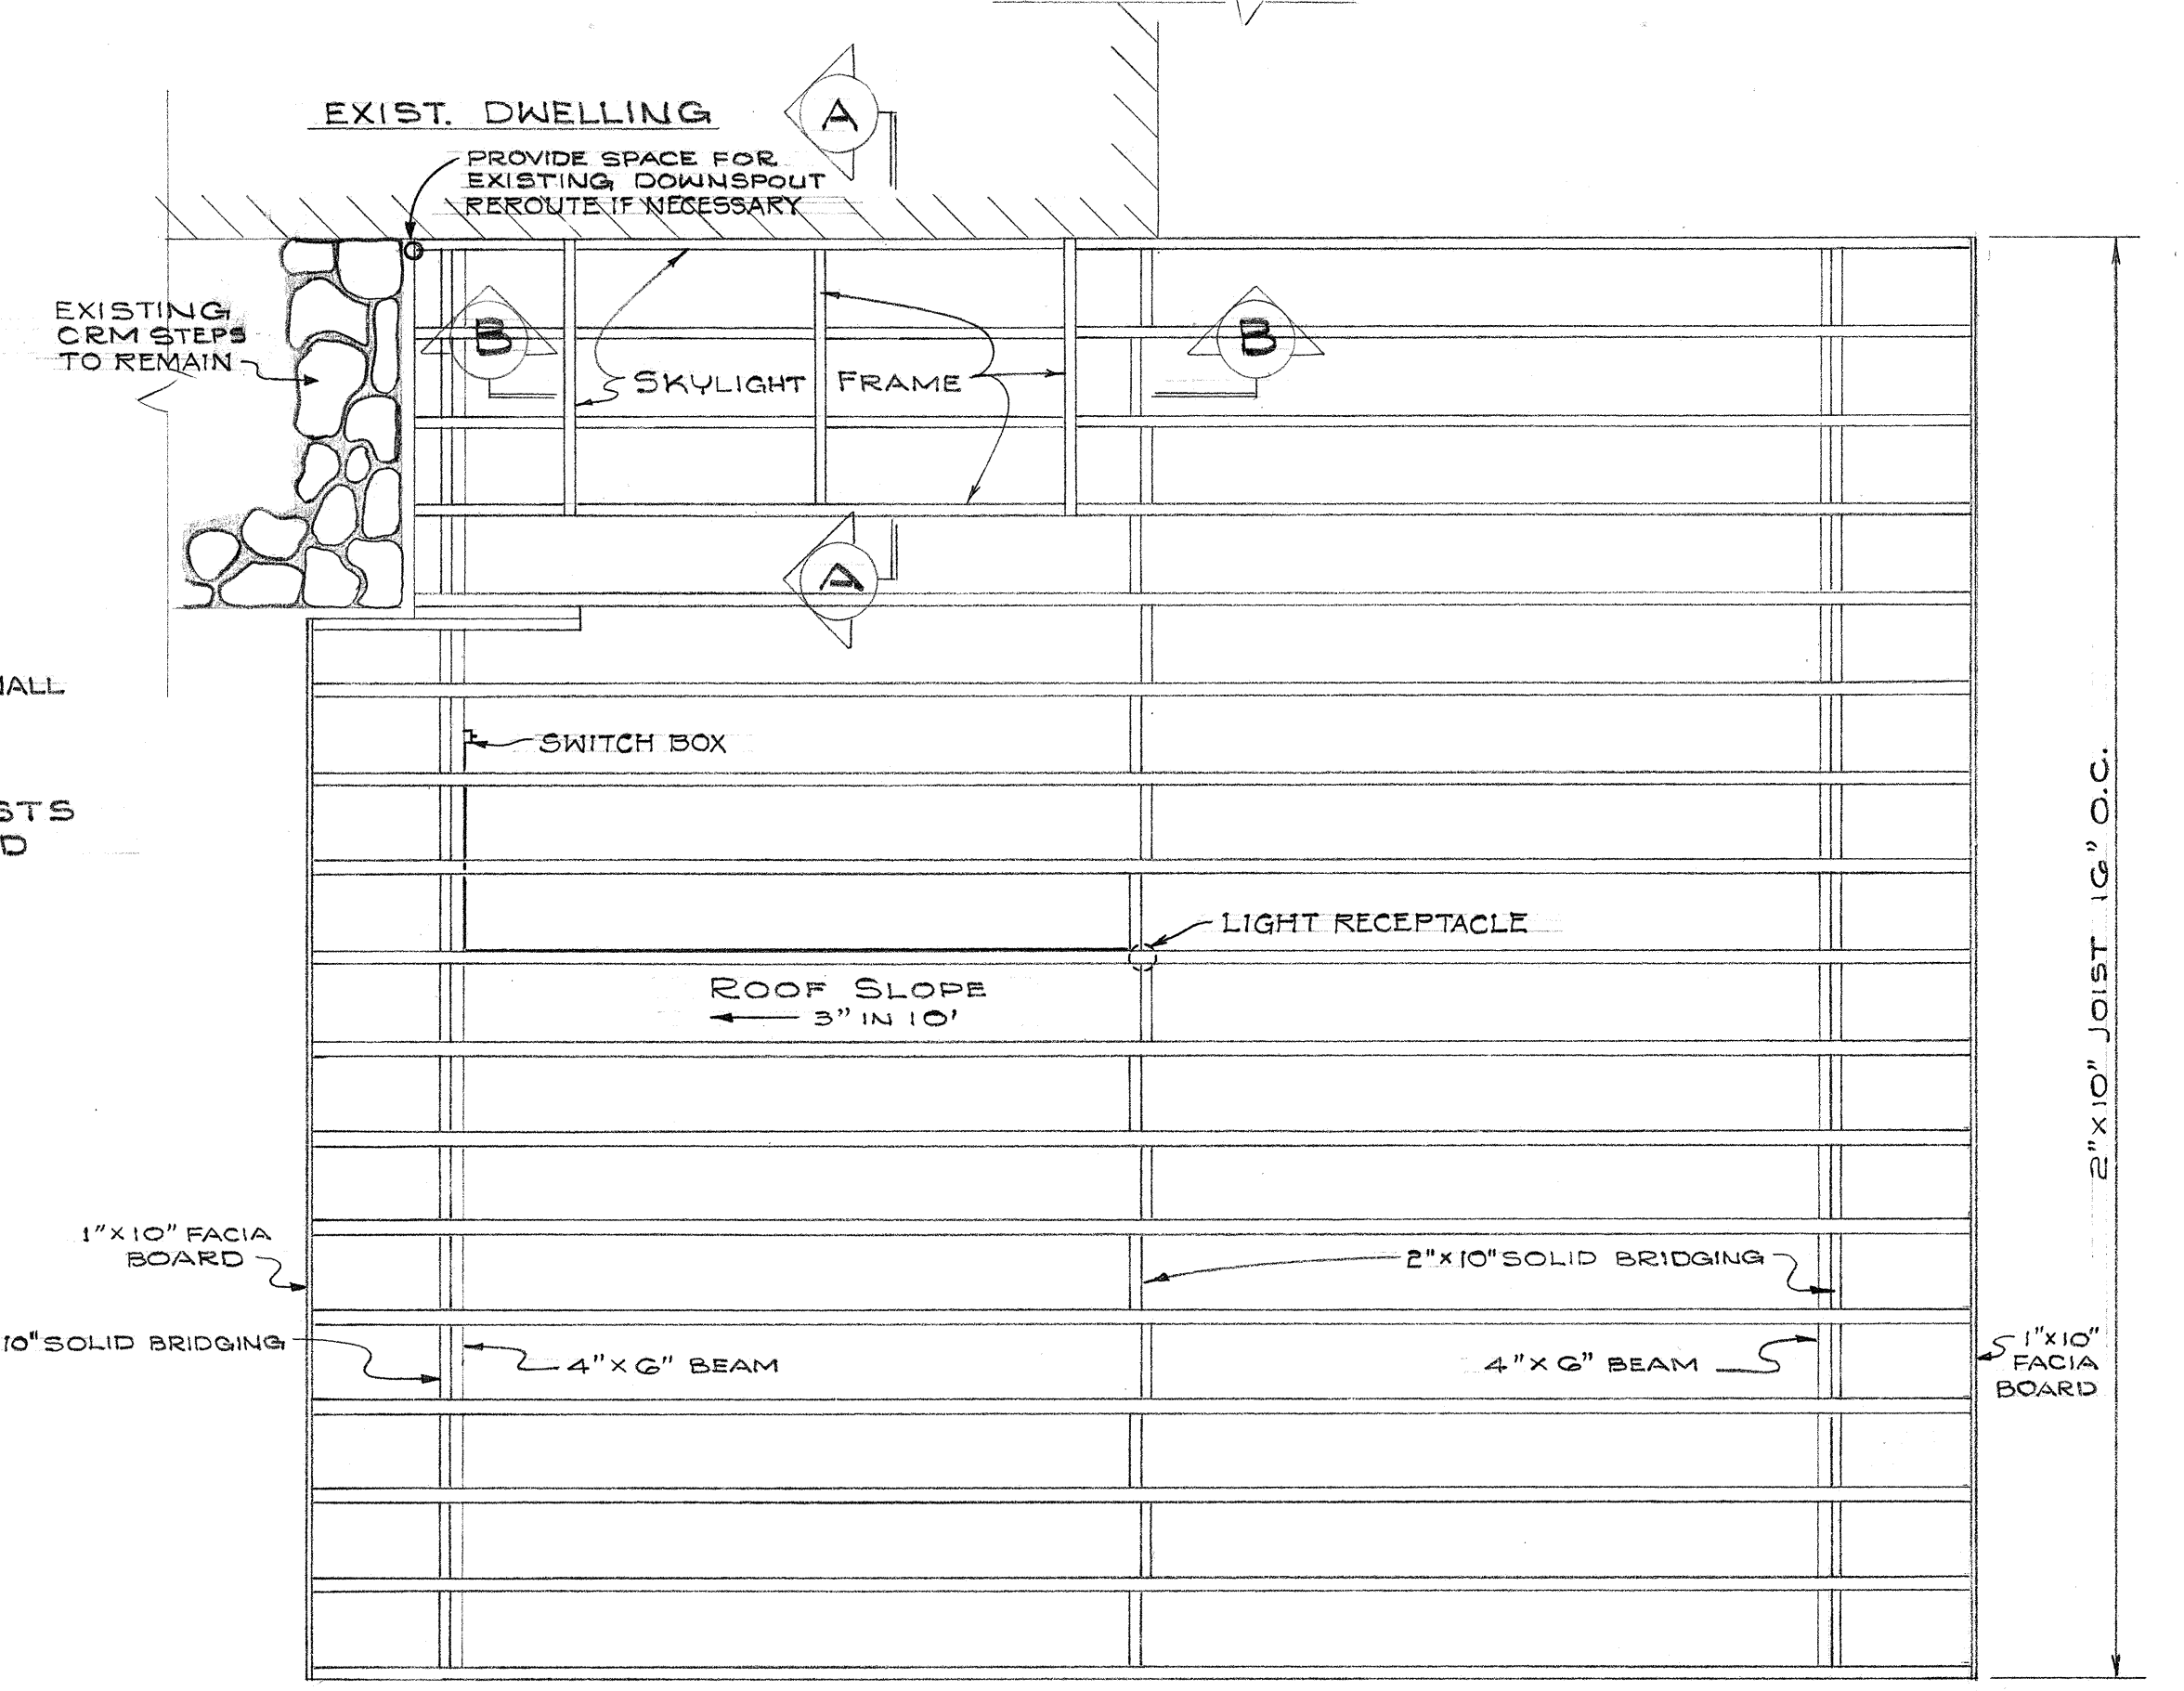

ROOF FRAMING PLAN
3/8" = 1'-0"

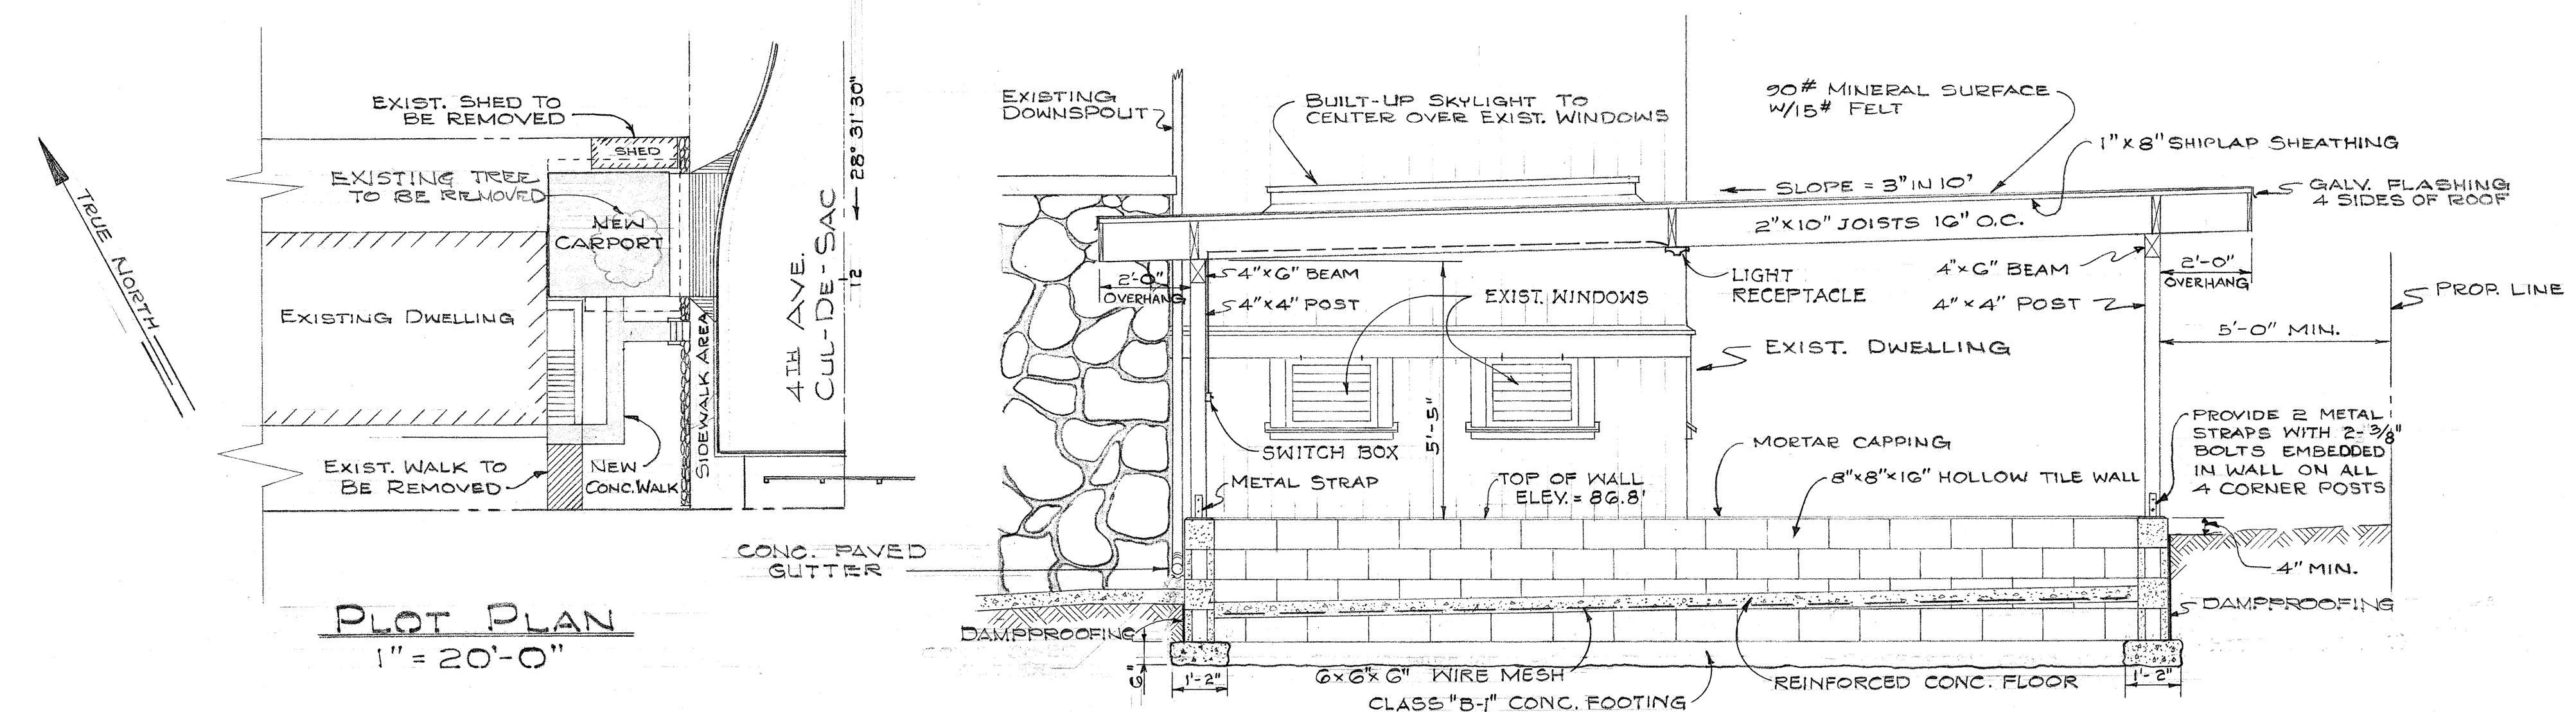

SECTION "C-C"
3/8" = 1'-0"







NOTE:
FOR SPECIFICATIONS SEE
SECTIONS 123 AND 123A
OF THE SPECIAL PROVI-
SIONS.

STATE OF HAWAII
DEPARTMENT OF TRANSPORTATION
HIGHWAYS DIVISION
CONTRACT ITEM NO. 123A
CONSTRUCTION OF CARPORT,
CONCRETE WALK AND STEPS
ON LOT TAX KEY: 3-2-10:G1
AT 1038 4TH AVE.
Mr. & Mrs. BUNG KWAI KOP et al. (OWNERS)
LUNALILO FRWY. PROJ. NO. I-HI-1(4): 24
Scale: As Shown March 1963

SHEET No. OF SHEETS

ORIGINAL PLAN	DATE
DRAWN BY	
DESIGNED BY	
NOTED BY	
CHECKED BY	


FED. ROAD DIST. NO.	STATE	FED. AID PROJ. NO.	FISCAL YEAR	SHEET NO.	TOTAL SHEETS
HAWAII	HAW.	I-HI-1(4)	1963	54	217

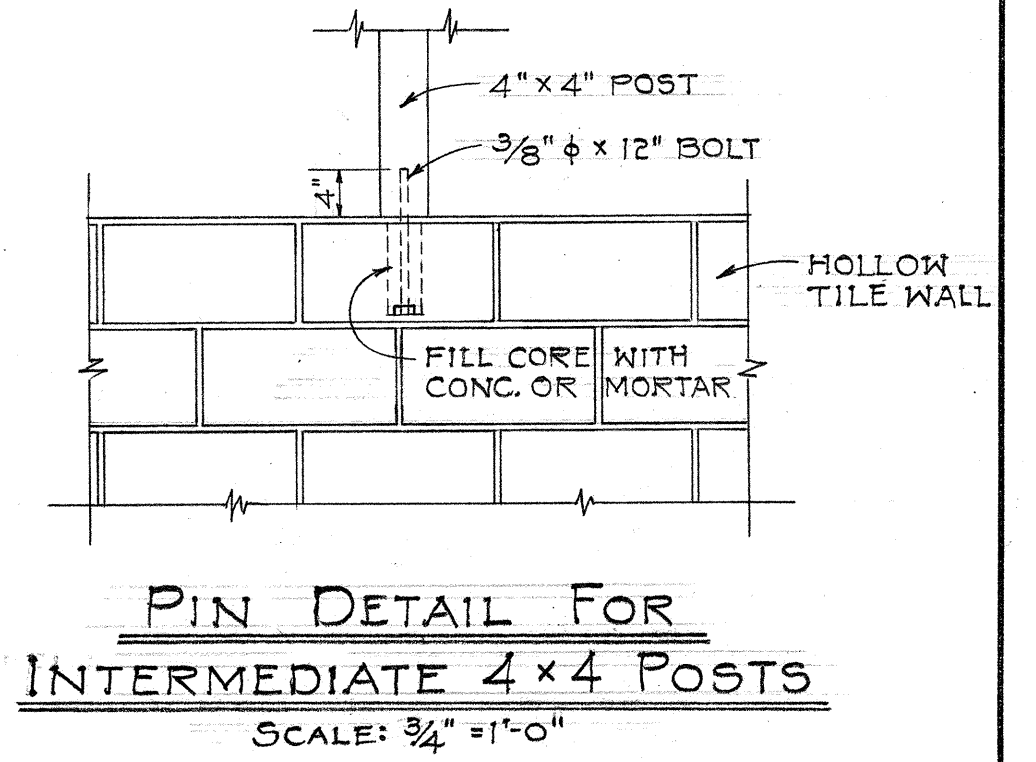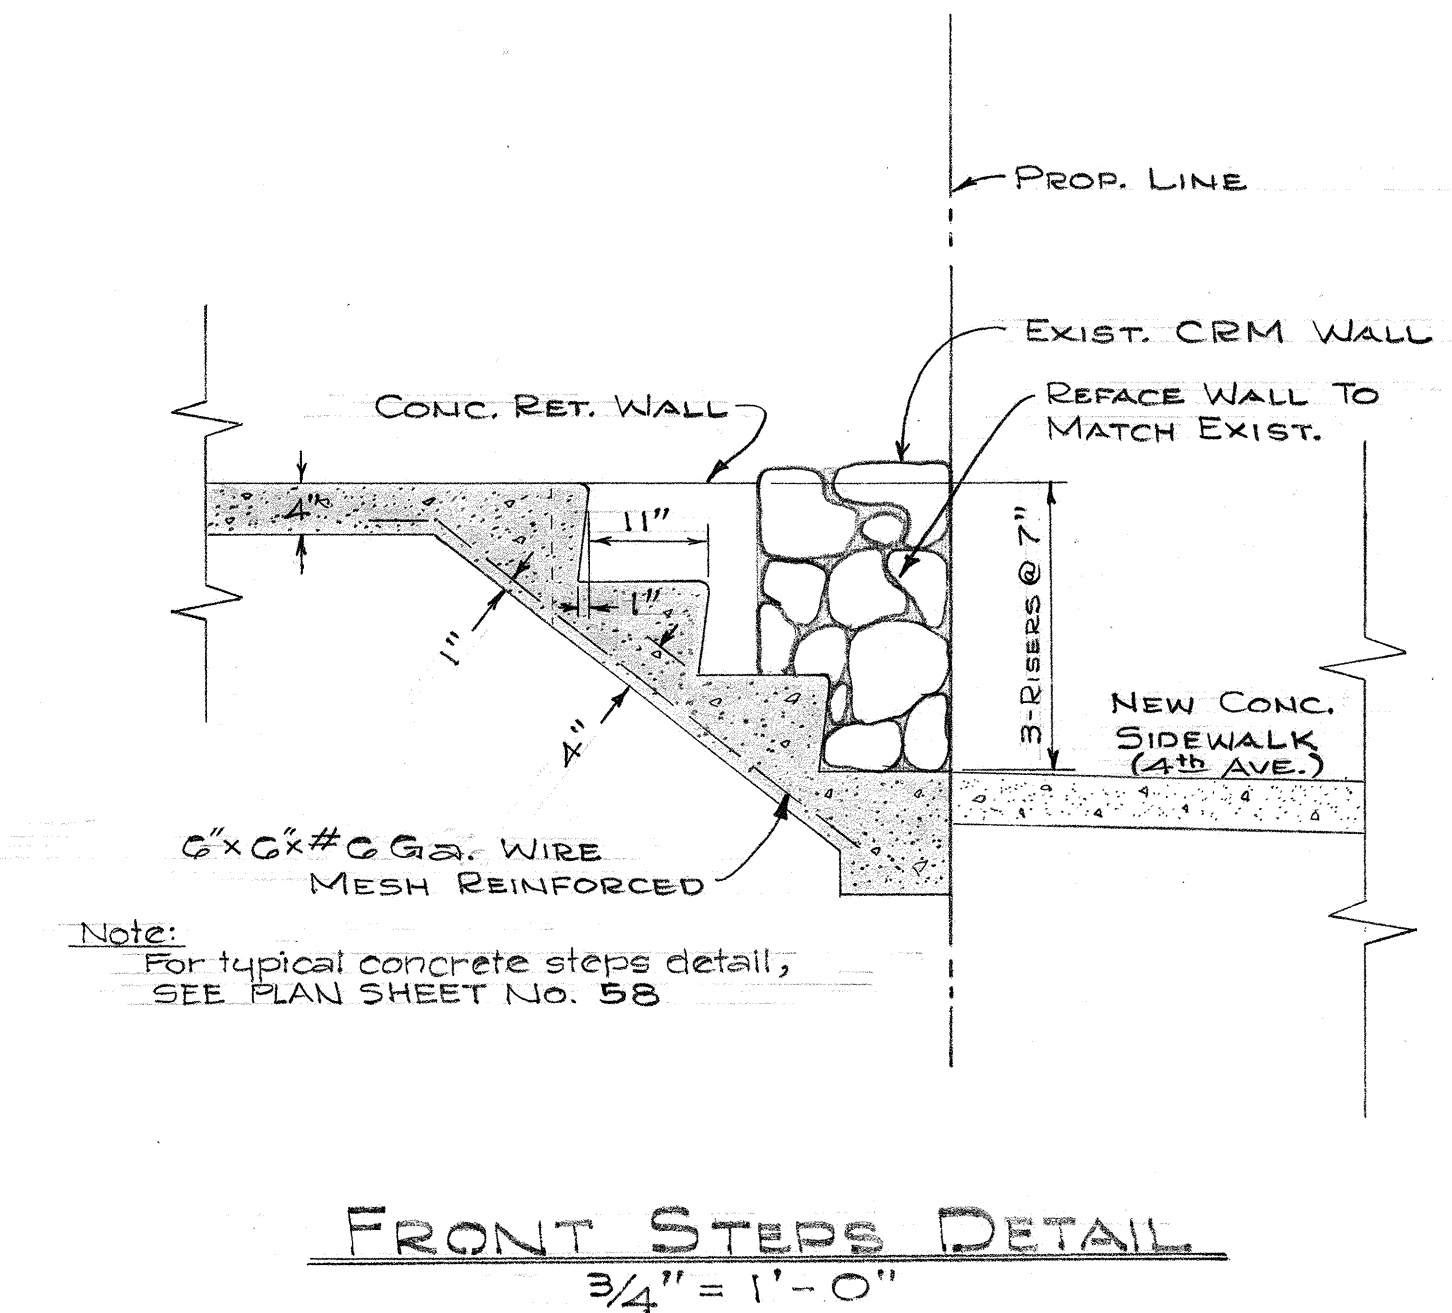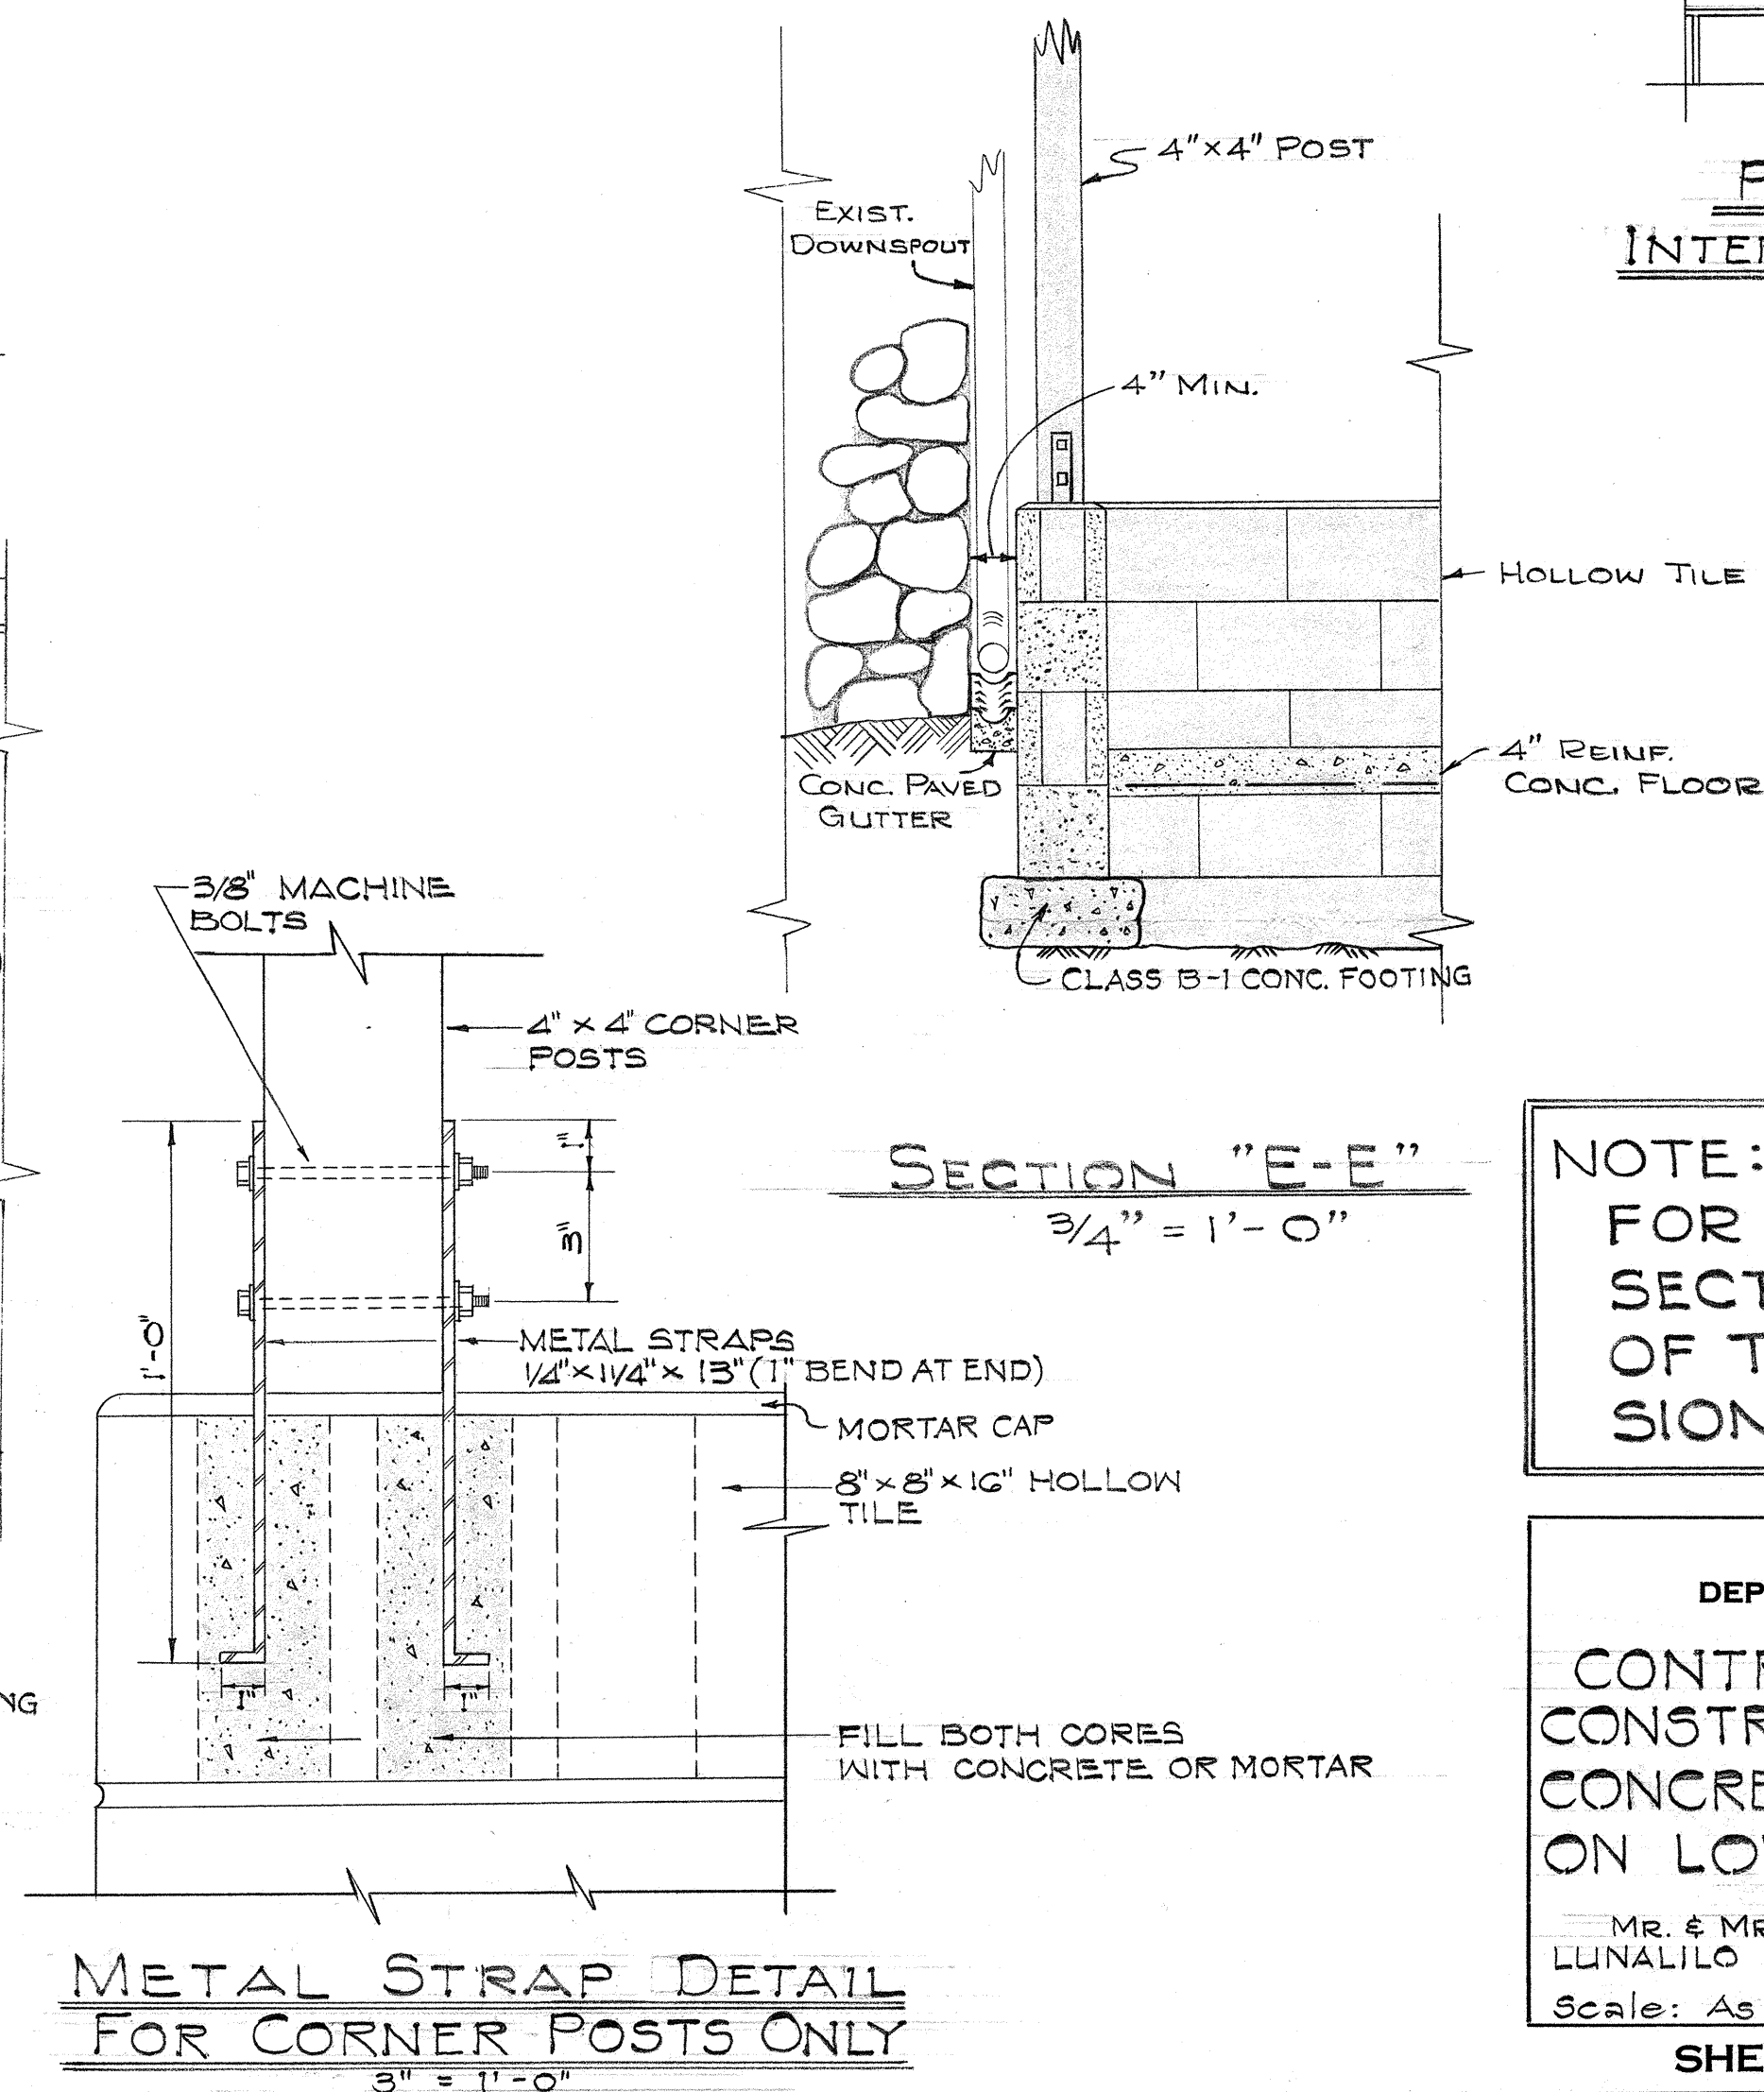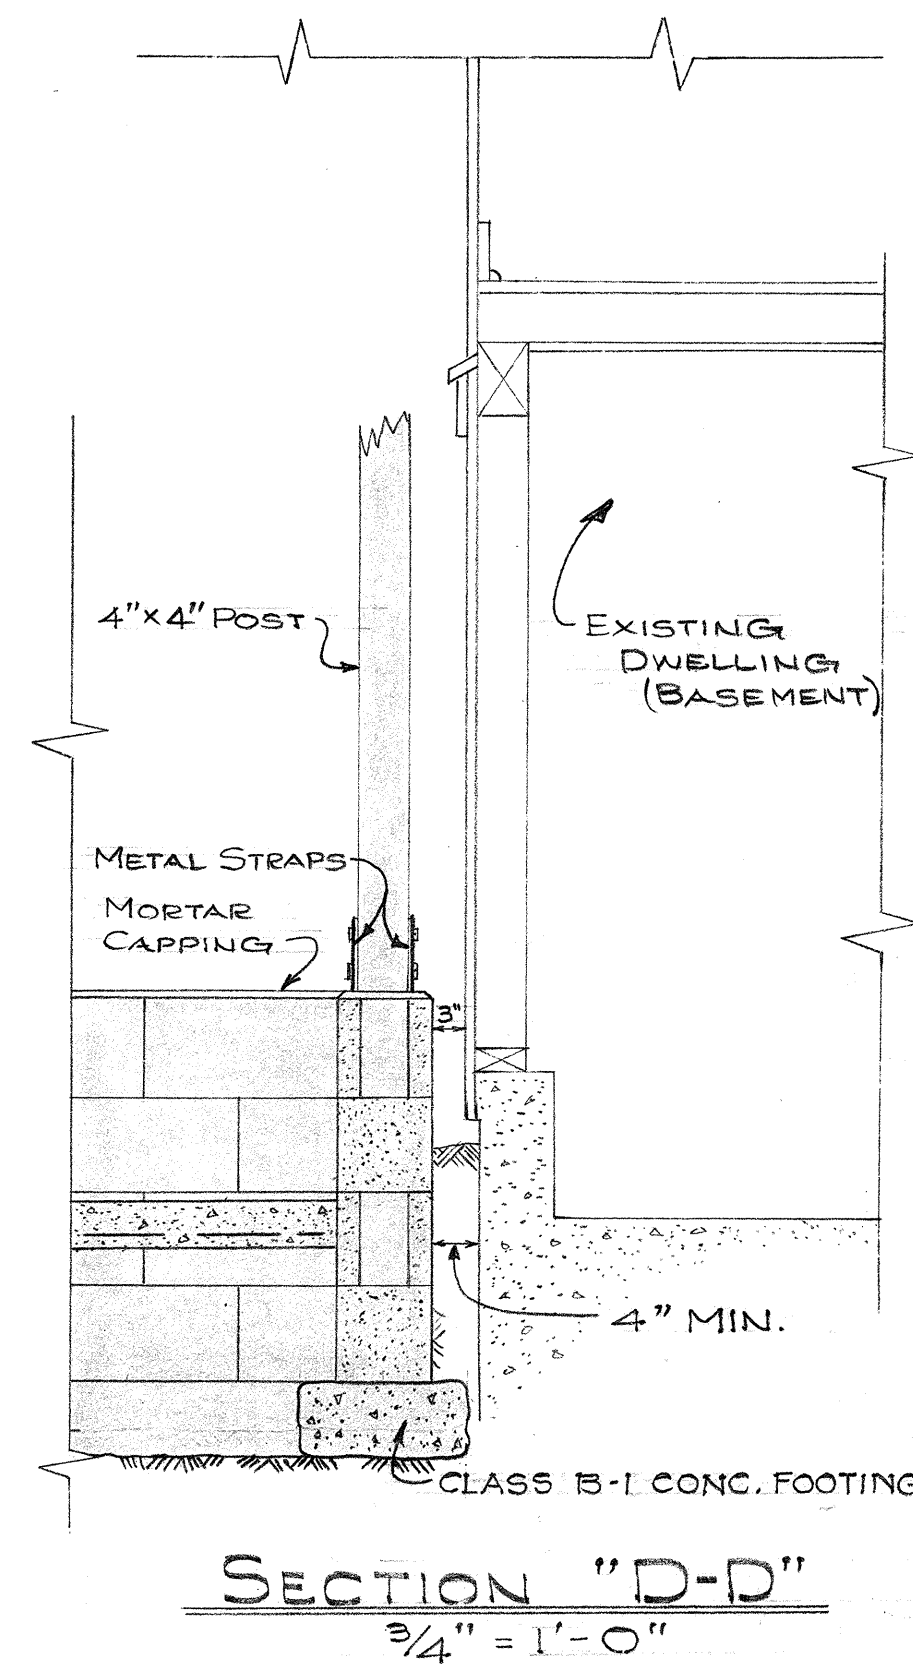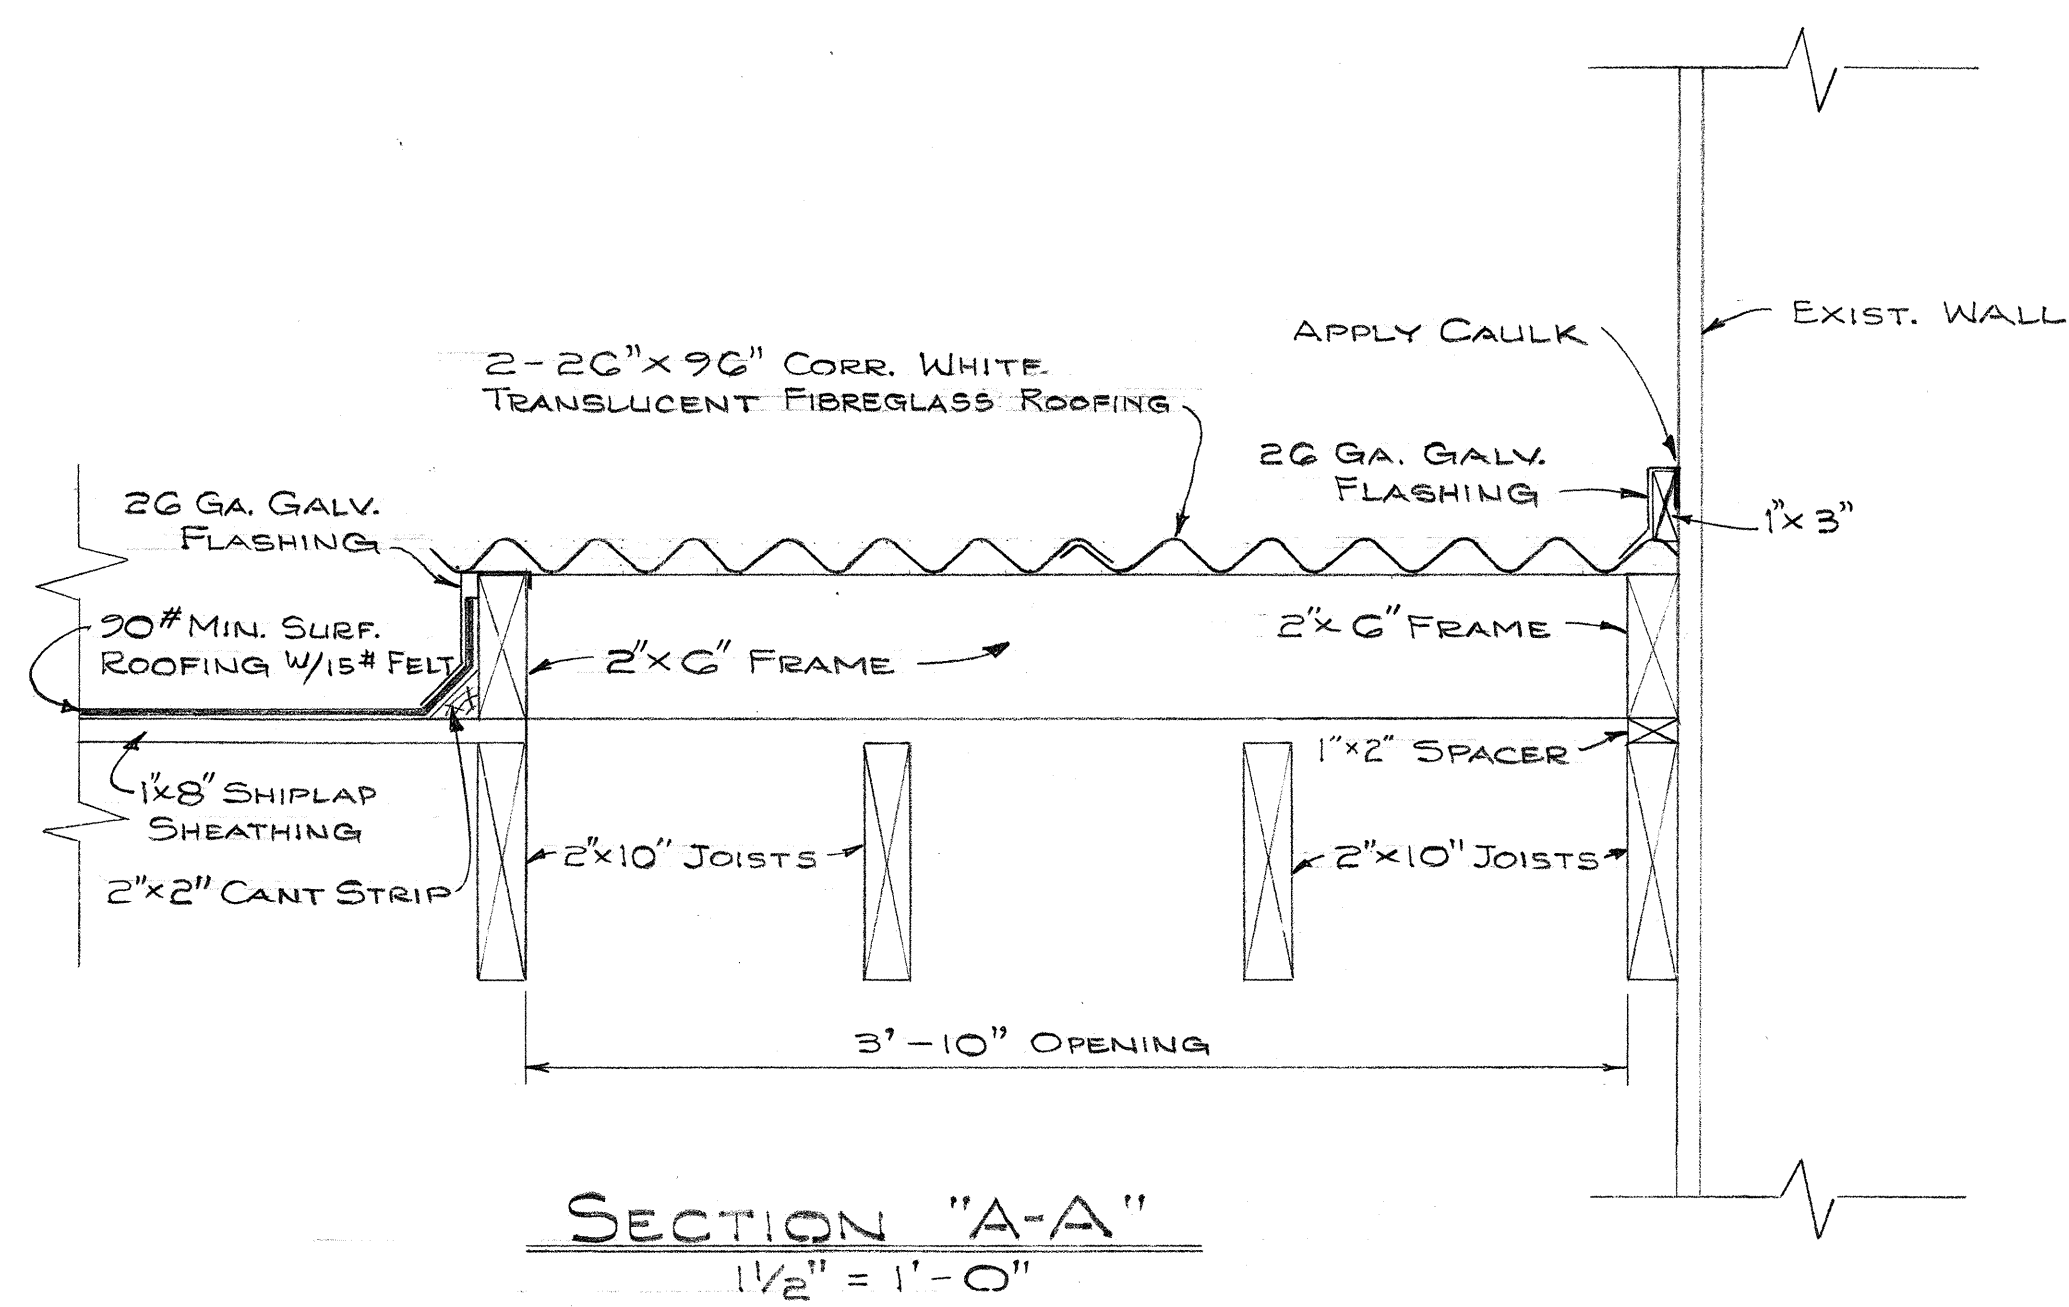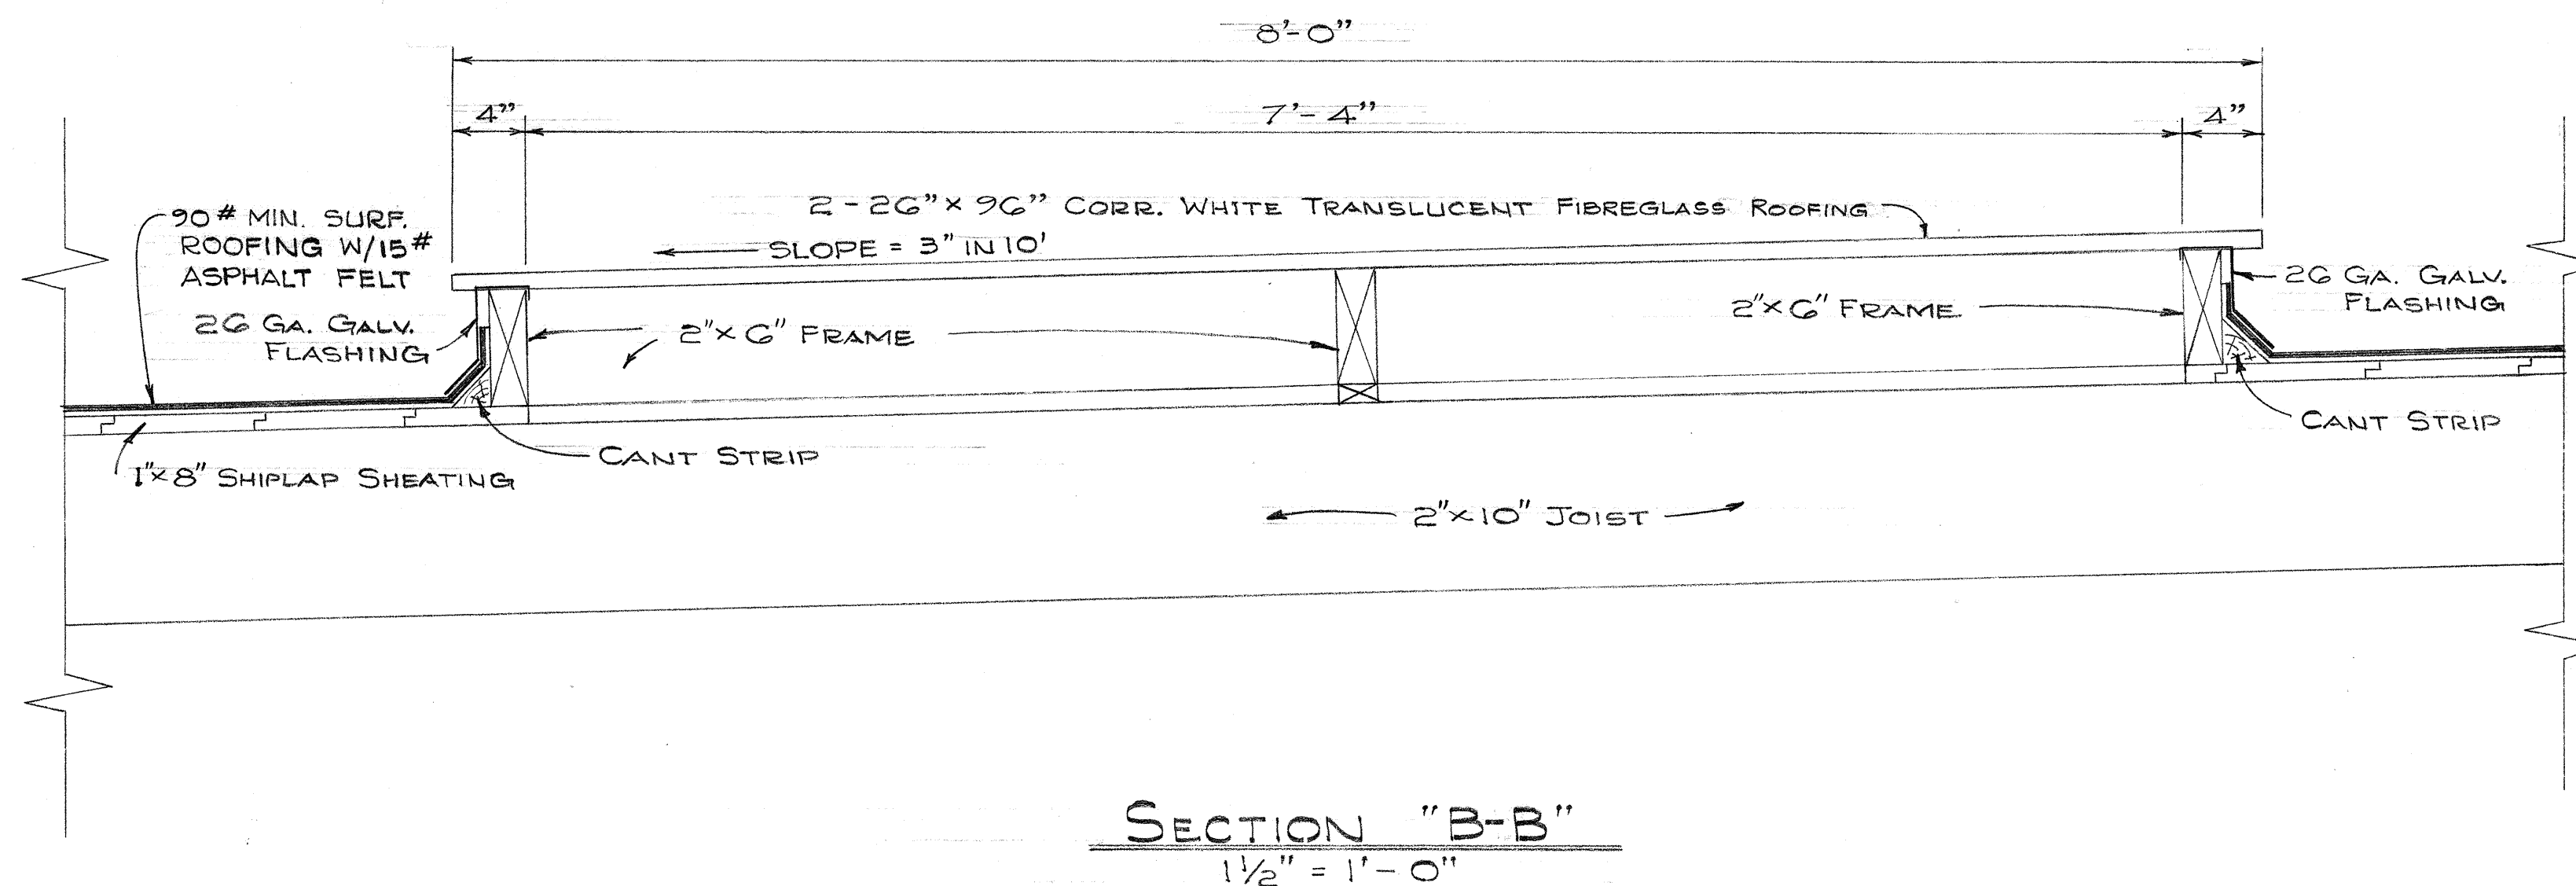



NOTE:
FOR SPECIFICATIONS SEE SECTIONS 123 AND 123A OF THE SPECIAL PROVISIONS.

STATE OF HAWAII
DEPARTMENT OF TRANSPORTATION
HIGHWAYS DIVISION
CONTRACT ITEM NO. 123A
CONSTRUCTION OF CARPORT,
CONCRETE WALK AND STEPS
ON LOT TAX KEY: 3-2-10:61
AT 1038 4TH AVE.
MR. & MRS. BUNG KWAI KOP et al (OWNERS)
LUNALILO FRNT. PROJ. NO. I-HI-1(4):24
Scale: As Shown March 1963
SHEET No. OF SHEETS

th Ave. Sta. 16+50 =
ahoa Ave. Sta. 10+00








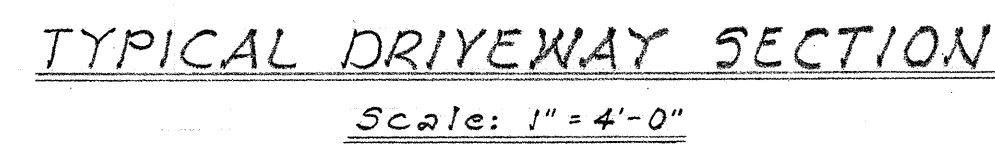


True North
Scale: 1" = 20'



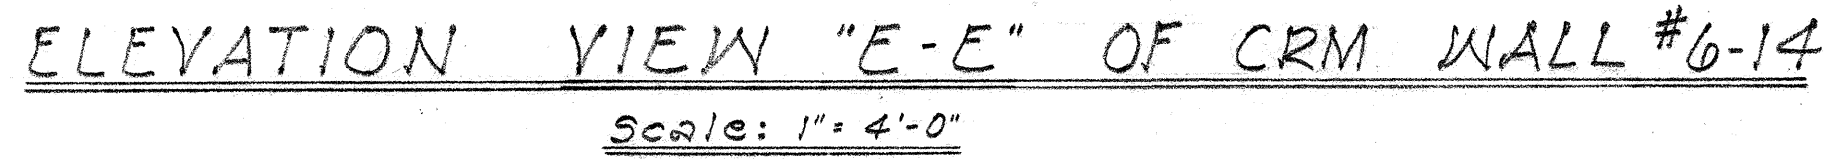
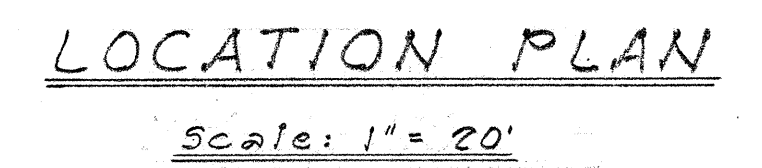


ORIGINAL PLAN	SURVEY PLOTTED BY	DATE
	DRAWN BY	
NOTE BOOK	TRACED BY	
	DESIGNED BY	
	QUANTITIES BY	
No.	CHECKED BY	

FED. ROAD DIST. NO.	STATE	FED. AID PROJ. NO.	FISCAL YEAR	SHEET NO.	TOTAL SHEETS
HAWAII	HAW.	1-H-1(4)	1963	50	67

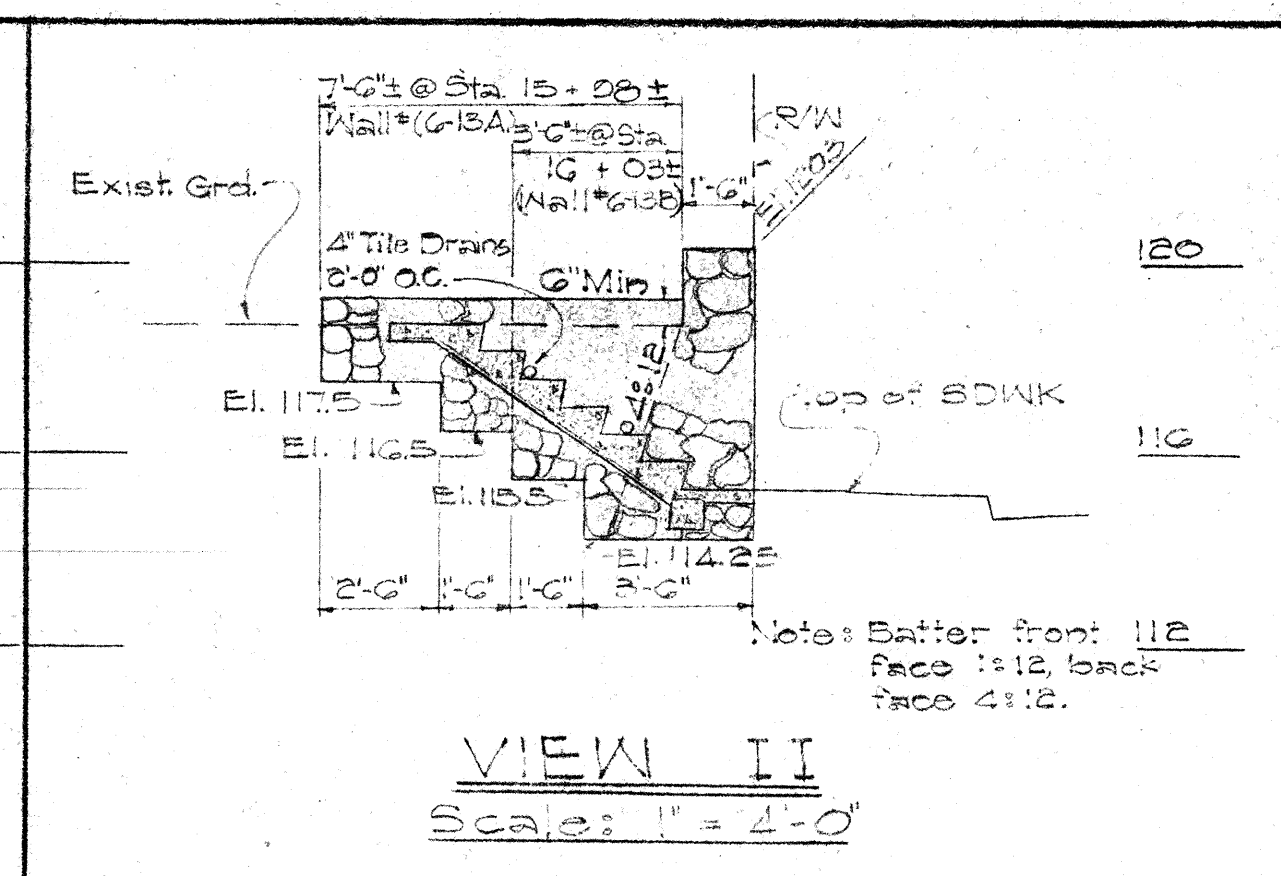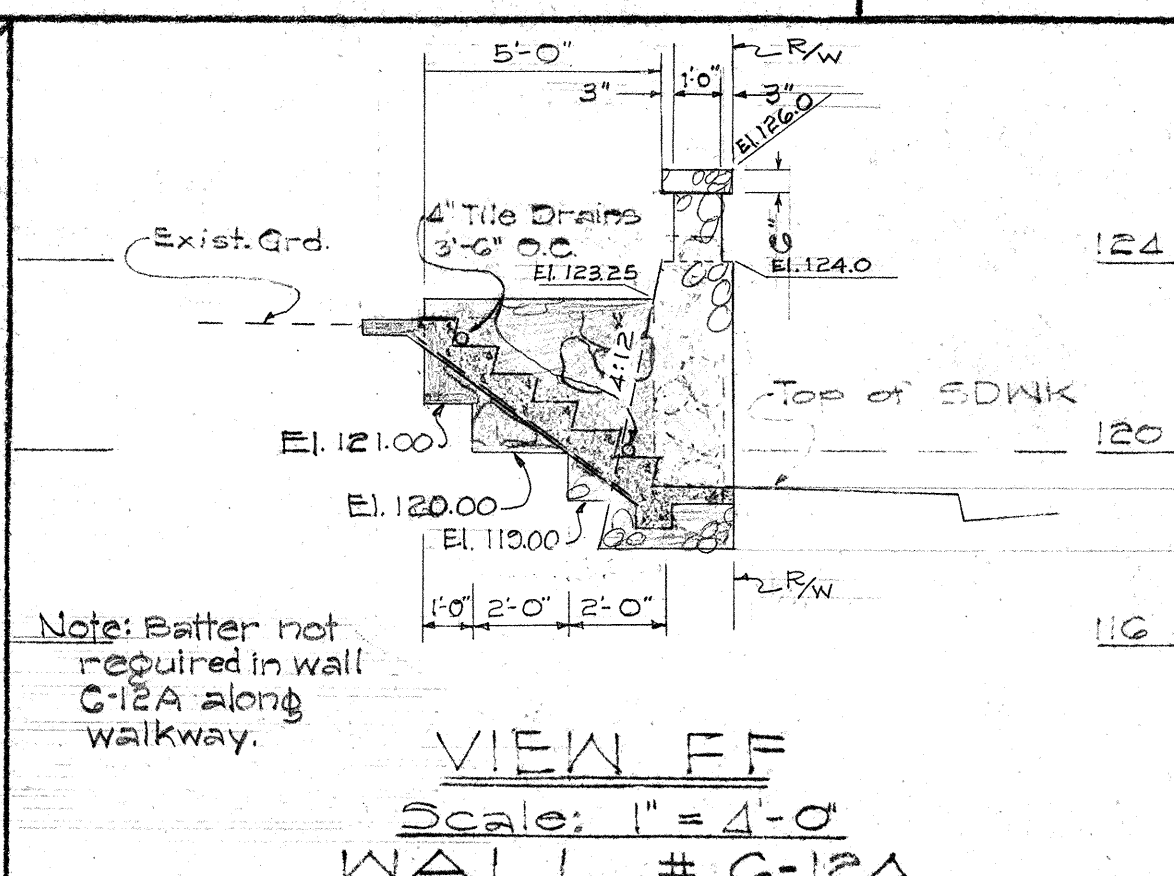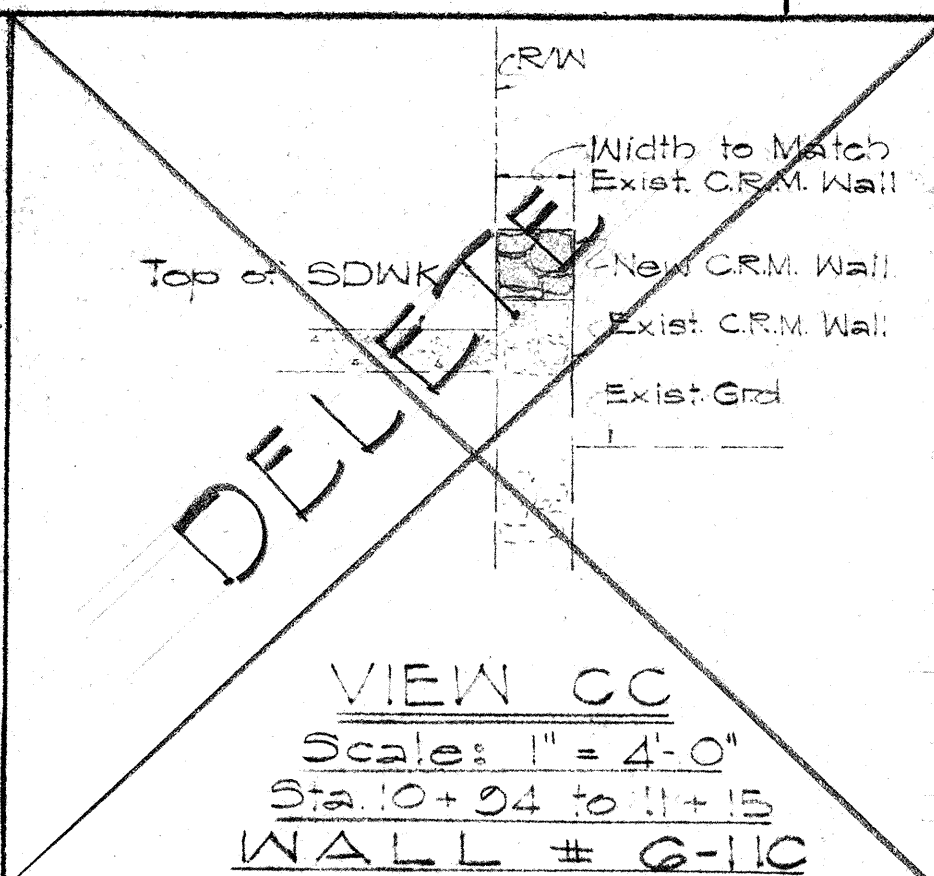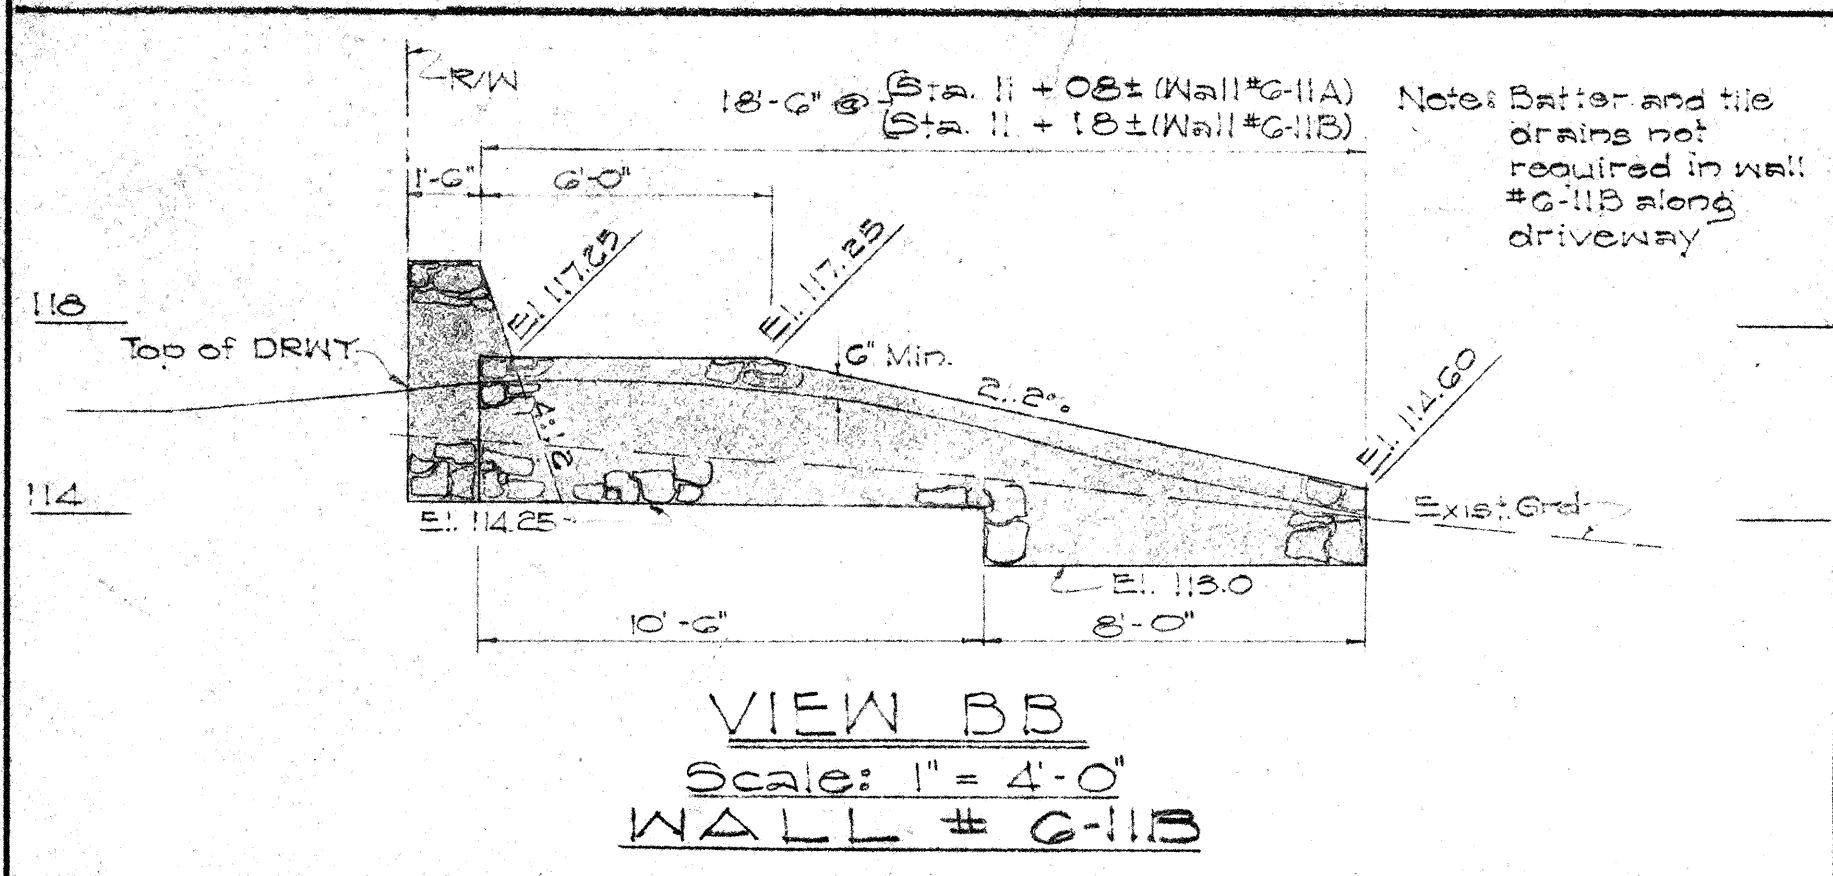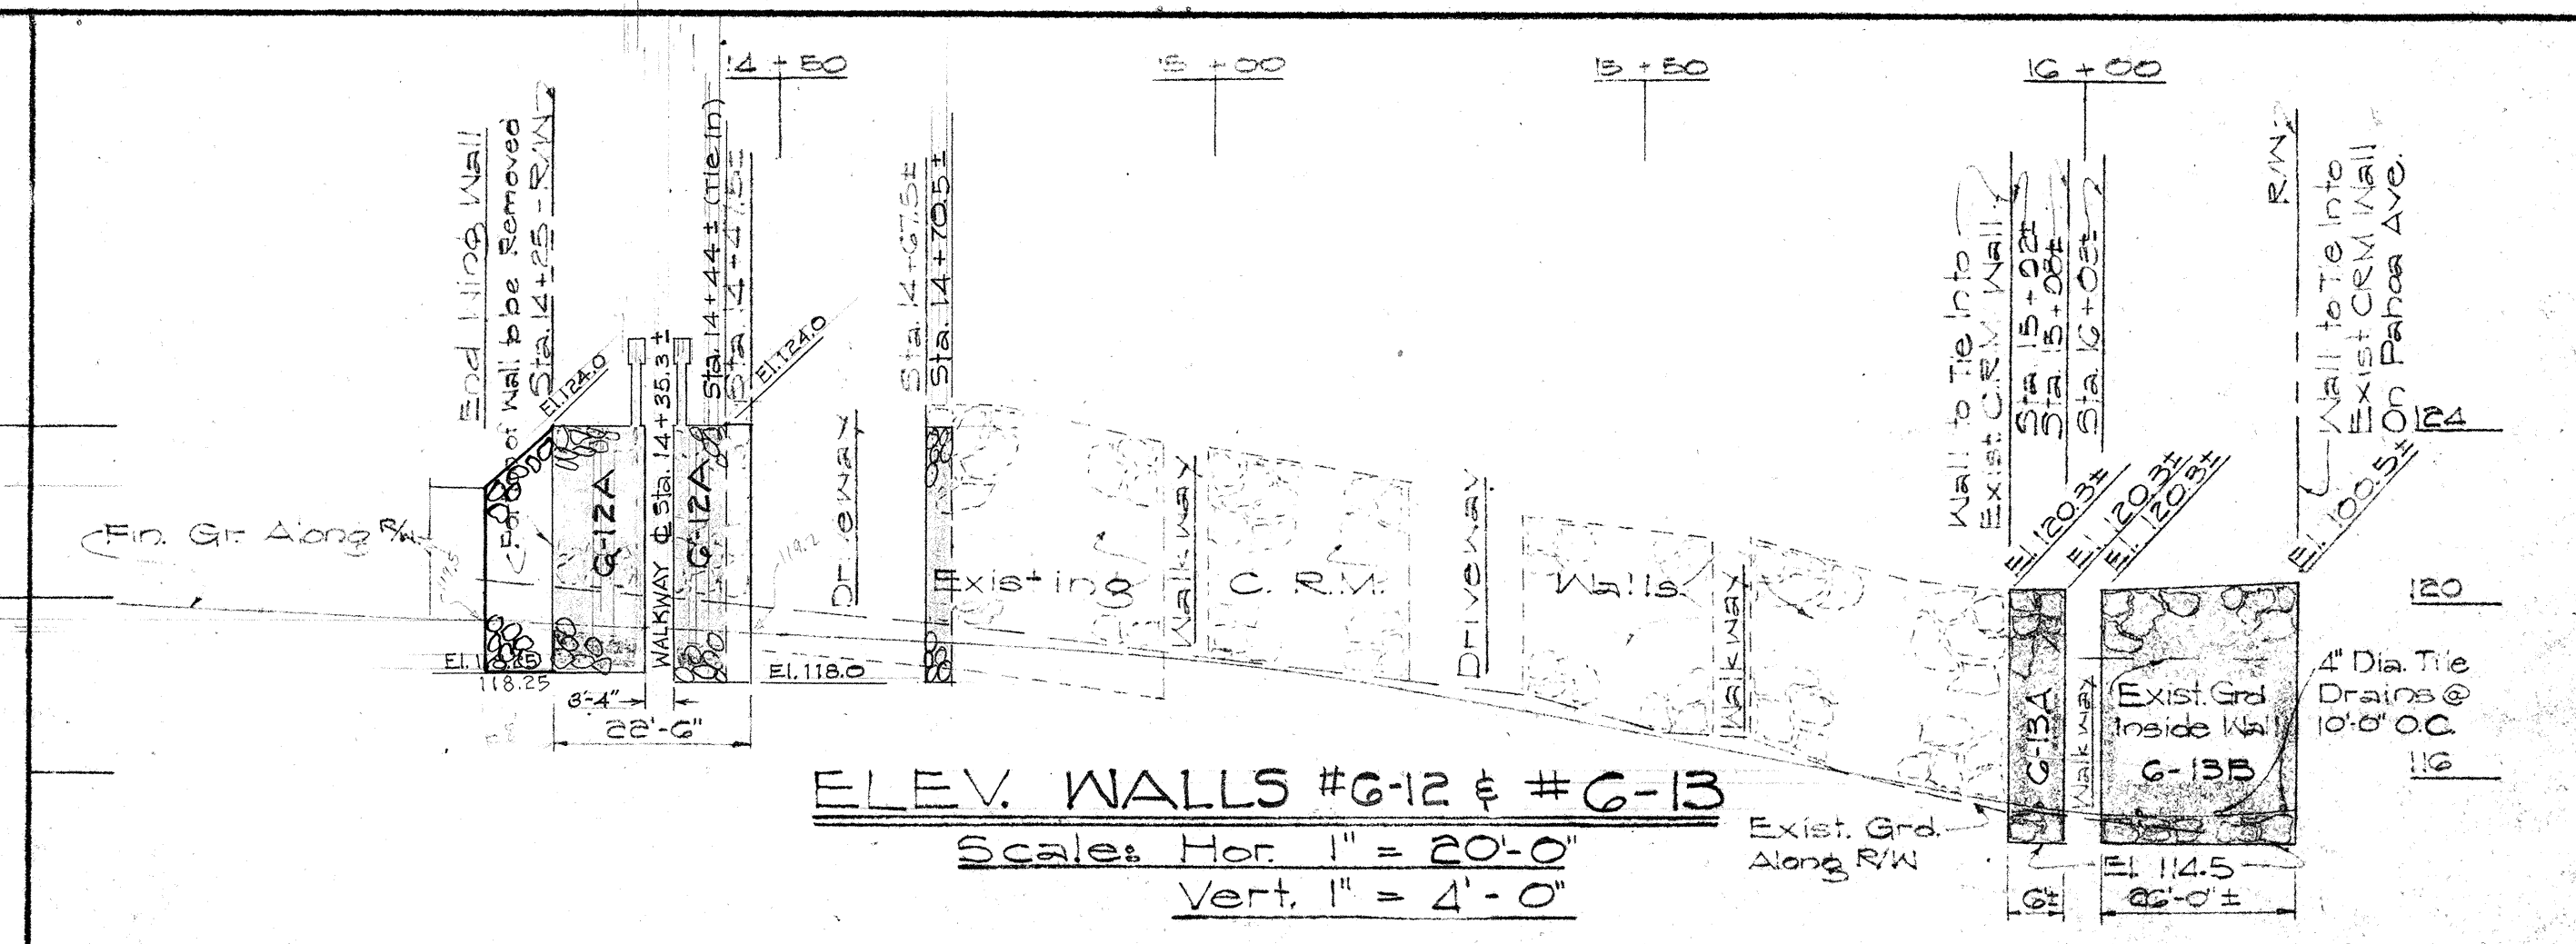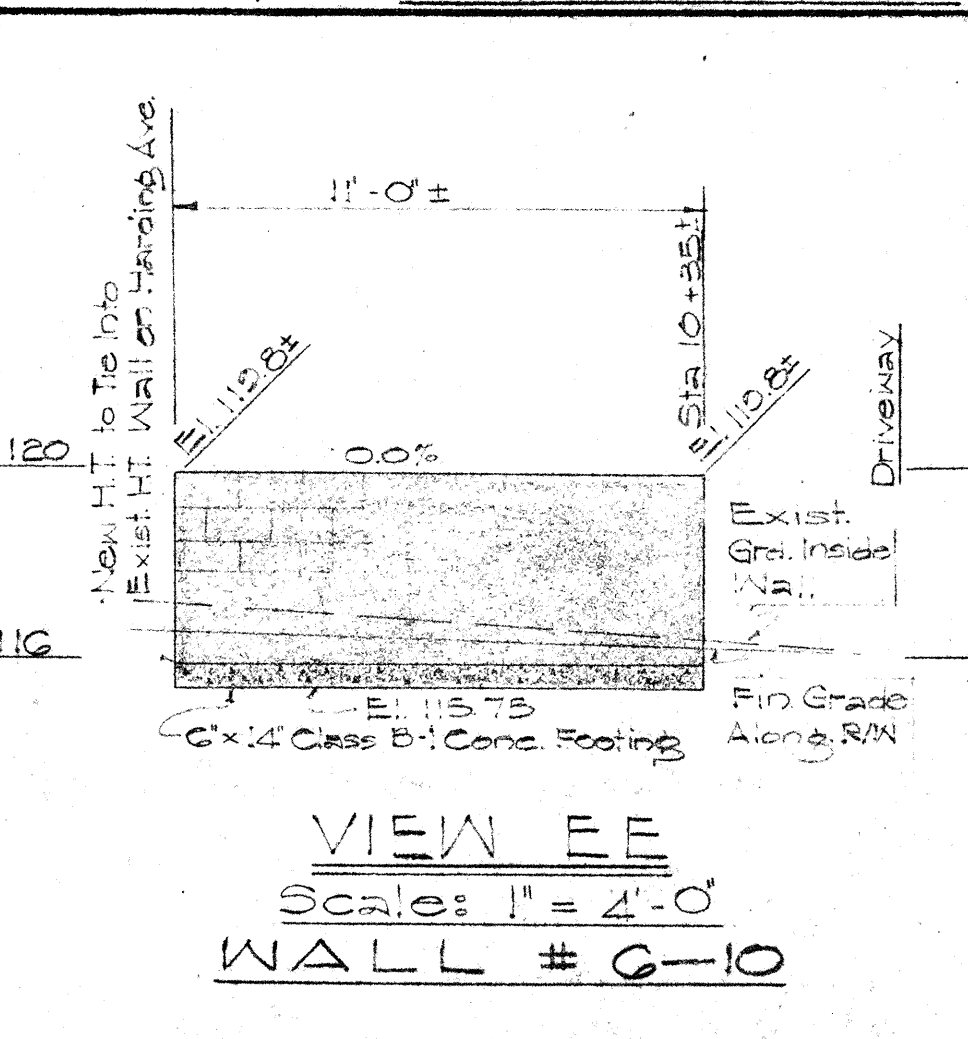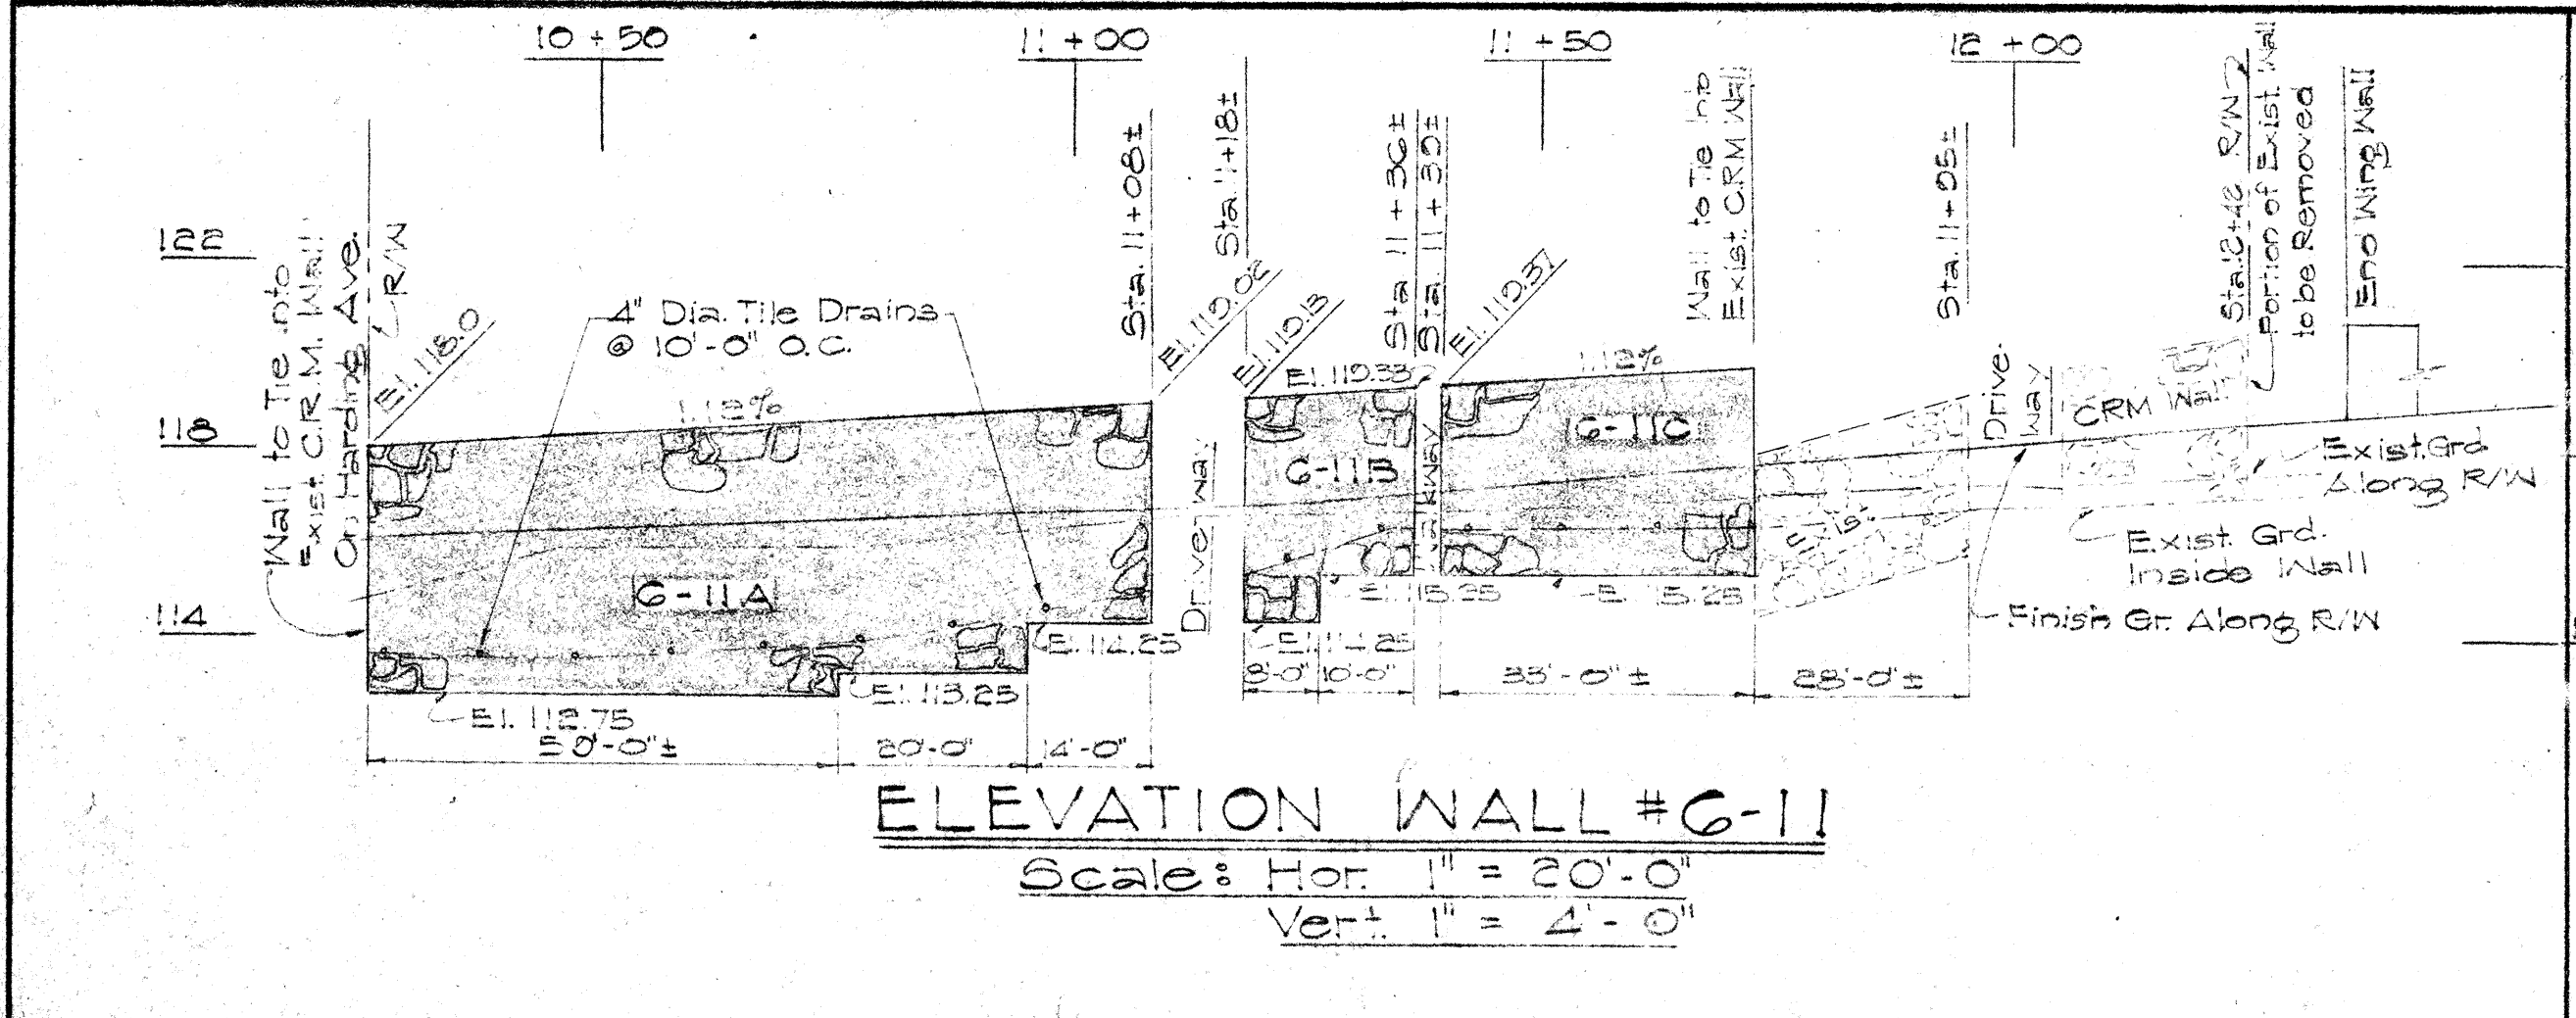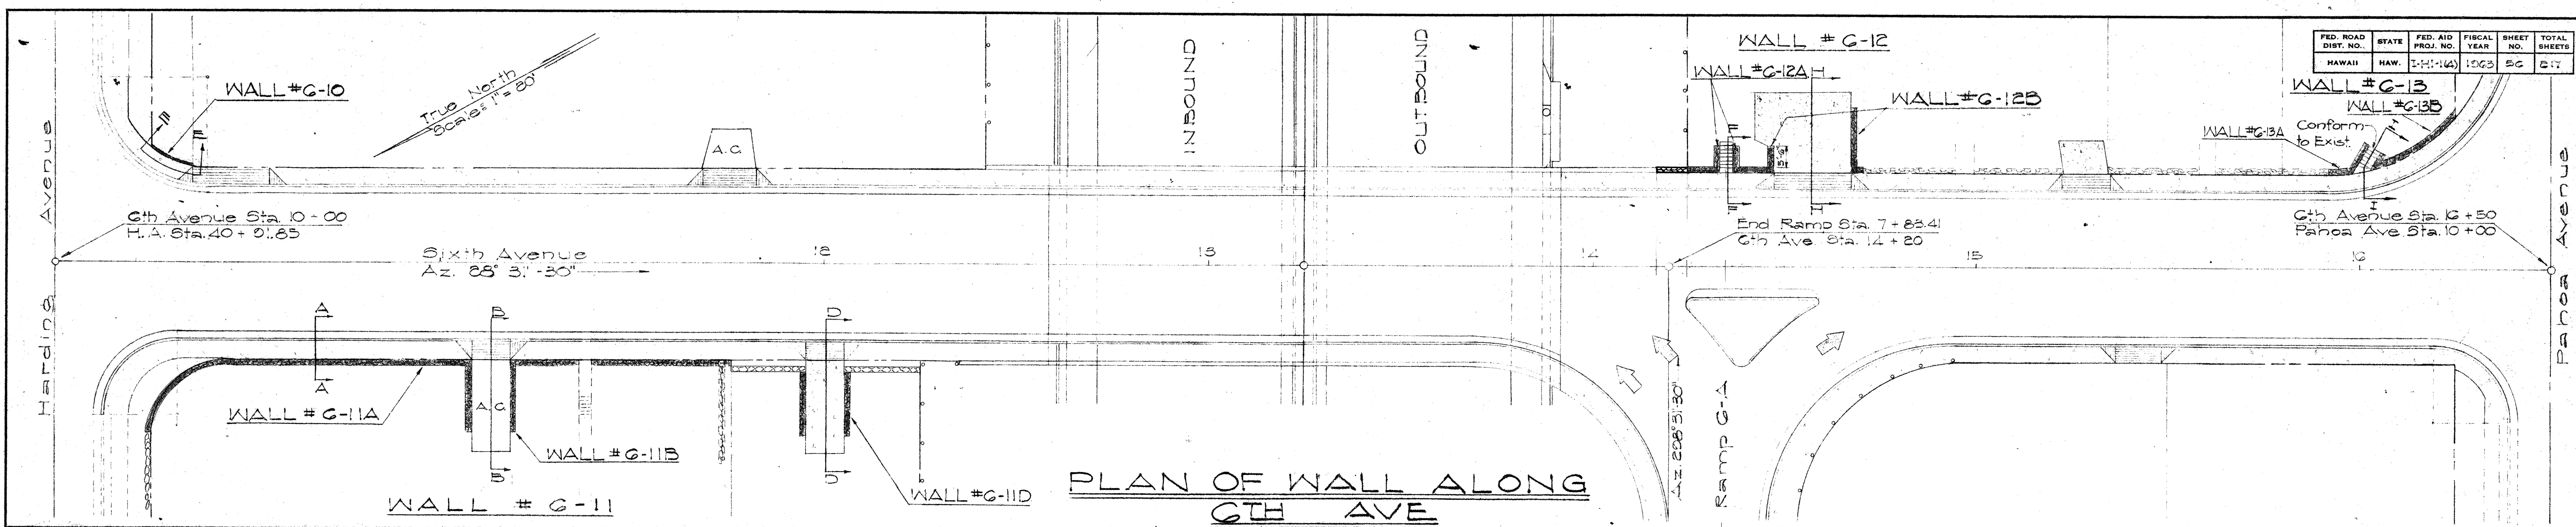

NOTE:
For typical concrete steps detail,
see plan sheet No. 50.

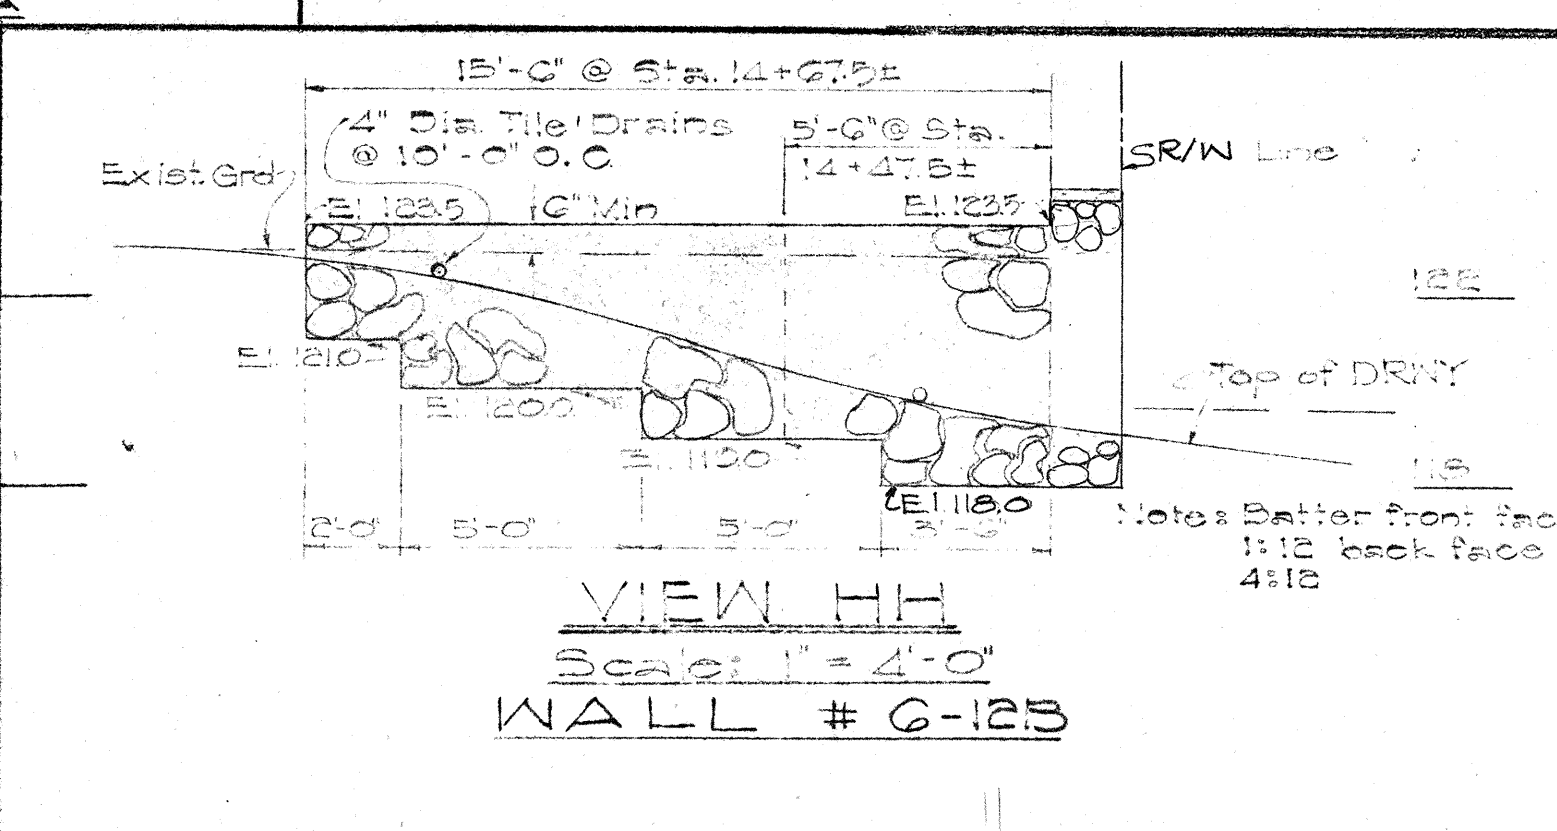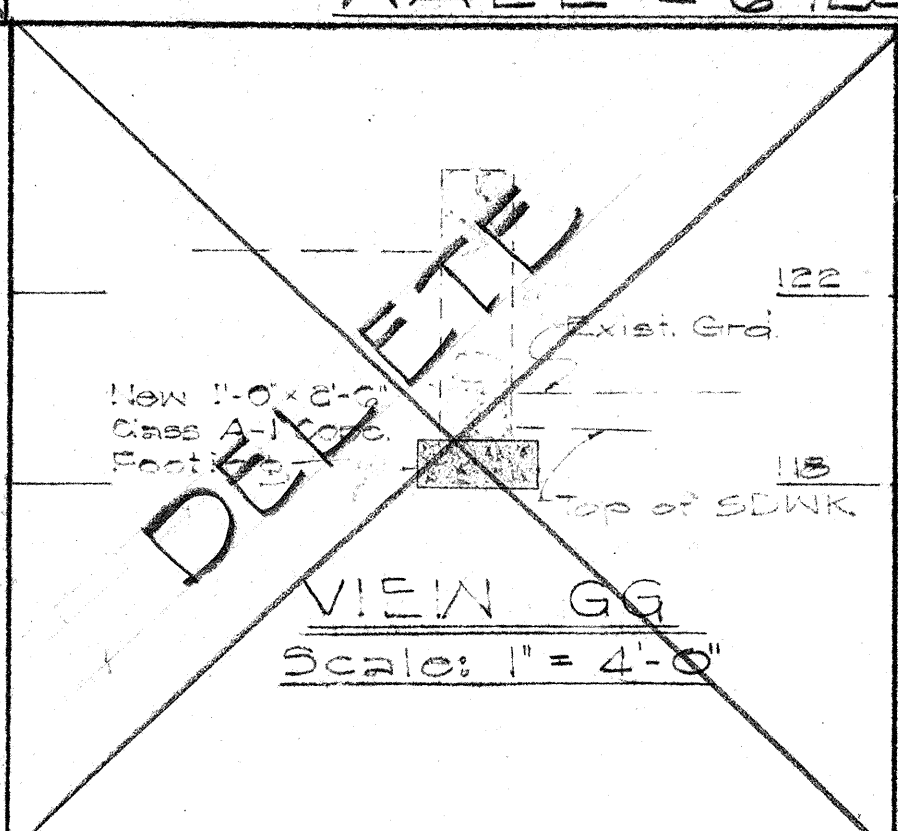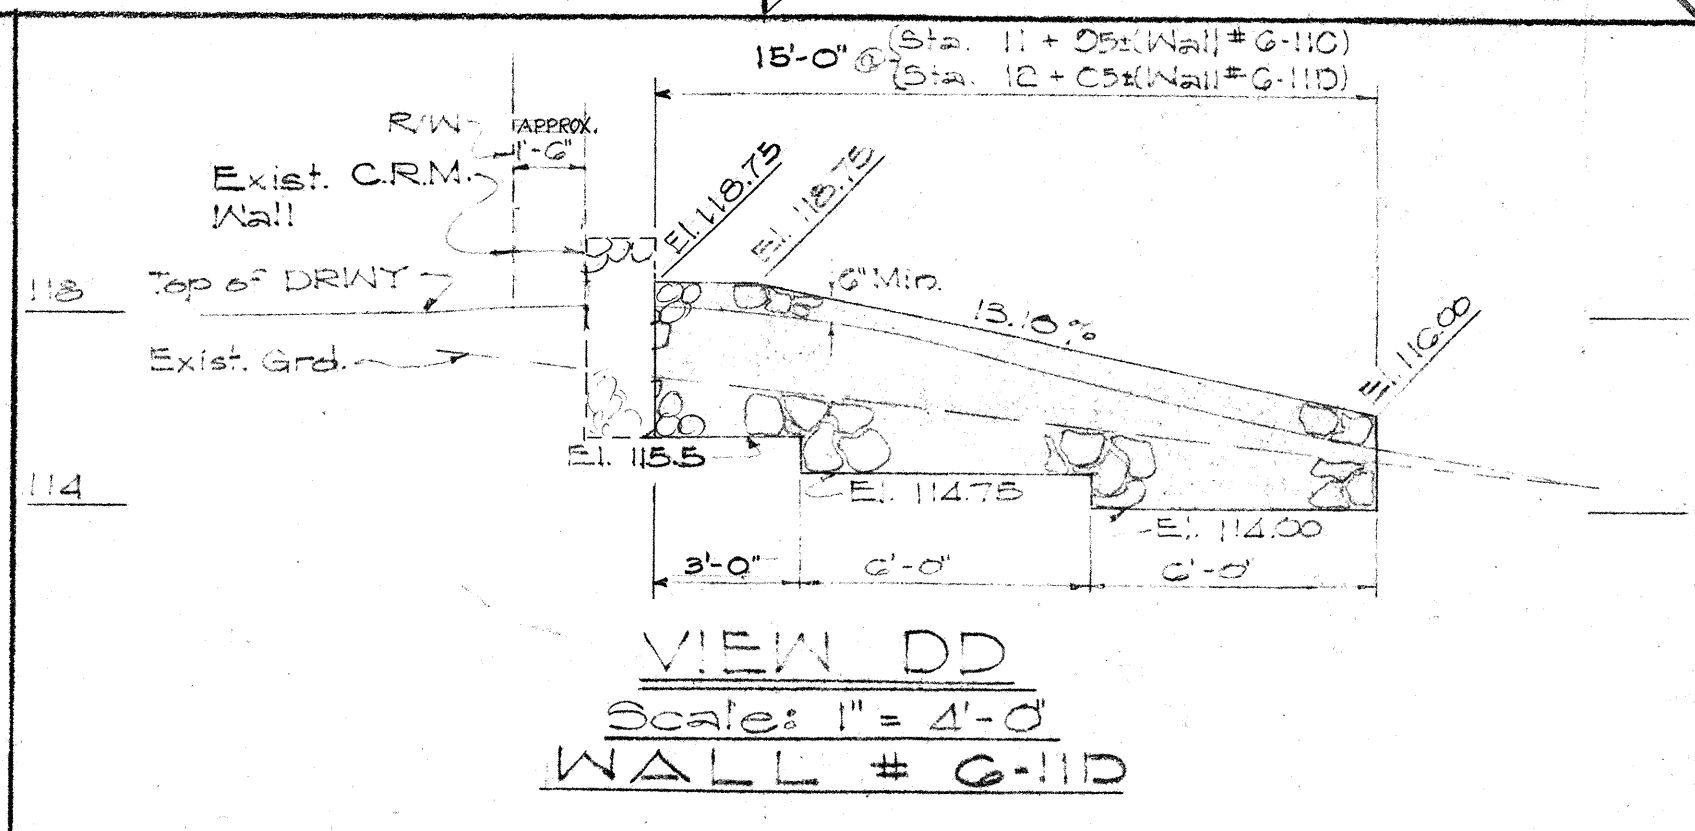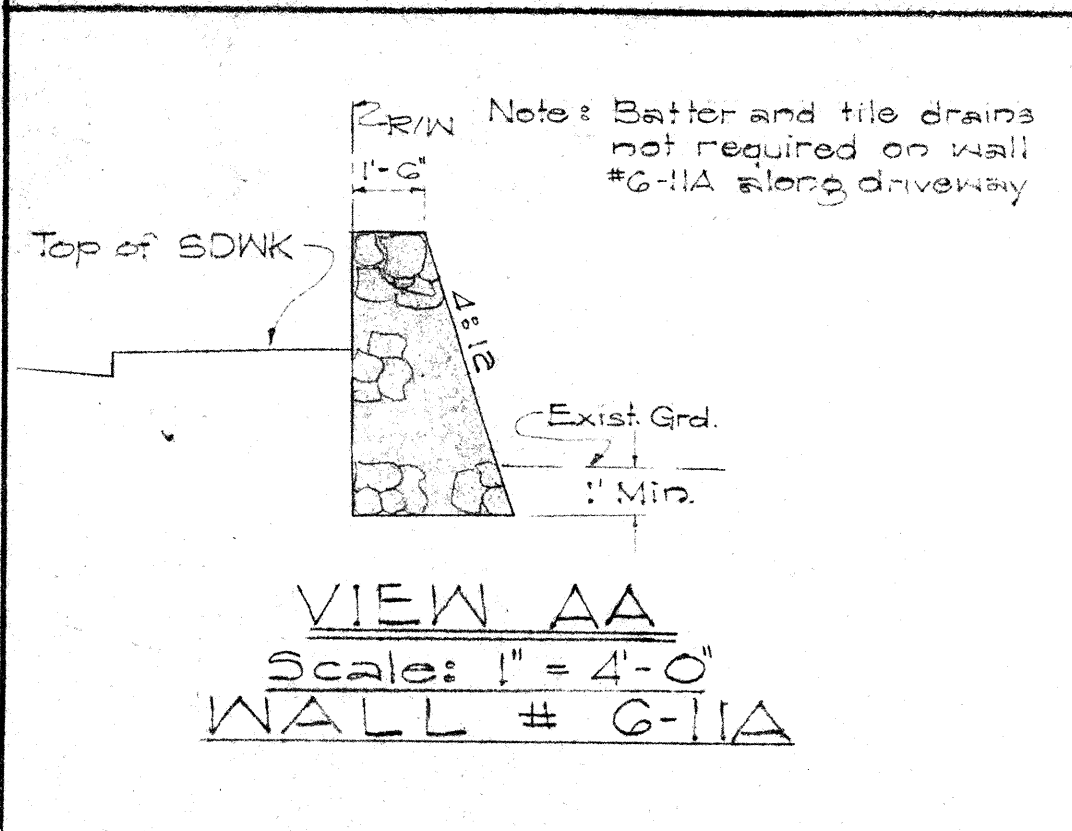

This Sheet Supersedes Sheet No. 50

STATE OF HAWAII
DEPARTMENT OF TRANSPORTATION
HIGHWAYS DIVISION

DETAILS OF WALLS
G-10, G-11, G-12 AND G-13

LUNALILO FREEWAY PROJ. No. 1-H-1(4):24
Scale: As shown Date: April, 1963








SHEET No. OF SHEETS

DATE	DESIGNED BY
PLAN	DRAWN BY
NOTE BOOK	CHECKED BY
No.	

PRINTED ON CLEARPRINT 1000-H

11/5/63

Revised: June 7, 1963

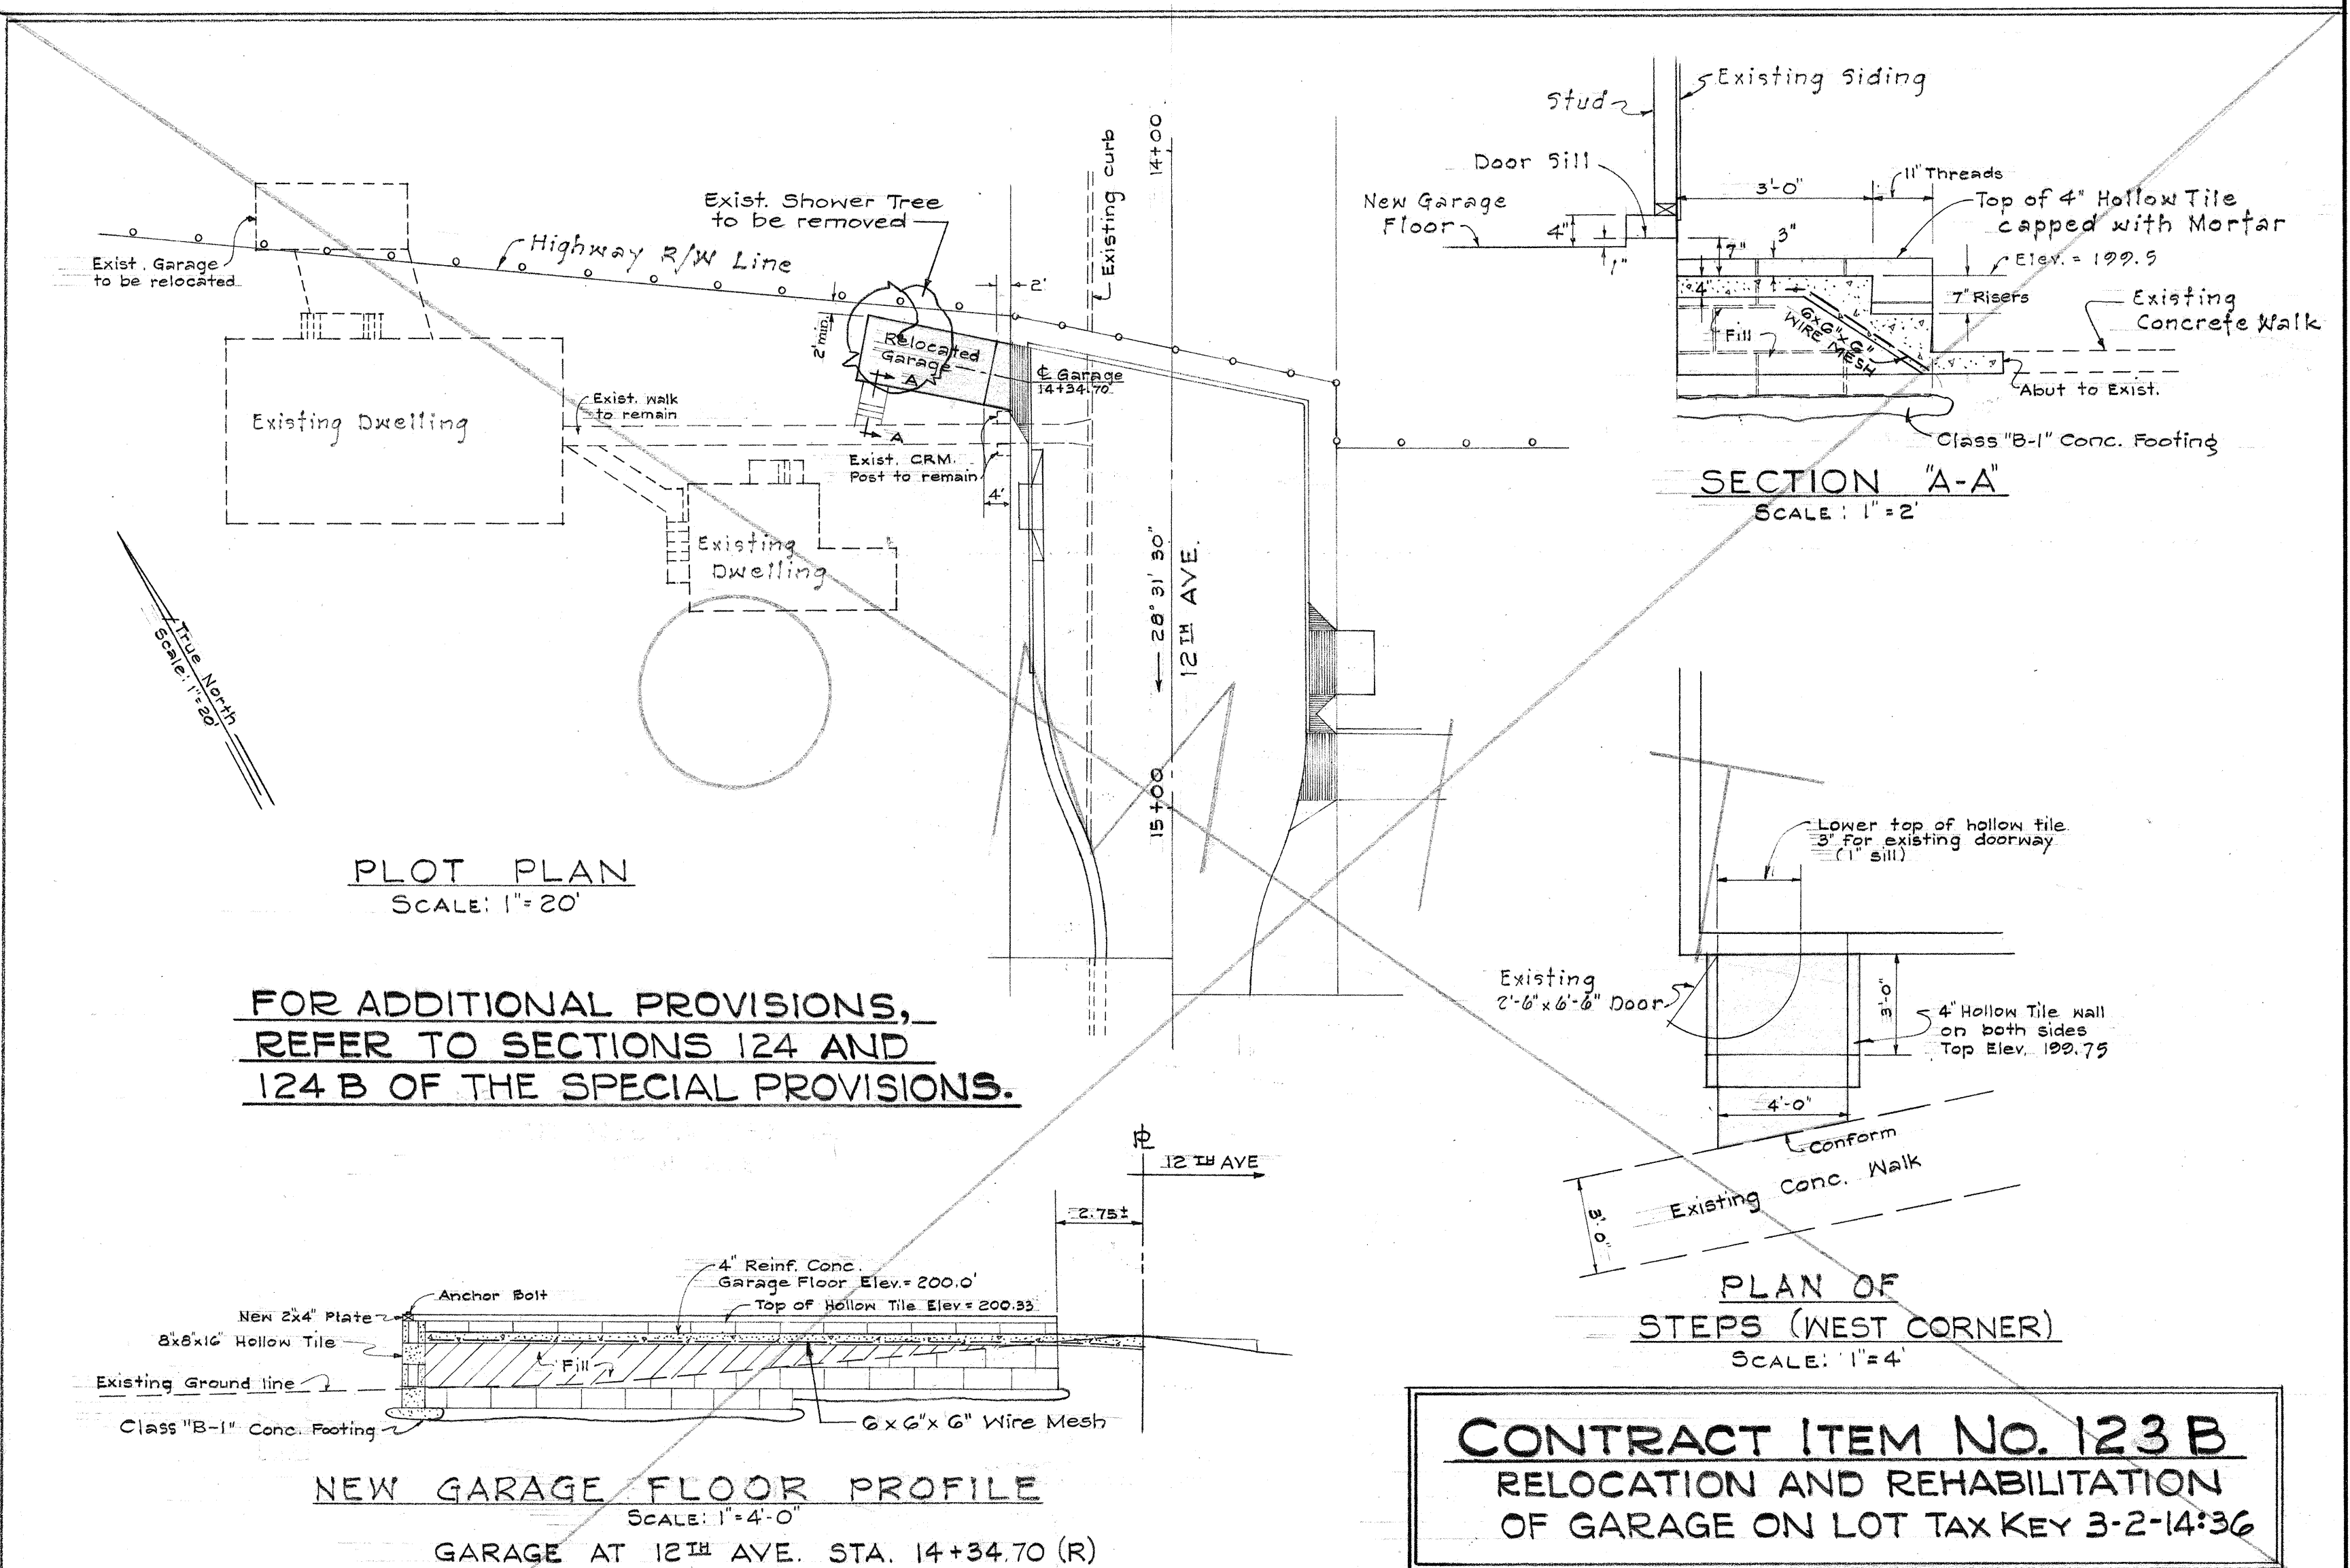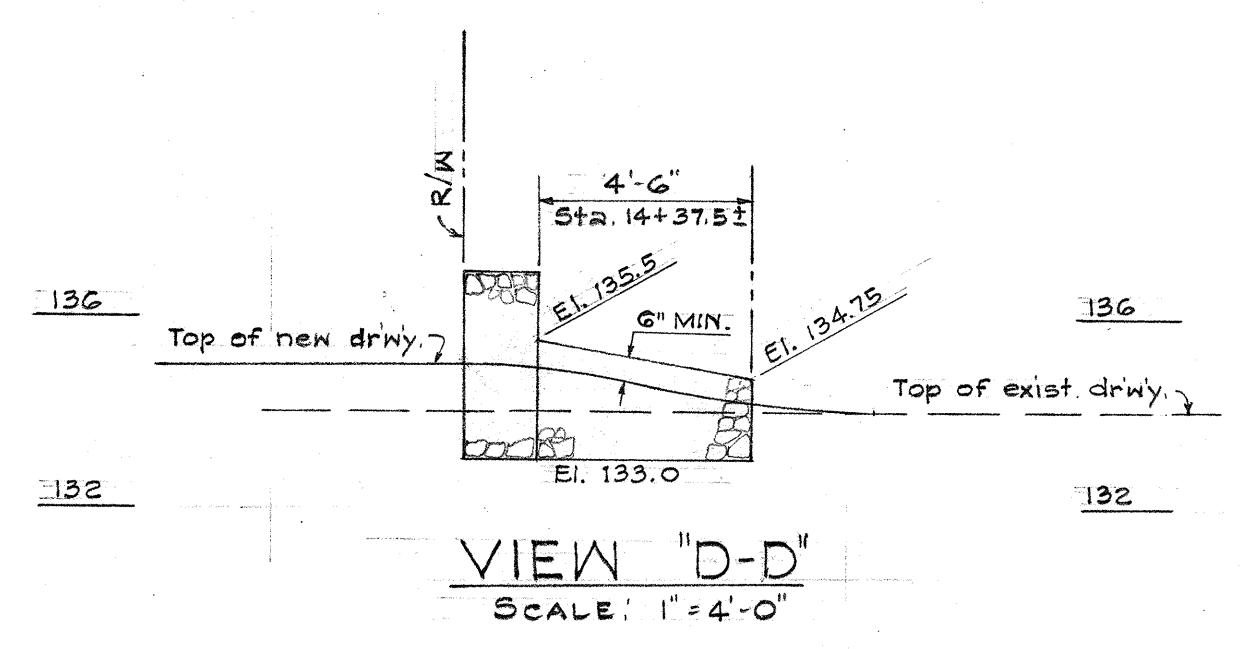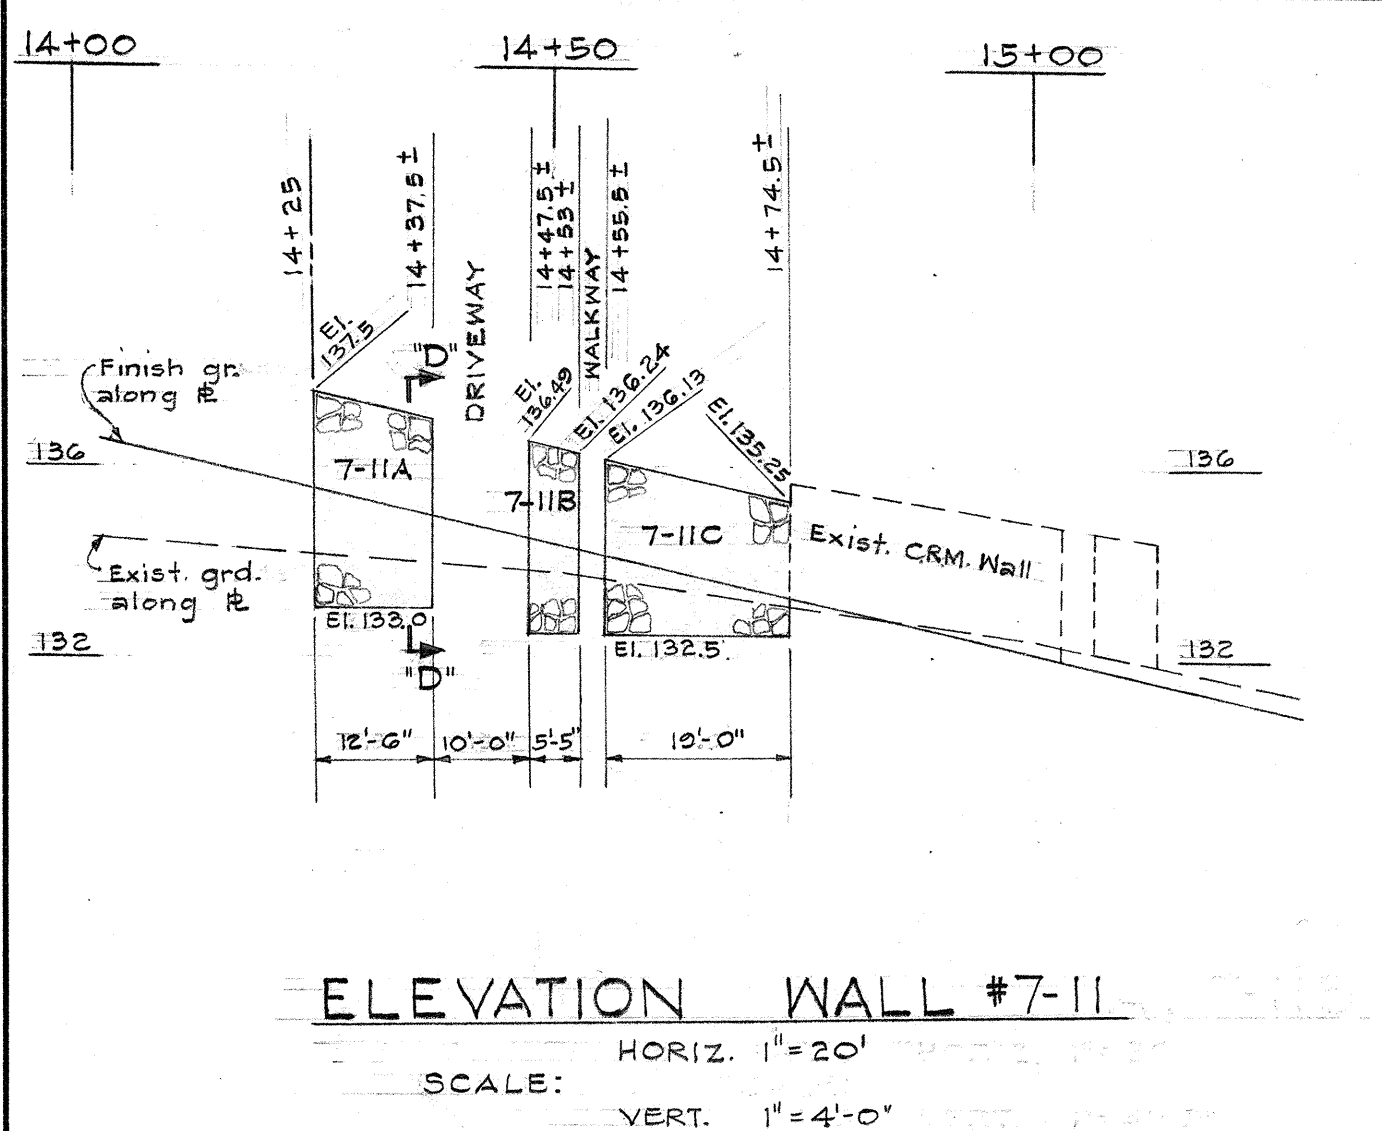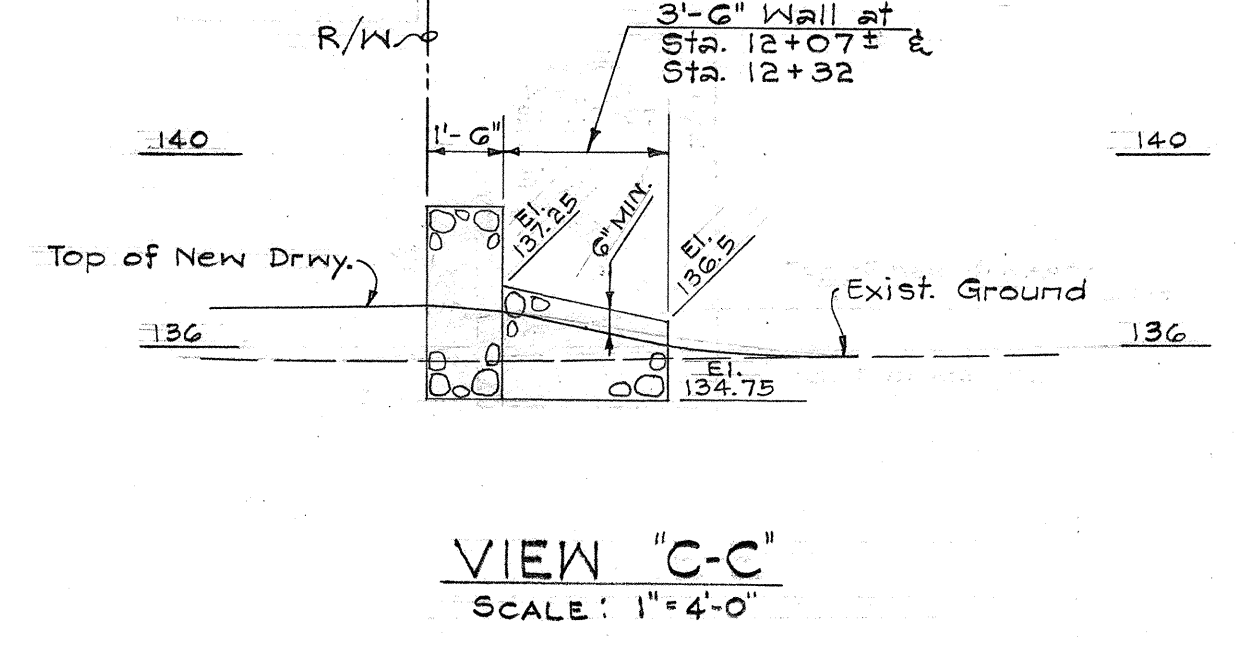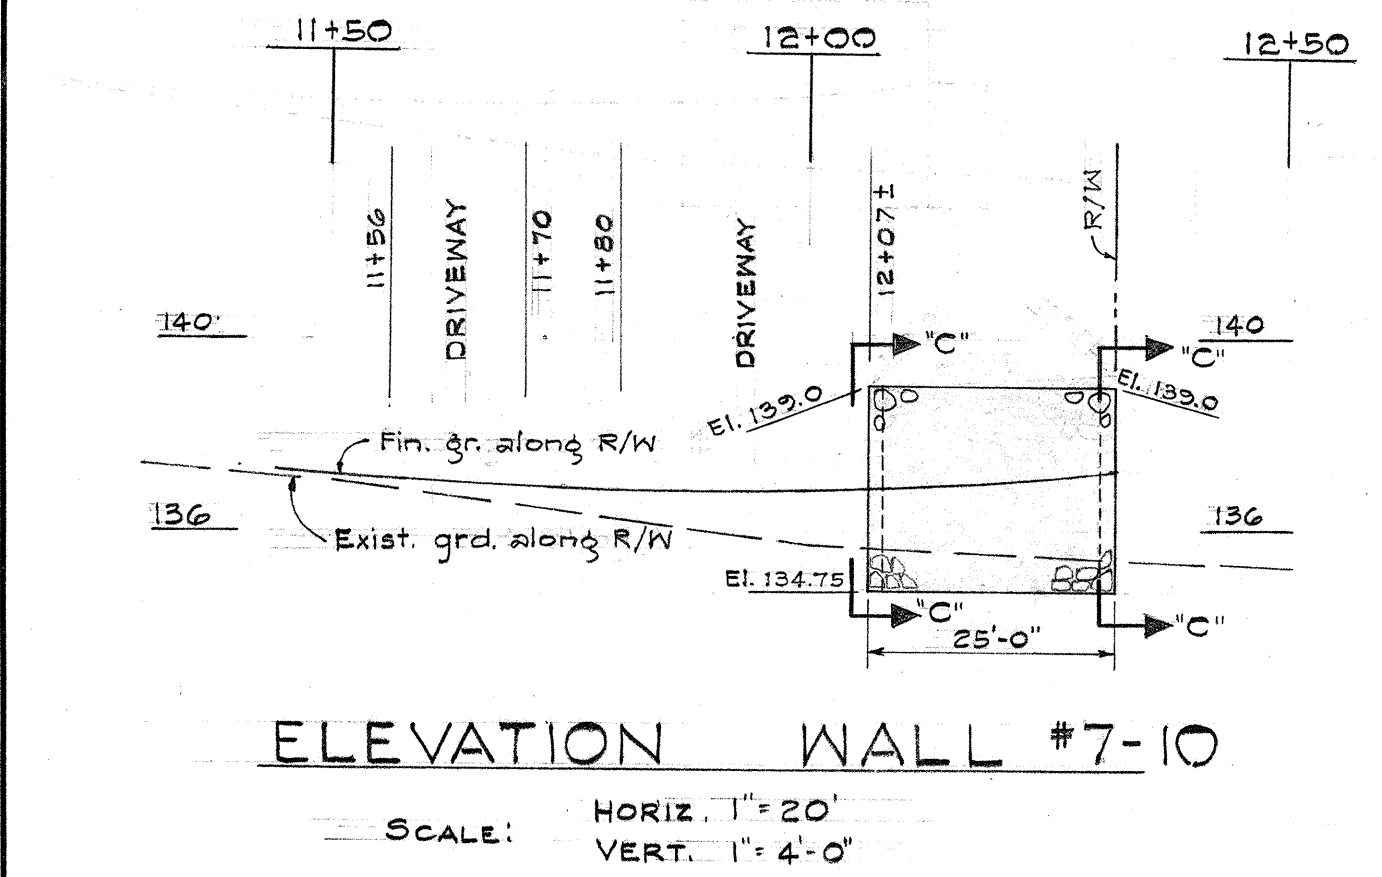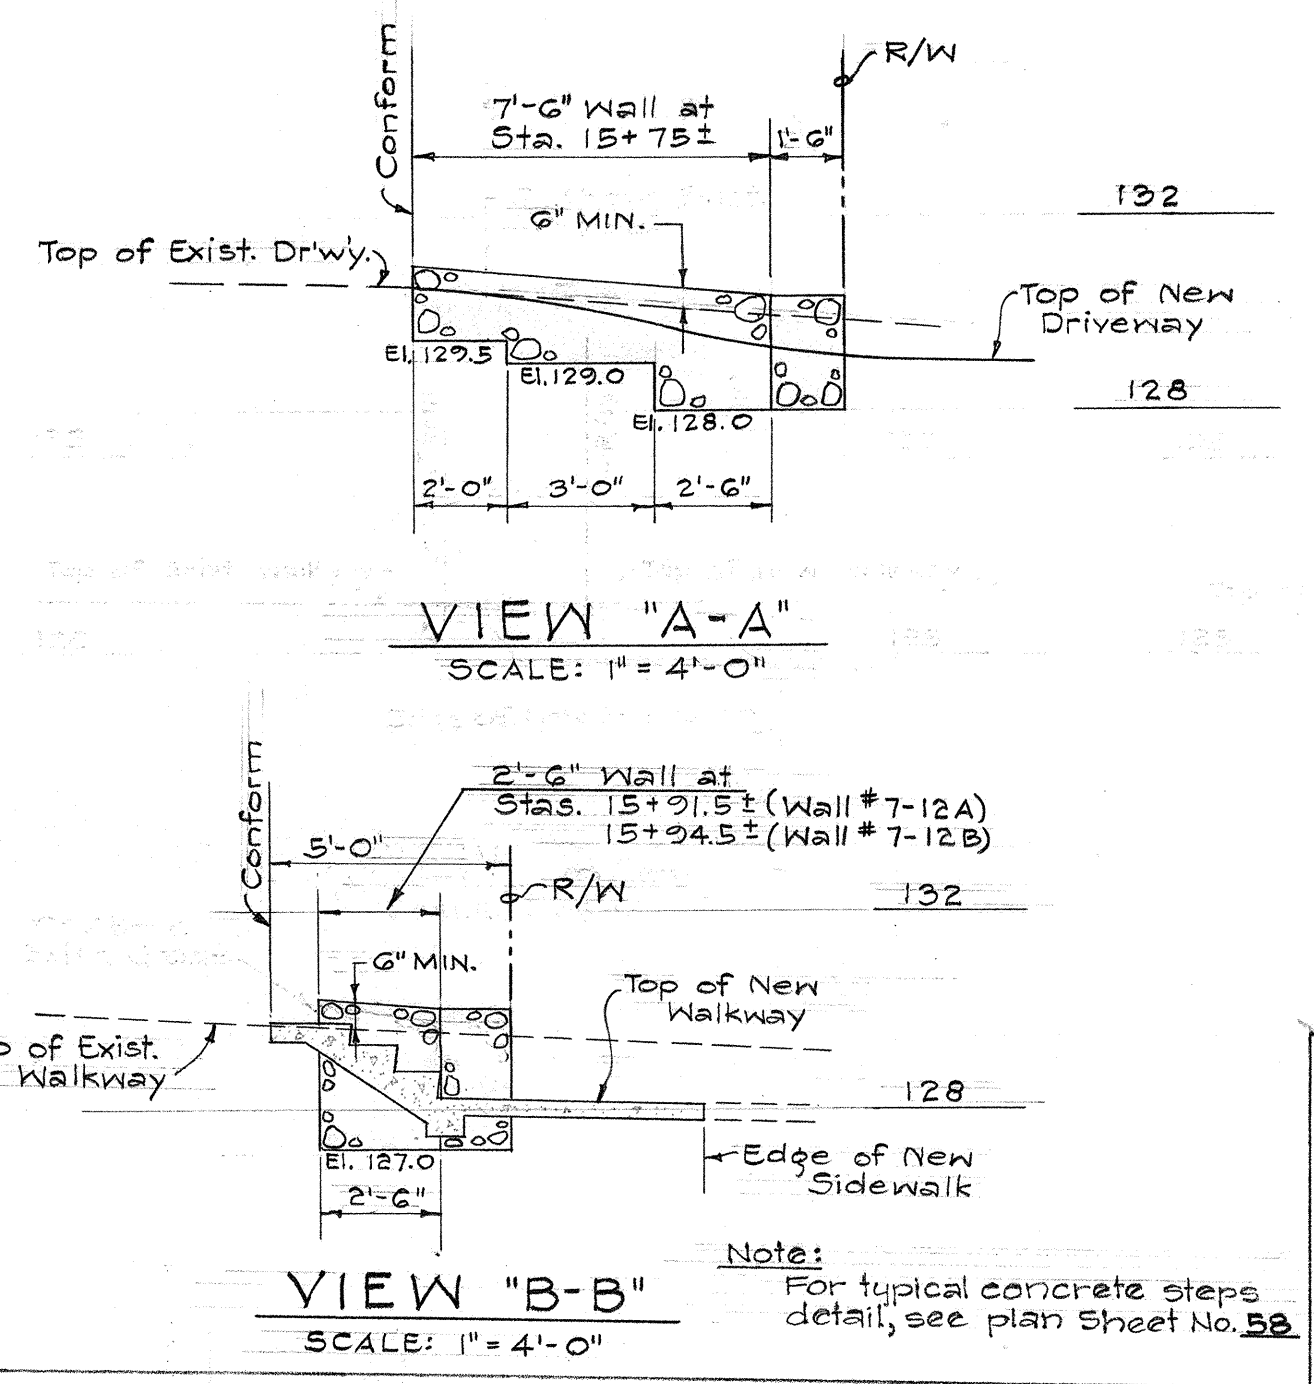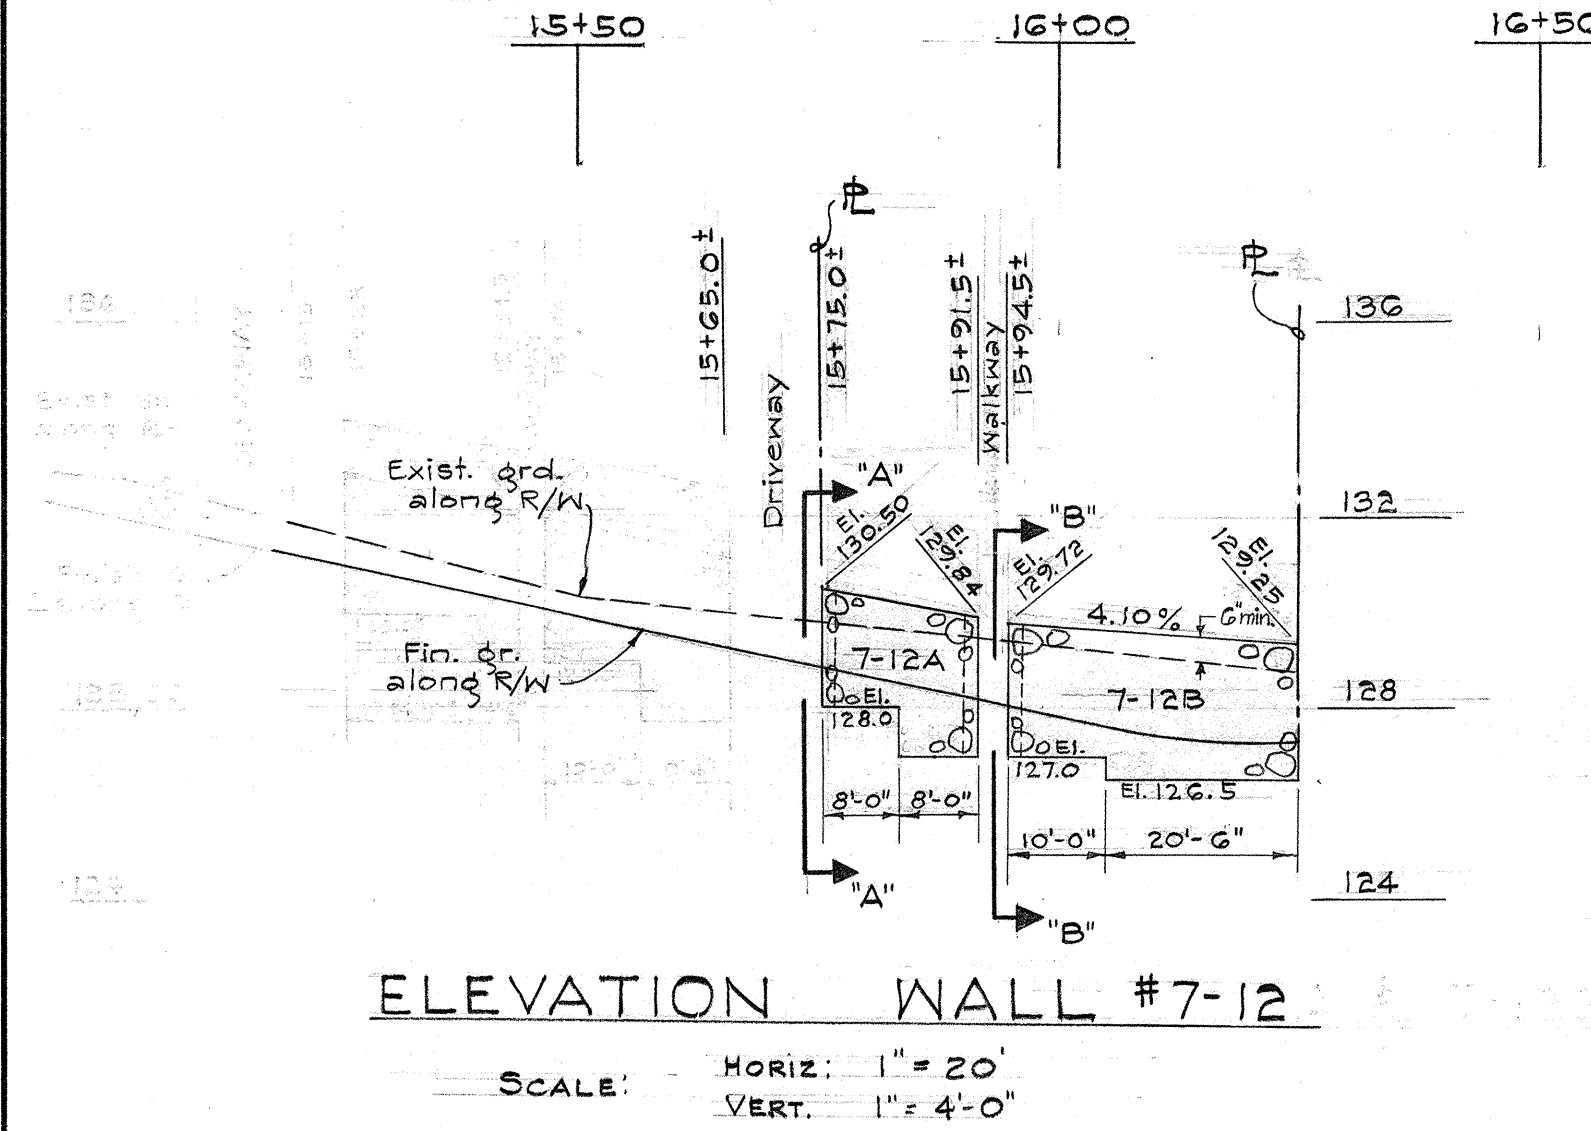

FOR ADDITIONAL PROVISIONS, REFER TO SECTIONS 124 AND 124 B OF THE SPECIAL PROVISIONS.

NOTE:

1. Relocate existing garage to location shown.
2. Dimension of hollow tile garage foundation shall be constructed to fit existing garage.
3. Provide new 2x4 plates. Anchor bolt size and quantity to match existing.
4. Existing posts may be replaced with new matching post at the discretion of the project engineer.
5. Provide electrical connection to existing outlet in garage.
6. New wood material shall be painted with two coats of matching paint.
7. Area shall be cleared of debris after completion of work.
8. Resod all area bared during construction.

RELOCATION OF EXISTING GARAGE
FOR MRS. ELLEN A. KENWAY 1020 12TH AVE.
TMK 3-2-14-36


CONTRACT ITEM NO. 123 B
RELOCATION AND REHABILITATION
OF GARAGE ON LOT TAX KEY 3-2-14-36

STATE OF HAWAII
DEPARTMENT OF TRANSPORTATION
HIGHWAYS DIVISION
**RELOCATION AND REHABILITATION
OF GARAGE ON
LOT TAX KEY: 3-2-14-36**
AND
DETAILS OF WALLS 7-10, 7-11A,
7-11B, 7-11C, 7-12A AND 7-12B.
LUNALILO FRWY. PROJ. NO. I-14-14:24
Scale: As Shown April 1963
SHEET No. OF SHEETS

DATE: _____
DRAWN BY: _____
CHECKED BY: _____
DESIGNED BY: _____
NOTED BY: _____
QUANTITIES BY: _____
CHECKED BY: _____


FED. ROAD DIST. NO.	STATE	FED. AID PROJ. NO.	FISCAL YEAR	SHEET NO.	TOTAL SHEETS
HAWAII	HAW.	1-H-14	1963	58	217

Revised: July 8, 1964

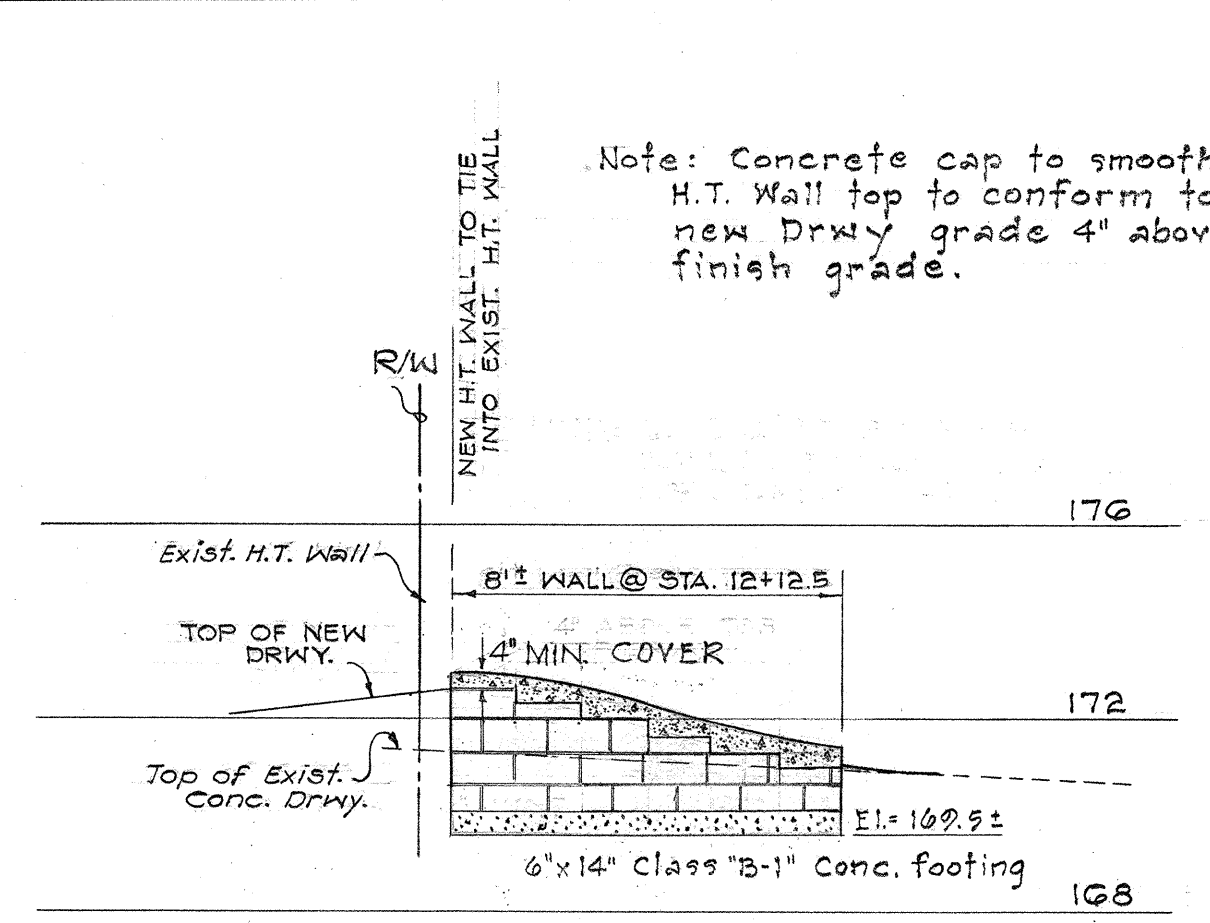


ELEVATION - WALL #3-10
Scale: 1" = 4'-0"


3RD AVENUE

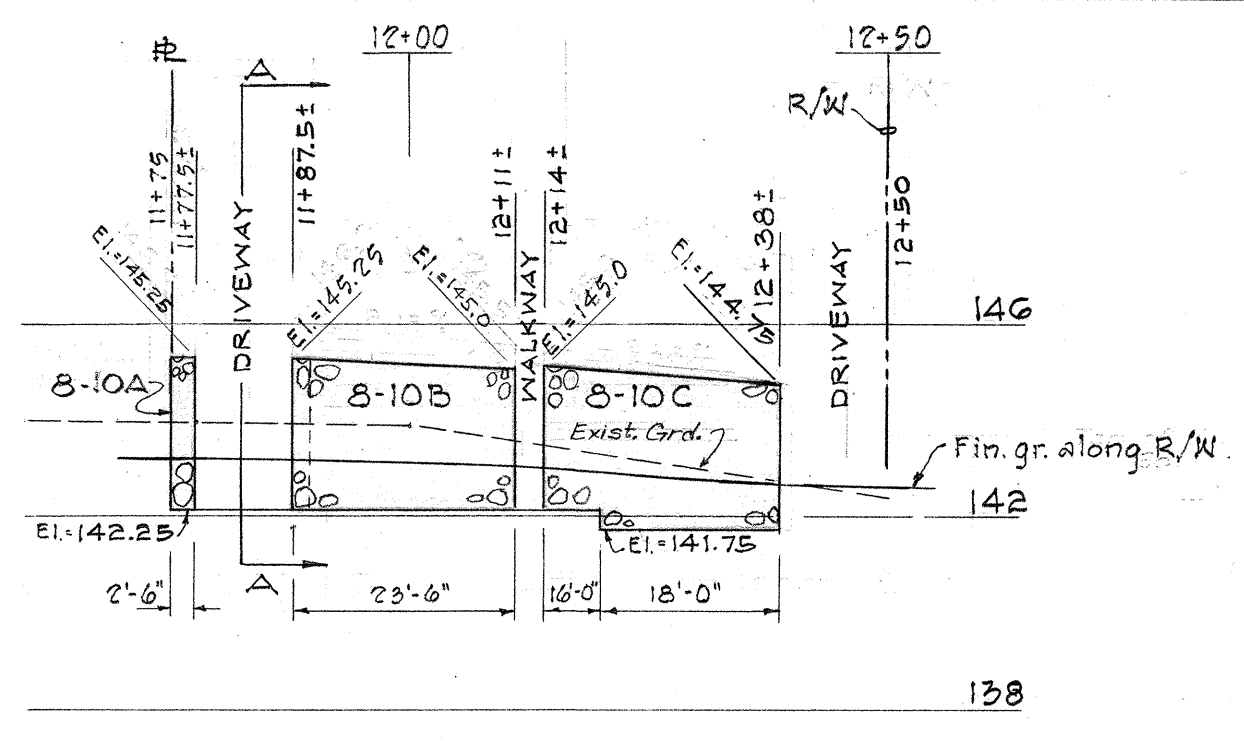

ELEVATION - WALL #8-10
Scale: Hor. 1" = 20'-0"
Ver. 1" = 4'-0"

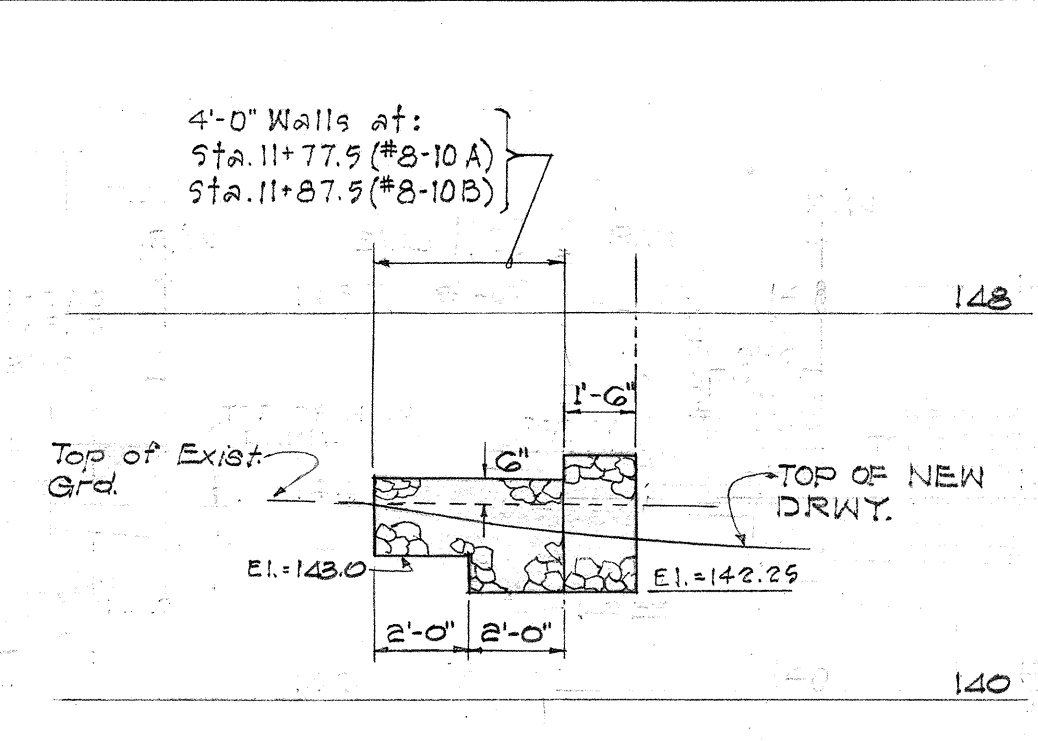


VIEW A-A
Scale: 1" = 4'-0"

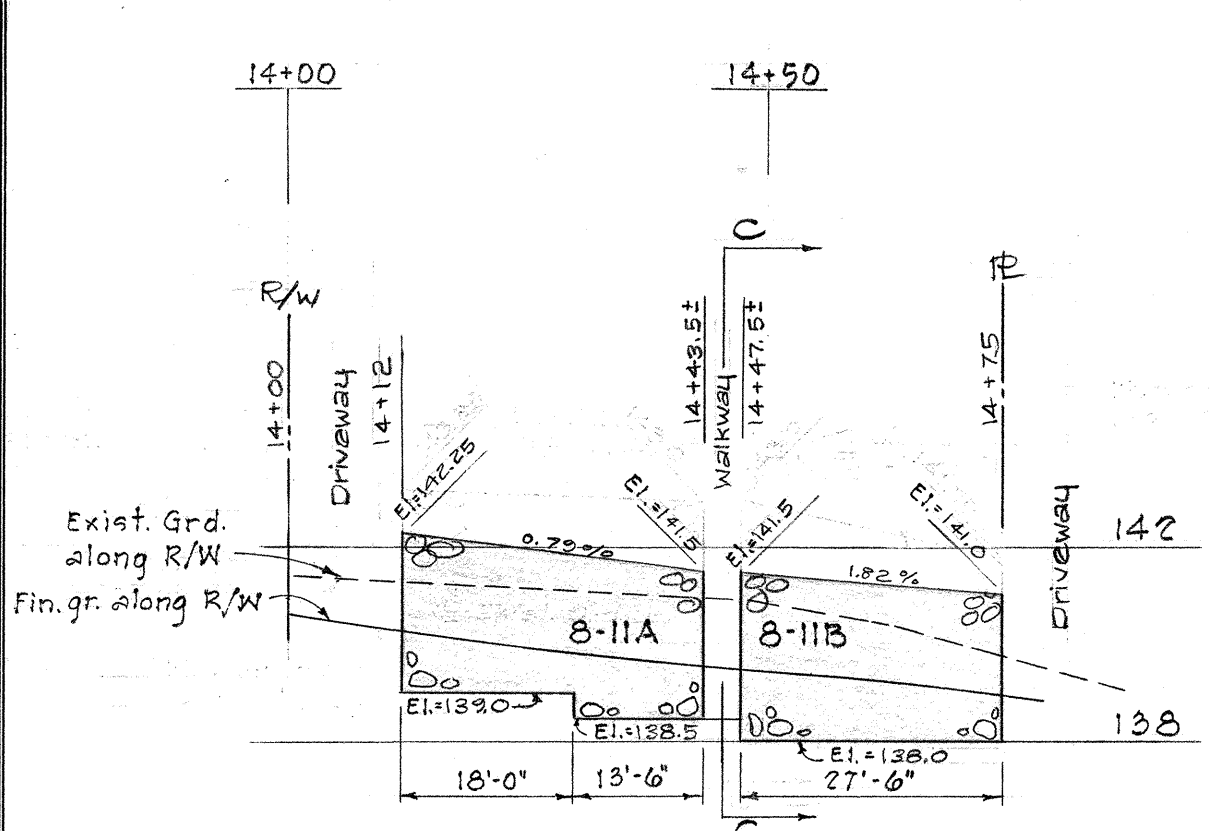


ELEVATION - WALL #8-11
Scale: Hor. 1" = 20'-0"
Ver. 1" = 4'-0"

8TH AVENUE

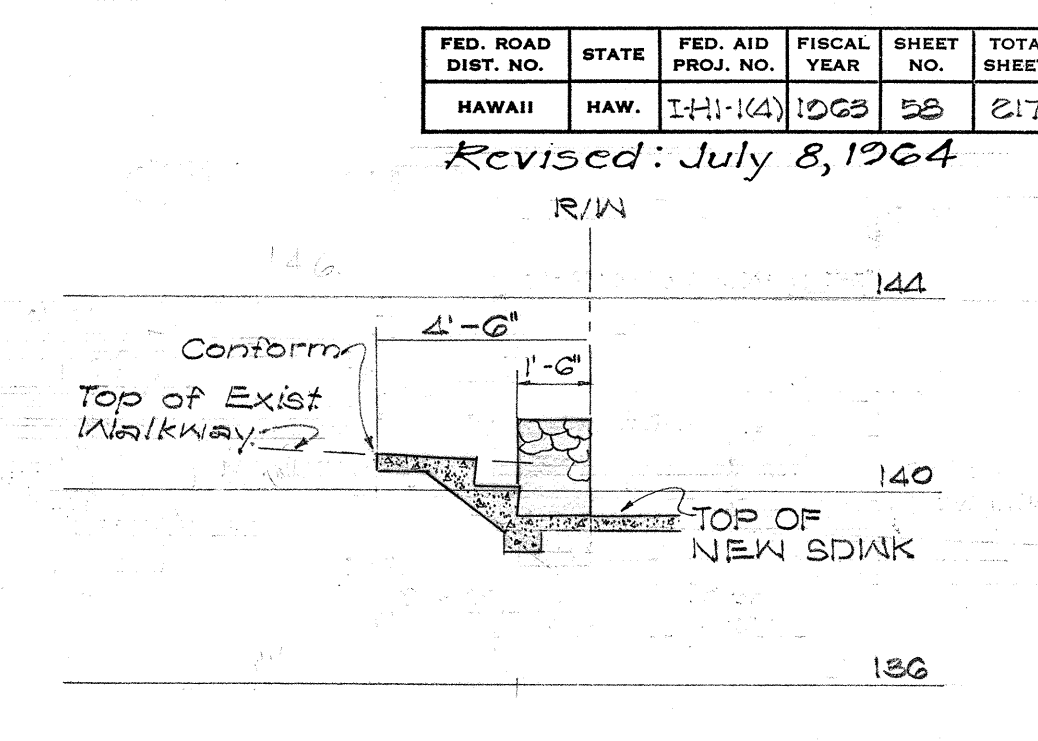


VIEW C-C
Scale: 1" = 4'-0"


WALL No. 11-B & 11-C ELIMINATED.
See Detail Plan Sheet No. 28AS
For Revision Dated July 8, 1964

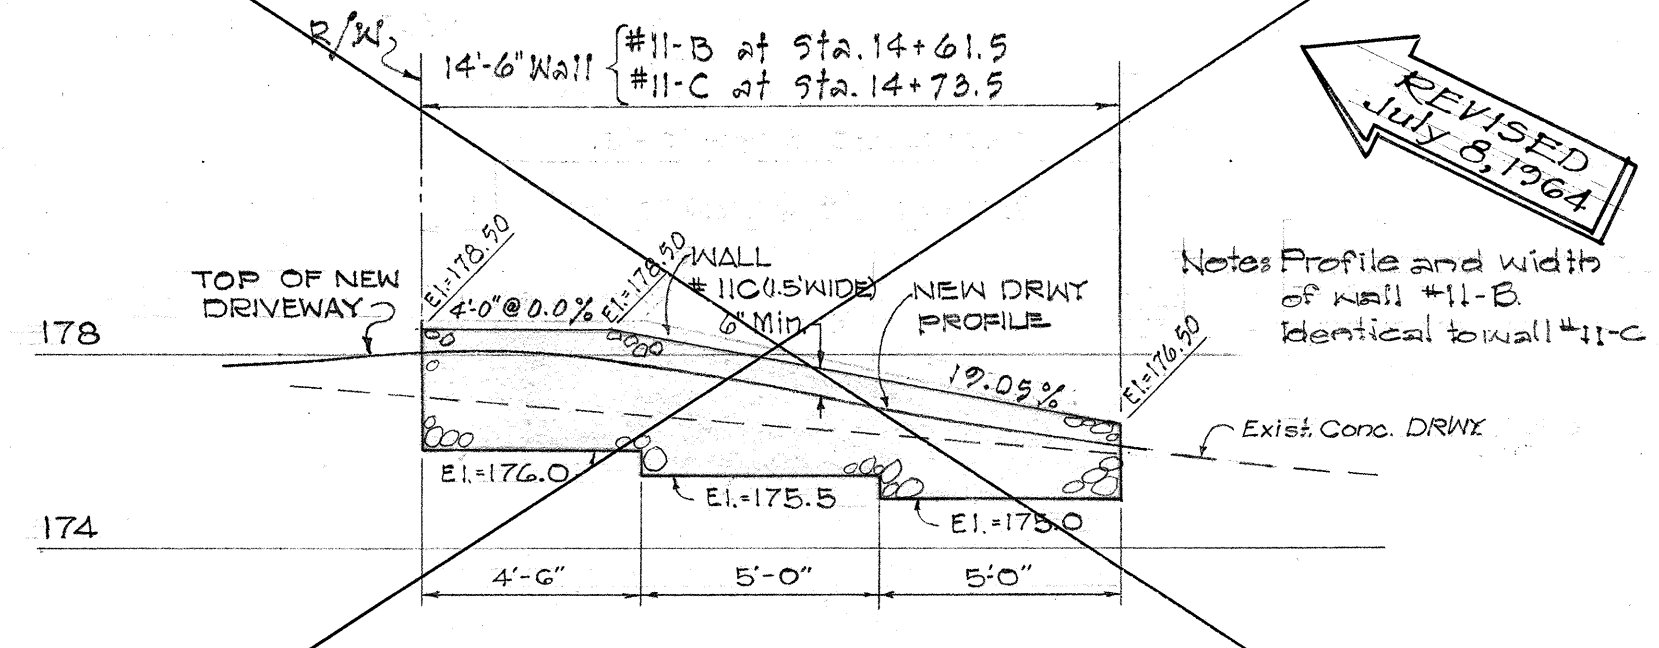


PROFILE OF C.R.M. WALL #11-B & 11-C ALONG DRIVEWAY AT 11TH AVE STA. 14+67(R)
Scale: 1" = 4'-0"

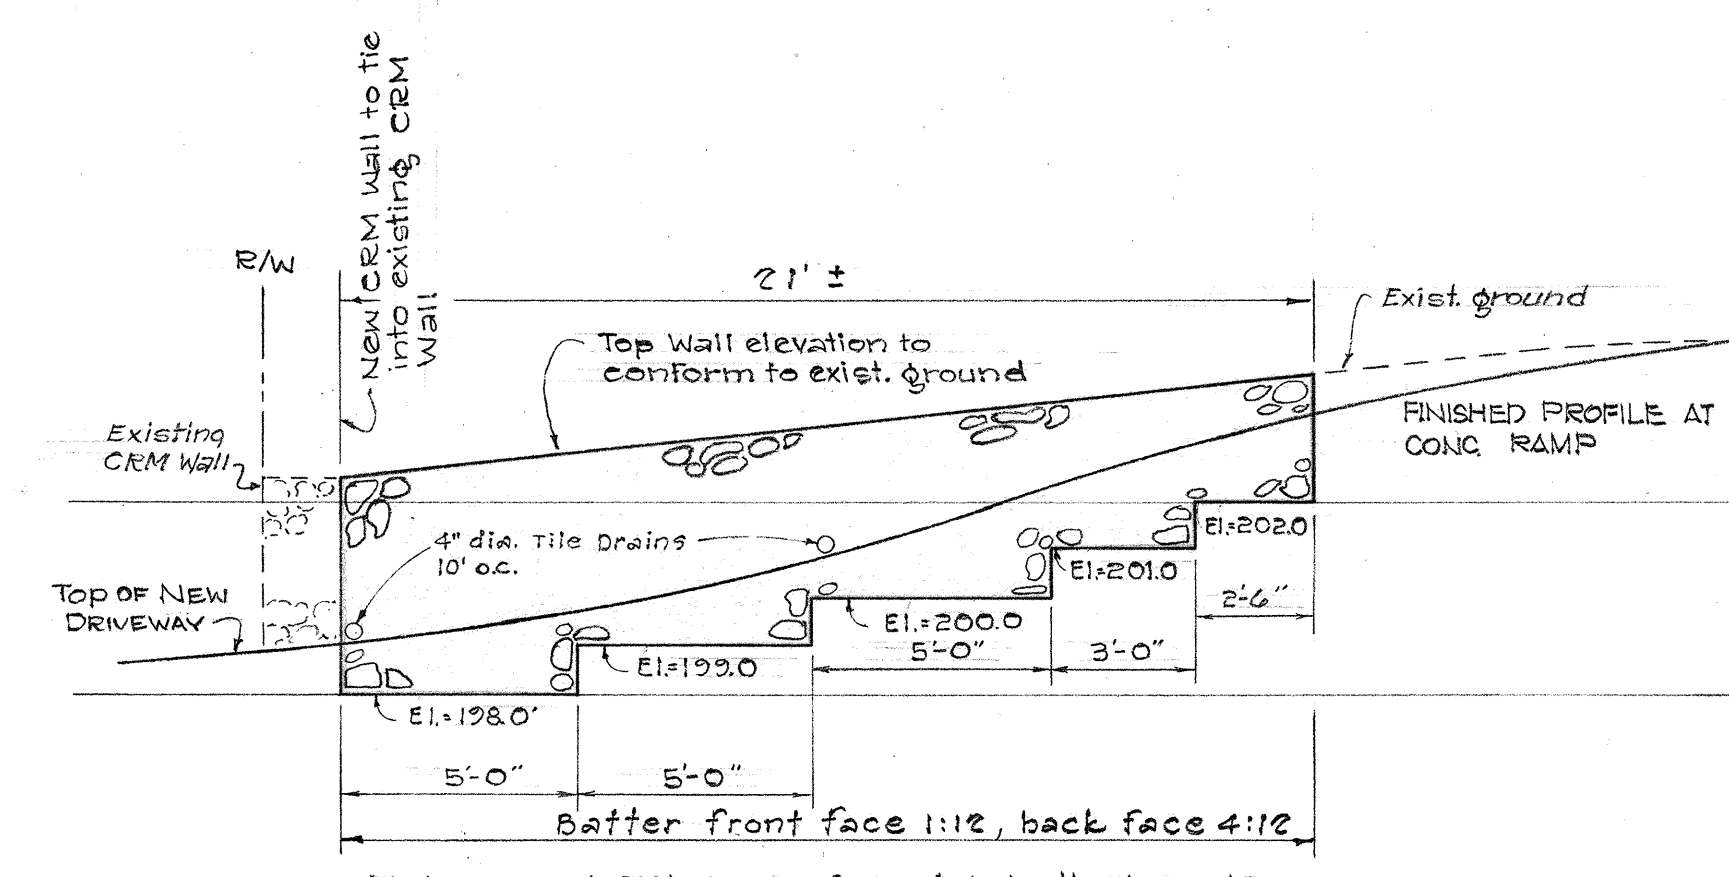


ELEVATION WALL #12-B
Scale: 1" = 4'-0"

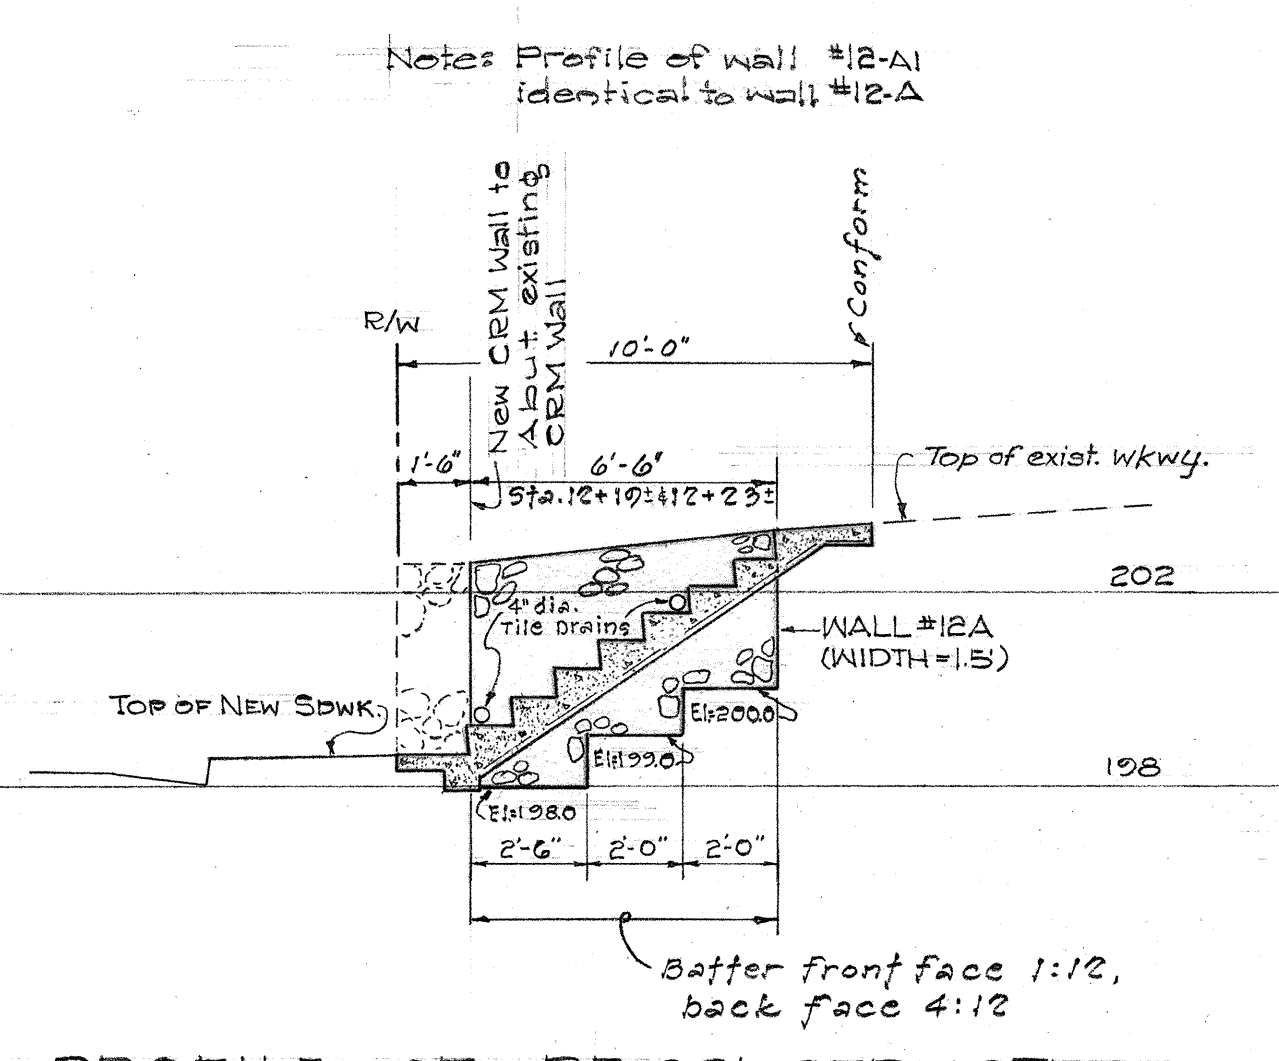


PROFILE OF RECONSTRUCTED CONC STEP AT STA. 12+27(L)
Scale: 1" = 4'-0"

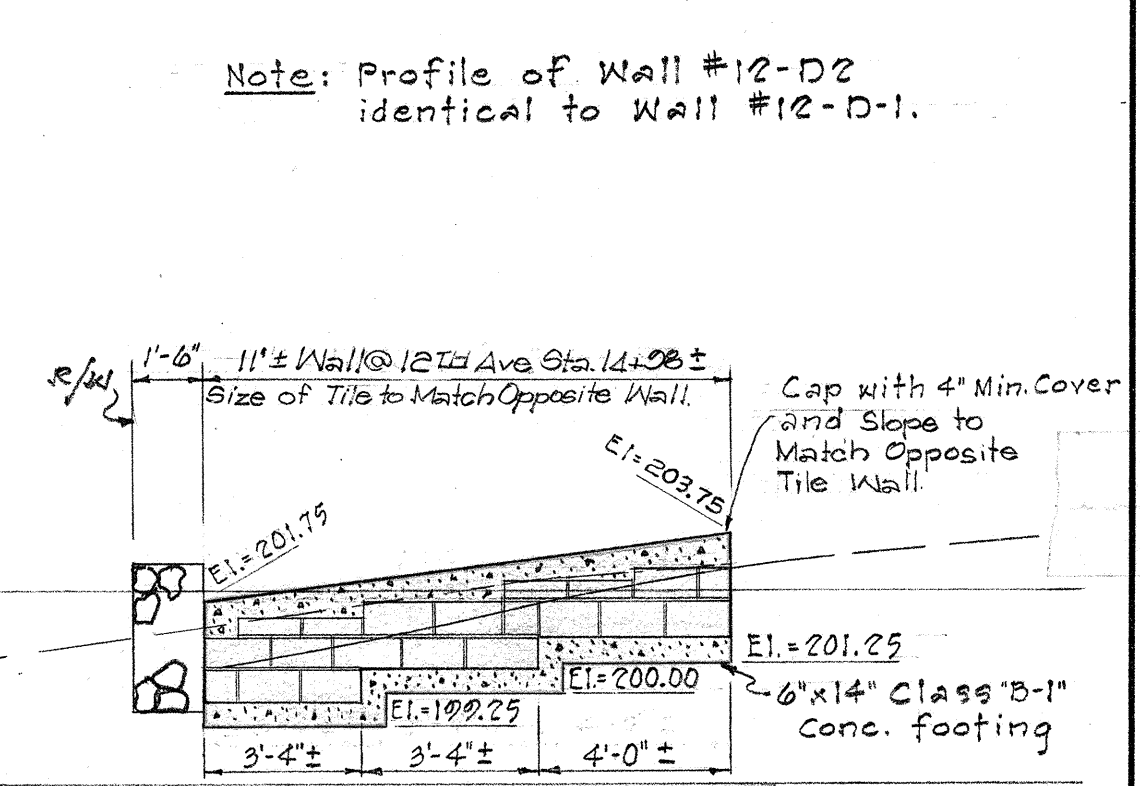


ELEVATION - WALL #12-D2
Scale: 1" = 4'-0"

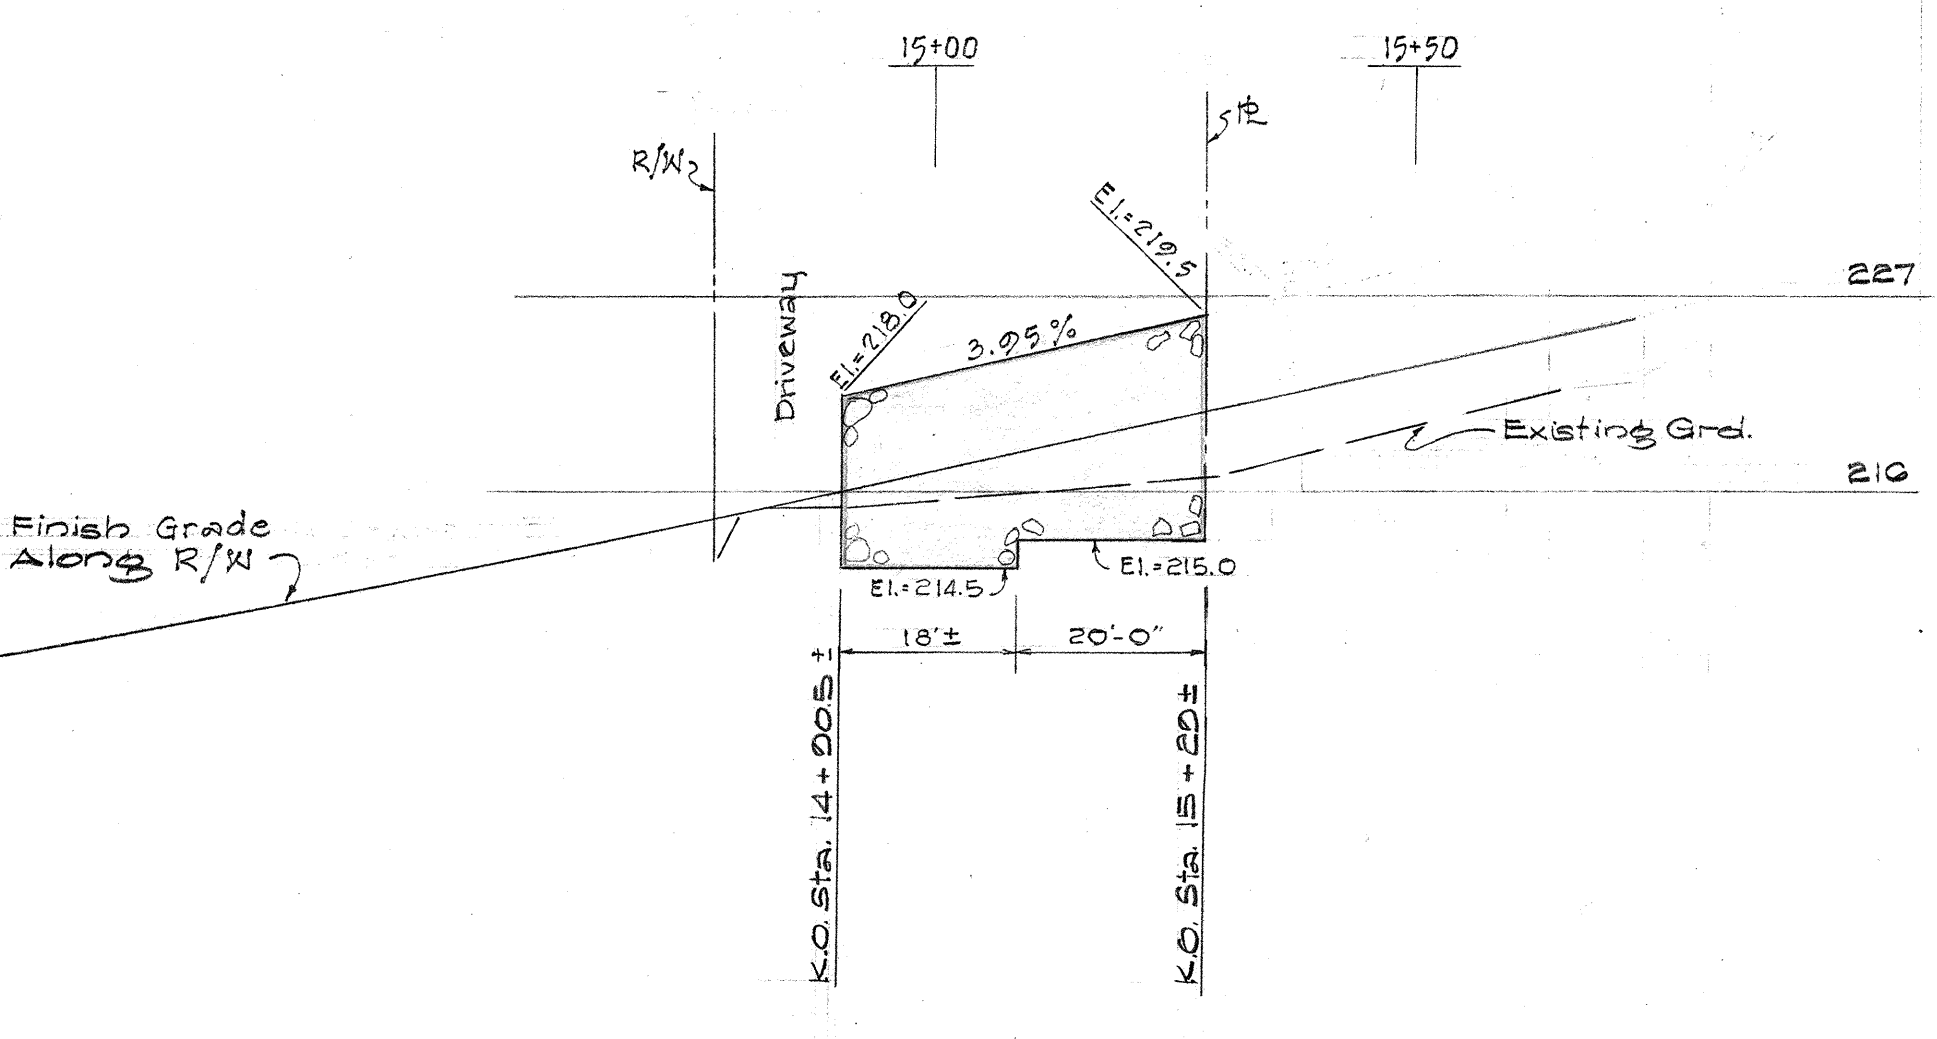

PROFILE OF C.R.M. WALL #K.O.-1
Scale: Horiz. 1" = 20'-0"
Ver. 1" = 4'-0"

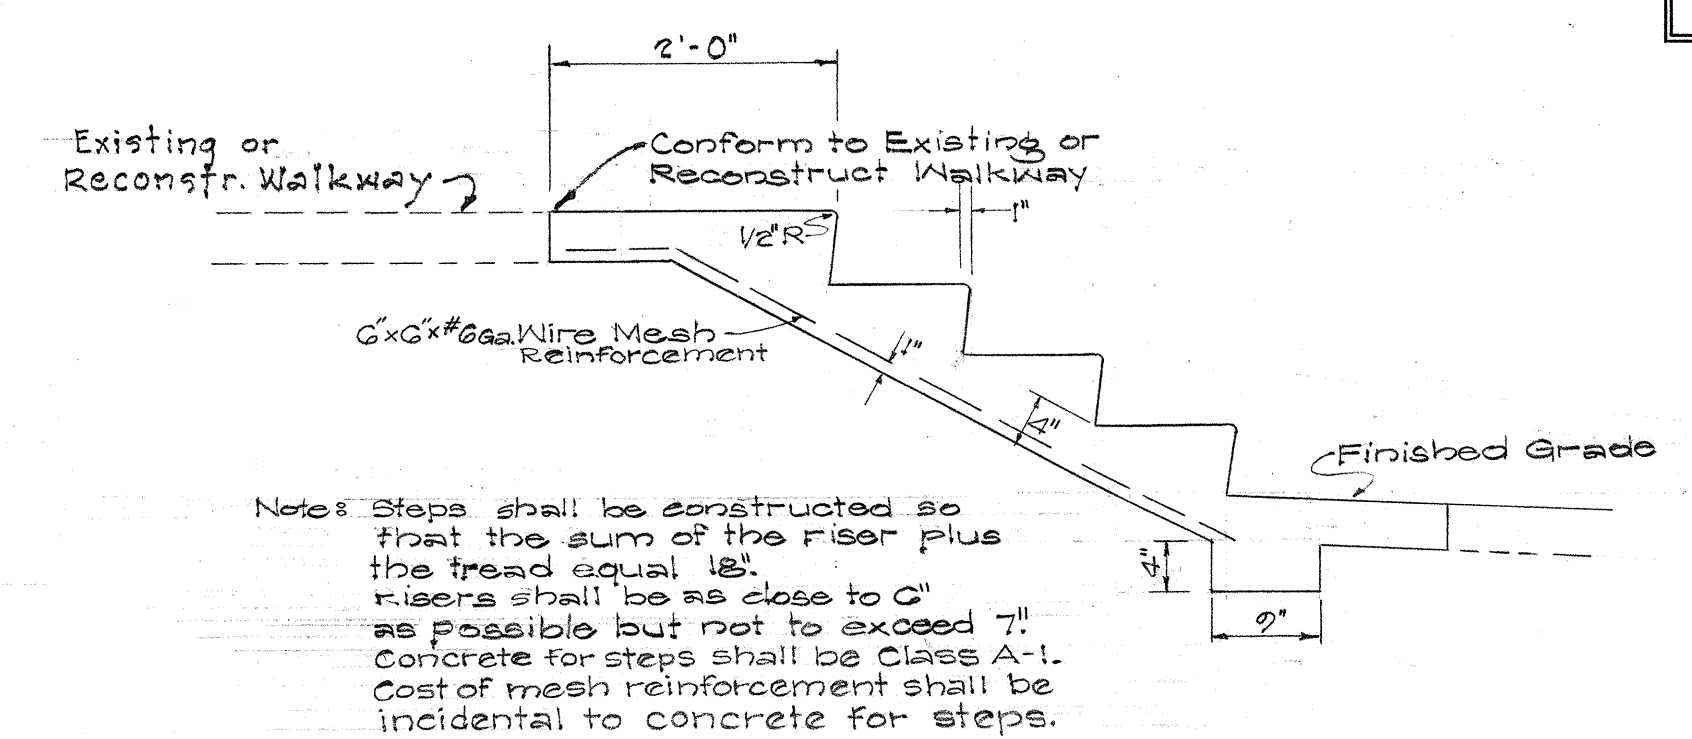

TYPICAL CONCRETE STEPS DETAIL
Scale: 3/4" = 1'-0"

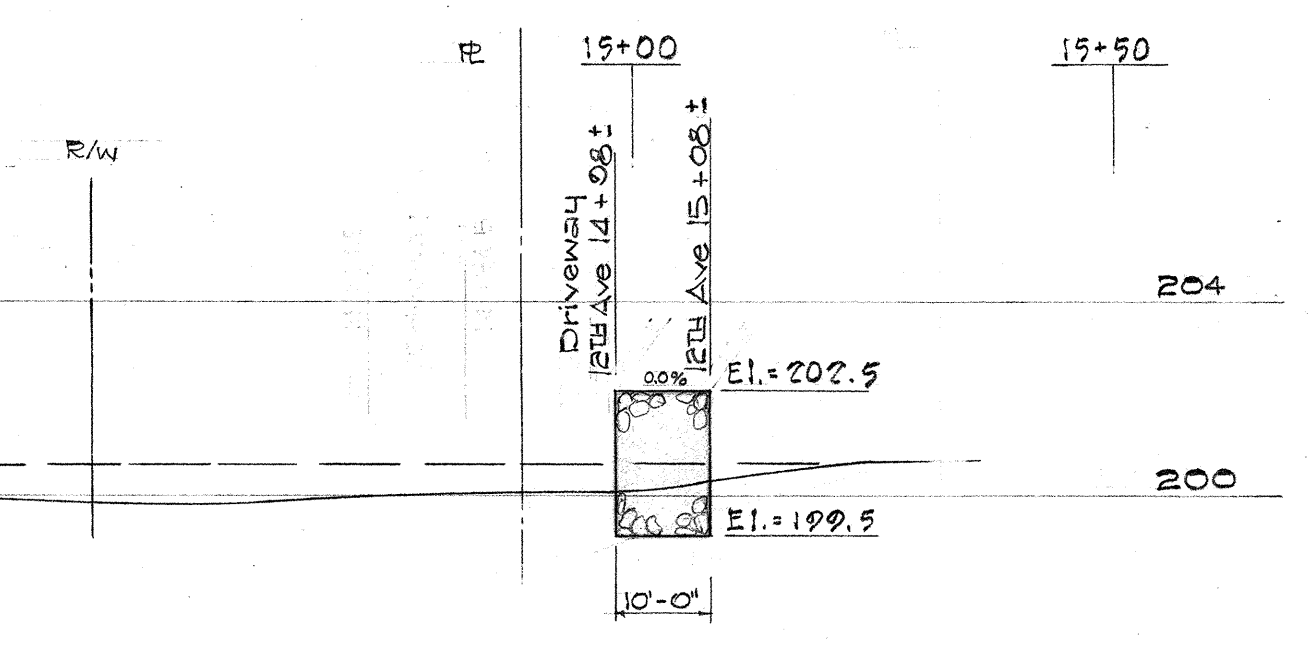

ELEVATION WALL #12-C
Scale: Hor. 1" = 20'-0"
Ver. 1" = 4'-0"

STATE OF HAWAII
DEPARTMENT OF TRANSPORTATION
HIGHWAYS DIVISION

DETAILS OF CONC. STEPS & RETAINING WALLS ALONG 3RD, 8TH, 11TH, 12TH AND KOKO HEAD AVENUES

LUNALILO FREEWAY PROJ. No. 1-H-1(4):24

Scale: As shown Date: April, 1963


SHEET No. OF SHEETS

This Sheet Supersedes Sheet No. 585


DATE	1964
DESIGNED BY	...
CHECKED BY	...
NOTED BY	...
QUANTITIES BY	...
NO.	...

FED. ROAD DIST. NO.	STATE	FED. AID PROJ. NO.	FISCAL YEAR	SHEET NO.	TOTAL SHEETS
HAWAII	HAW.	1-HI-14	1963	30	317

Revised: Dec. 3, 1963
Revised: July 2, 1964

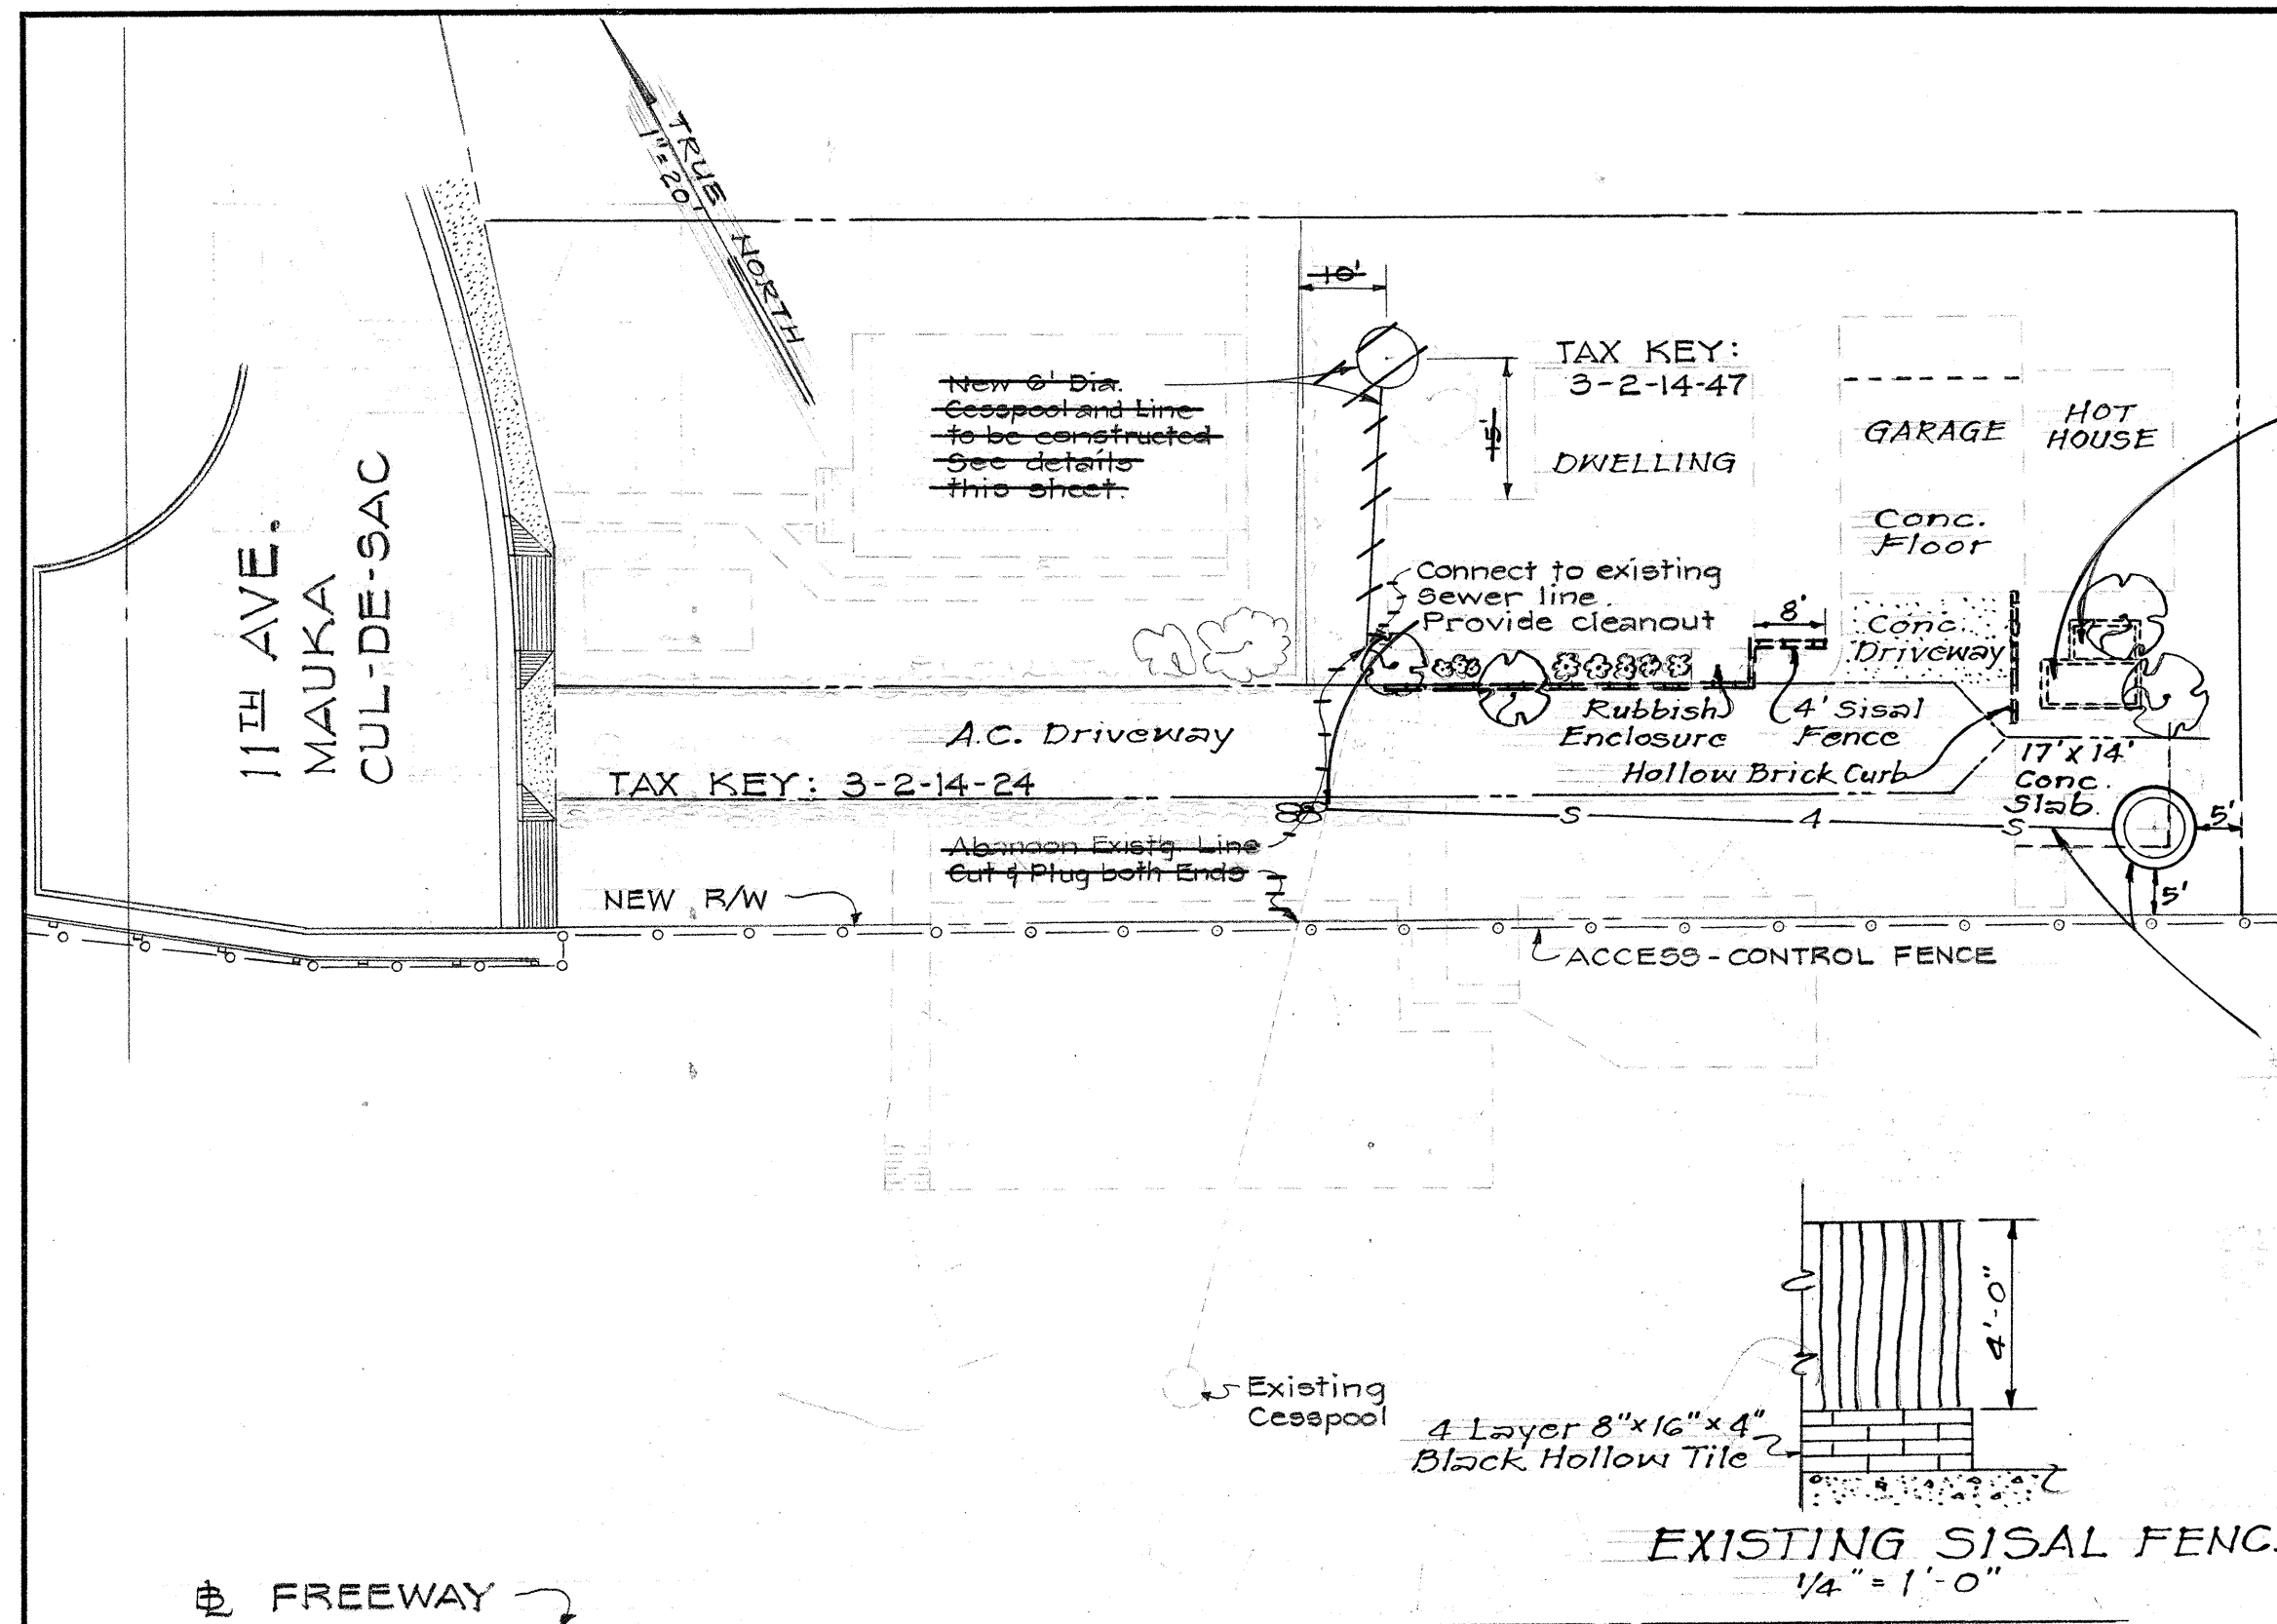


New 6" Dia. Cesspool and line to be constructed. See details this sheet.

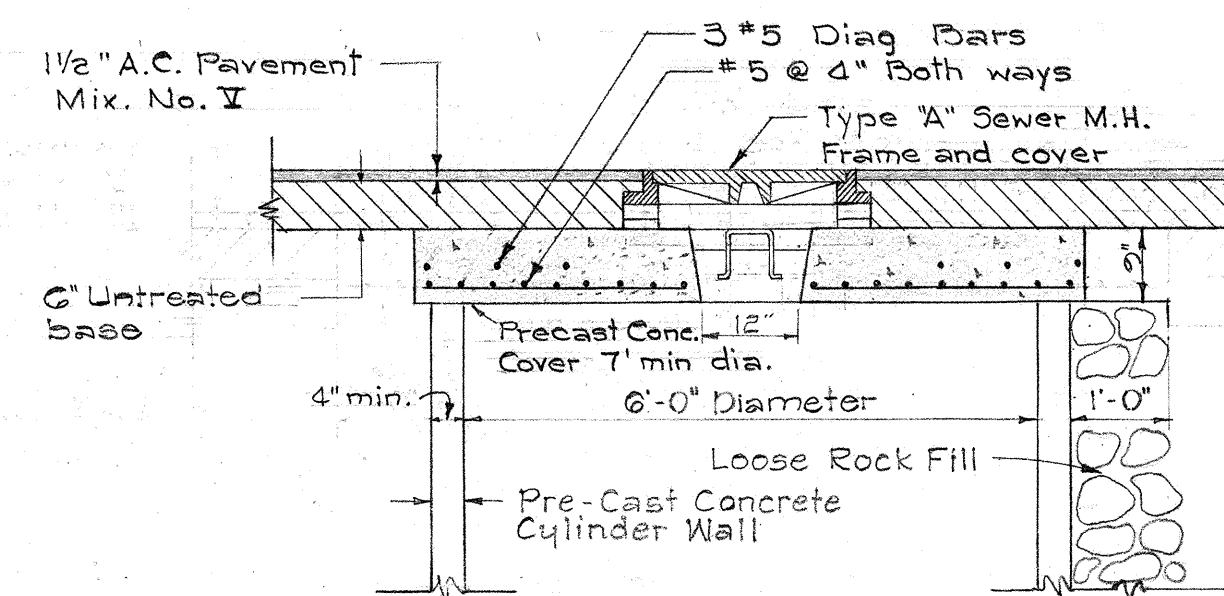


DETAIL OF COVER FOR 6" DIA. CESSPOOL

Scale: 1/2" = 1'-0"

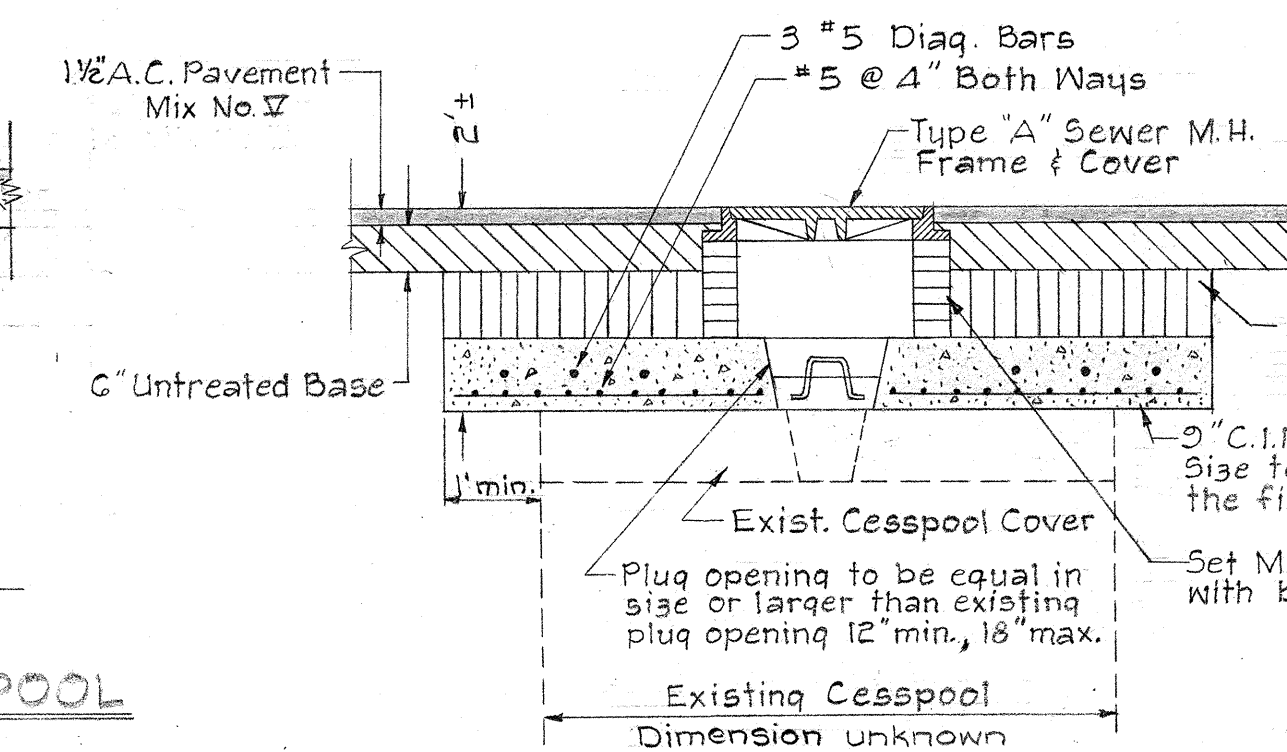

DETAIL OF REINFORCED CONCRETE COVER OVER EXISTING CESSPOOL

Scale: 1/2" = 1'-0"

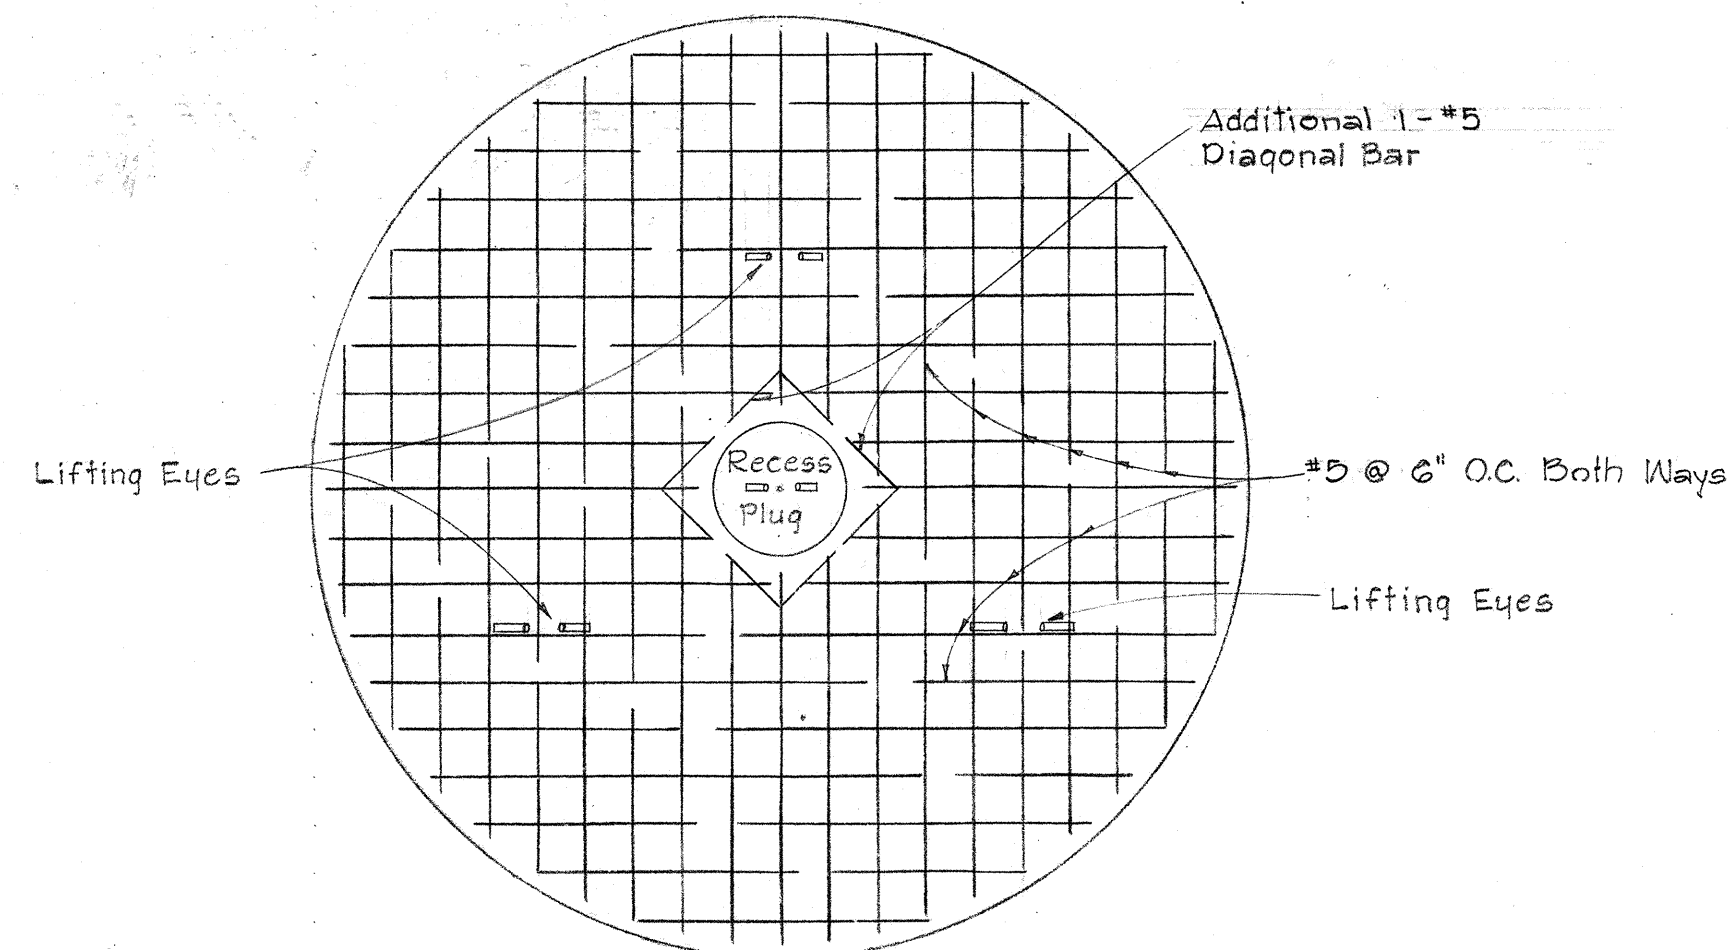

DETAIL OF COVER FOR 8" DIA. CESSPOOL

Scale: 1/2" = 1'-0"

GENERAL NOTES:

- Cesspool to be constructed in accordance with Board of Health Regulations.
- No cover shall be placed over cesspool until Diameter, Depth, and/or other dimensions have been inspected and approved by the Board.
- Concrete shall be Class B-1.
- Reinforcing: round deformed bars, new billet stock intermediate grade, ASTM A15. All hooked bars shall have ACI std. hook unless otherwise shown.
- Existing Cesspools will not be demolished until the new cesspools are constructed and lines connected.
- For the 6" cesspool to be constructed on Lot Tax Key No. 3-2-14-24 delete the A.C. paving and untreated base above the cover and in lieu thereof place a minimum top soil cover of 12".

STATE OF HAWAII
DEPARTMENT OF TRANSPORTATION
HIGHWAYS DIVISION

DETAILS FOR
CONSTRUCTION OF CESSPOOLS
AND CESSPOOL COVERS

Lunalilo Freeway
Scale: As shown

Proj. No. 1-HI-14:24
April 1963

SHEET No. OF SHEETS

This sheet supersedes sheet No. 525

59