

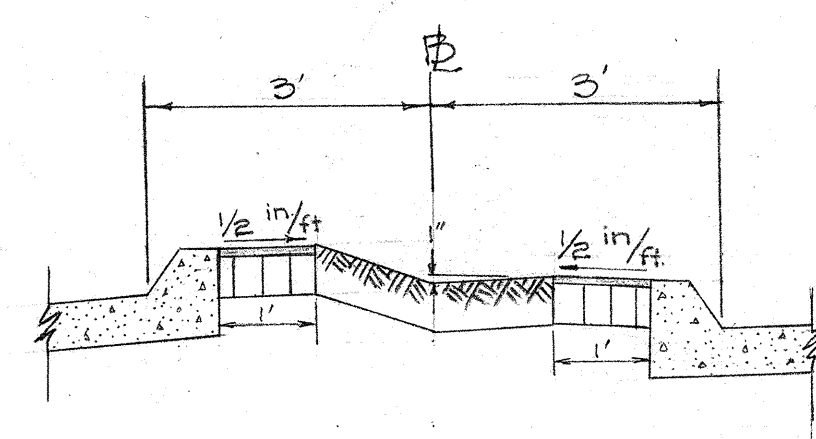
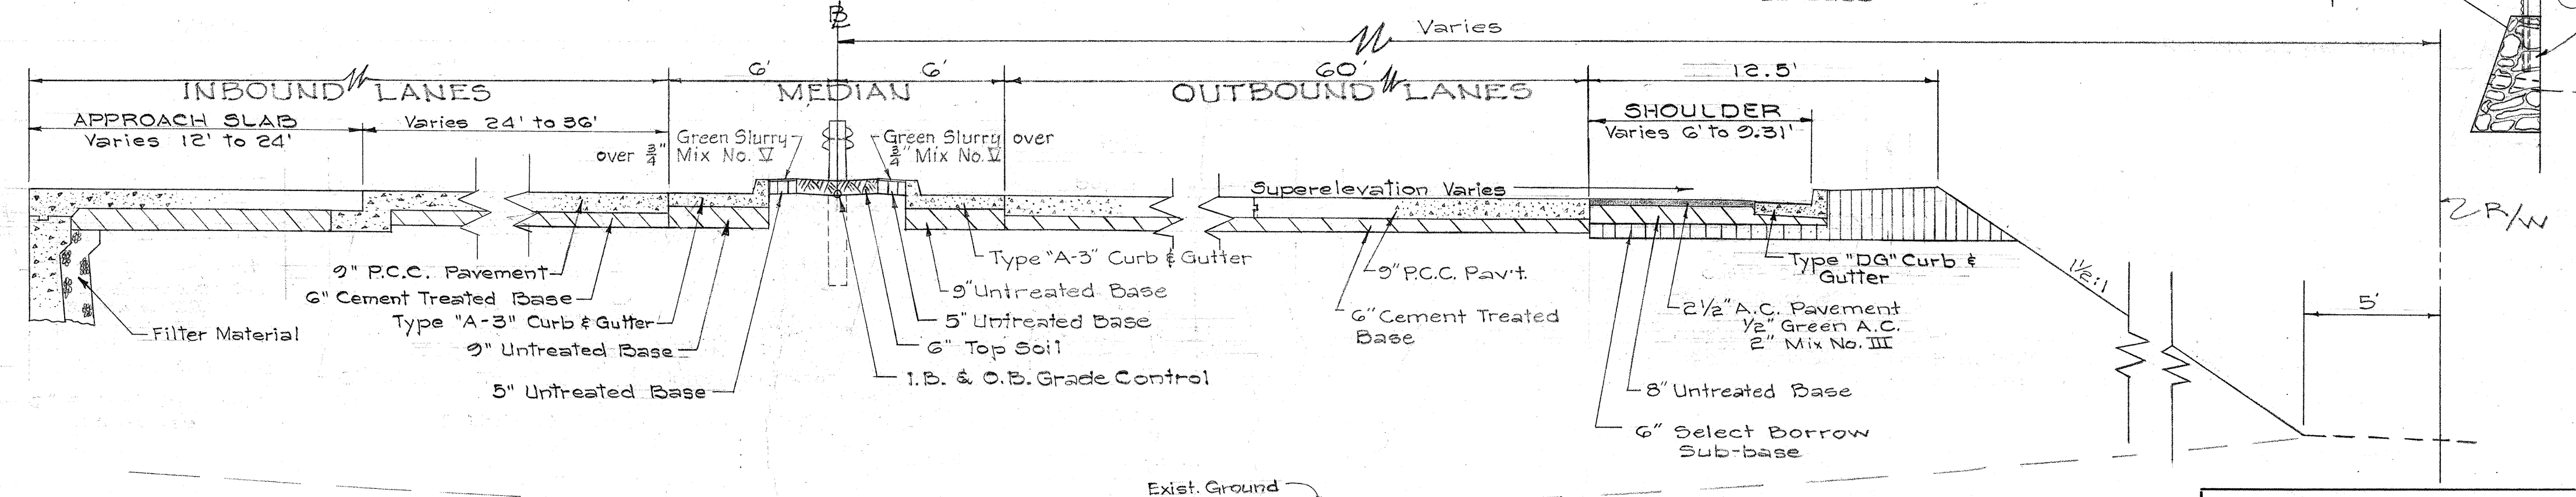
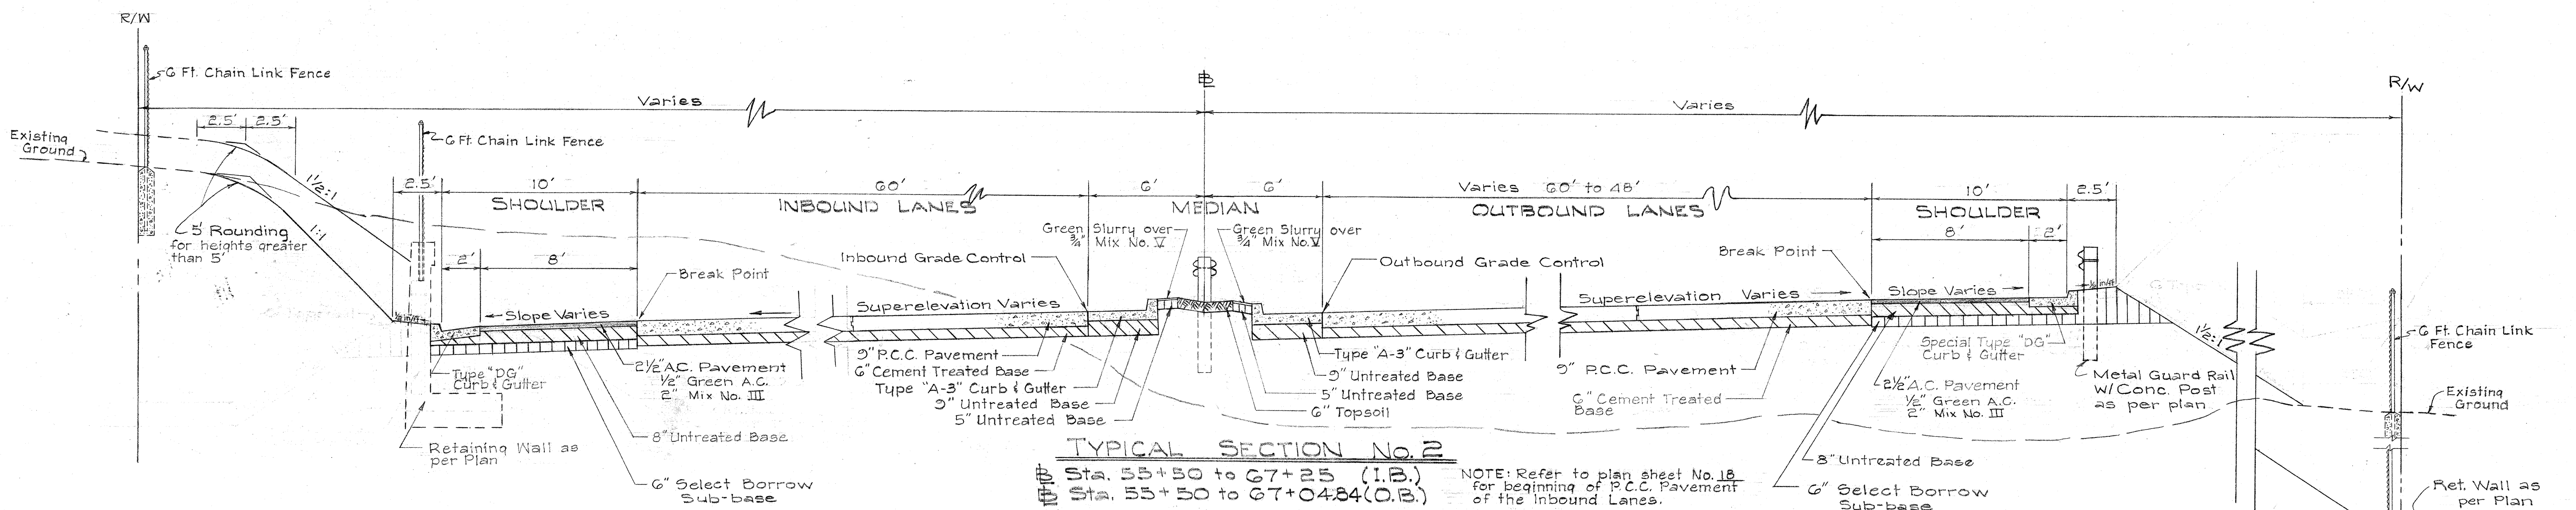
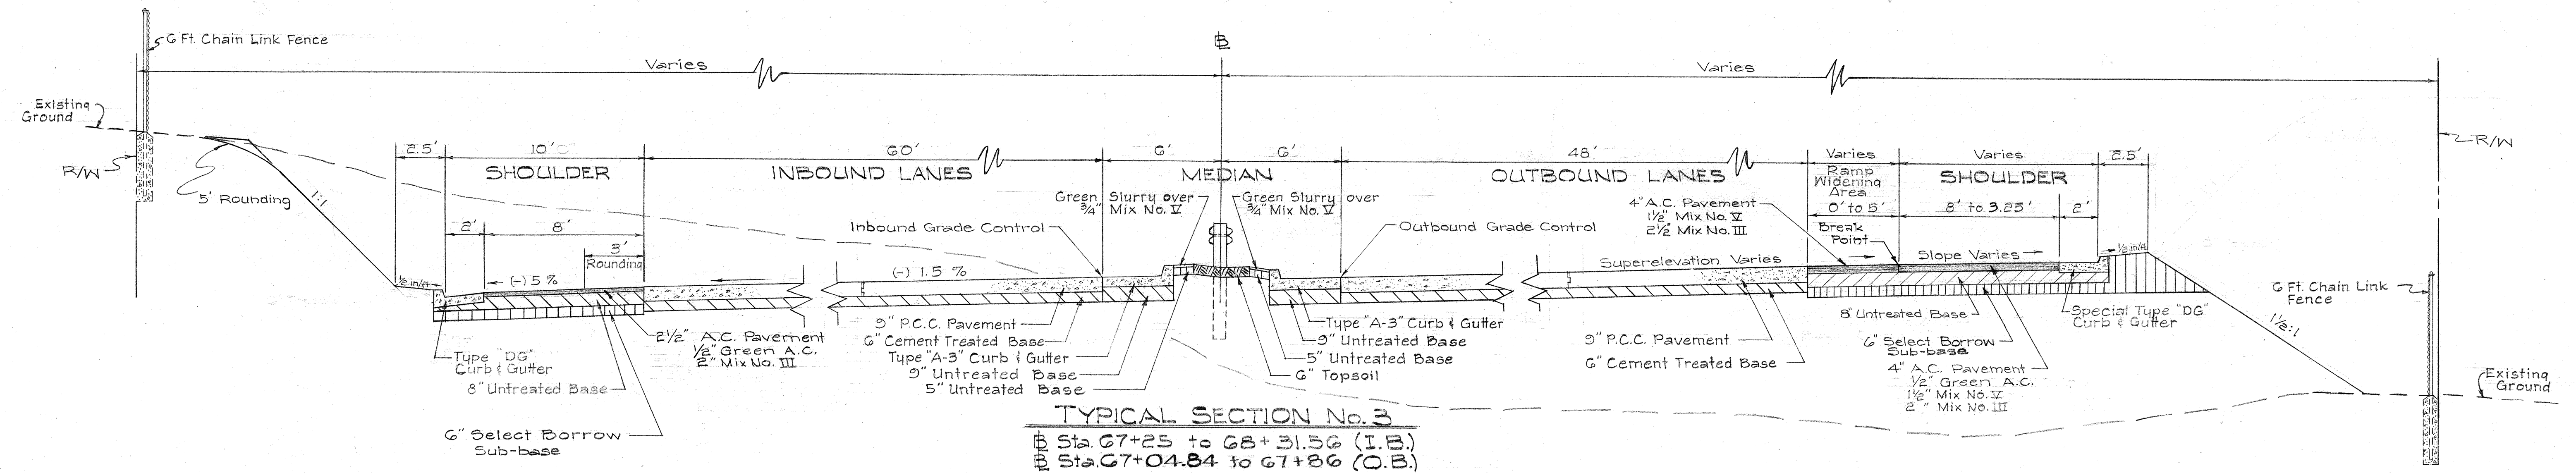
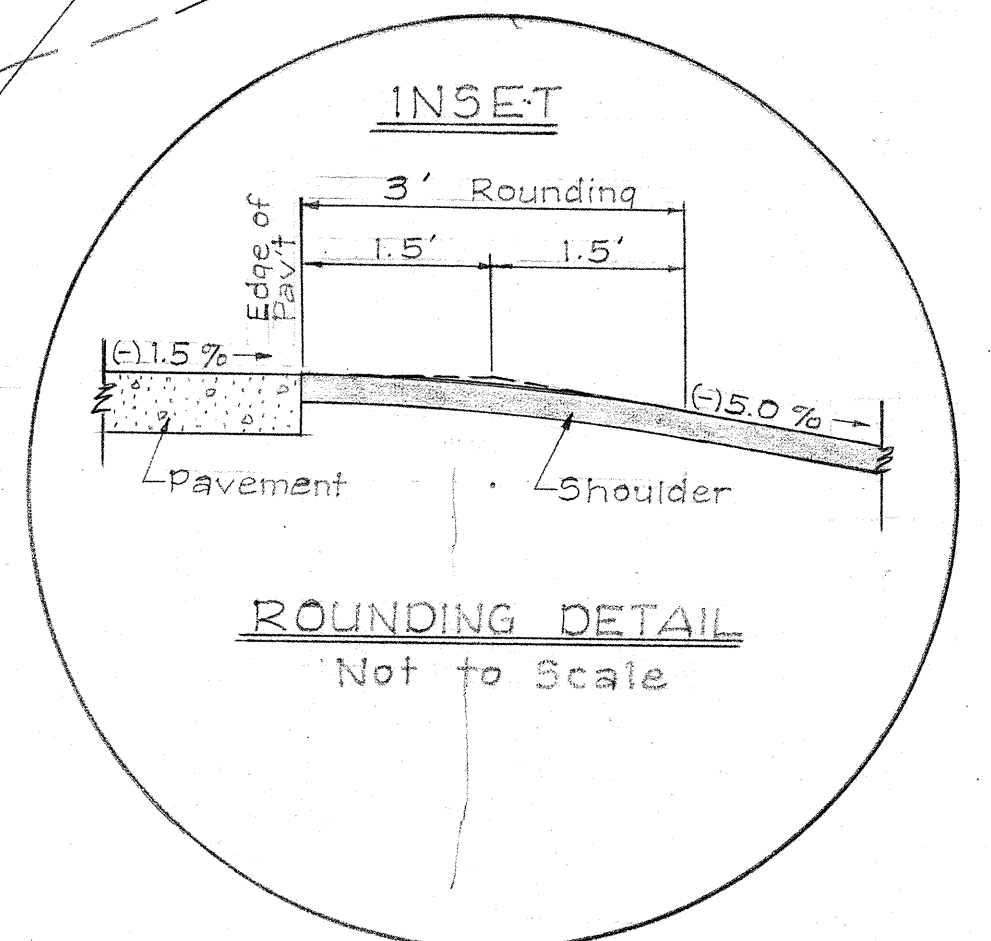
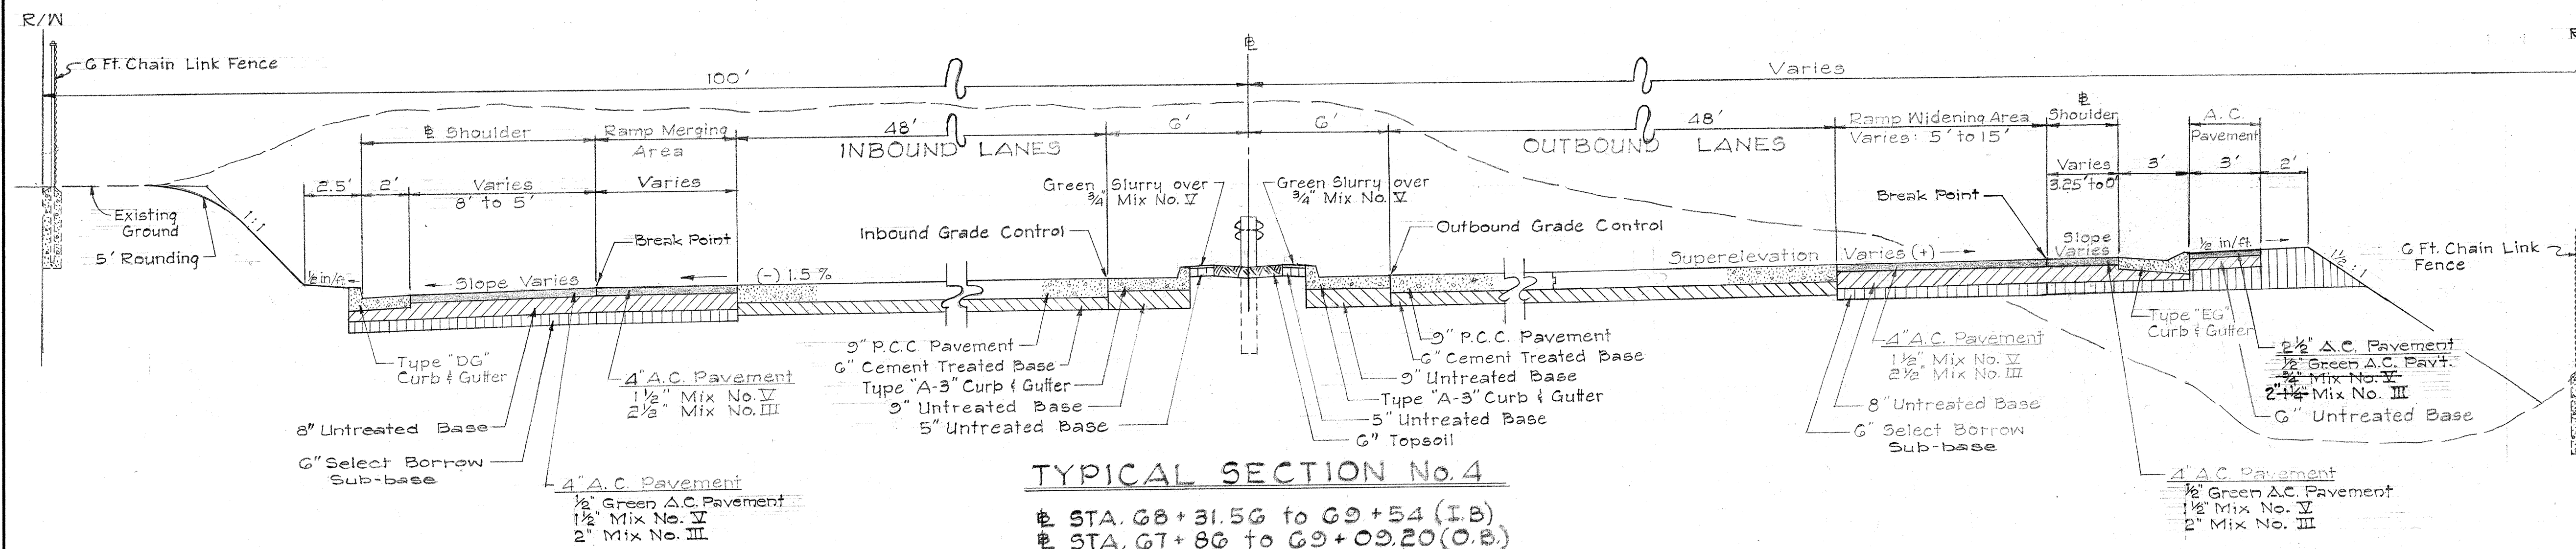





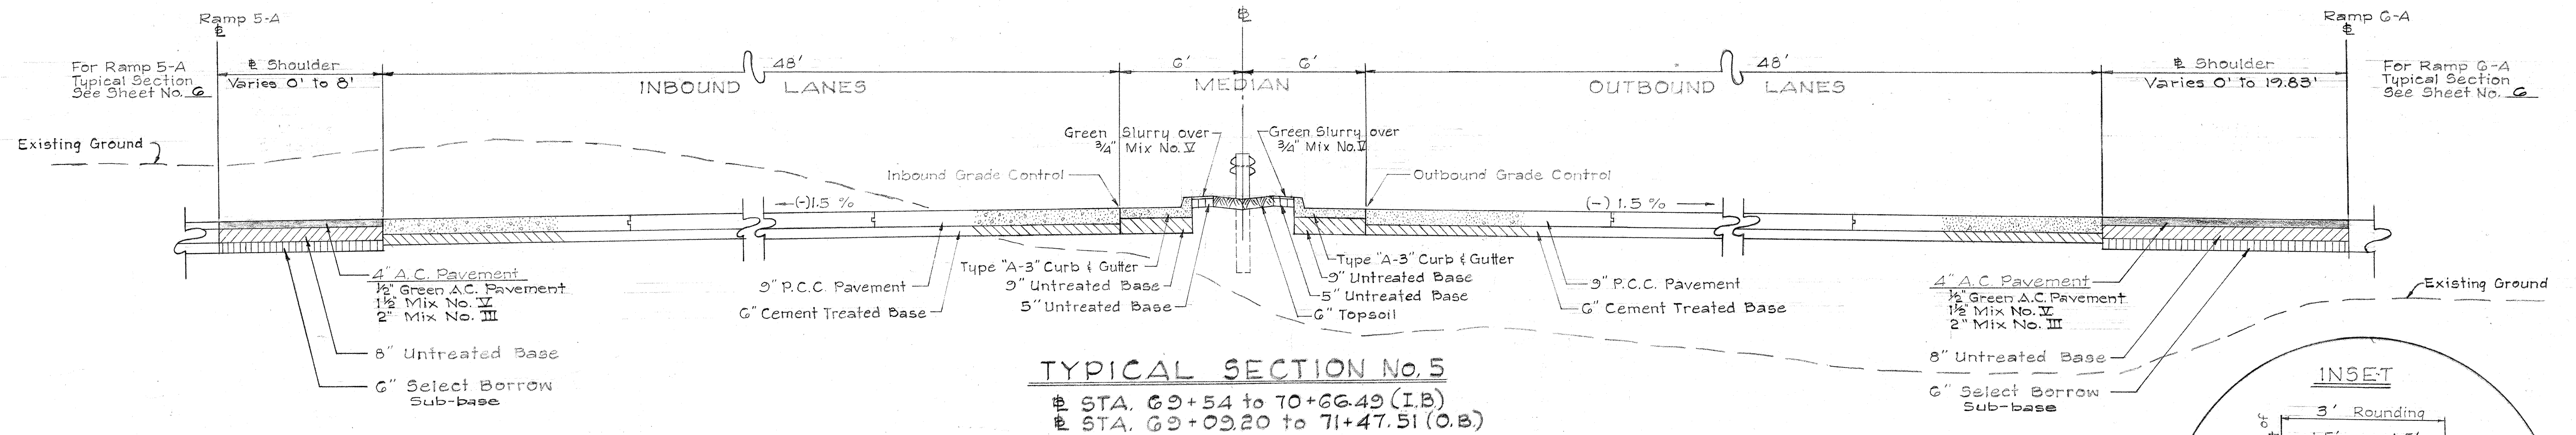


STATE OF HAWAII
 DEPARTMENT OF TRANSPORTATION
 HIGHWAYS DIVISION
LUNALILO FREEWAY
 F.A.I. PROJ. No. I-HI-1(4):24
TYPICAL SECTIONS
 Scale: 1/4" = 1'-0" Date: Sept. 14, 1962
 SHEET No. OF SHEETS

DATE: _____
 SURVEY PLOTTED BY: _____
 PLAN: _____
 DESIGNED BY: _____
 NOTE BOOK: _____
 QUANTITIES BY: _____
 CHECKED BY: _____

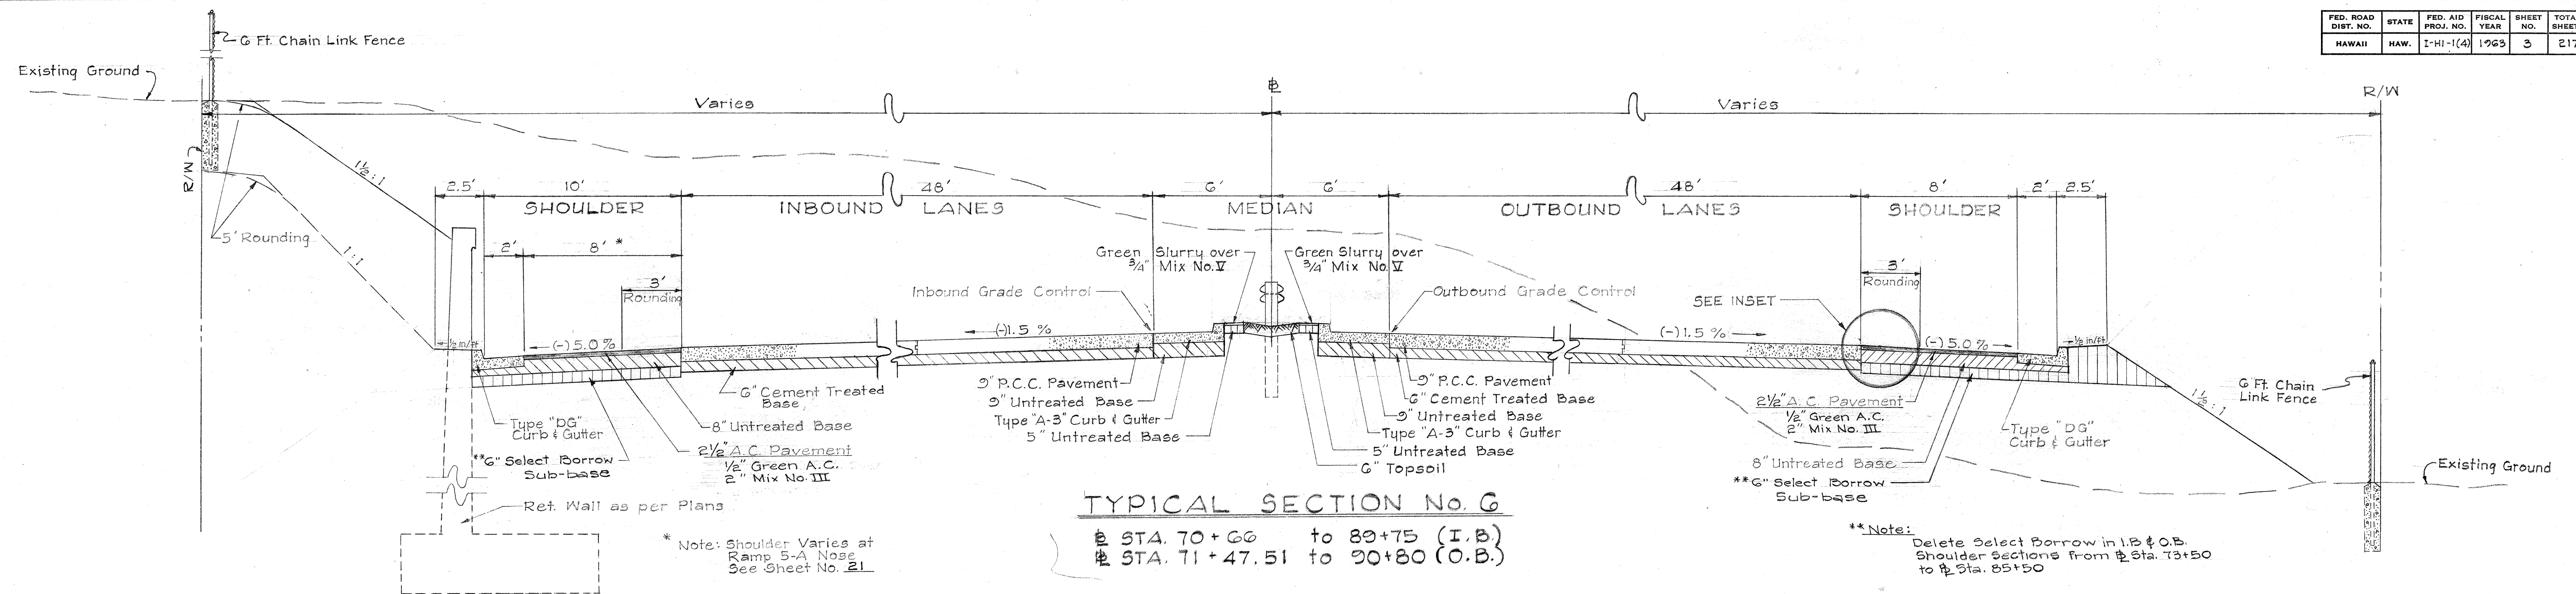

FED. ROAD DIST. NO.	STATE	FED. AID PROJ. NO.	FISCAL YEAR	SHEET NO.	TOTAL SHEETS
HAWAII	HAW.	I-HI-1(4)	1963	4	217

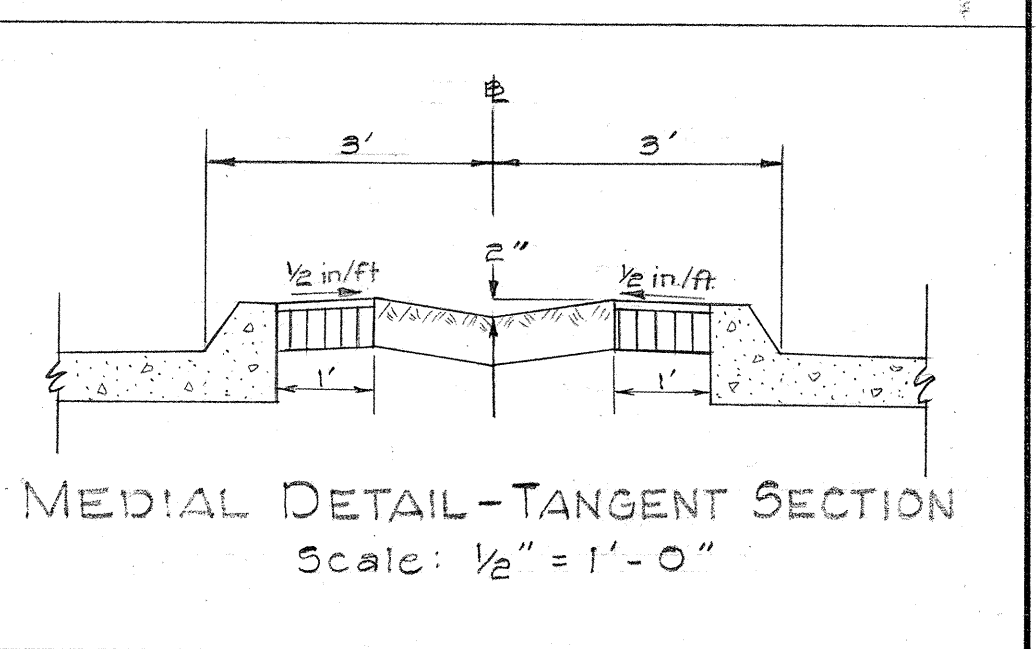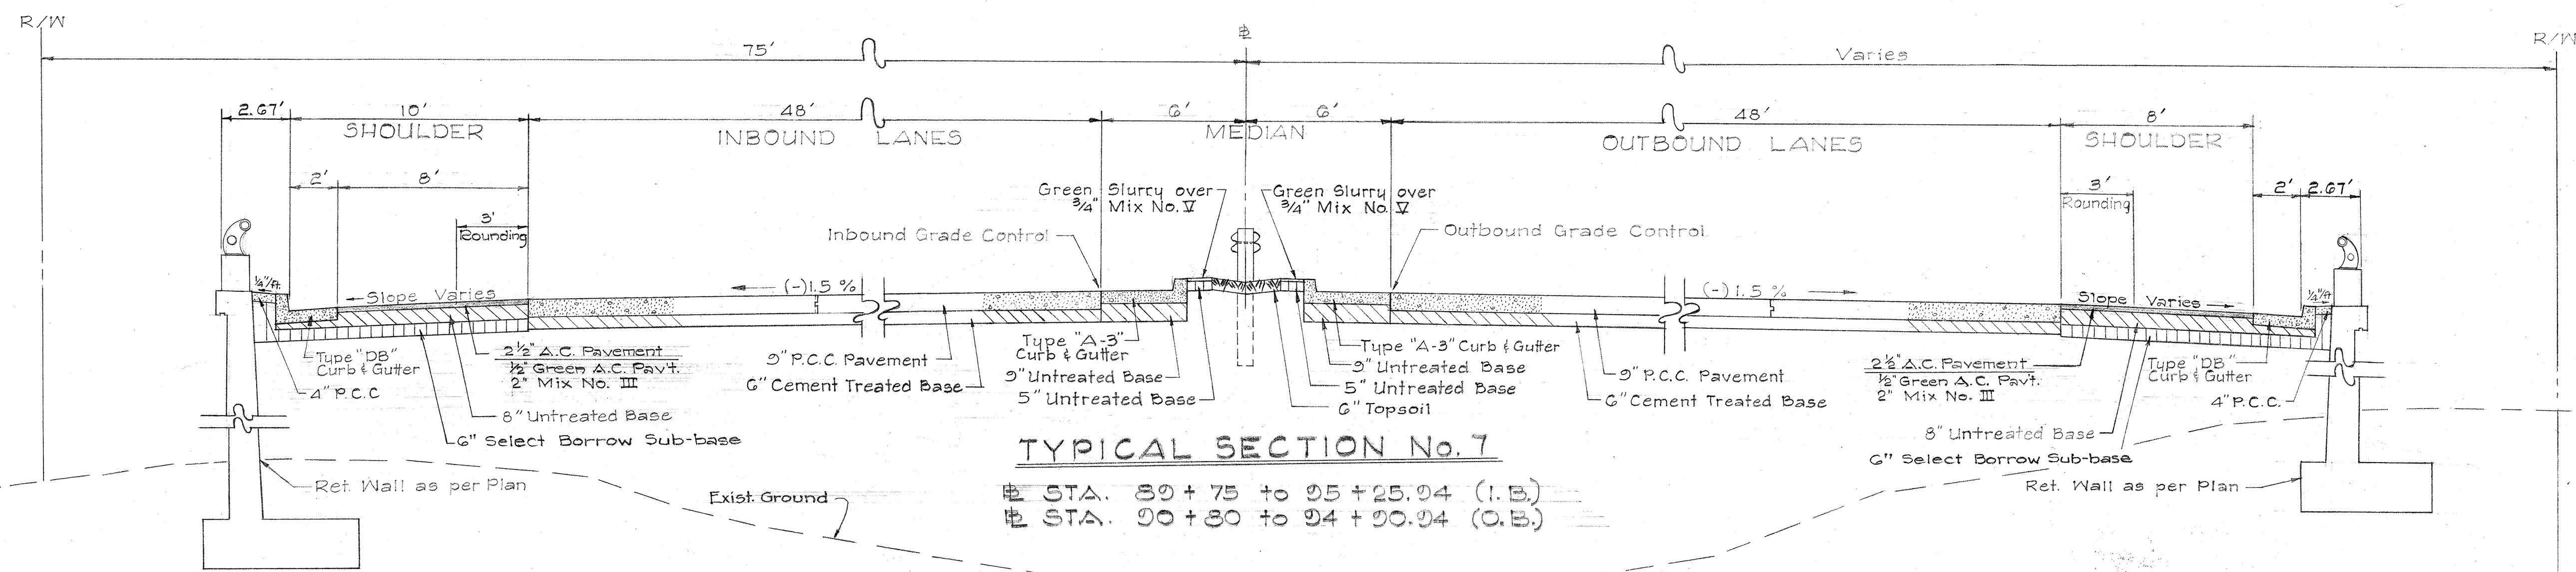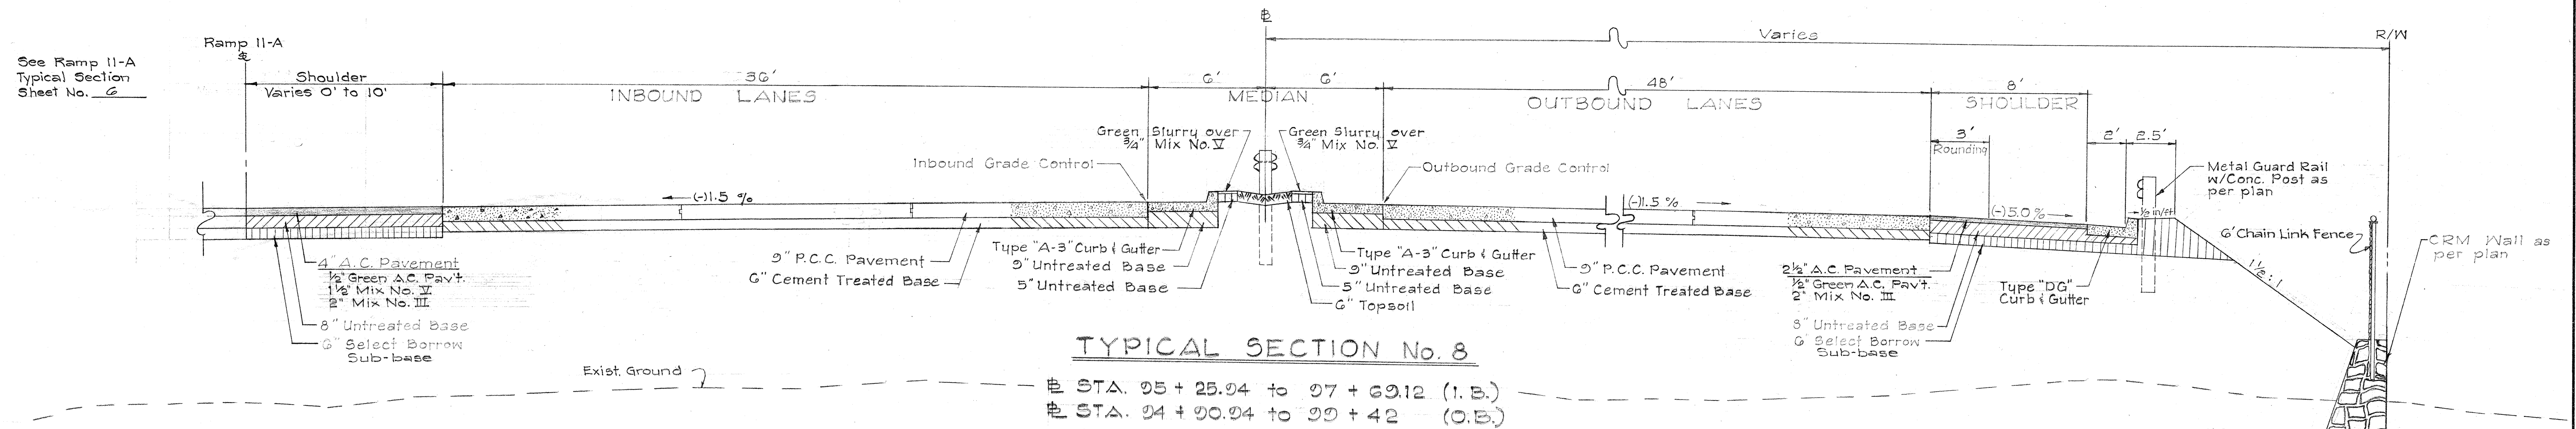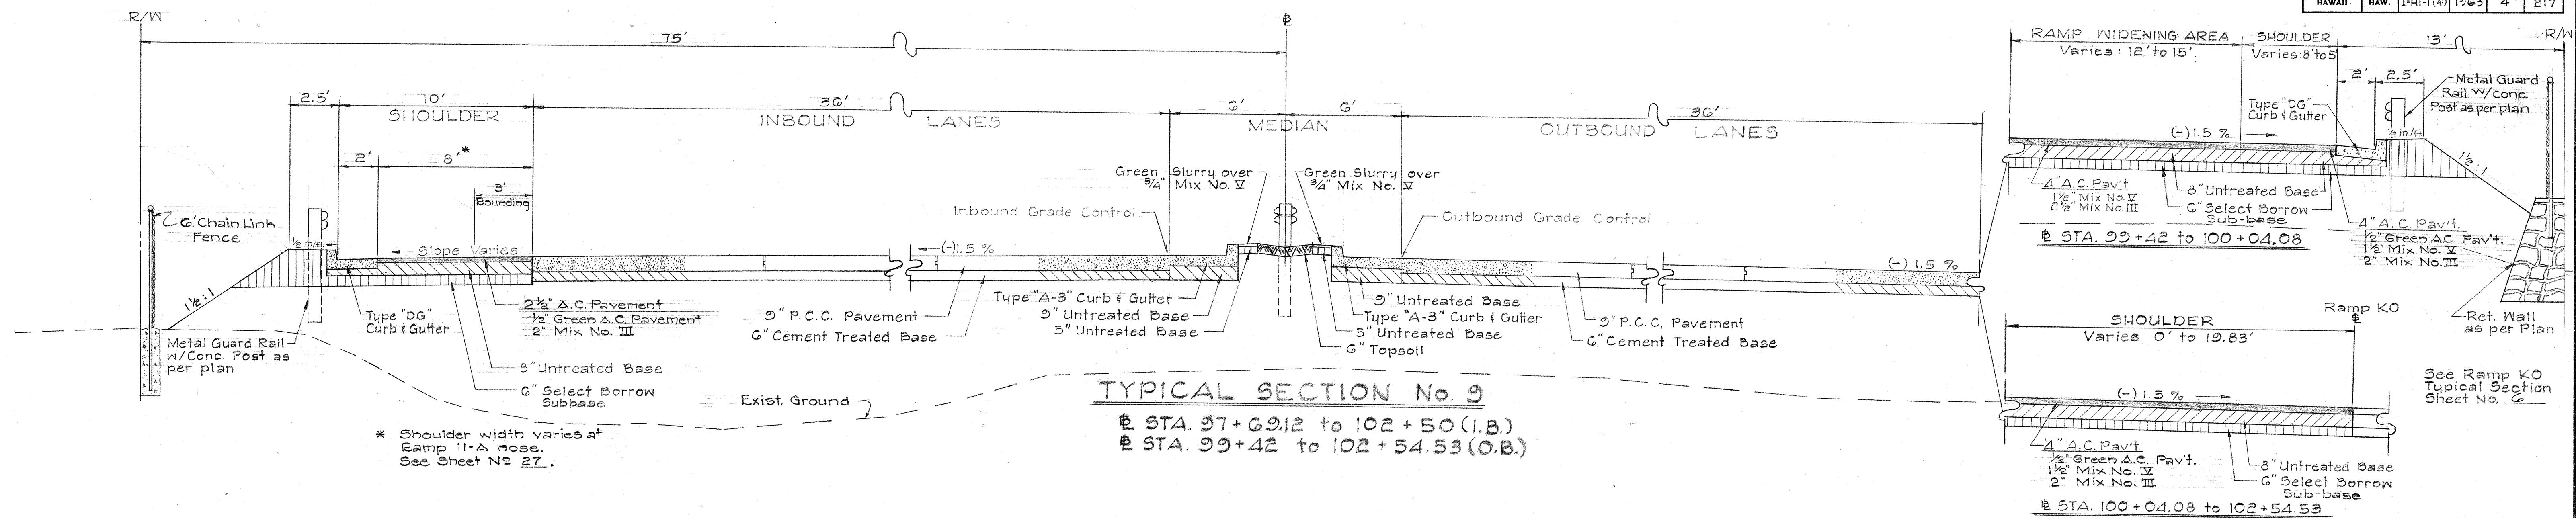

STATE OF HAWAII
 DEPARTMENT OF TRANSPORTATION
 HIGHWAYS DIVISION

LUNALILO FREEWAY
 F.A.I. PROJ. No. I-HI-1(4):24









TYPICAL SECTIONS

Scale: 1/4" = 1'-0" Date: Oct. 16, 1962

SHEET No. OF SHEETS

DATE	DESIGNED BY	CHECKED BY
PLANNED BY	NOTED BY	QUANTITIES BY
ORIGINAL PLAN	NOTE BOOK	No.


FED. ROAD DIST. NO.	STATE	FED. AID PROJ. NO.	FISCAL YEAR	SHEET NO.	TOTAL SHEETS
HAWAII	HAW.	I-HI-1(4)	1963	5	217

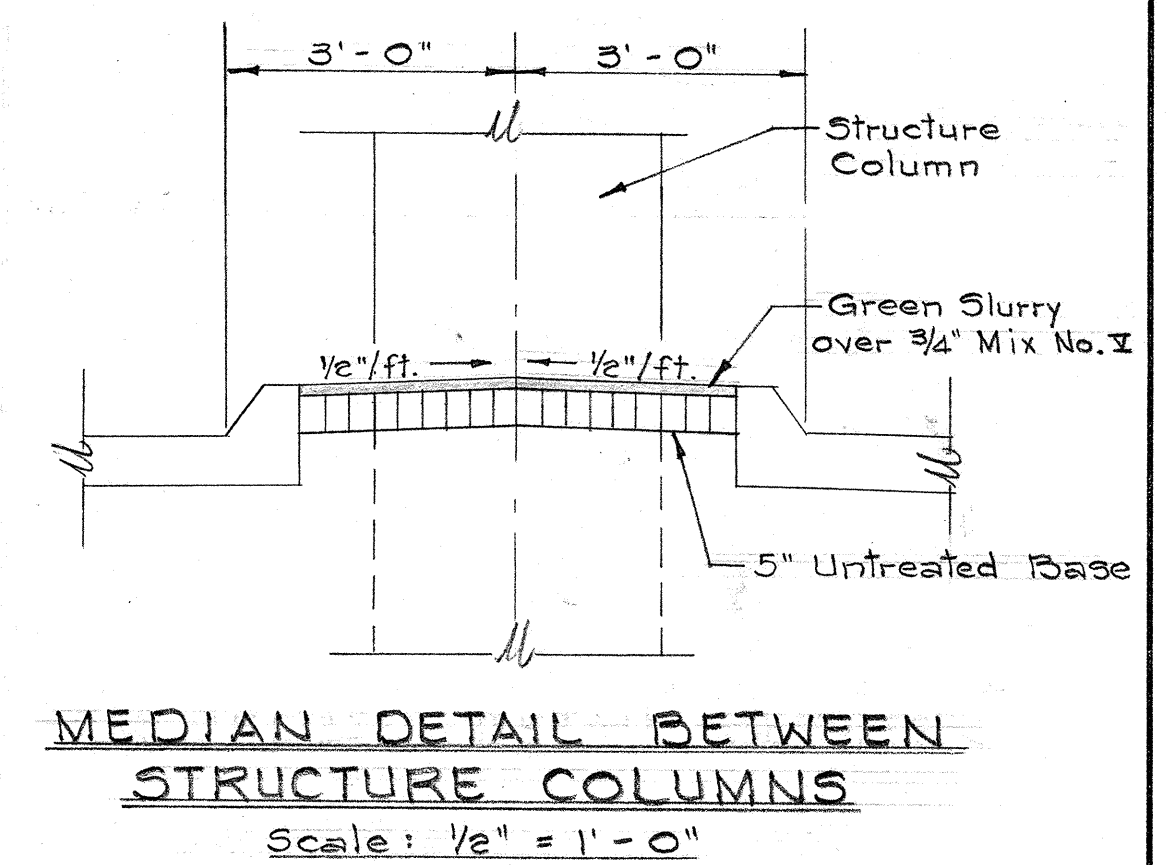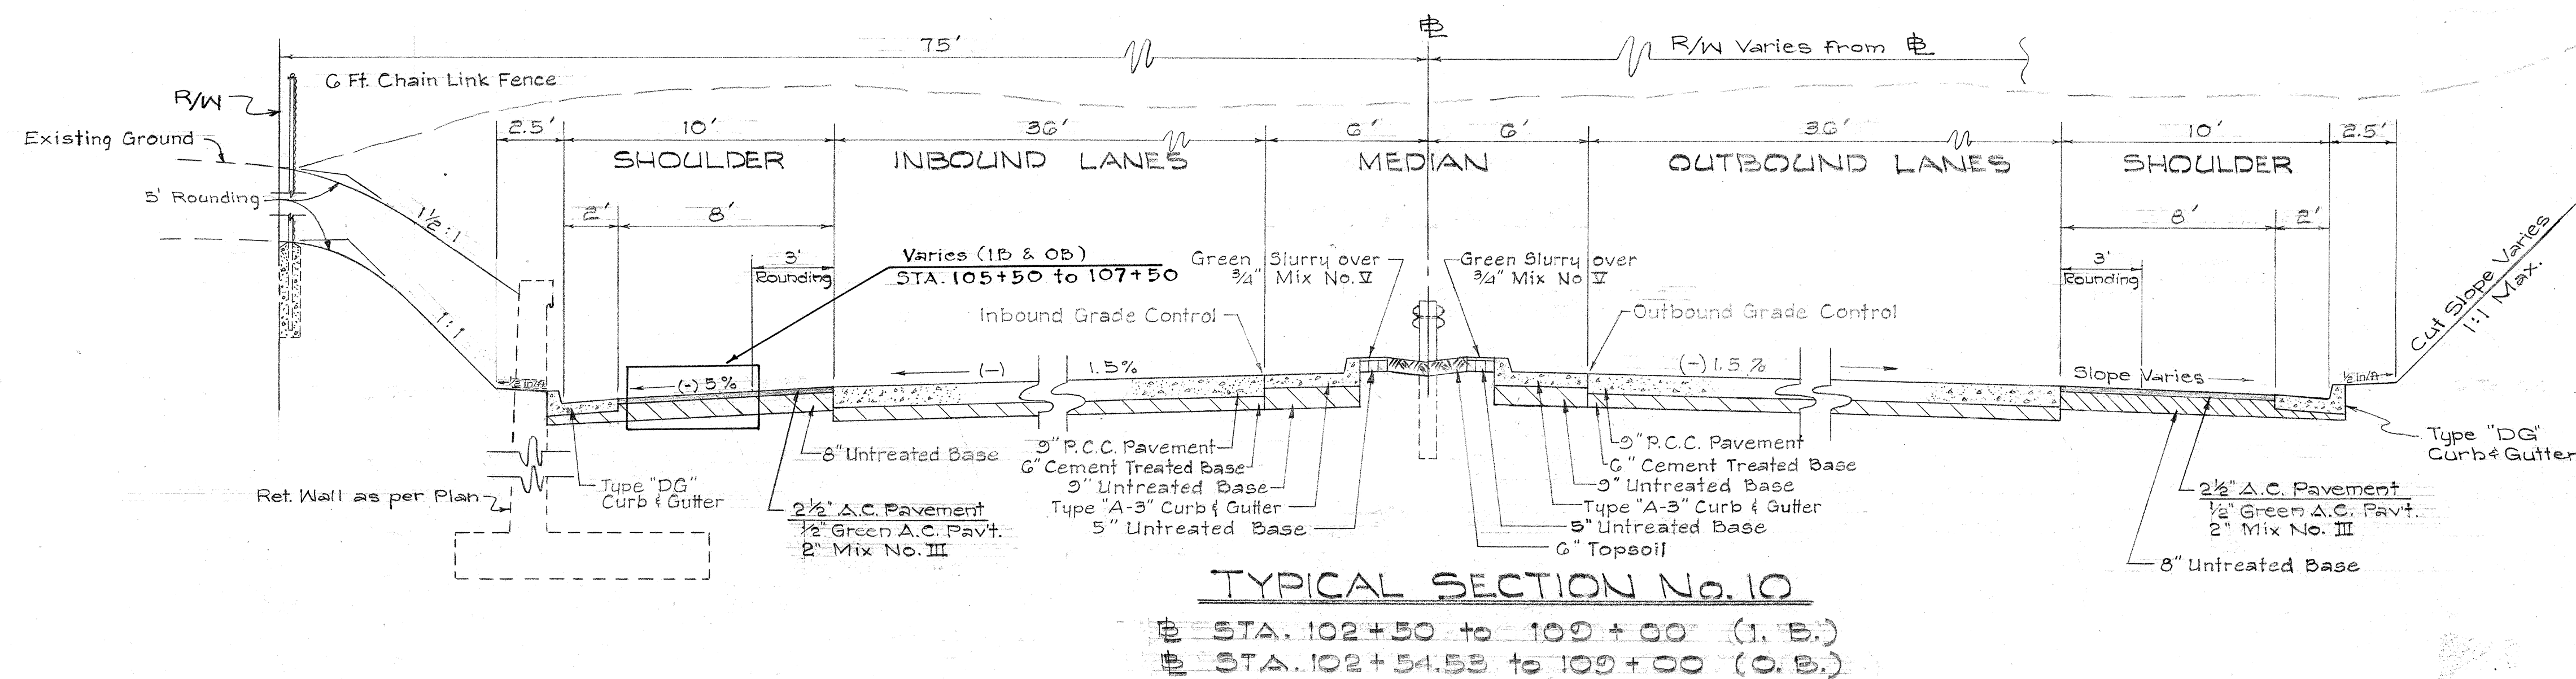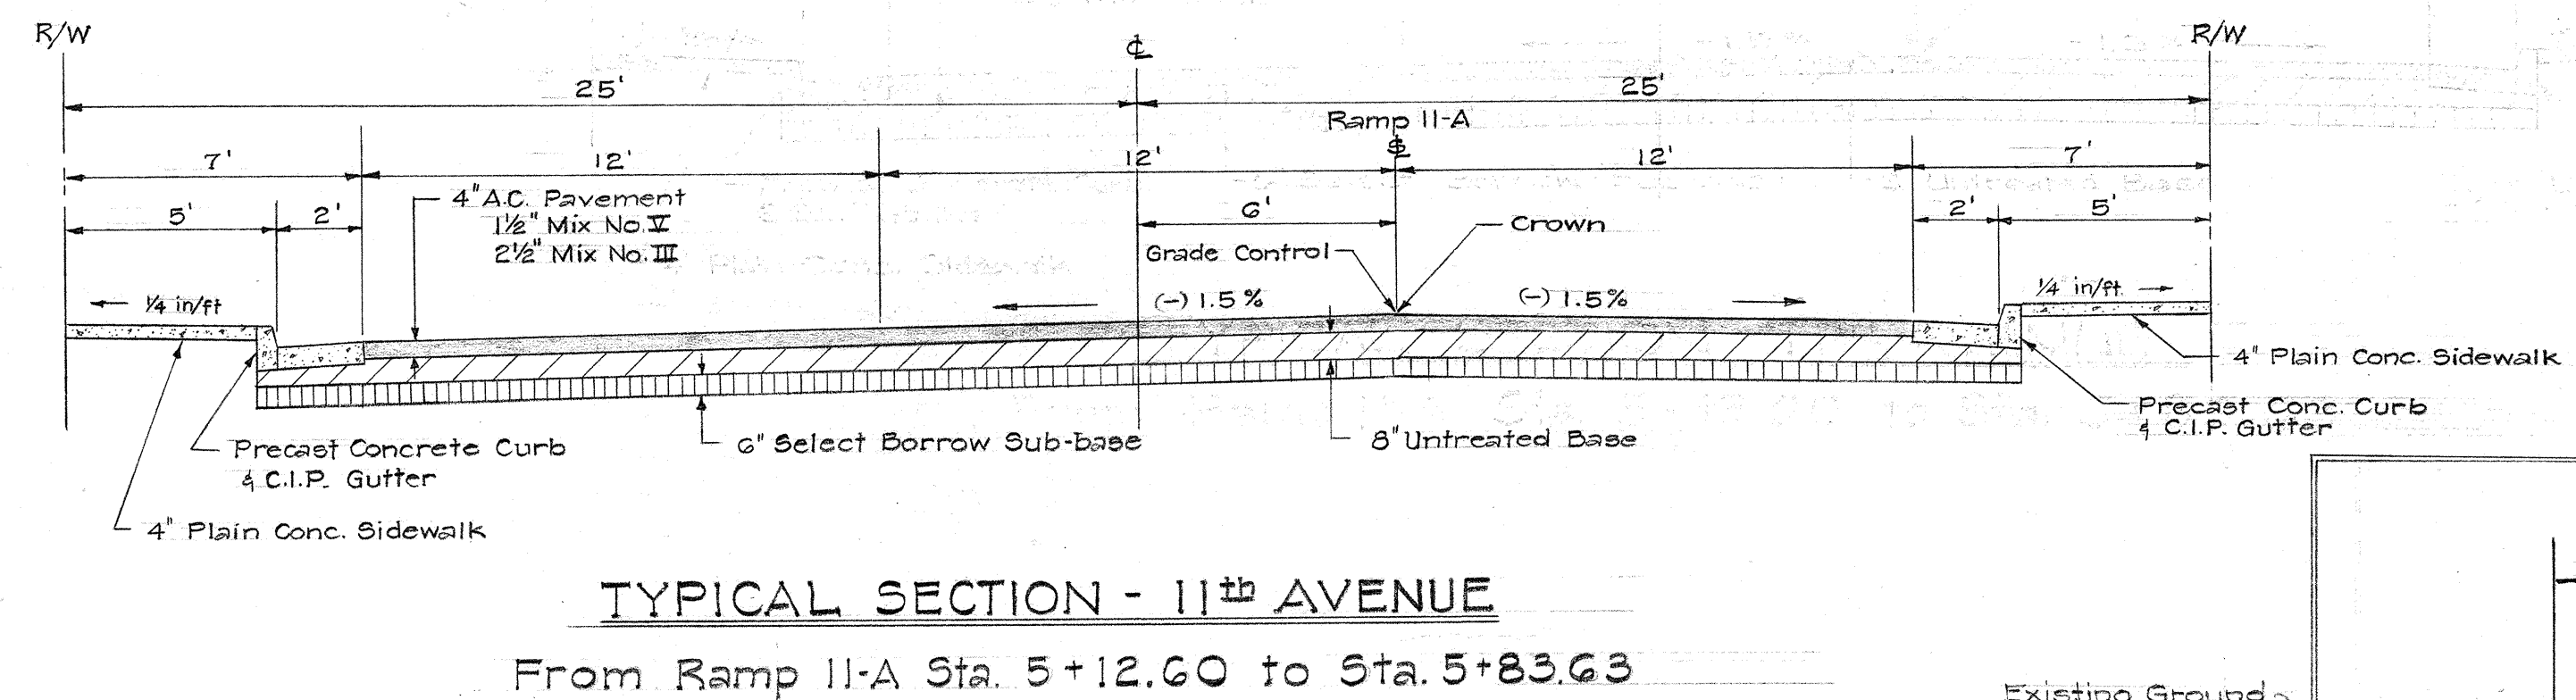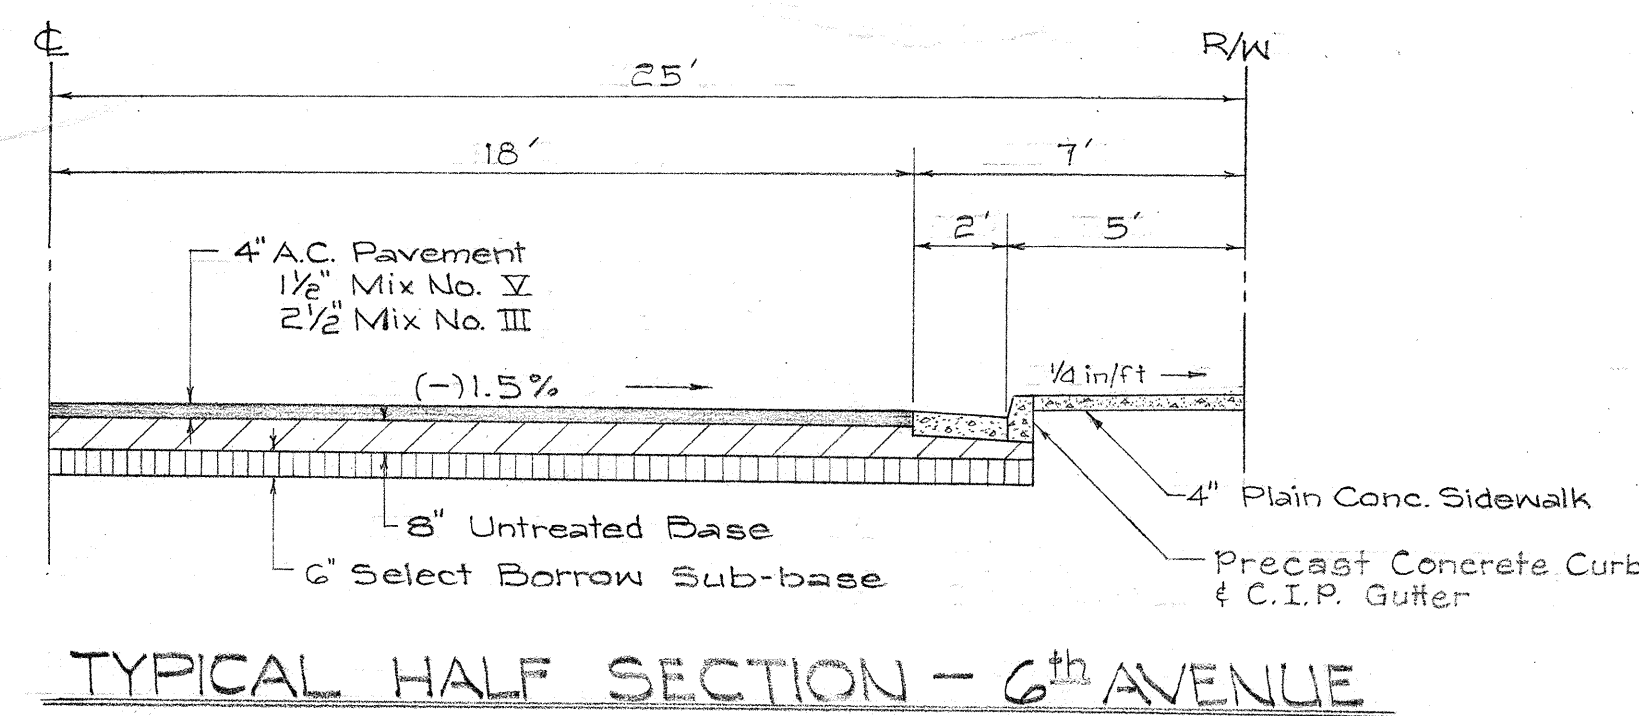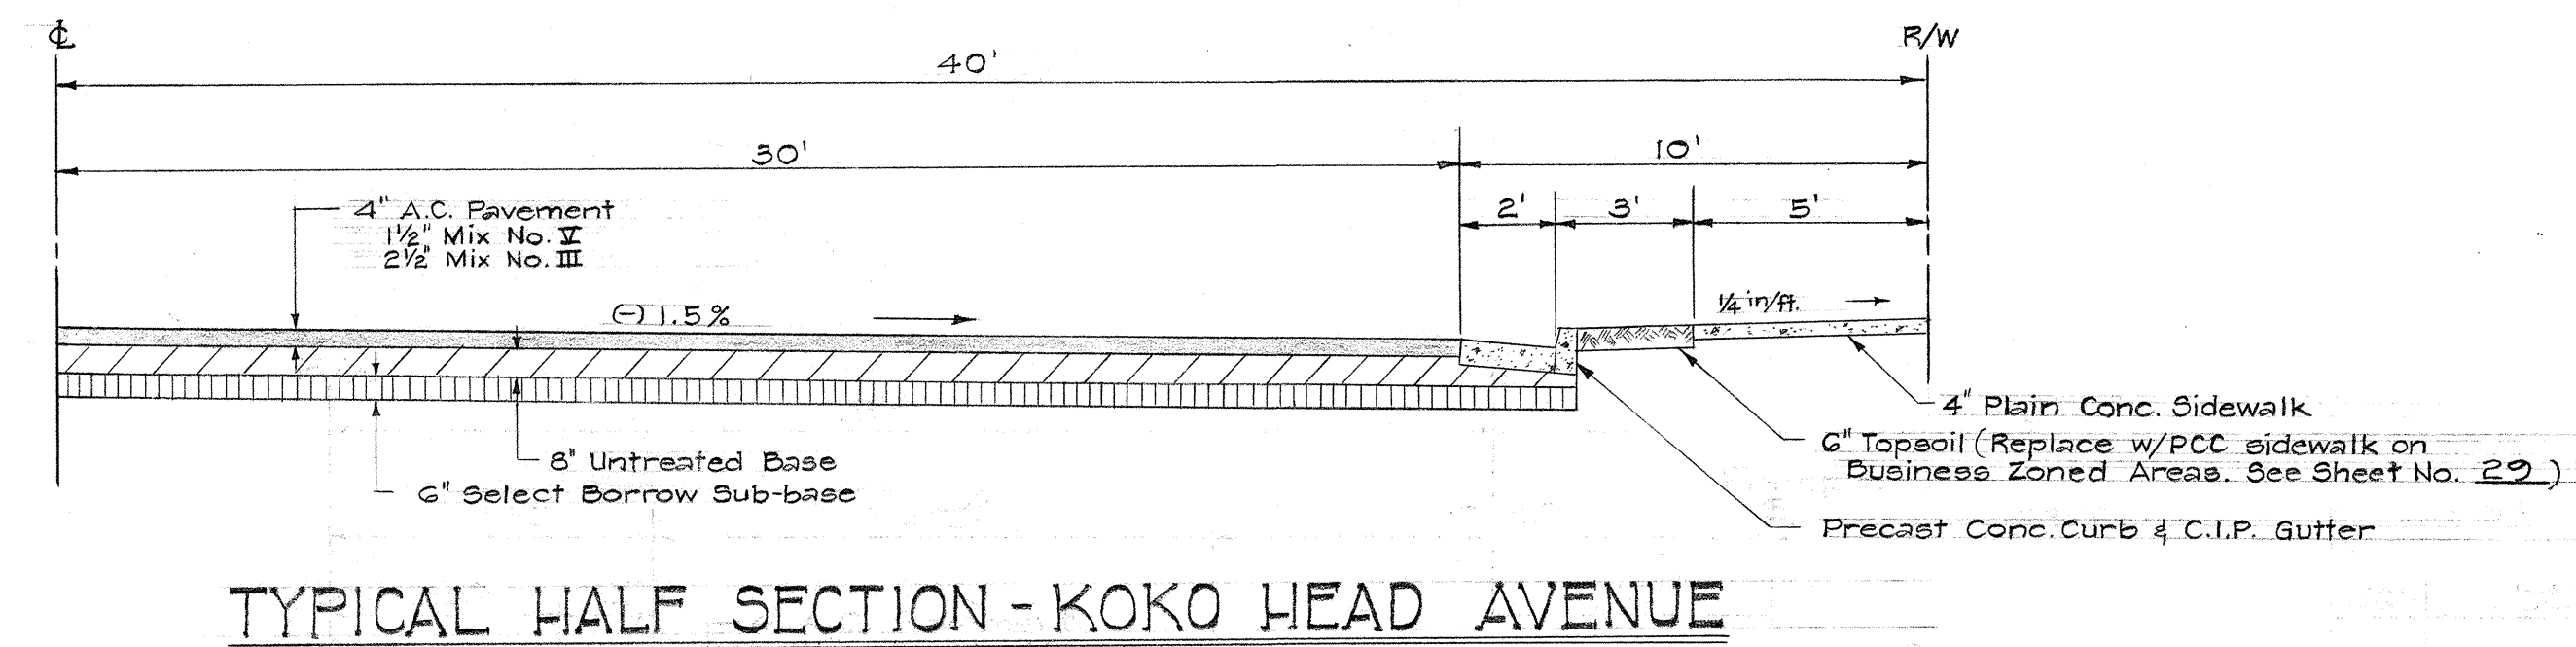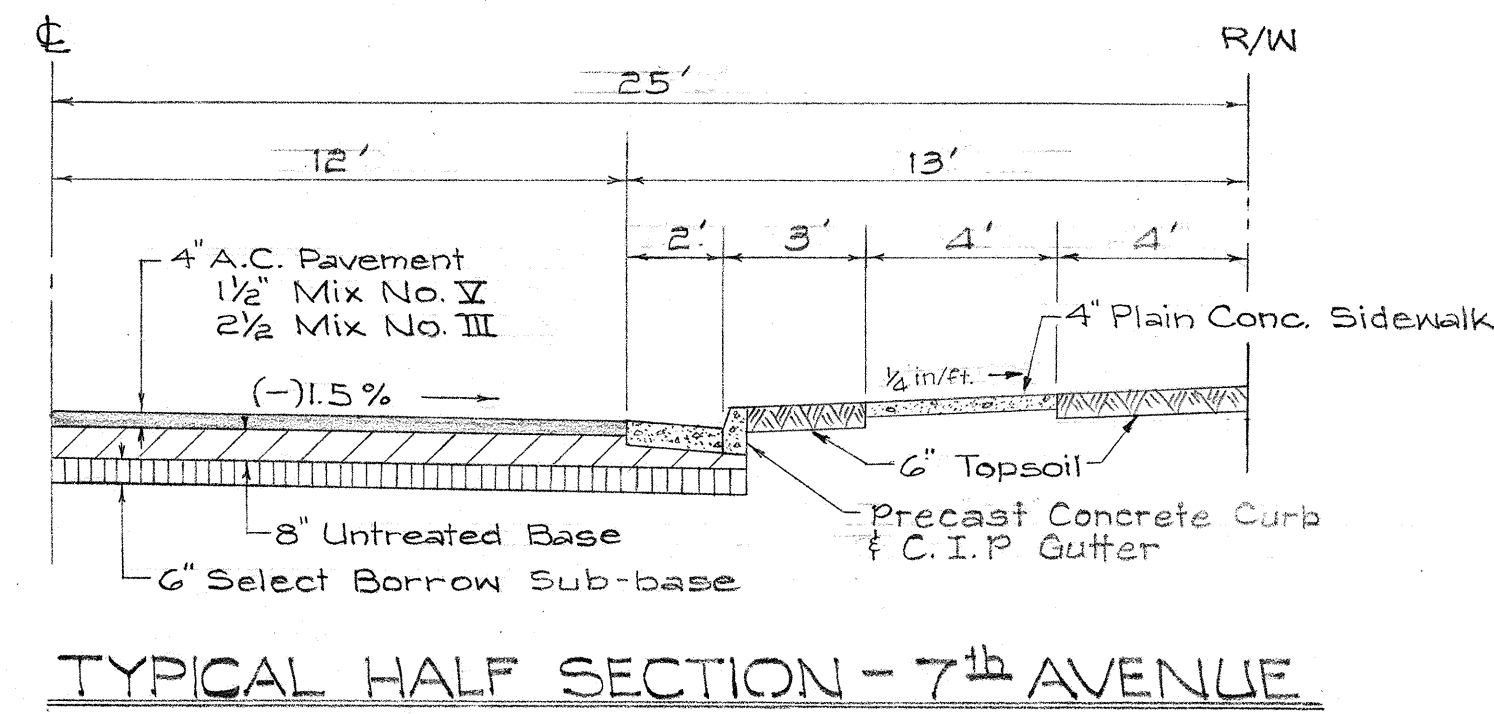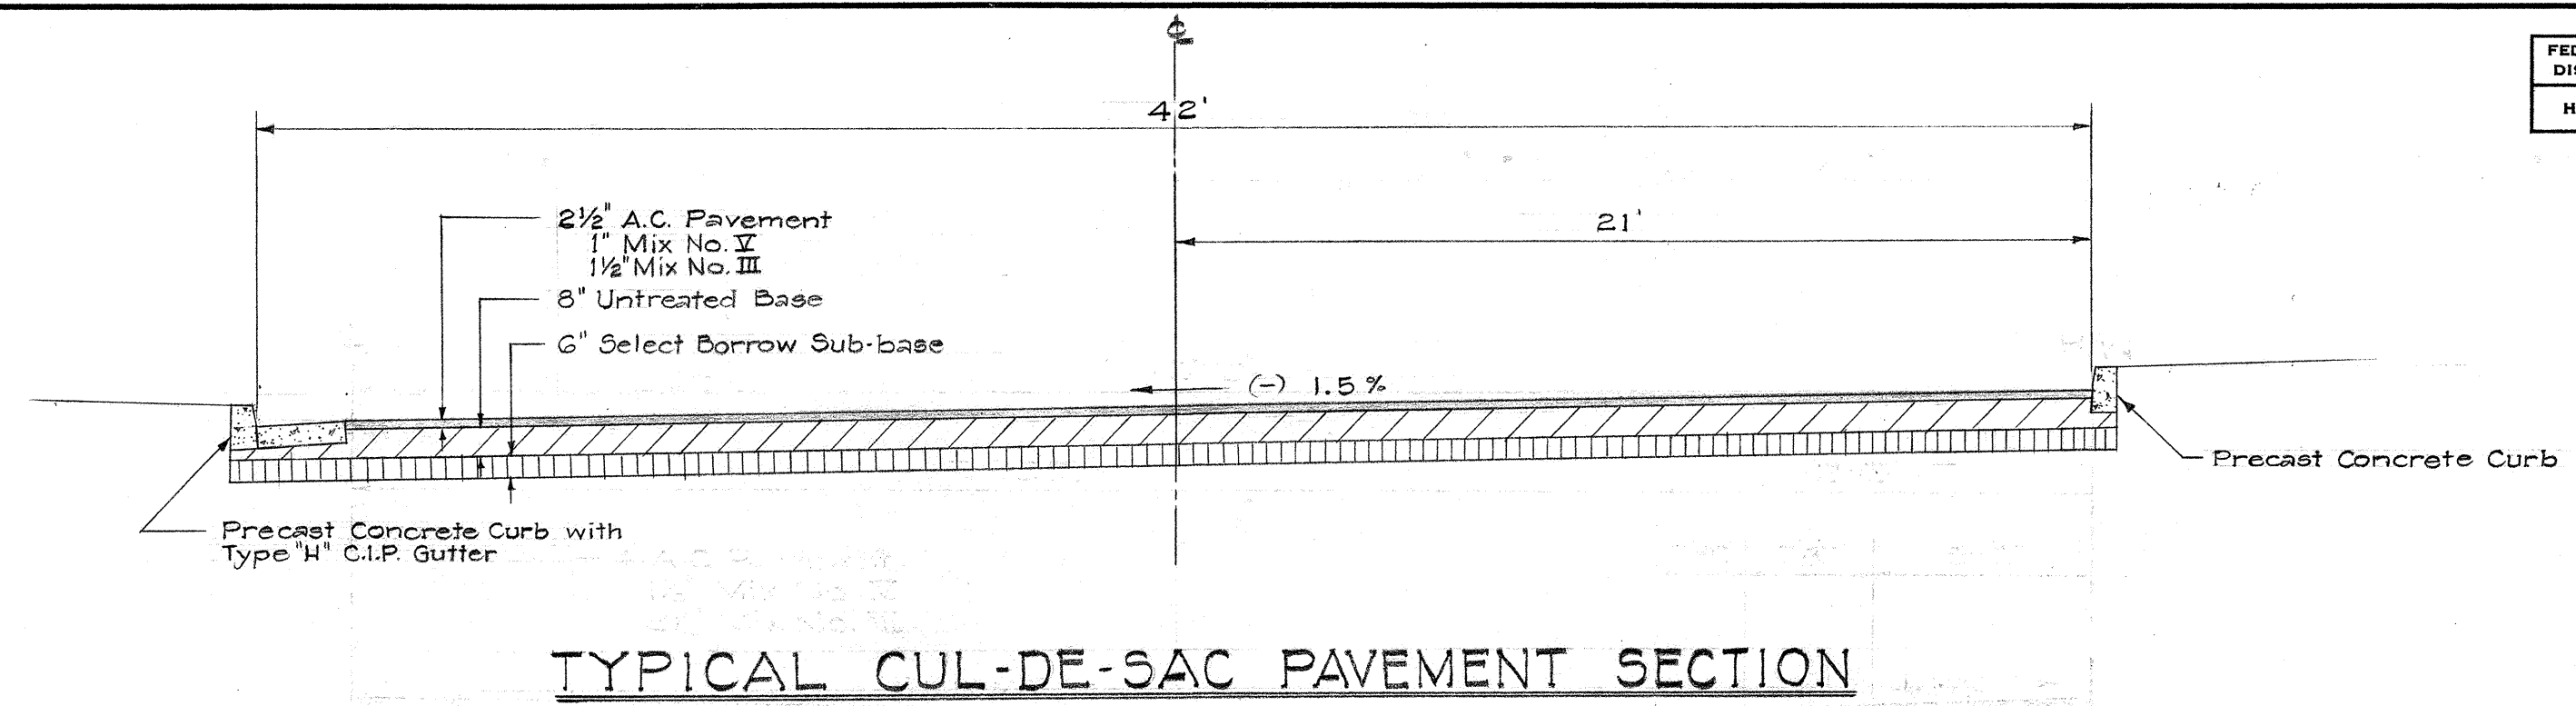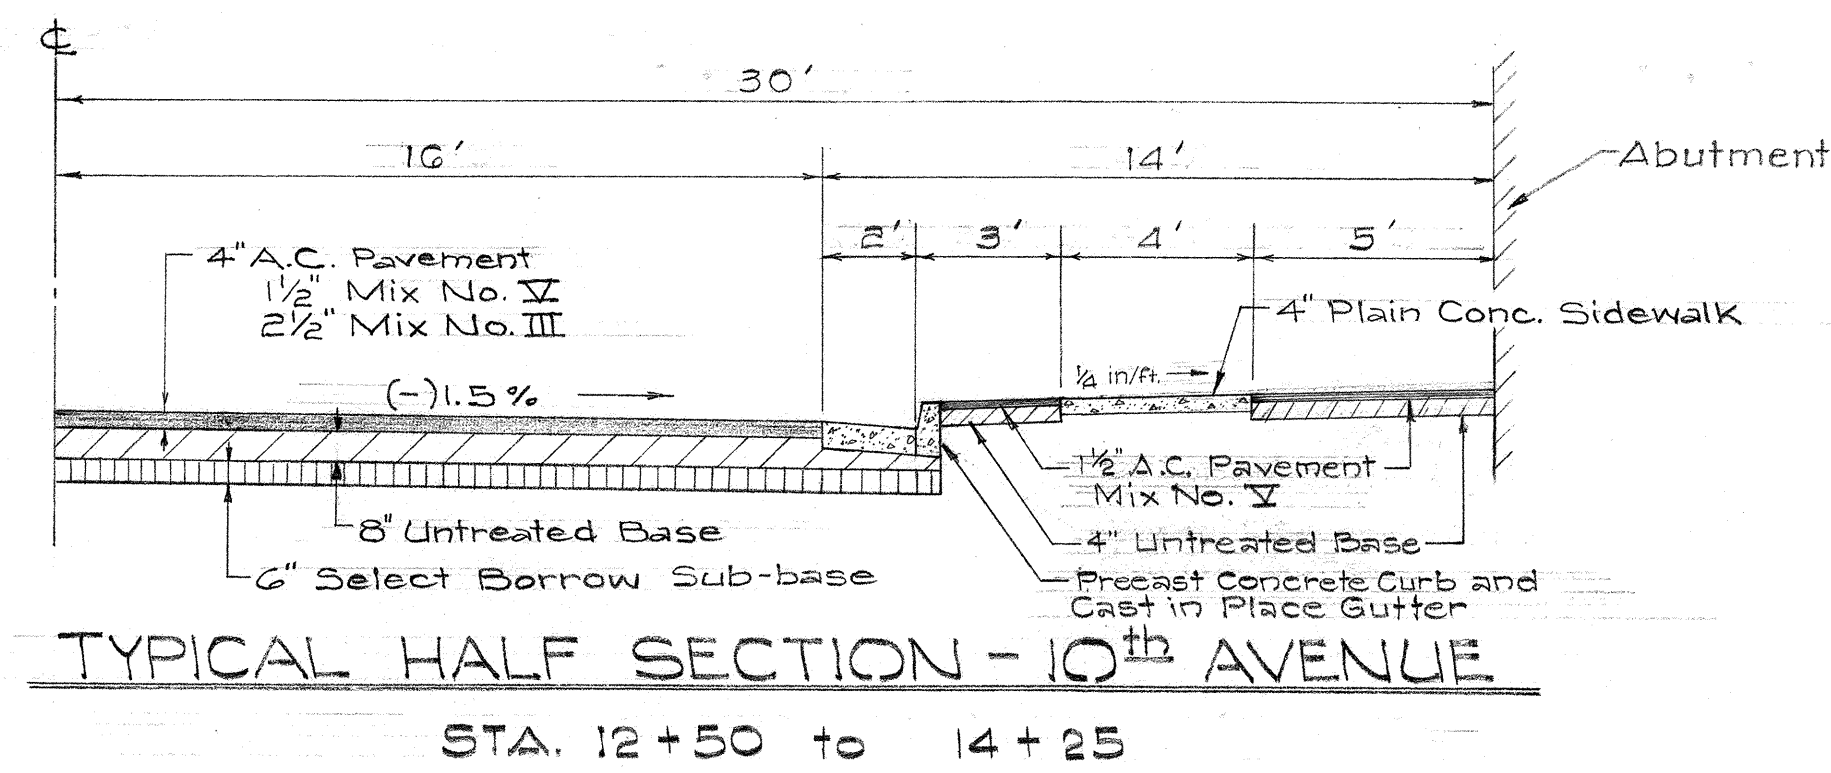


STATE OF HAWAII
DEPARTMENT OF TRANSPORTATION
HIGHWAYS DIVISION
LUNALILO FREEWAY
F.A.I. PROJ. No. I-HI-1(4)-24
TYPICAL SECTIONS
Scale: 1/4" = 1'-0" Date: Sept. 20, 1962
SHEET No. 5 OF 217 SHEETS

ORIGINAL PLAN	DATE
DESIGNED BY	BY
NOTED BY	BY
CHECKED BY	BY
NO.	


FED. ROAD DIST. NO.	STATE	FED. AID PROJ. NO.	FISCAL YEAR	SHEET NO.	TOTAL SHEETS
HAWAII	HAW.	I-HI-1(4)	1965	6	217

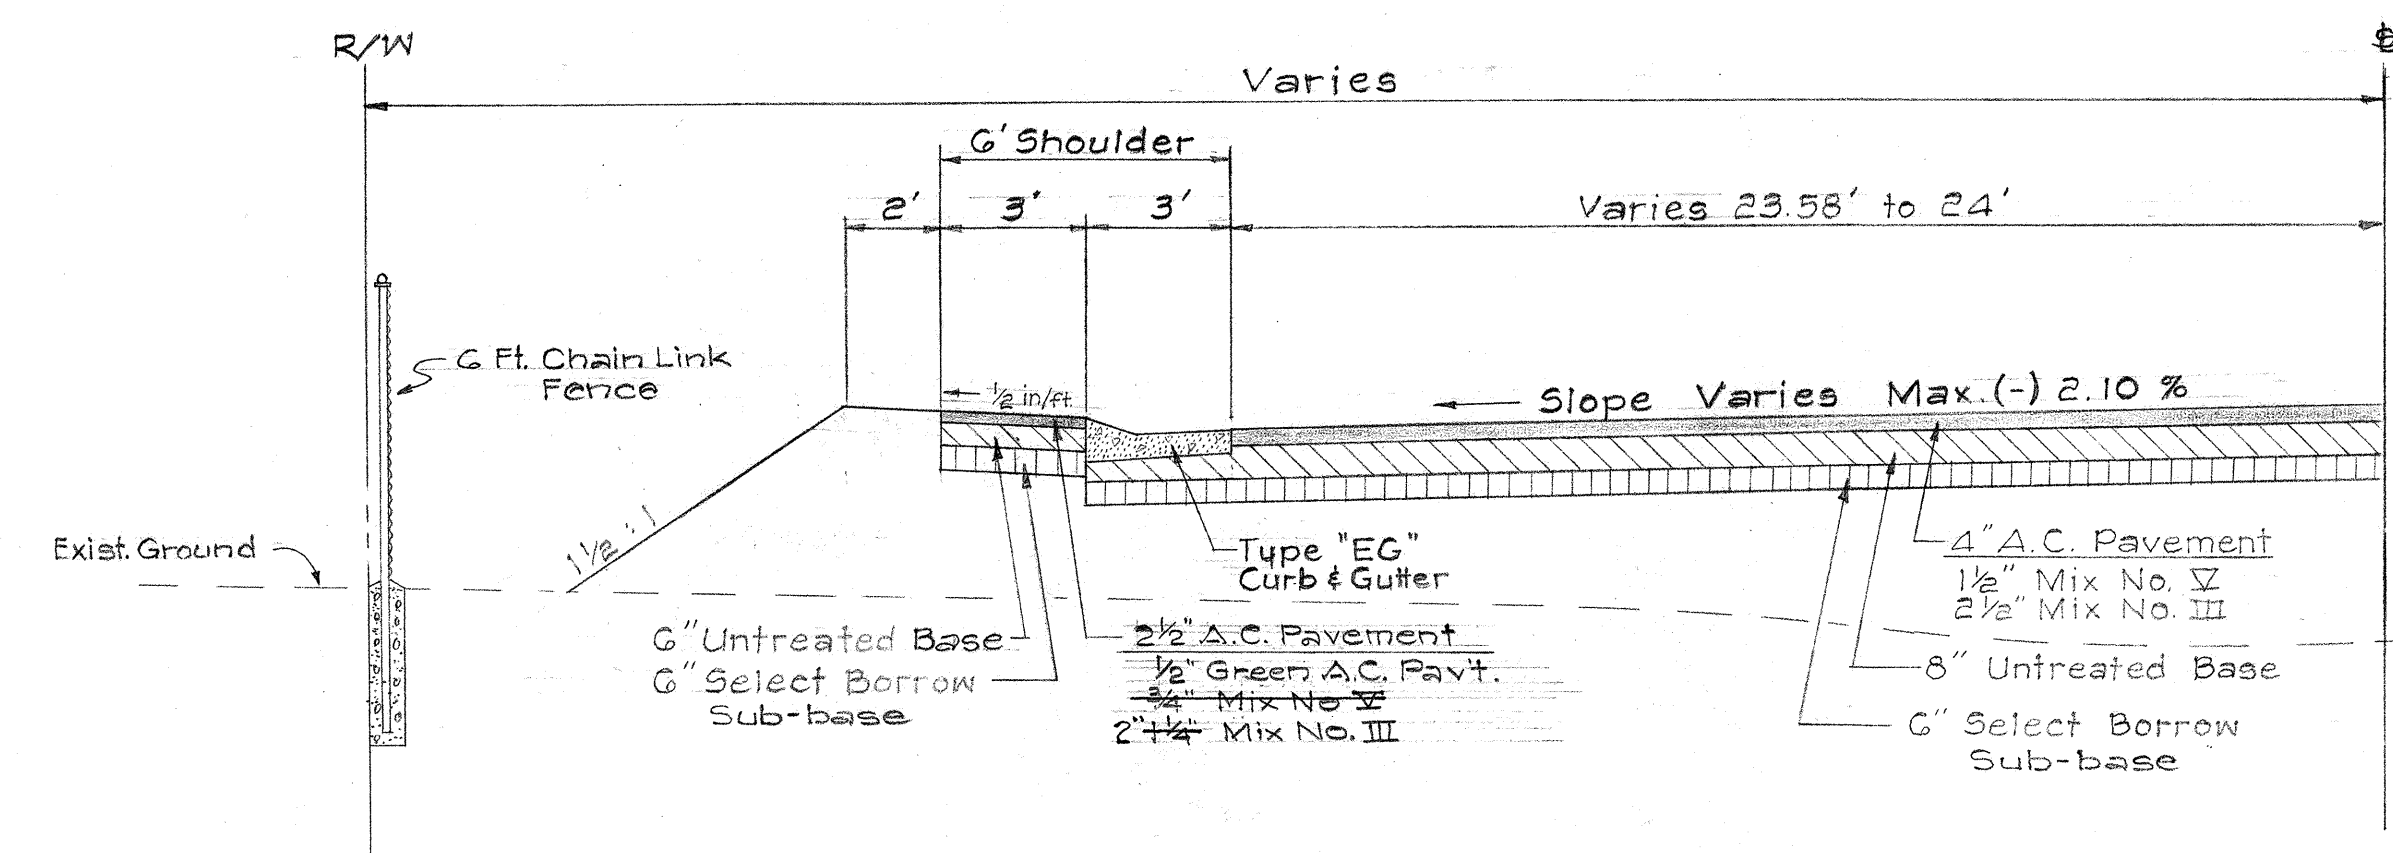


TYPICAL SECTION-RAMP II-A
STA. 4+62.74 to 5+12.60

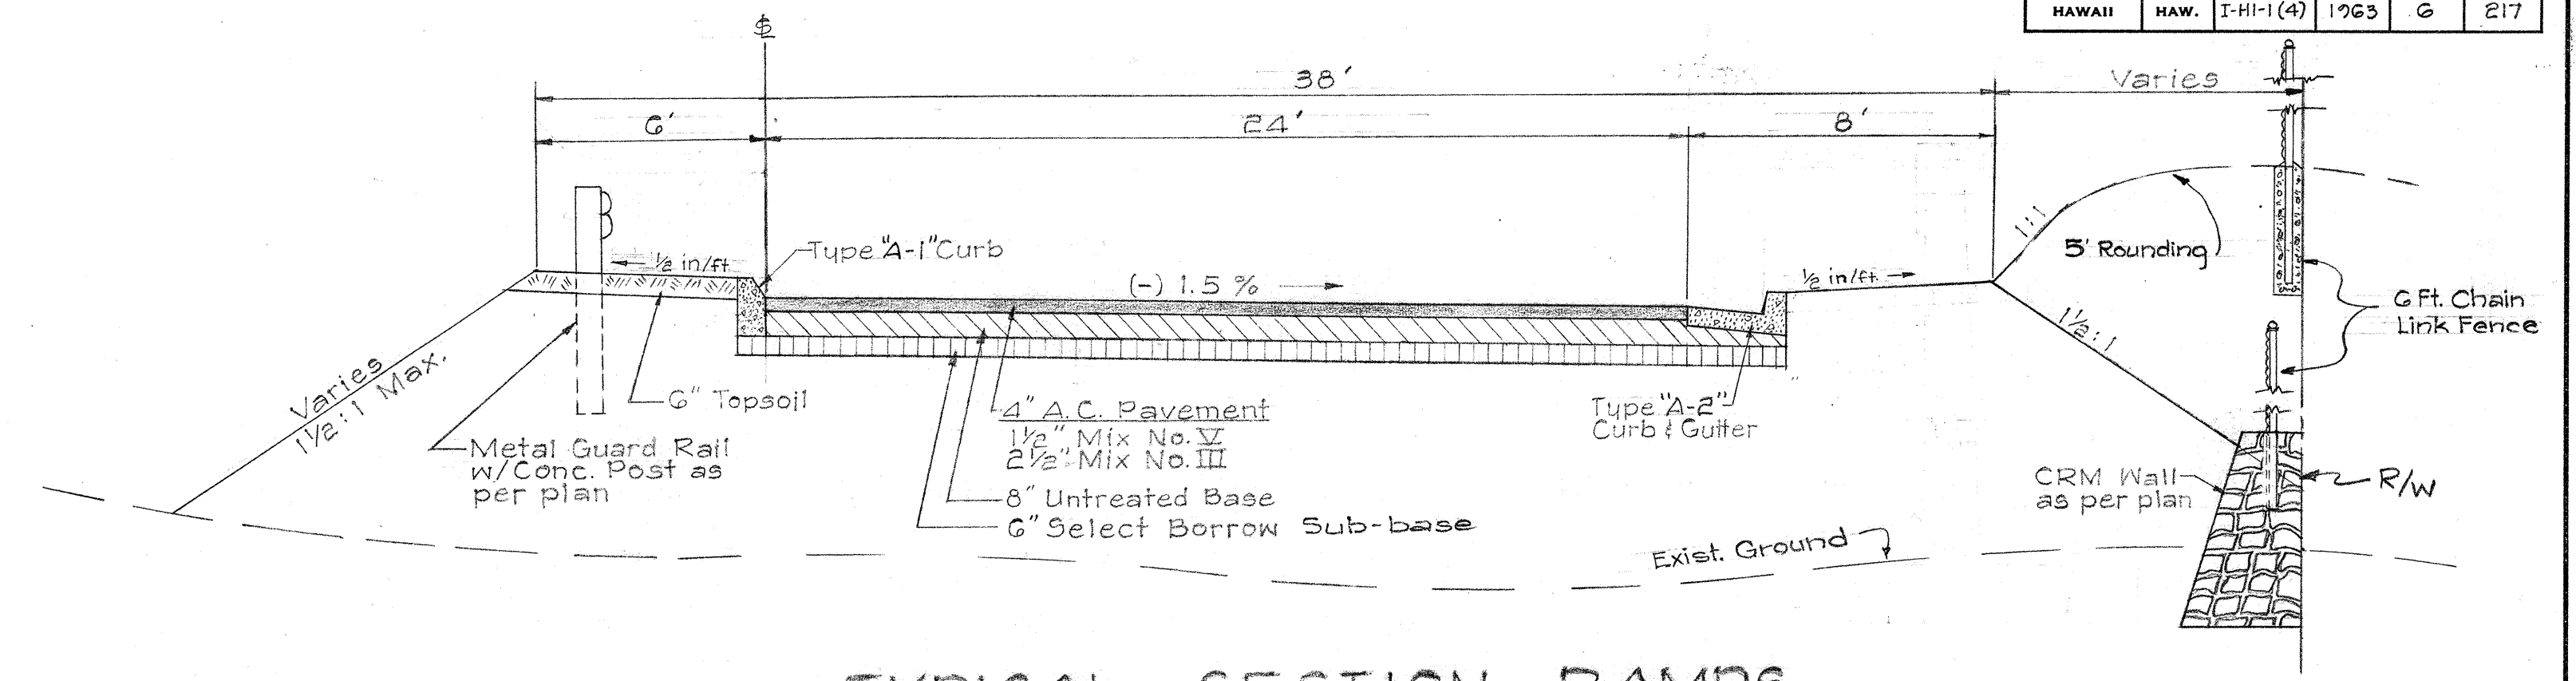


TYPICAL SECTION-RAMPS
Ramp G-A STA. 4+47.89 to 7+13.41
Ramp KO STA. 6+28 to 8+10.04

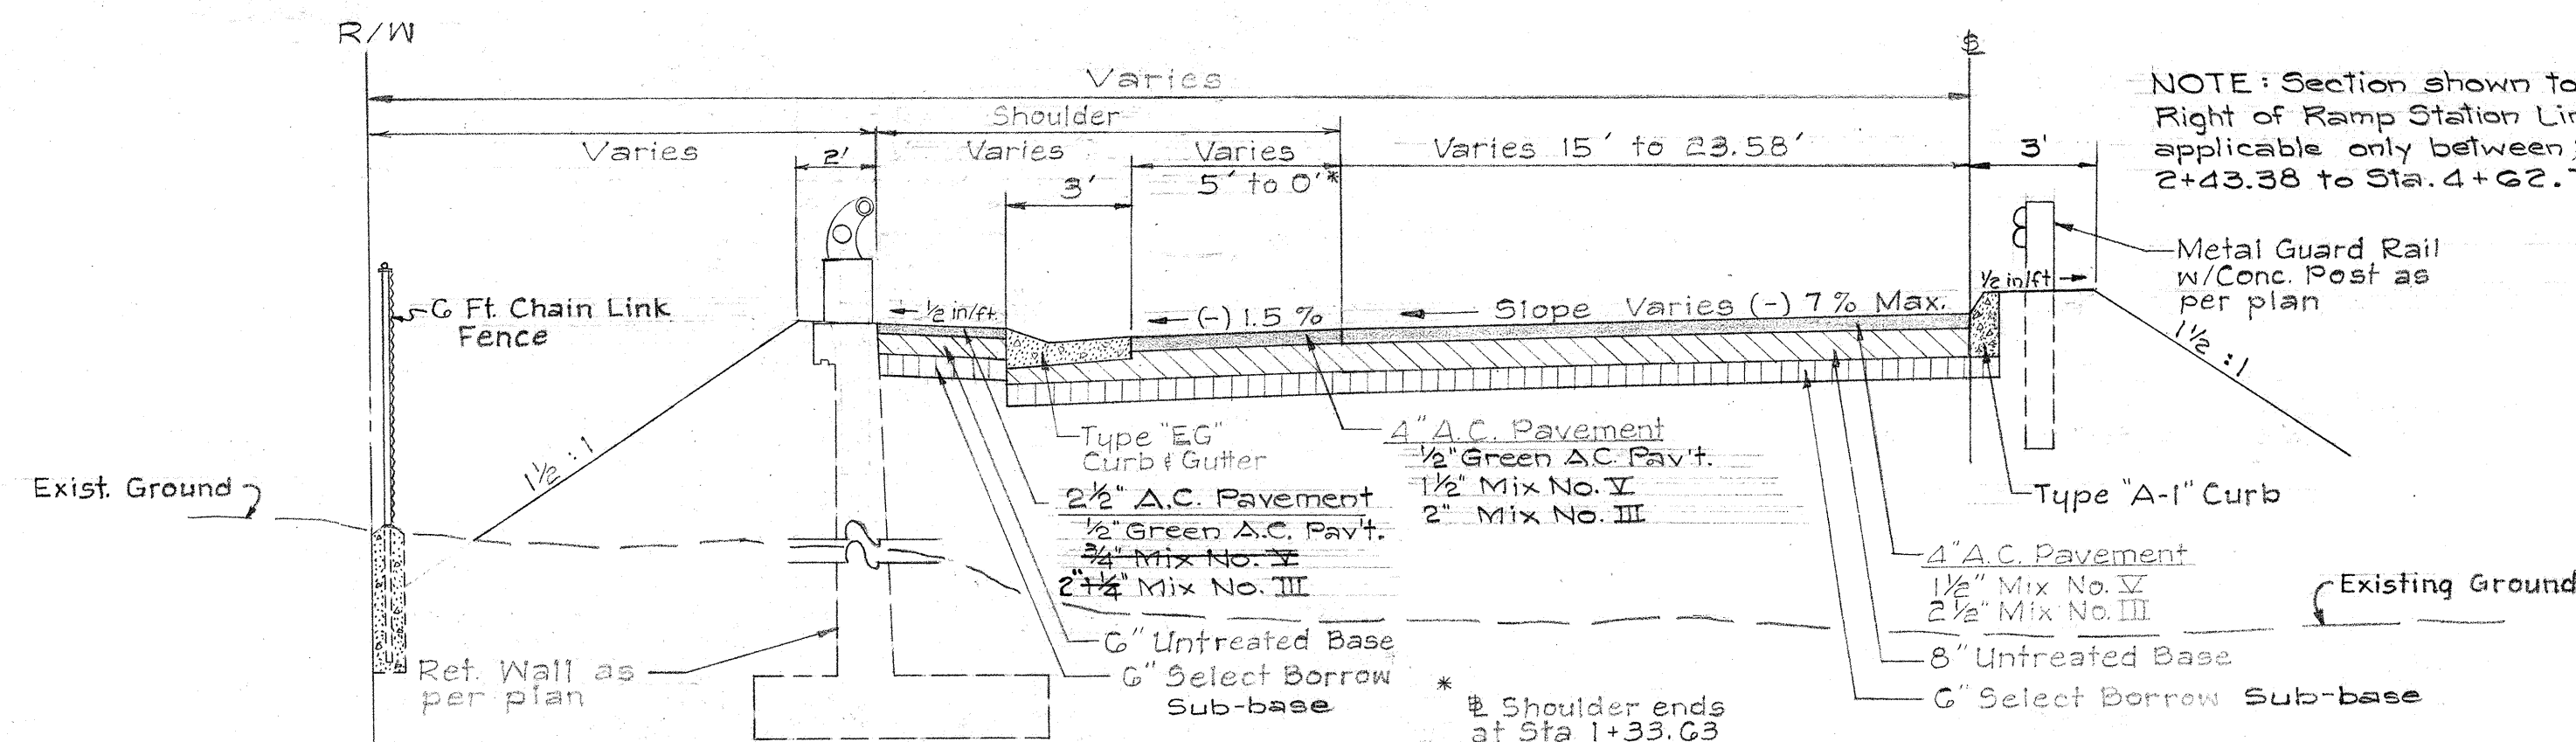


TYPICAL SECTION-RAMP II-A
STA. 0+00 to 4+62.74

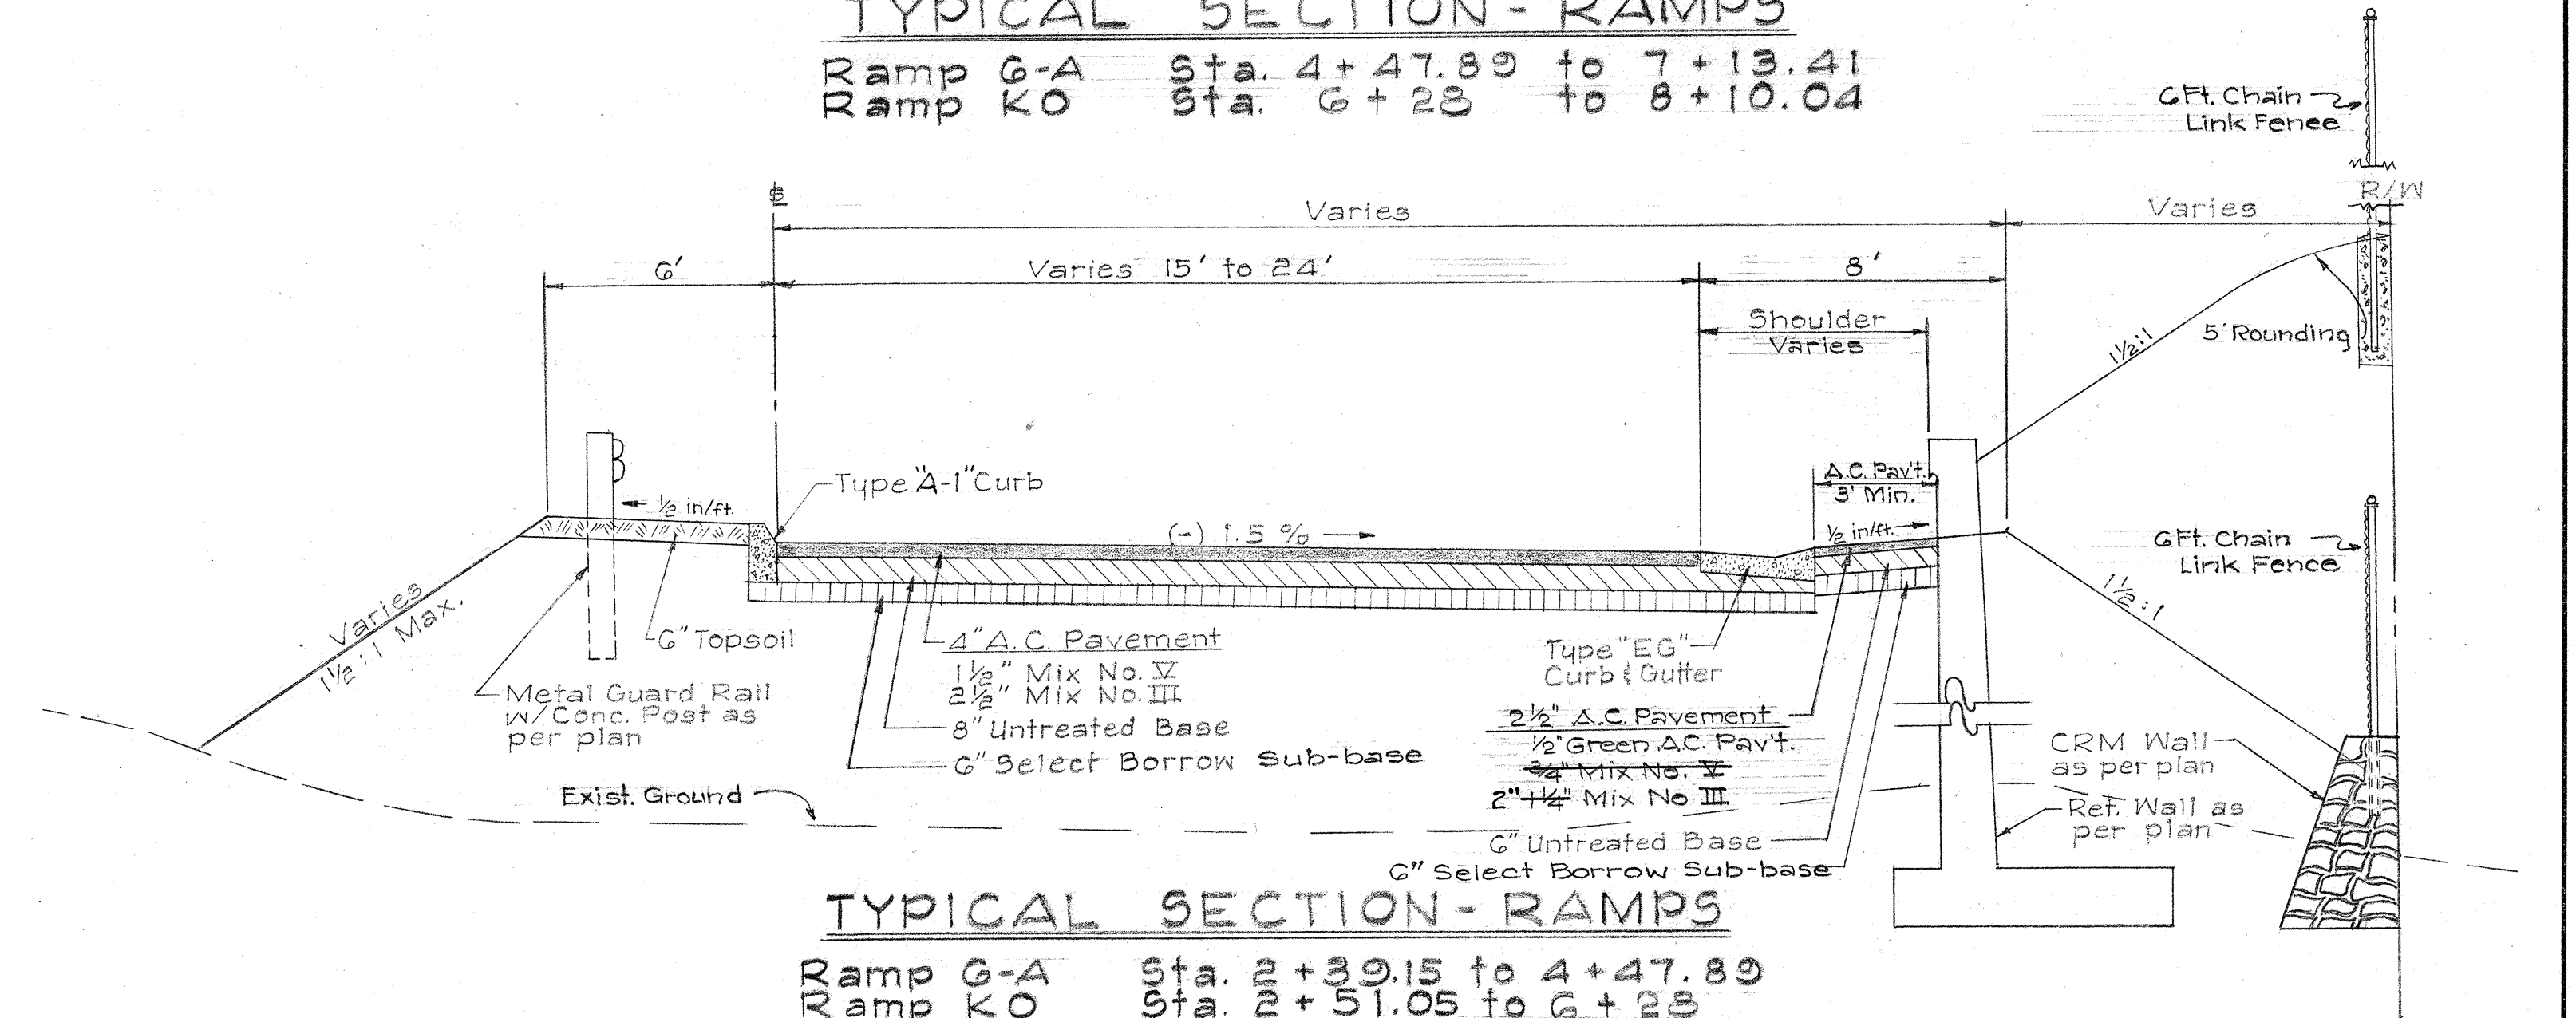


TYPICAL SECTION-RAMPS
Ramp G-A STA. 2+39.15 to 4+47.89
Ramp KO STA. 2+51.05 to 6+28

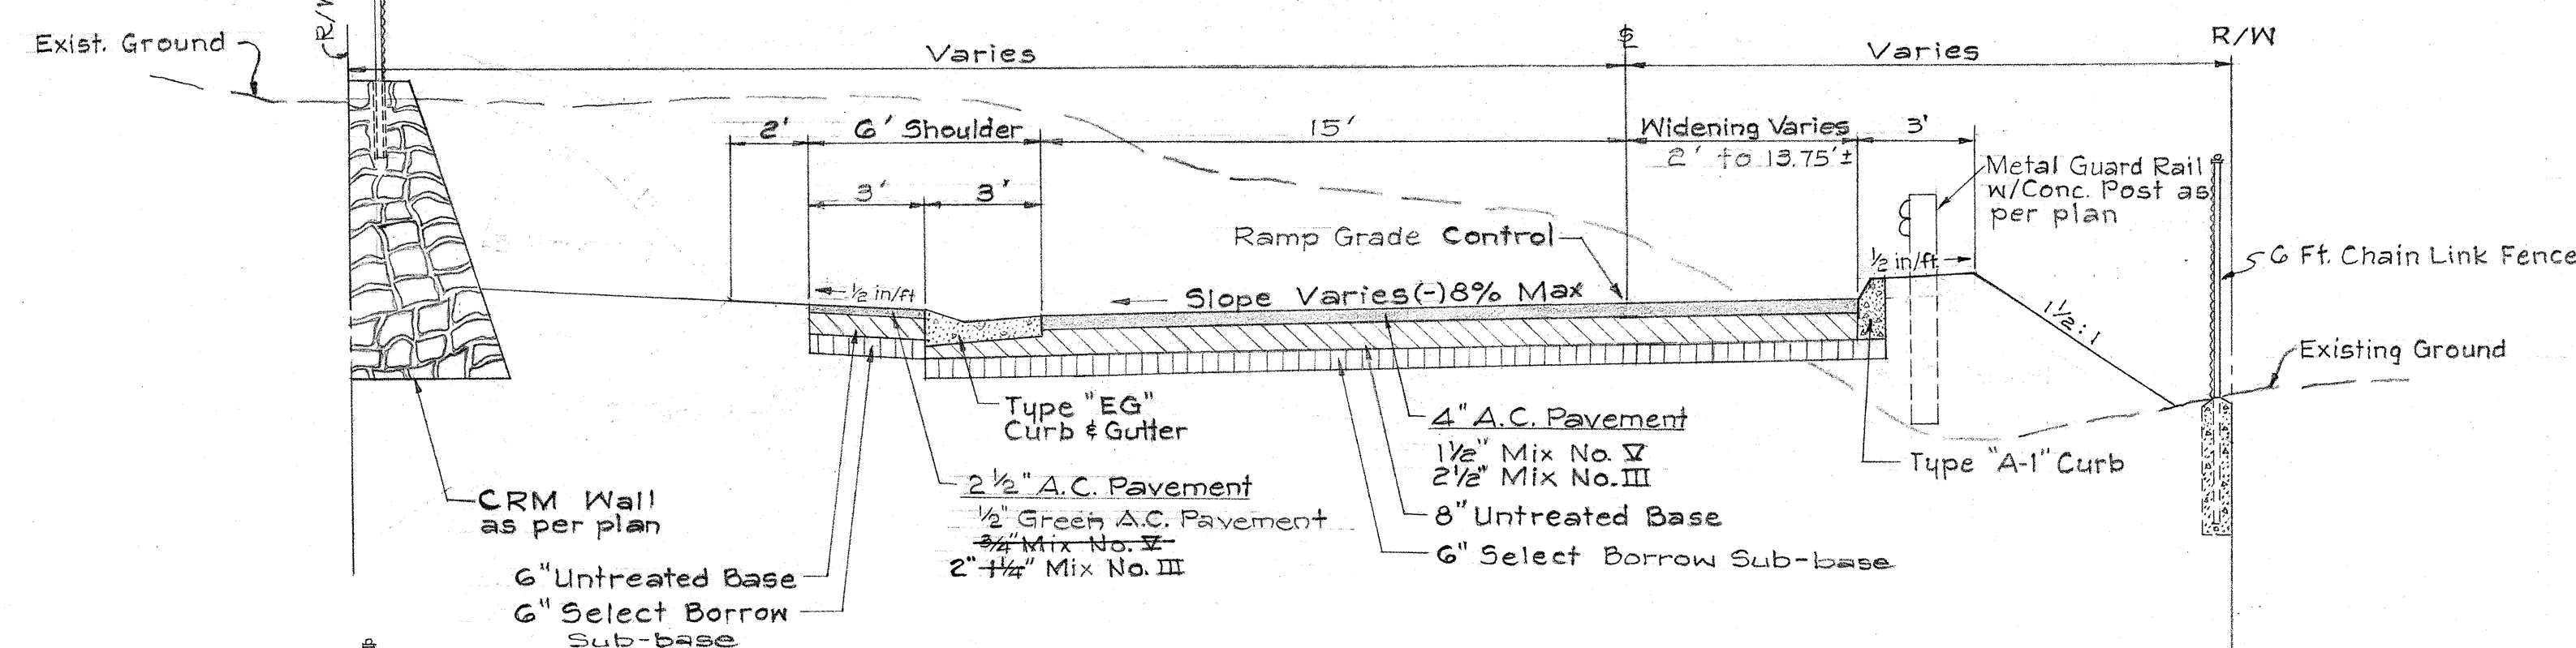

TYPICAL SECTION-RAMP 5-A
STA. 10+86.57 to 14+09.22

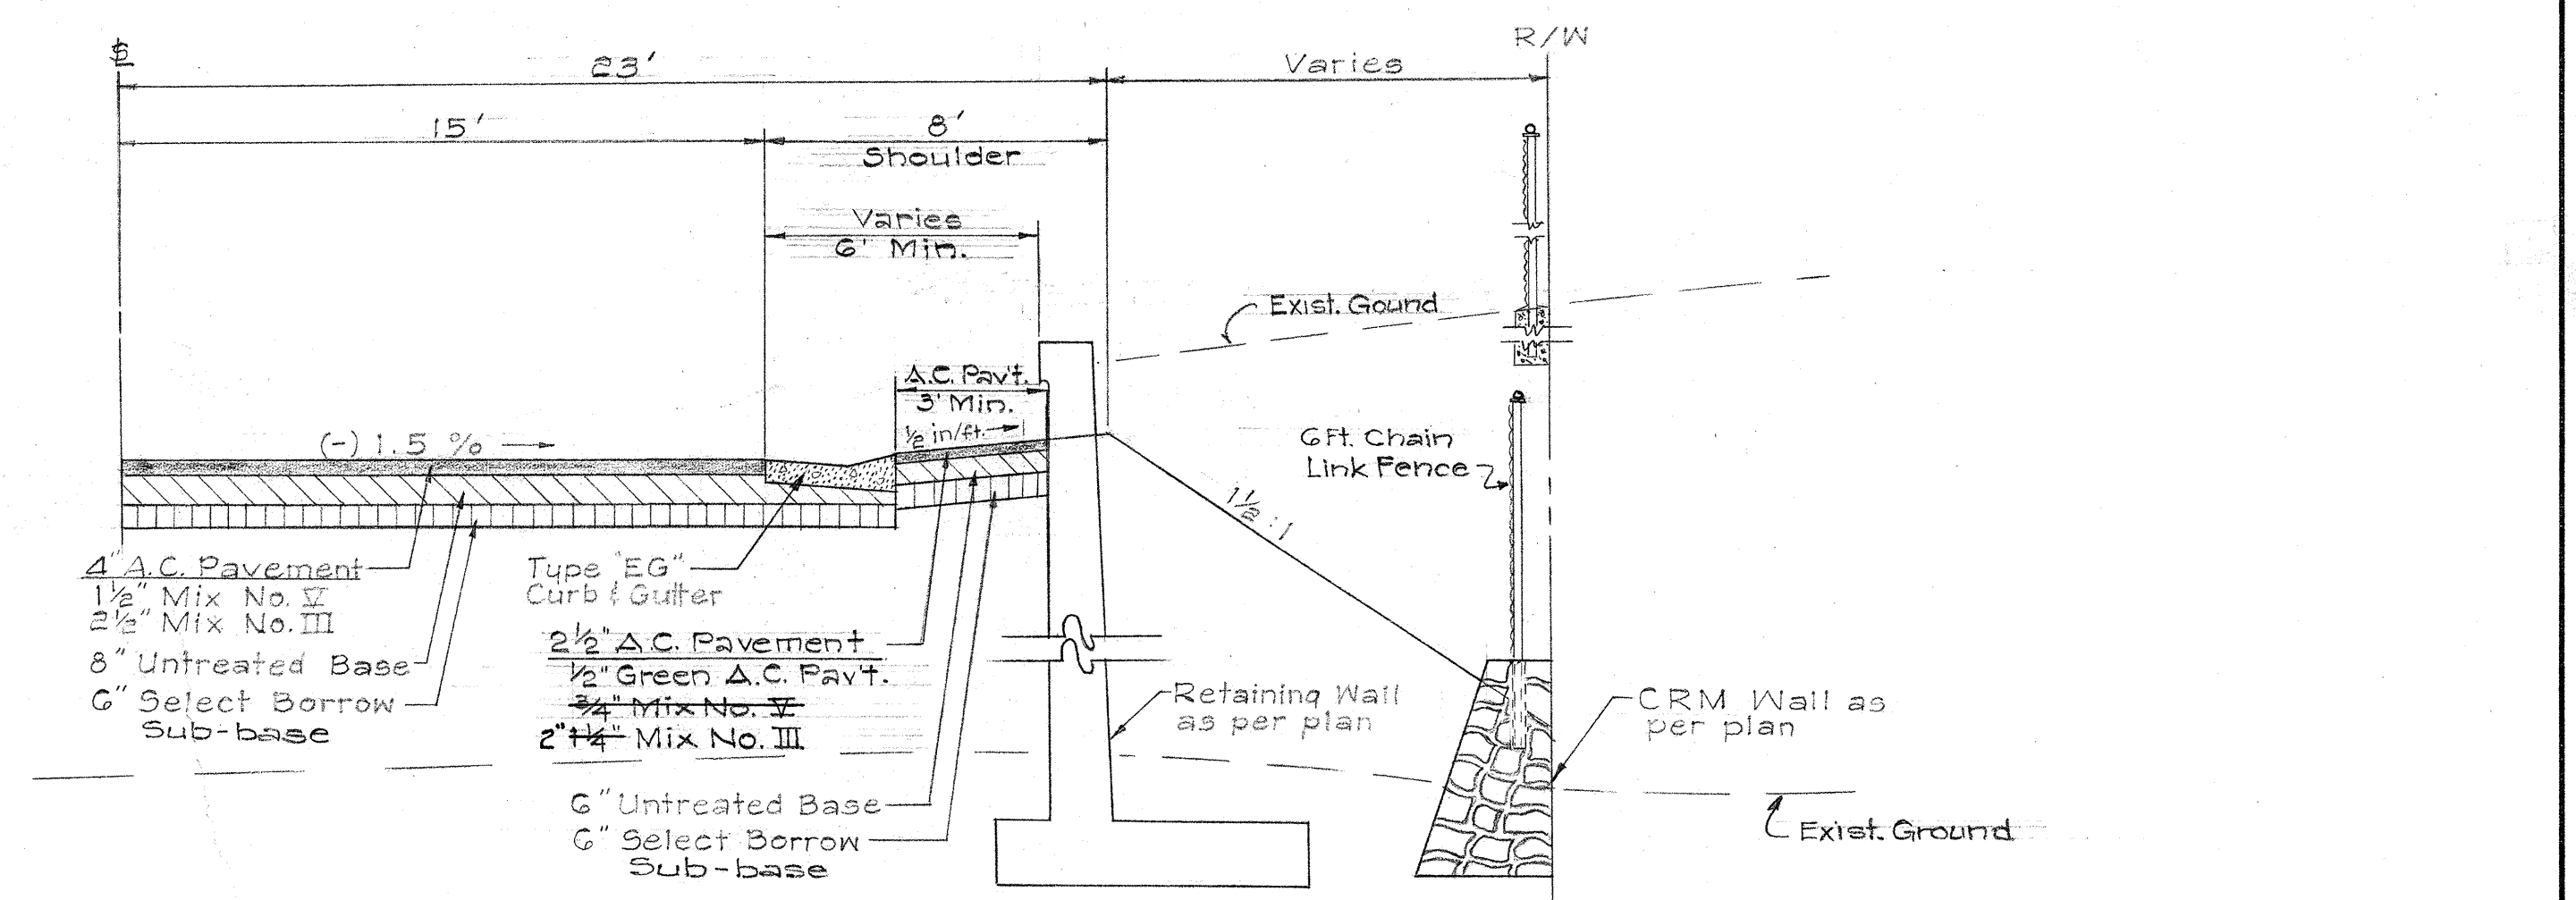

TYPICAL SECTION-RAMPS
Ramp G-A STA. 0+00 to 2+39.15
Ramp KO STA. 0+00 to 2+51.05

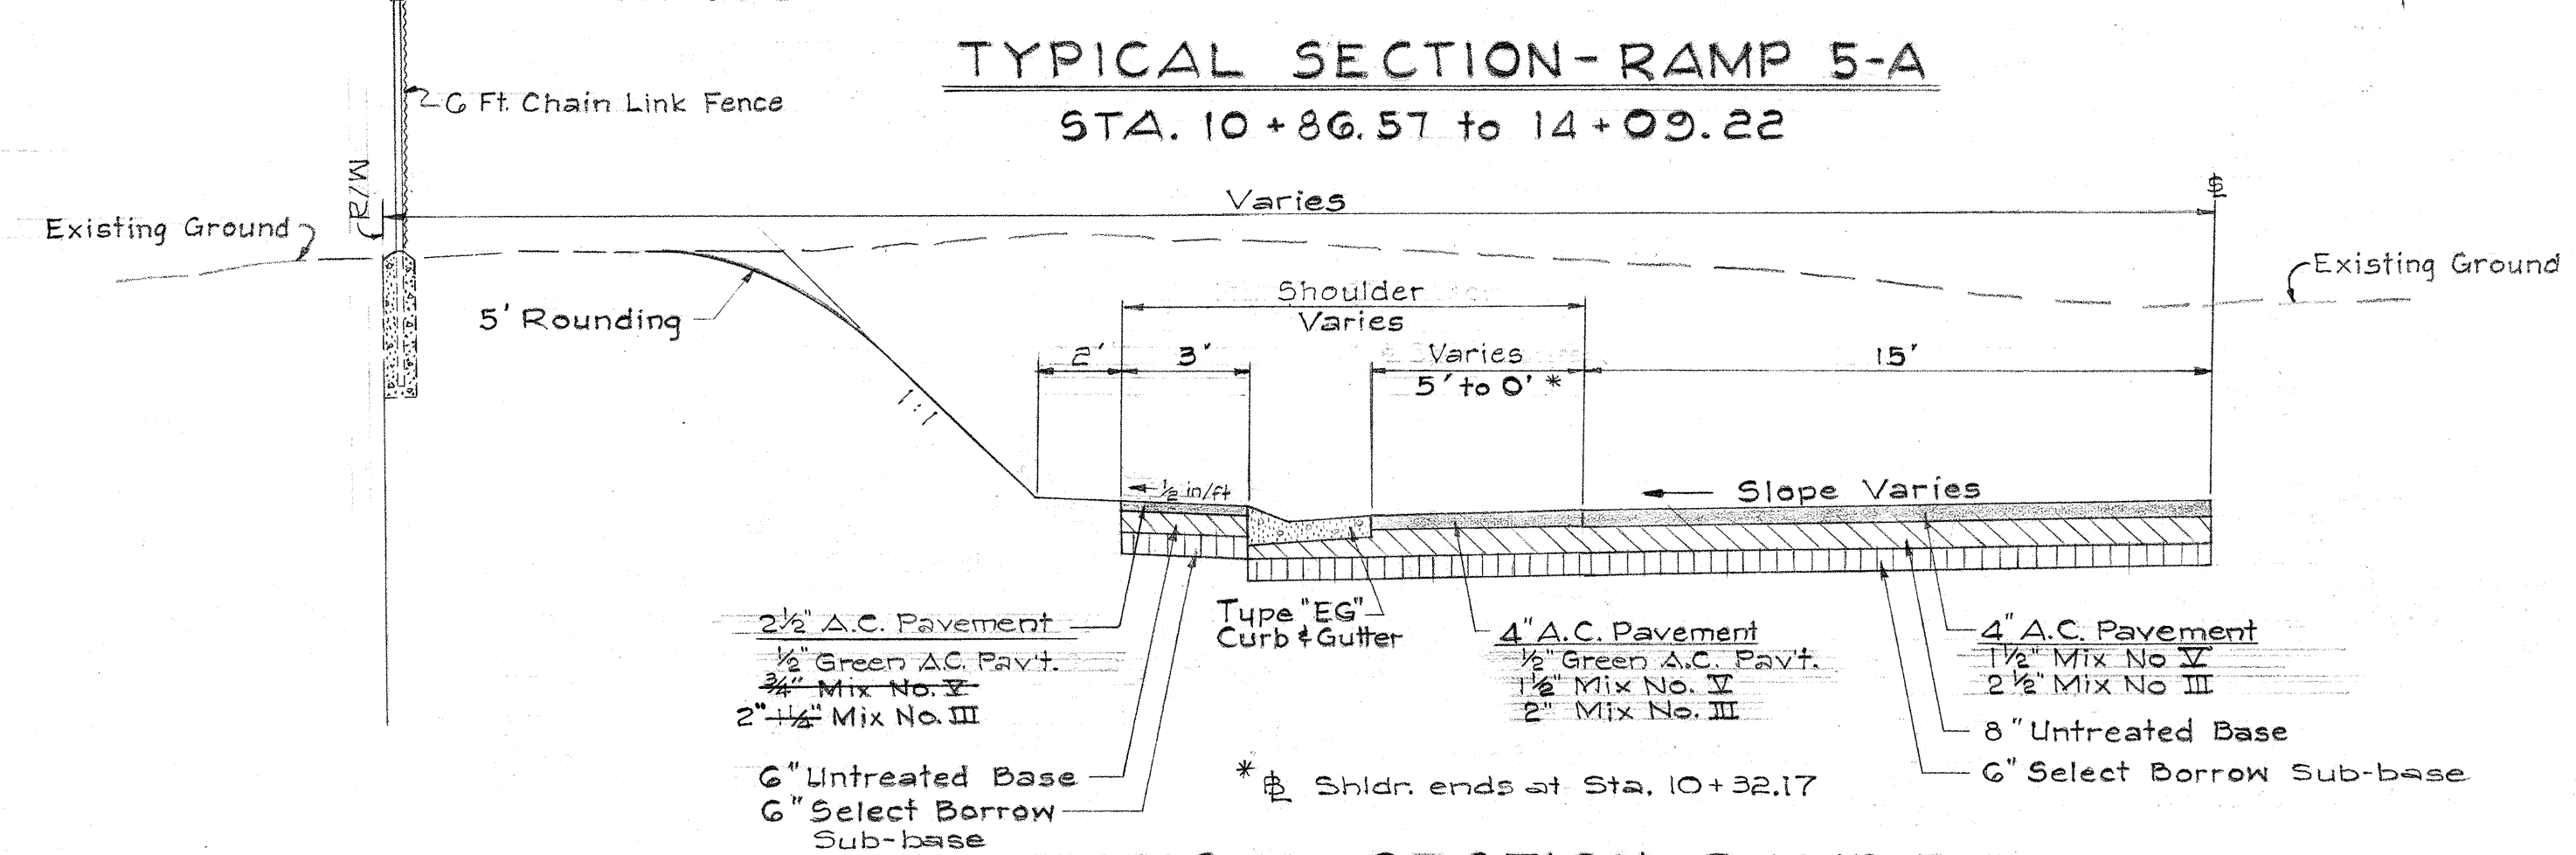

TYPICAL SECTION-RAMP 5-A
STA. 9+54 to 10+66.20

Note: On Ramp KO, Green A.C. Shoulder transitions from 5' to 0' between Ramp Rt. E.P. & Lt. edge of Type "EG" curbs & gutter. For Pavement Section of Green A.C. shoulder refer to Typical Section No. 9 for Rt. Shoulder Section (Sta. 99+42 to 100+04.08) which varies from 8' to 5'.

STATE OF HAWAII
DEPARTMENT OF TRANSPORTATION
HIGHWAYS DIVISION

LUNALILO FREEWAY
F.A.I. PROJ. No. I-HI-1(4):24

TYPICAL SECTIONS

Scale: 1/4"=1'-0" Date: Oct. 16, 1962

SHEET No. 6 OF 7 SHEETS

SURVEY PLOTTED BY	DATE
DRAWN BY	
DESIGNED BY	
QUANTITIES BY	
CHECKED BY	
ORIGINAL PLAN	
NOTE BOOK	
No.	