




FED. ROAD DIST. NO.	STATE	FED. AID PROJ. NO.	FISCAL YEAR	SHEET NO.	TOTAL SHEETS
HAWAII	HAW.				

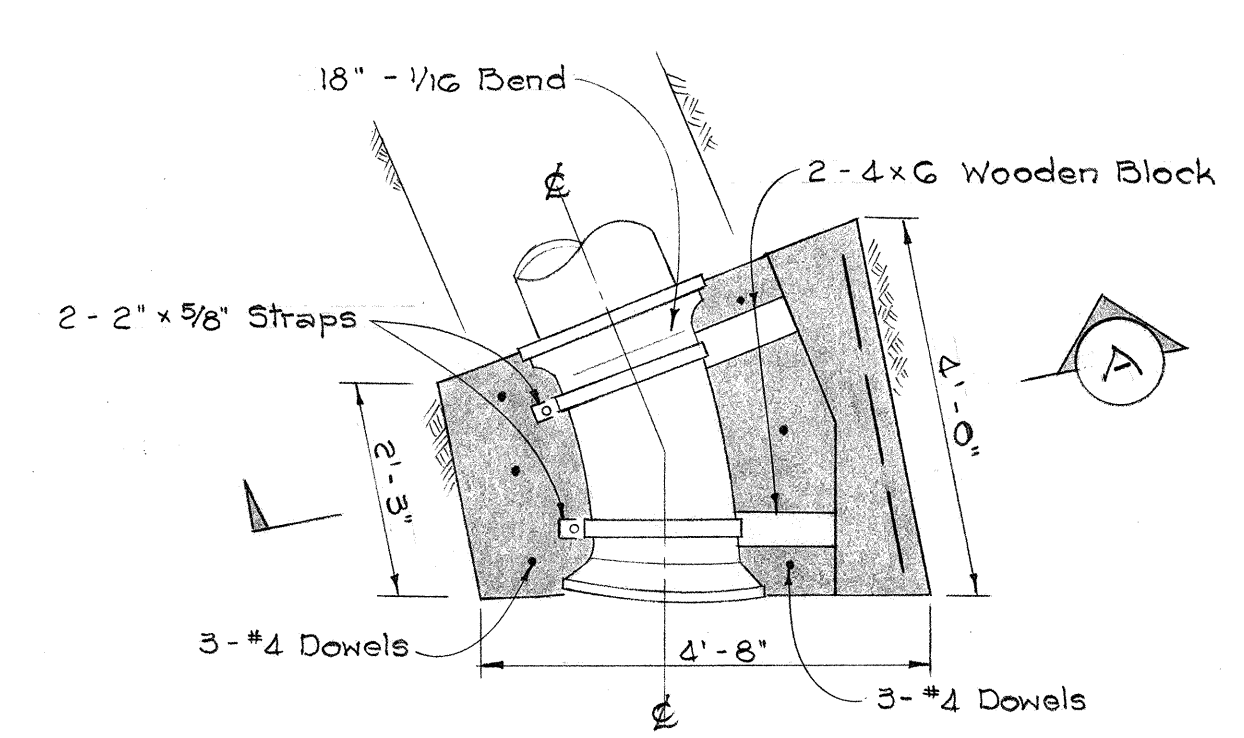

PLAN
Scale: 1/2" = 1'-0"

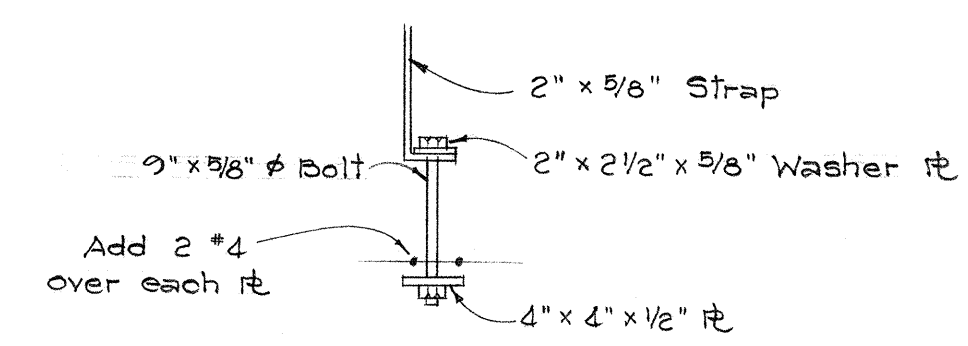


ANCHOR DETAIL
Scale: 1" = 1'-0"

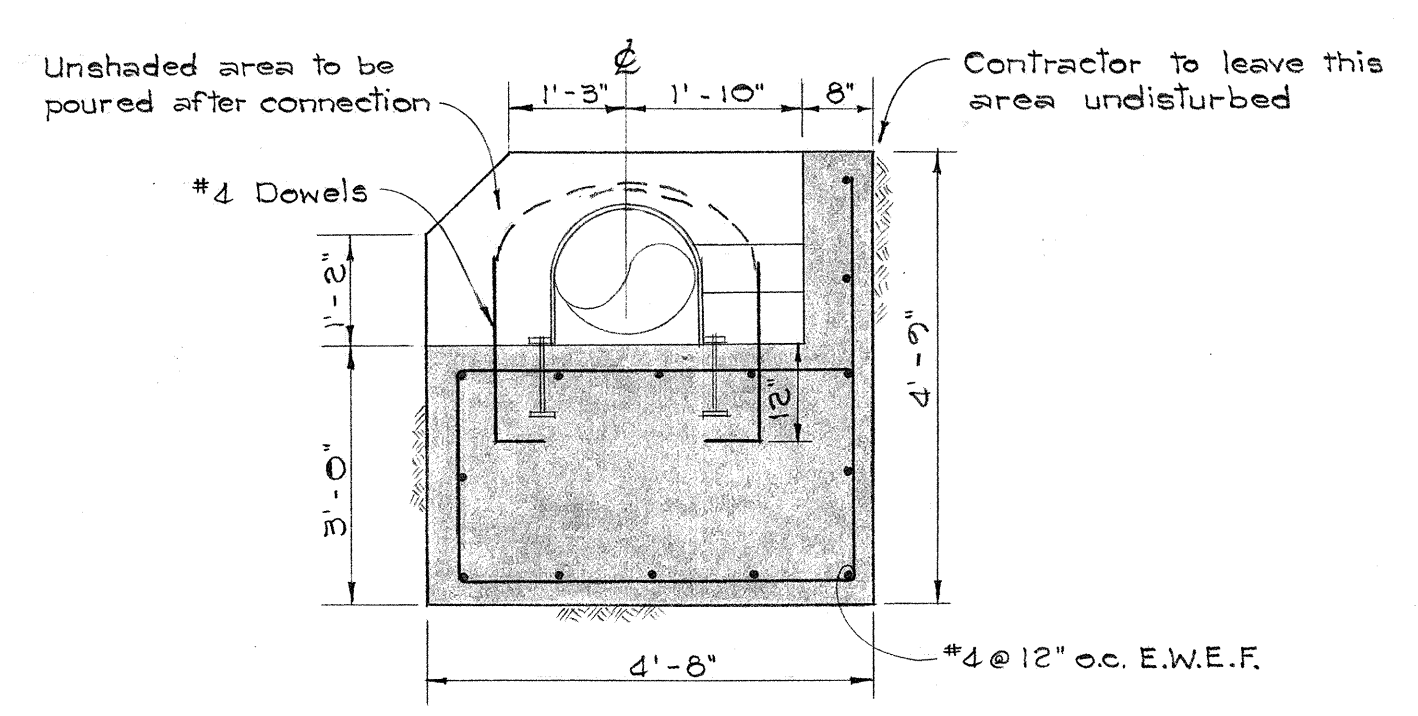


SECTION "A"
Scale: 1/2" = 1'-0"

CONCRETE BLOCK 18" - 1/16 BEND CONNECTION
AT K.O. STA. 10+07
Scale: As Shown

- NOTE:
1. Class "B-1" concrete.
 2. Unformed surface - 3" cover over reinforcing steel.
 3. Contractor to verify dimensions in field before fabrication.

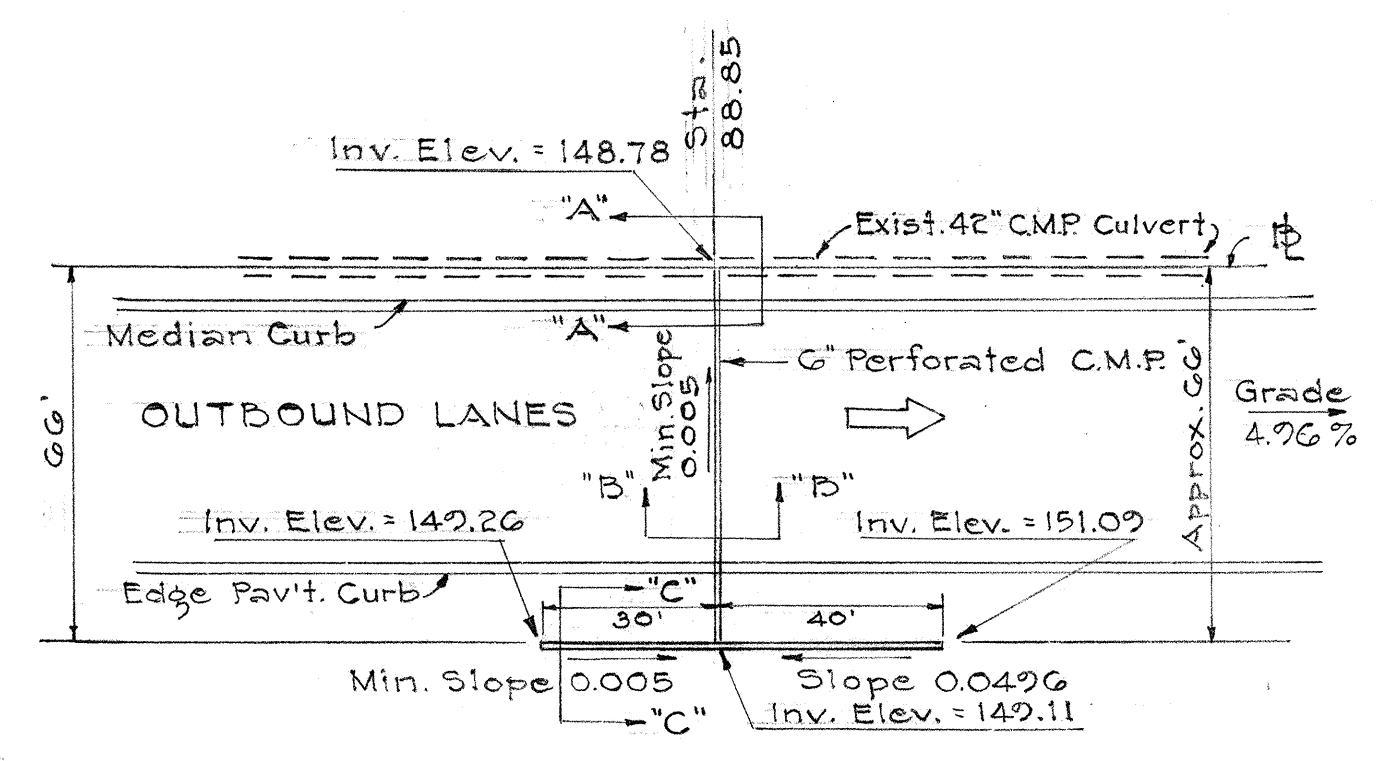


PLAN

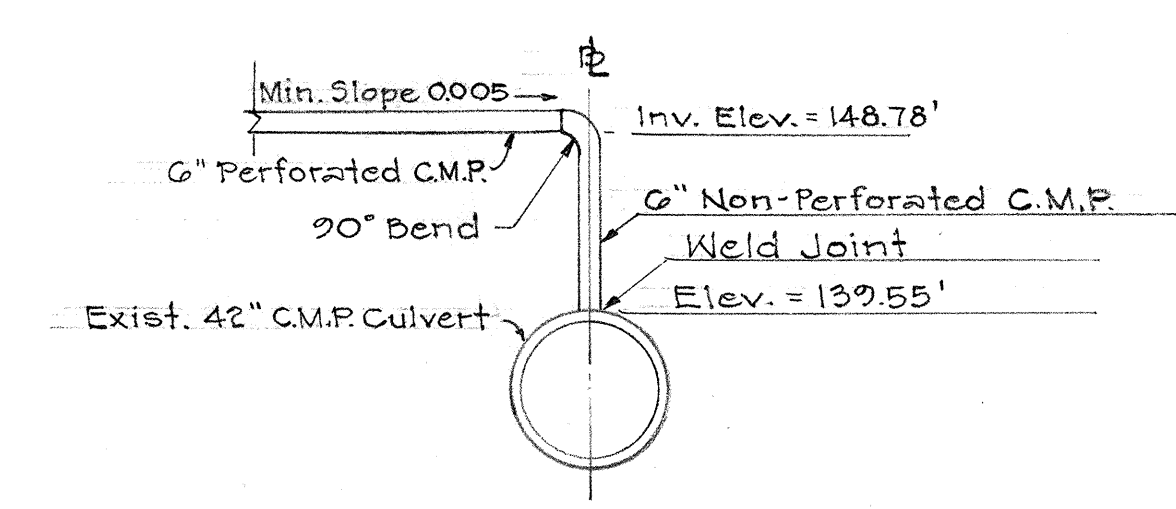


SECTION "A-A"


SUB - DRAIN INSTALLATION
AT STA. 88+85
Not To Scale
"AS BUILT"

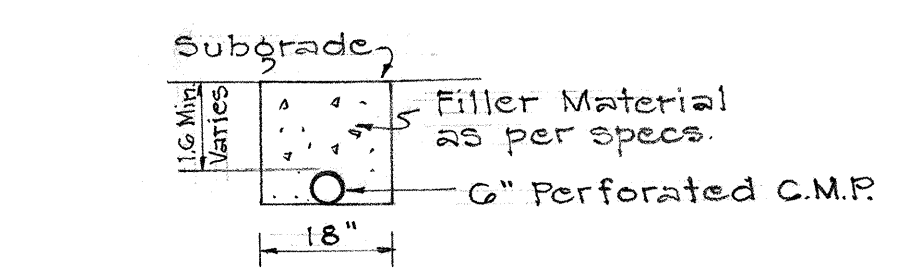


SECTION "B-B"

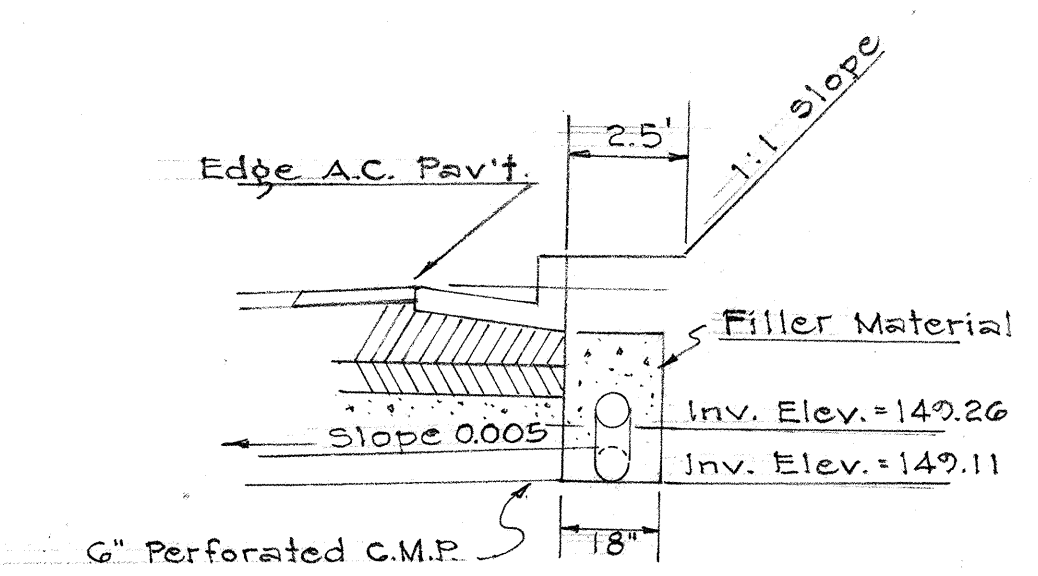

SECTION "C-C"

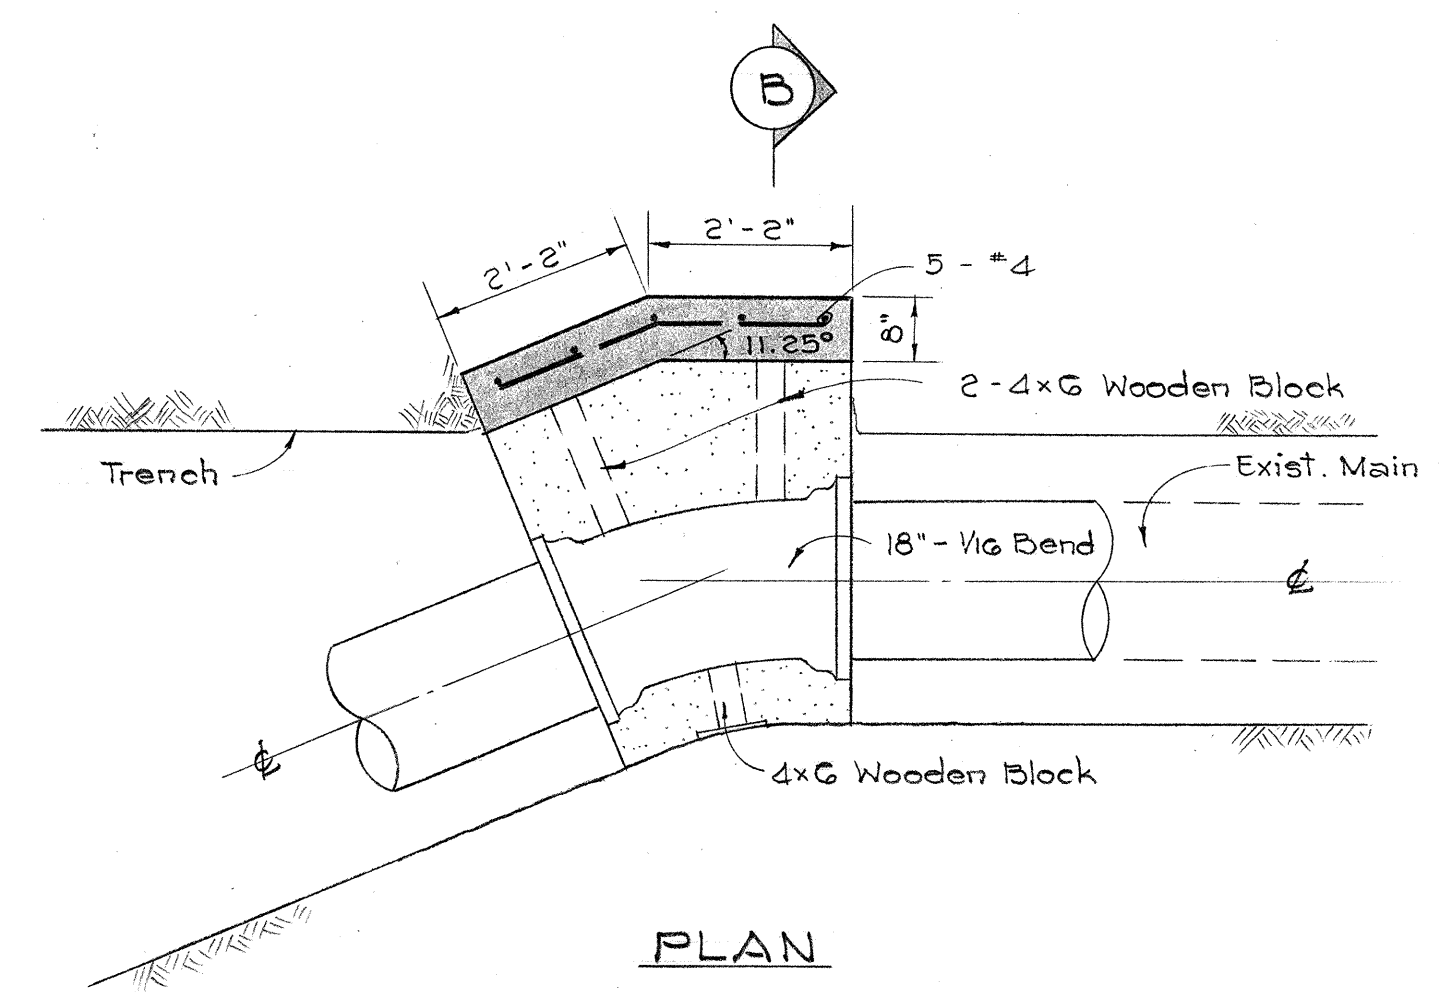

PLAN

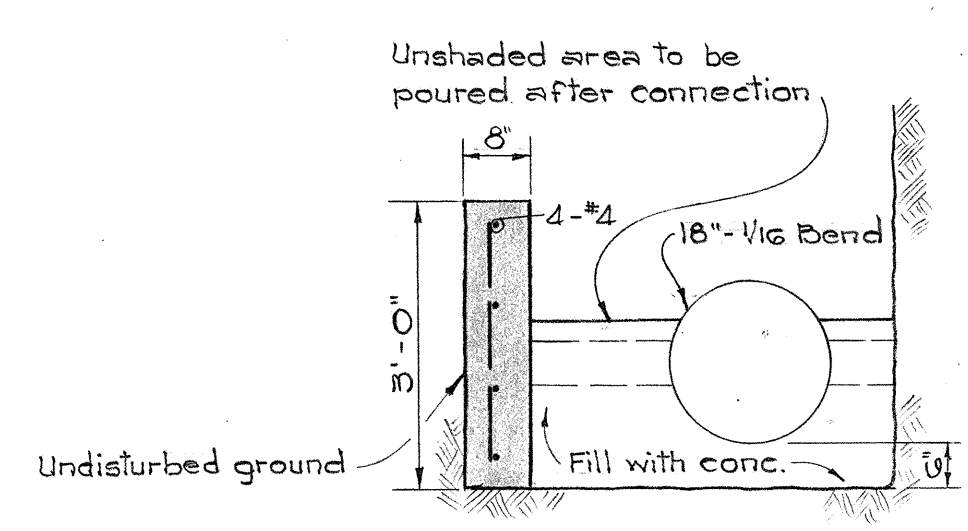

SECTION "B"

CONCRETE BLOCK 18" - 1/16 BEND CONNECTION
AT K.O. STA. 16+35
Scale: 1/2" = 1'-0"

- NOTE:
1. Class "B-1" concrete

STATE OF HAWAII
DEPARTMENT OF TRANSPORTATION
HIGHWAYS DIVISION

UTILITIES
WATER, SEWER AND GAS

LUNALILO FREEWAY Proj. No. I-HI-1(4):24
Scale: As Shown Date: July, 1964.

SHEET No. OF SHEETS