

FINAL	SURVEYED	DATE
SURVEY	NOTED	
NOTE BOOK	AREAS	
NO.	CHECKED	

ORIGINAL	SURVEYED	DATE
SURVEY	NOTED	
NOTE BOOK	AREAS	
NO.	CHECKED	

FED. ROAD DIST. NO.	STATE	FED. AID PROJ. NO.	FISCAL YEAR	SHEET NO.	TOTAL SHEETS
HAWAII	HAW	U-072-1(10)	1963	A35	45

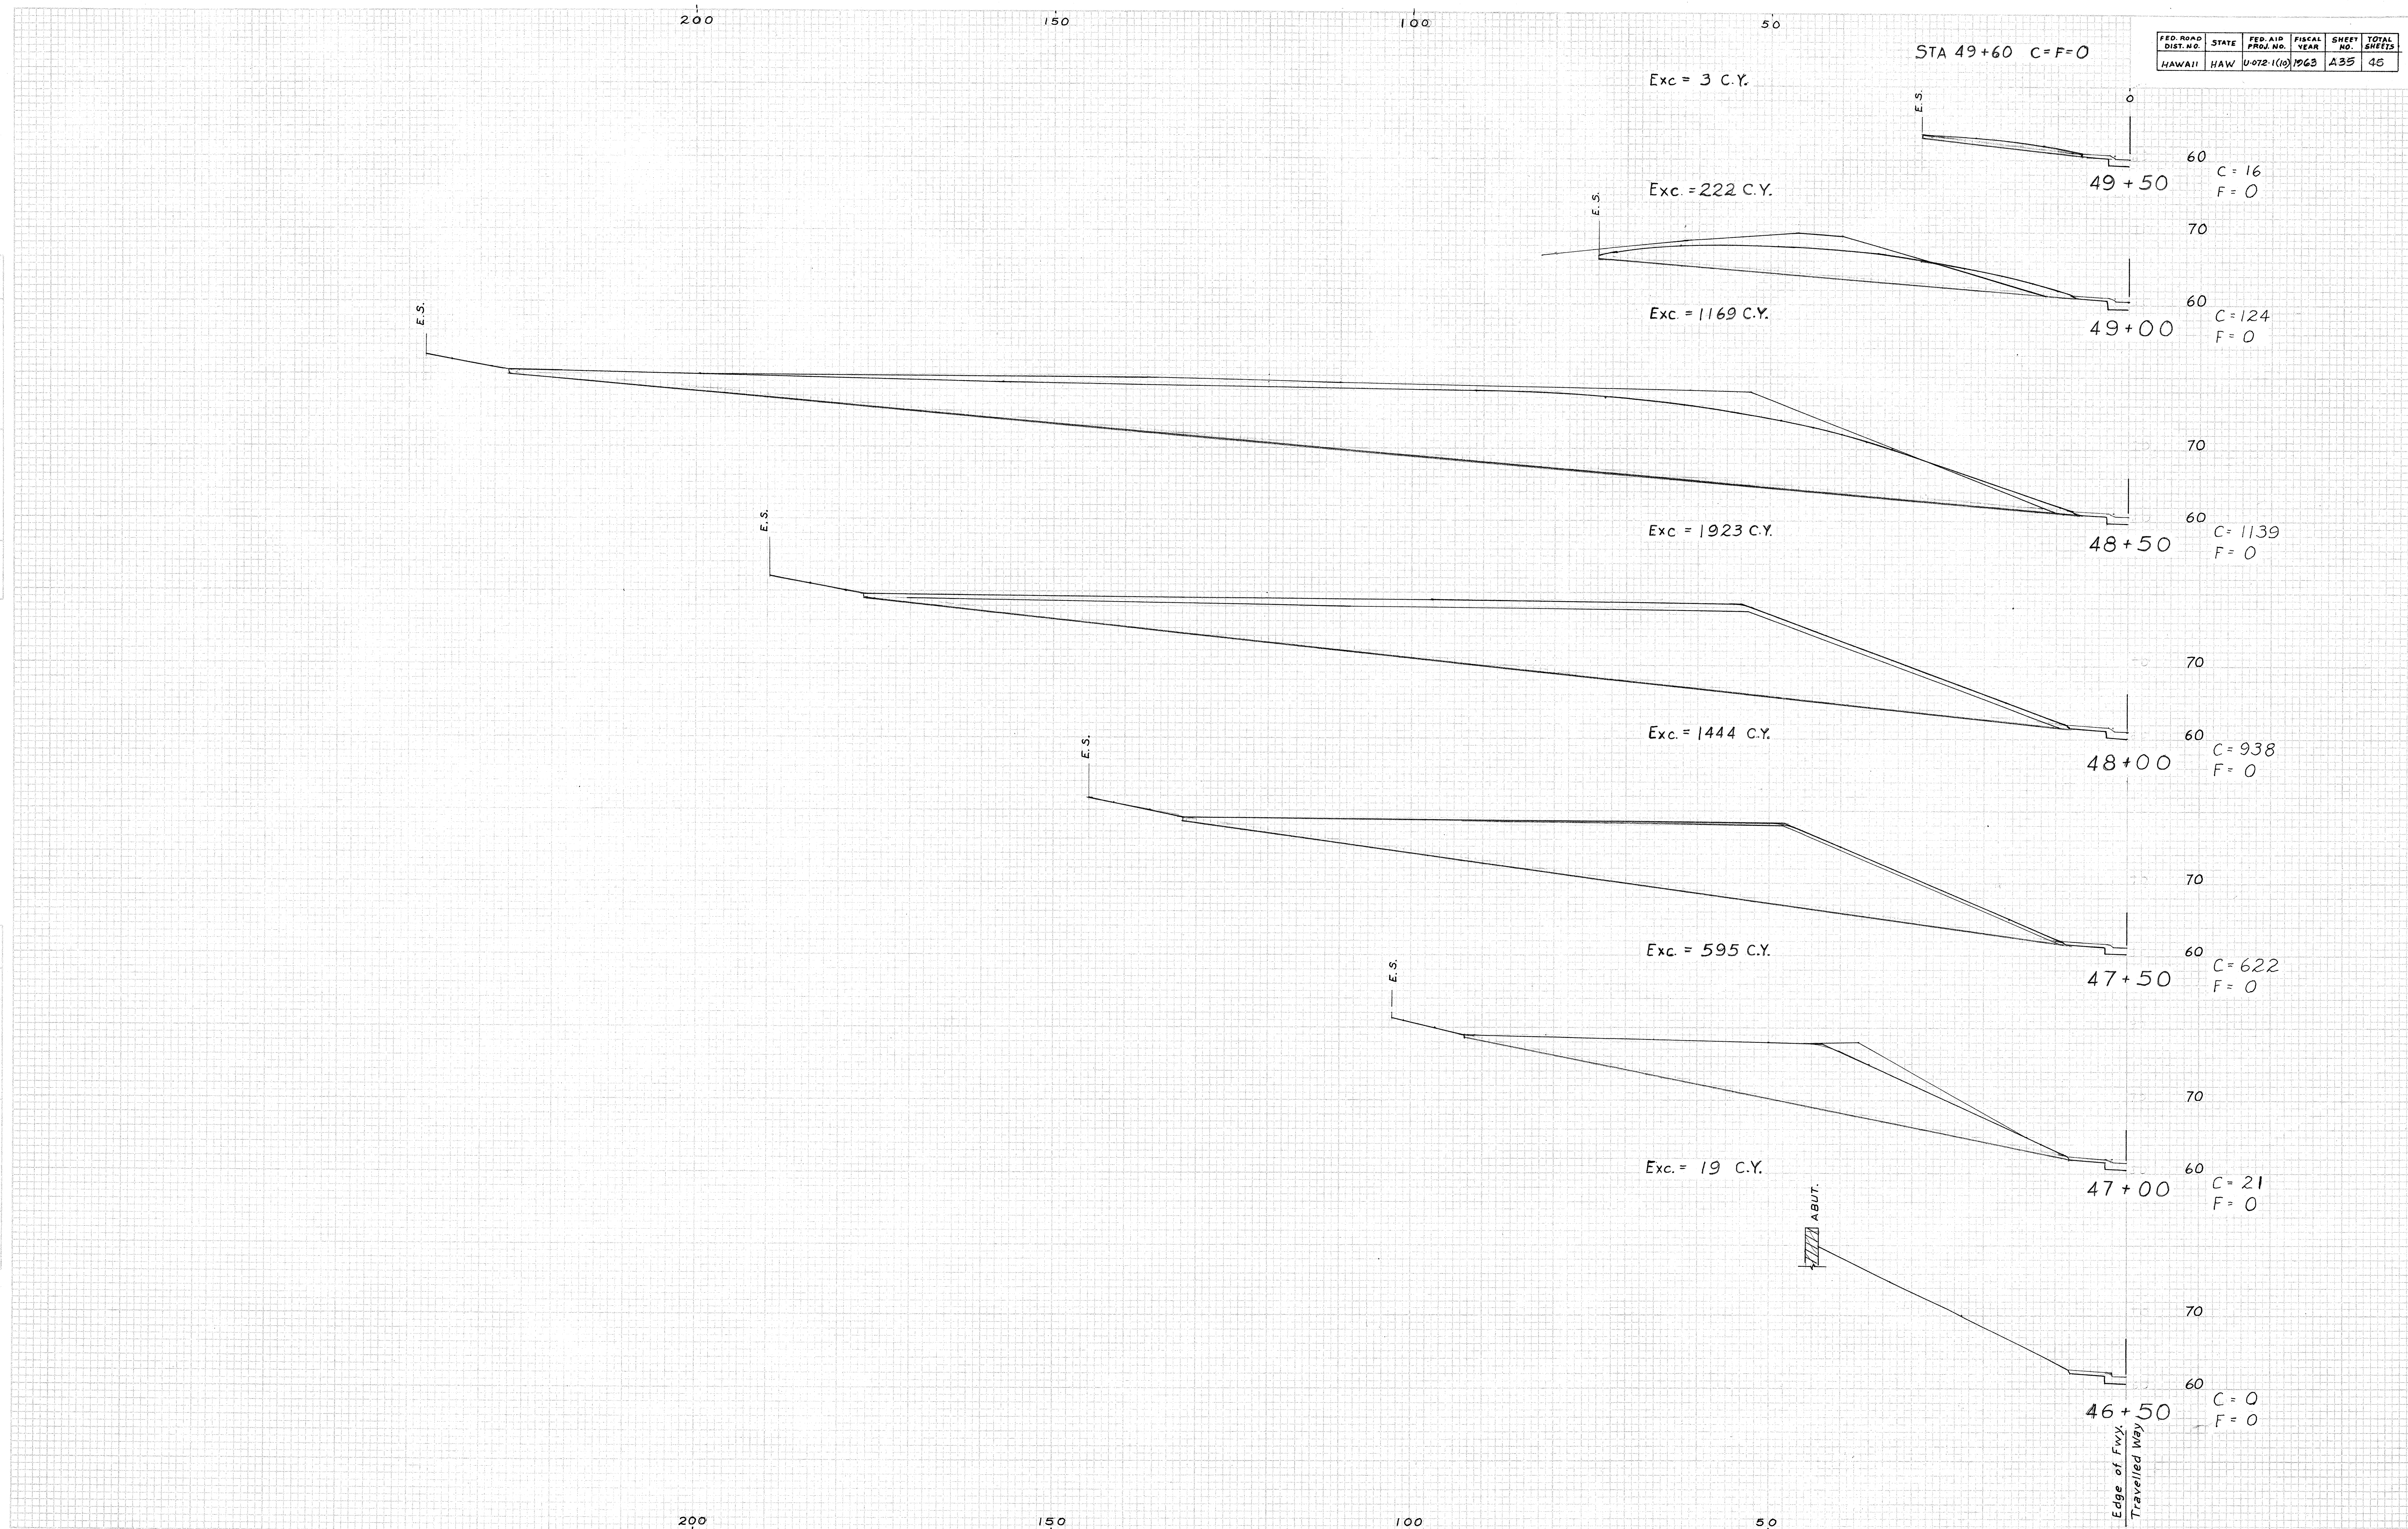


PLATE 3 - CROSS SECTION - A.S.
CLEARING OF PAPER CO., S. F. CAL.

NO. 10336-3