

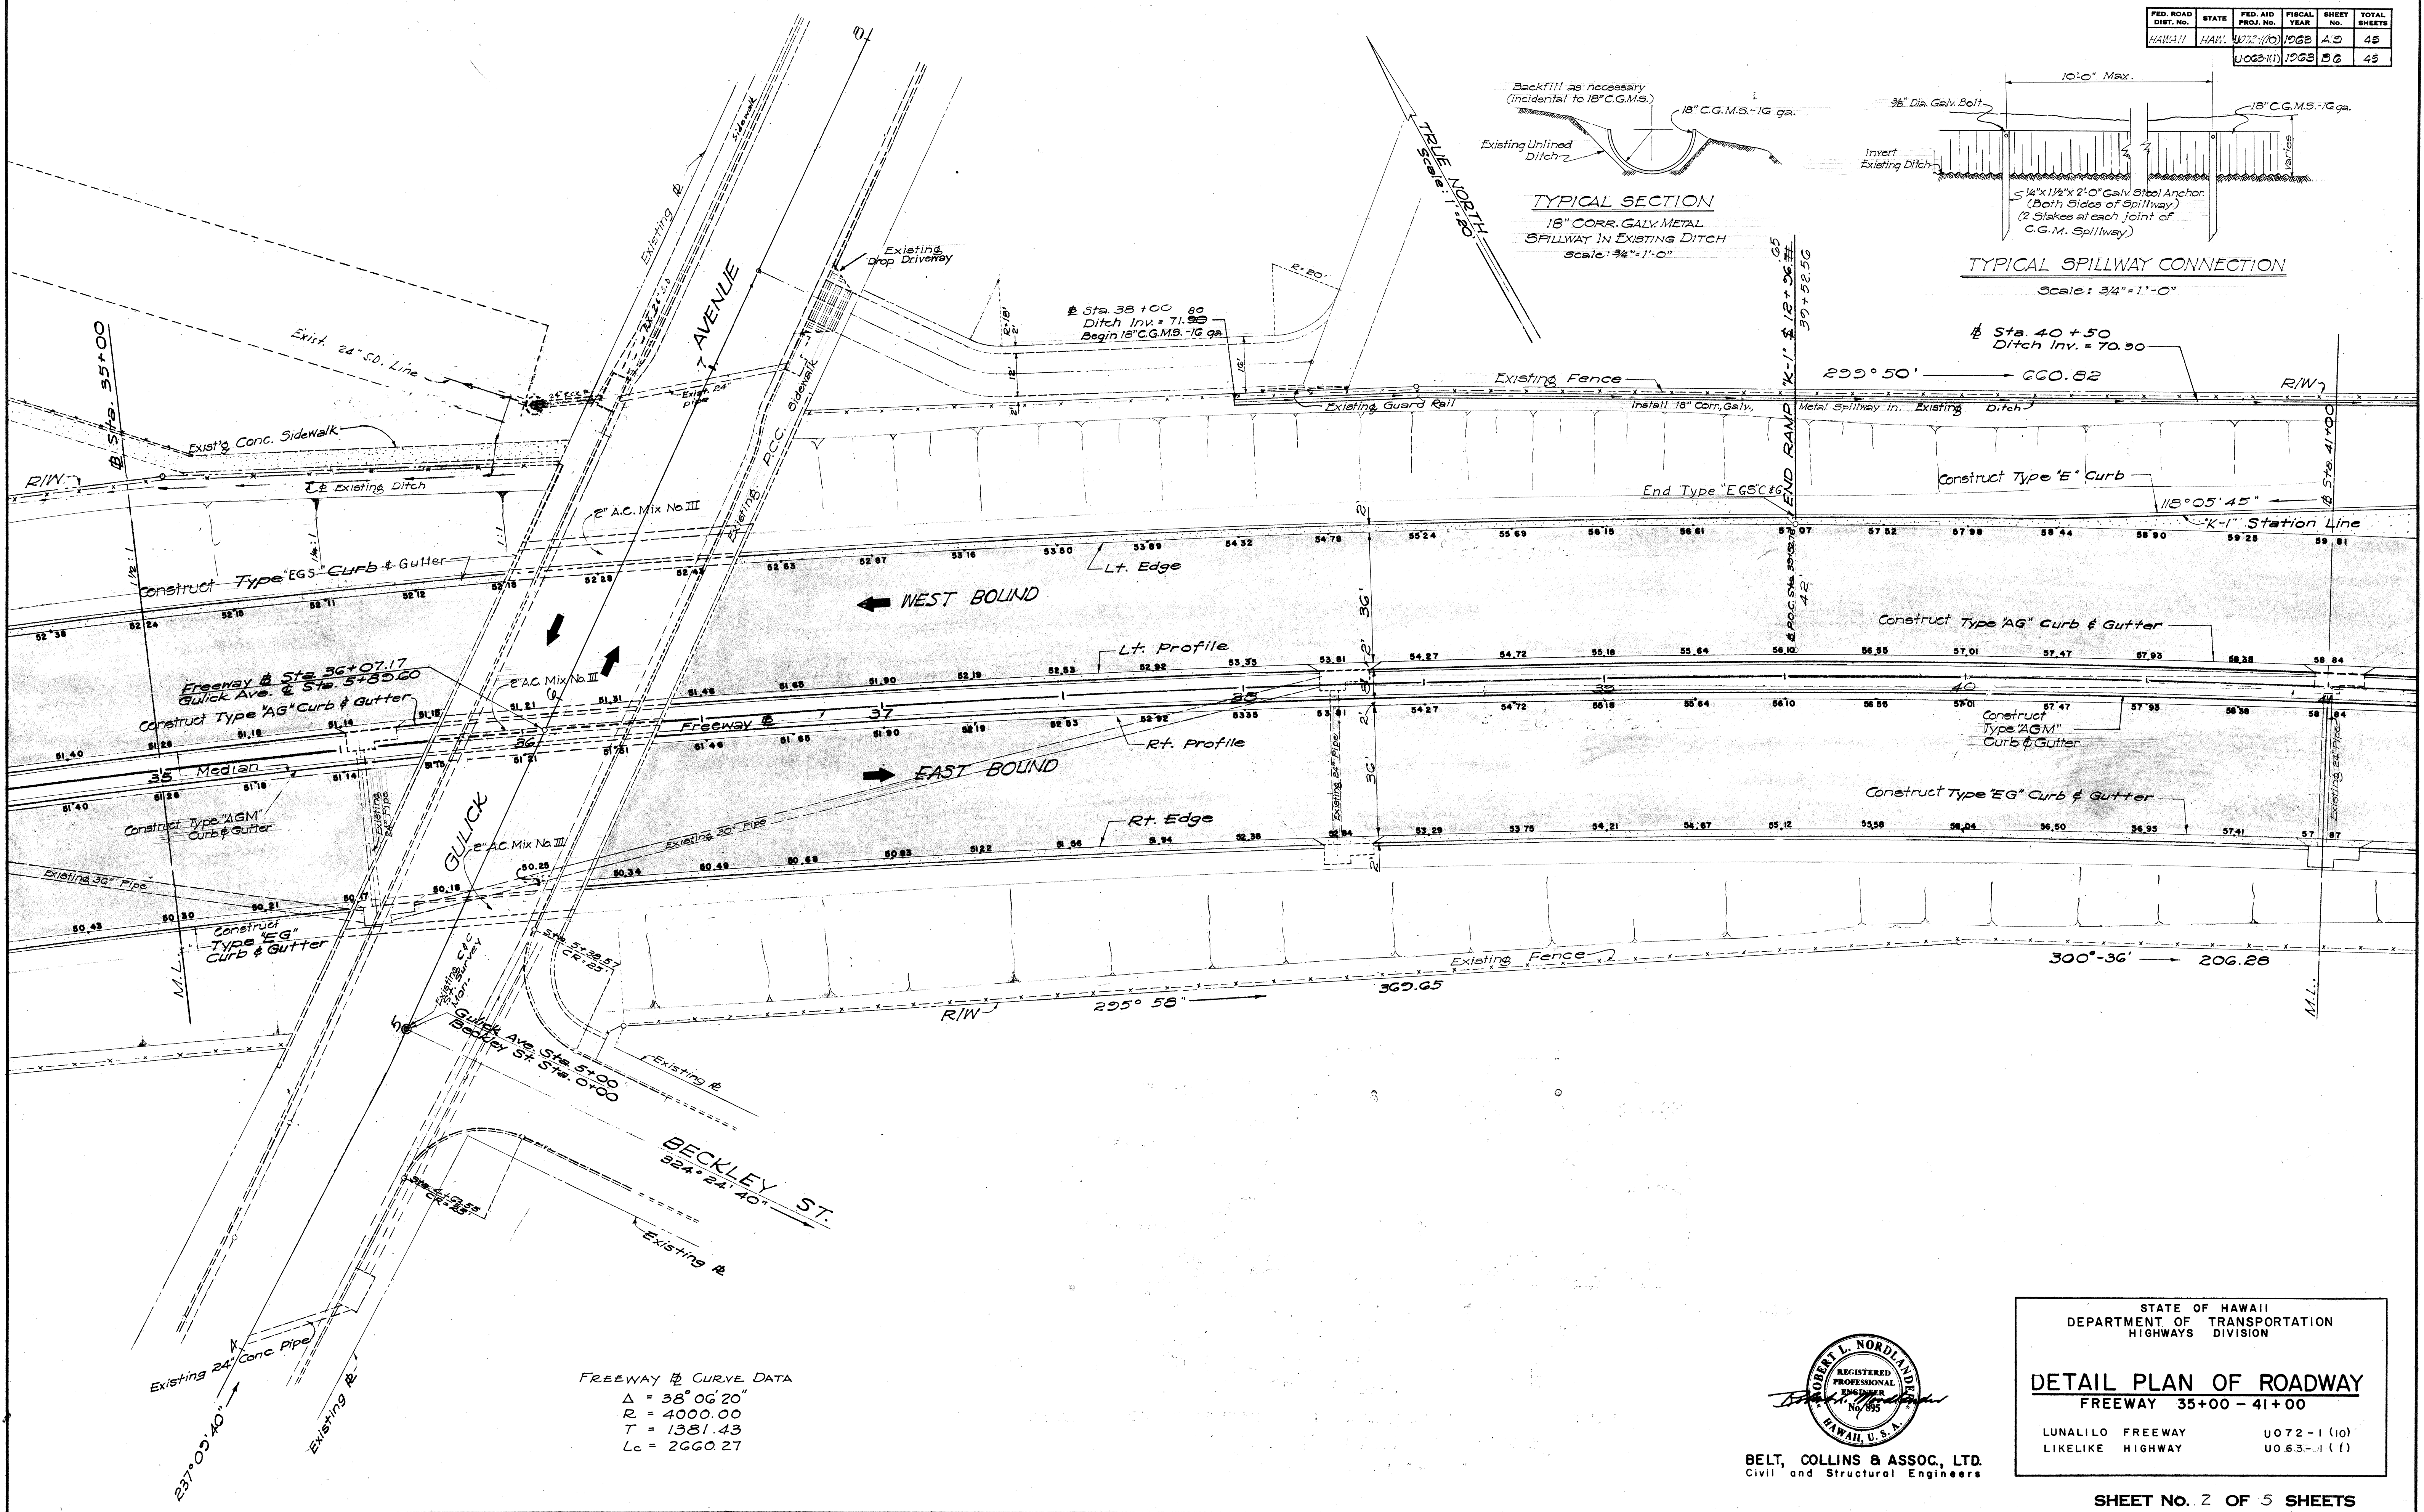
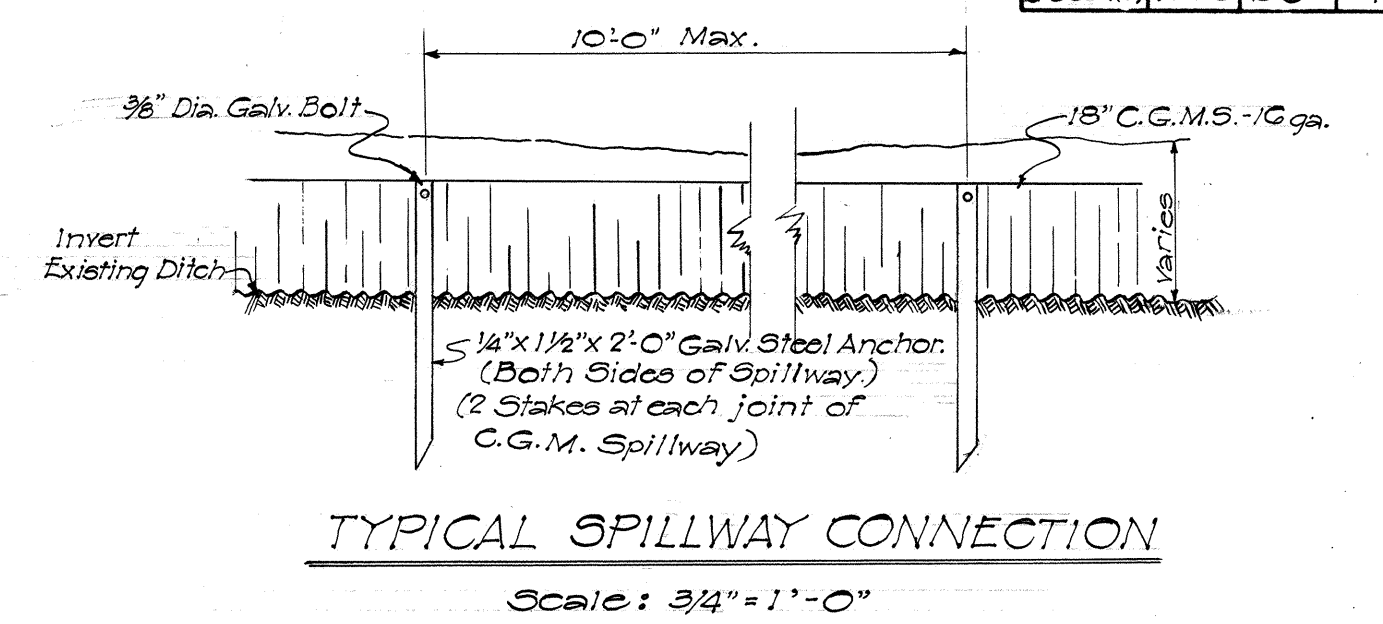


FED. ROAD DIST. NO.	STATE	FED. AID PROJ. NO.	FISCAL YEAR	SHEET NO.	TOTAL SHEETS
HAWAII	HAW.	402-1(10)	1963	49	48
		U063-1(1)	1963	56	48

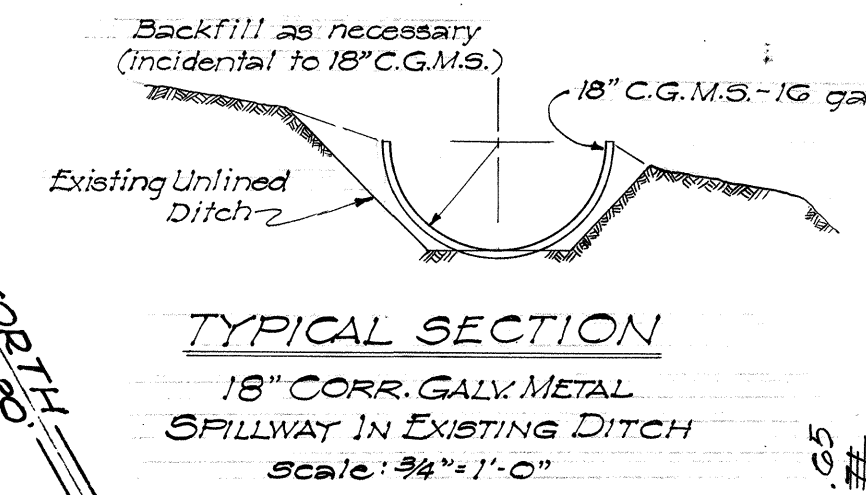

FREEWAY 35 CURVE DATA
 $\Delta = 38^{\circ} 06' 20''$
 $R = 4000.00$
 $T = 1381.43$
 $L_c = 2660.27$

DESIGNED BY	DATE
DRAWN BY	
CHECKED BY	
QUANTITIES CHECKED BY	
NOTE BOOK	
CHECKED BY	

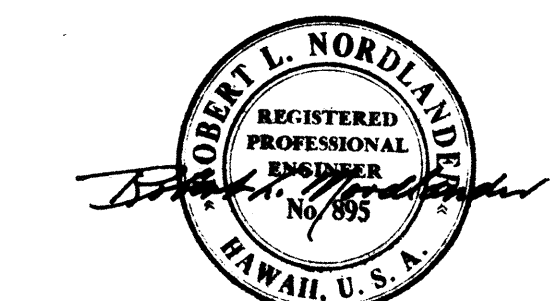

BELT, COLLINS & ASSOC., LTD.
 Civil and Structural Engineers

STATE OF HAWAII
 DEPARTMENT OF TRANSPORTATION
 HIGHWAYS DIVISION


DETAIL PLAN OF ROADWAY
 FREEWAY 35+00 - 41+00

LUNALILO FREEWAY U072-1 (10)
 LIKELIKE HIGHWAY U063-1 (1)



SHEET NO. 2 OF 5 SHEETS

A 9 B 6

FED. ROAD DIST. NO.	STATE	FED. AID PROJ. NO.	FISCAL YEAR	SHEET NO.	TOTAL SHEETS
HAWAII	HAW.	U072-1(10)	1963	A 10	43
		U063-1(1)	1963	B 7	43

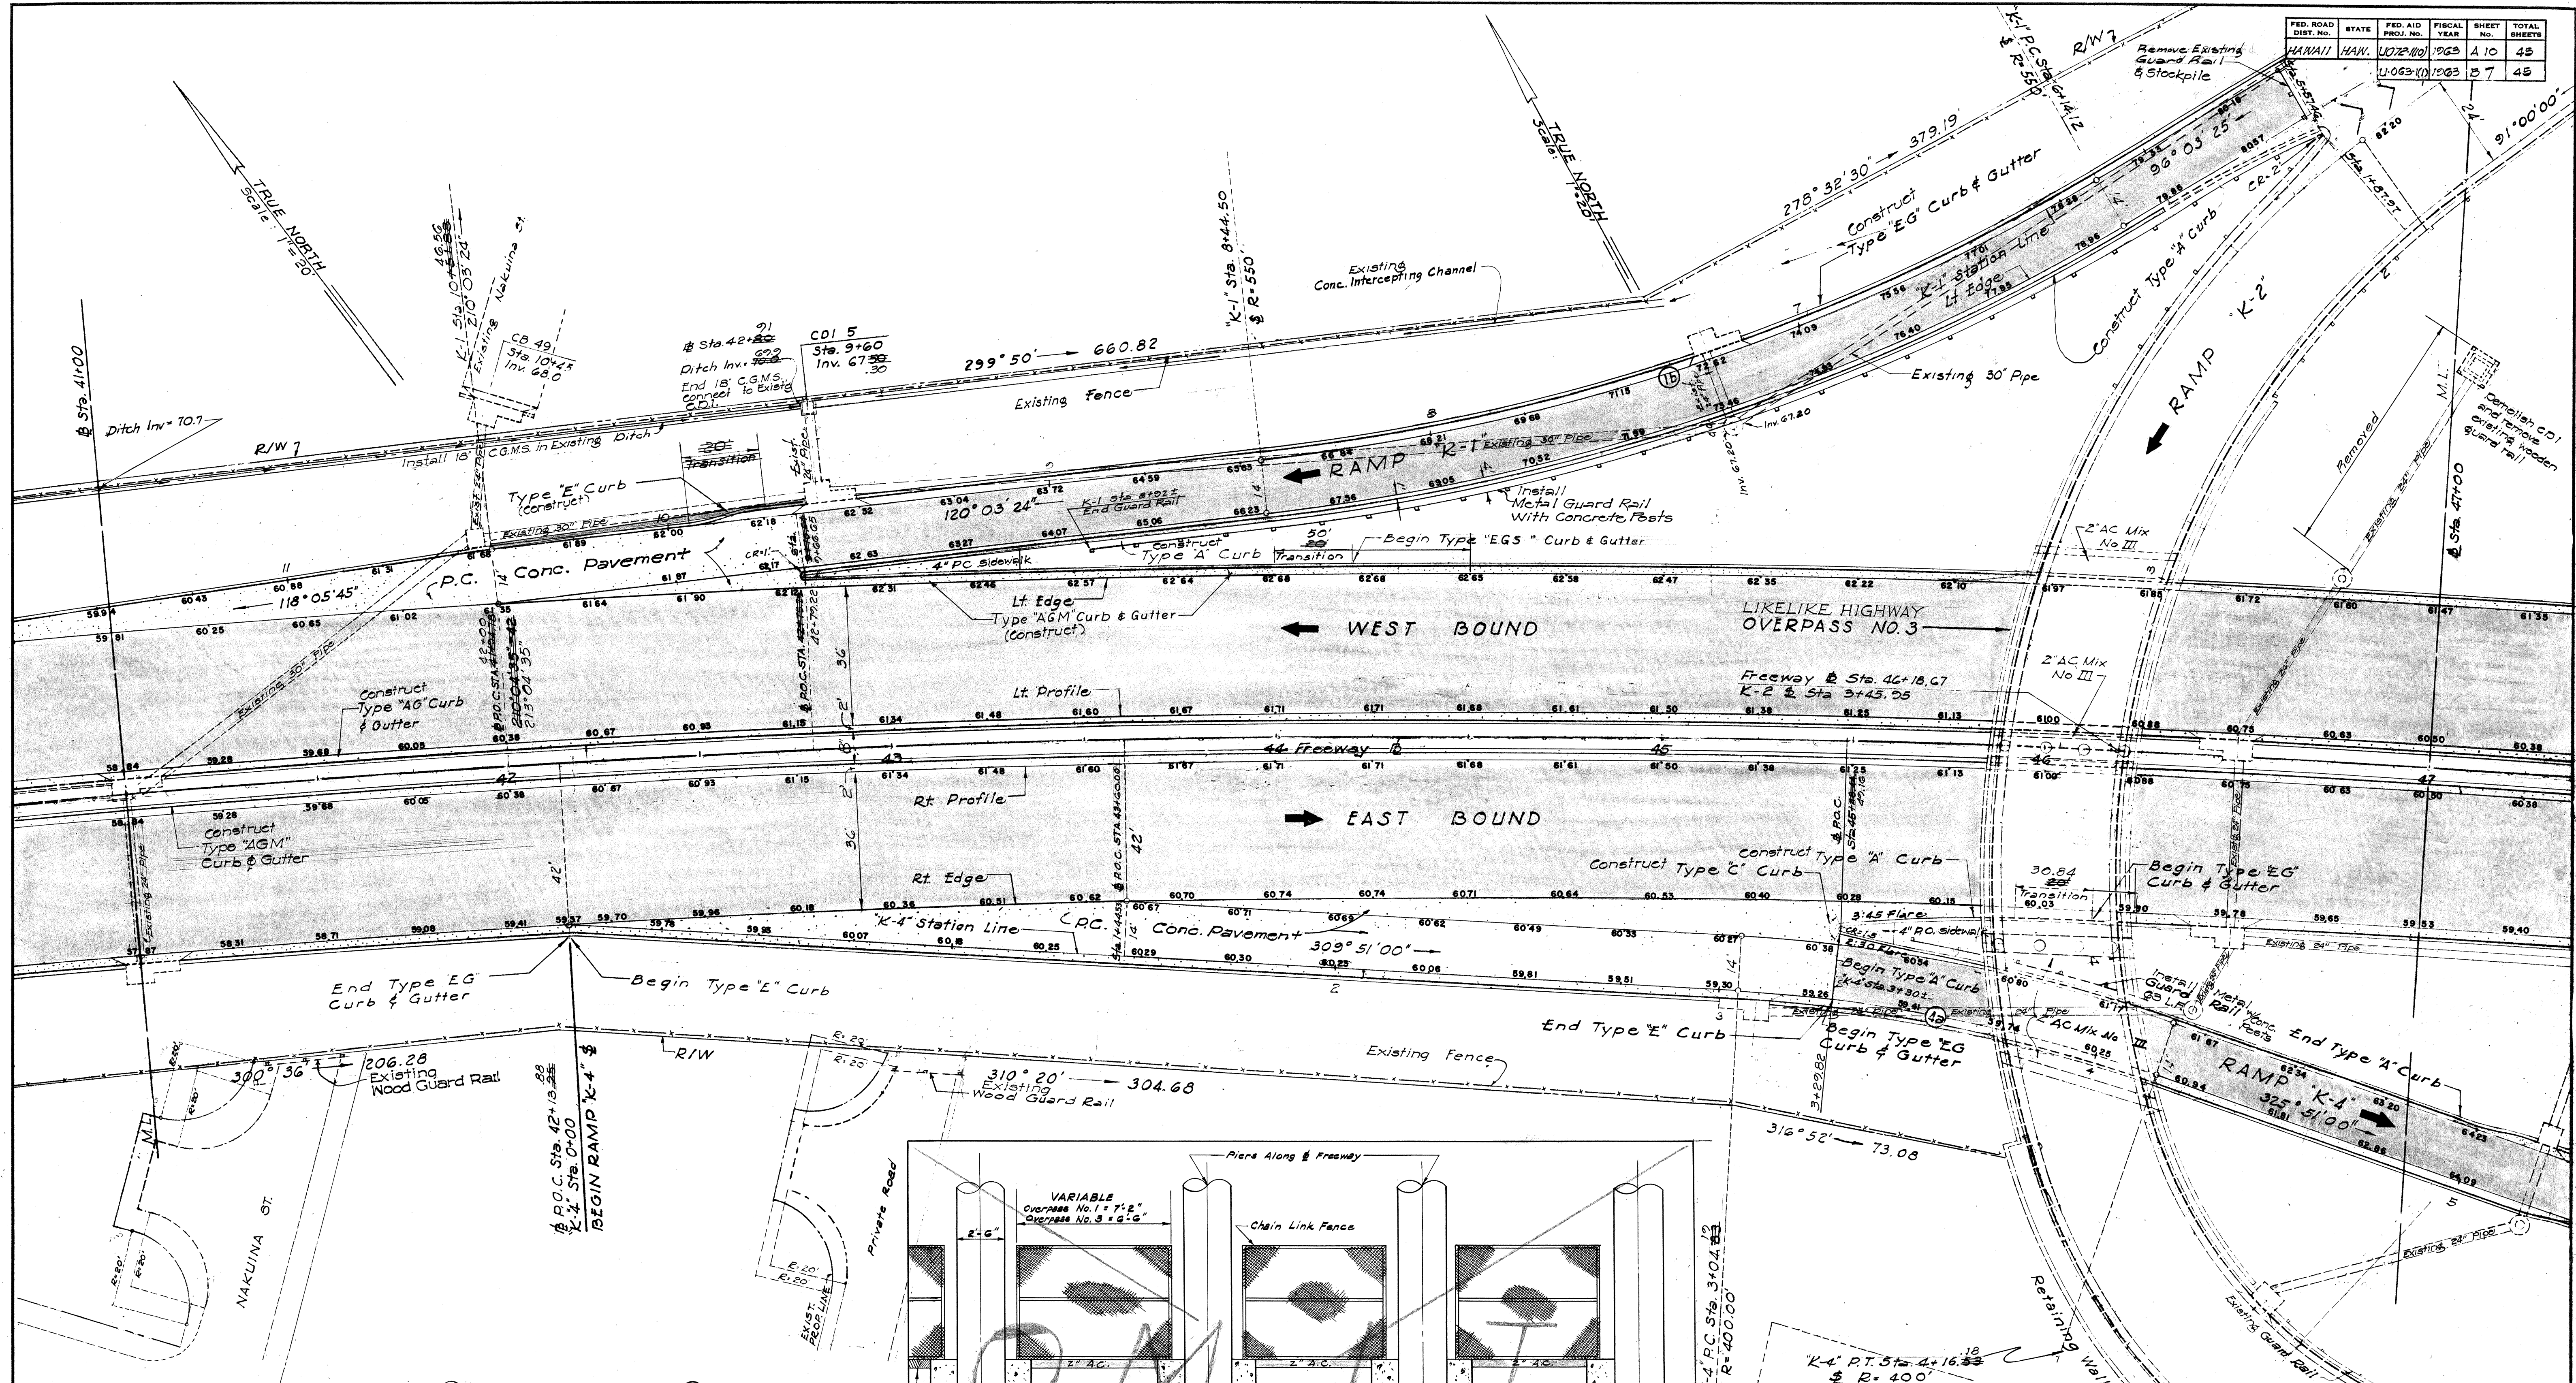

FREEWAY & CURVE DATA	(A) K-4 & CURVE DATA	(B) K-1 & CURVE DATA
$\Delta = 38^{\circ} 06' 20''$	$\Delta = 16^{\circ} 02' 30''$	$\Delta = 24^{\circ} 00' 00''$
$R = 4000.00$	$R = 4000.00$	$R = 550.00$
$T = 1381.43$	$T = 263.39$	$T = 116.91$
$Lc = 2660.27$	$Lc = 111.70$	$Lc = 230.38$

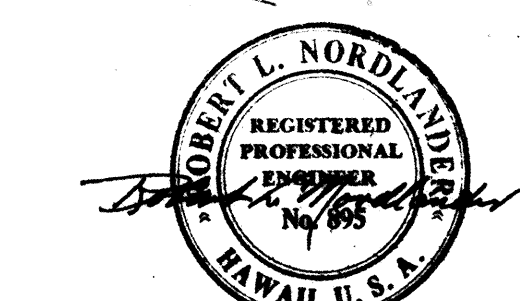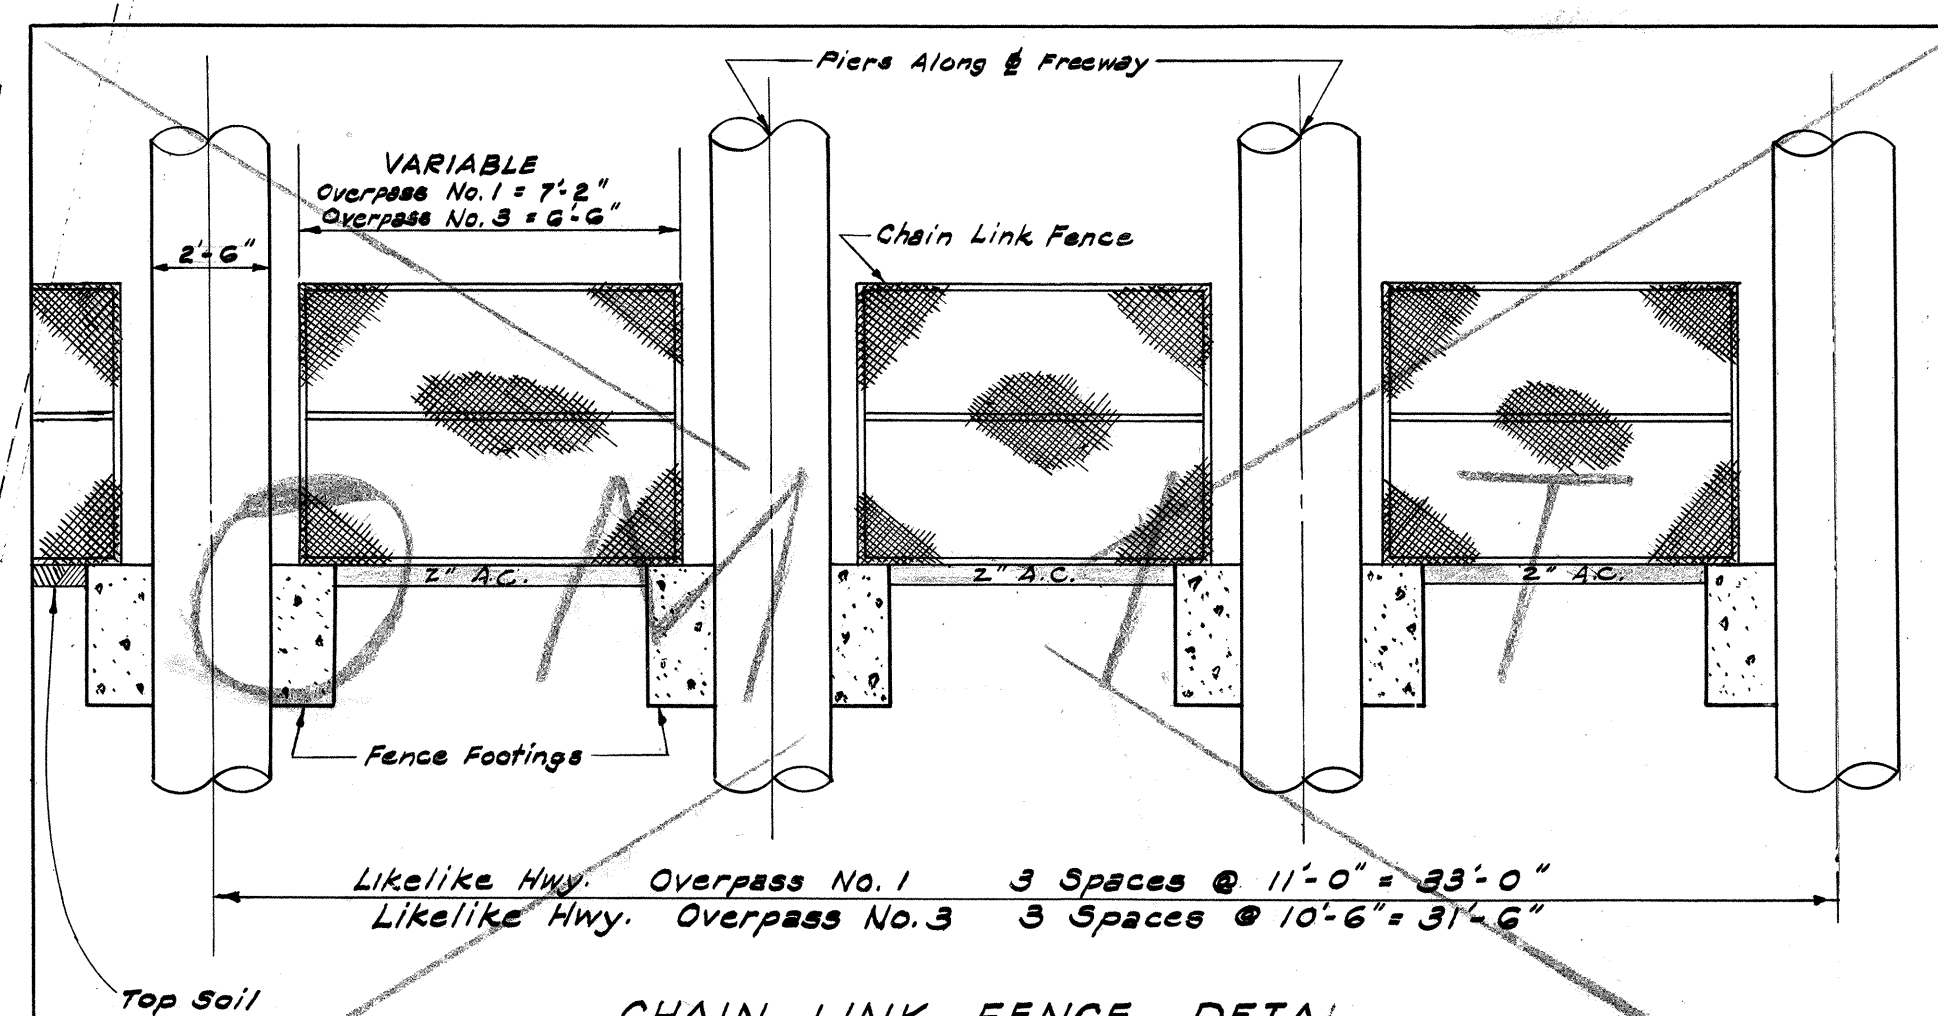

BELT, COLLINS & ASSOC., LTD.
Civil and Structural Engineers

STATE OF HAWAII
DEPARTMENT OF TRANSPORTATION
HIGHWAYS DIVISION

DETAIL PLAN OF ROADWAY
FREEWAY 41+00 - 47+00

LUNALILO FREEWAY U072-1 (10)
LIKELIKE HIGHWAY U063-1 (1)


SHEET No. 3 OF 5 SHEETS

A 10 B 7

FED. ROAD DIST. No.	STATE	FED. AID PROJ. No.	FISCAL YEAR	SHEET No.	TOTAL SHEET
HAWAII	HAW.	U072-1(10)	1963	4 11	45
		U063-1(1)	1963	8 8	45

CURVE DATA

(42)	(4C)	(4J)	(4L)
$\Delta = 37^{\circ}09'00''$	$\Delta = 60^{\circ}00'00''$	$\Delta = 37^{\circ}00'00''$	$\Delta = 69^{\circ}00'00''$
$R = 175.50$	$R = 125.00$	$R = 177.80$	$R = 135.00$
$T = 55.35$	$T = 72.17$	$T = 55.30$	$T = 76.70$
$Lc = 130.00$	$Lc = 130.00$	$Lc = 175.27$	$Lc = 139.28$

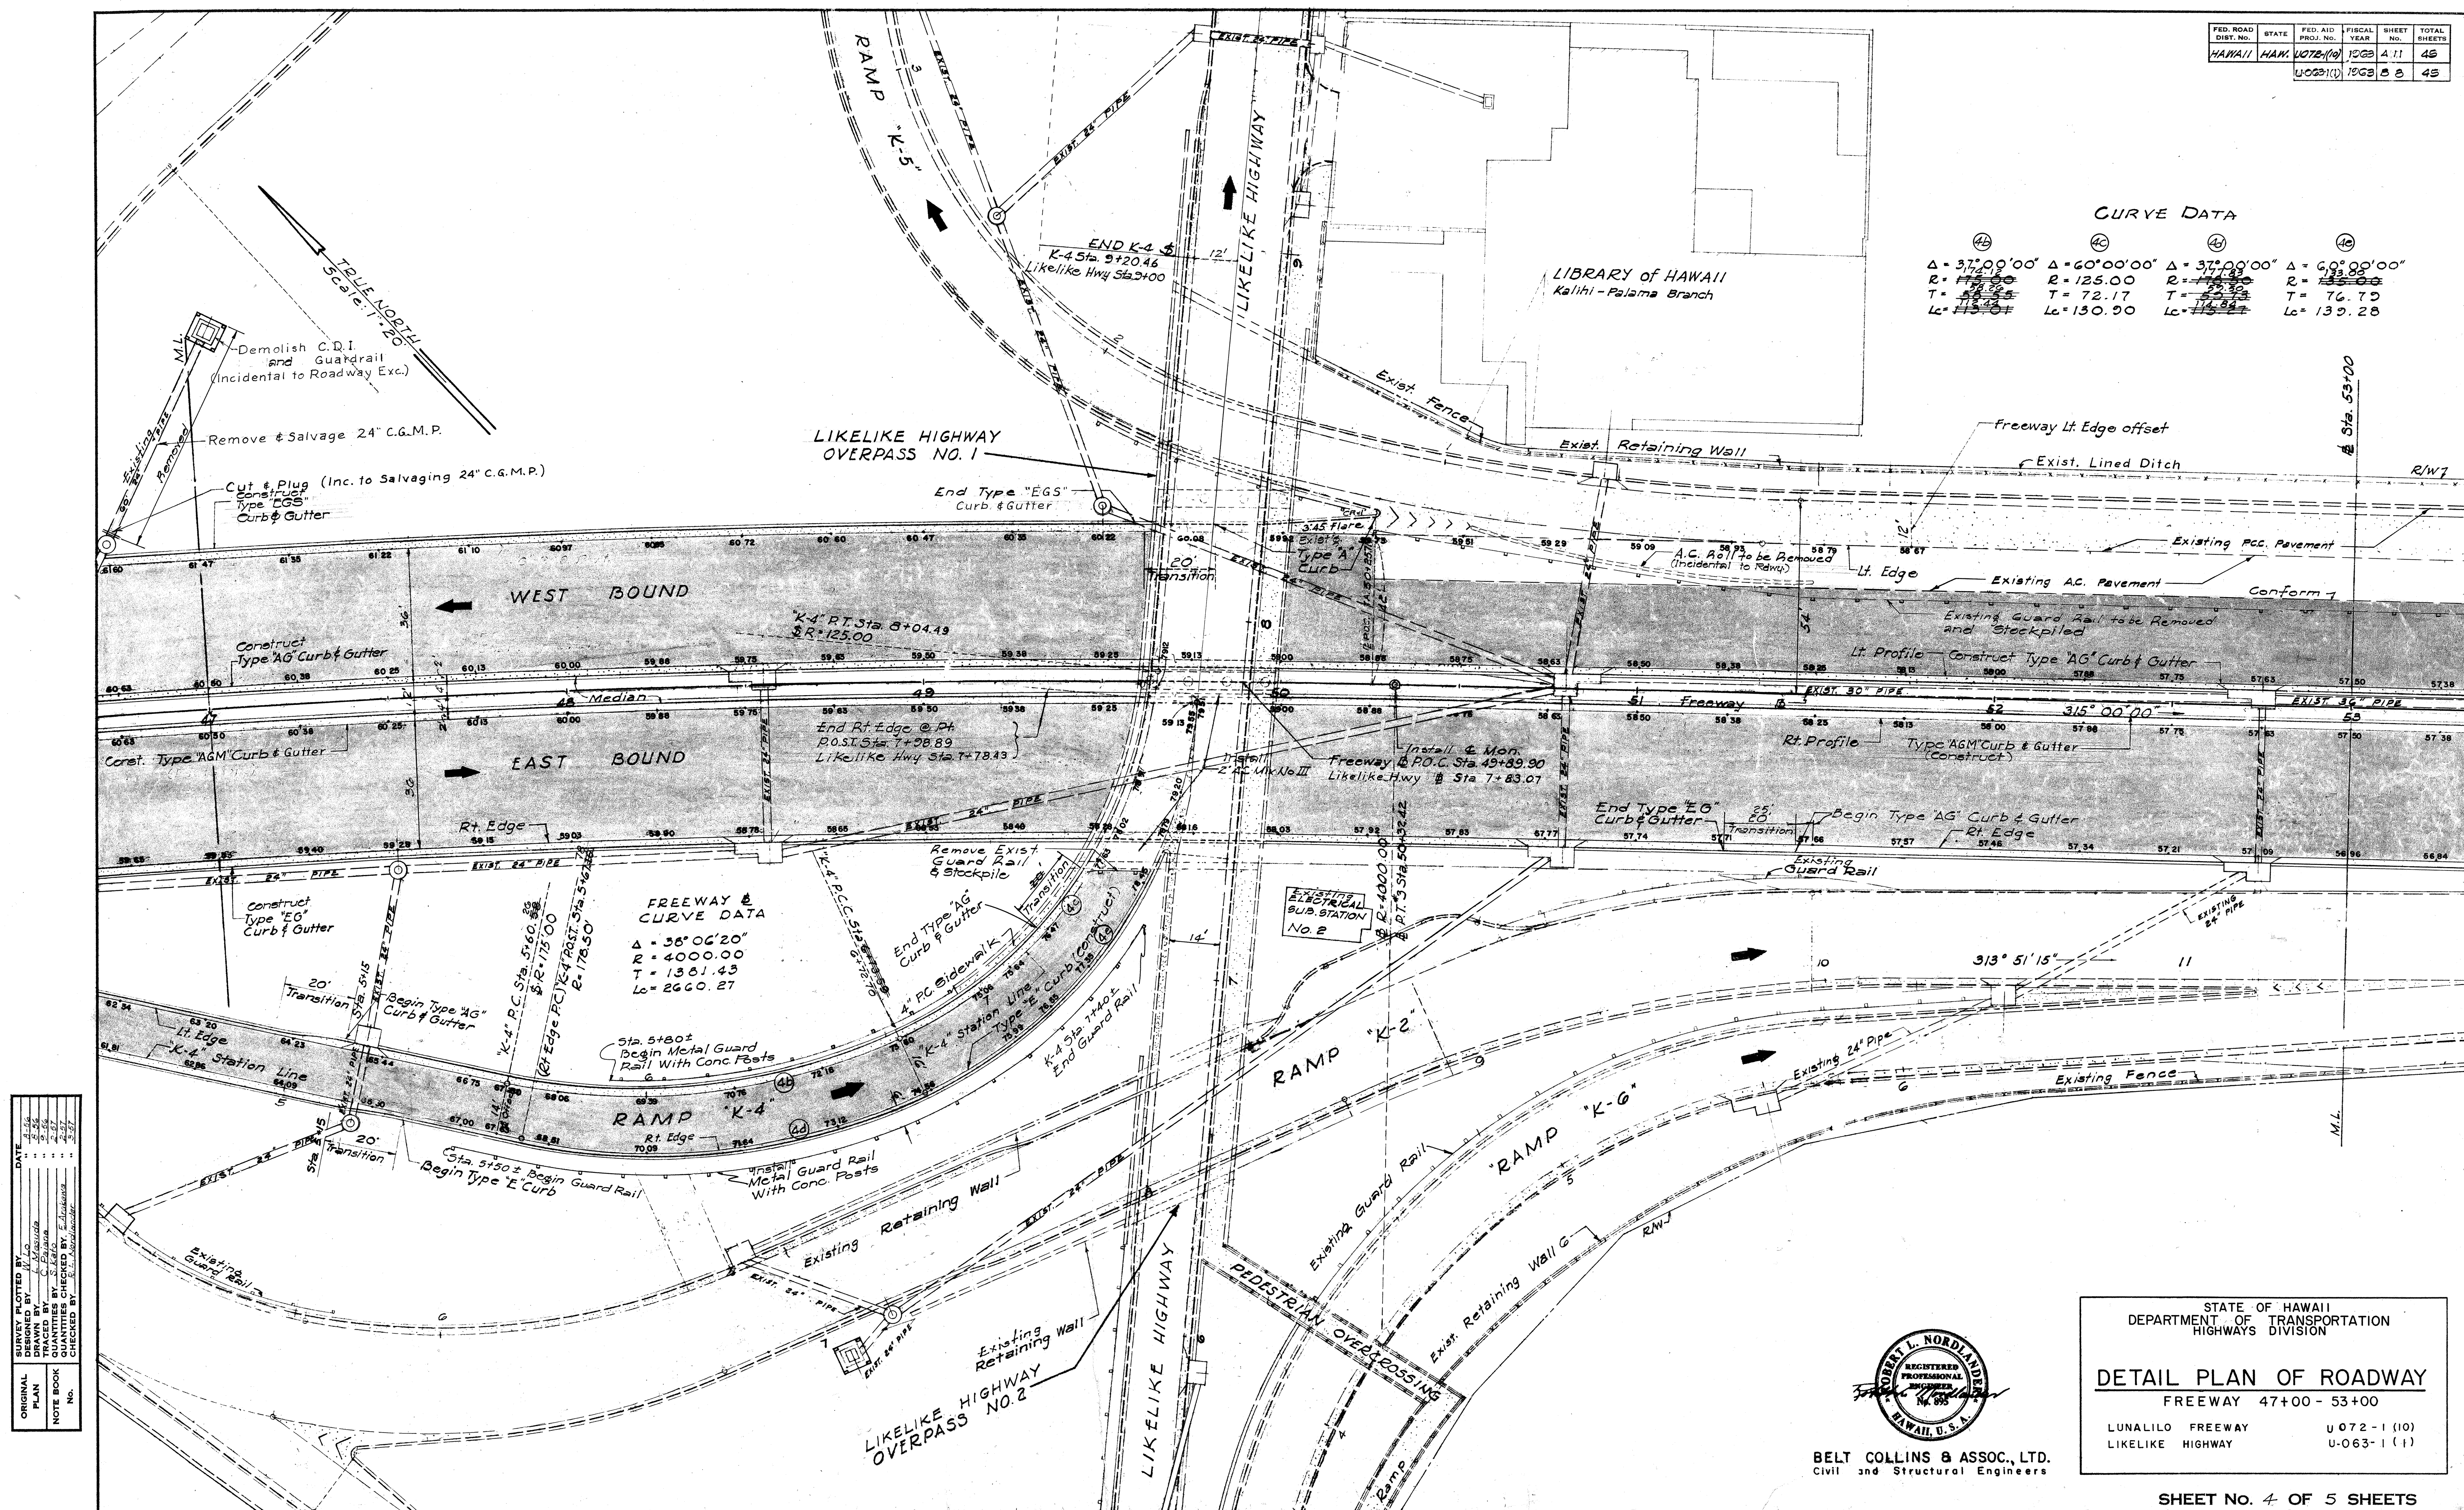

STATE OF HAWAII
DEPARTMENT OF TRANSPORTATION
HIGHWAYS DIVISION

DETAIL PLAN OF ROADWAY



FREEWAY 47+00 - 53+00

LUNALILO FREEWAY U 072 - 1 (10)
LIKELIKE HIGHWAY U-063 - 1 (1)


SHEET No. 4 OF 5 SHEETS

A 11 B 8

FED. ROAD DIST. NO.	STATE	FED. AID PROJ. NO.	FISCAL YEAR	SHEET NO.	TOTAL SHEETS
HAWAII	HAW.	U-072-1(10)	1968	A12	48
		U-063-1(1)	1968	B9	45

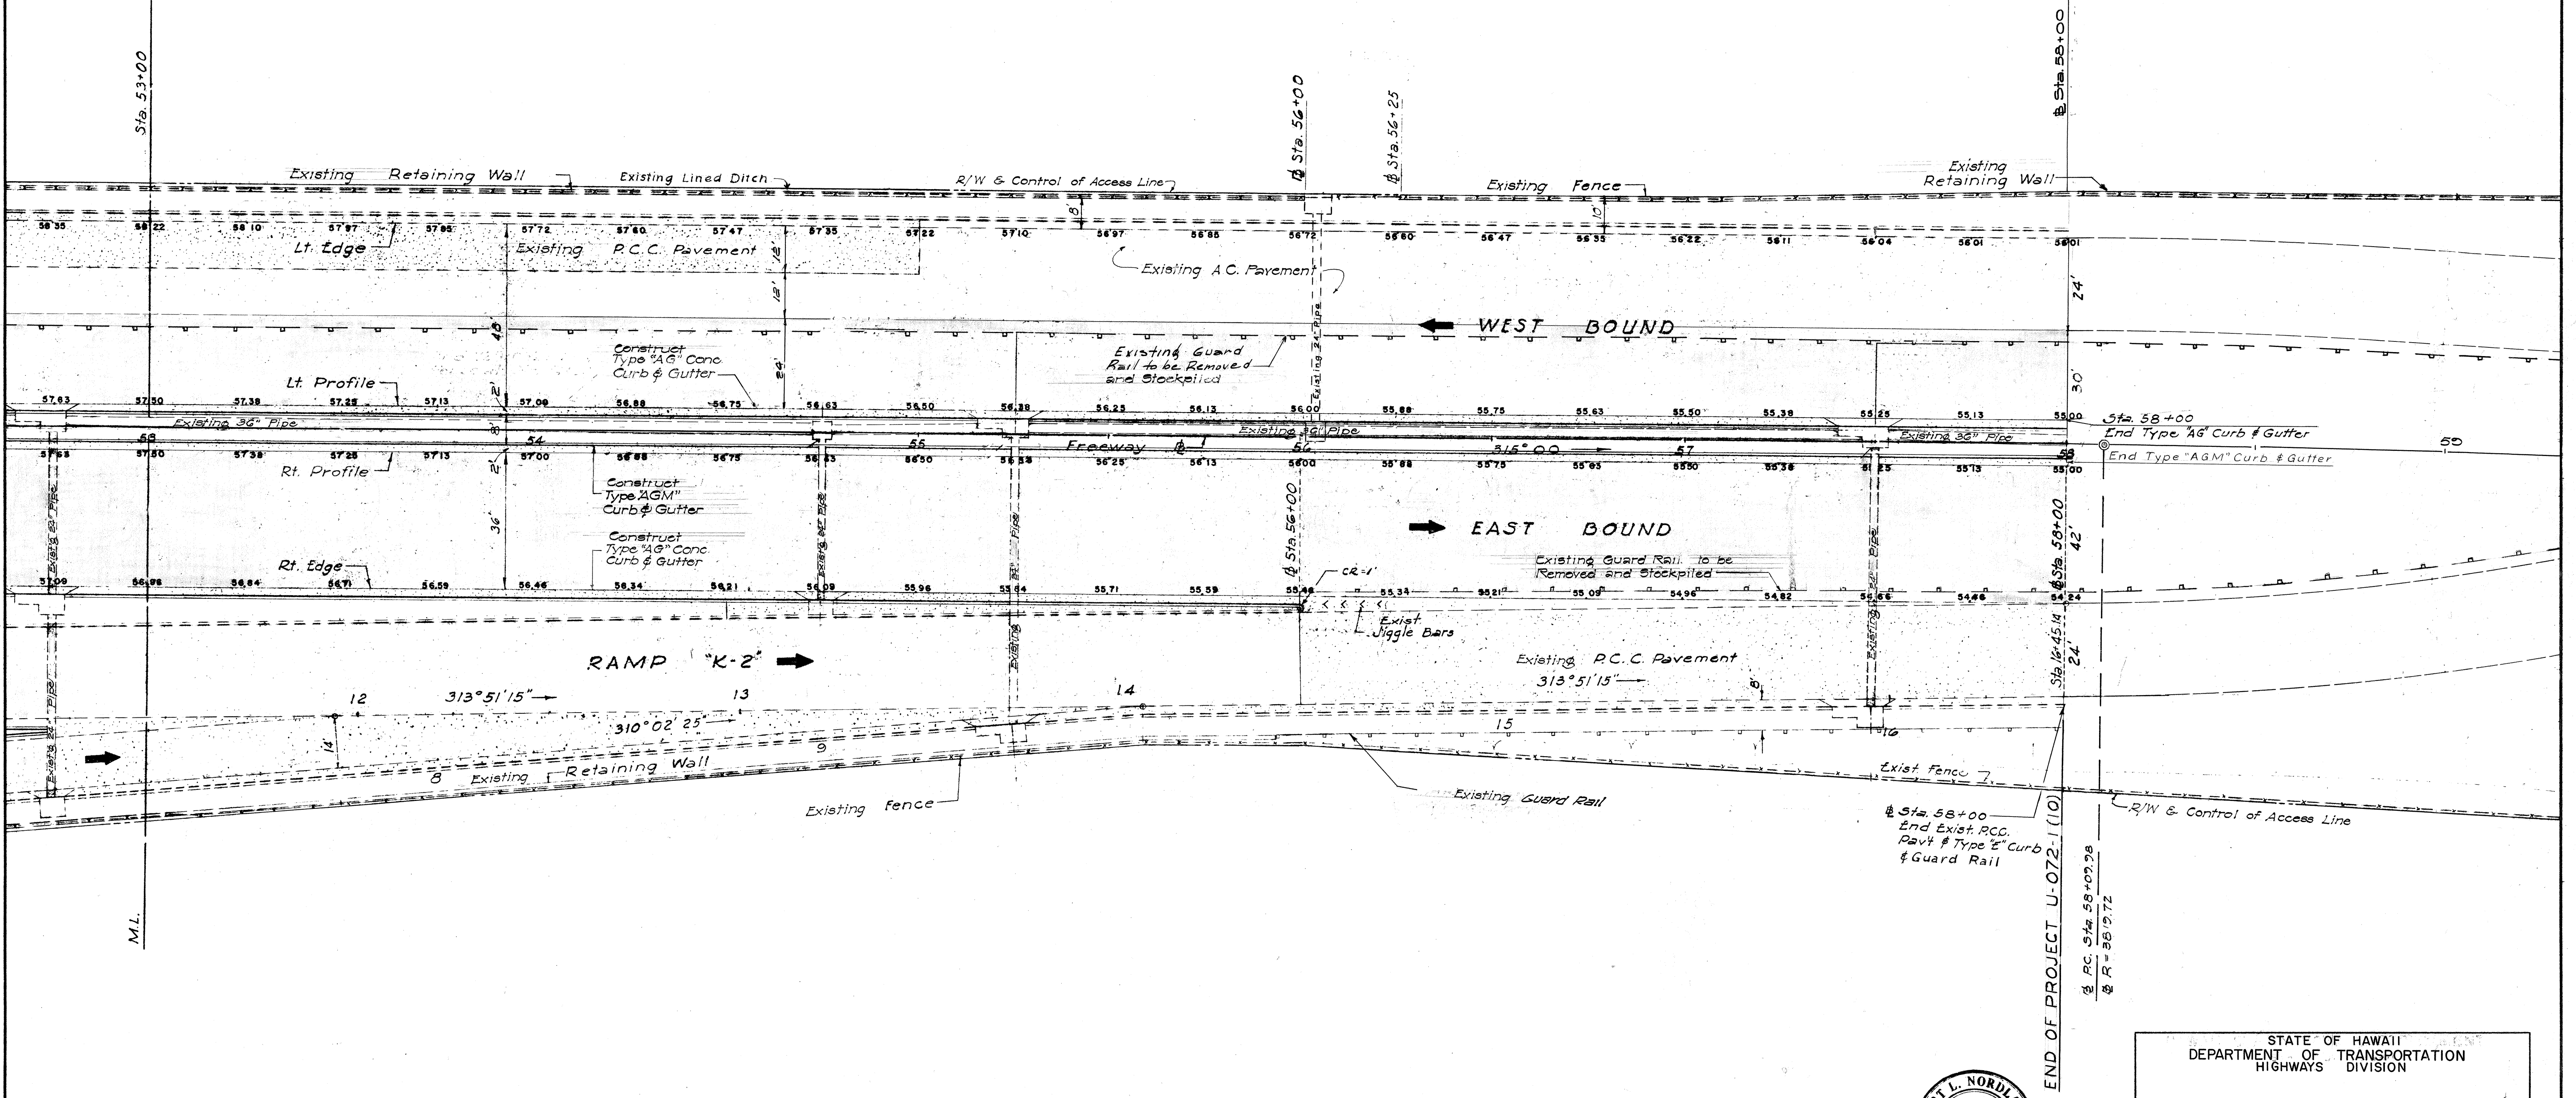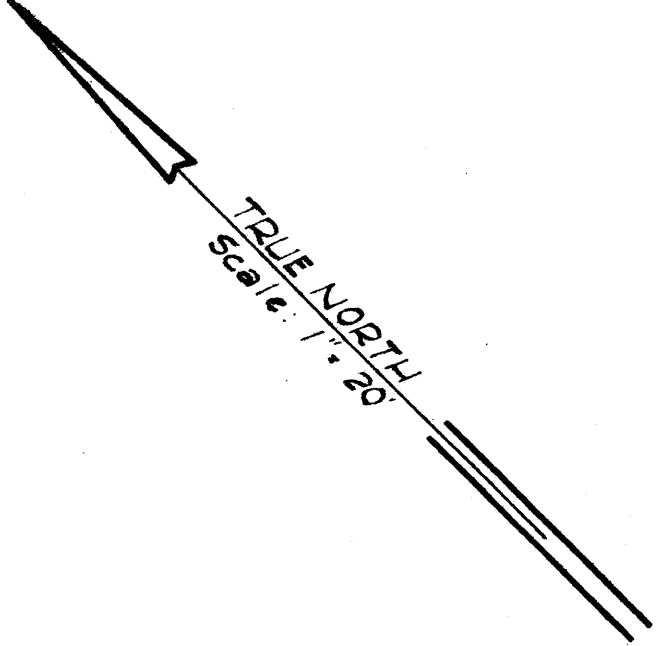

SURVEY PLOTTED BY	DATE
DESIGNED BY	
DRAWN BY	
CHECKED BY	
QUANTITIES CHECKED BY	
CHECKED BY	

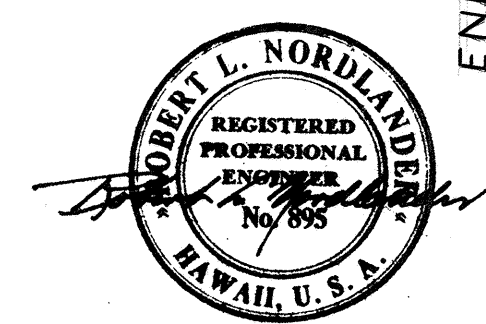

BELT, COLLINS & ASSOC., LTD.
Civil and Structural Engineers

STATE OF HAWAII
DEPARTMENT OF TRANSPORTATION
HIGHWAYS DIVISION

DETAIL PLAN OF ROADWAY
FREEWAY 53+00 - 58+00
LUNALILO FREEWAY U-072-1(10)
LIKELIKE HIGHWAY U-063-1(1)

SHEET No. 5 OF 5 SHEETS

A 12 B 9