


FED. ROAD DIST. NO.	STATE	FED. AID PROJ. NO.	FISCAL YEAR	SHEET NO.	TOTAL SHEETS
HAWAII	HAW.	U-072-1(10)	1969	A-7	45

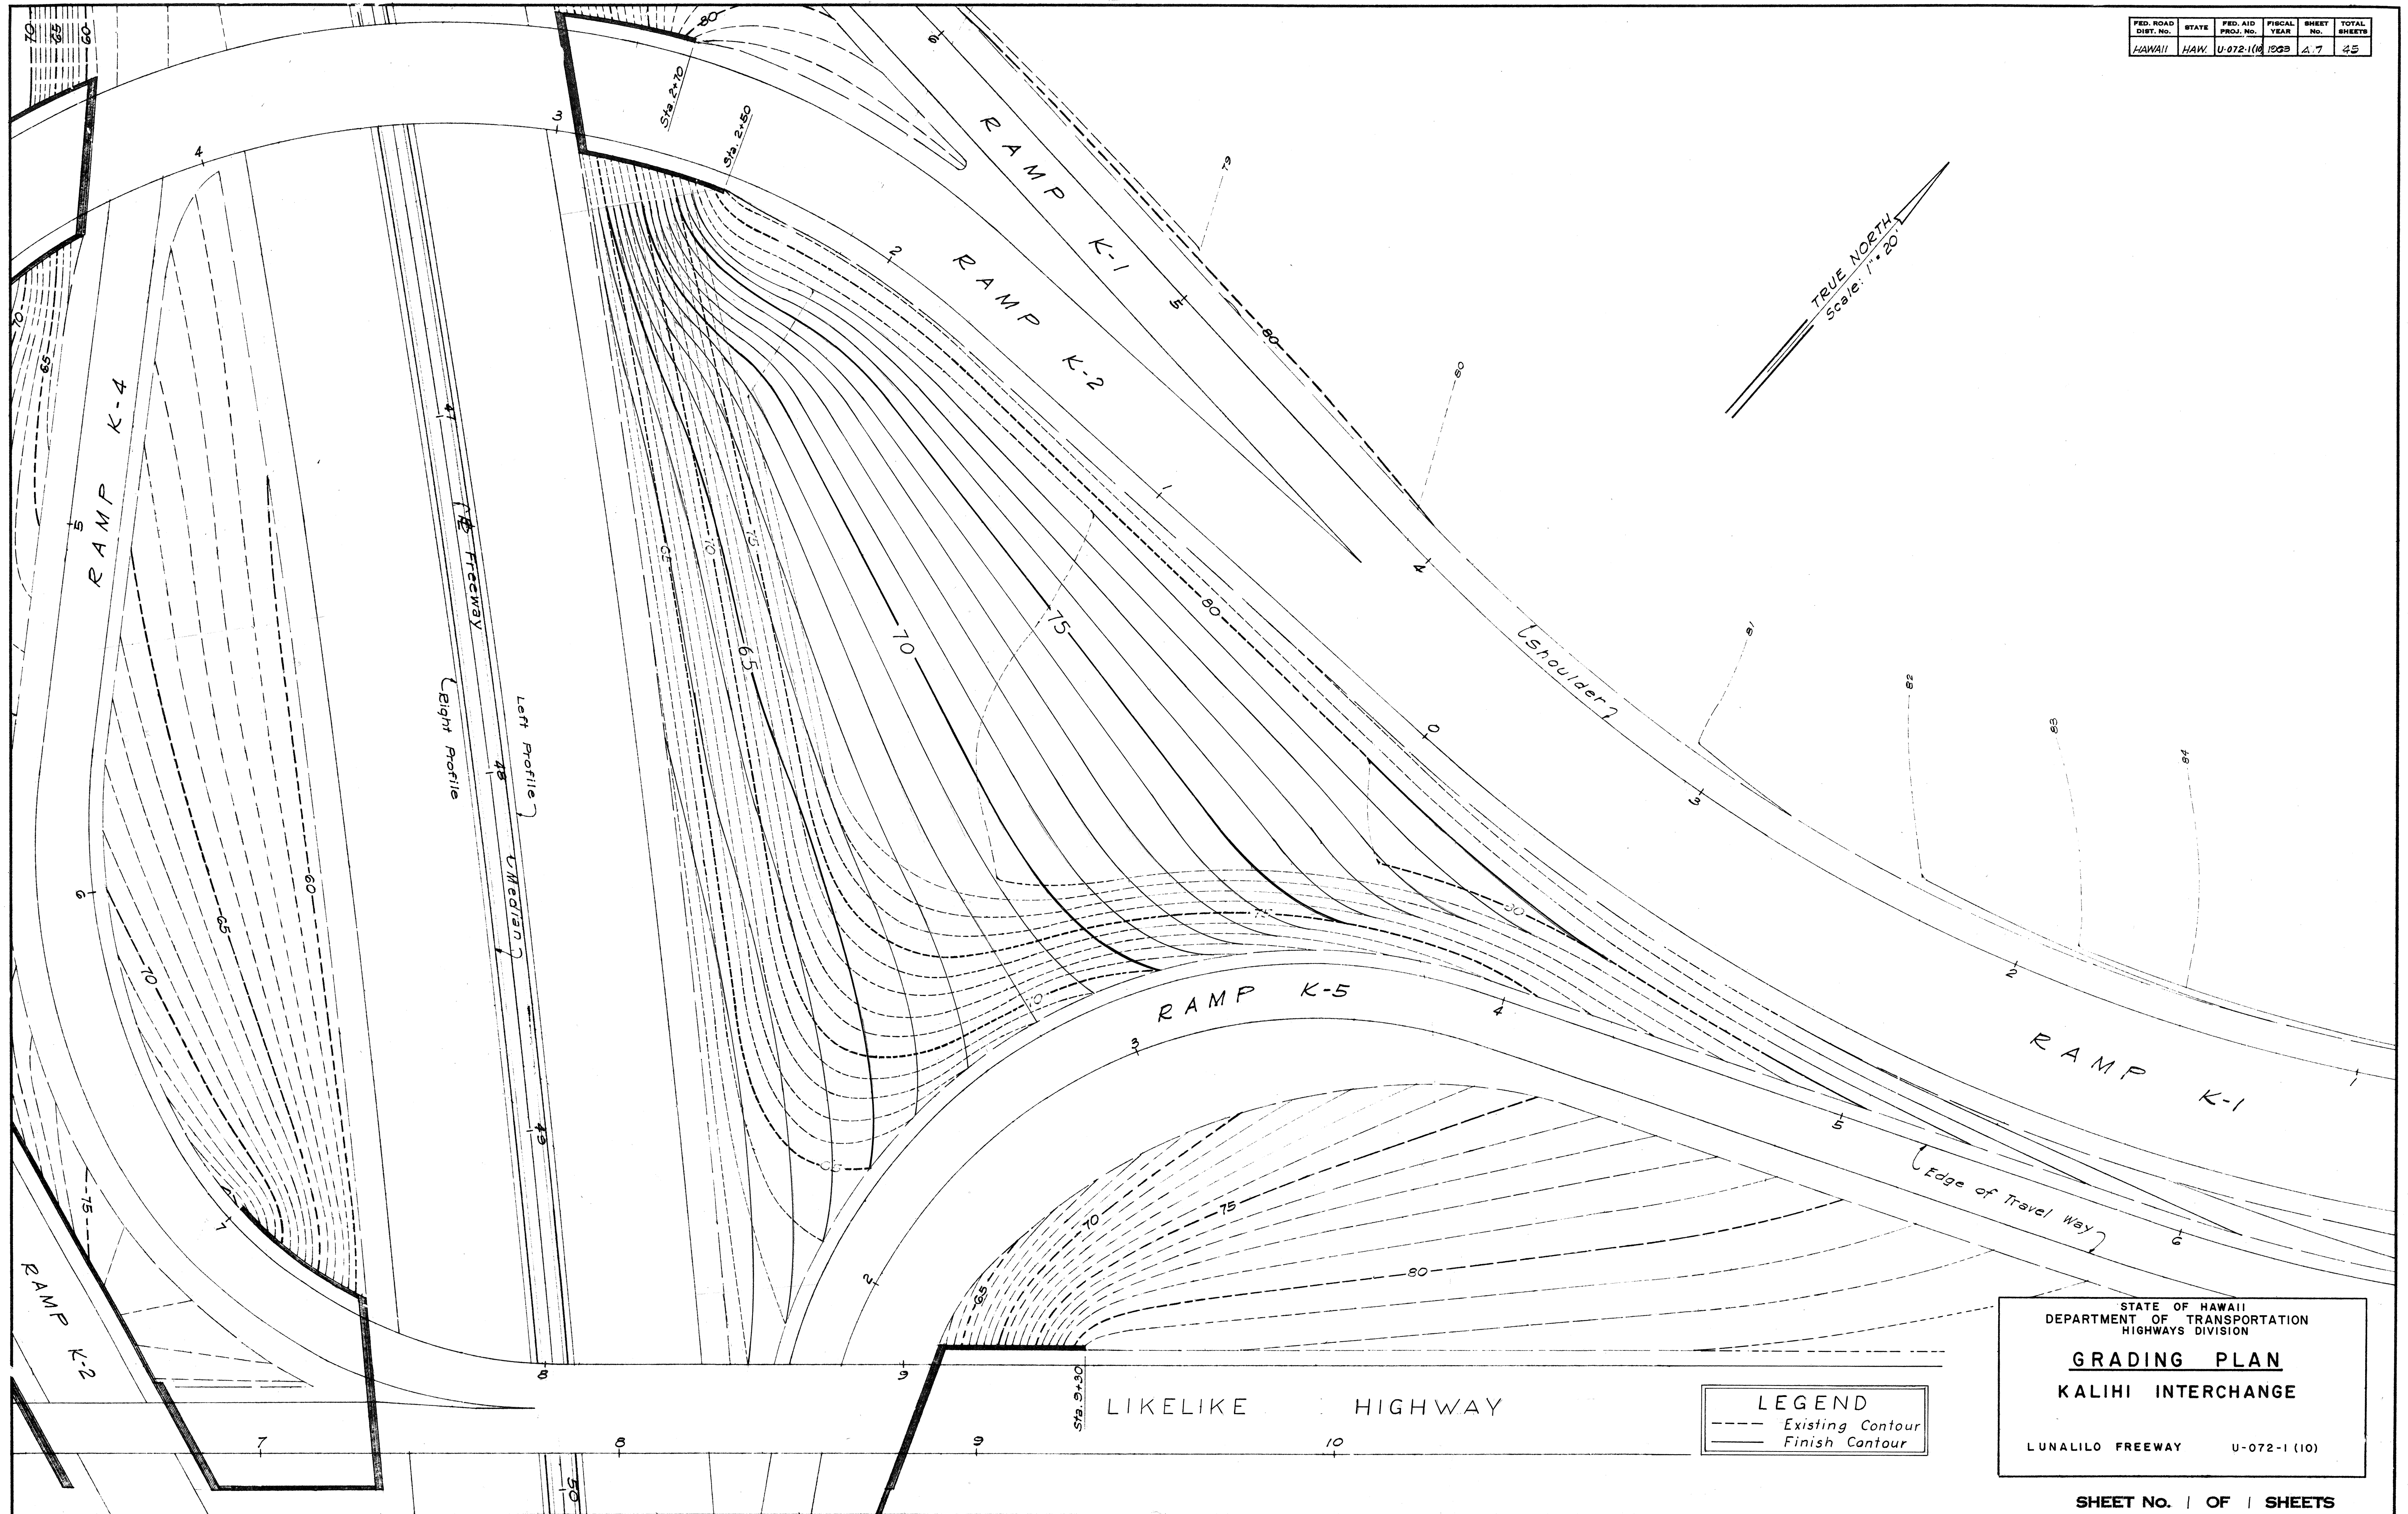

ORIGINAL PLAN	DATE
NOTED BY	10-8
TRACED BY	10-8
QUANTITIES CHECKED BY	
CHECKED BY	

STATE OF HAWAII
DEPARTMENT OF TRANSPORTATION
HIGHWAYS DIVISION
GRADING PLAN
KALIHI INTERCHANGE
LUNALILO FREEWAY U-072-1 (10)

SHEET NO. | OF | SHEETS