

PLAN	SURVEYED	DATE
PLANNED		
NOTED		
NO.		



PROFILE	SURVEYED	DATE
PLANNED		
NOTED		
NO.		

NOTE:
Coordinates referred to Mokuauia &
Origin of azimuth = Mokuauia &
B.M. referred to Mean Sea Level Datum.

FREEWAY CURVE DATA

Δ = 38° 06' 20"
R = 4000.00
T = 1381.45
L = 2660.27


FED. ROAD DIST. No.	STATE	FED. AID PROJ. No.	FISCAL YEAR	SHEET No.	TOTAL SHEETS
HAWAII	HAW.	U-072-1(0)	1963	44	45

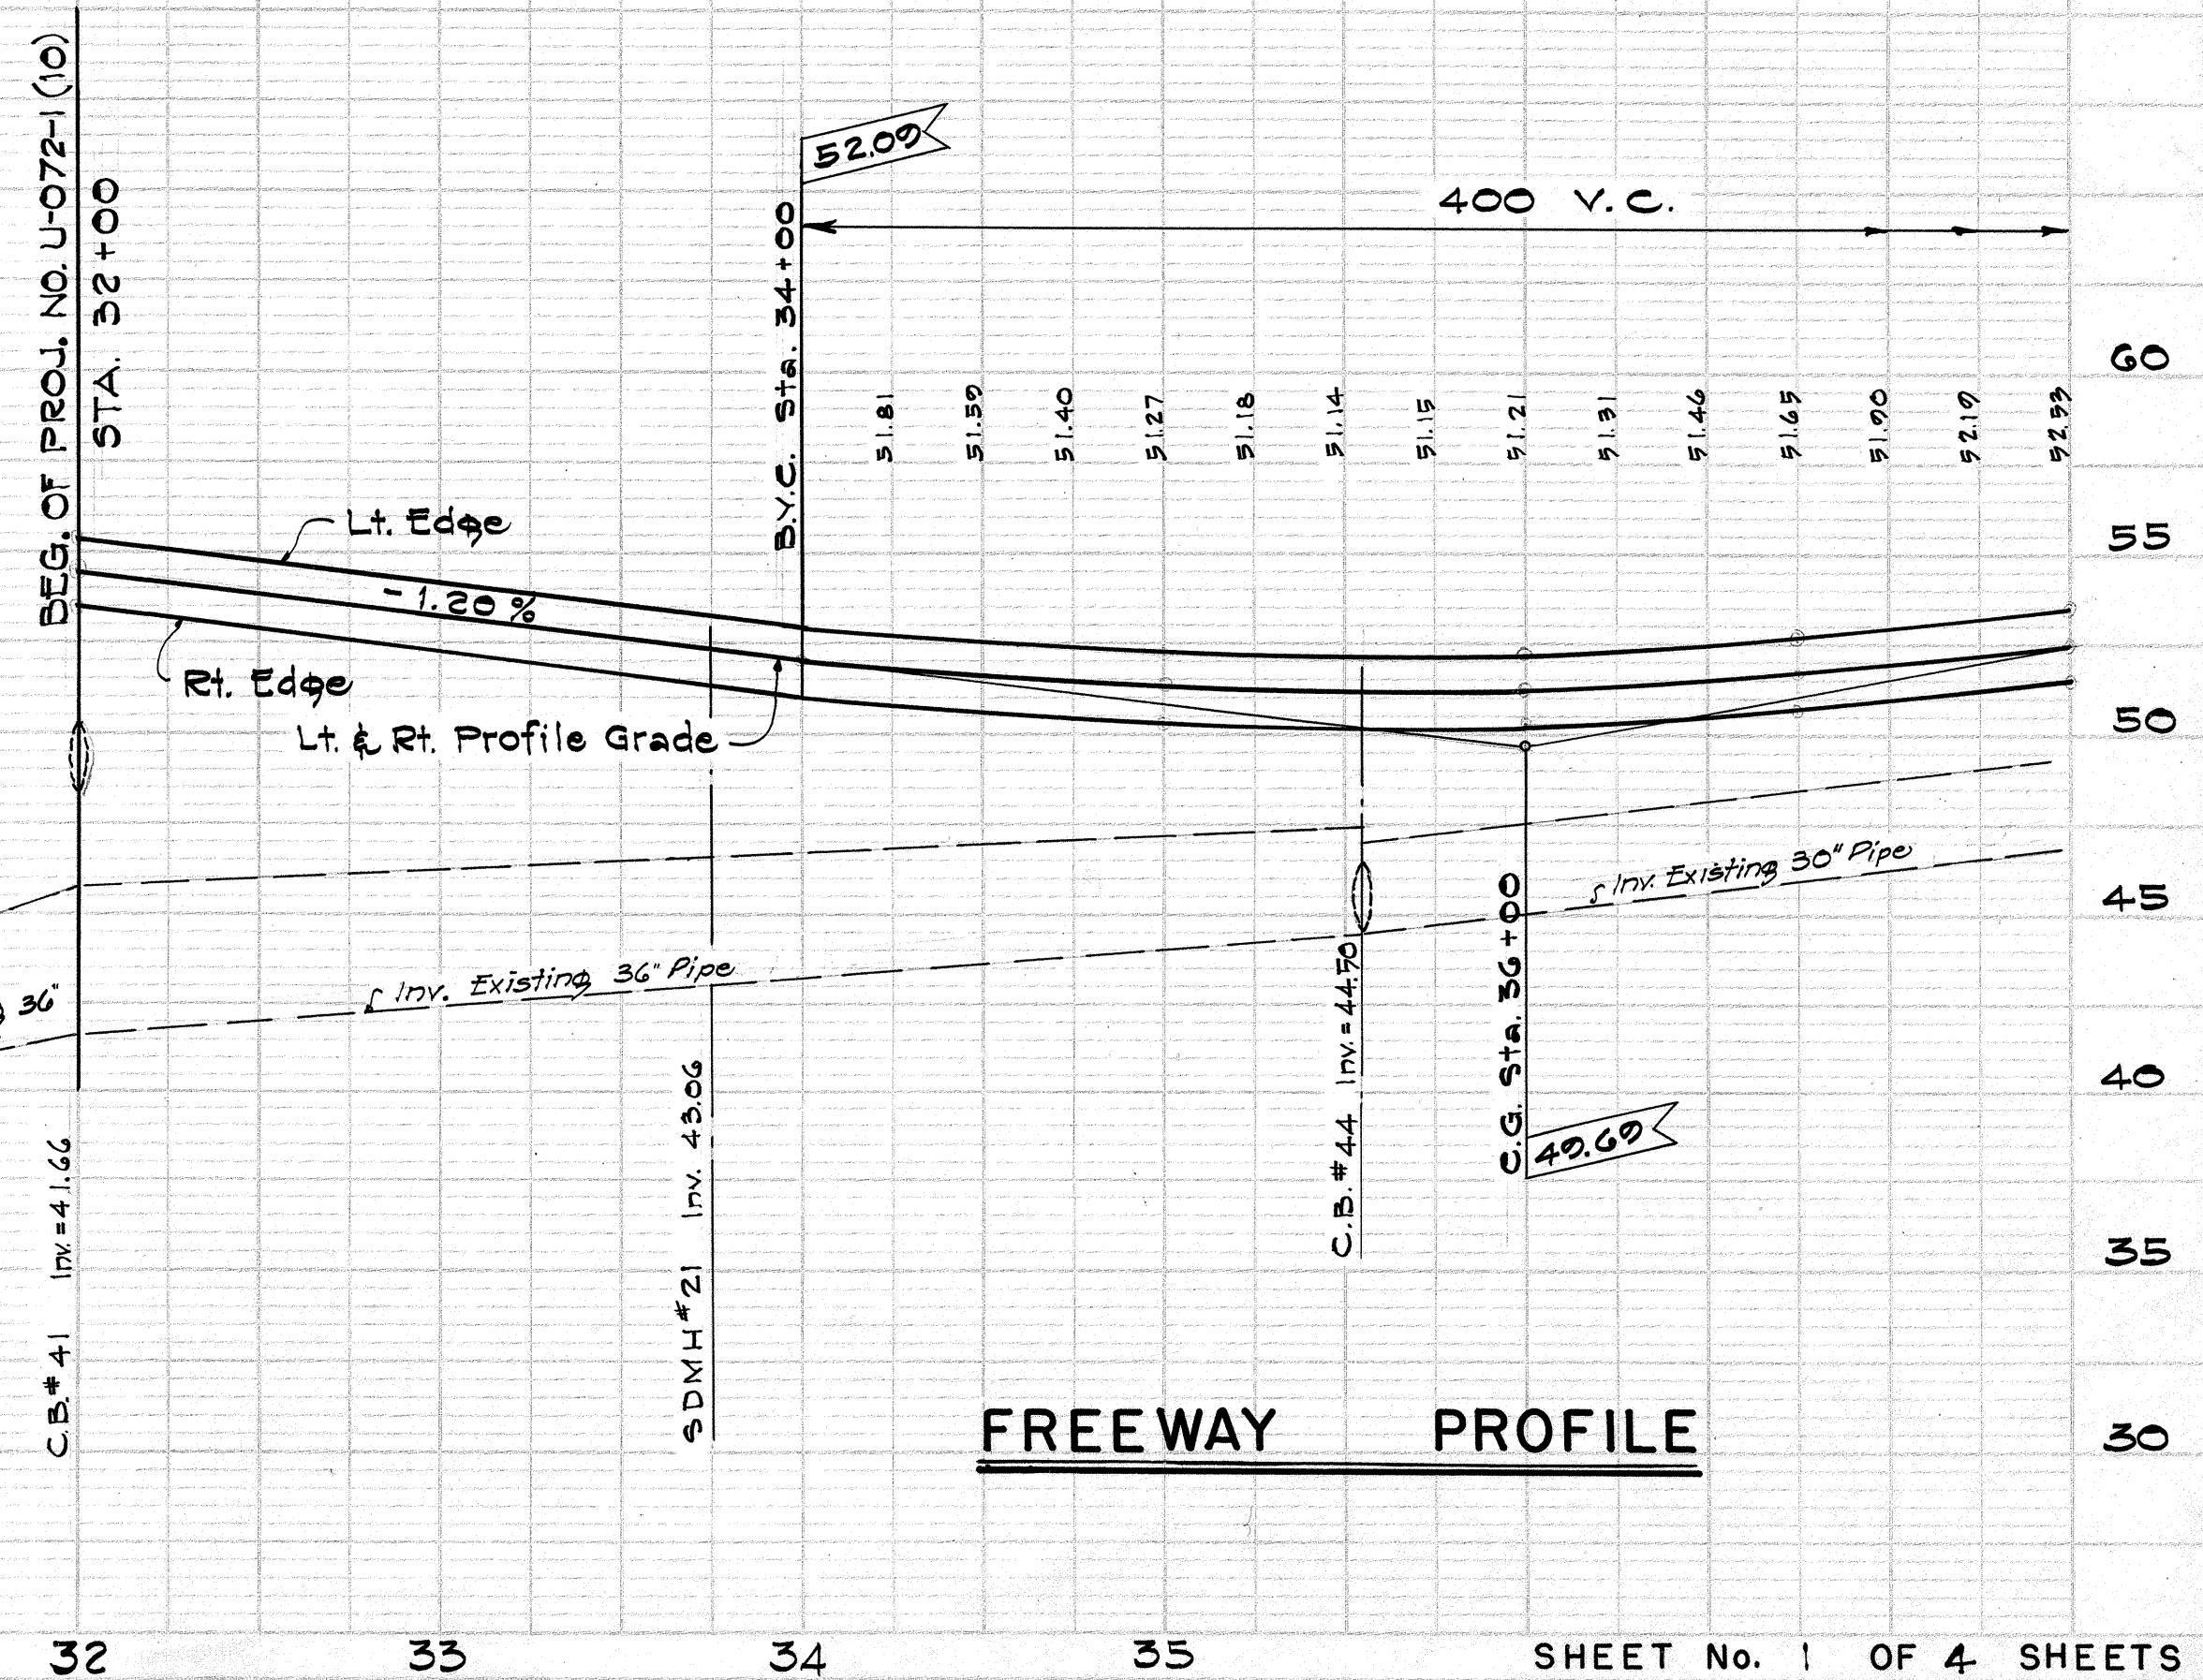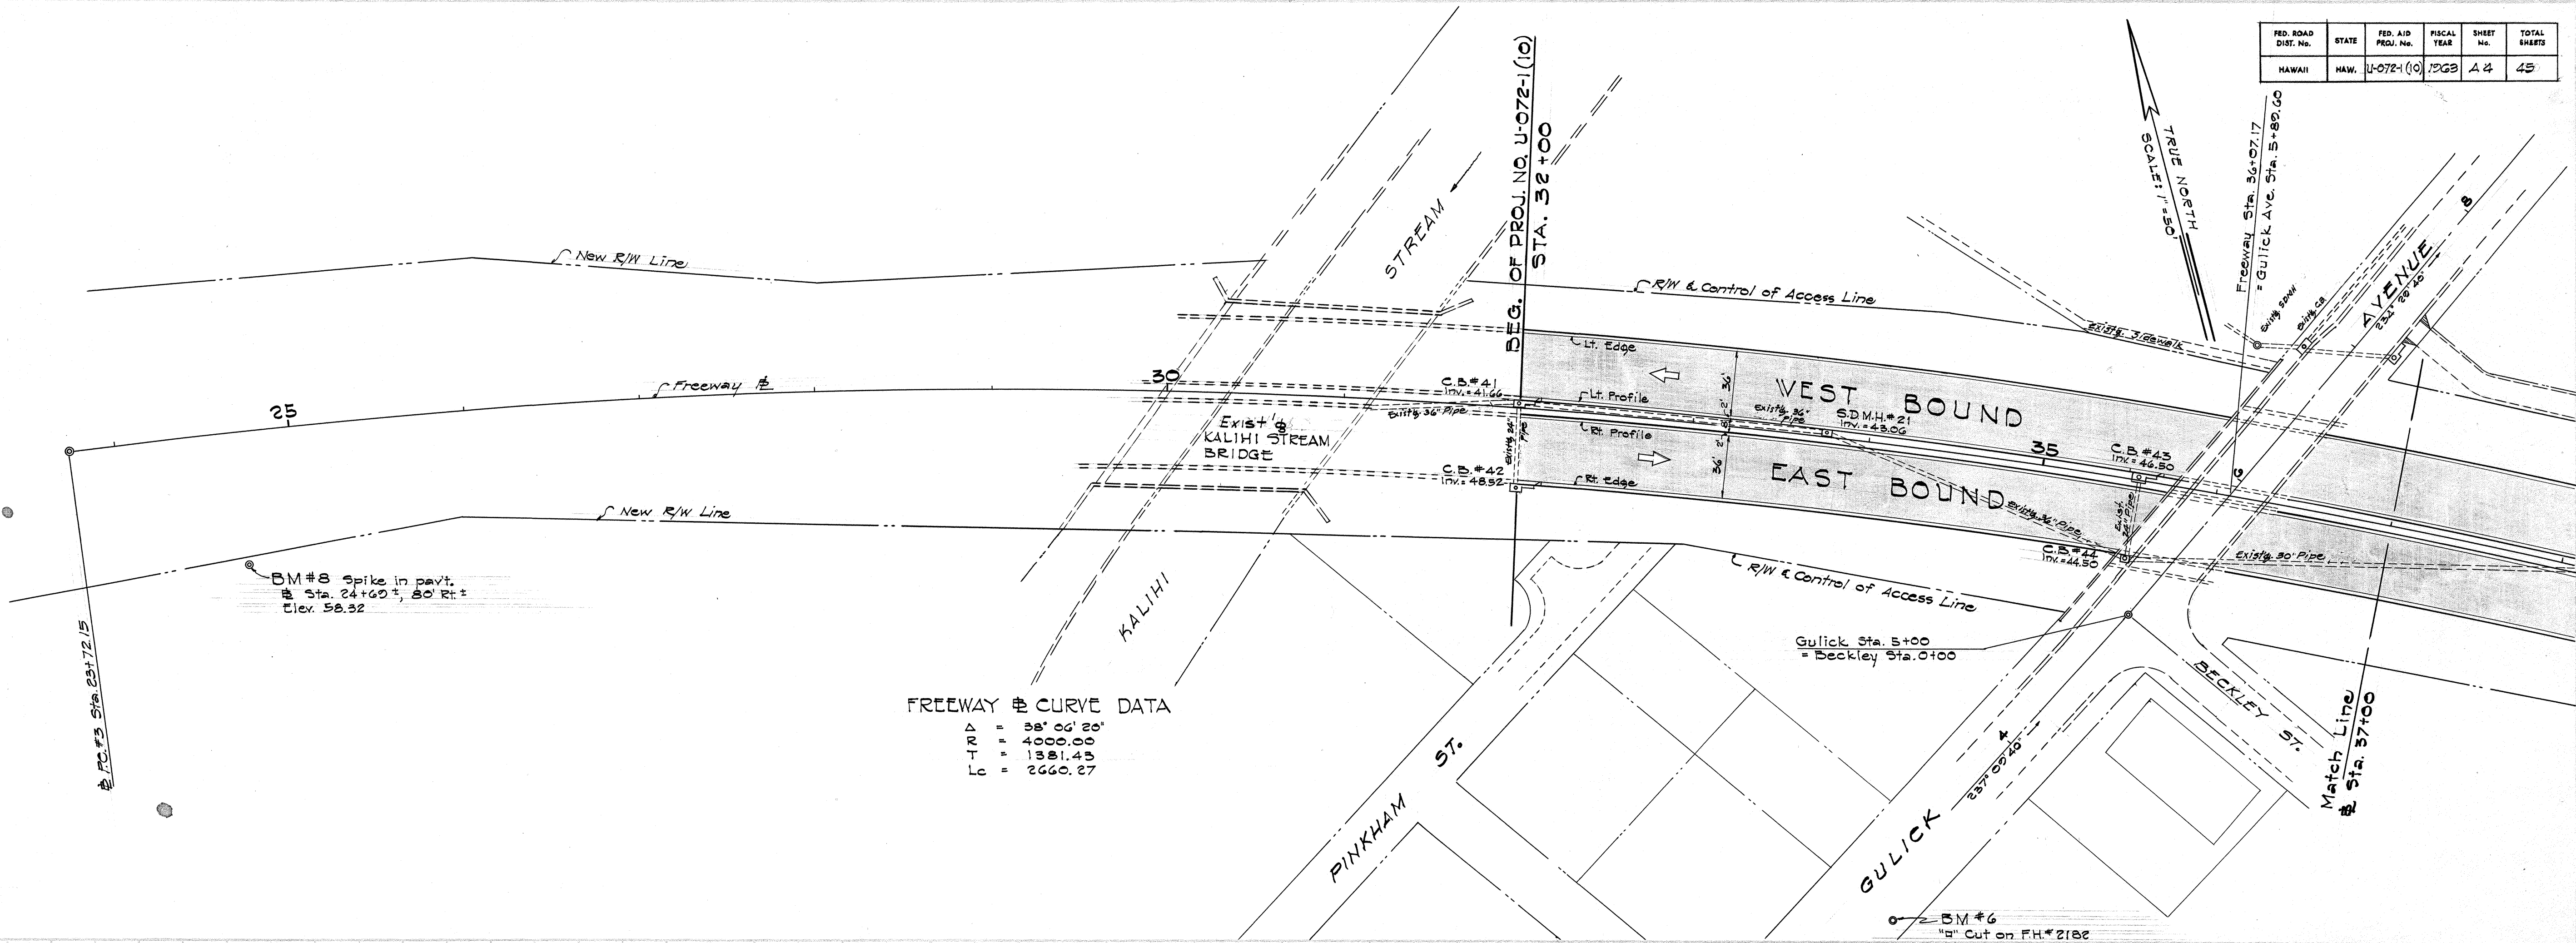

FREEWAY PROFILE

SHEET No. 1 OF 4 SHEETS

SHEET No. 2 OF 4 SHEETS

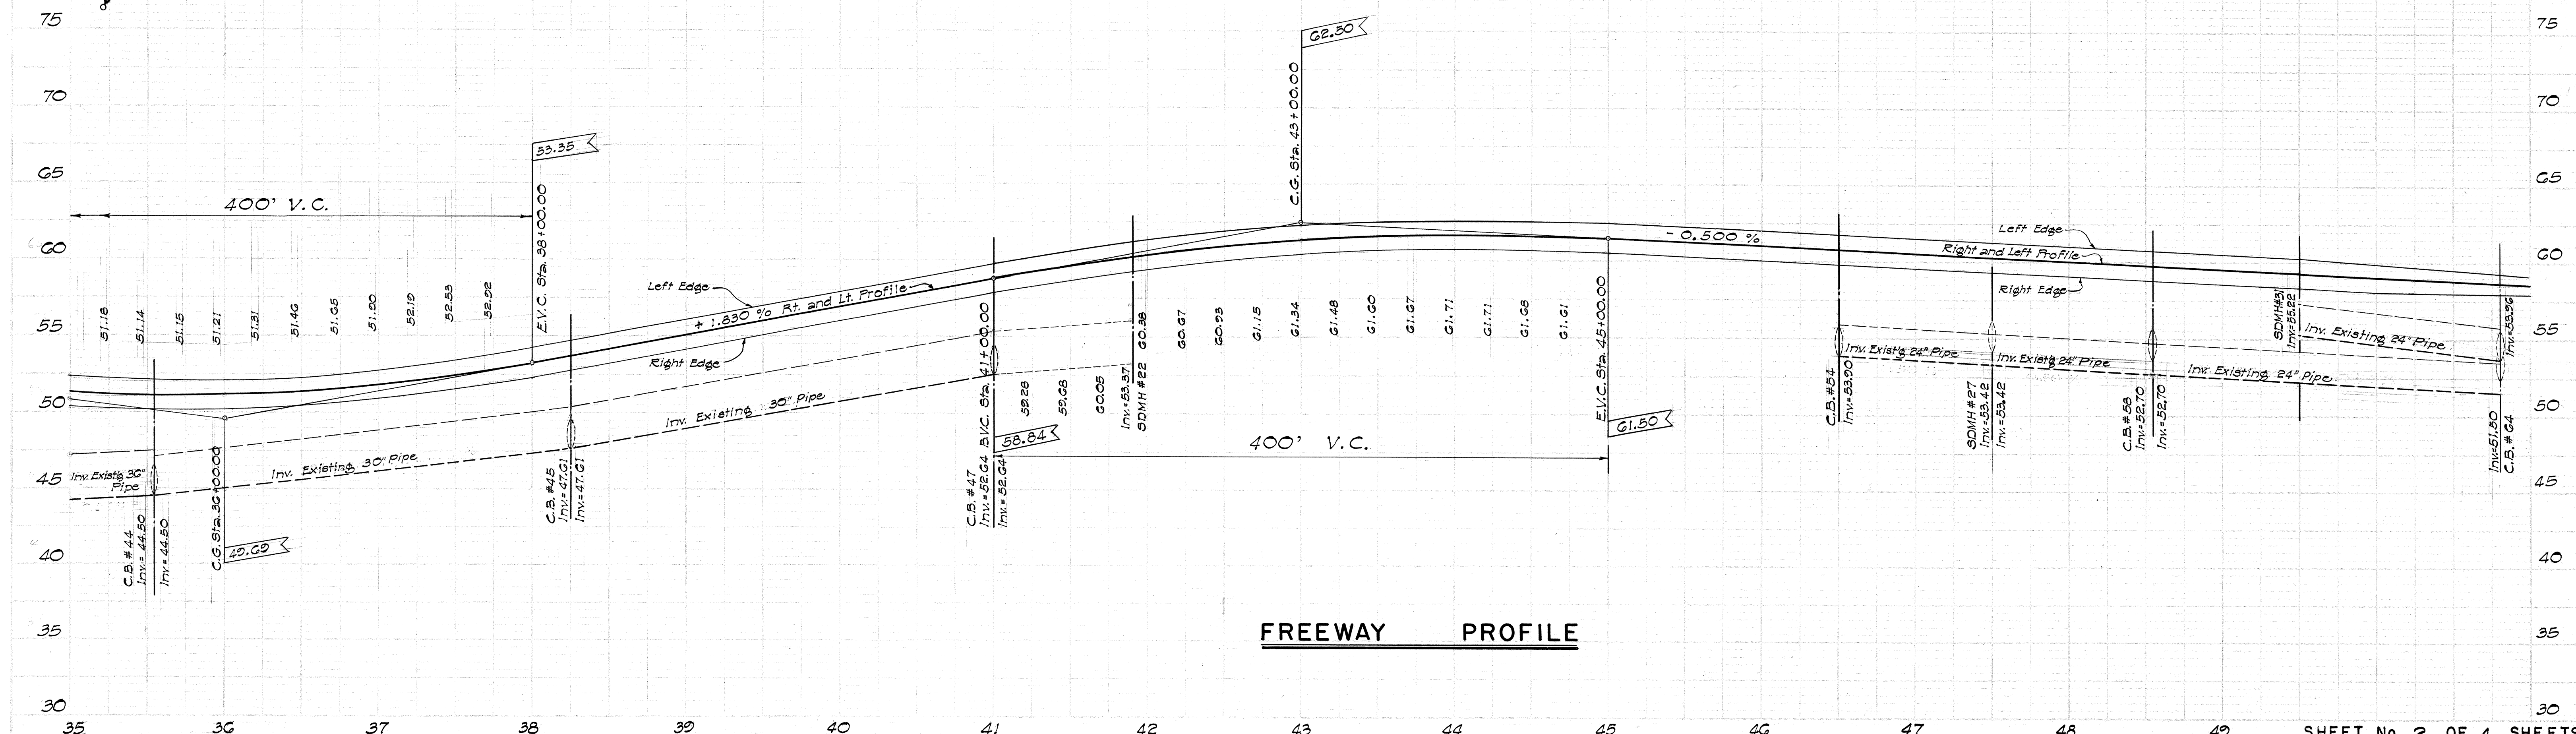

A 5 B 4

