

INDEX TO DRAWINGS	
SHEET NO.	DESCRIPTION
1	TITLE SHEET
2	PLAN AND PROFILE
3-6	DEMOLITION PLANS
7-9	DETAIL PLANS
10-21	DRAINAGE DETAILS
(10-17)	SPECIAL
(18-21)	STANDARD
22-30	UTILITY DETAILS
(22-25)	SPECIAL
(26-30)	STANDARD
31-33	MISCELLANEOUS DETAILS
34	REHABILITATION PLANS

STATE OF HAWAII

DEPARTMENT OF TRANSPORTATION

HIGHWAYS DIVISION

HONOLULU, HAWAII

"AS BUILT"

PLANS FOR CONSTRUCTION OF

DRAINAGE SYSTEM

FOR

INTERSTATE HIGHWAY (LUNALILO FREEWAY)

KAPIOLANI INTERCHANGE, KING STREET TO FIRST AVENUE

FEDERAL AID INTERSTATE PROJECT No. I-HI-I(5):24,UNIT I

DISTRICT OF HONOLULU

ISLAND OF OAHU


SCALES:

PLAN & PROFILEHOR. 1" = 50'

.VER. 1" = 10'

DETAIL DRAINAGE &

UTILITY PLANS 1" = 20'

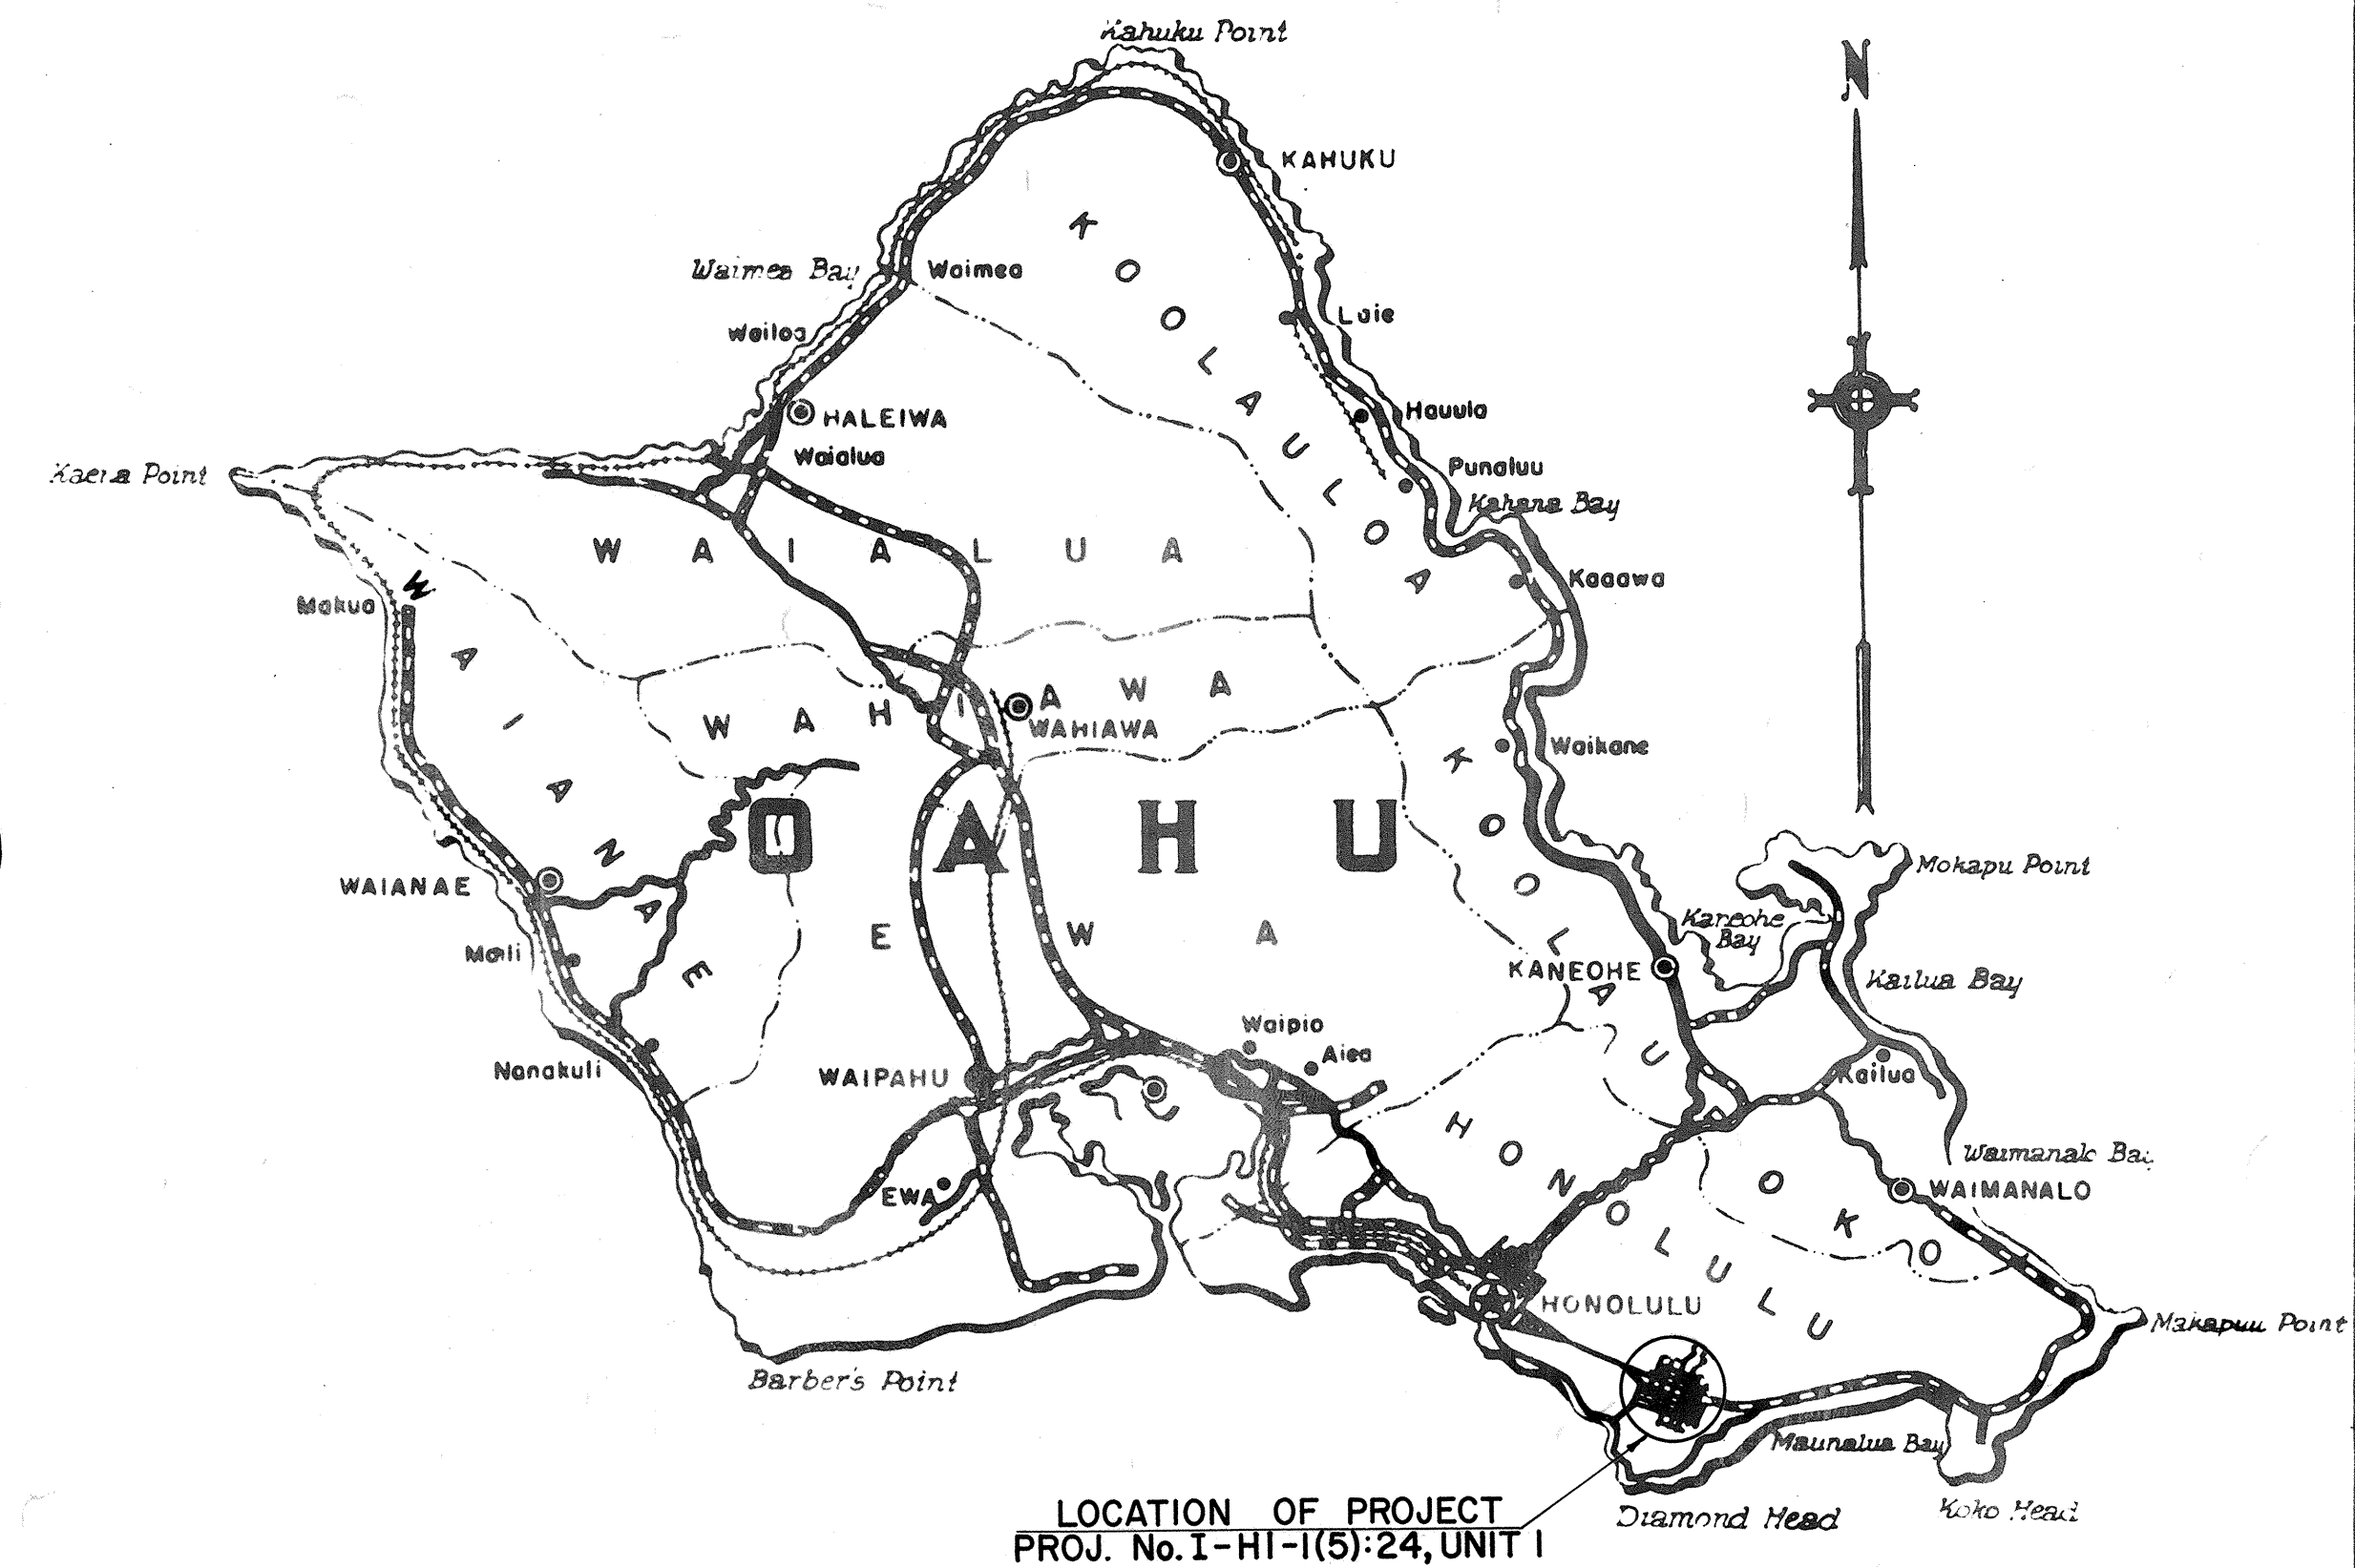

Federal Aid Projects Previously Constructed Or Under Construction

NOTE:

ALL CHANGES MADE DURING CONSTRUCTION

HAVE BEEN NOTED IN RED ON THESE TRACINGS

AND CHECKED BY:

Richard Pata

RESIDENT ENGINEER

FEB 7, 1966

DATE

APPROVED: *J. J. Waters*

DATE 31 Aug 64

DIRECTOR OF TRANSPORTATION

DEPARTMENT OF COMMERCE

BUREAU OF PUBLIC ROADS

APPROVED: _____

DIVISION ENGINEER

DATE

DATE

SURVEY PLOTTED BY

DESIGNED BY


DRAWN BY

CHECKED BY

NOTE BOOK

QUANTITIES CHECKED BY

NO.

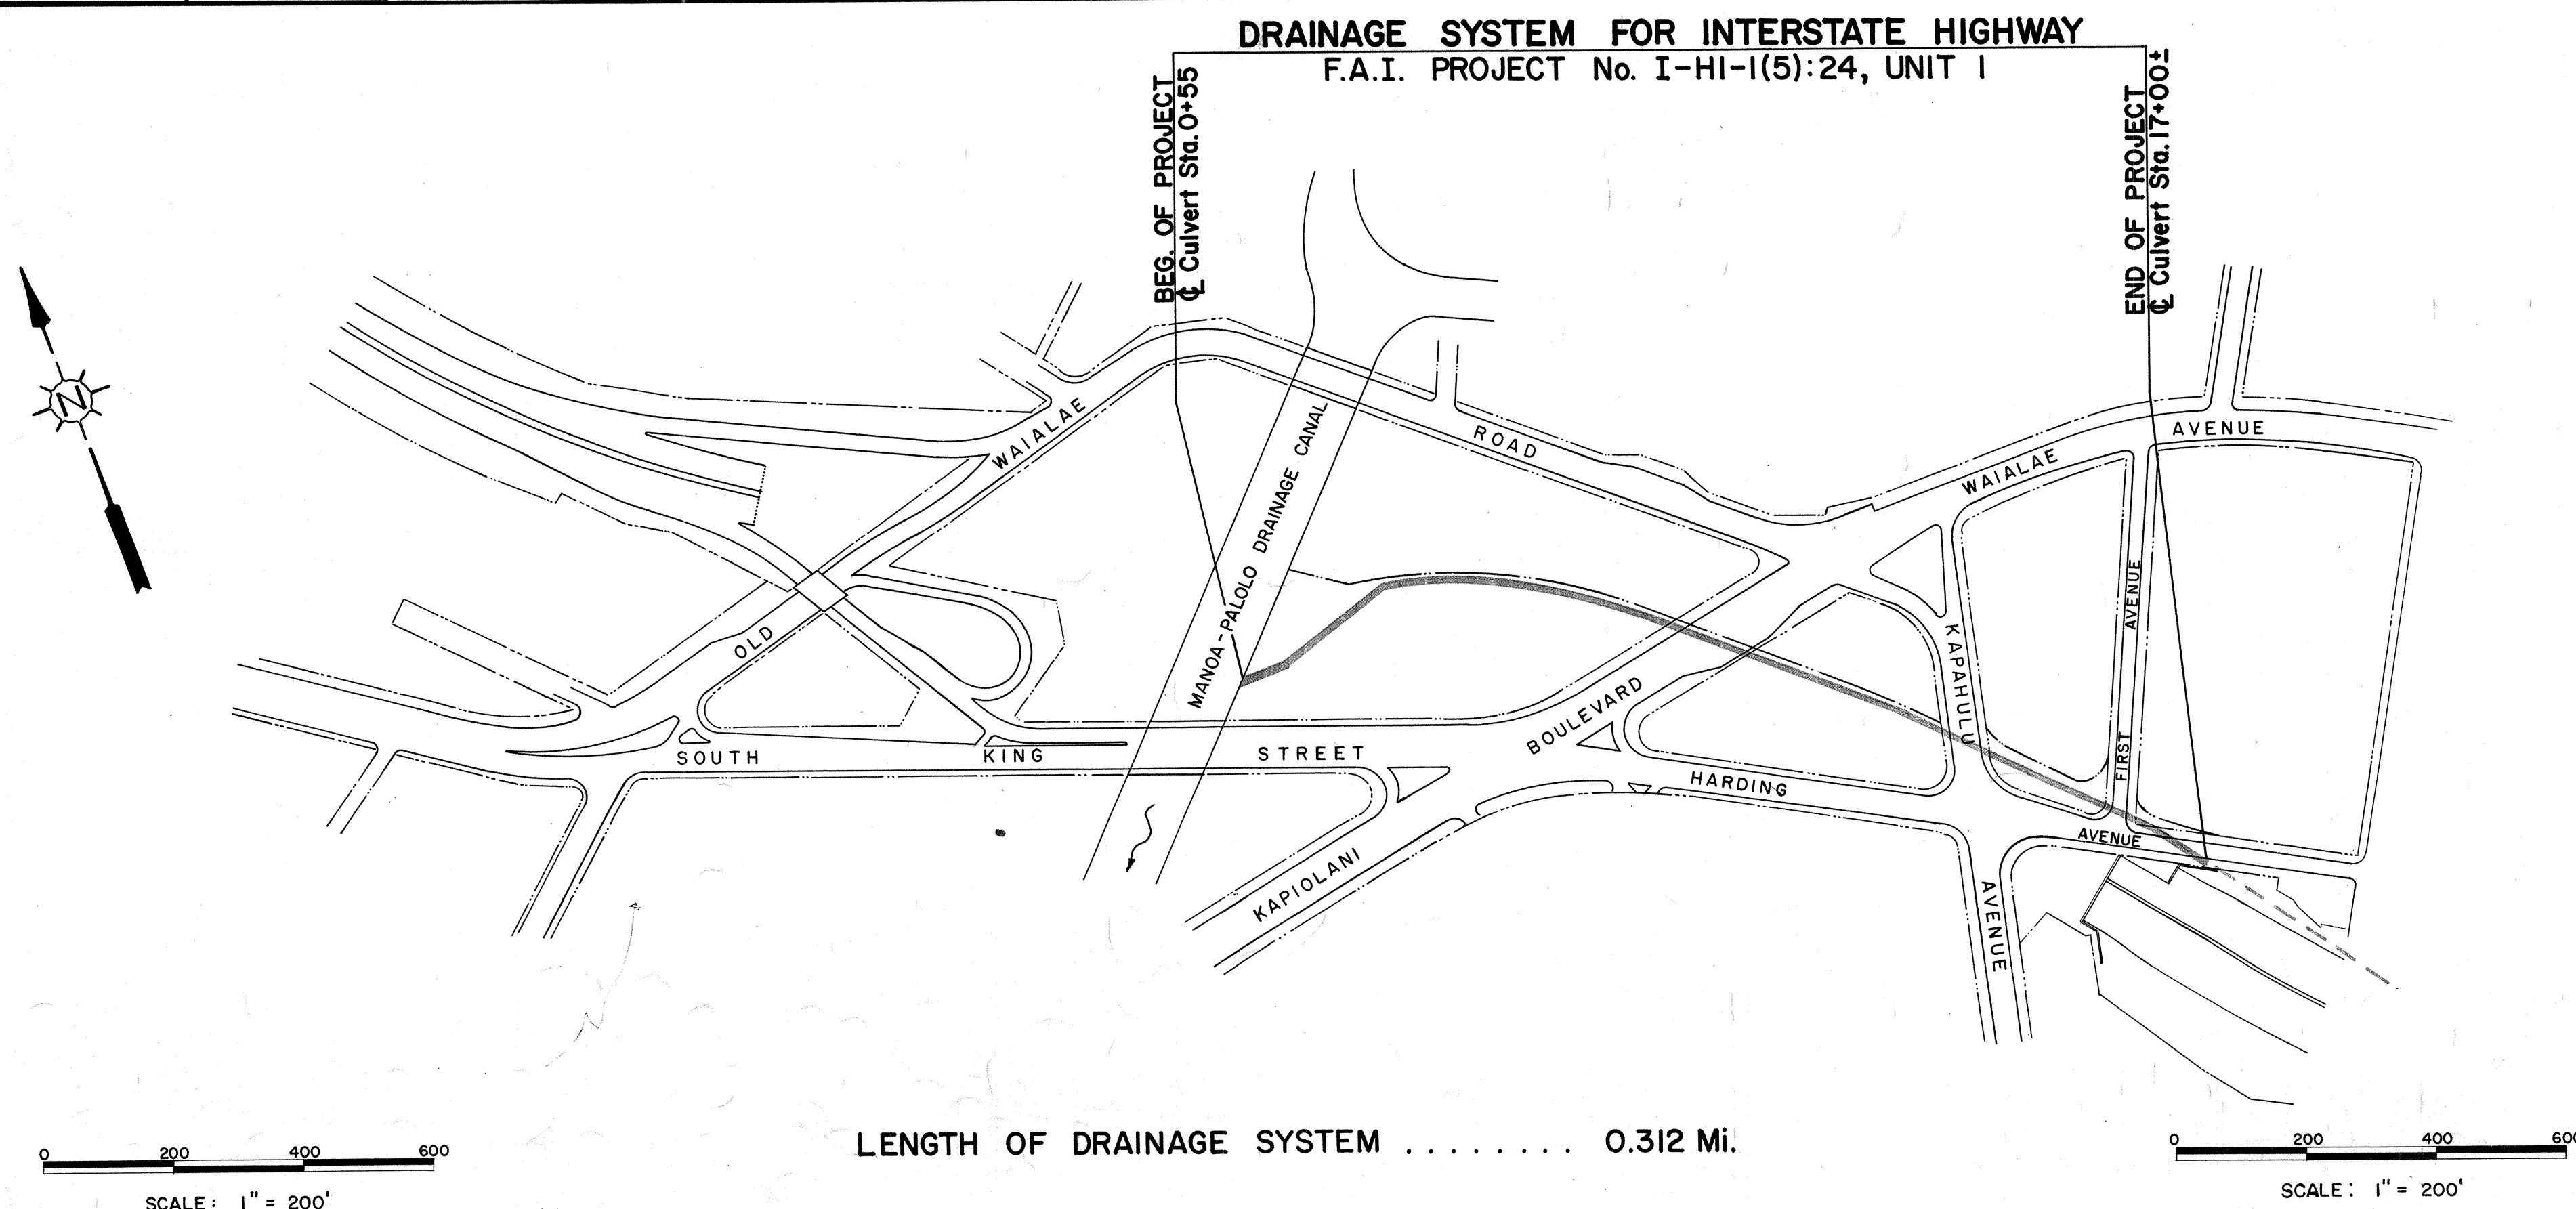

LENGTH OF DRAINAGE SYSTEM 0.312 Mi.

0 200 400 600

SCALE: 1" = 200'