

| INDEX TO DRAWINGS |                           |
|-------------------|---------------------------|
| SHEET NO.         | DESCRIPTION               |
| 1                 | Title sheet & Layout Plan |
| 2-7               | Boring Location Plans     |
| 8-14              | Profiles at Borings       |
|                   |                           |
|                   |                           |
|                   |                           |
|                   |                           |


STATE OF HAWAII  
DEPARTMENT OF TRANSPORTATION  
HIGHWAYS DIVISION  
HONOLULU, HAWAII

PLANS OF  
SUB-STRATA INVESTIGATION  
INTERSTATE ROUTE H-1  
FEDERAL AID INTERSTATE PROJECT I-HI-1(8)  
(WAIAWA INTERCHANGE)

DISTRICT OF EWA  
ISLAND OF OAHU

SCALES

PLAN ..... 1 IN. = 300 FT.  
PROFILE ..... HOR. 1 IN. = 100 FT.  
VER. 1 IN. = 10 FT.

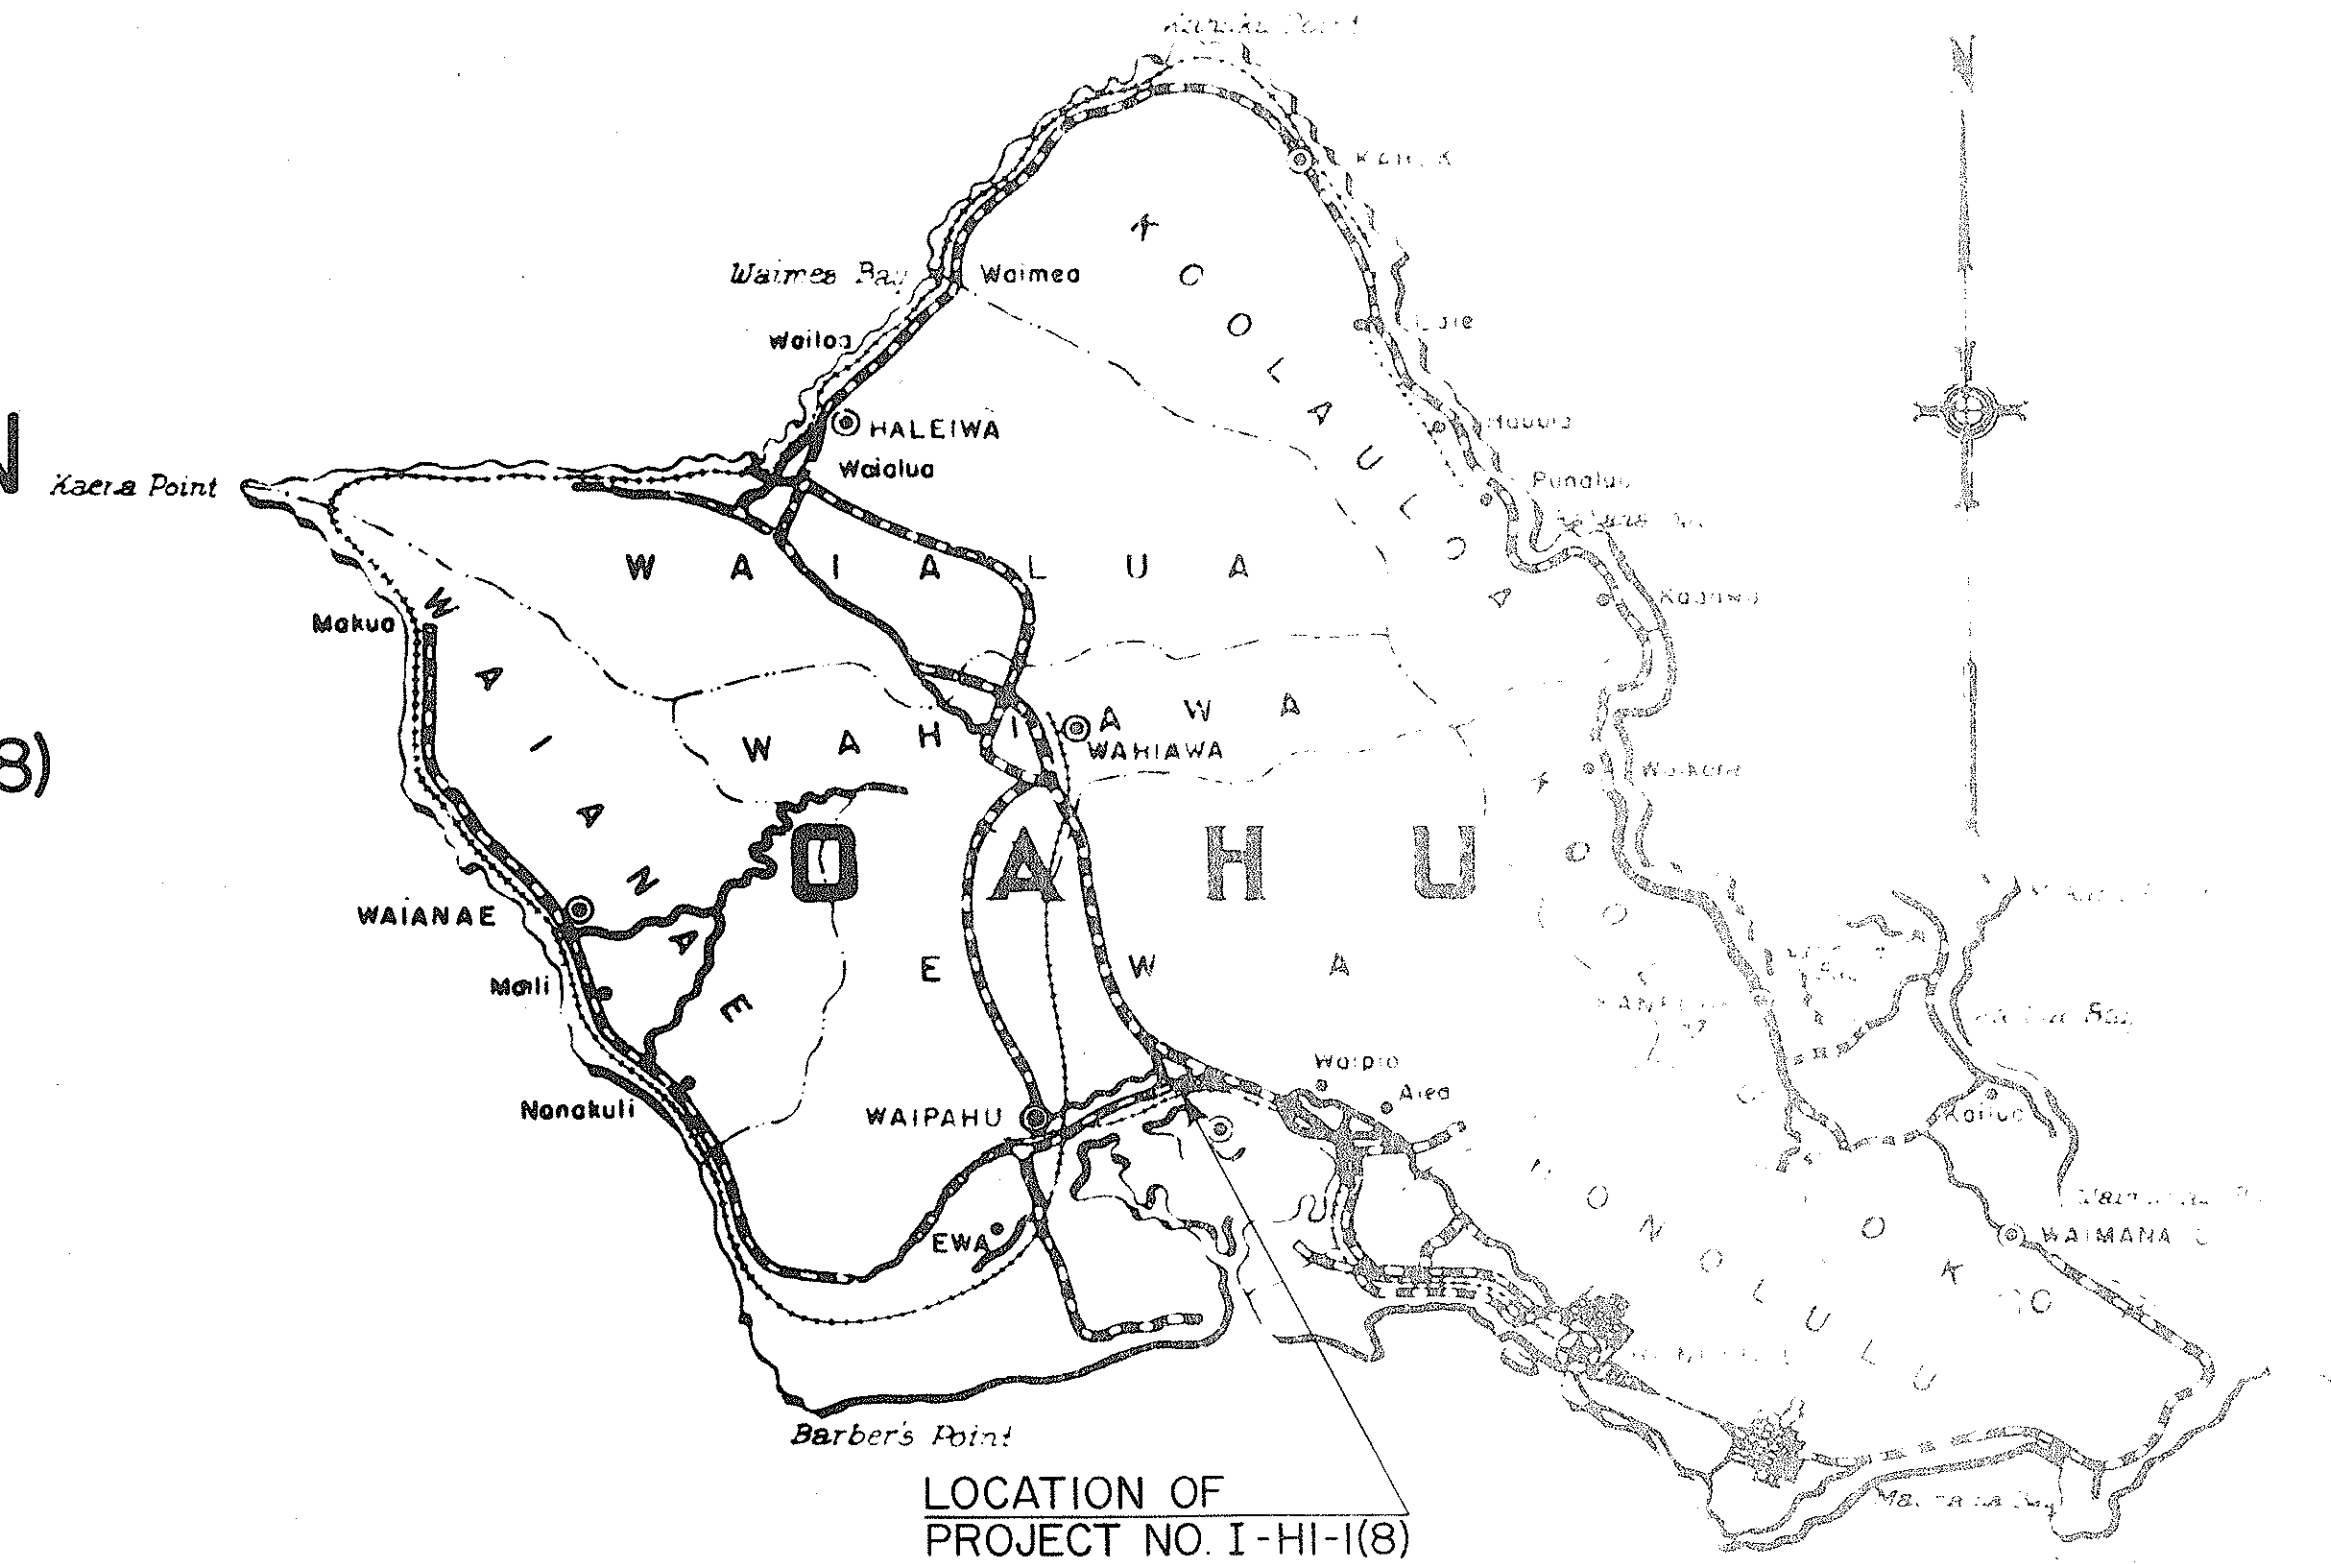

LOCATION OF  
PROJECT NO. I-HI-1(8)

Federal Aid Projects Previously Constructed Or Under Construction

Correction to Plan No. 1, On 7/24/15 (Permit Notification)  
Moved because No Right of Entry

Anticipated crop damage area due to boring contractor's operations.

LAYOUT PLAN  
Scale: 1" = 300'

APPROVED: *[Signature]* DATE 16 Dec 64

DEPARTMENT OF COMMERCE  
BUREAU OF PUBLIC ROADS  
APPROVED: \_\_\_\_\_  
DIVISION ENGINEER DATE

DATE \_\_\_\_\_  
SURVEY PLATTED BY \_\_\_\_\_  
ORIGINAL PLAN \_\_\_\_\_  
DRAWN BY \_\_\_\_\_  
NOTE BOOK \_\_\_\_\_  
QUANTITIES CHECKED BY \_\_\_\_\_  
CHECKED BY \_\_\_\_\_

