


PROJ. NO.	STATE	PROJ. AND FUND. NO.	FISCAL YEAR	SHEET NO.	TOTAL SHEETS
MAKAKILO	HAWAII	1-11-1(17)	1965	15	146

ORIGINAL	SURVEY PLOTTED BY	DATE
PLAN	DRAWN BY	
NOTED	TRACED BY	
BOOK	QUANTITIES BY	
NO.	CHECKED BY	

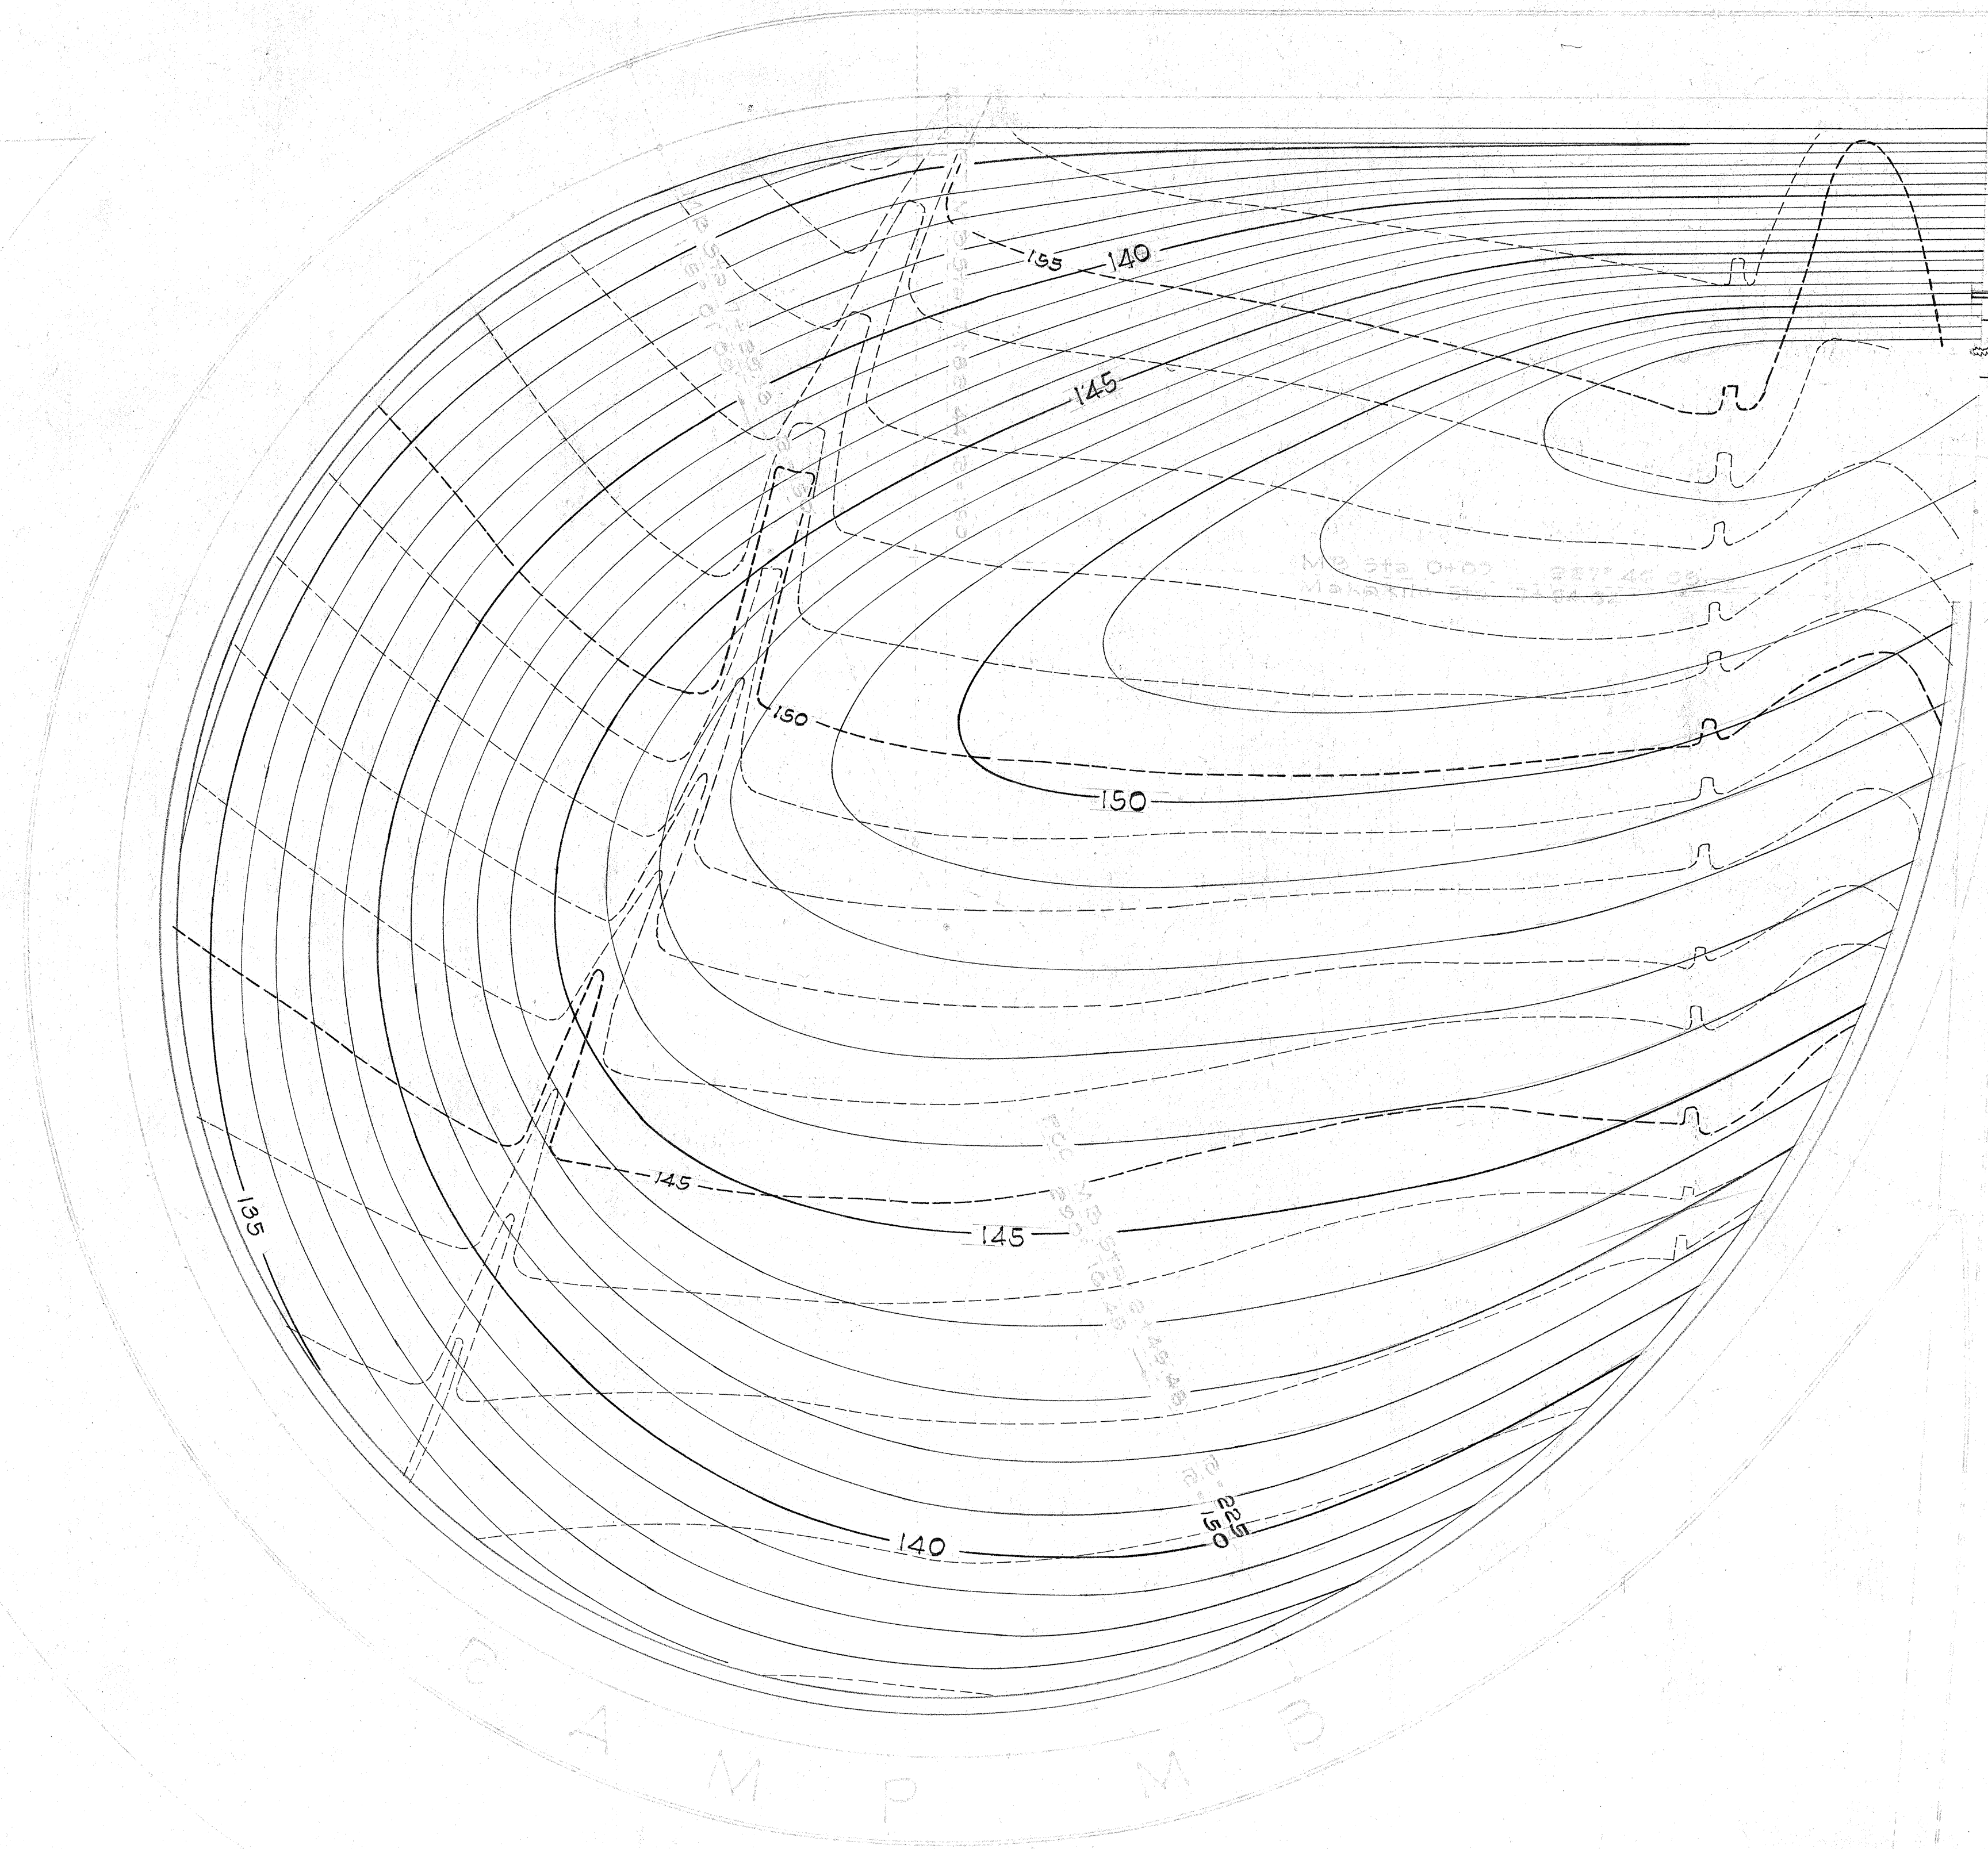

NOTE:

1. Contractor to grade contoured area as shown on this plan.
2. Contour lines shown as solid lines are finished contours.
3. Grading Excavation will be paid for under Roadway Excavation.

STATE OF HAWAII
DEPARTMENT OF TRANSPORTATION
HIGHWAYS DIVISION

GRADING PLAN RAMP MB


INTERSTATE ROUTE H-1
F.A.T. PROJ. No. 1-11-1(17), UNIT 1

Scale: 1" = 20'

Date: January, 1965

SHEET No. 1 OF 2 SHEETS

FED. ROAD DIST. NO.	STATE	FED. AID FUND. NO.	FISCAL YEAR	SHEET NO.	TOTAL SHEETS
HAWAII	HAW.	I-H-1(17)	1965	19	146

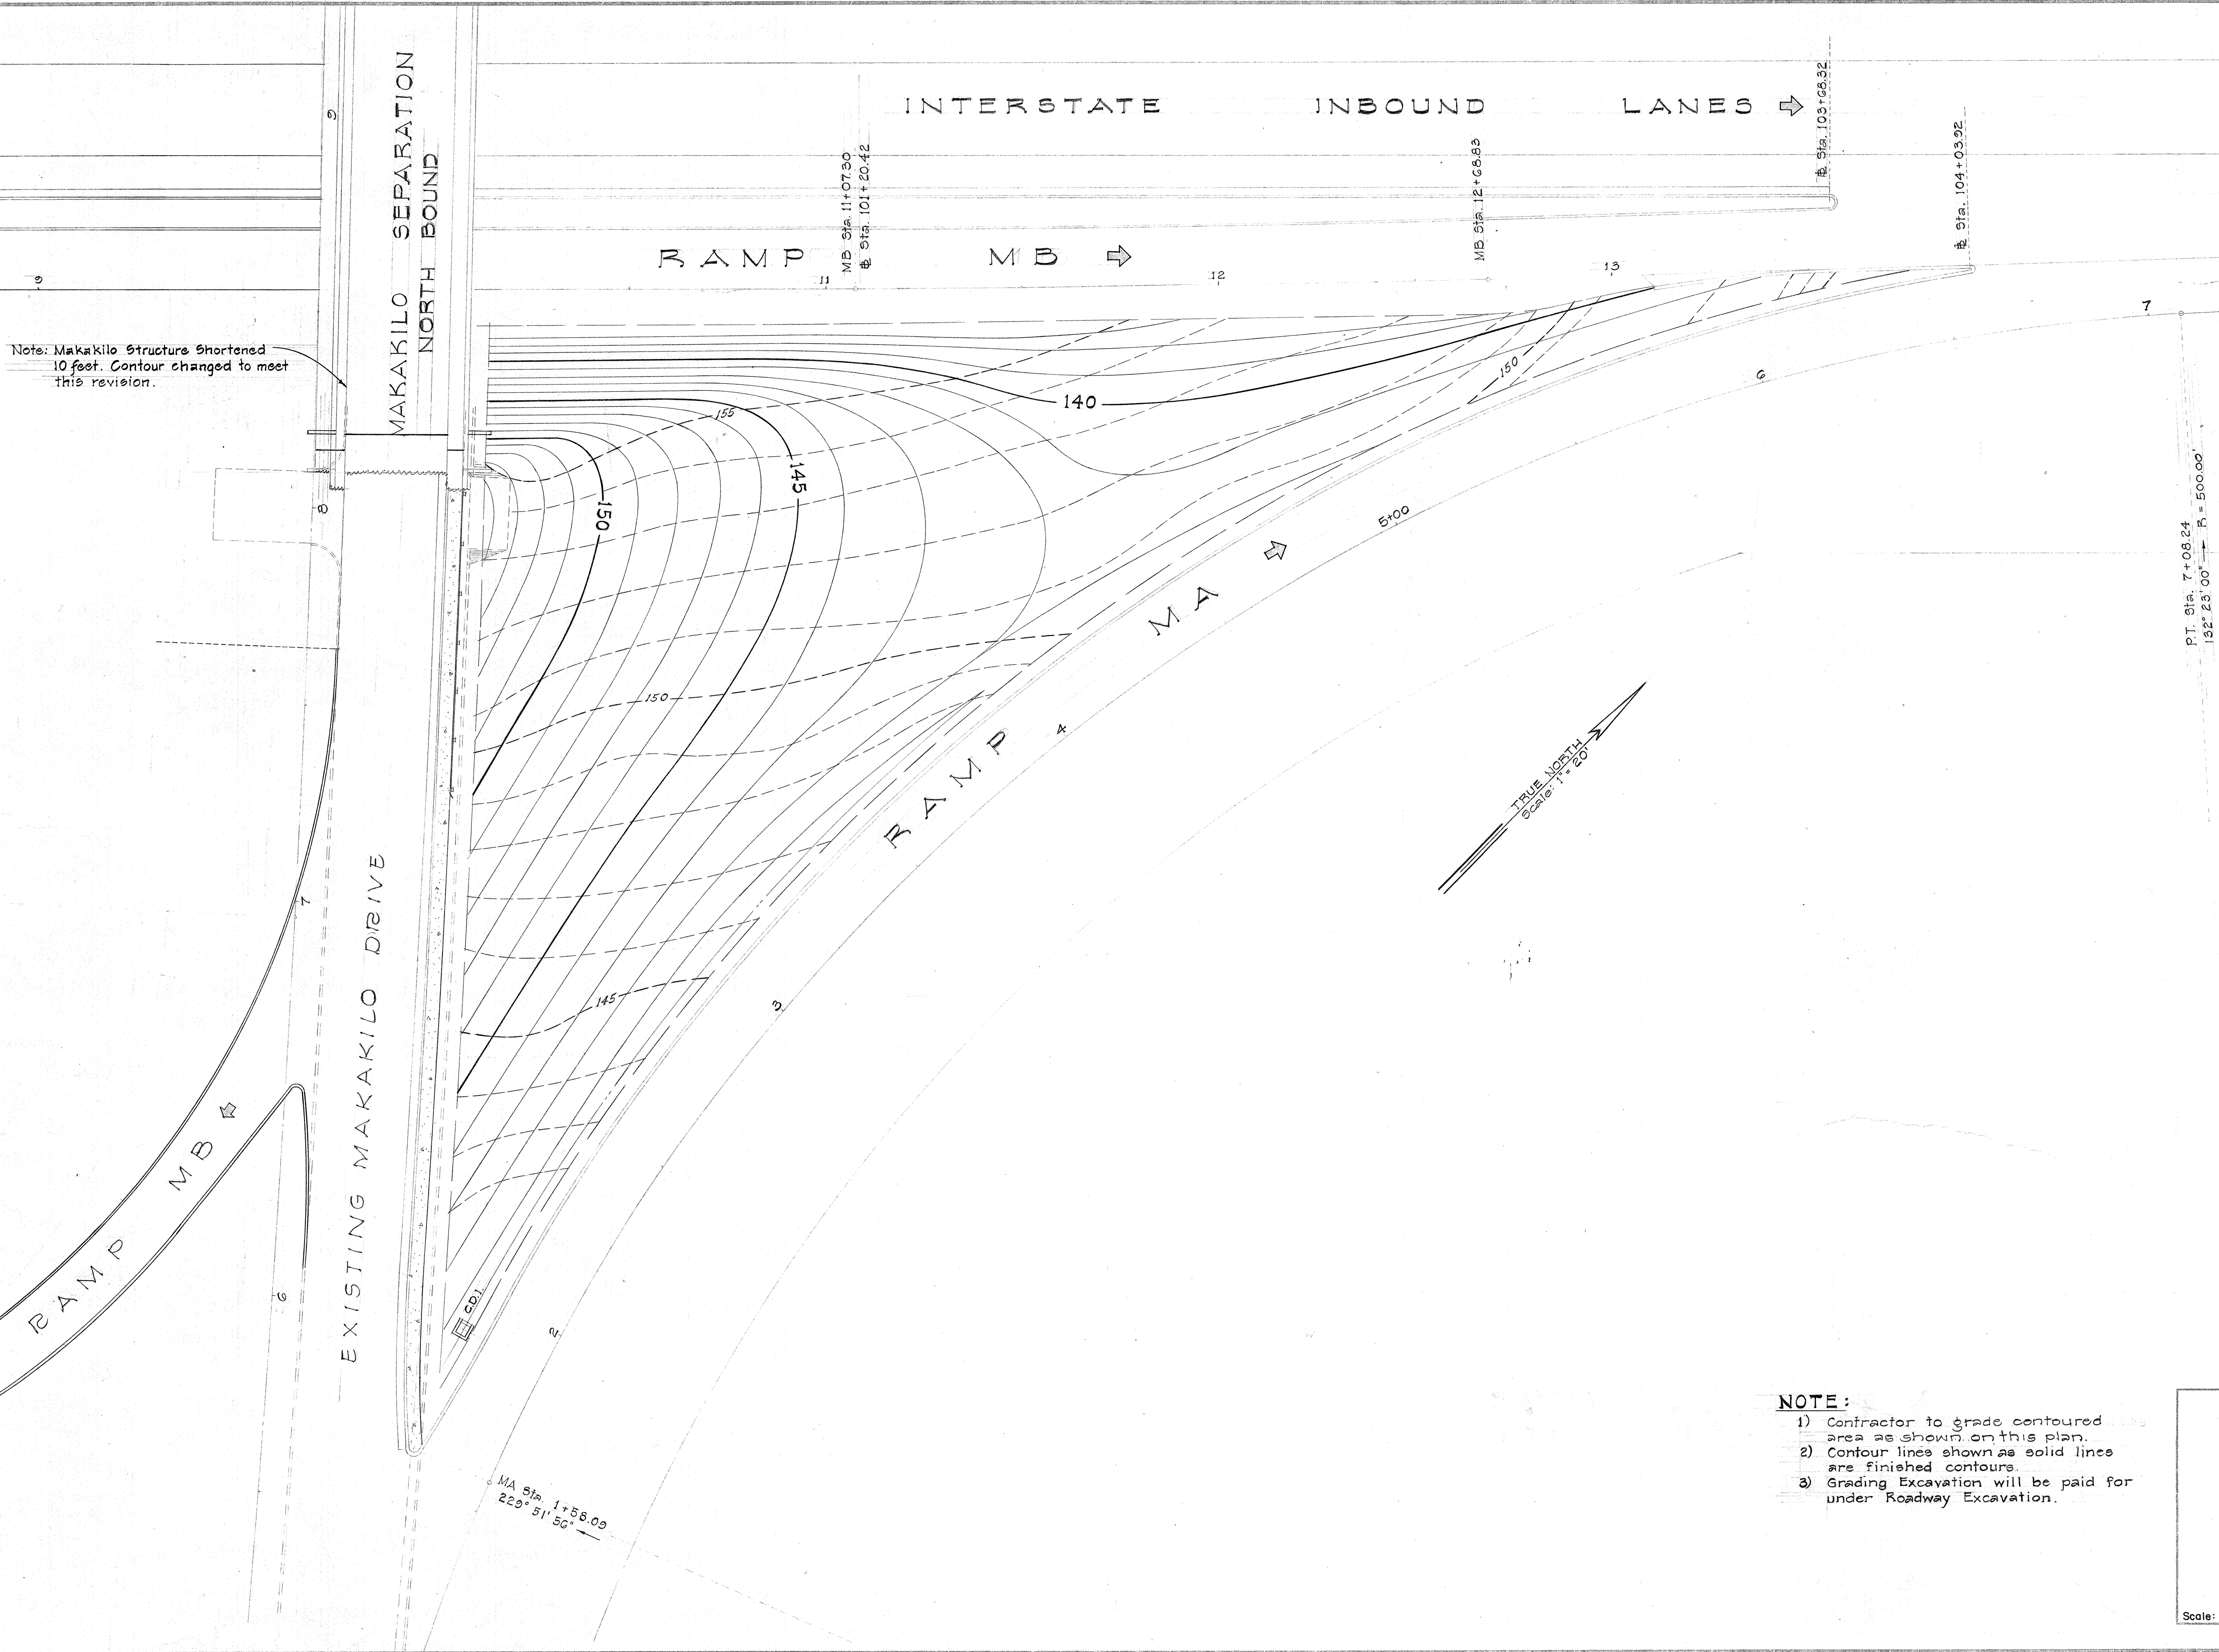

- NOTE:**
- 1) Contractor to grade contoured area as shown on this plan.
 - 2) Contour lines shown as solid lines are finished contours.
 - 3) Grading Excavation will be paid for under Roadway Excavation.

STATE OF HAWAII
DEPARTMENT OF TRANSPORTATION
HIGHWAYS DIVISION

**GRADING PLAN
RAMP MA**

INTERSTATE ROUTE H-1
F.A.I. Proj. No. I-H-1(17), UNIT 1

Scale: 1" = 20' Date: October, 1964

SHEET No. 2 OF 2 SHEETS

ORIGINAL PLAN	DATE
DESIGNED BY	"
TRACED BY	"
NOTE BOOK	"
CHECKED BY	"
No.	"