
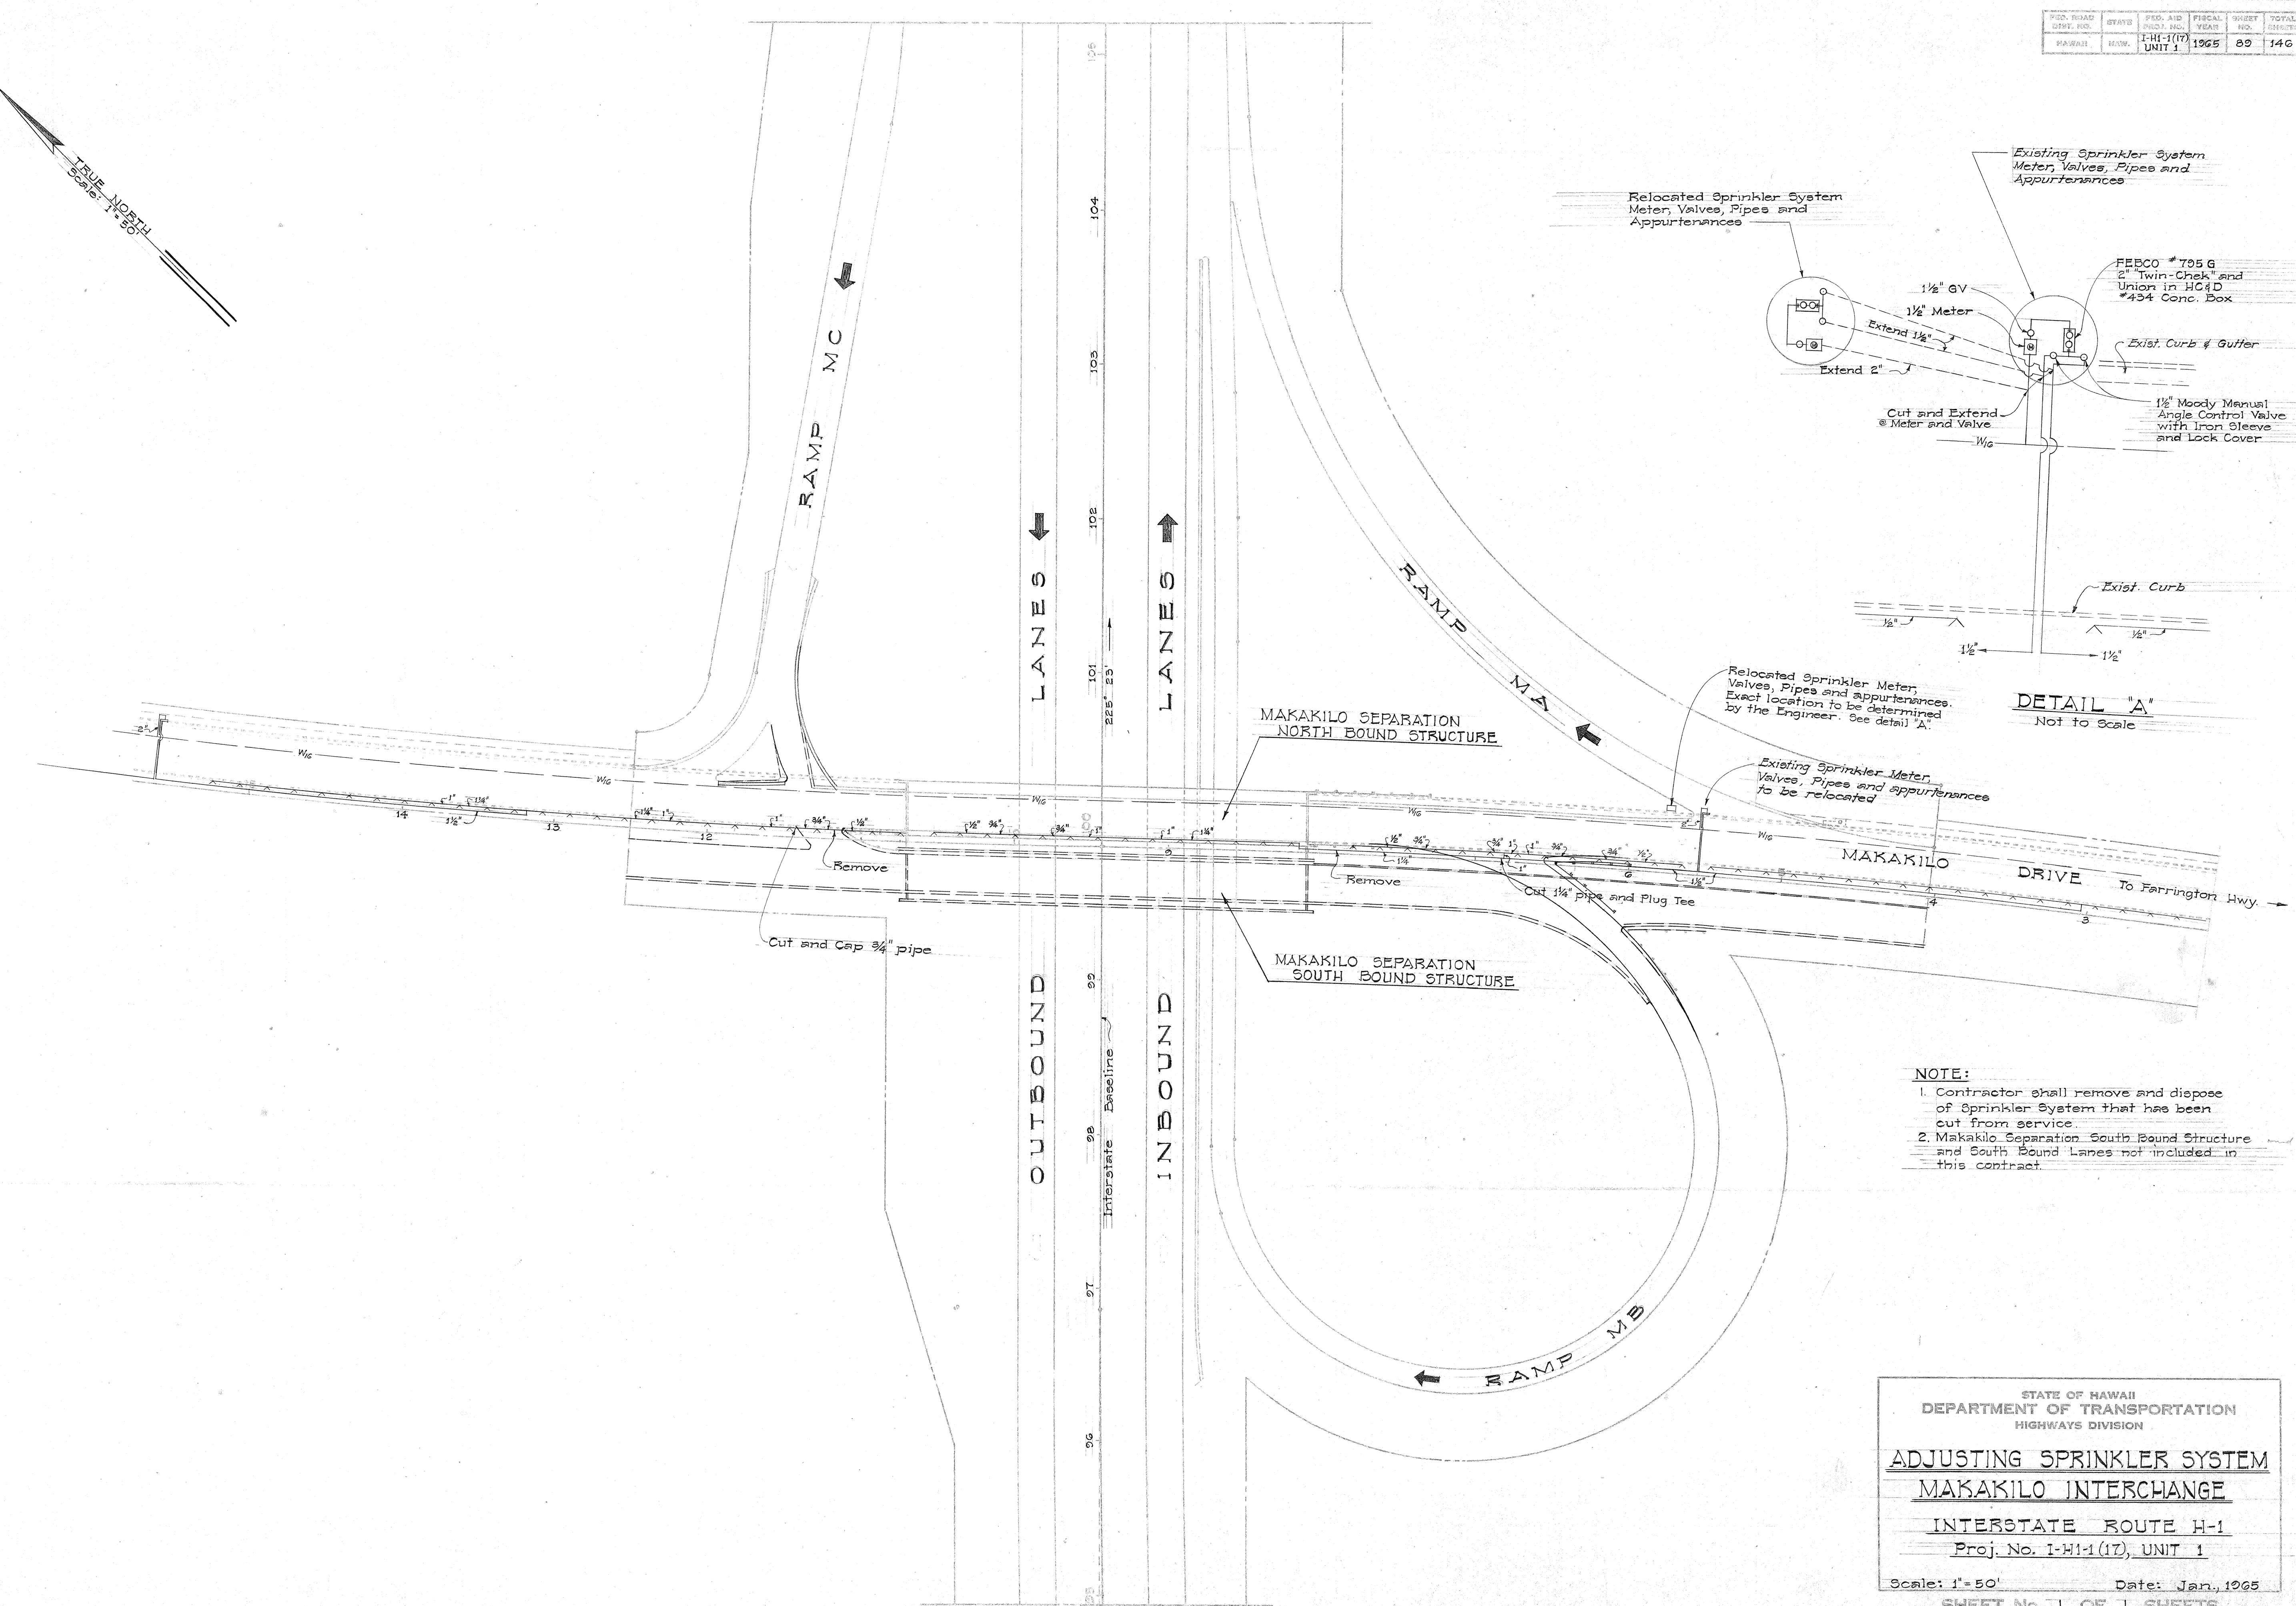


FED. ROAD DIST. NO.	STATE	FED. AID PROJ. NO.	FISCAL YEAR	SHEET NO.	TOTAL SHEETS
1-H-1(17)	HAWAII	UNIT 1	1965	89	146

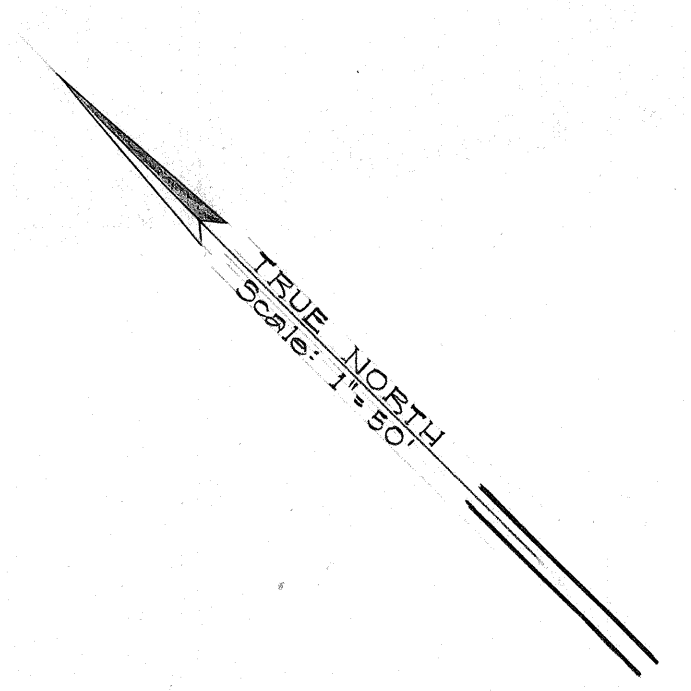

- NOTE:**
1. Contractor shall remove and dispose of Sprinkler System that has been cut from service.
 2. Makakilo Separation South Bound Structure and South Bound Lanes not included in this contract.

STATE OF HAWAII
DEPARTMENT OF TRANSPORTATION
HIGHWAYS DIVISION

**ADJUSTING SPRINKLER SYSTEM
MAKAKILO INTERCHANGE**

INTERSTATE ROUTE H-1
Proj. No. I-H-1(17), UNIT 1

Scale: 1"=50' Date: Jan. 1965

SHEET No. 1 OF 1 SHEETS

ORIGINAL PLAN	SURVEY PLOTTED BY	DATE
NOTE BOOK	DRAWN BY	
	DESIGNED BY	
	CHECKED BY	

89