
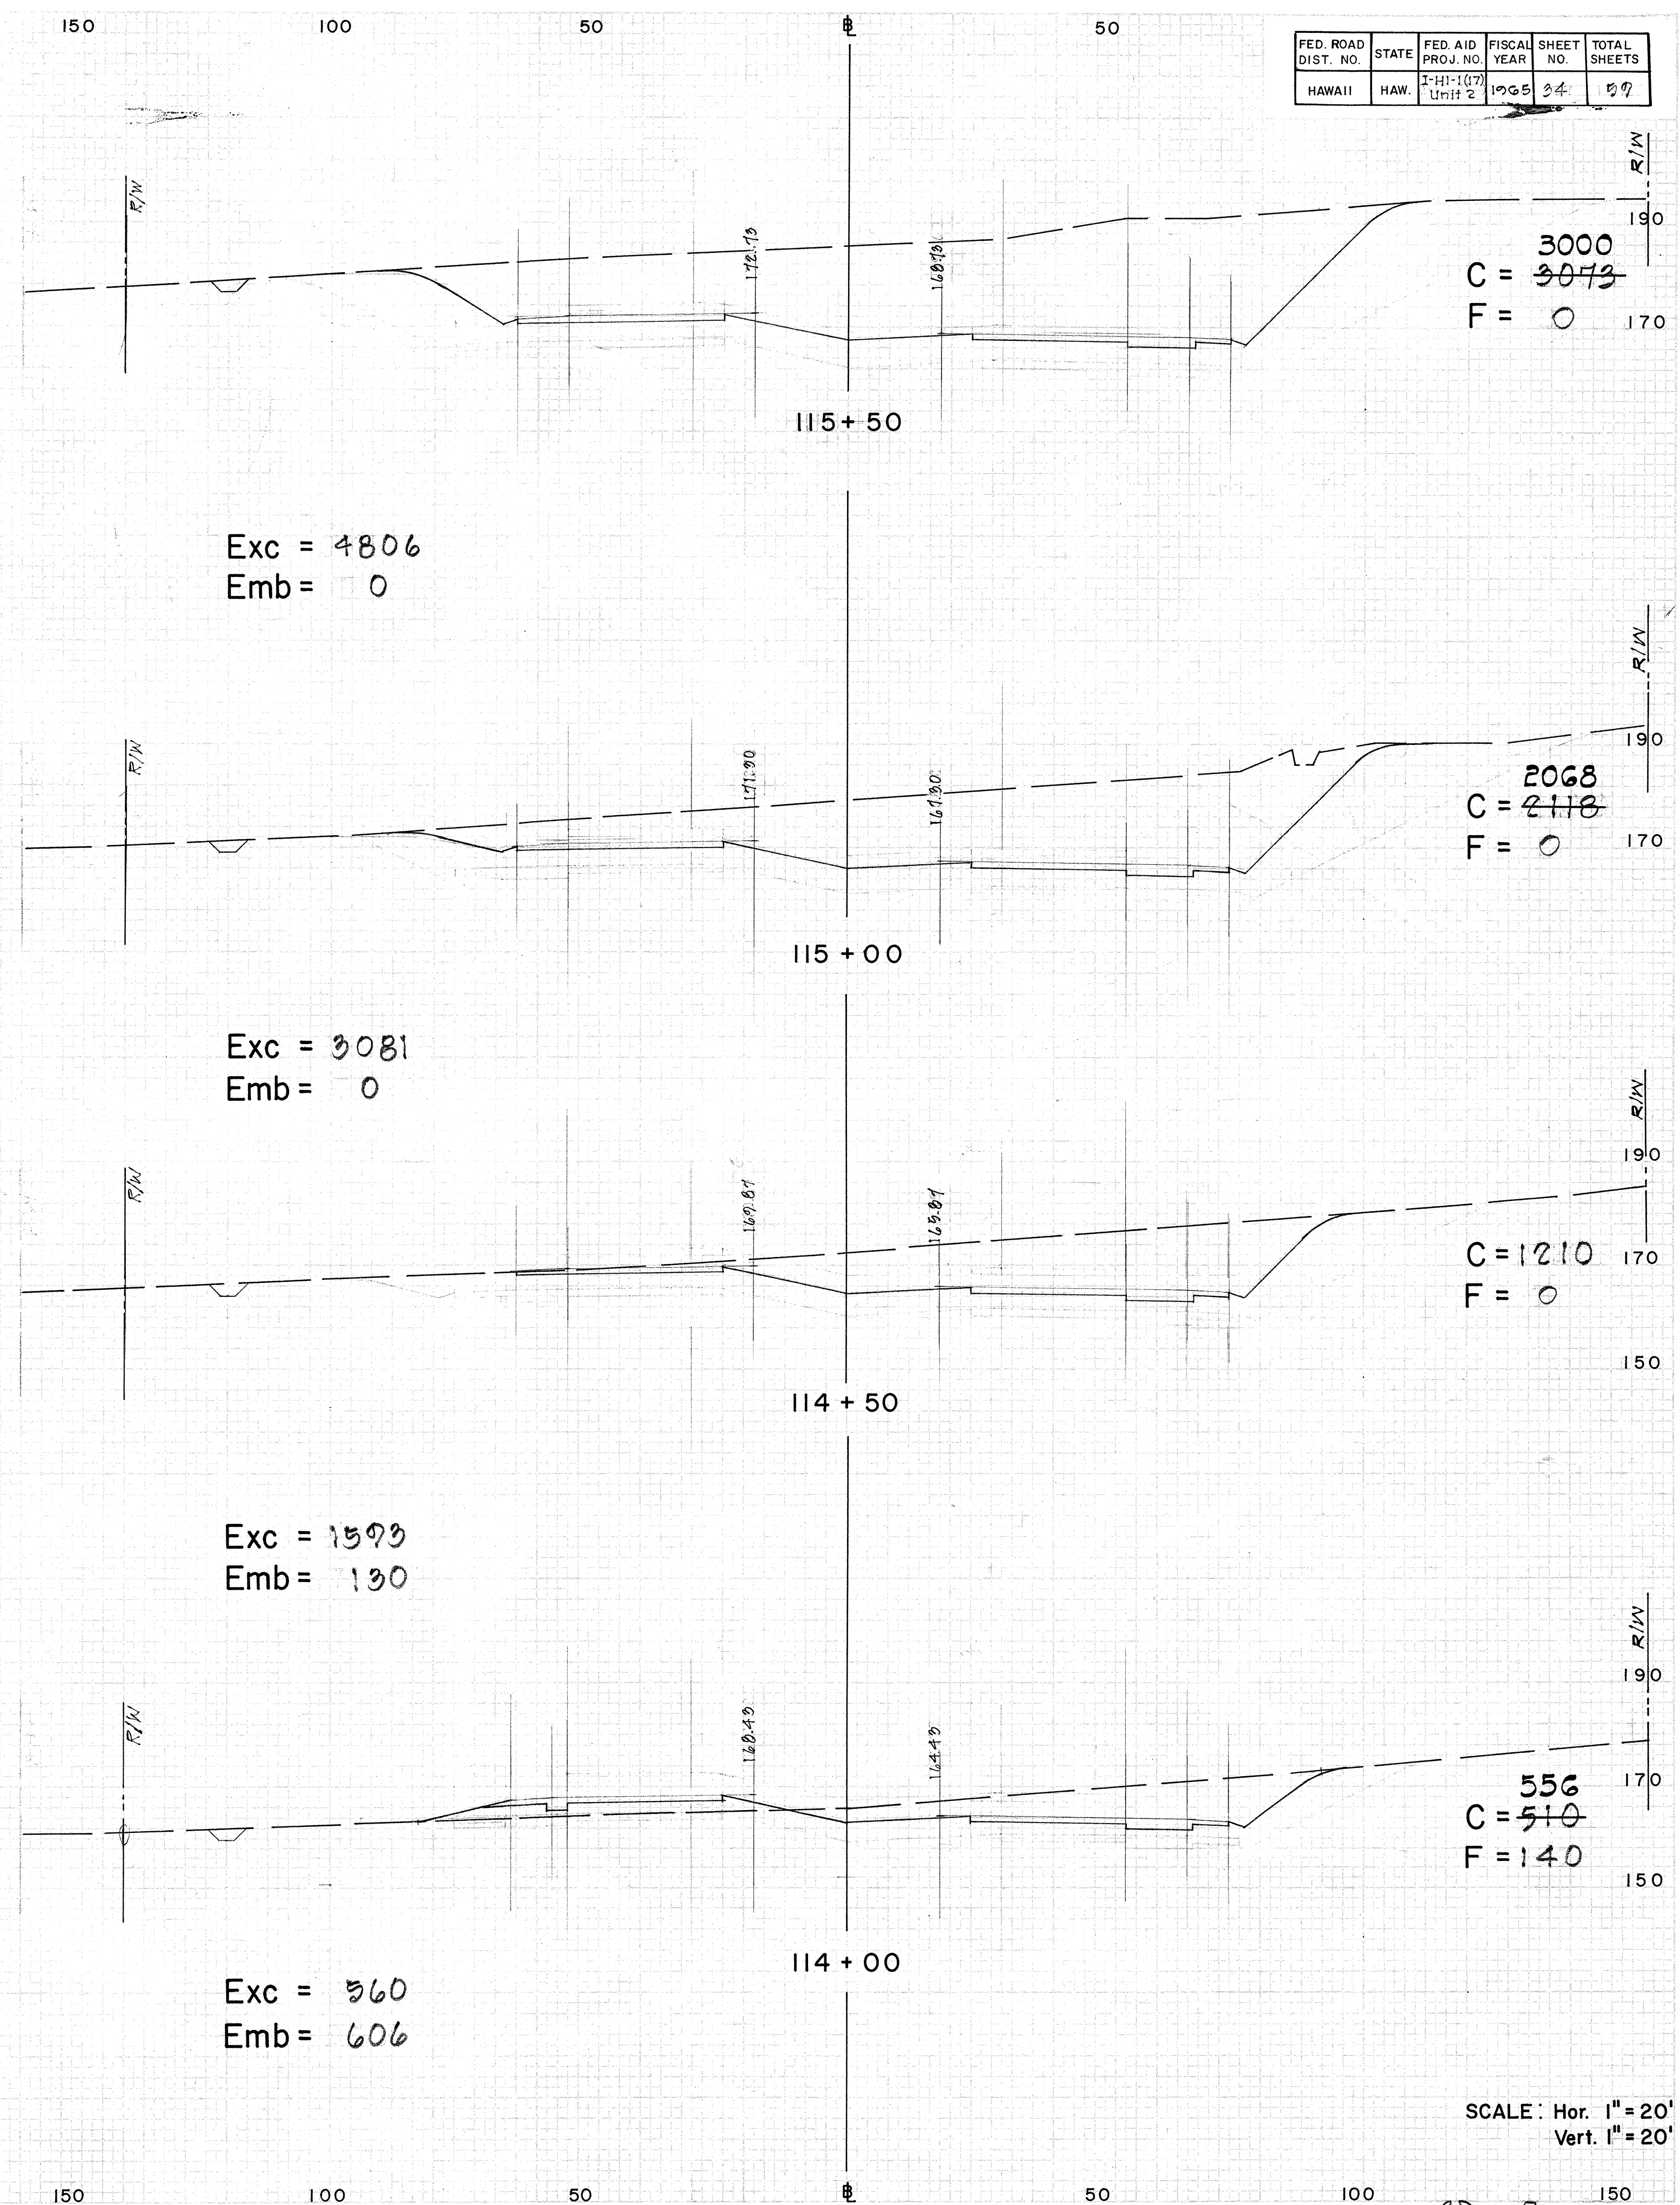


2/2

FED. ROAD DIST. NO.	STATE	FED. AID PROJ. NO.	FISCAL YEAR	SHEET NO.	TOTAL SHEETS
HAWAII	HAW.	I-H-1077 Unit 2	1965	34	59

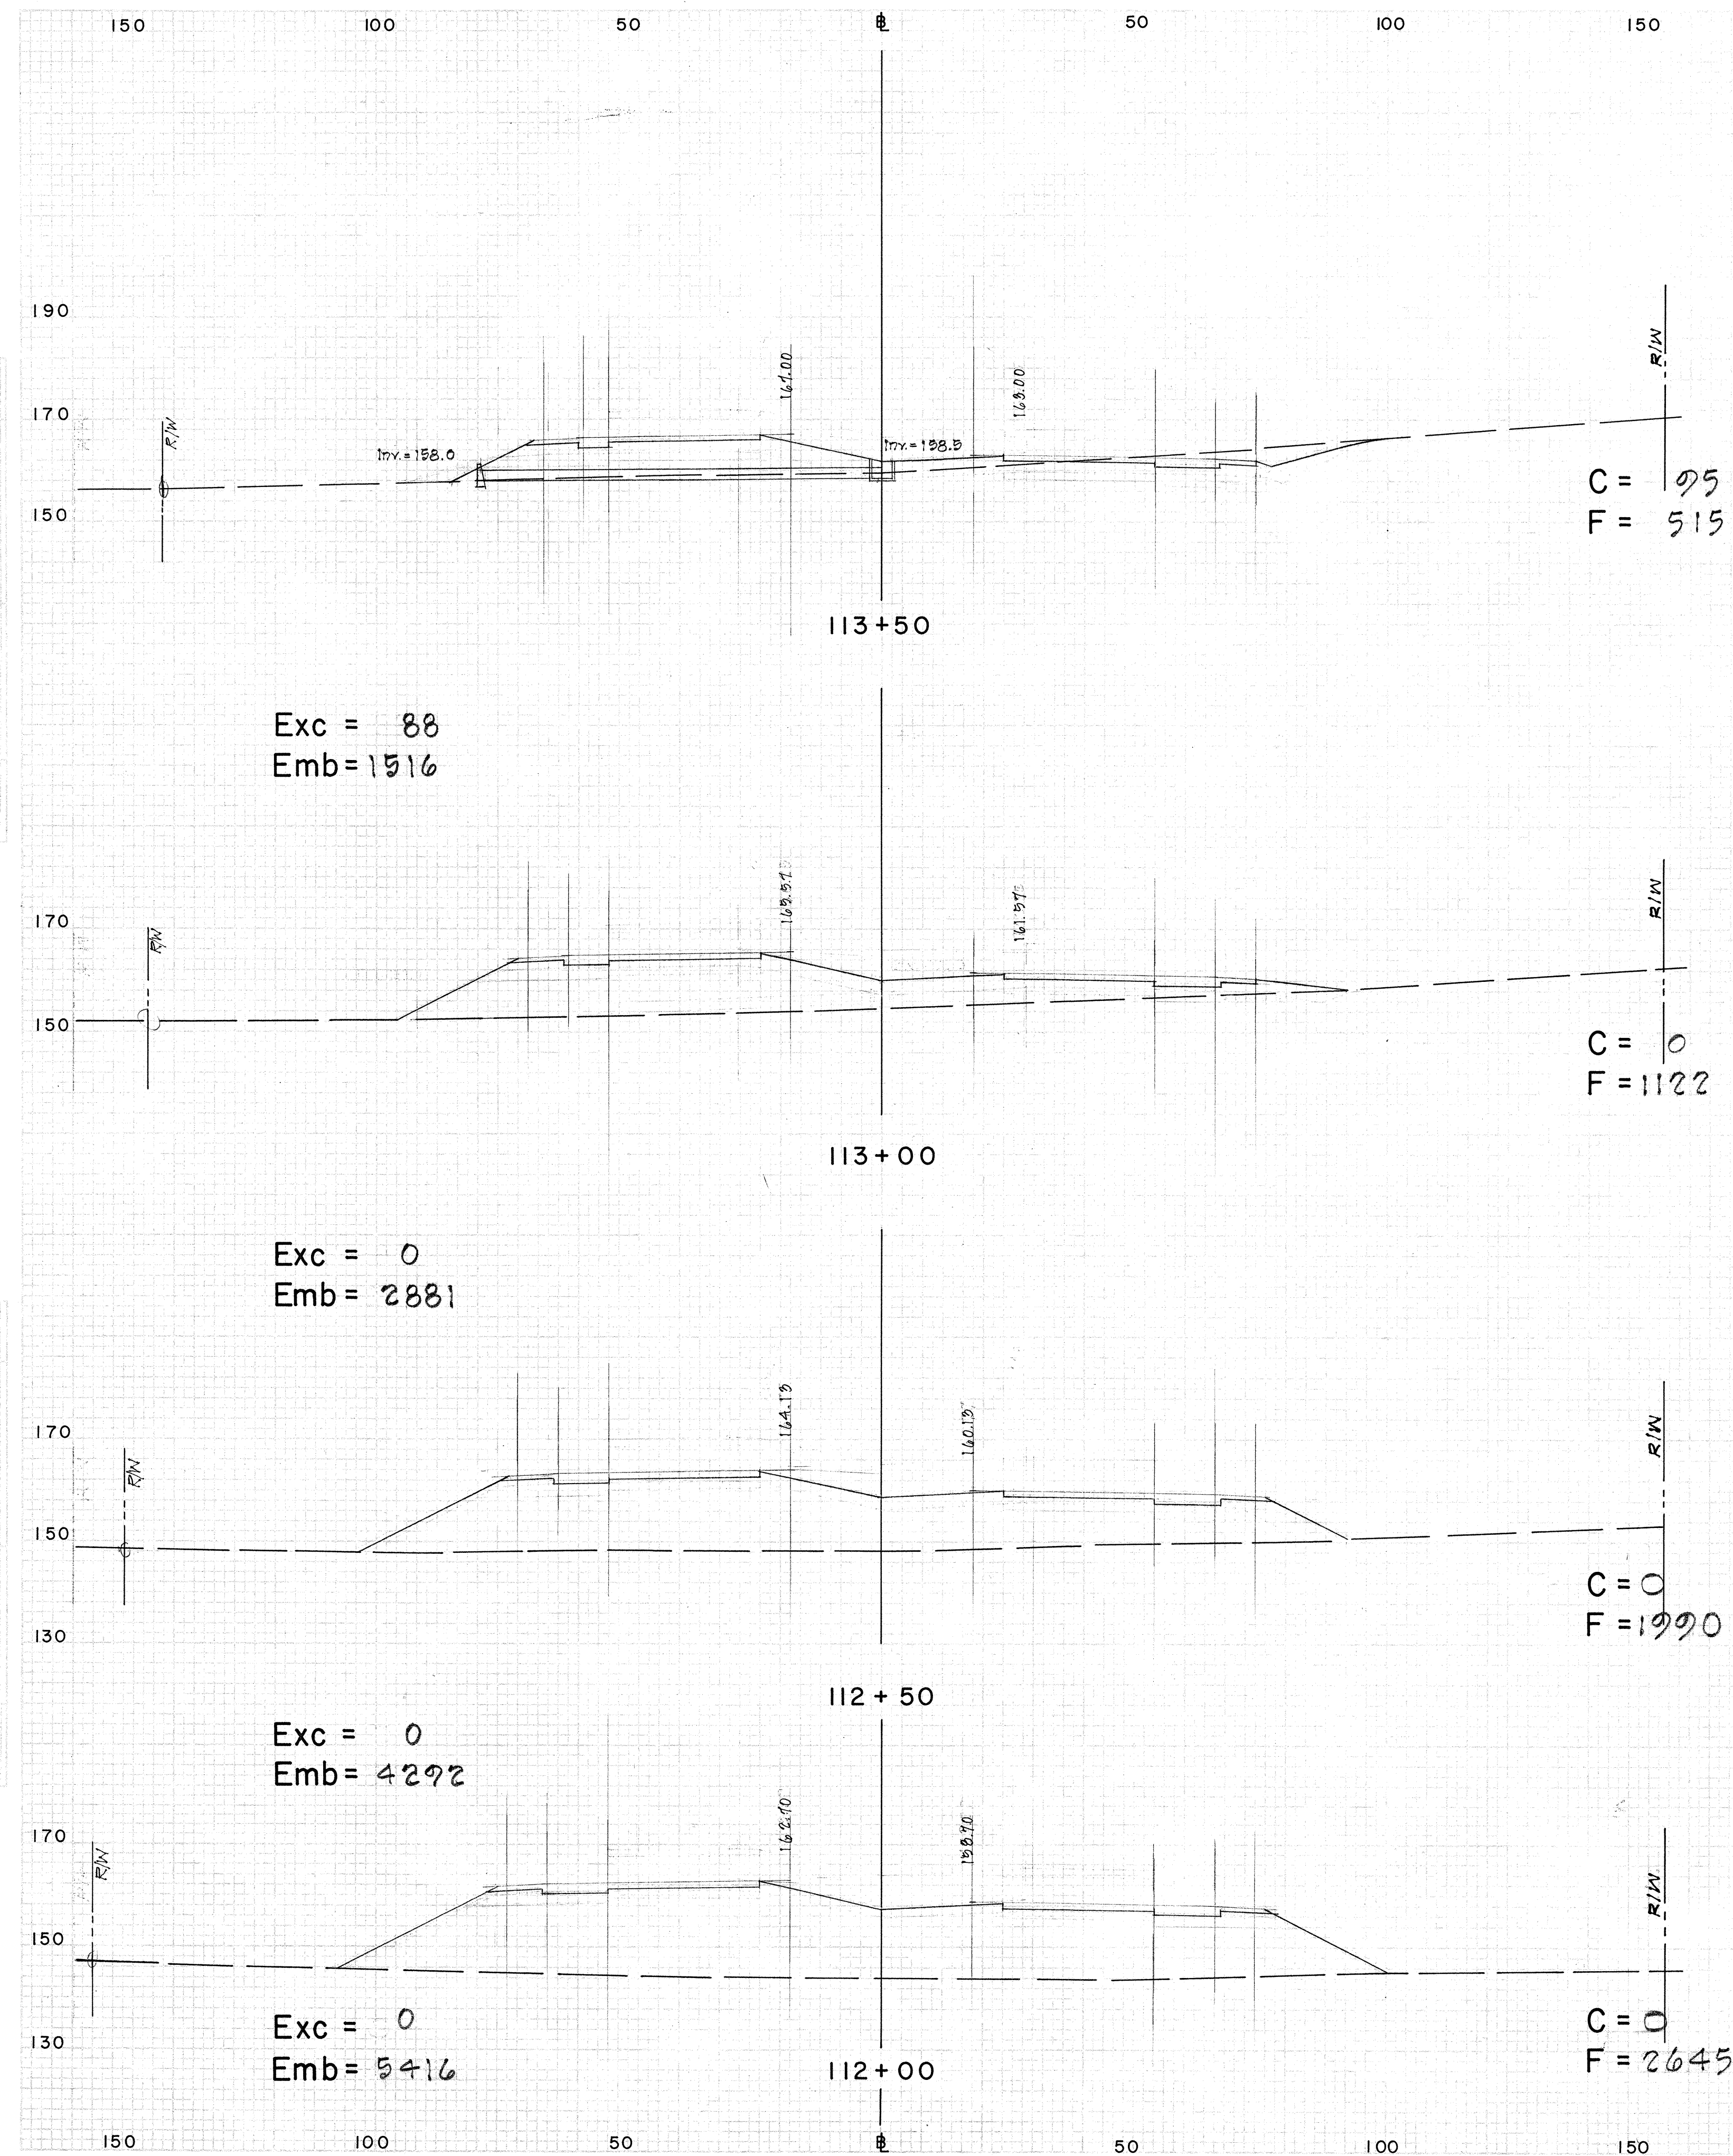


SCALE: Hor. 1" = 20'
Vert. 1" = 20'

34


99.07-4-23

FED. ROAD DIST. NO.	STATE	FED. AID PROJ. NO.	FISCAL YEAR	SHEET NO.	TOTAL SHEETS
HAWAII	HAW.	1-HI-1017	1965	35	37

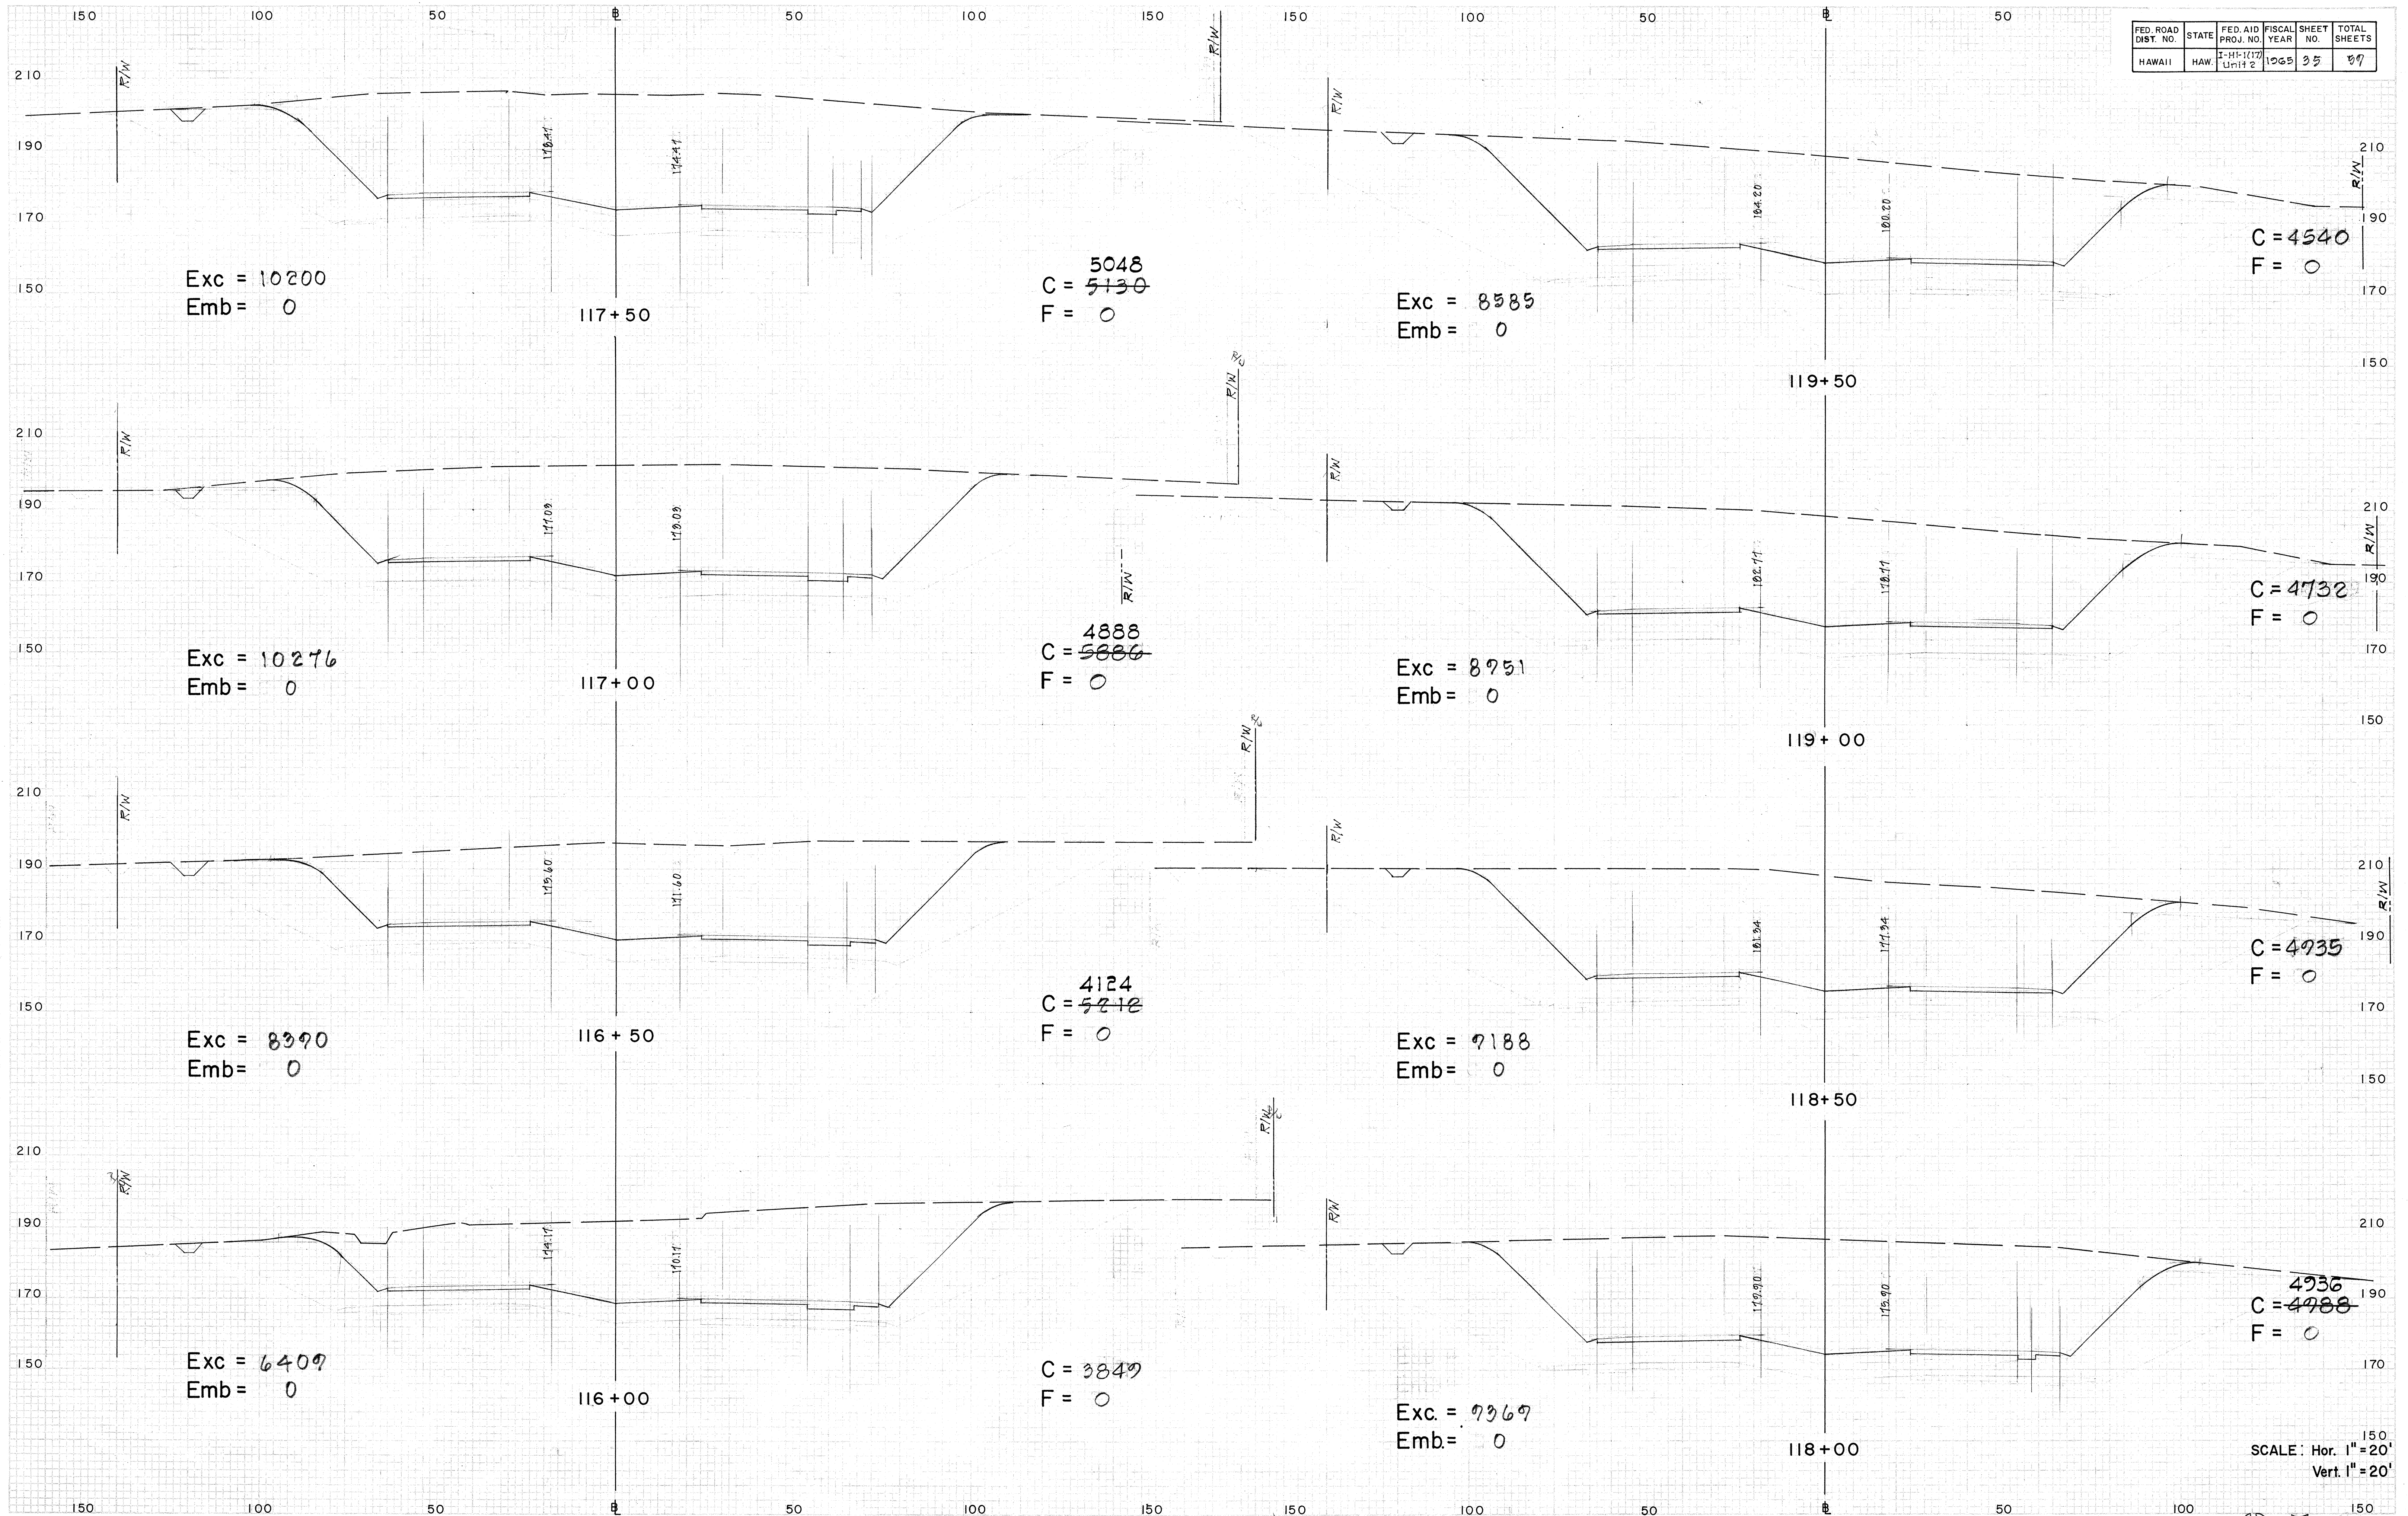


SCALE: Hor. 1"=20'
Vert. 1"=20'

FED. ROAD DIST. NO.	STATE	FED. AID PROJ. NO.	FISCAL YEAR	SHEET NO.	TOTAL SHEETS
HAWAII	HAW.	I-HI-107	1965	36	89

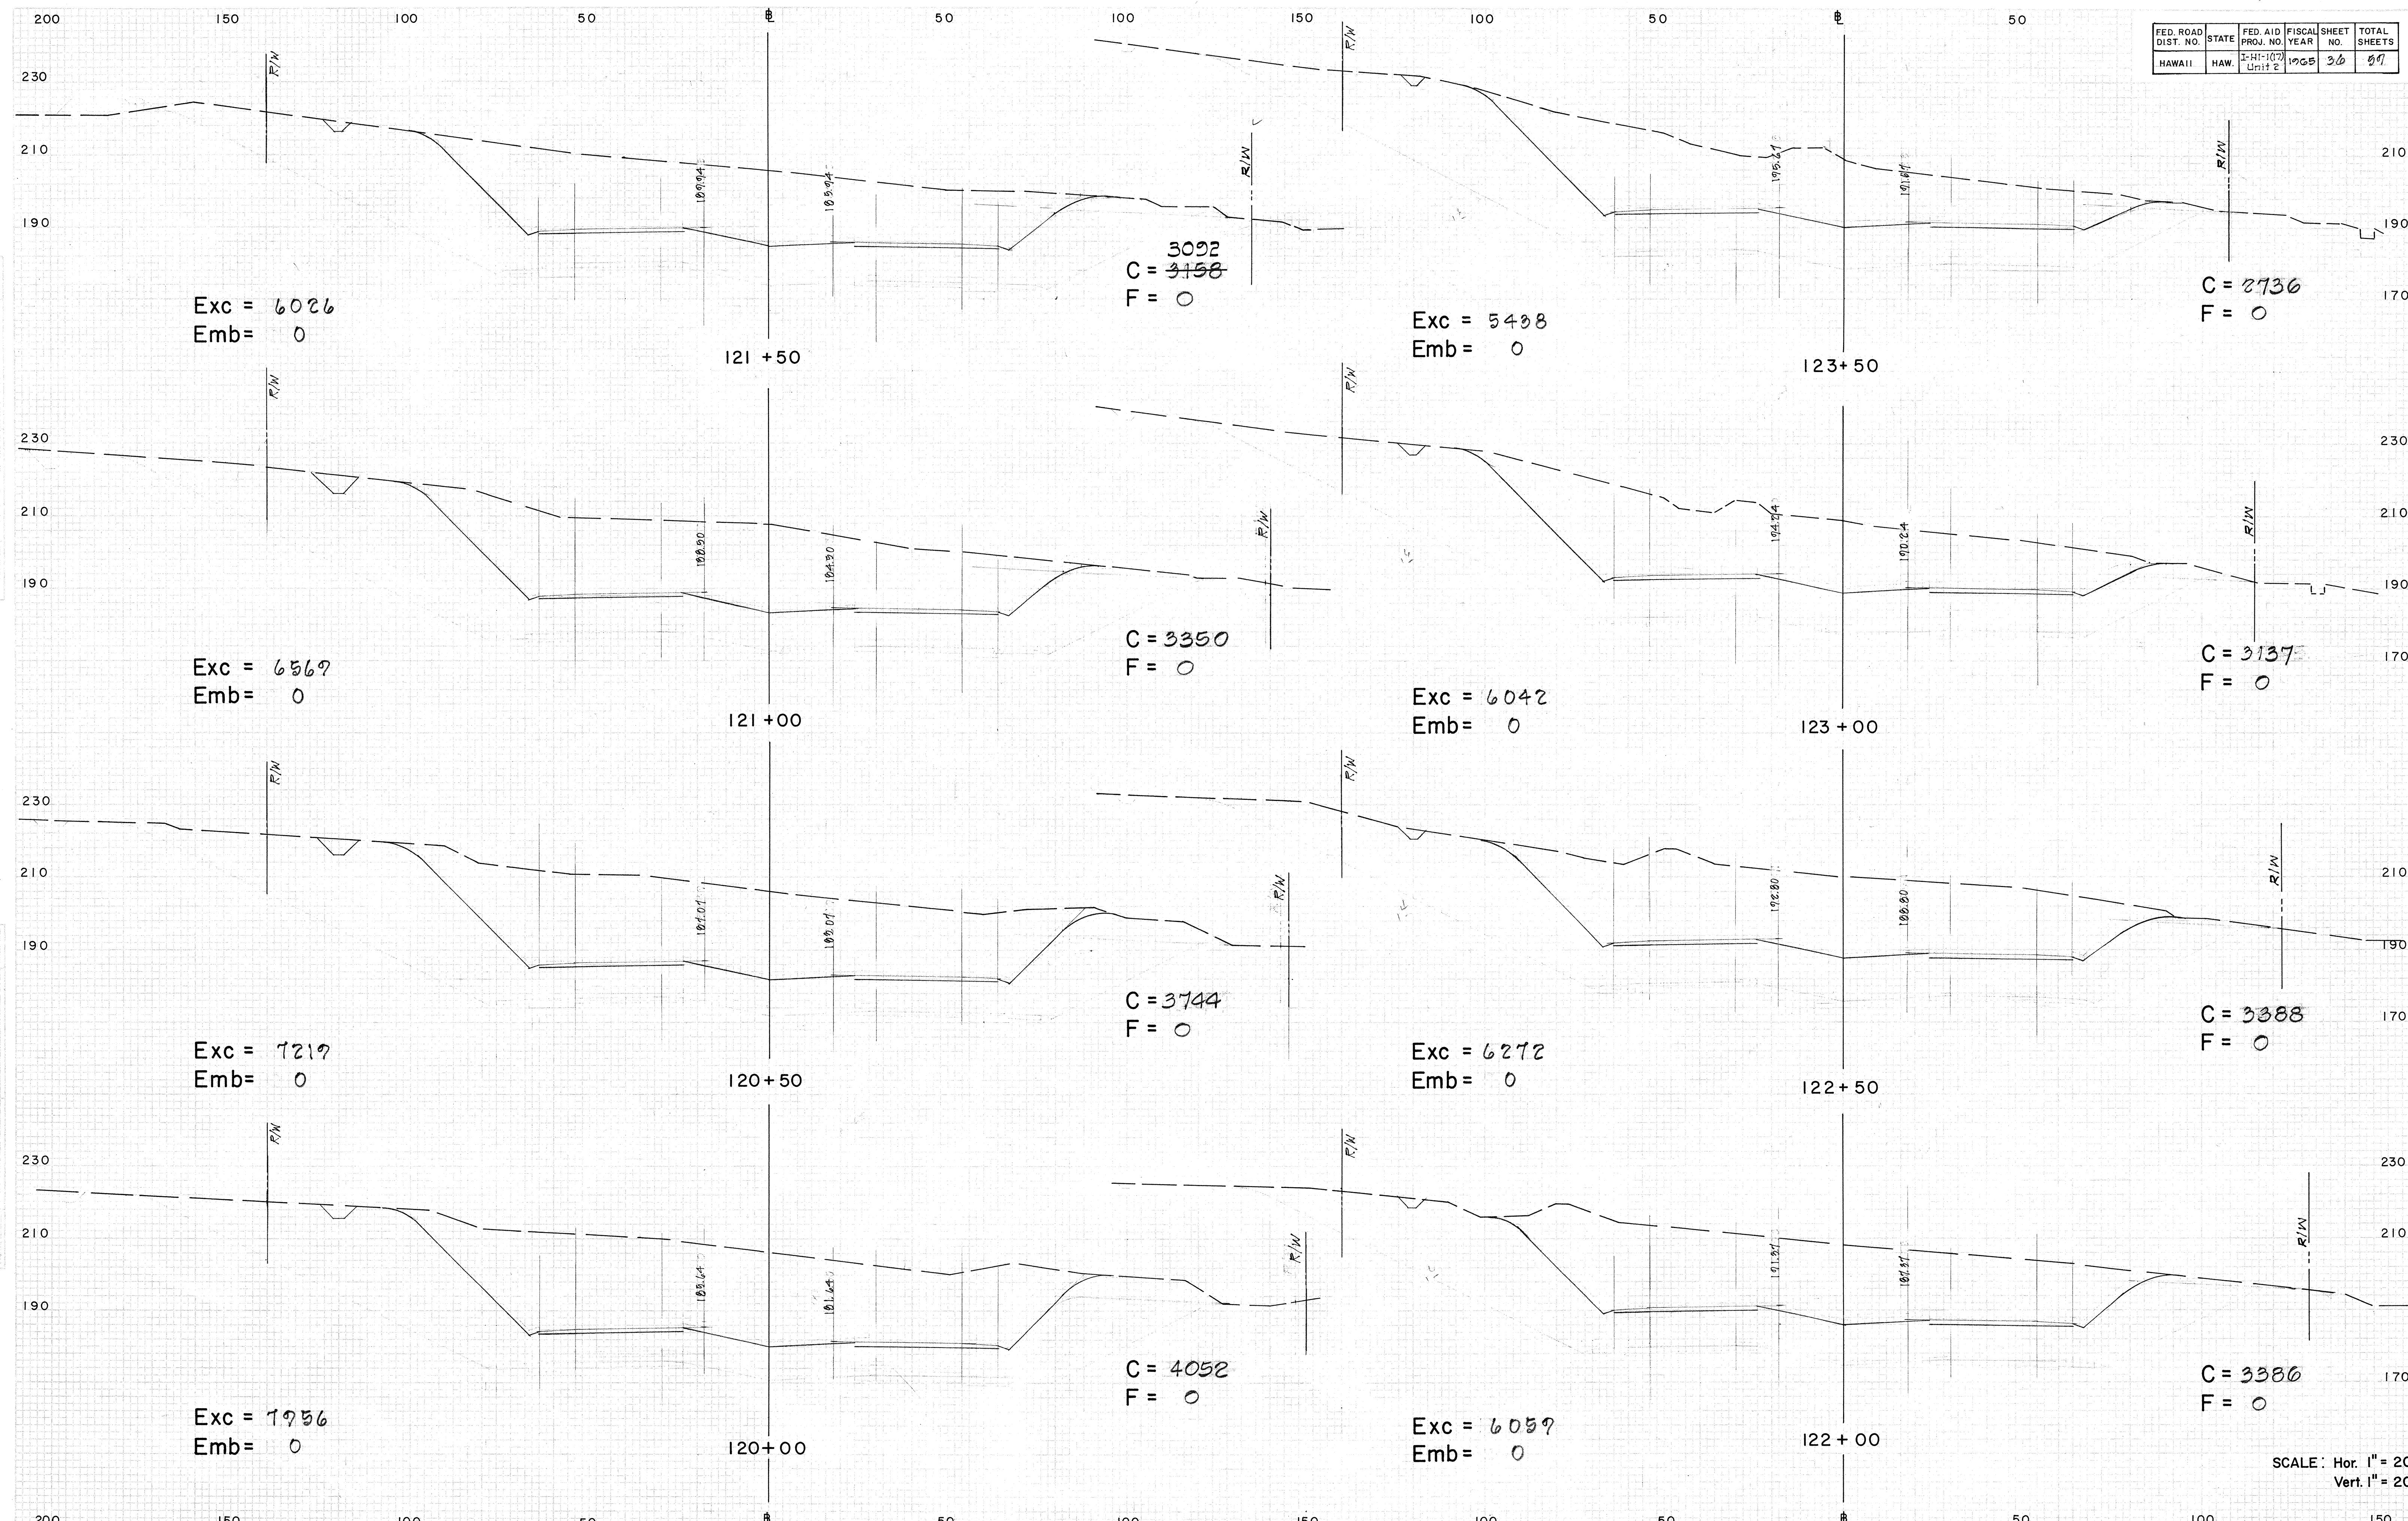

SCALE: Hor. 1" = 20'
Vert. 1" = 20'


FED. ROAD DIST. NO.	STATE	FED. AID PROJ. NO.	FISCAL YEAR	SHEET NO.	TOTAL SHEETS
HAWAII	HAW.	7-HI-1(17) Unit 2	1965	37	59

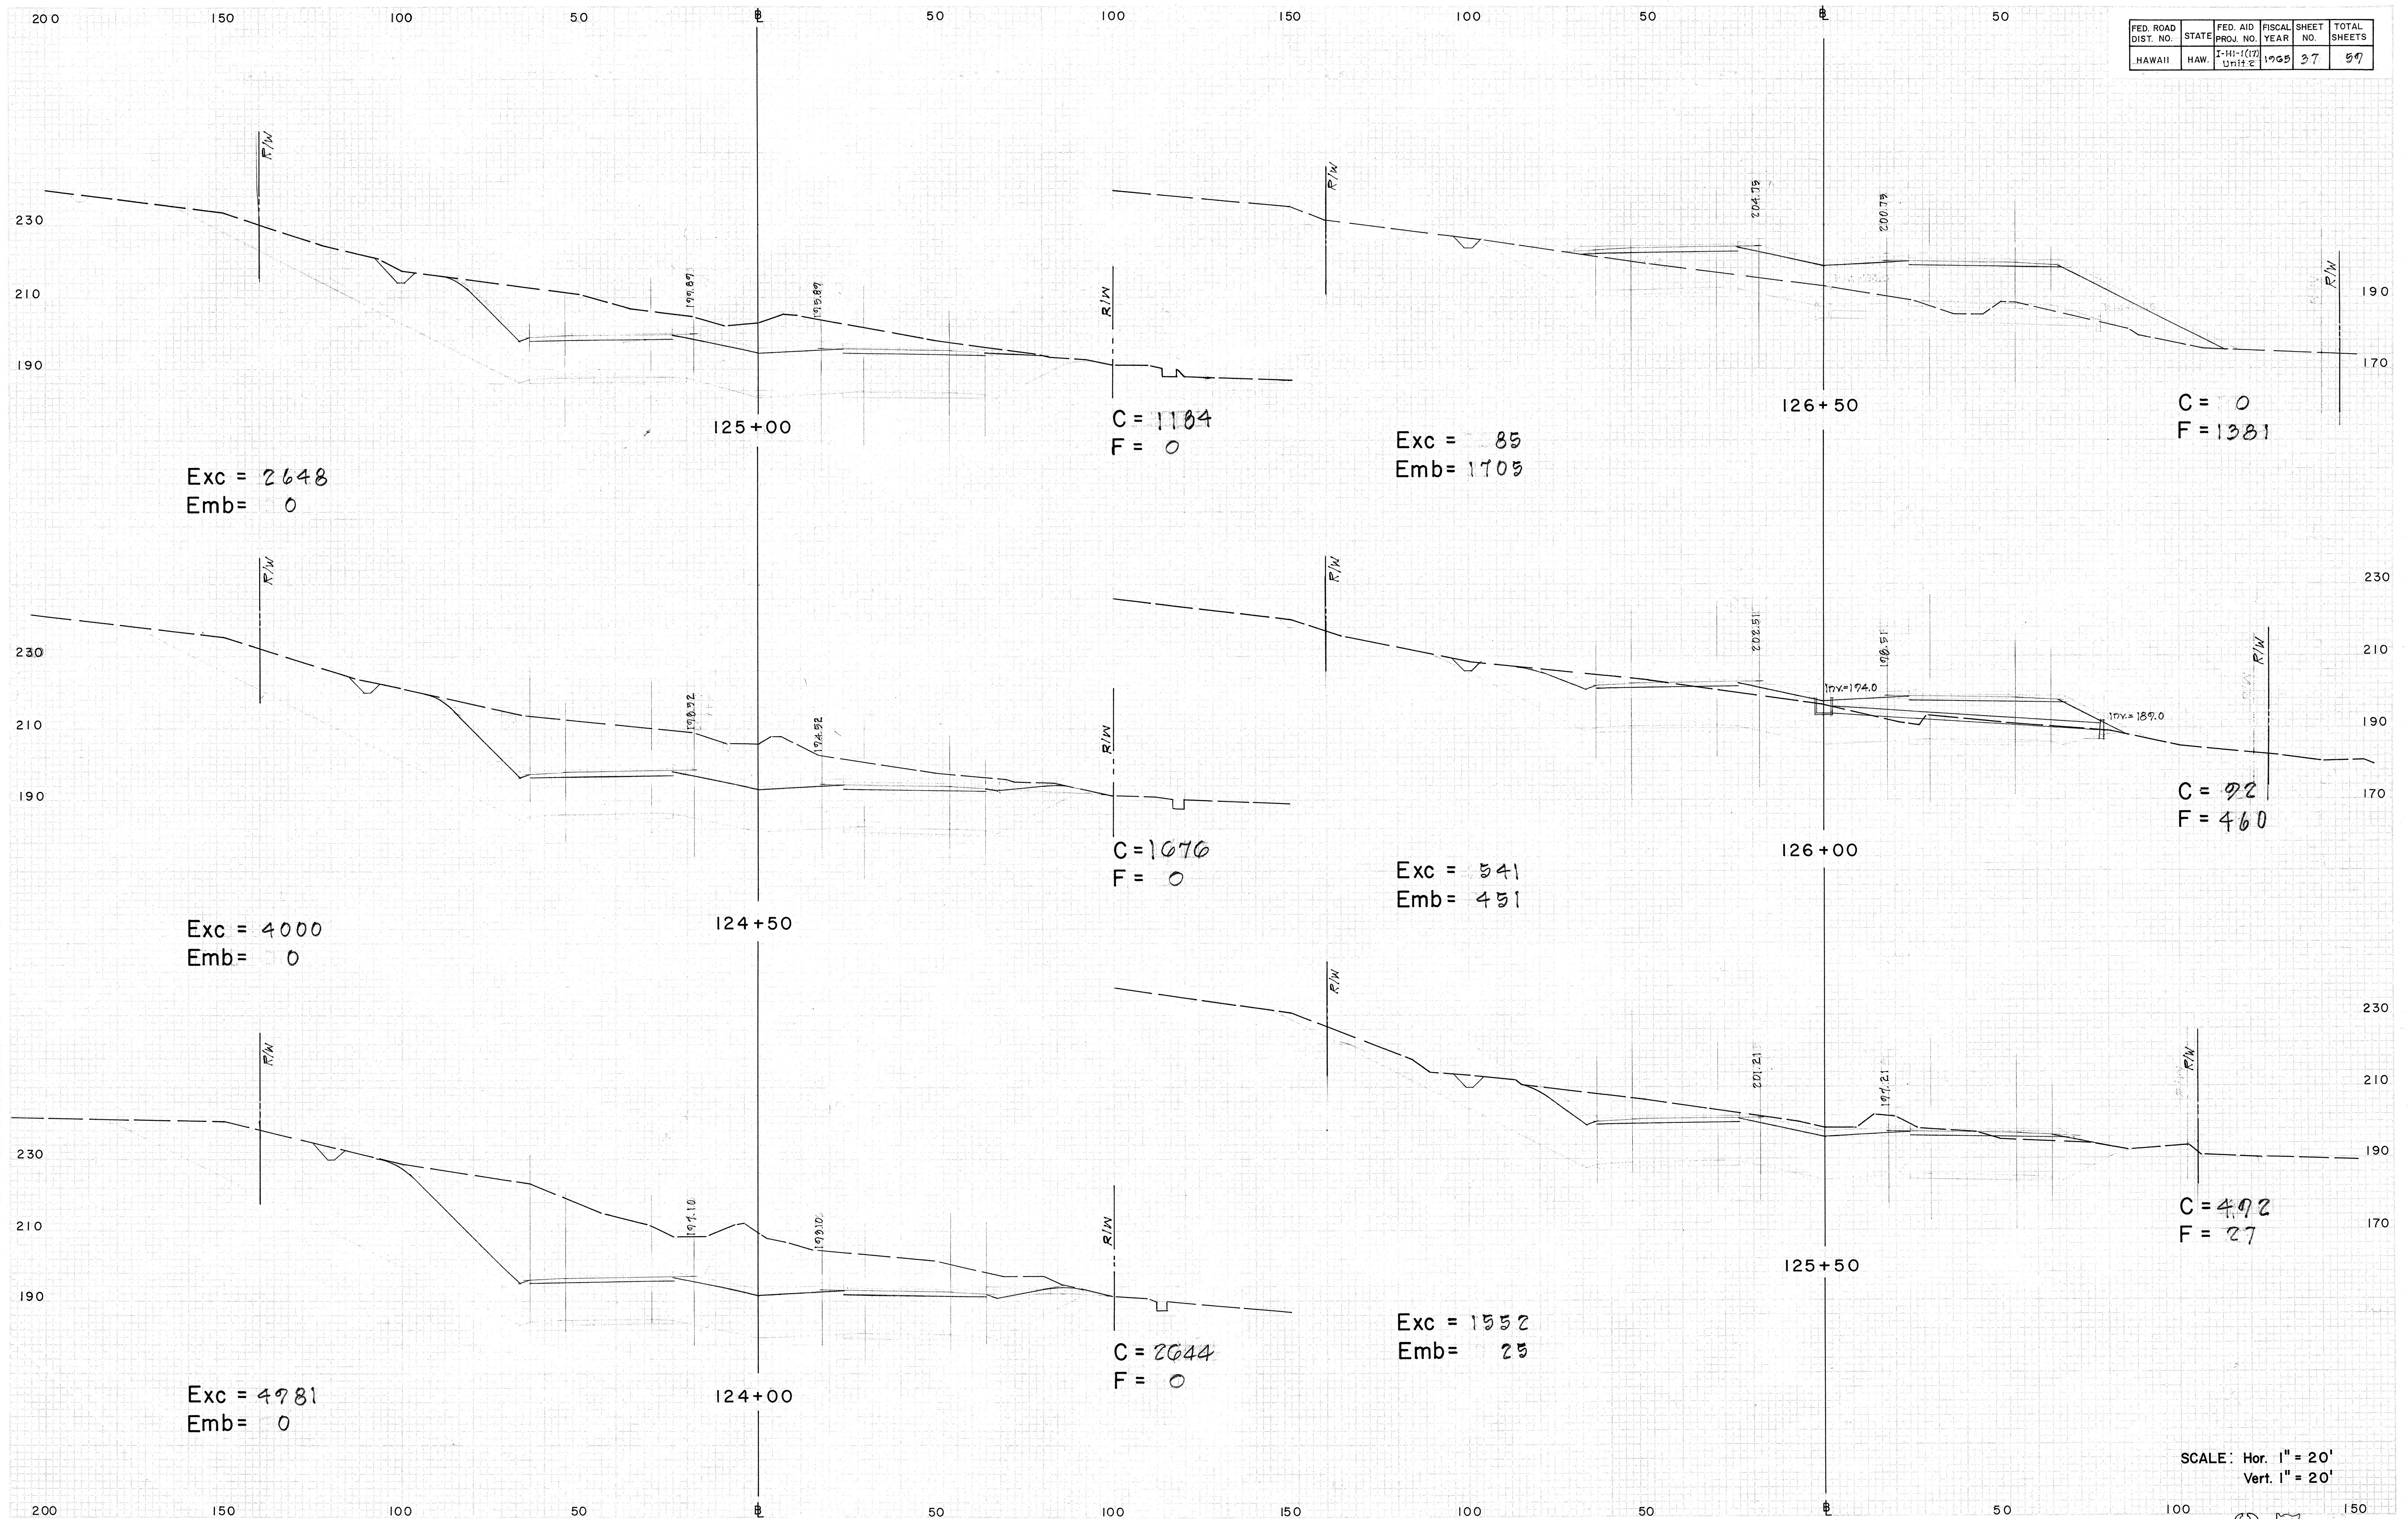

SCALE: Hor. 1" = 20'
Vert. 1" = 20'

FED. ROAD DIST. NO.	STATE	FED. AID PROJ. NO.	FISCAL YEAR	SHEET NO.	TOTAL SHEETS
HAWAII	HAW	1-41-1(17) Unit 2	1965	38	89

Revised: 3/25/65

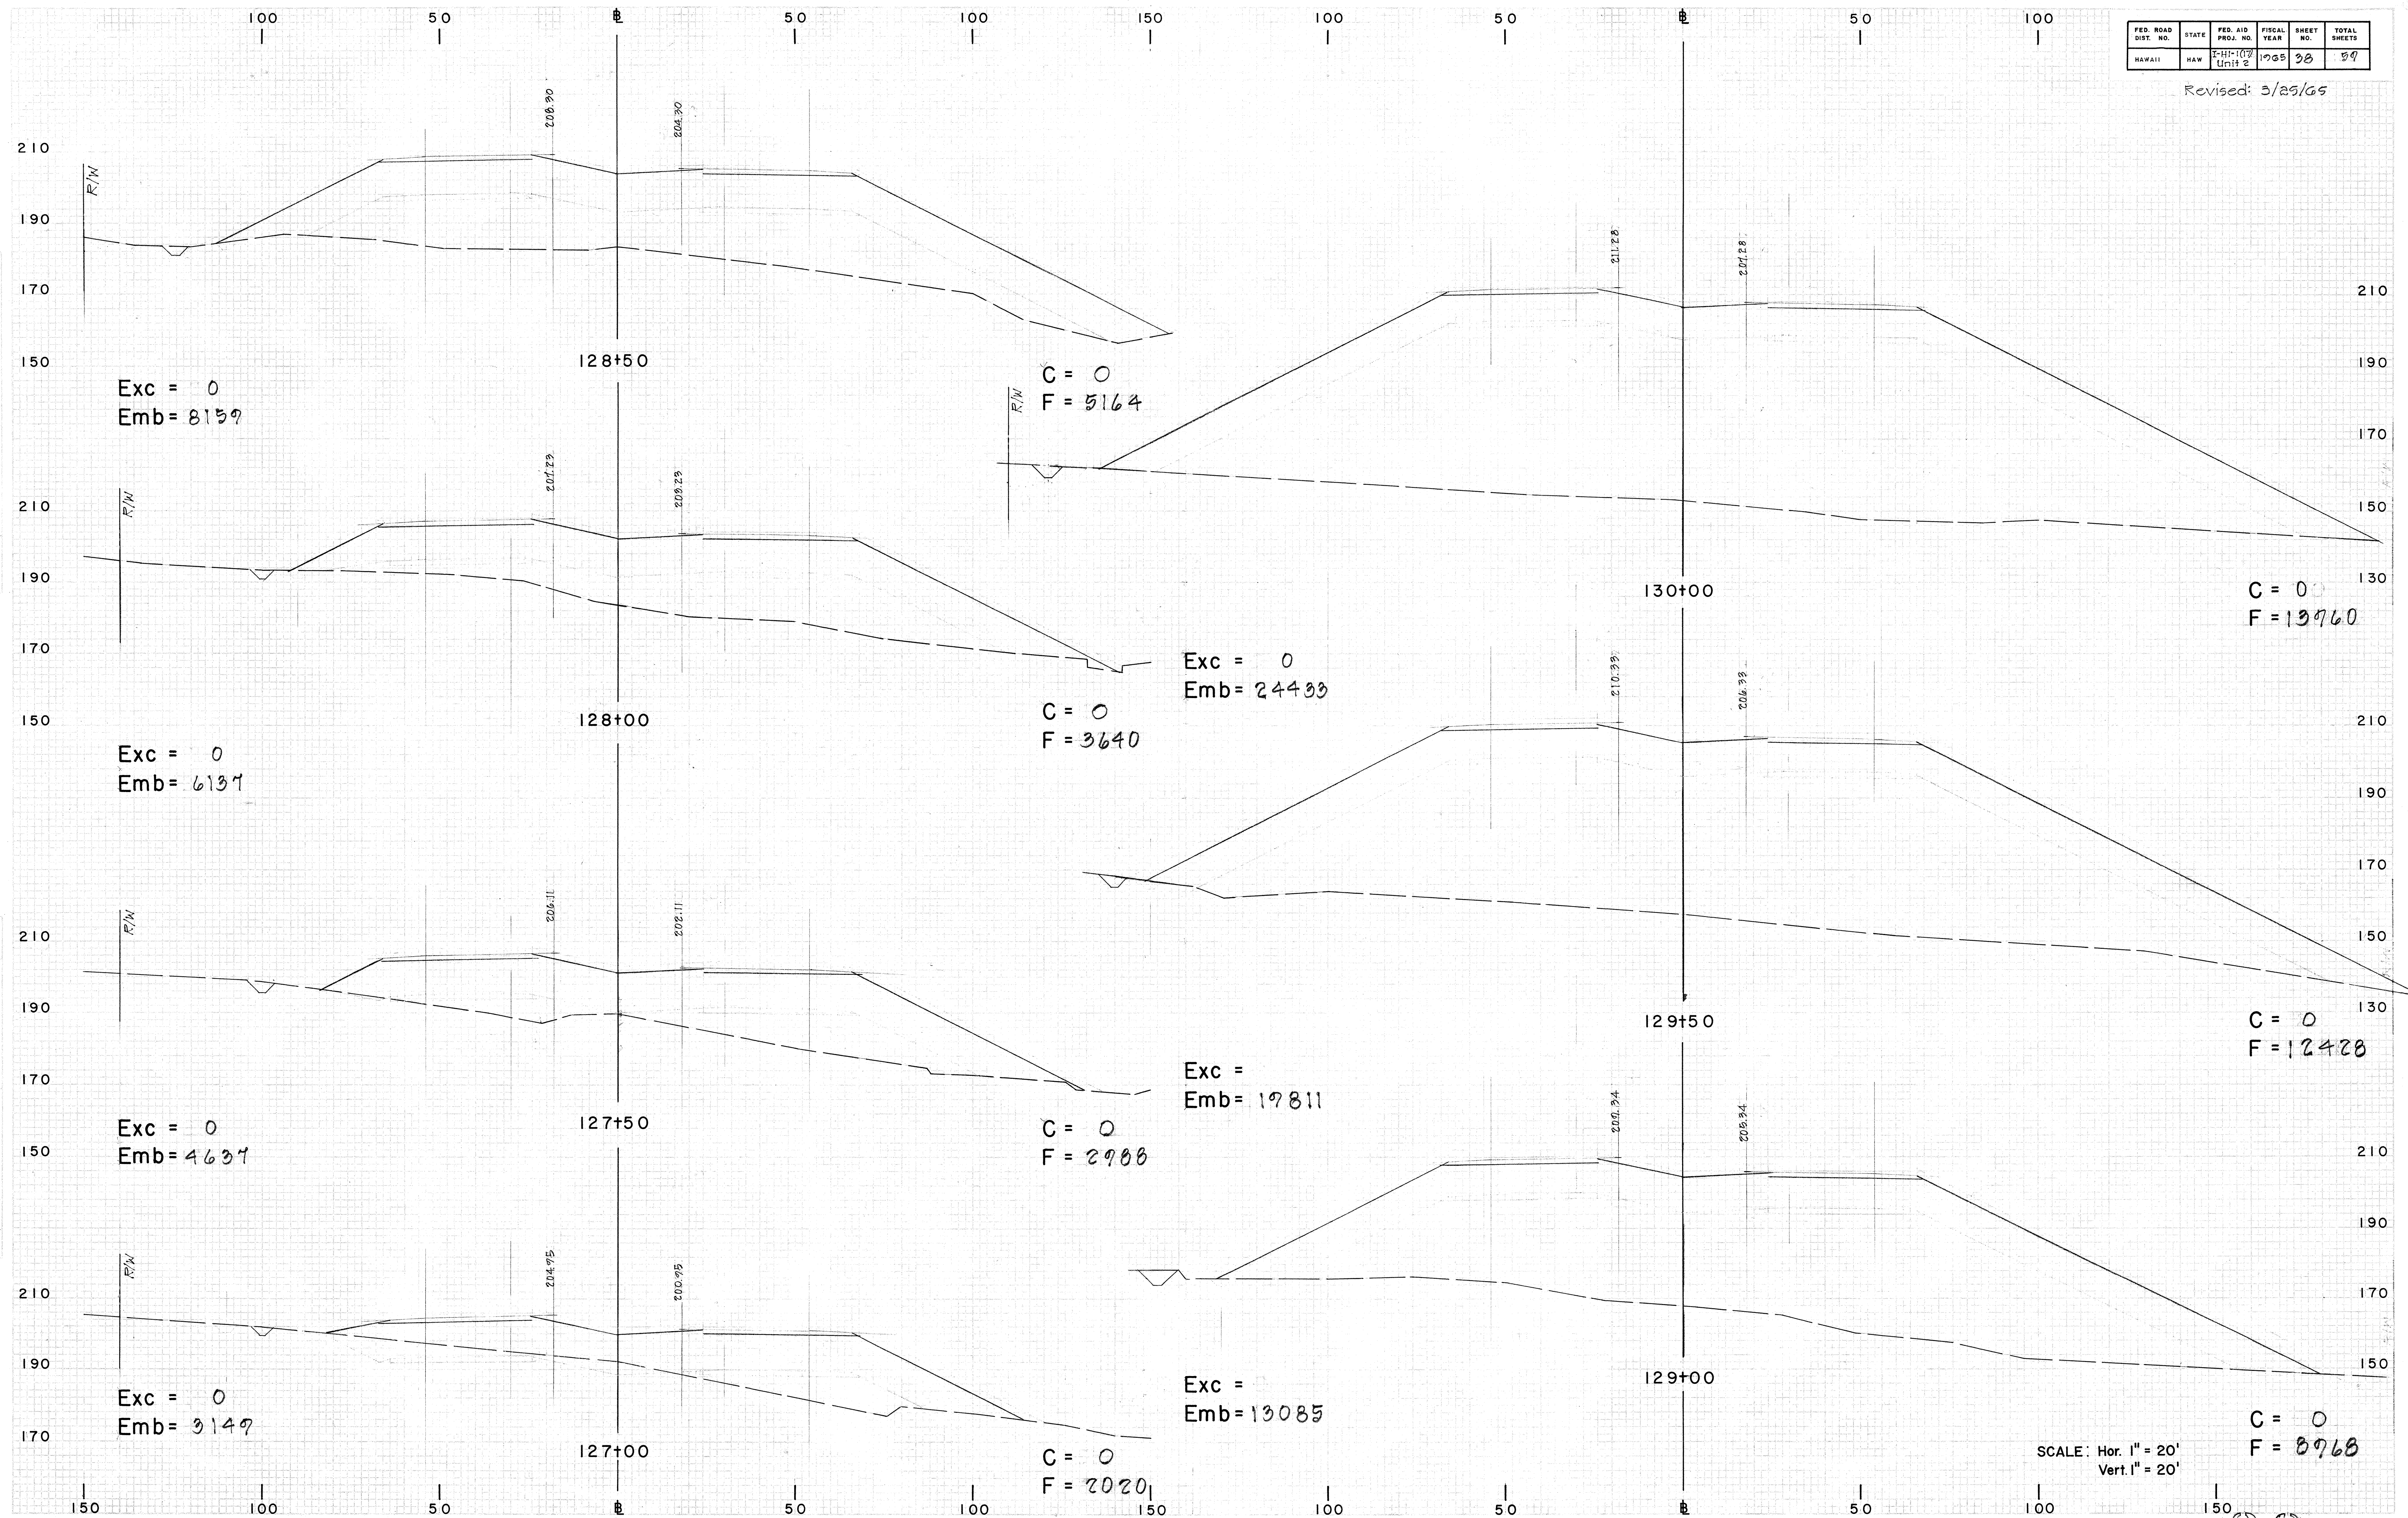


FED. ROAD DIST. NO.	STATE	FED. AID PROJ. NO.	FISCAL YEAR	SHEET NO.	TOTAL SHEETS
HAWAII	HAW	I-41-107 Unit 2	1965	39	59

Revised: 3/25/65

SURVEYED
 PLANNED
 NOTED BOOK
 NO.

SURVEYED
 PLANNED
 NOTED BOOK
 NO.

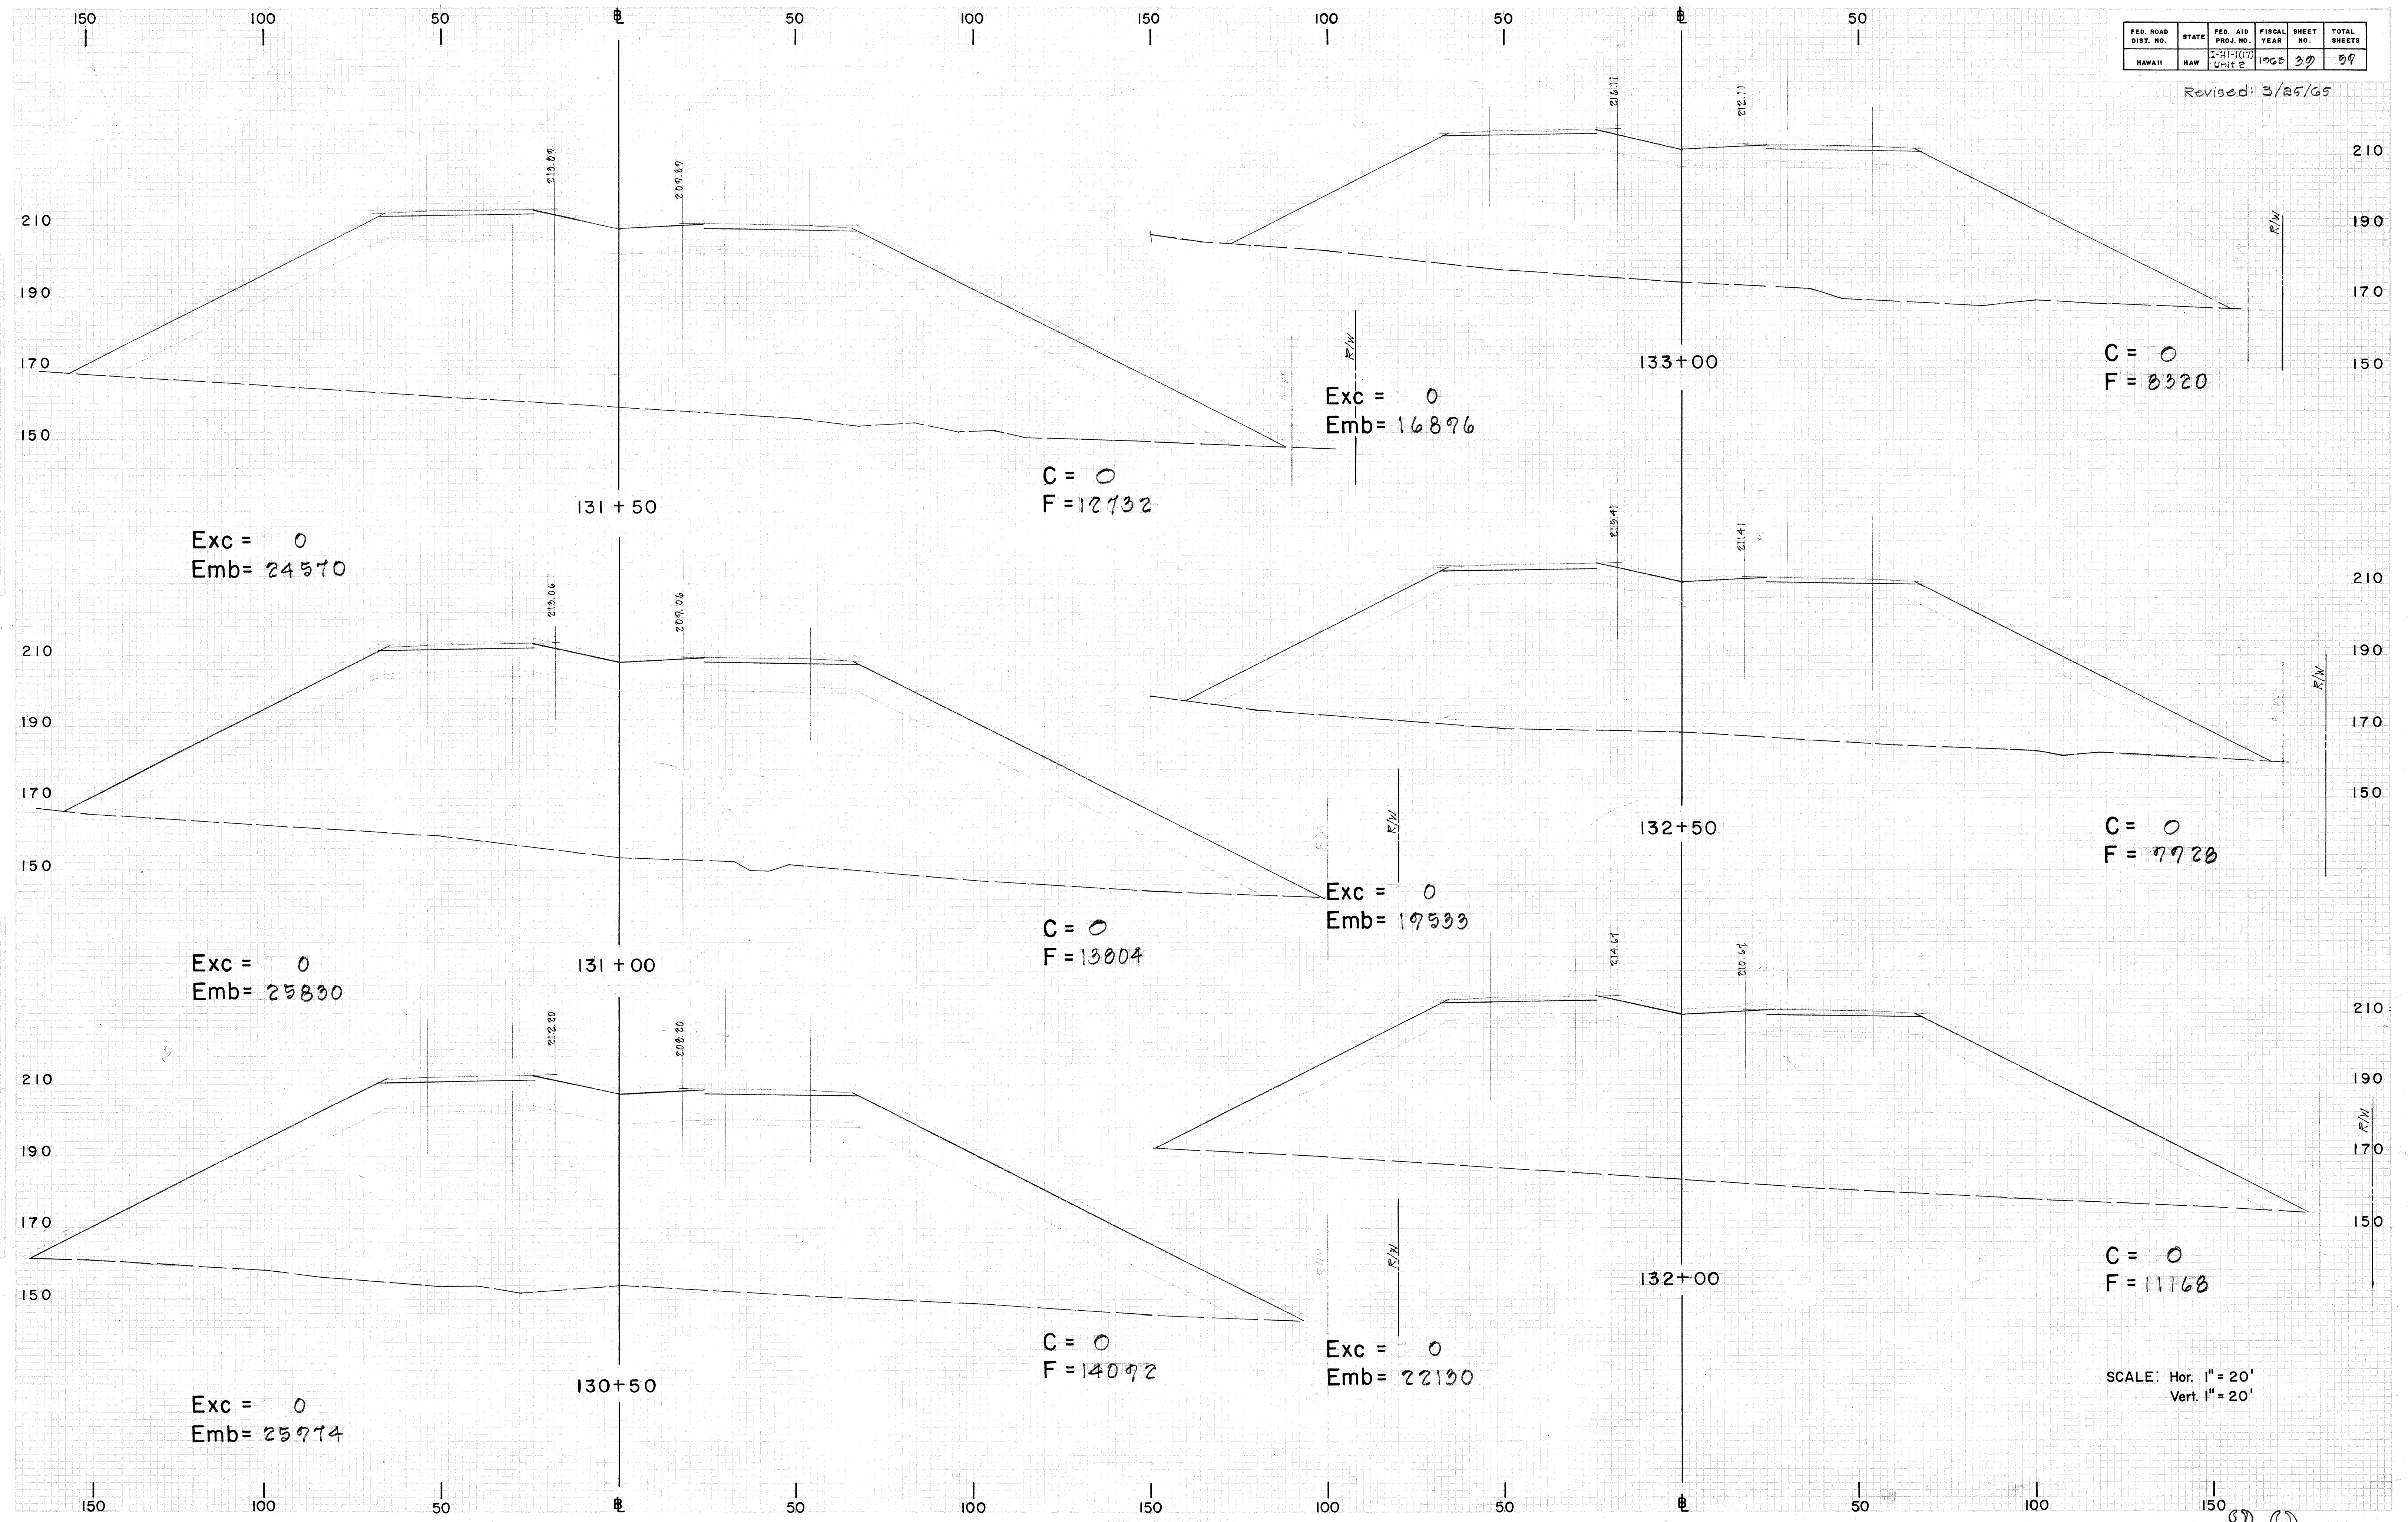


SCALE: Hor. 1" = 20'
 Vert. 1" = 20'

39


FED. ROAD DIST. NO.	STATE	FED. AID PROJ. NO.	FISCAL YEAR	SHEET NO.	TOTAL SHEETS
HAWAII	HAW	I-H-1(02) Unit 2	1965	40	99

Revised: 3/25/65

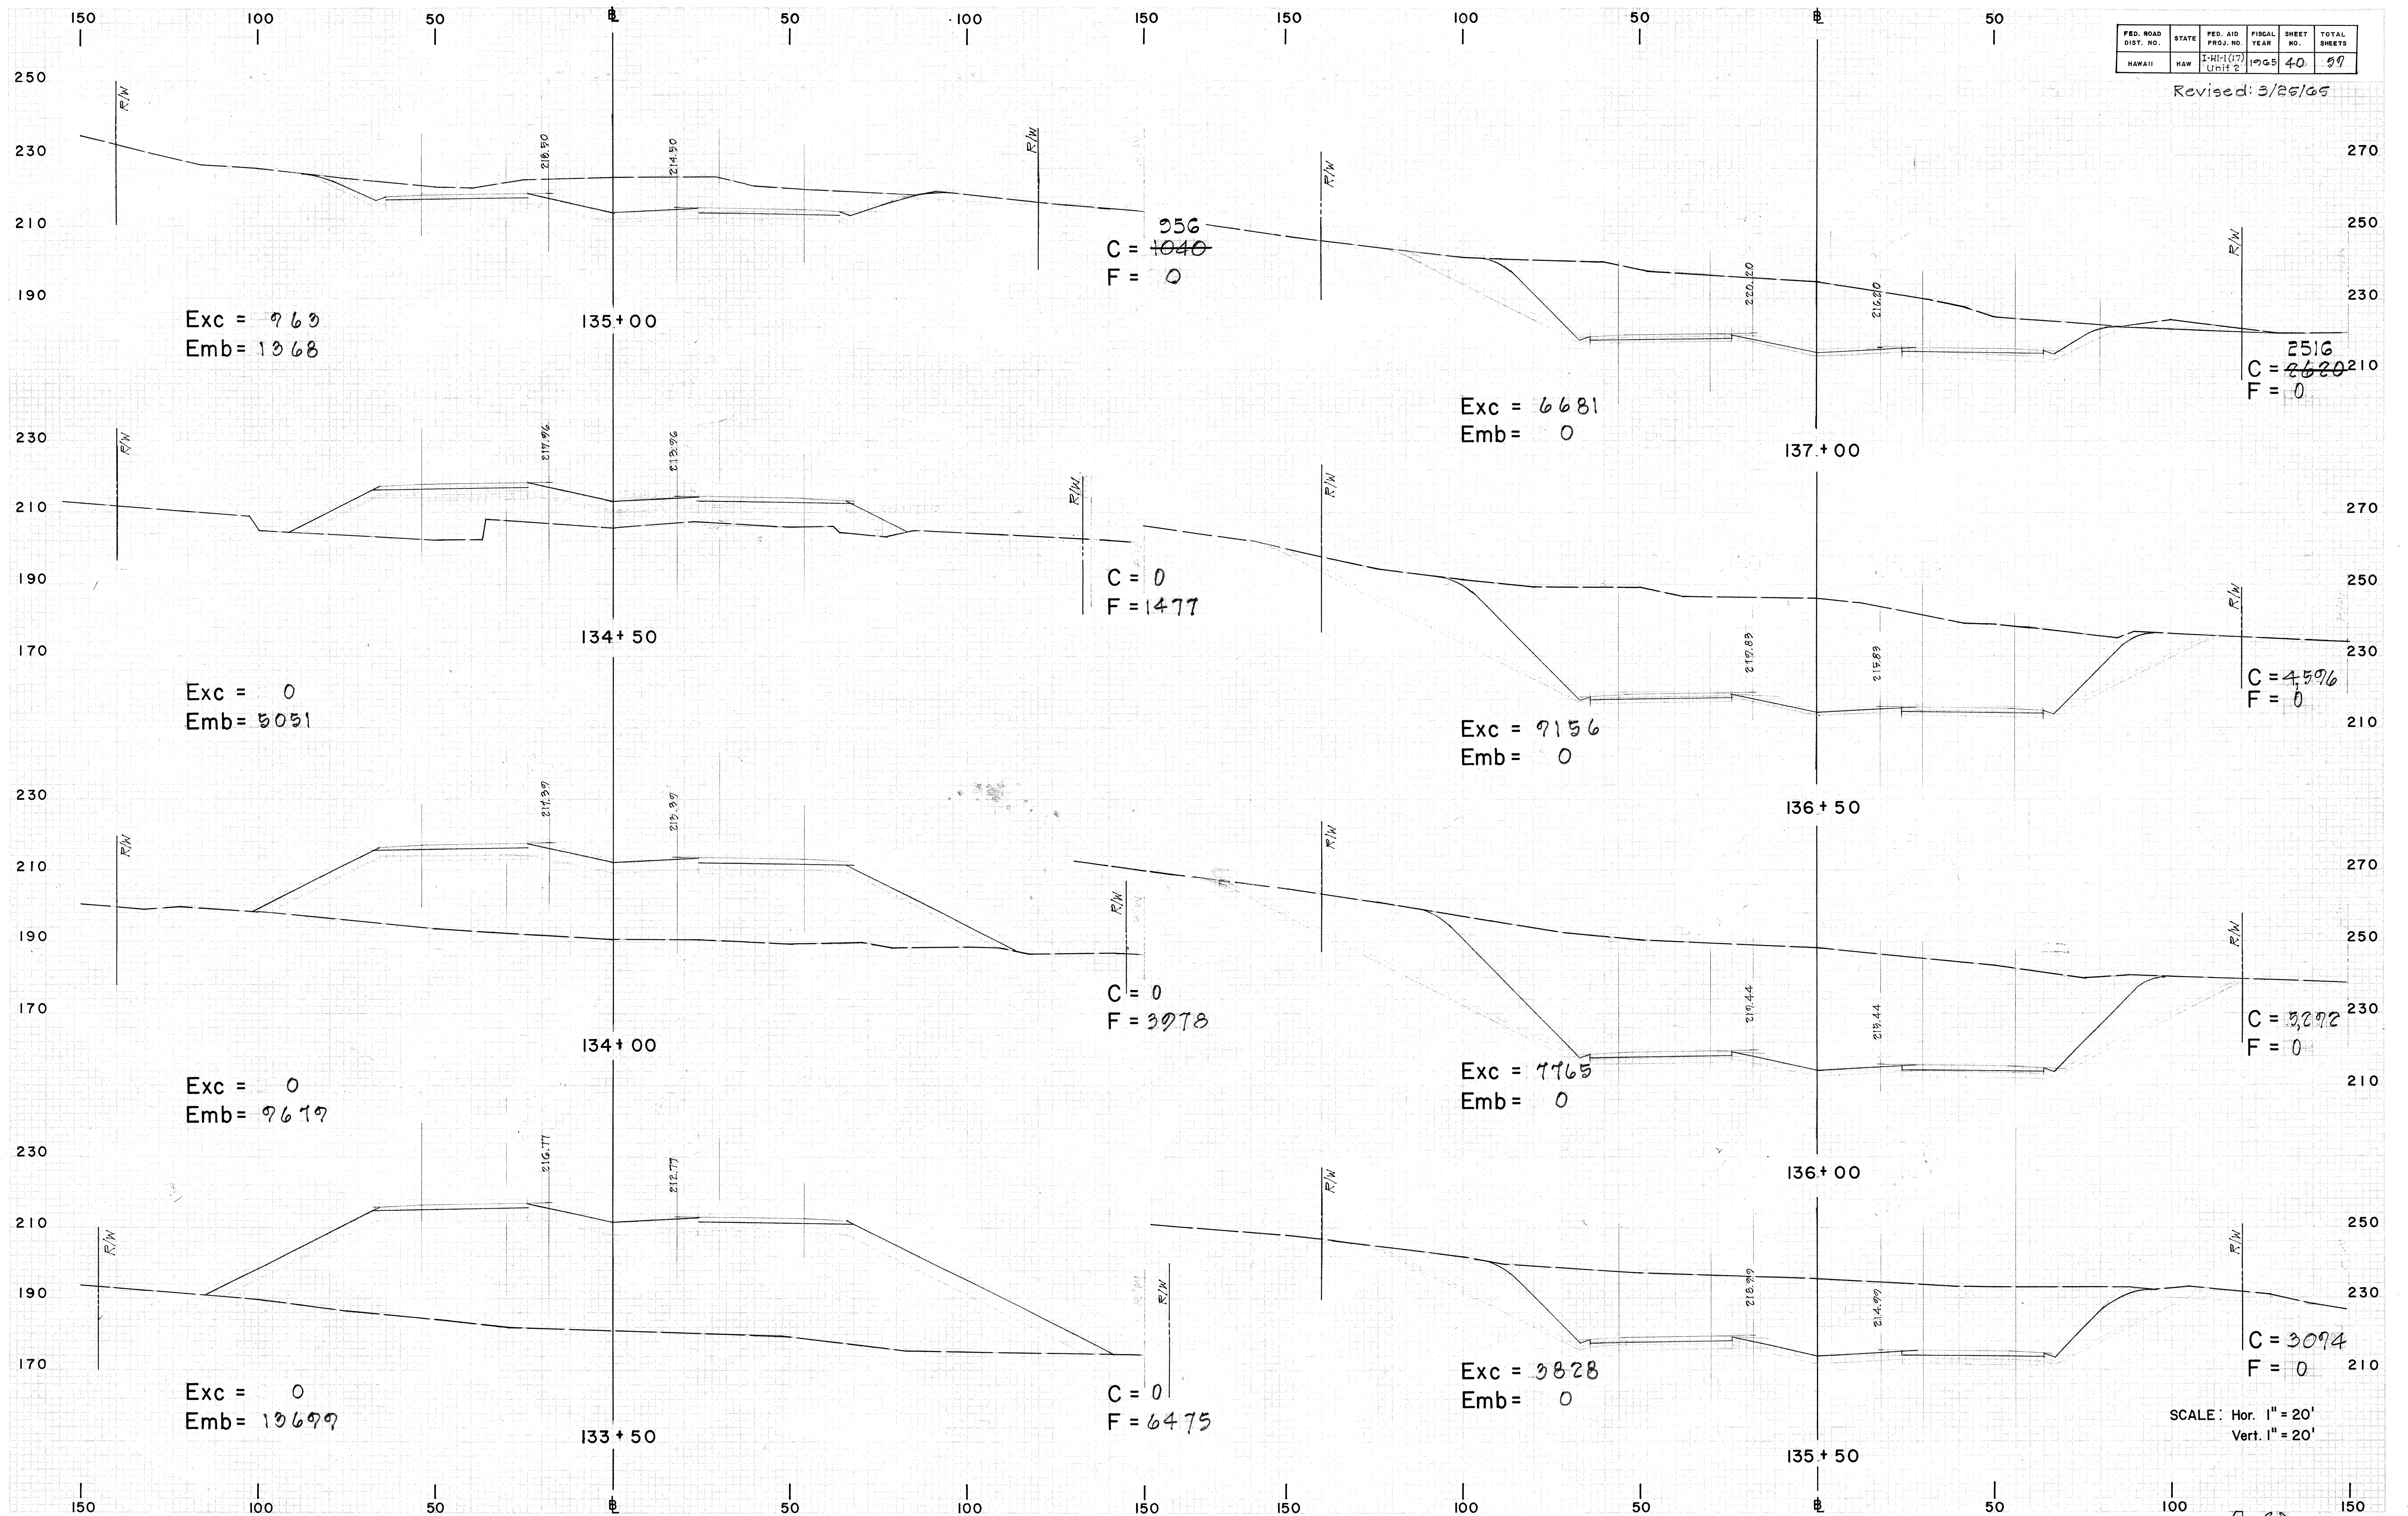


SCALE: Hor. 1" = 20'
Vert. 1" = 20'

FED. ROAD DIST. NO.	STATE	FED. AID PROJ. NO.	FISCAL YEAR	SHEET NO.	TOTAL SHEETS
HAWAII	HAW	1-H-1(17) Unit 2	1965	41	99

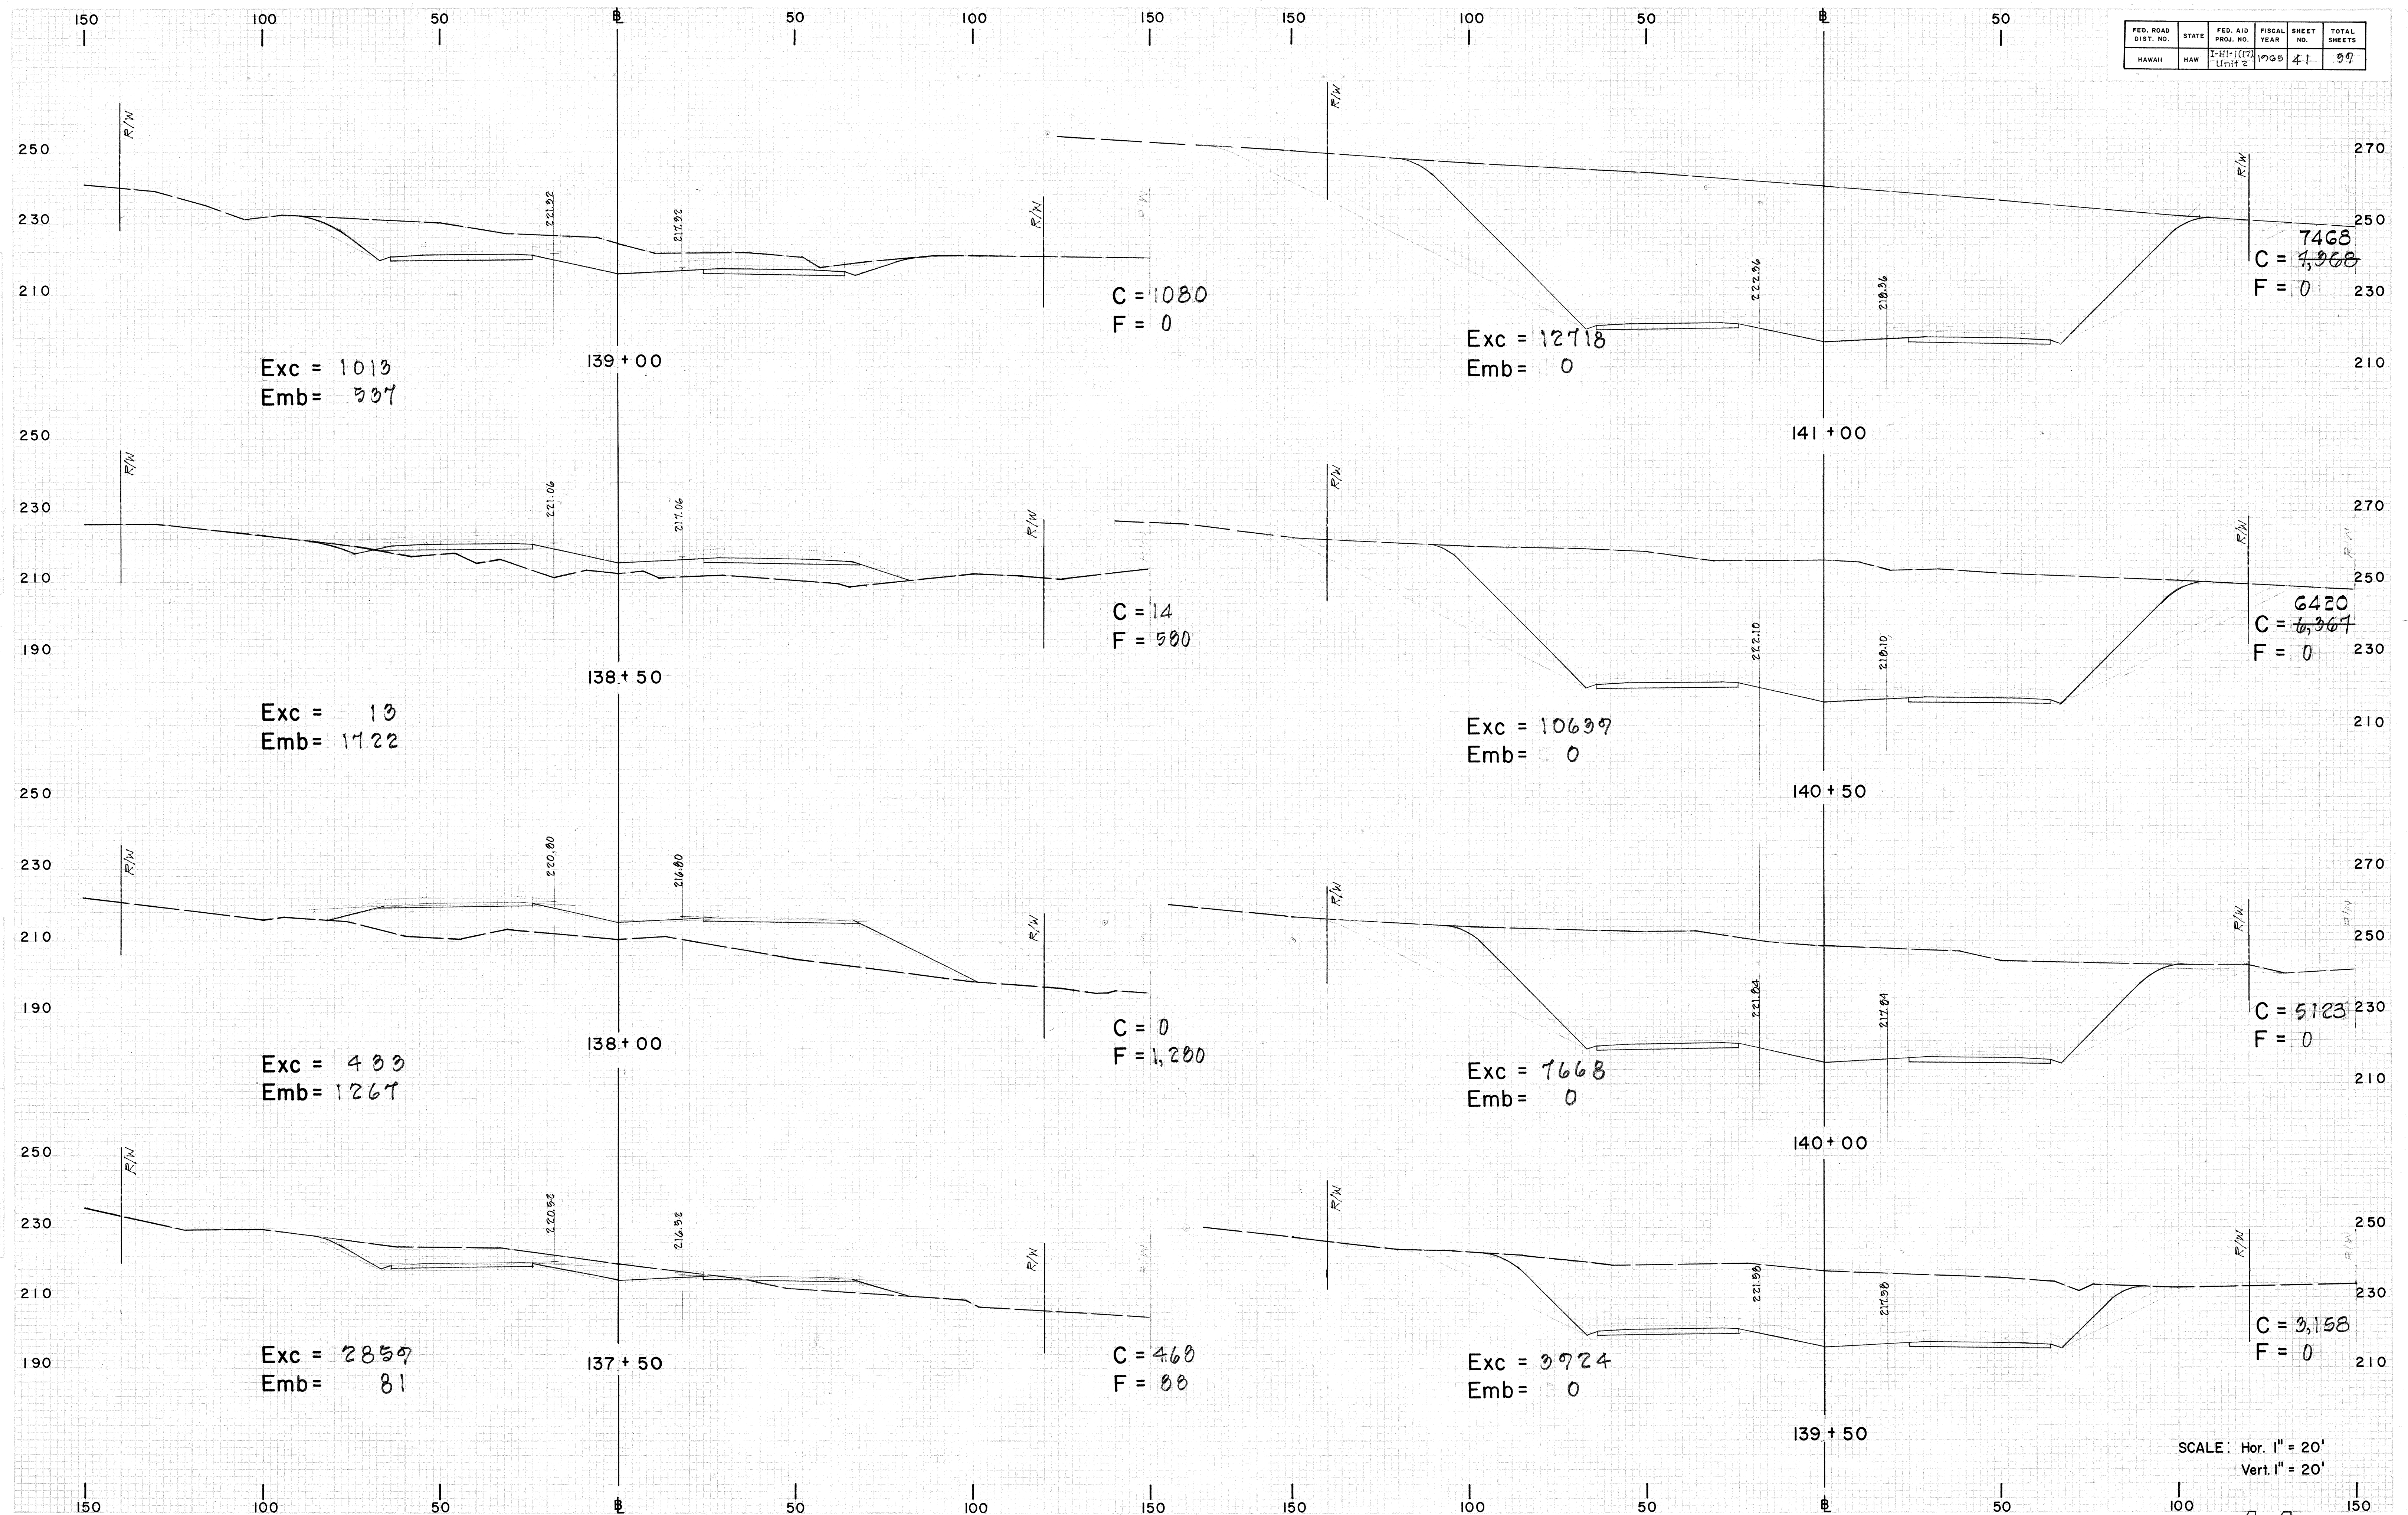


SCALE: Hor. 1" = 20'
Vert. 1" = 20'

FED. ROAD DIST. NO.	STATE	FED. AID PROJ. NO.	FISCAL YEAR	SHEET NO.	TOTAL SHEETS
HAWAII	HAW	I-81-1(17) Unit 2	1963	42	99

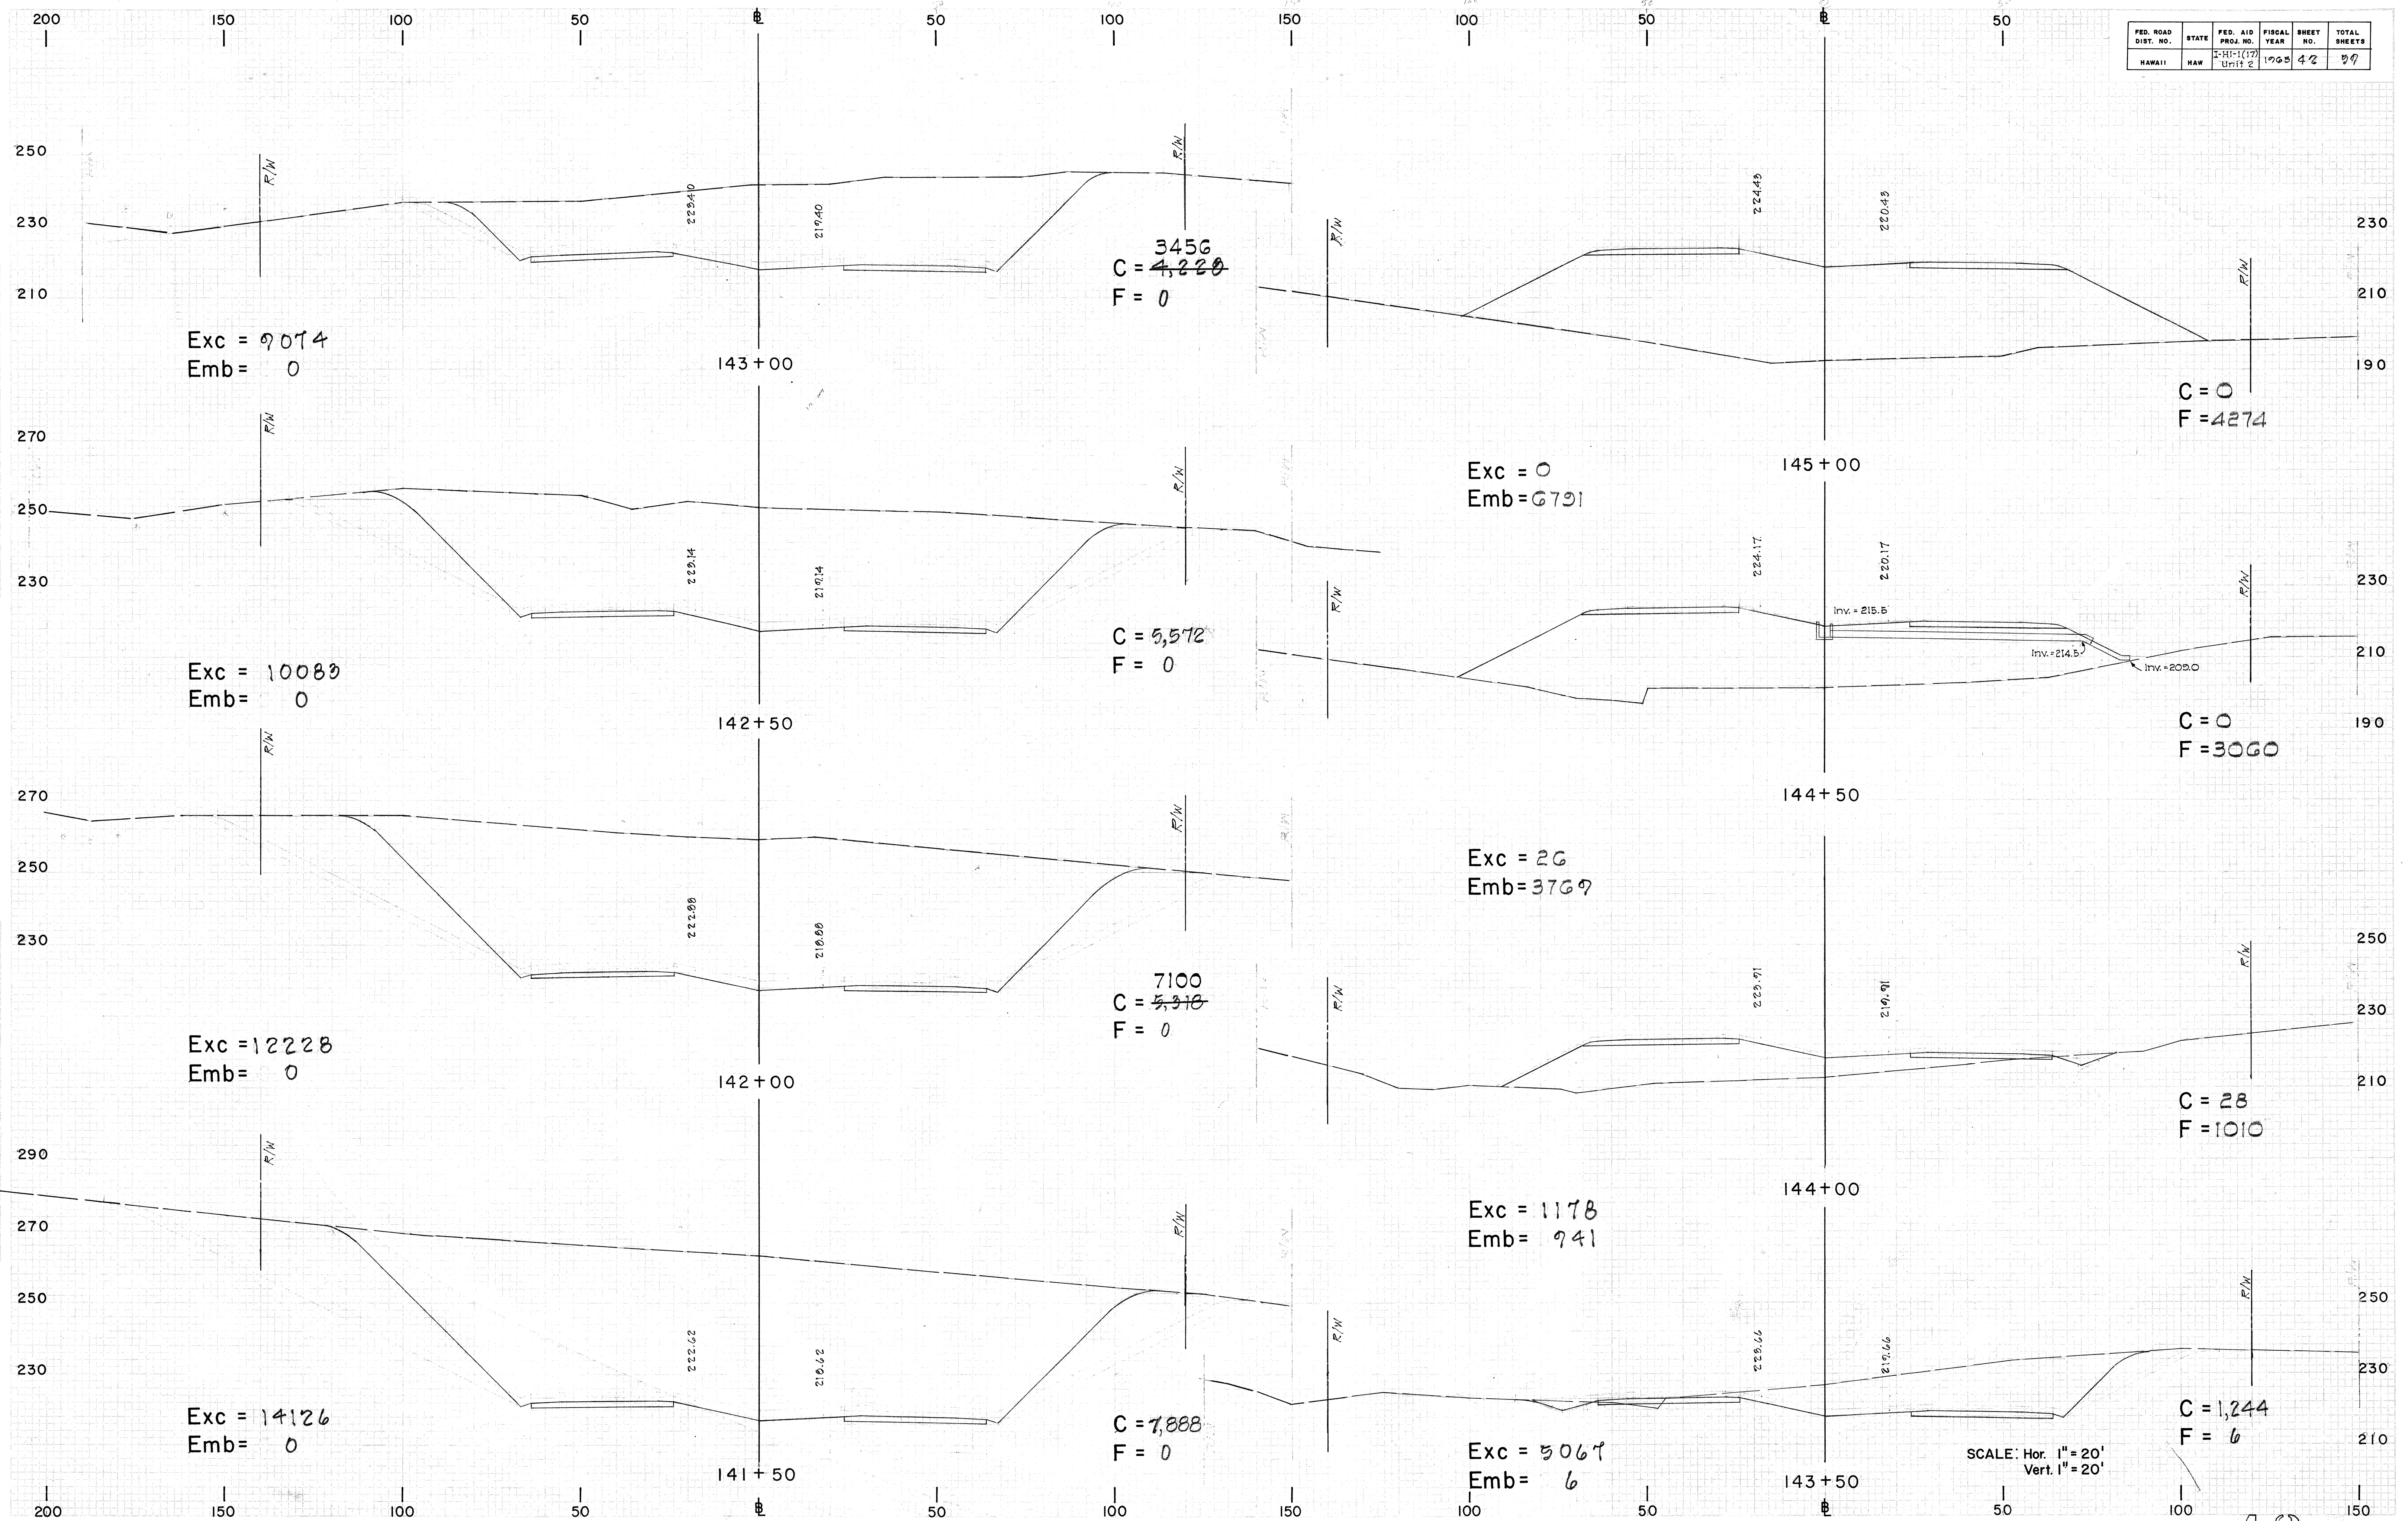


FED. ROAD DIST. NO.	STATE	FED. AID PROJ. NO.	FISCAL YEAR	SHEET NO.	TOTAL SHEETS
HAWAII	HAW	100-100	1965	43	87

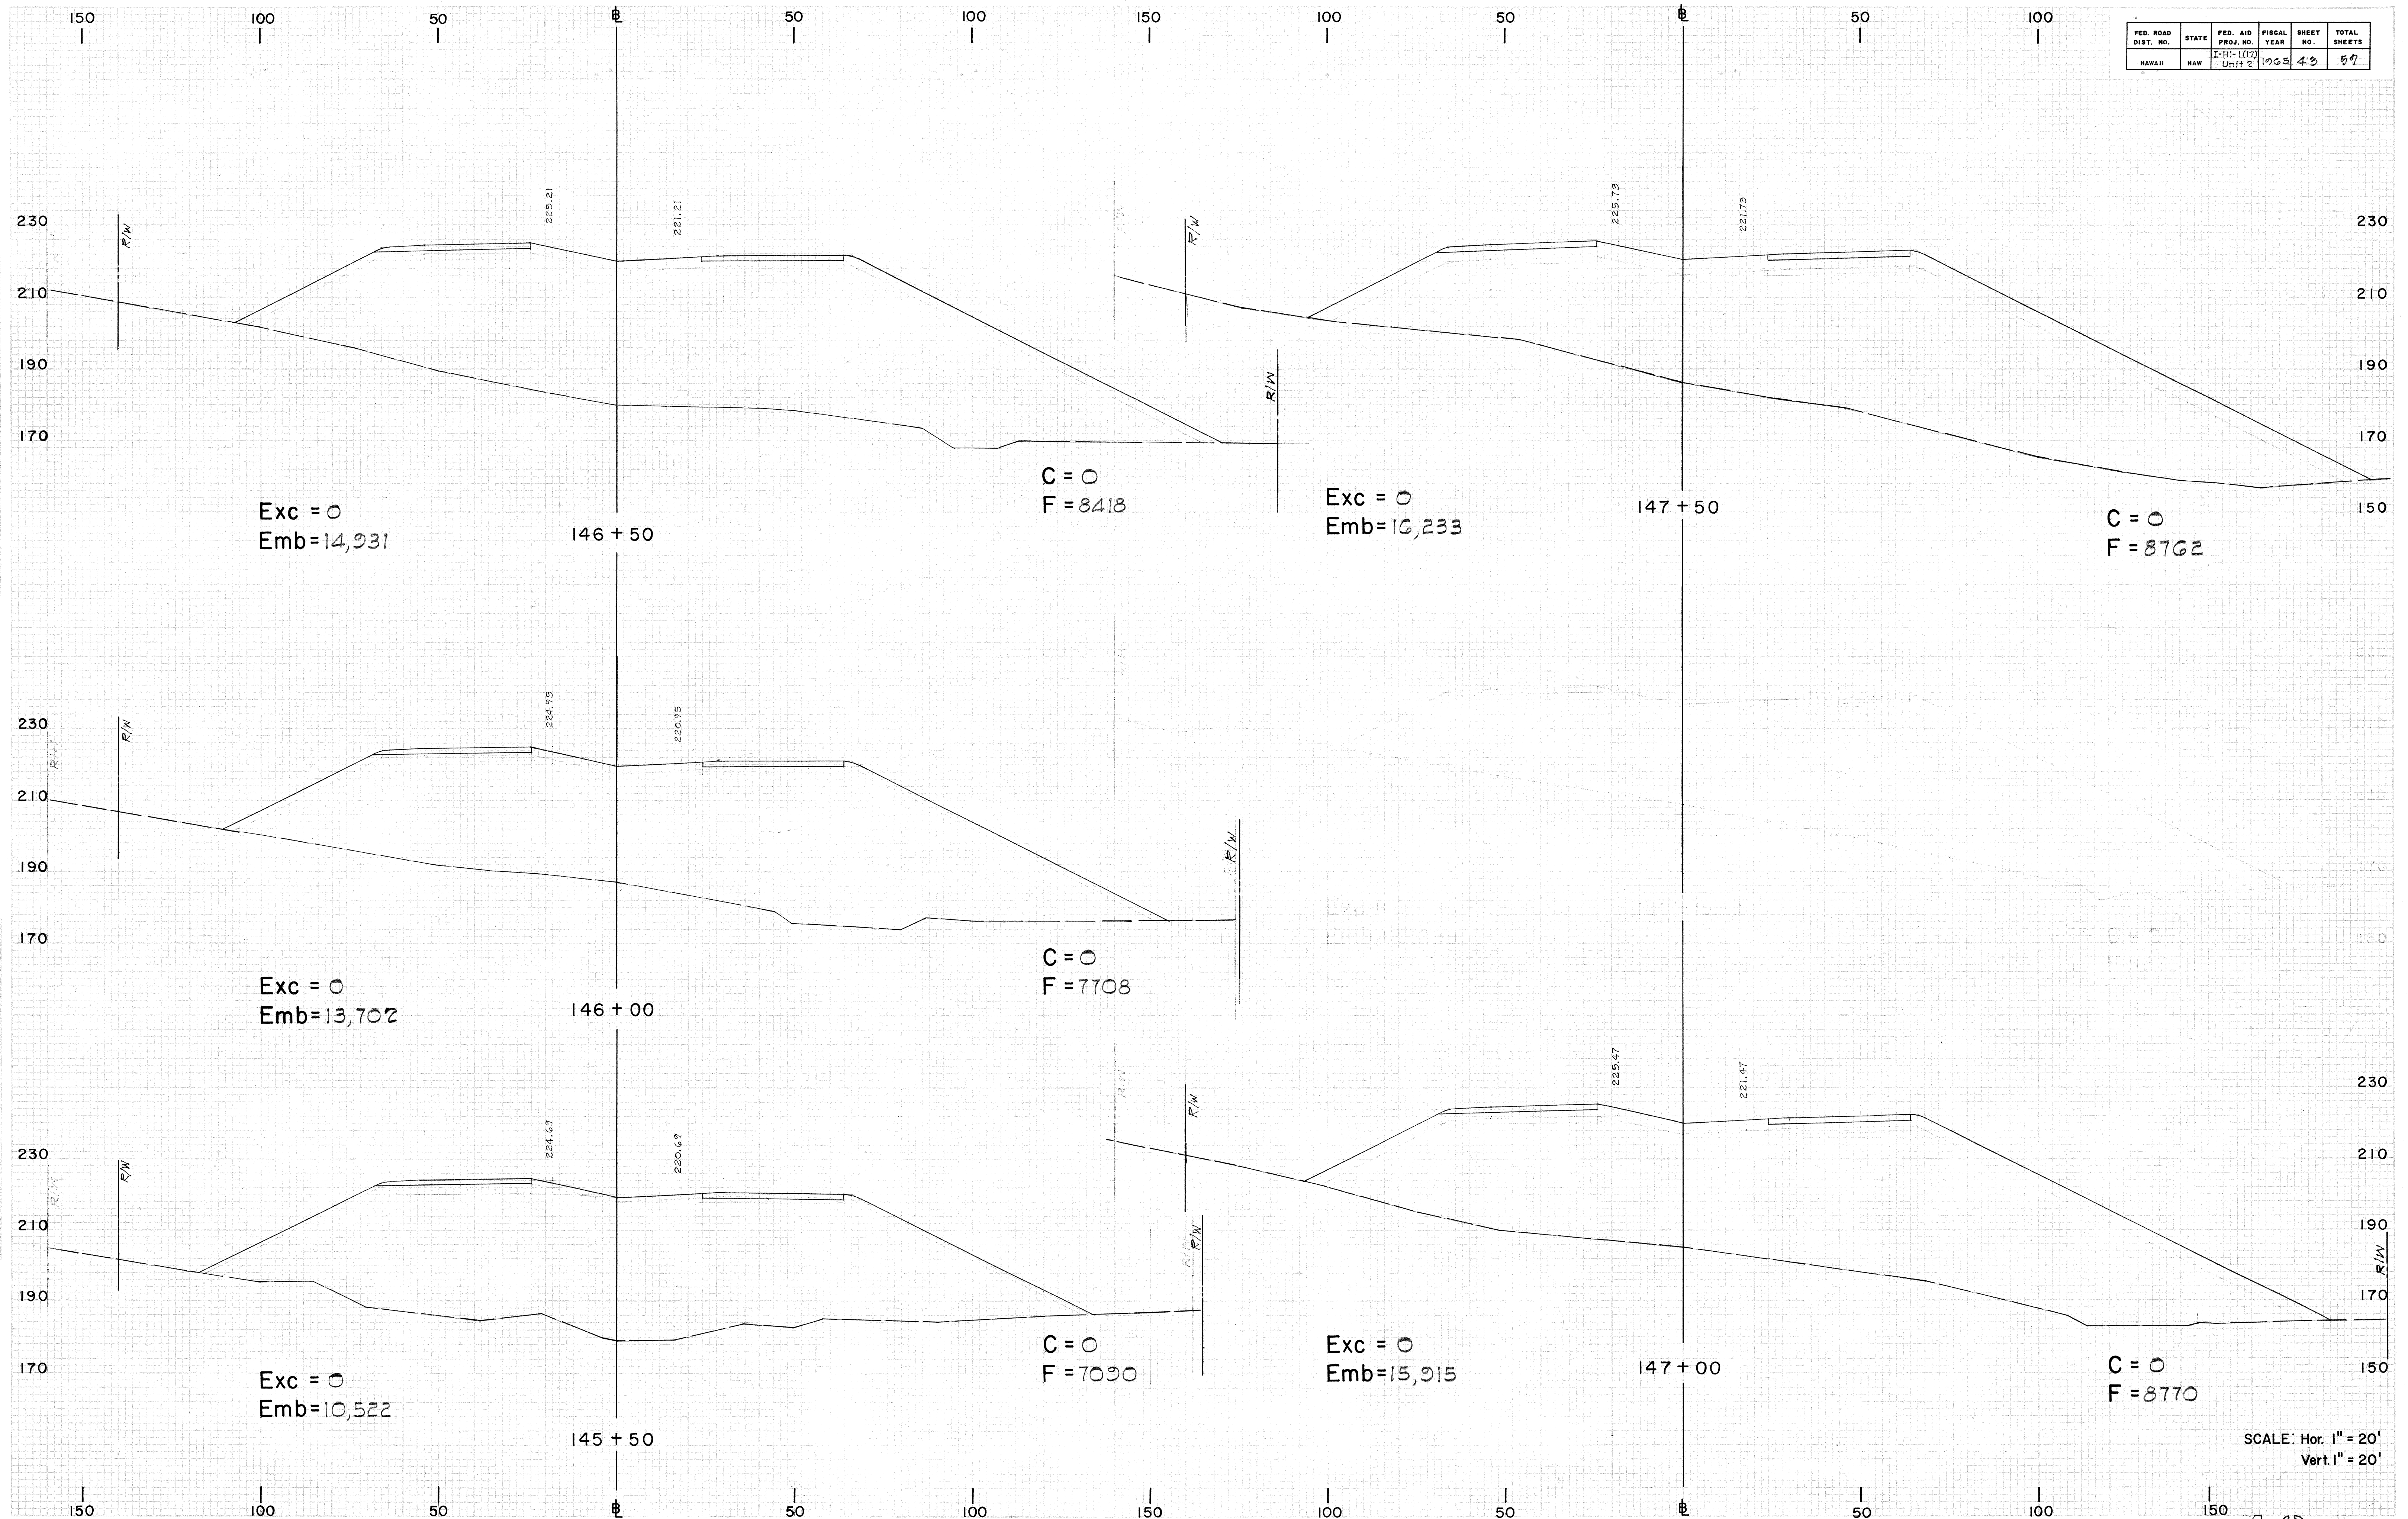


FED. ROAD DIST. NO.	STATE	FED. AID PROJ. NO.	FISCAL YEAR	SHEET NO.	TOTAL SHEETS
HAWAII	HAW	1-11-107	1965	44	99

DATE	BY
REVISION	BY
REVISION	BY
REVISION	BY
REVISION	BY

DATE	BY
REVISION	BY
REVISION	BY
REVISION	BY
REVISION	BY

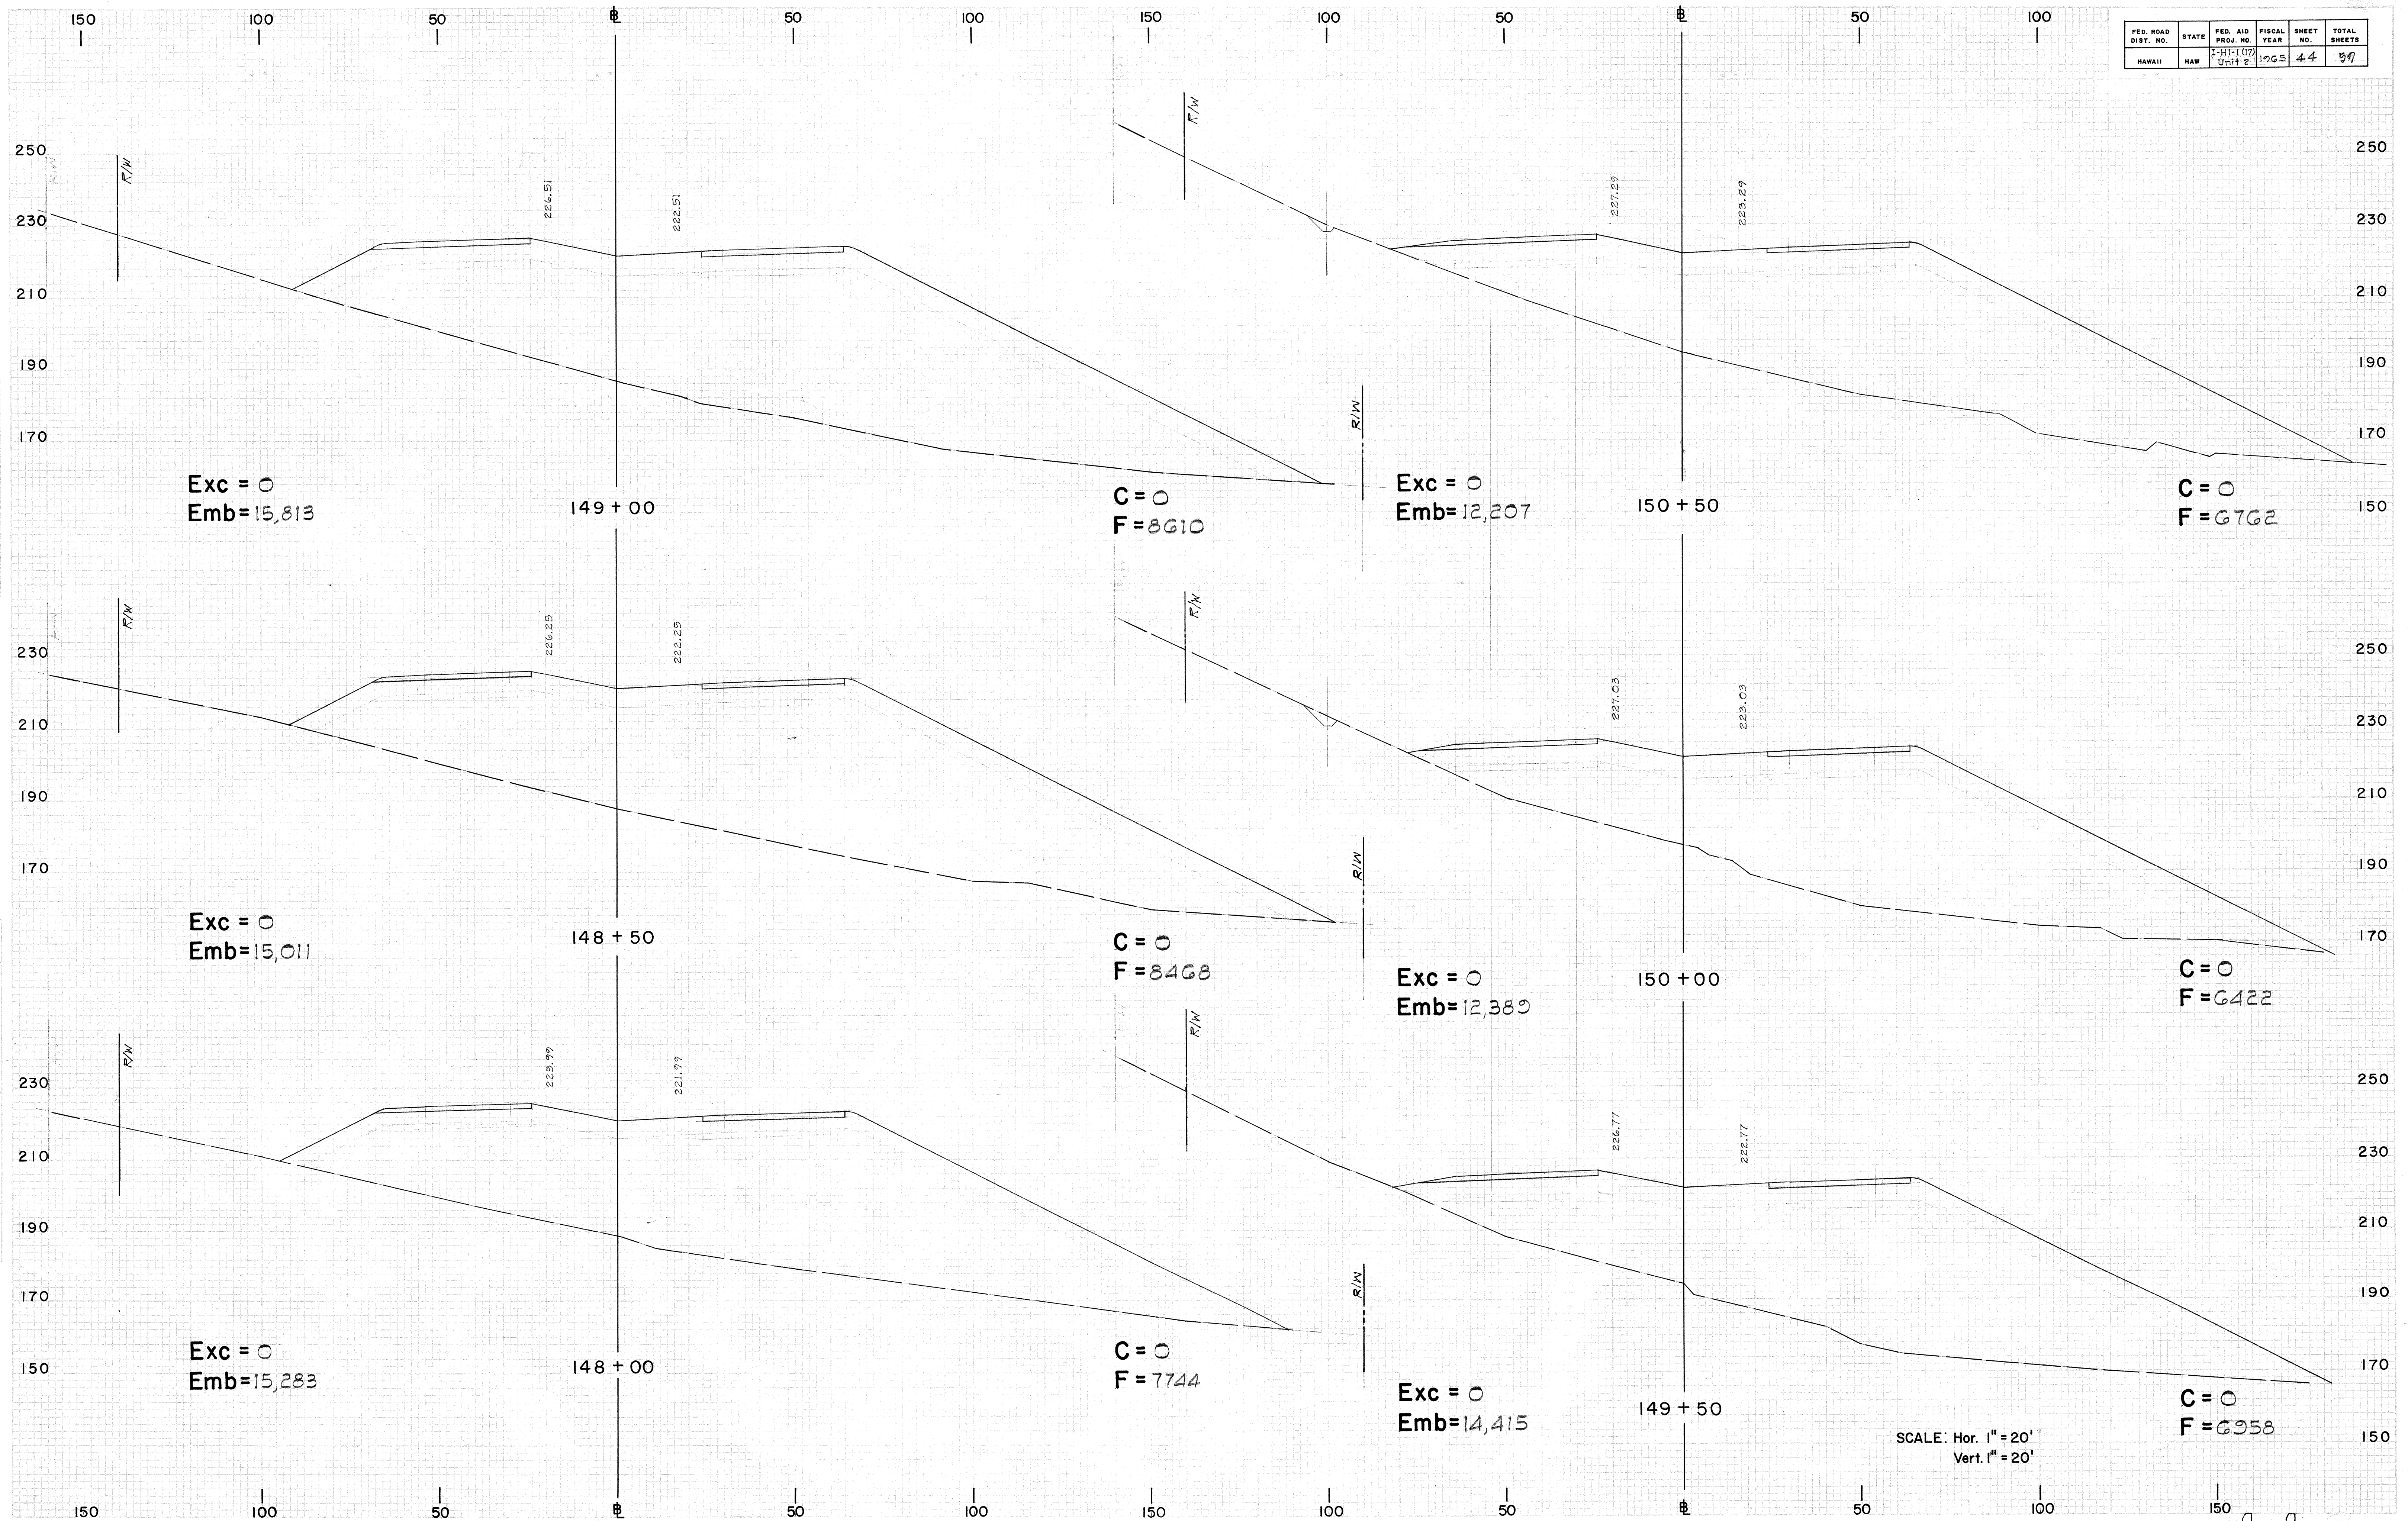

FED. ROAD DIST. NO.	STATE	FED. AID PROJ. NO.	FISCAL YEAR	SHEET NO.	TOTAL SHEETS
HAWAII	HAW	1-H-1(17) Unit 2	1965	45	99

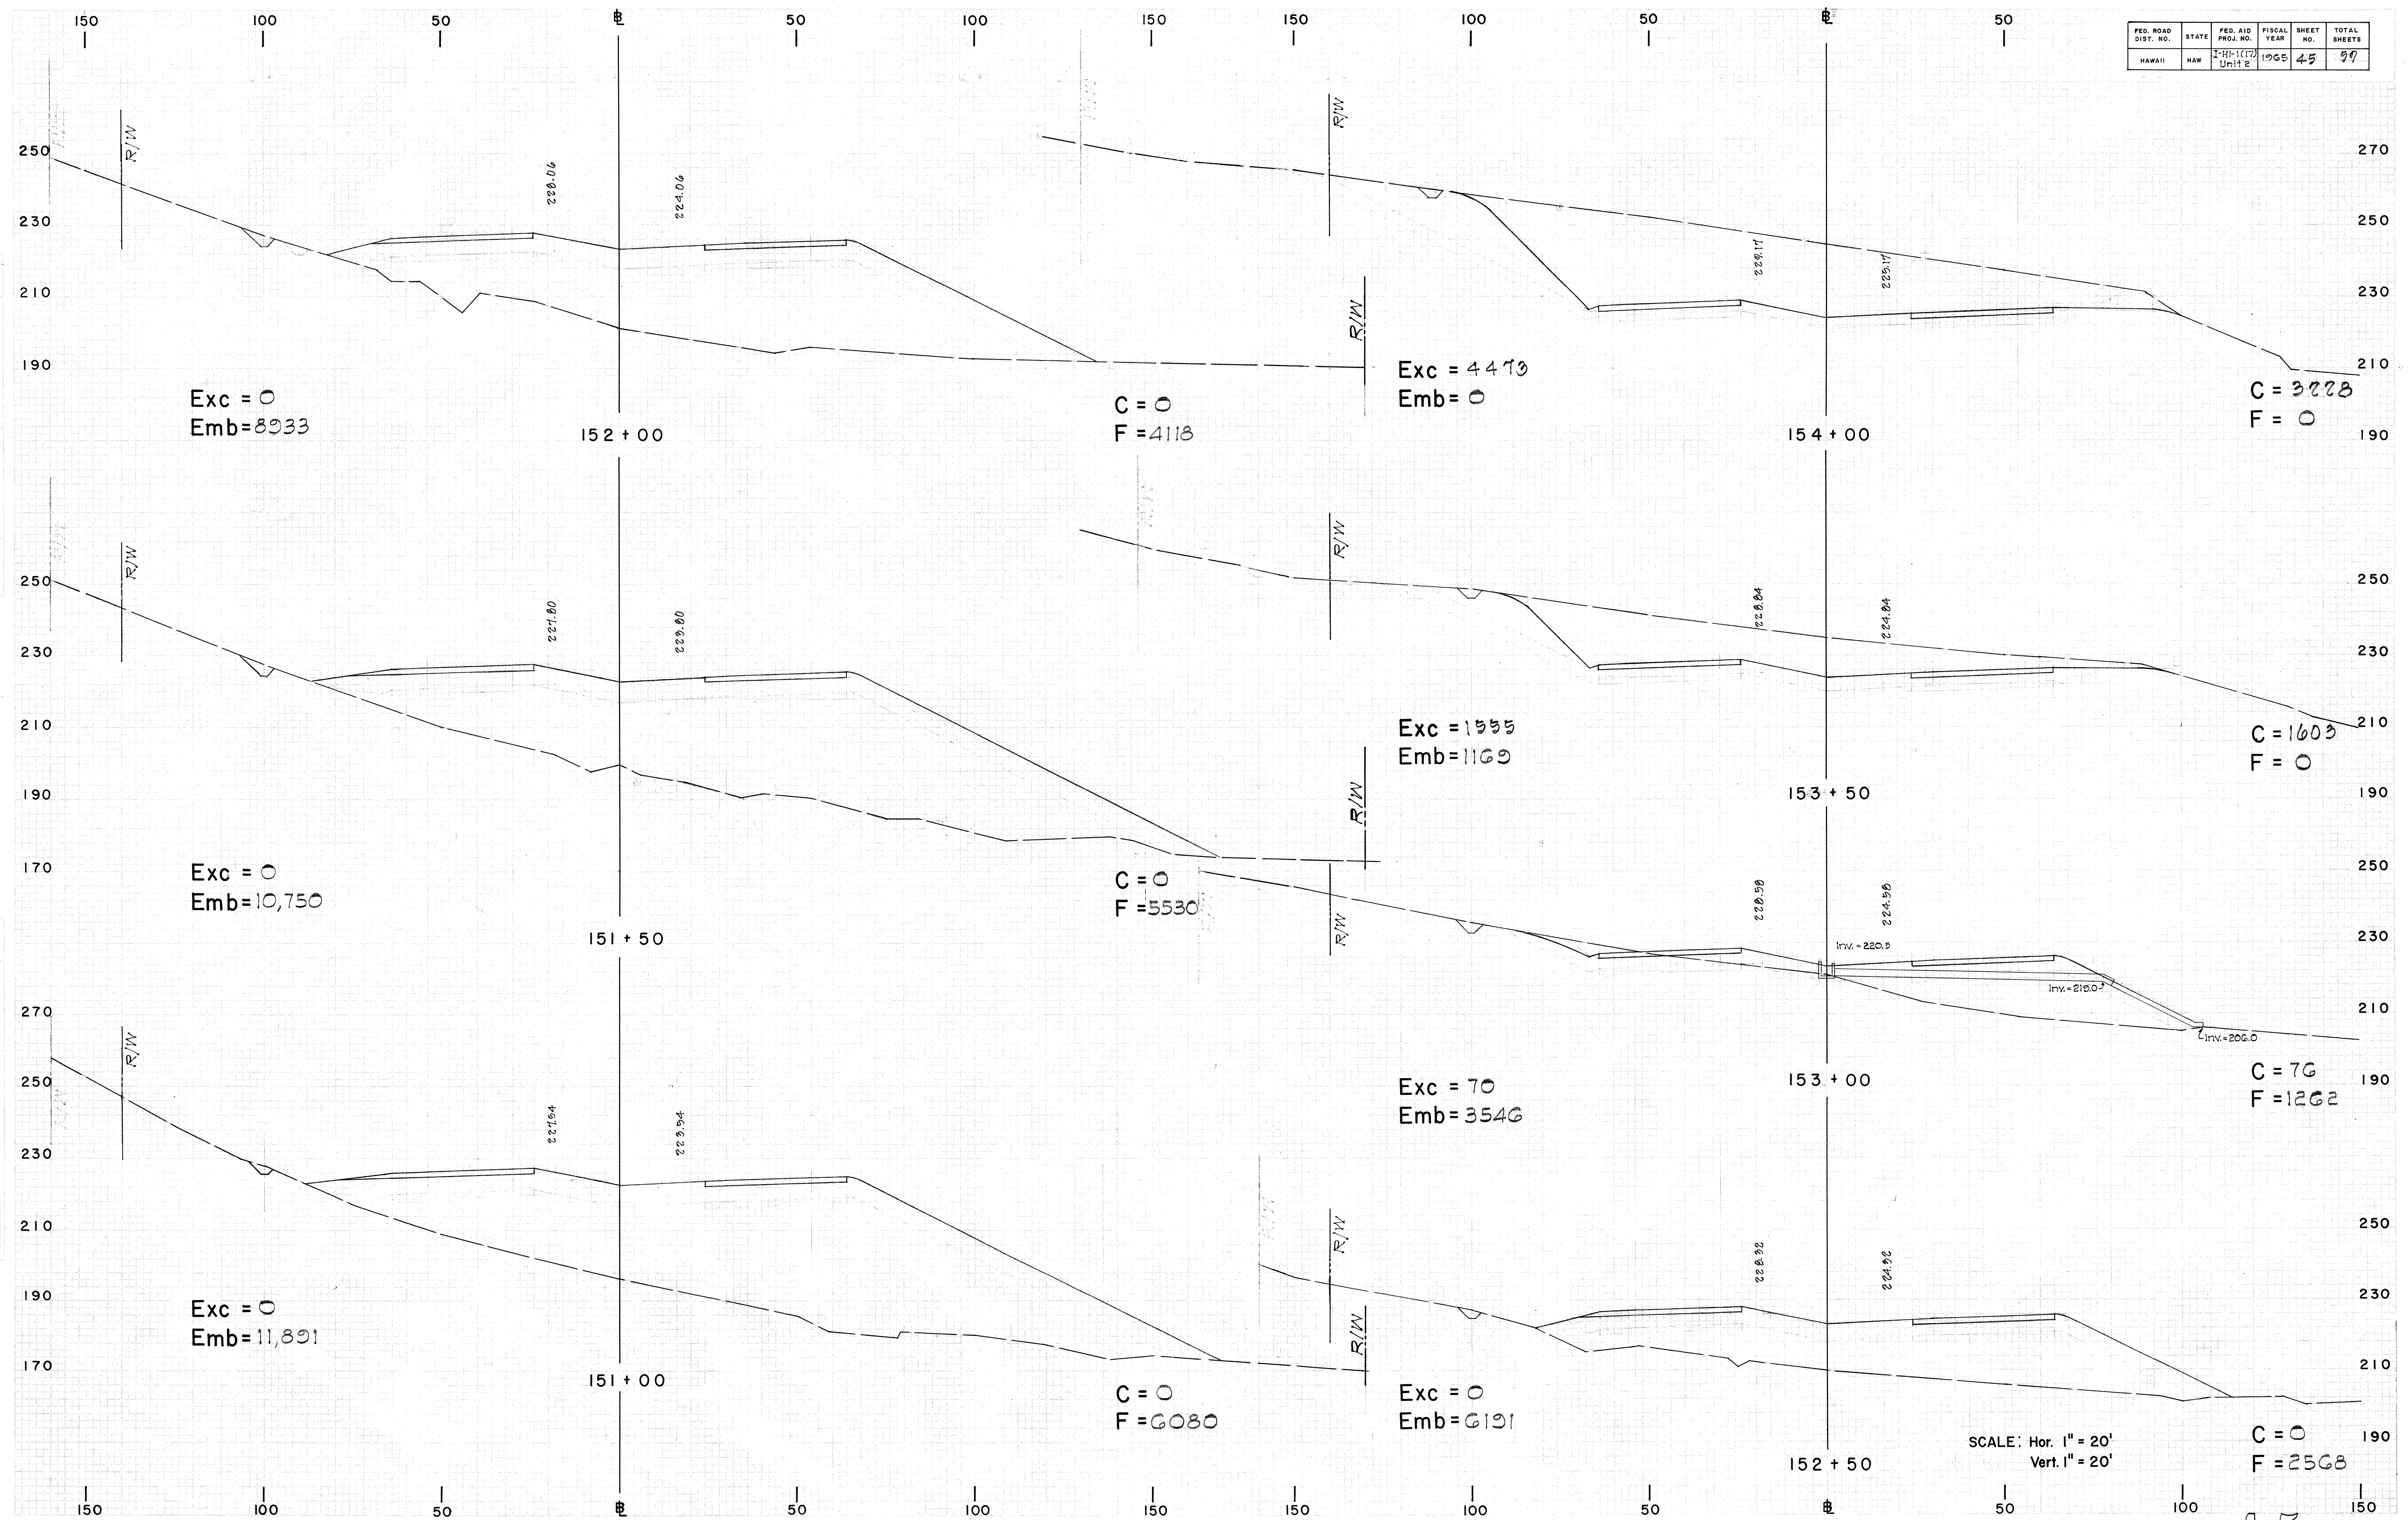

FED. ROAD DIST. NO.	STATE	FED. AID PROJ. NO.	FISCAL YEAR	SHEET NO.	TOTAL SHEETS
HAWAII	HAW	1-111-1(17) Unit 2	1965	46	59

Exc = 6363
Emb = 74

155+50

C = 3054
F = 80

Exc = 1119
Emb = 3015

157+00

C = 777
F = 1032

Exc = 1109
Emb = 0

155+00

3732
C = ~~3818~~
F = 0

Exc = 2578
Emb = 2048

156+50

C = 1079
F = 1324

Exc = 6558
Emb = 0

154+50

3800
C = ~~3855~~
F = 0

Exc = 4427
Emb = 836

156+00

C = 1727
F = 888

SCALE: Hor. 1" = 20'
Vert. 1" = 20'



46 6

FED. ROAD DIST. NO.	STATE	FED. AID PROJ. NO.	FISCAL YEAR	SHEET NO.	TOTAL SHEETS
HAWAII	HAW	1-11(17) Unit 2	1965	47	99

Revised: 3/25/65

REVISIONS
NO. DATE BY
1 11/1/64 J.E.B.
2 11/1/64 J.E.B.
3 11/1/64 J.E.B.


REVISIONS
NO. DATE BY
1 11/1/64 J.E.B.
2 11/1/64 J.E.B.
3 11/1/64 J.E.B.

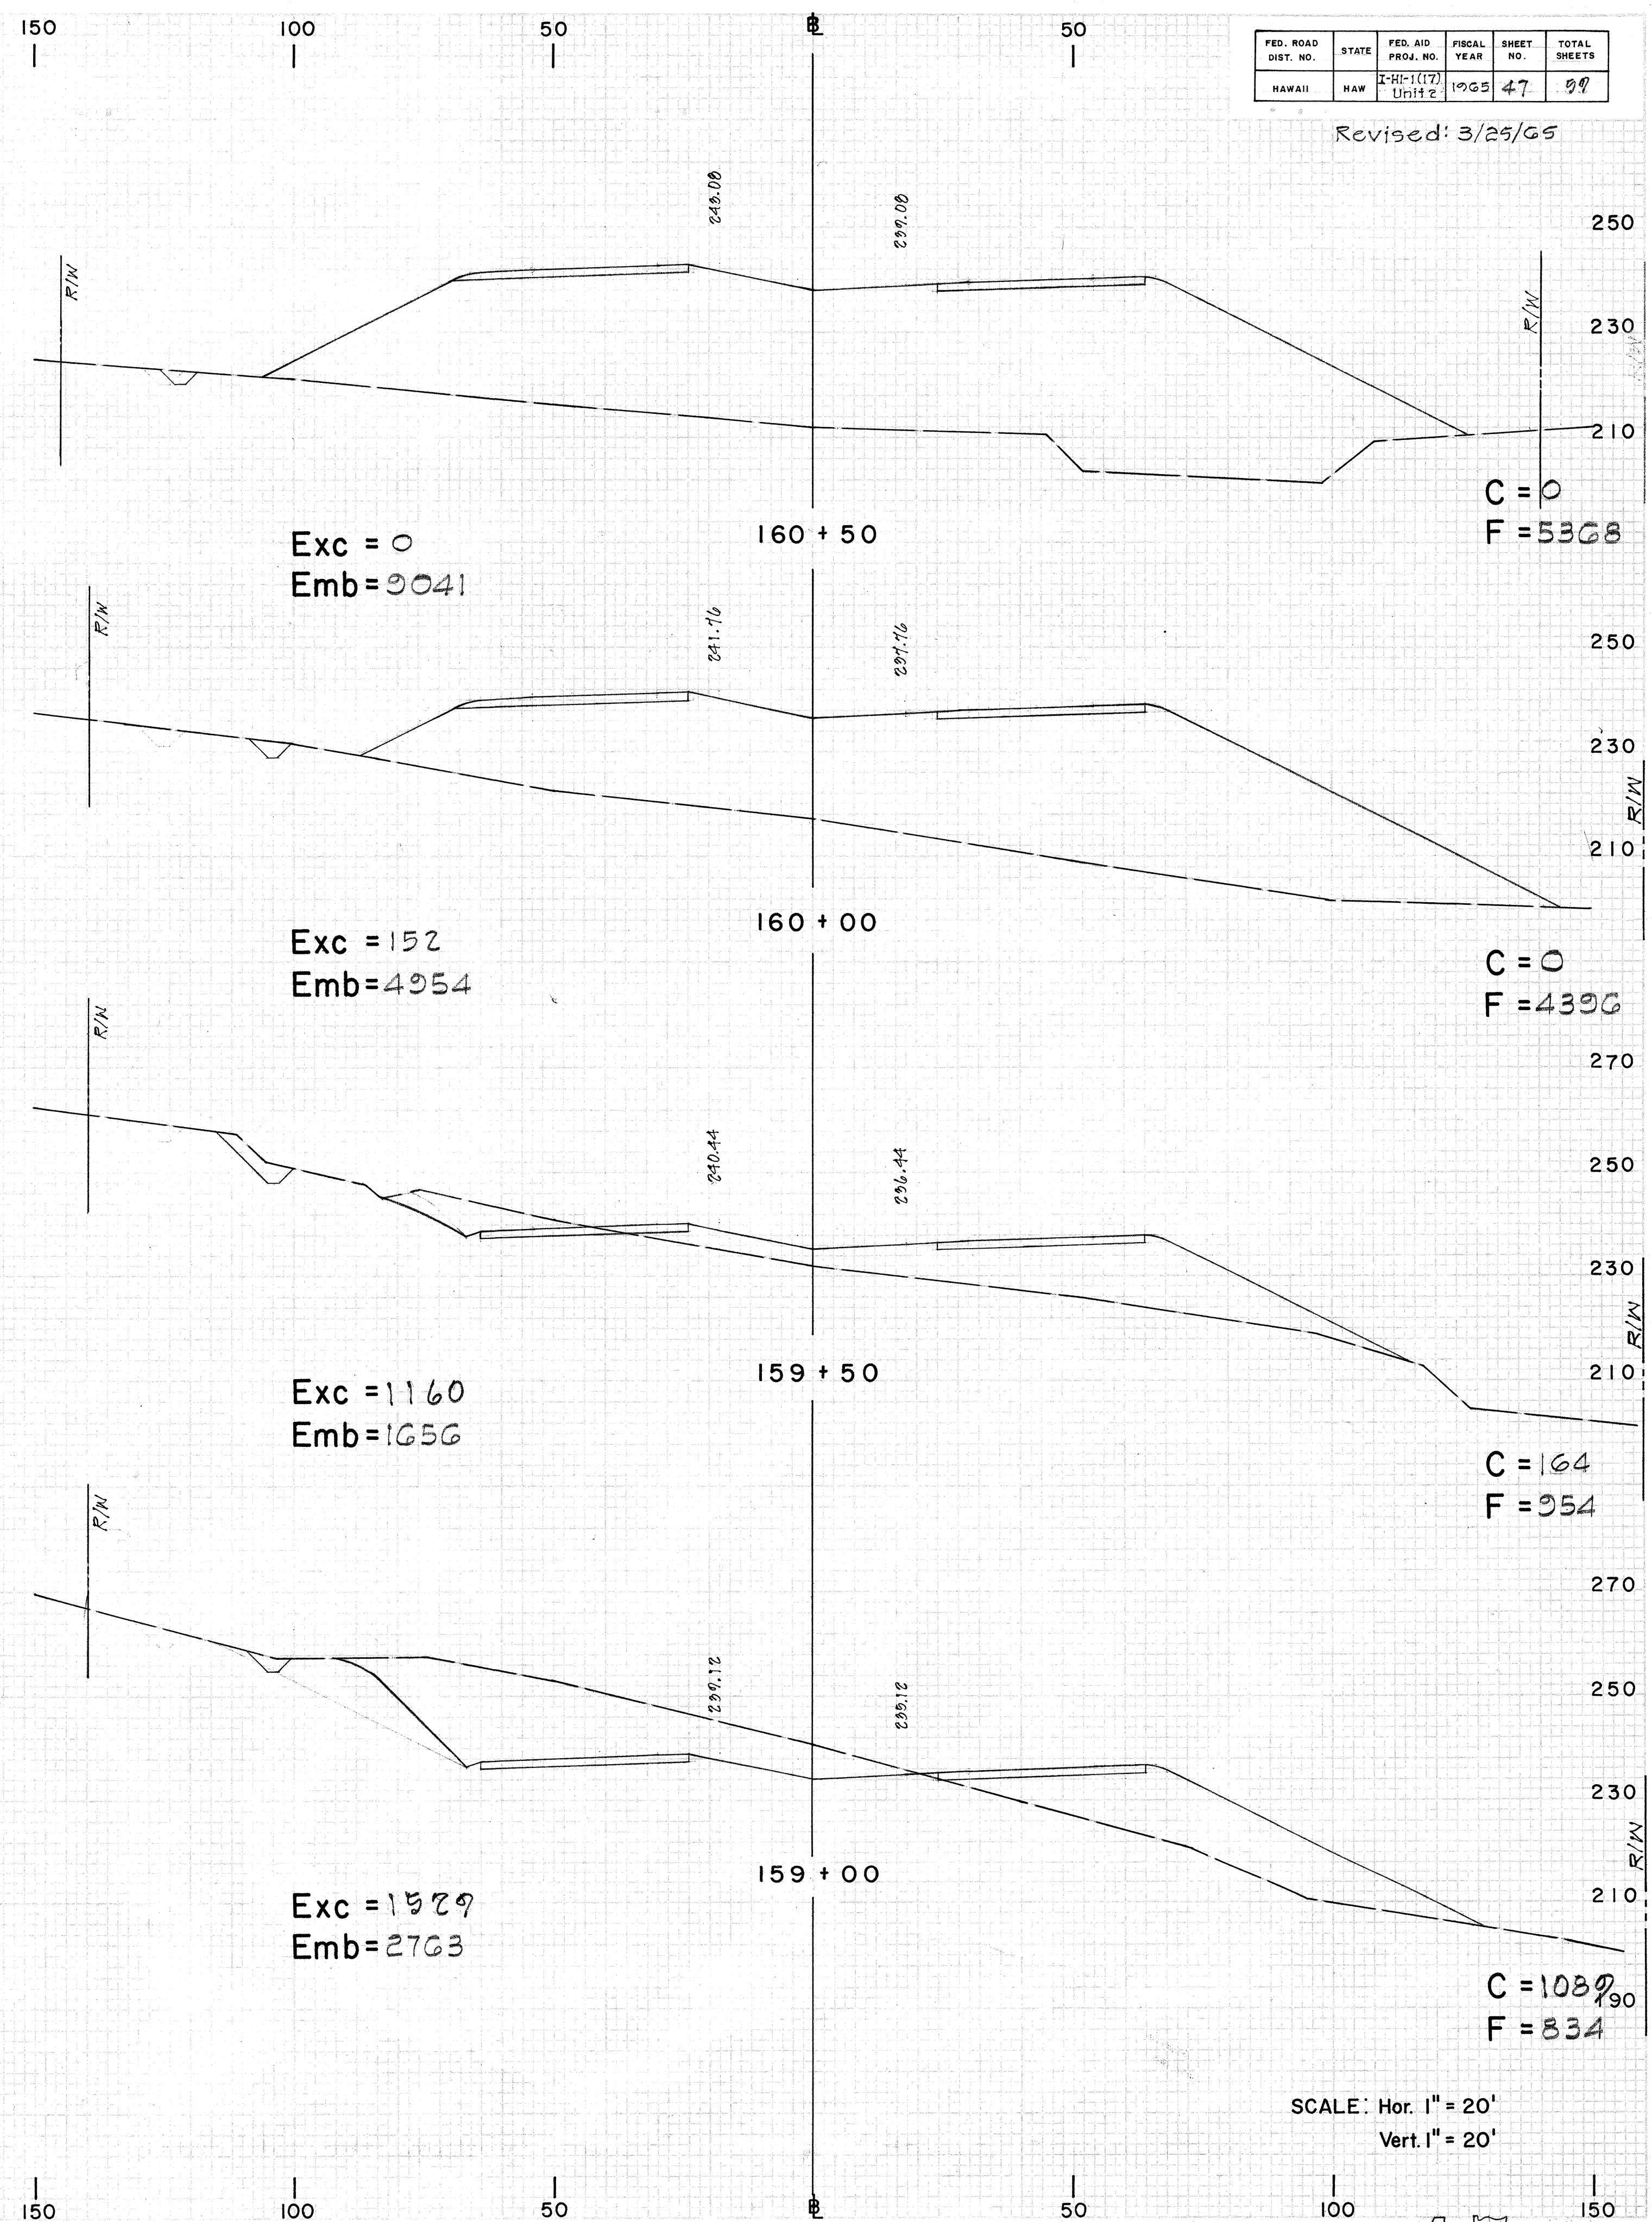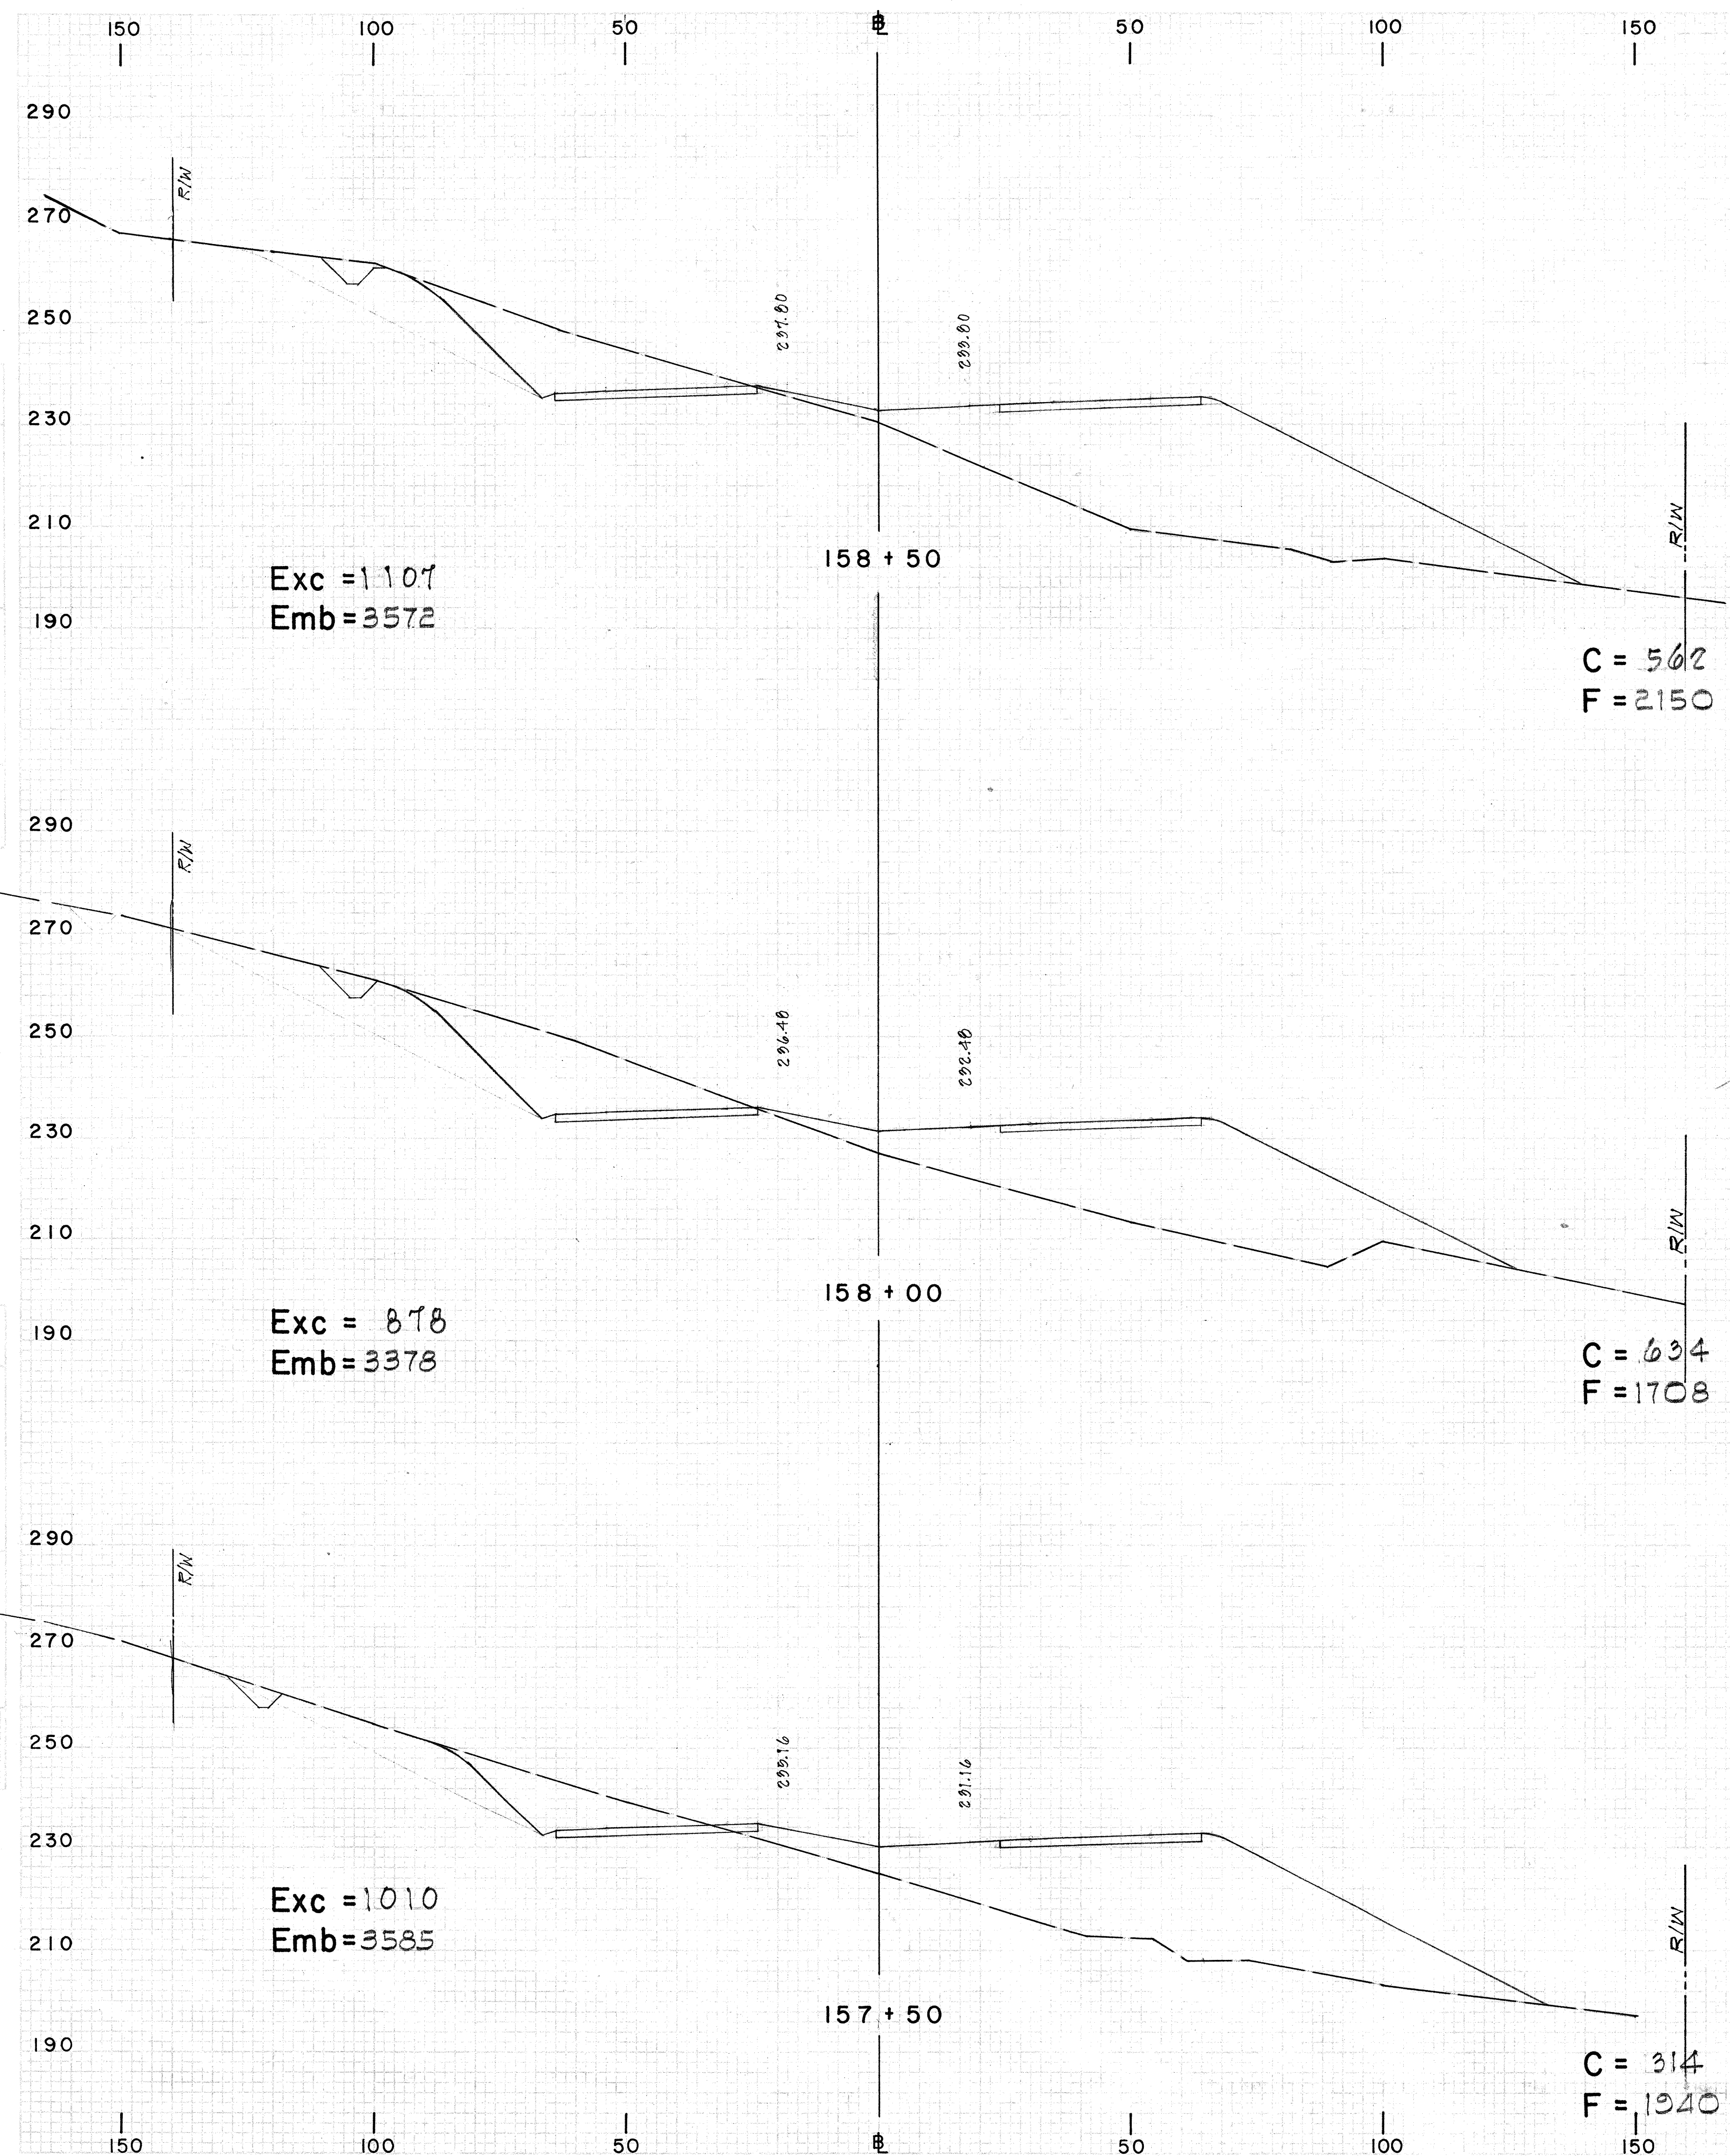

SCALE: Hor. 1" = 20'
Vert. 1" = 20'


47 5

FED. ROAD DIST. NO.	STATE	FED. AID PROJ. NO.	FISCAL YEAR	SHEET NO.	TOTAL SHEETS
HAWAII	HAW	244-1(17) Unit 2	1965	48	99

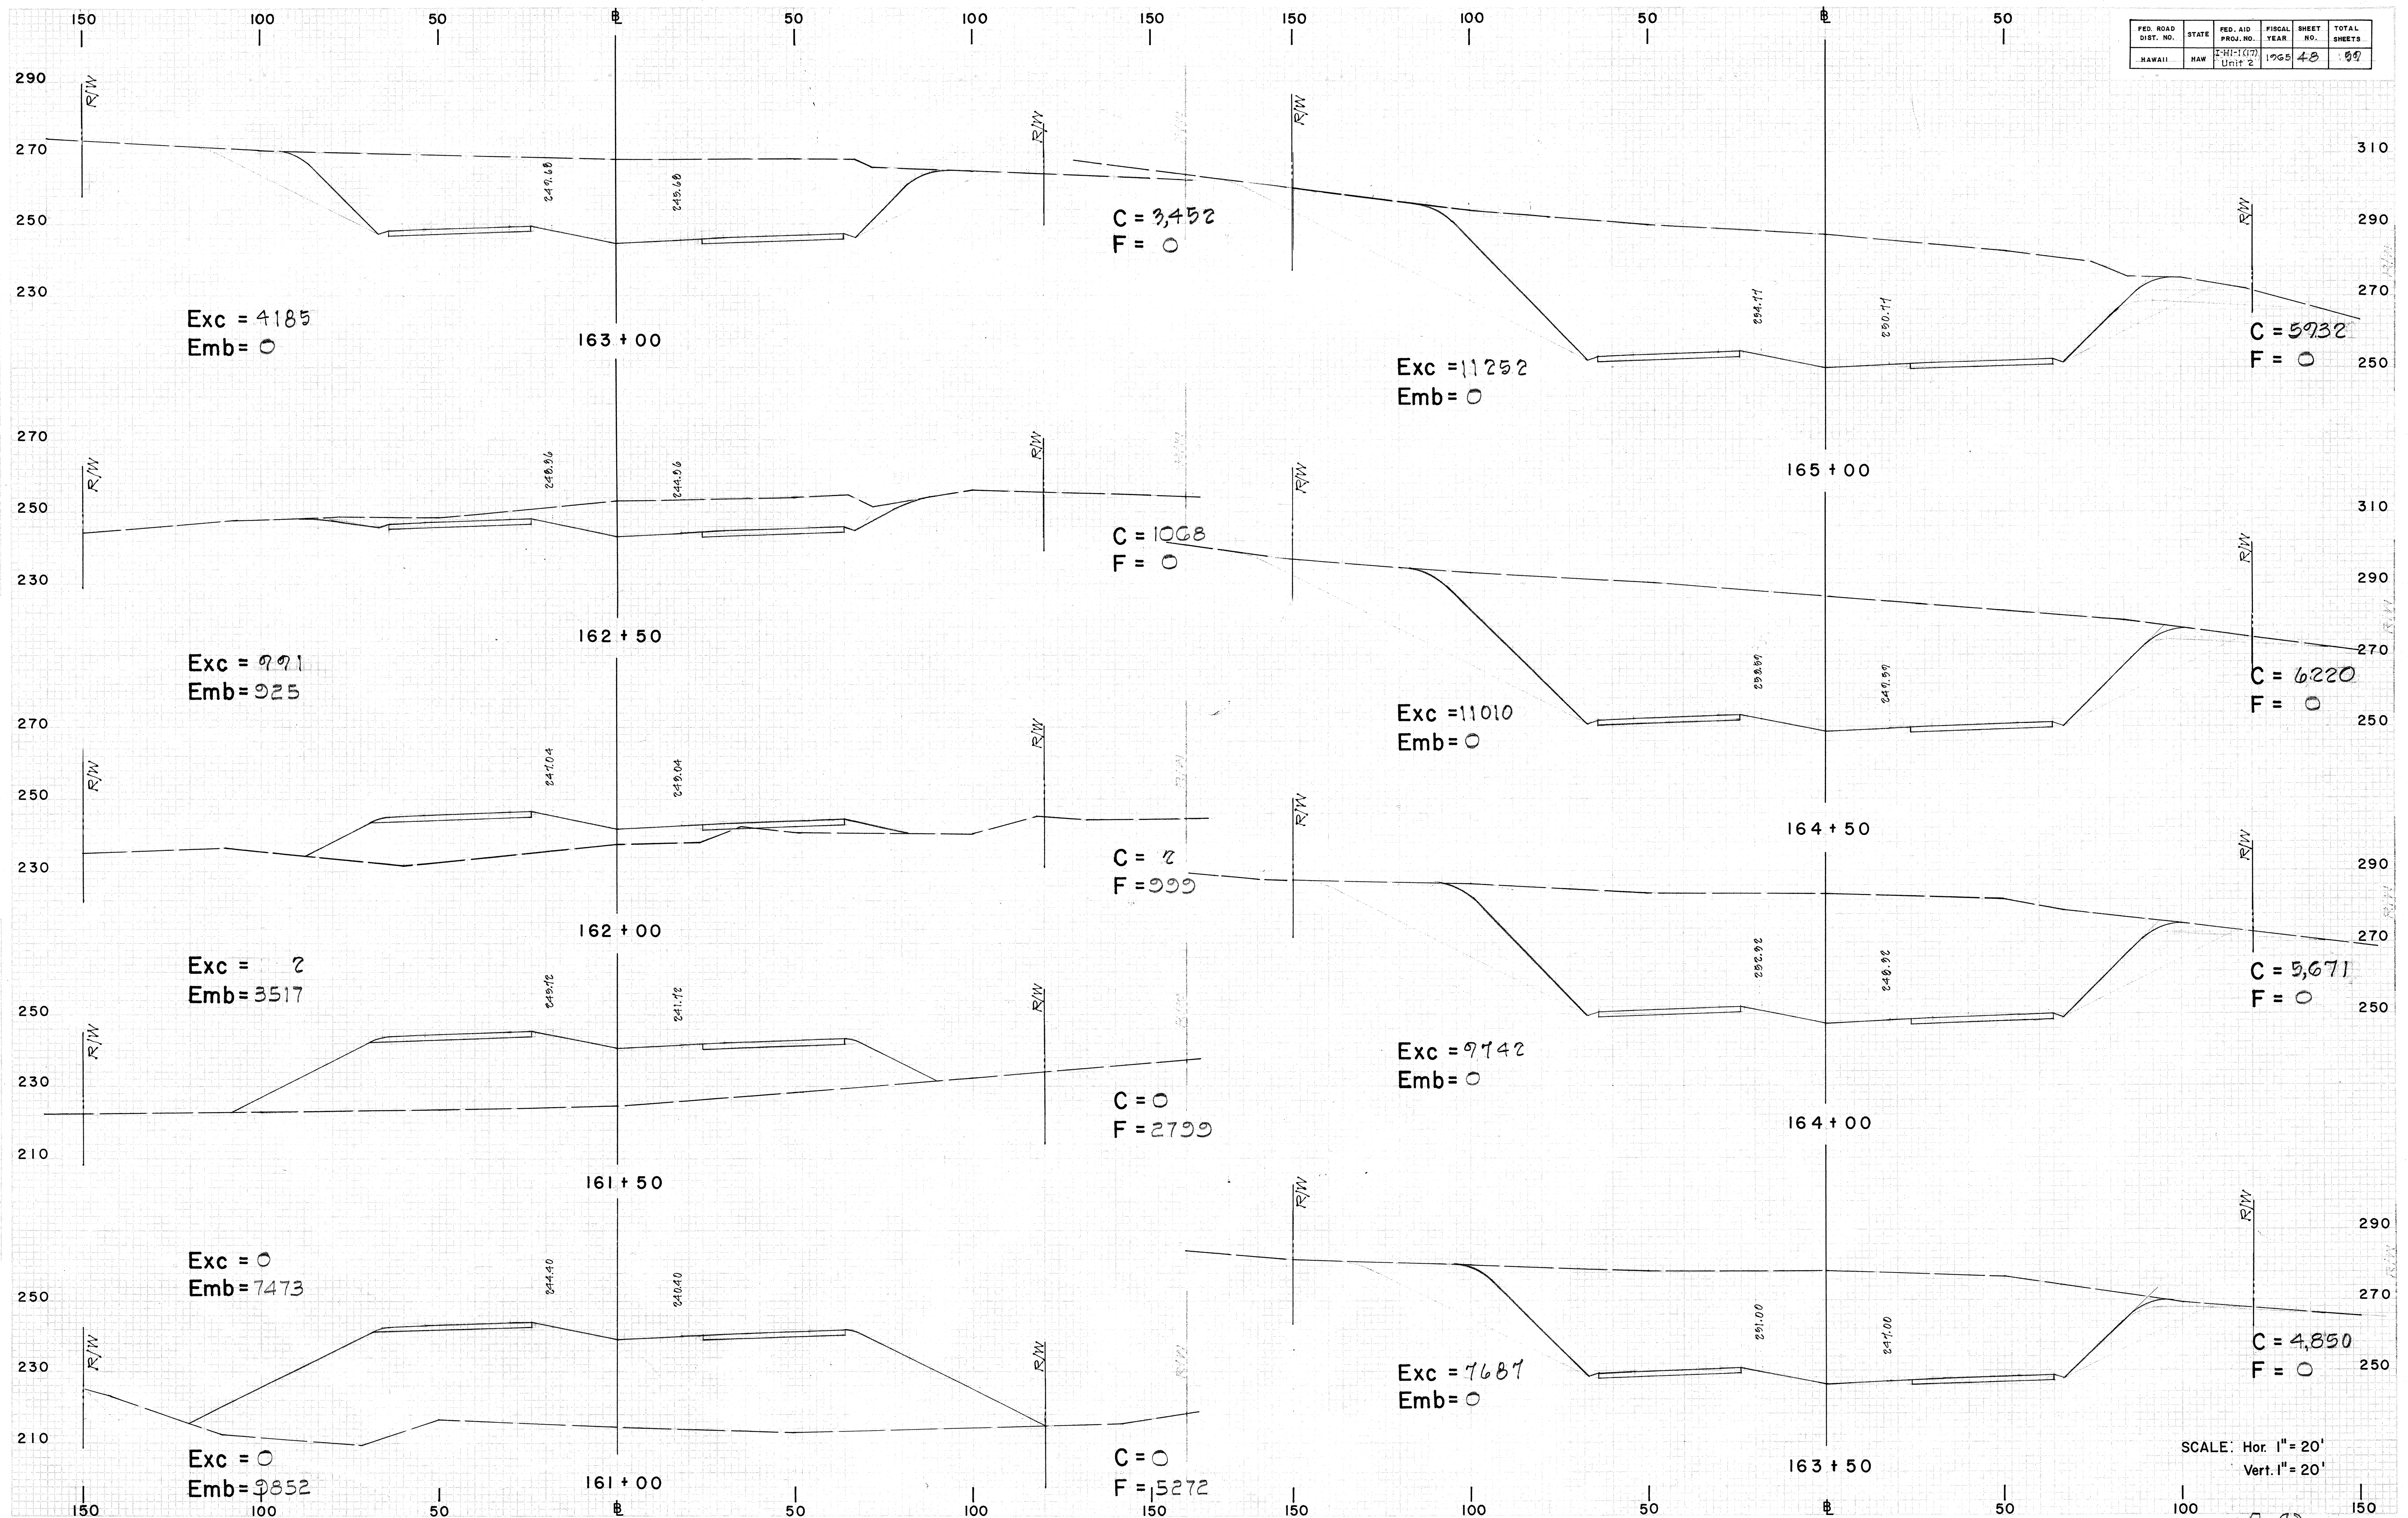


DD 8-4-3

FED. ROAD DIST. NO.	STATE	FED. AID PROJ. NO.	FISCAL YEAR	SHEET NO.	TOTAL SHEETS
HAWAII	HAW	HI-1(17) Unit 2	1965	47	57

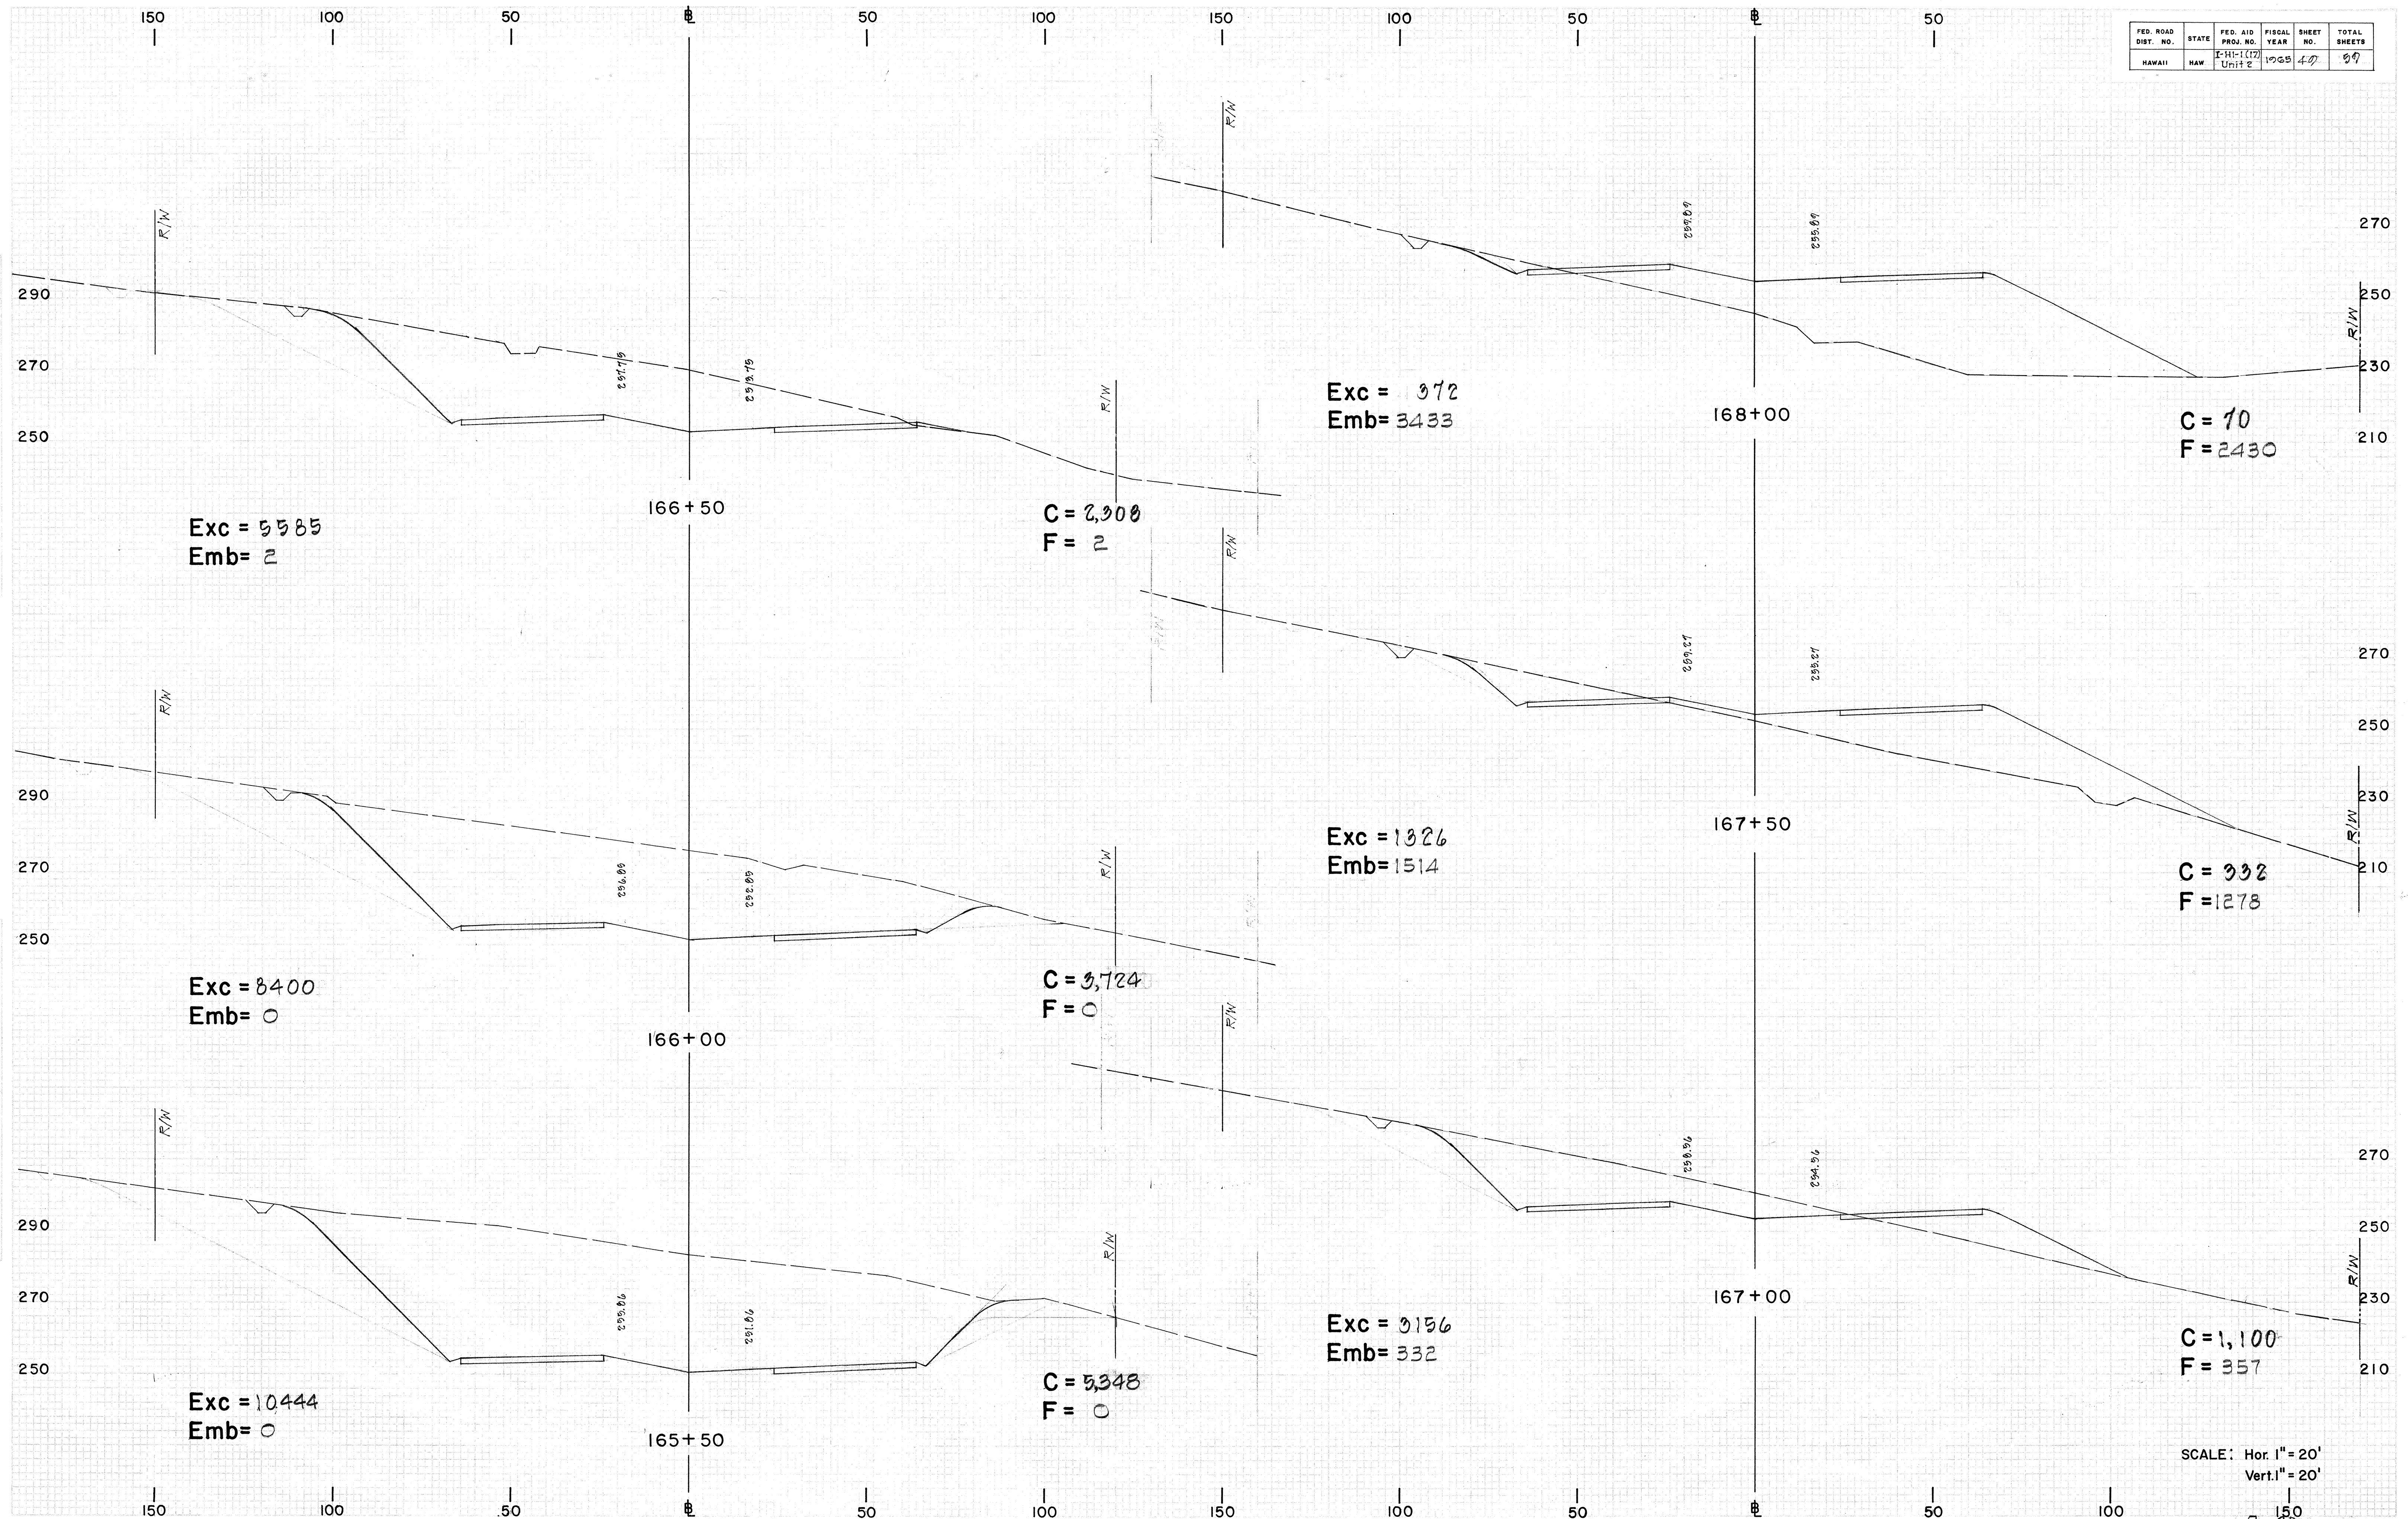

On 15-4-3

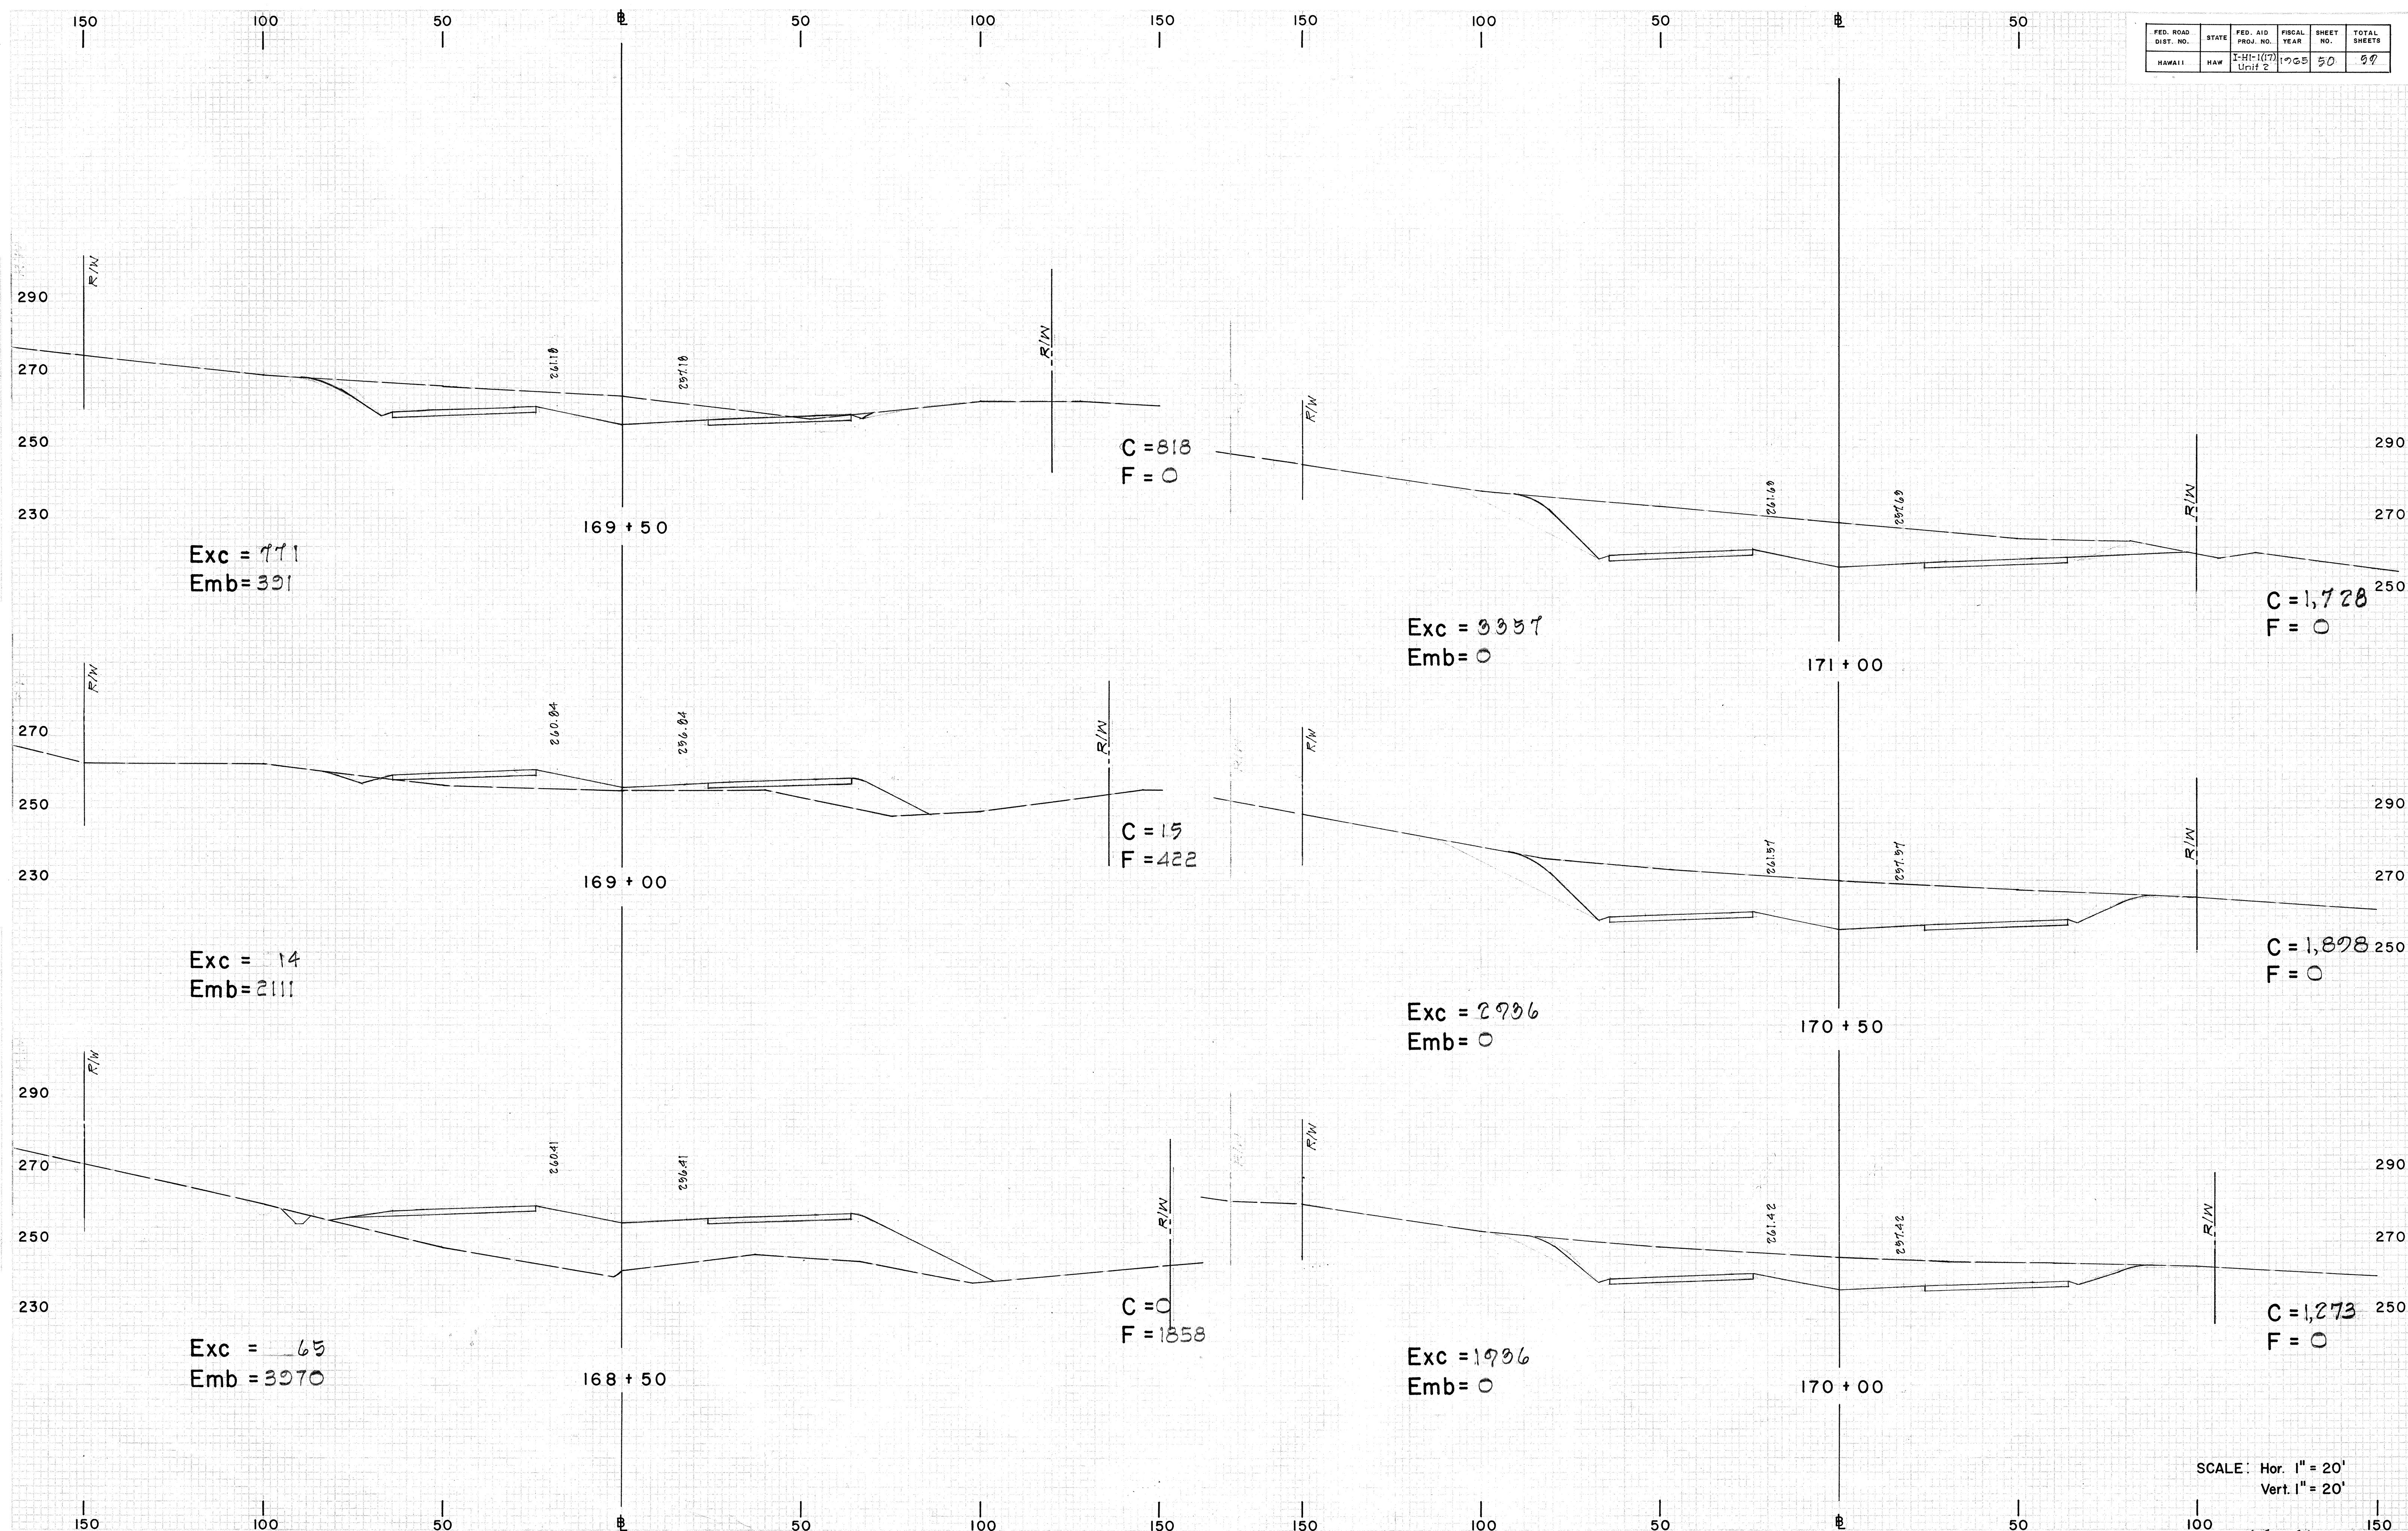

SCALE: Hor. 1" = 20'
Vert. 1" = 20'

5 ()


DD. B. 4-3

1

FED. ROAD DIST. NO.	STATE	FED. AID PROJ. NO.	FISCAL YEAR	SHEET NO.	TOTAL SHEETS
HAWAII	HAW	1-HI-117	1965	51	97

DESIGNED BY	DATE
CHECKED BY	DATE
PLANNED BY	DATE
NOTED BY	DATE
AREA	DATE

DESIGNED BY	DATE
CHECKED BY	DATE
PLANNED BY	DATE
NOTED BY	DATE
AREA	DATE

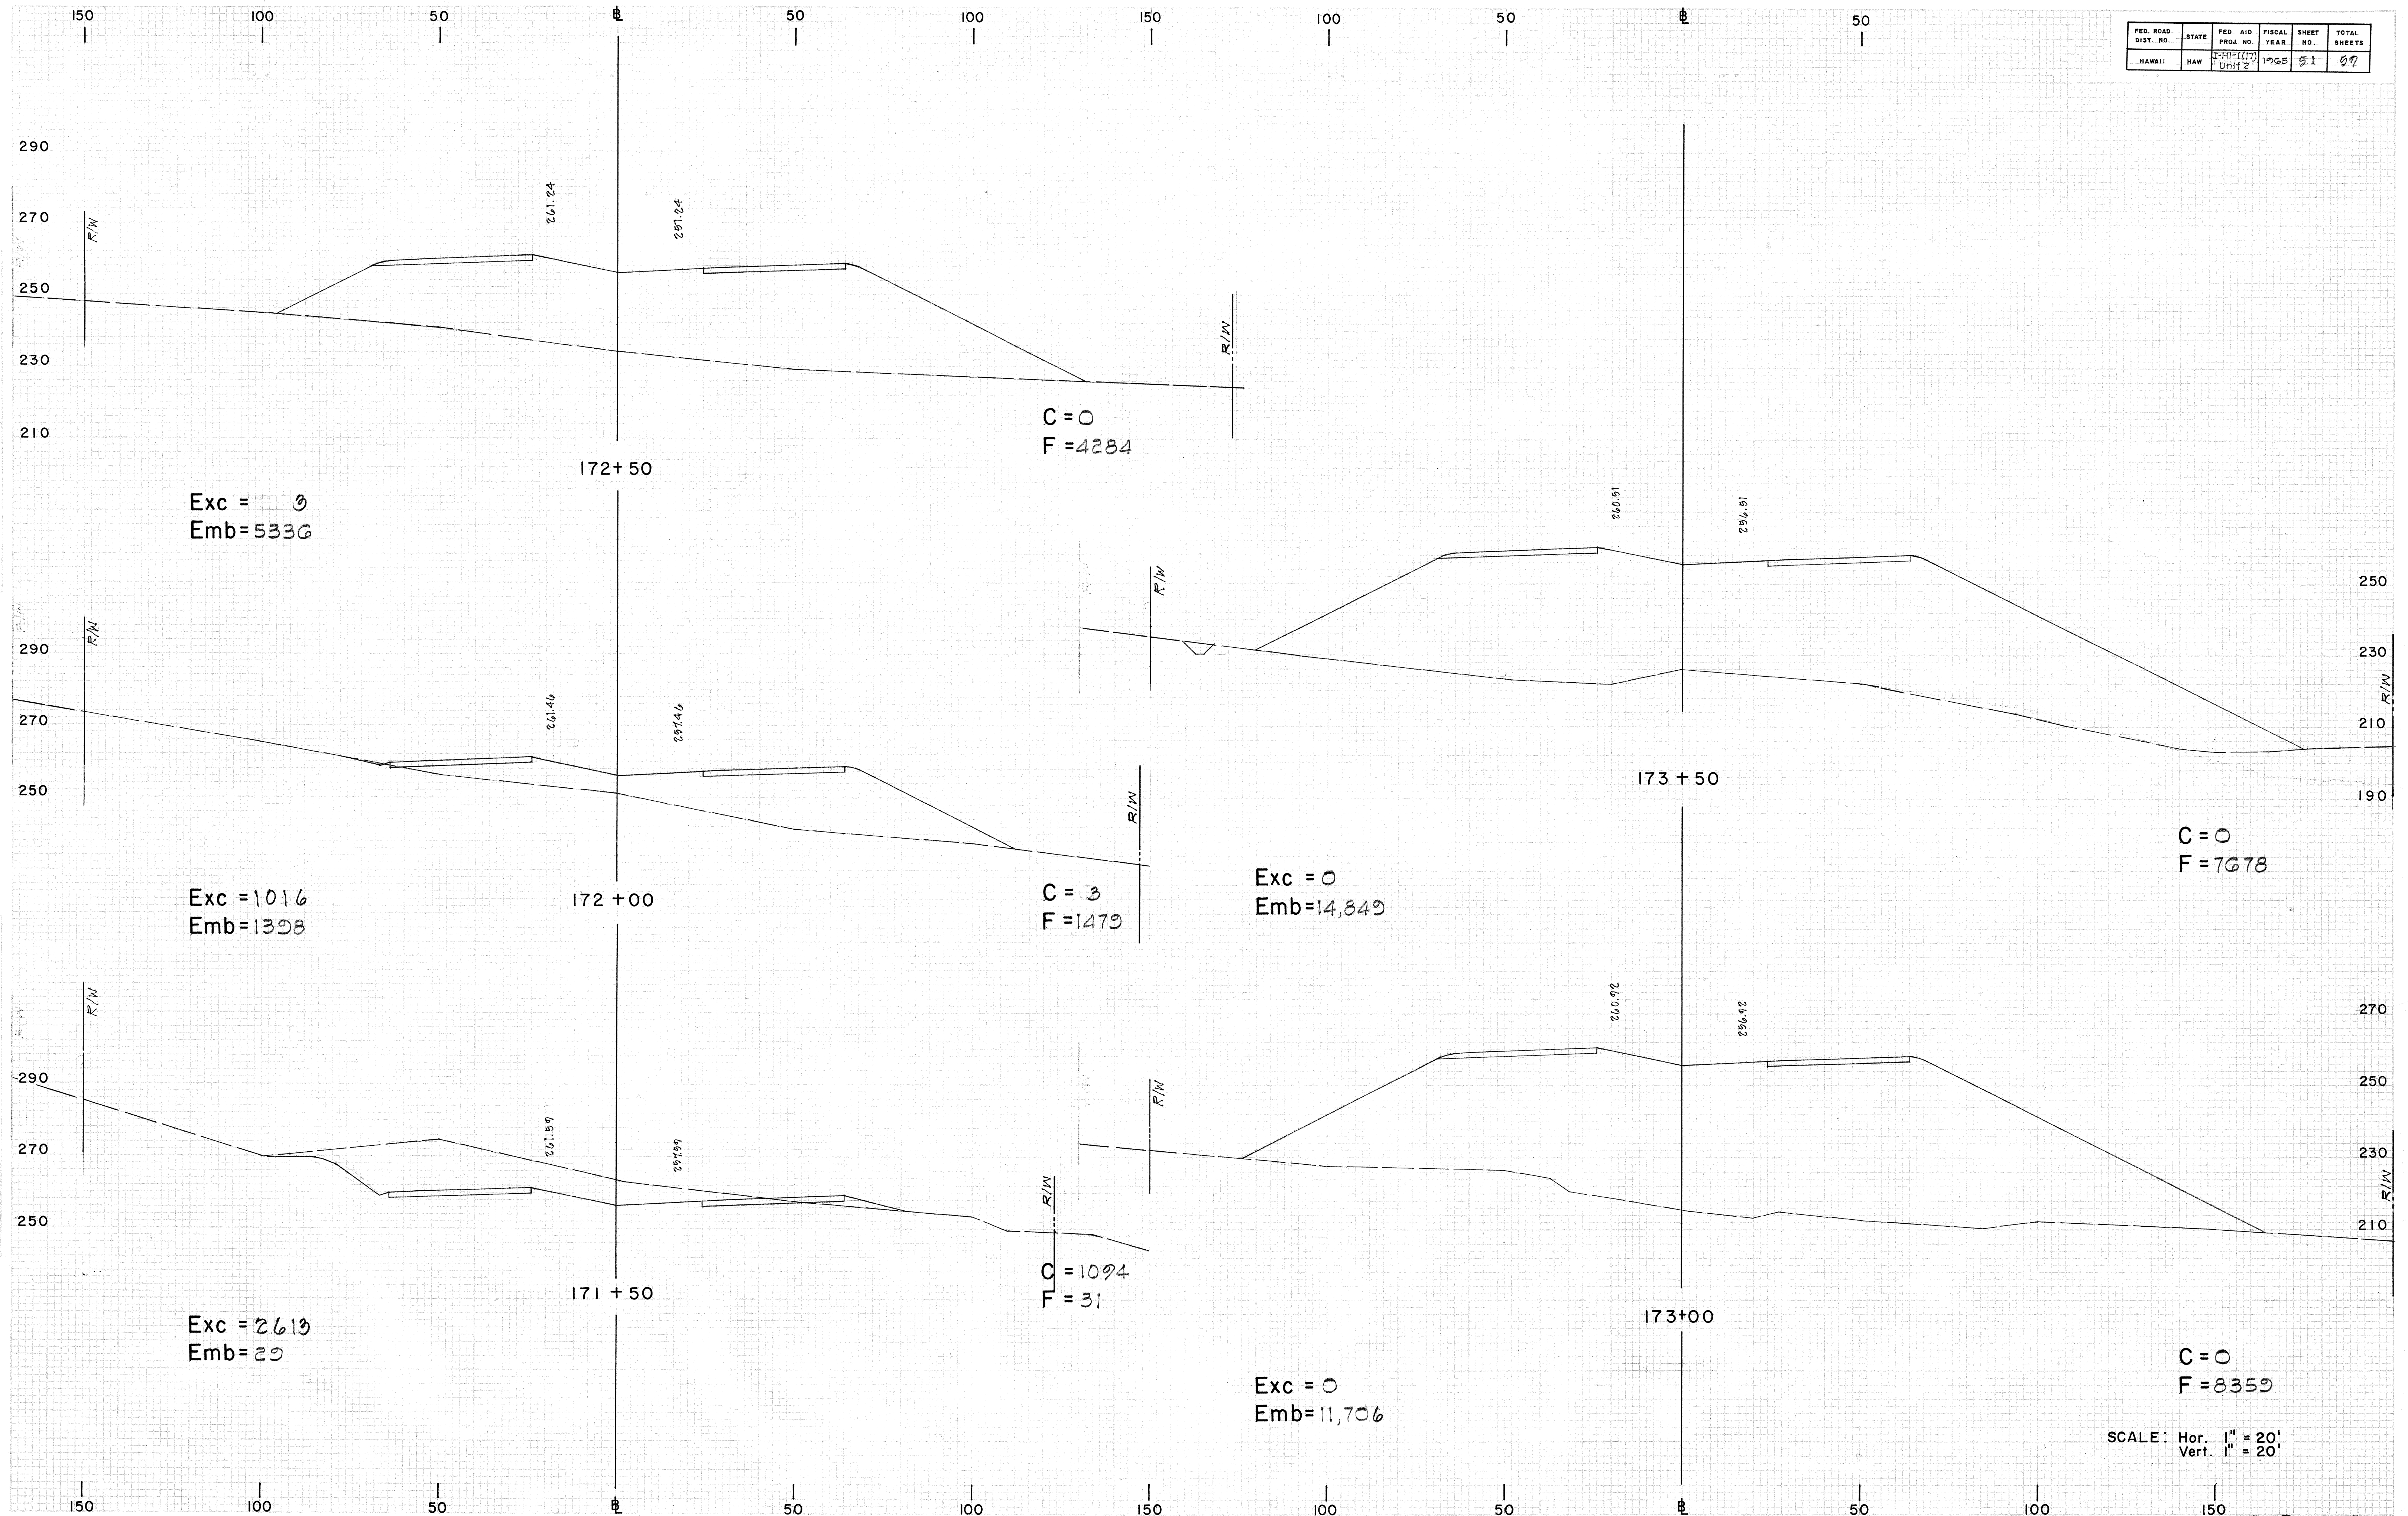


FED. ROAD DIST. NO.	STATE	FED. AID PROJ. NO.	FISCAL YEAR	SHEET NO.	TOTAL SHEETS
HAWAII	HAW	I-HI-107	1955	52	99

DESIGNED BY	DATE
SURVEYED BY	
NOTES BY	
CHKD BY	

DESIGNED BY	DATE
SURVEYED BY	
NOTES BY	
CHKD BY	


DESIGNED BY	DATE
SURVEYED BY	
NOTES BY	
CHKD BY	

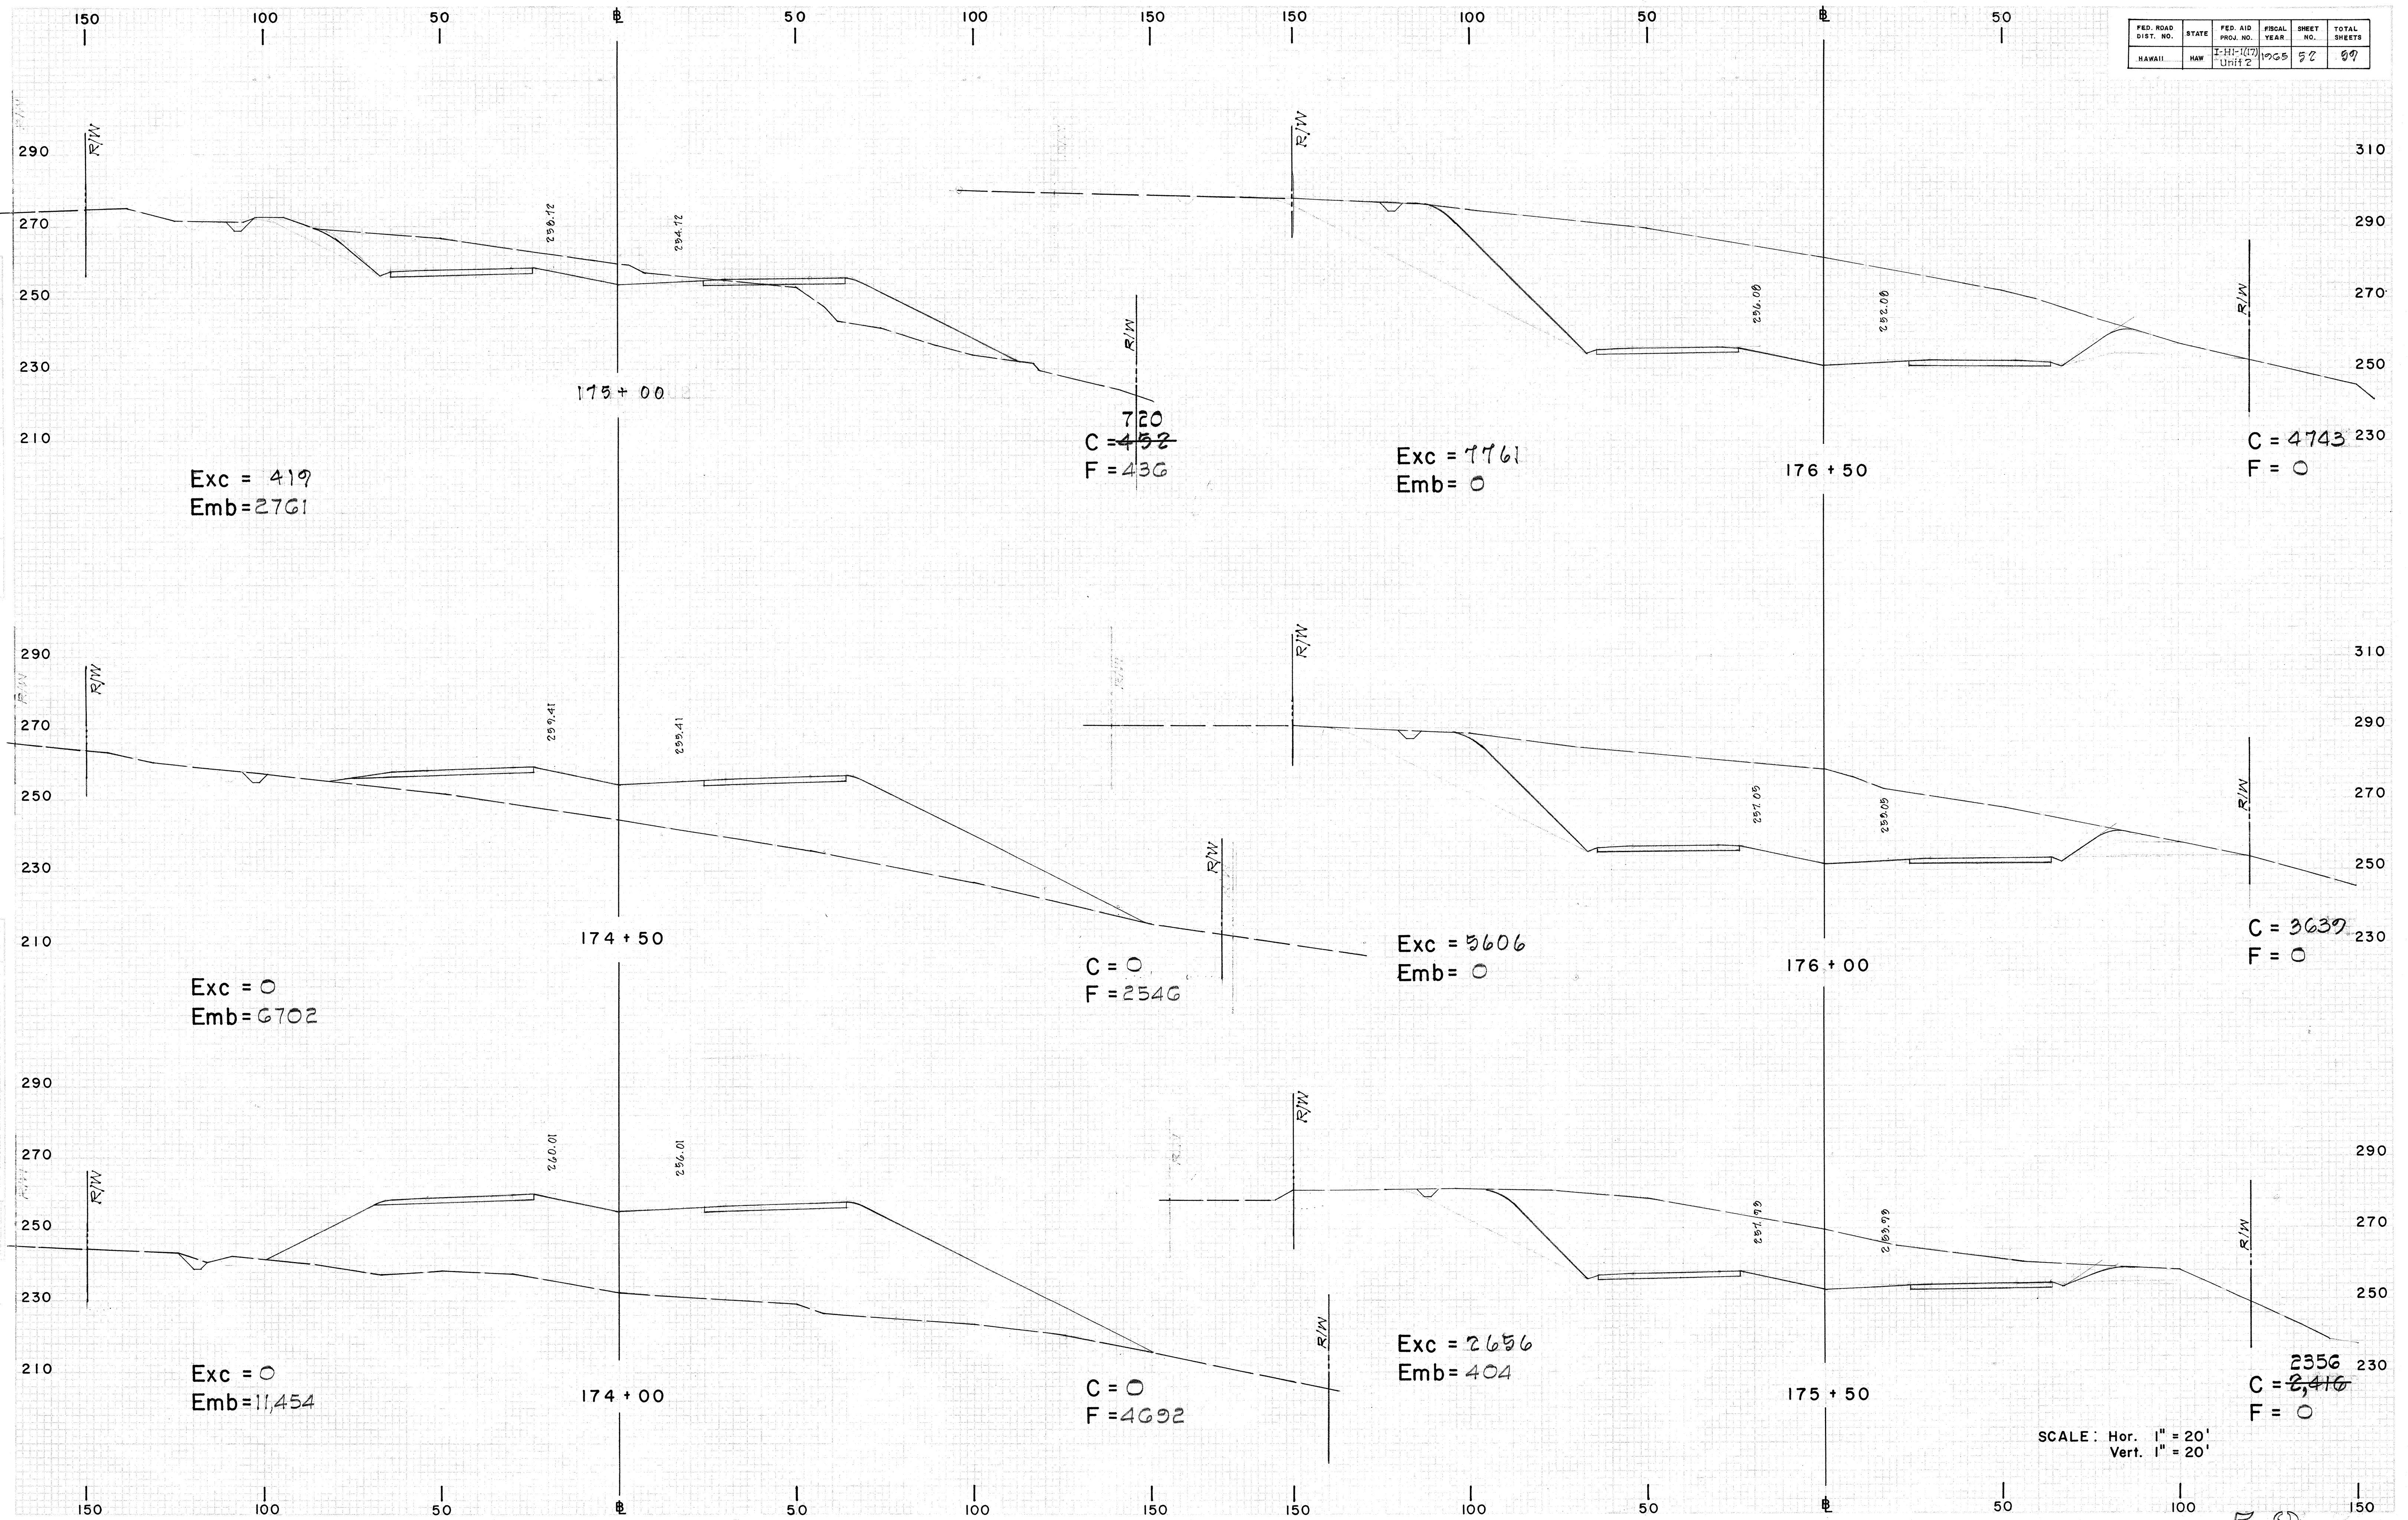

FED. ROAD DIST. NO.	STATE	FED. AID PROJ. NO.	FISCAL YEAR	SHEET NO.	TOTAL SHEETS
HAWAII	HAW	I-HI-1(17) Unit 2	1965	52	99


CHECKED
 SURVEY
 PLANNED
 NOTE BOOK
 DATE

CHECKED
 SURVEY
 PLANNED
 NOTE BOOK
 DATE

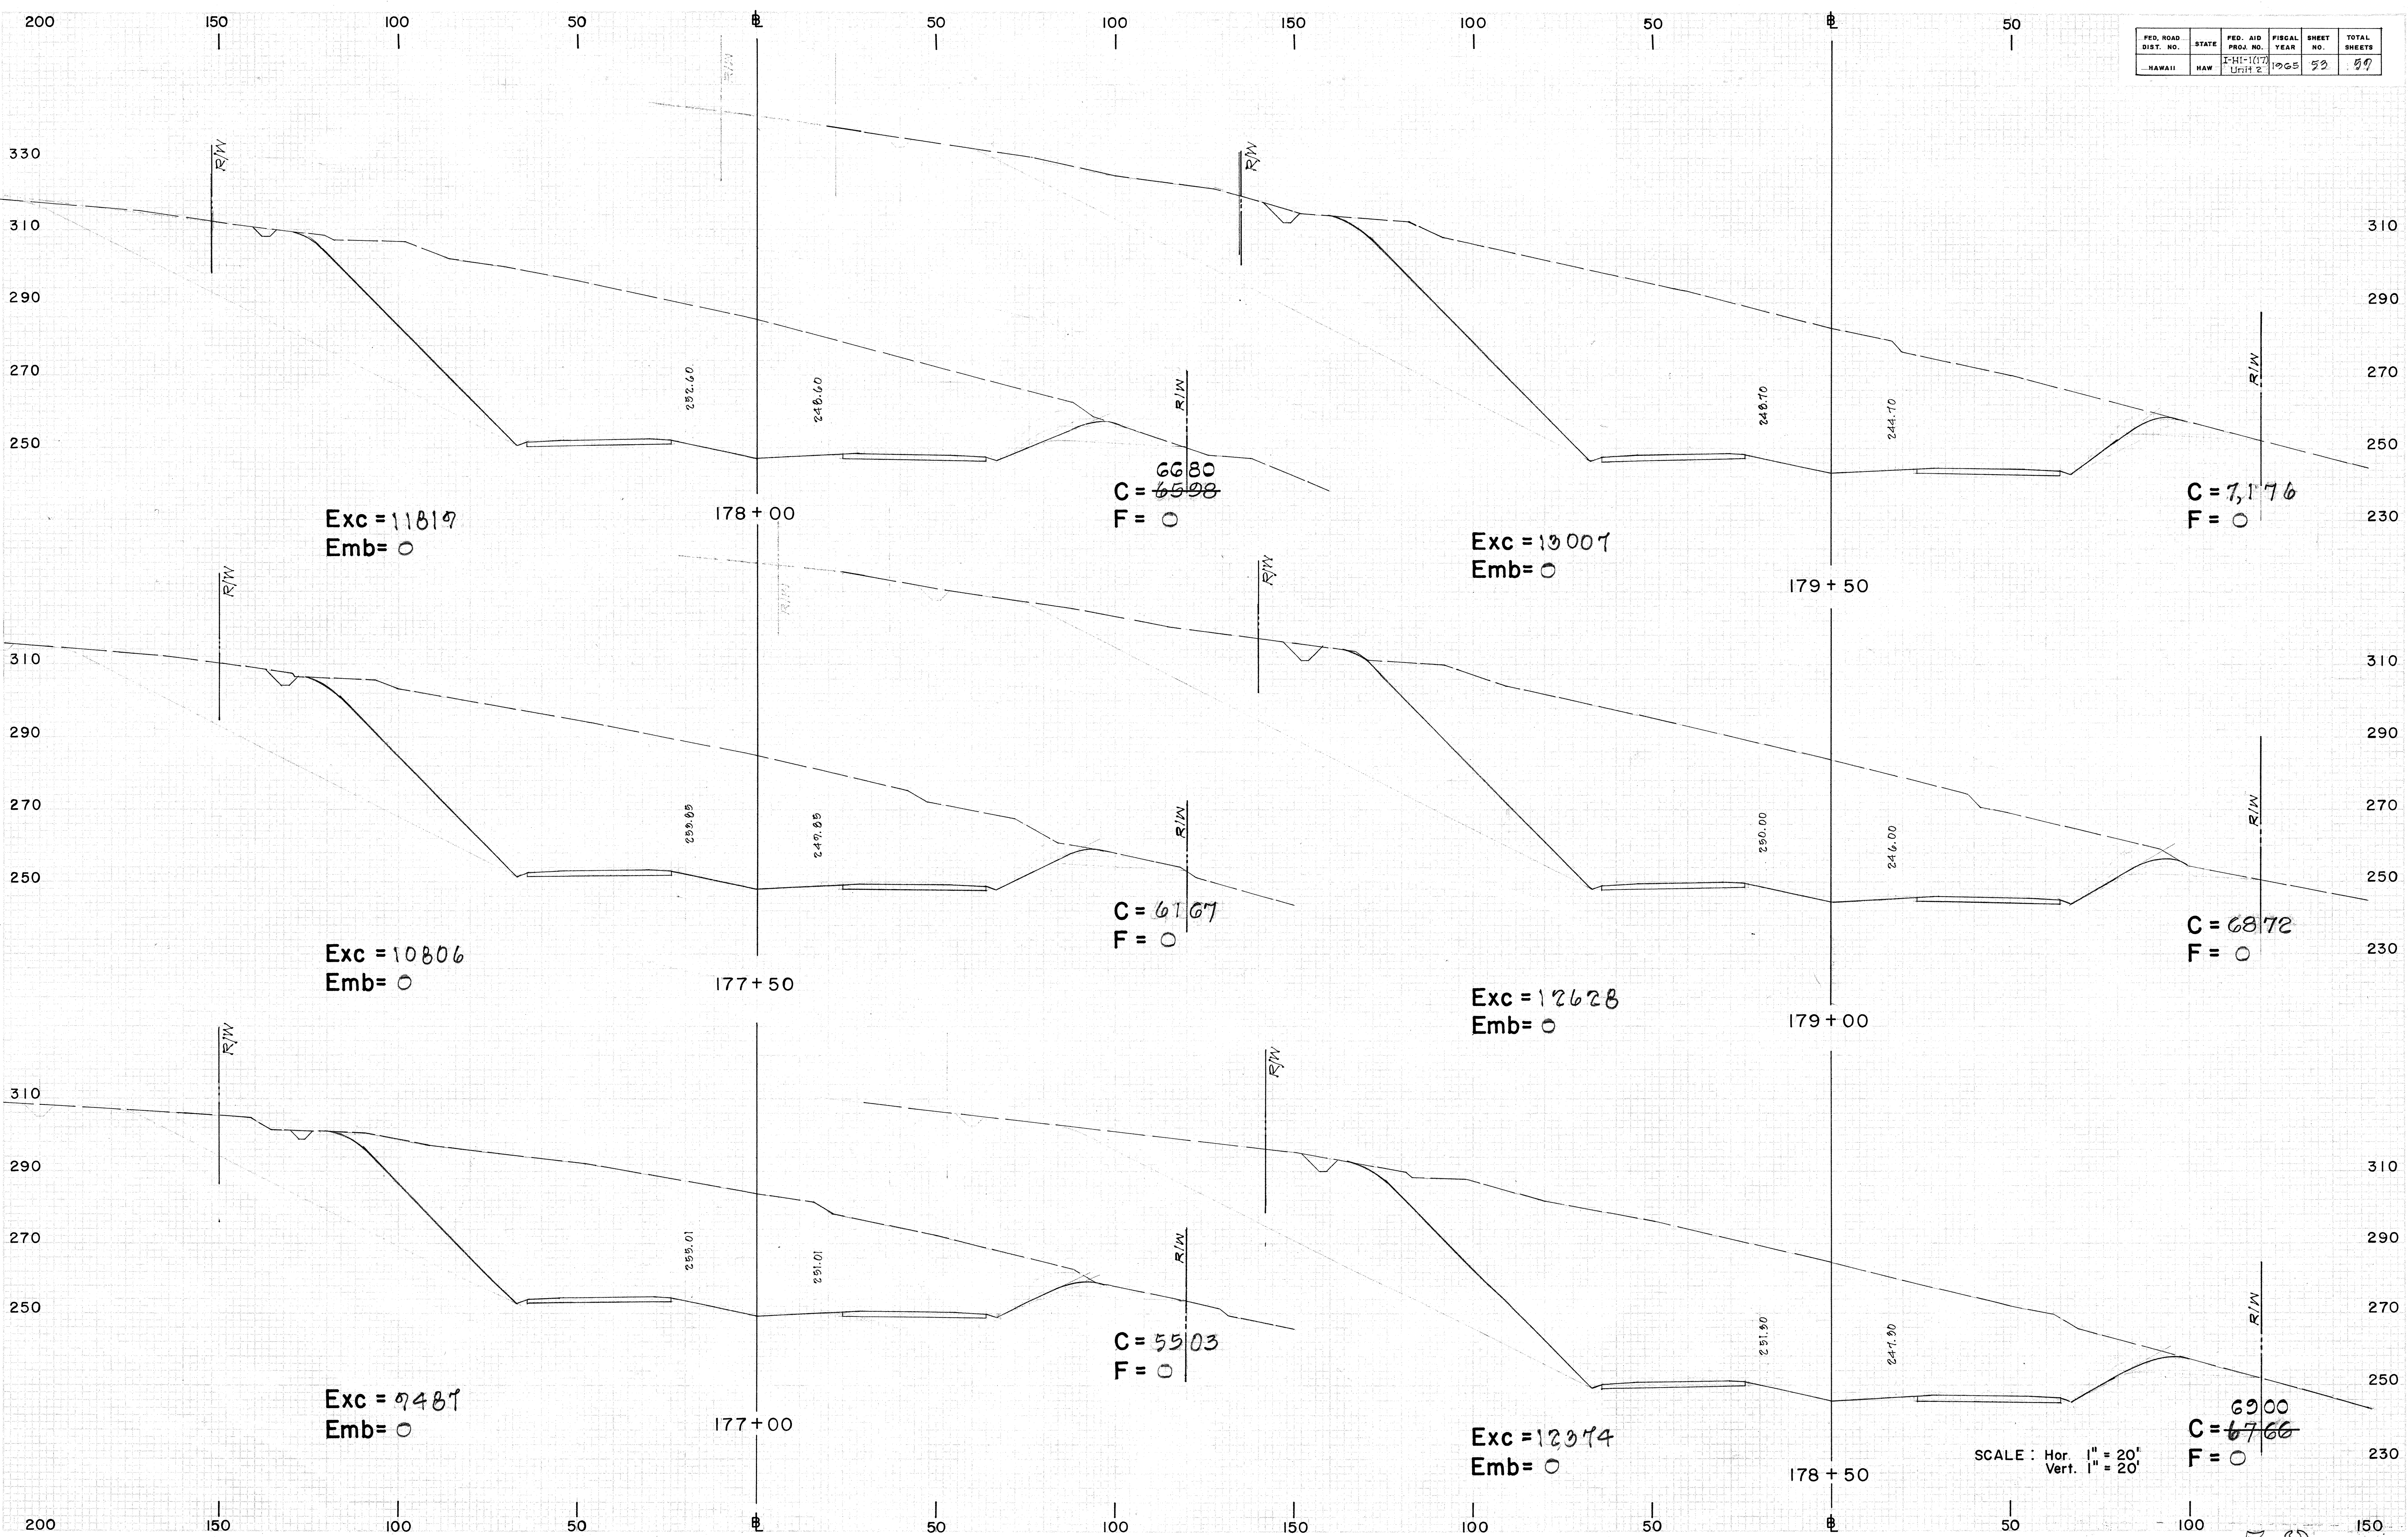


SCALE: Hor. 1" = 20'
 Vert. 1" = 20'

FED. ROAD DIST. NO.	STATE	FED. AID PROJ. NO.	FISCAL YEAR	SHEET NO.	TOTAL SHEETS
HAWAII	HAW	HA-117 Unit 2	1965	54	99

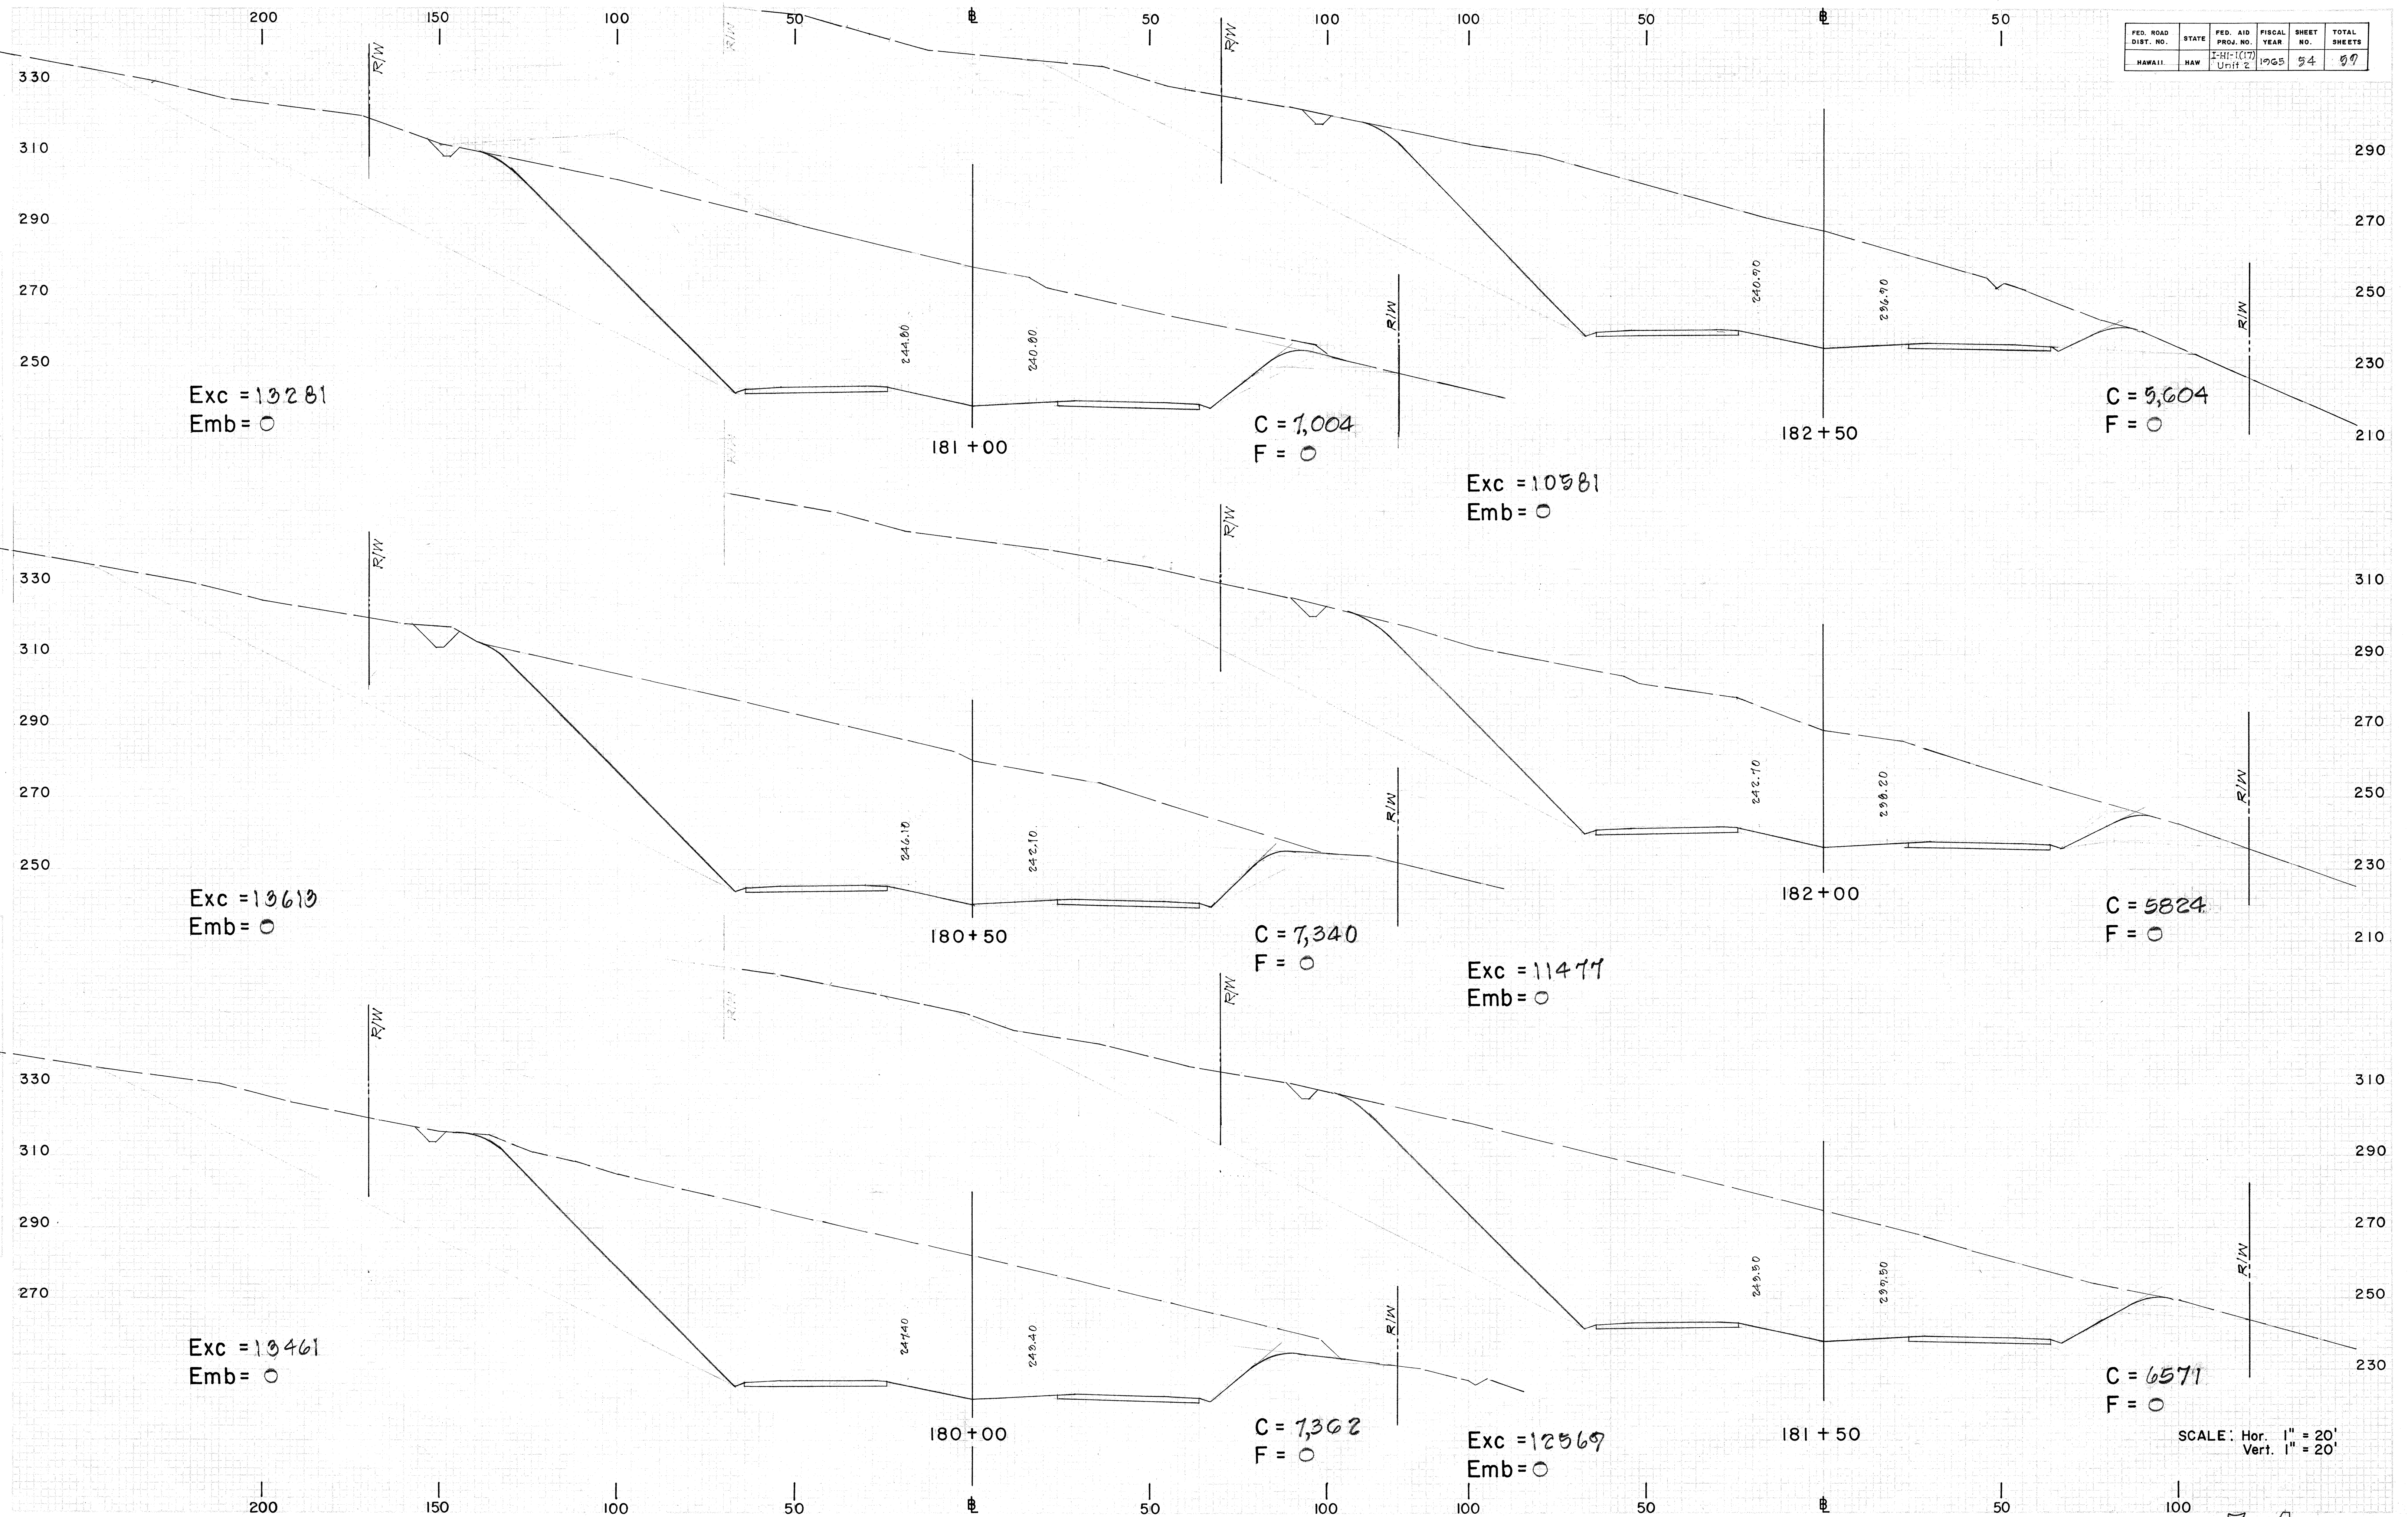

SCALE: Hor. 1" = 20'
Vert. 1" = 20'

FED. ROAD DIST. NO.	STATE	FED. AID PROJ. NO.	FISCAL YEAR	SHEET NO.	TOTAL SHEETS
HAWAII	HAW	I-HI-1(17) Unit 2	1965	55	59

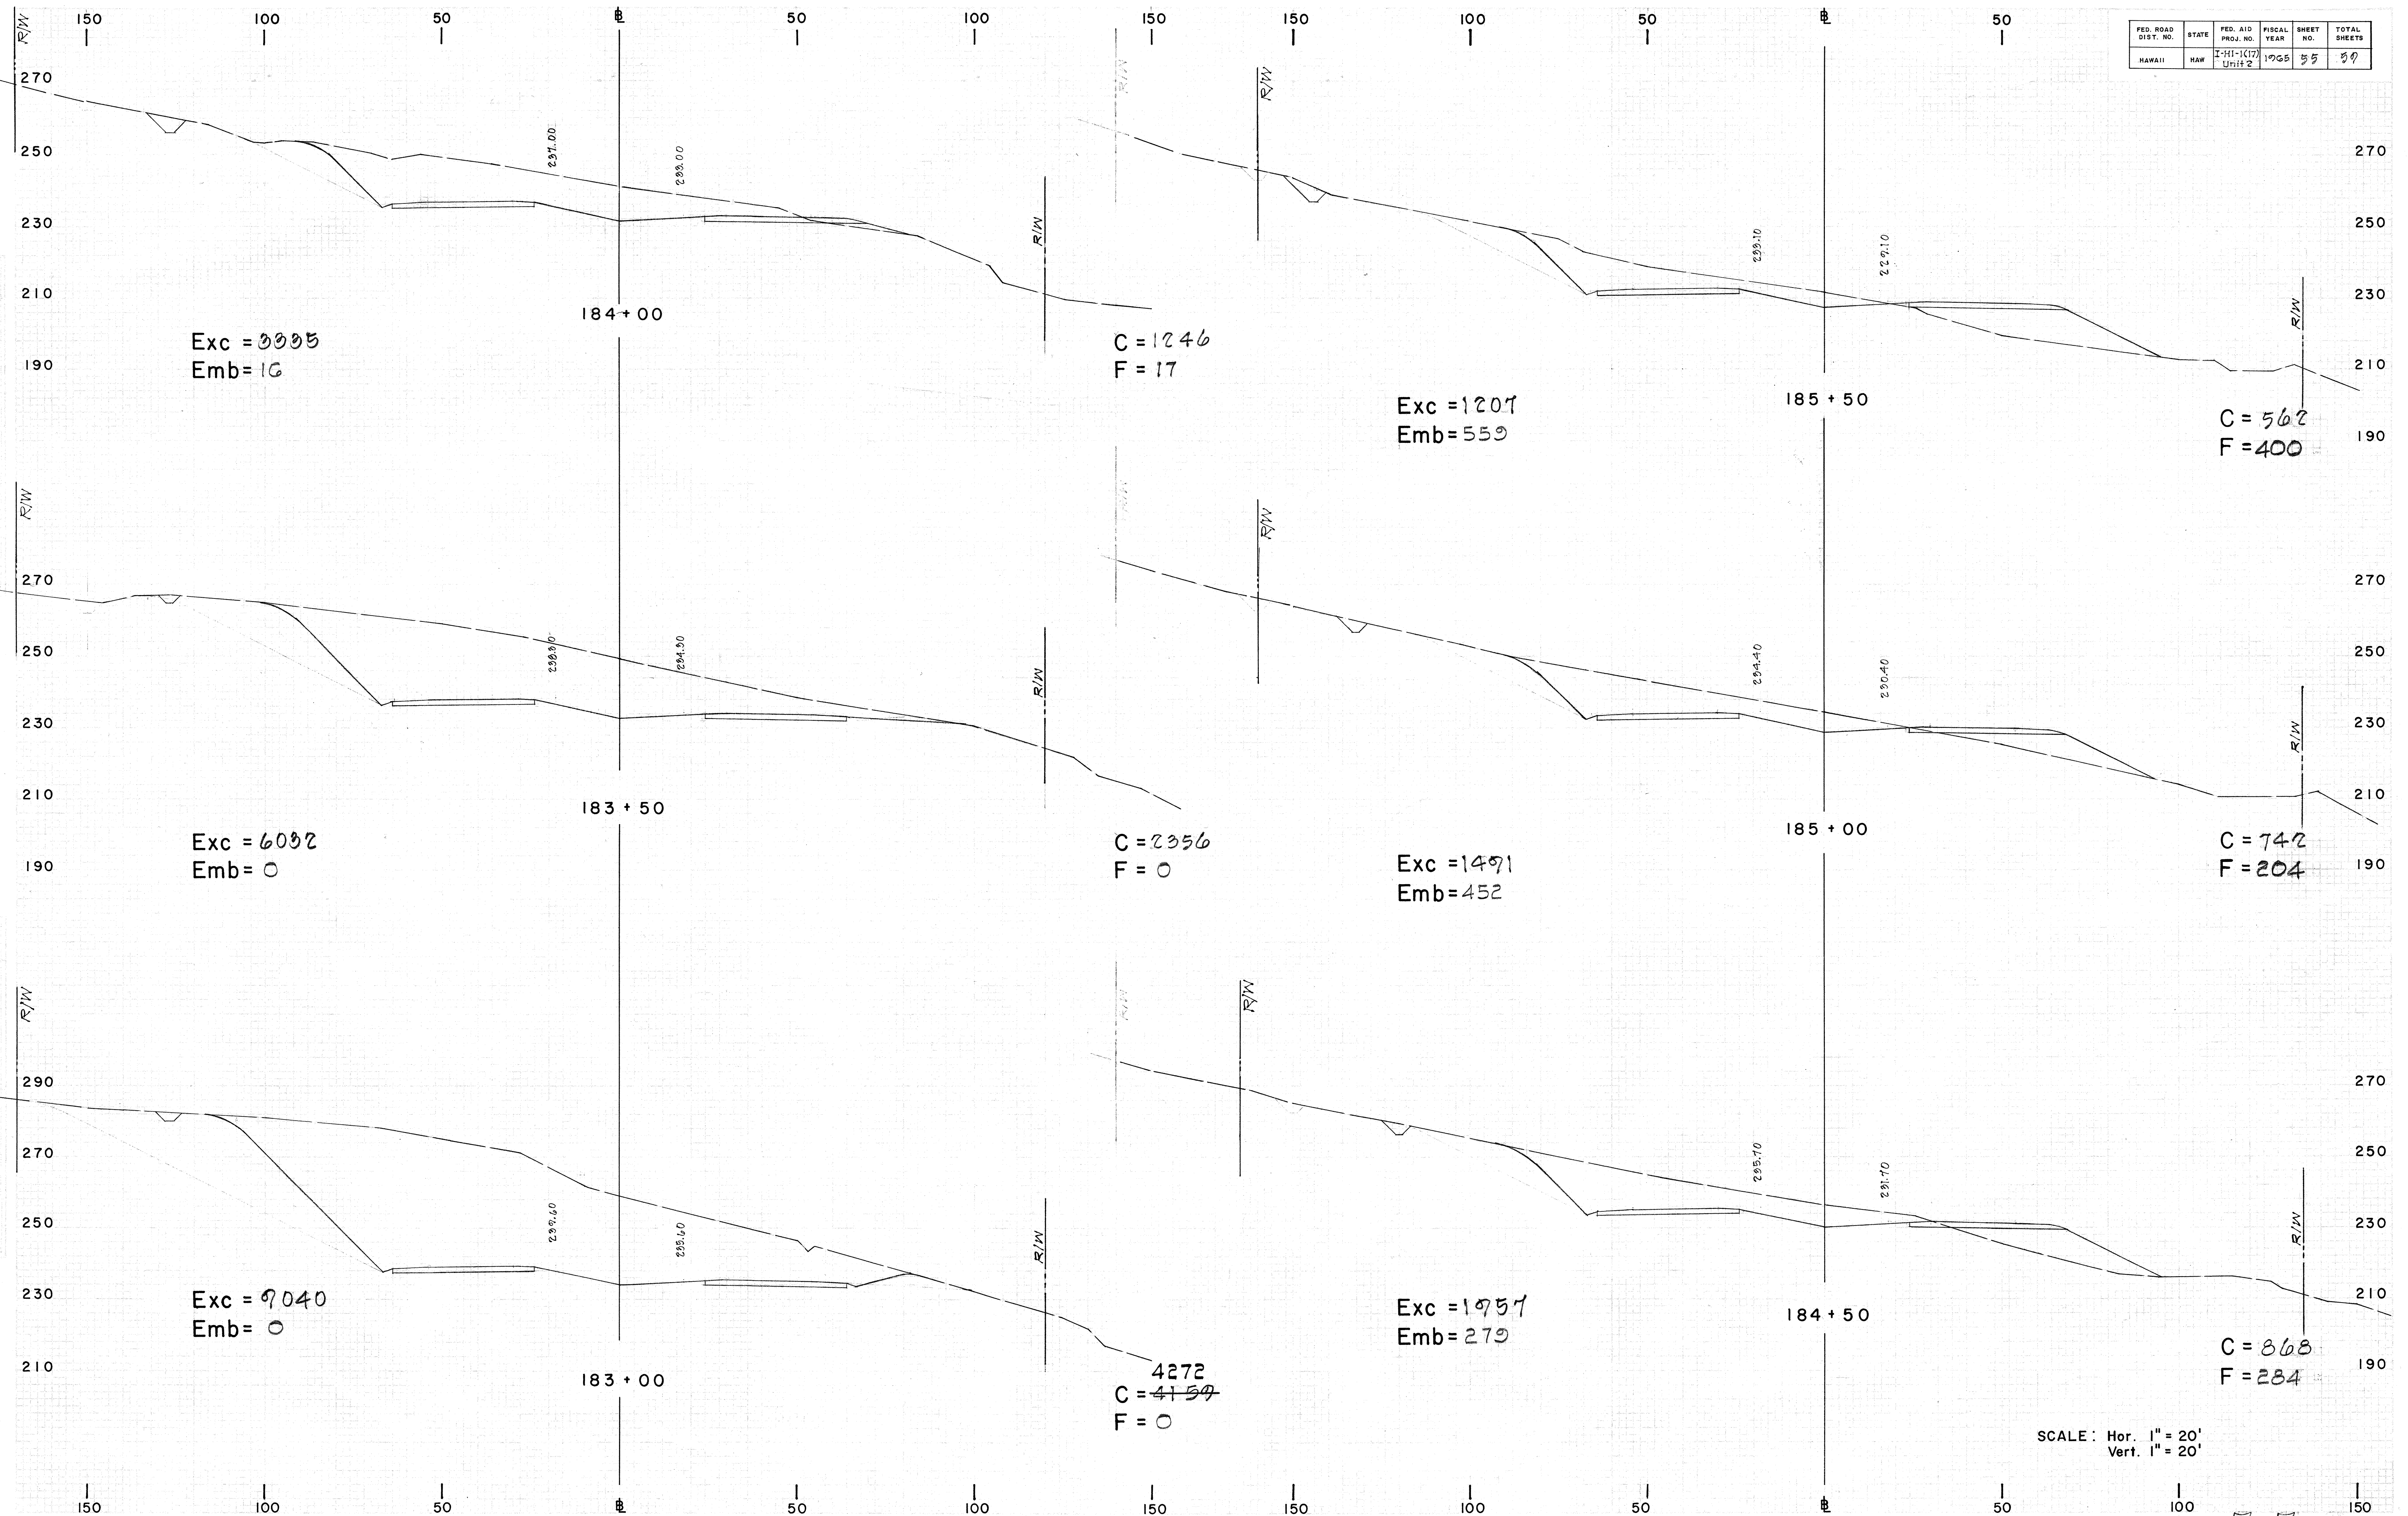


SCALE: Hor. 1" = 20'
Vert. 1" = 20'

55

00-13-11-3



FED. ROAD DIST. NO.	STATE	FED. AID PROJ. NO.	FISCAL YEAR	SHEET NO.	TOTAL SHEETS
HAWAII	HAW	I-41-(17) Unit 2	1965	56	99

Revised: 3/25/65

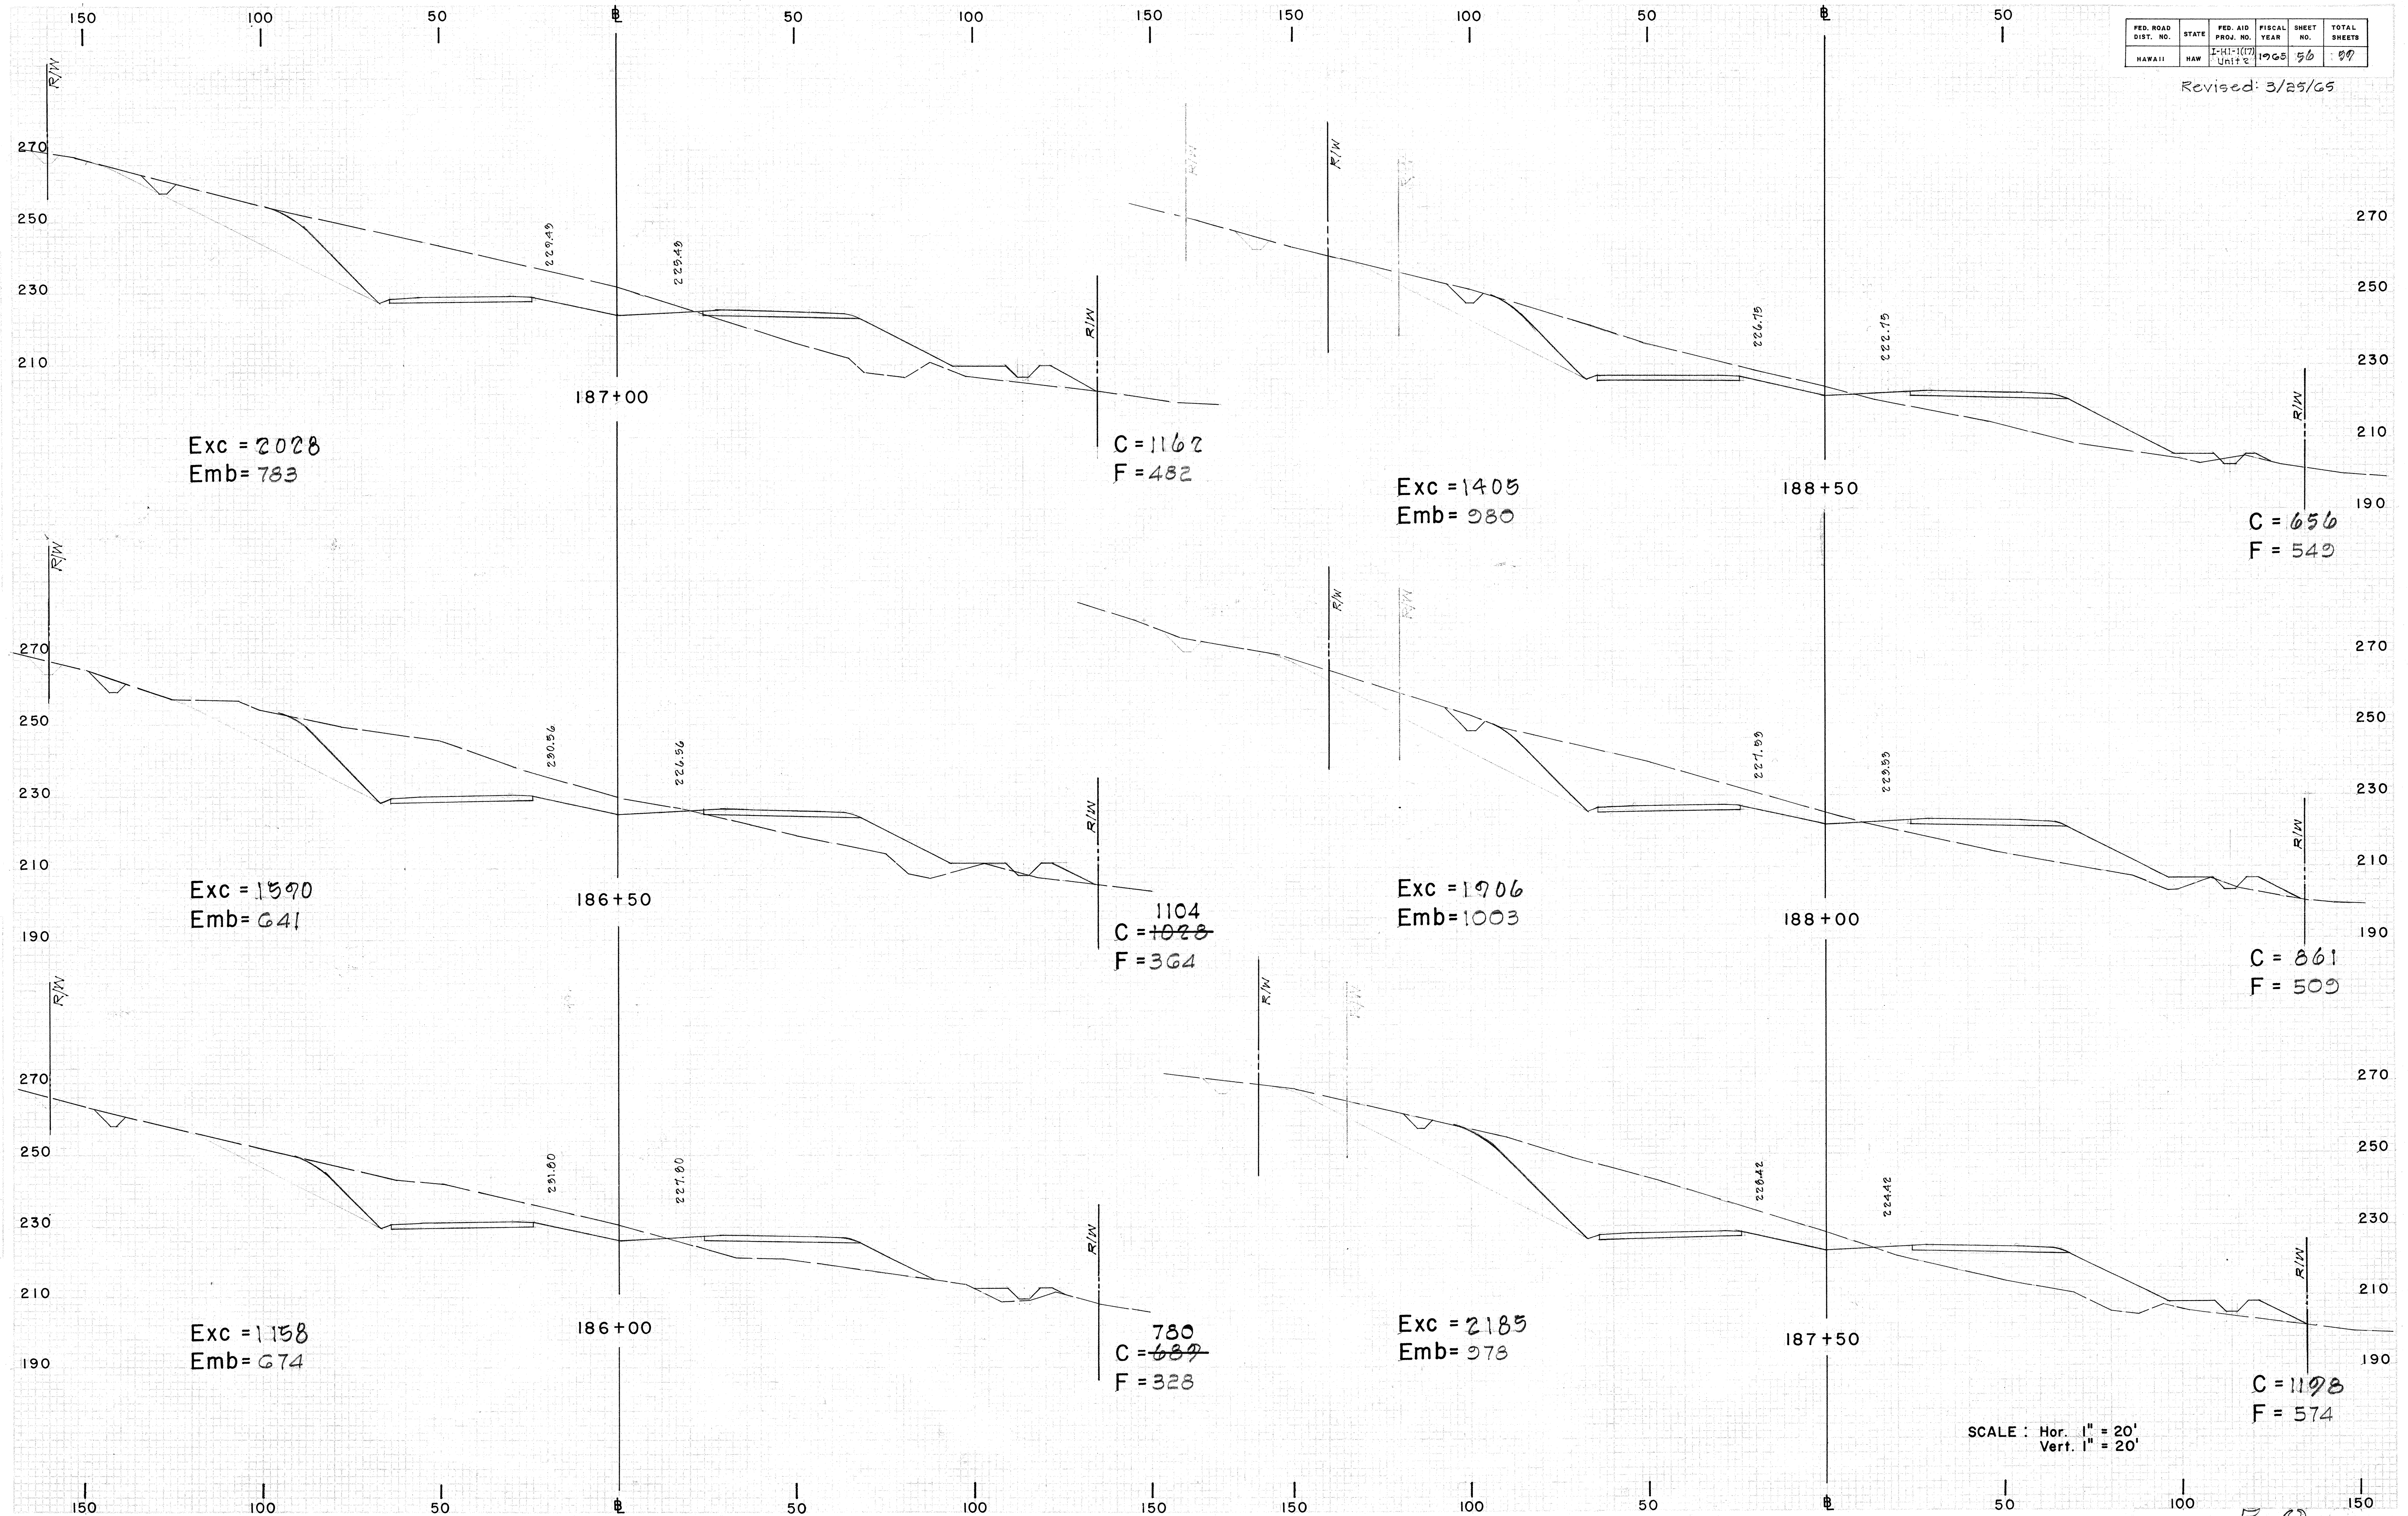

FED. ROAD DIST. NO.	STATE	FED. AID PROJ. NO.	FISCAL YEAR	SHEET NO.	TOTAL SHEETS
HAWAII	HAW.	I-41-107 Unit 2	1965	57	59


Revised: 3/25/65

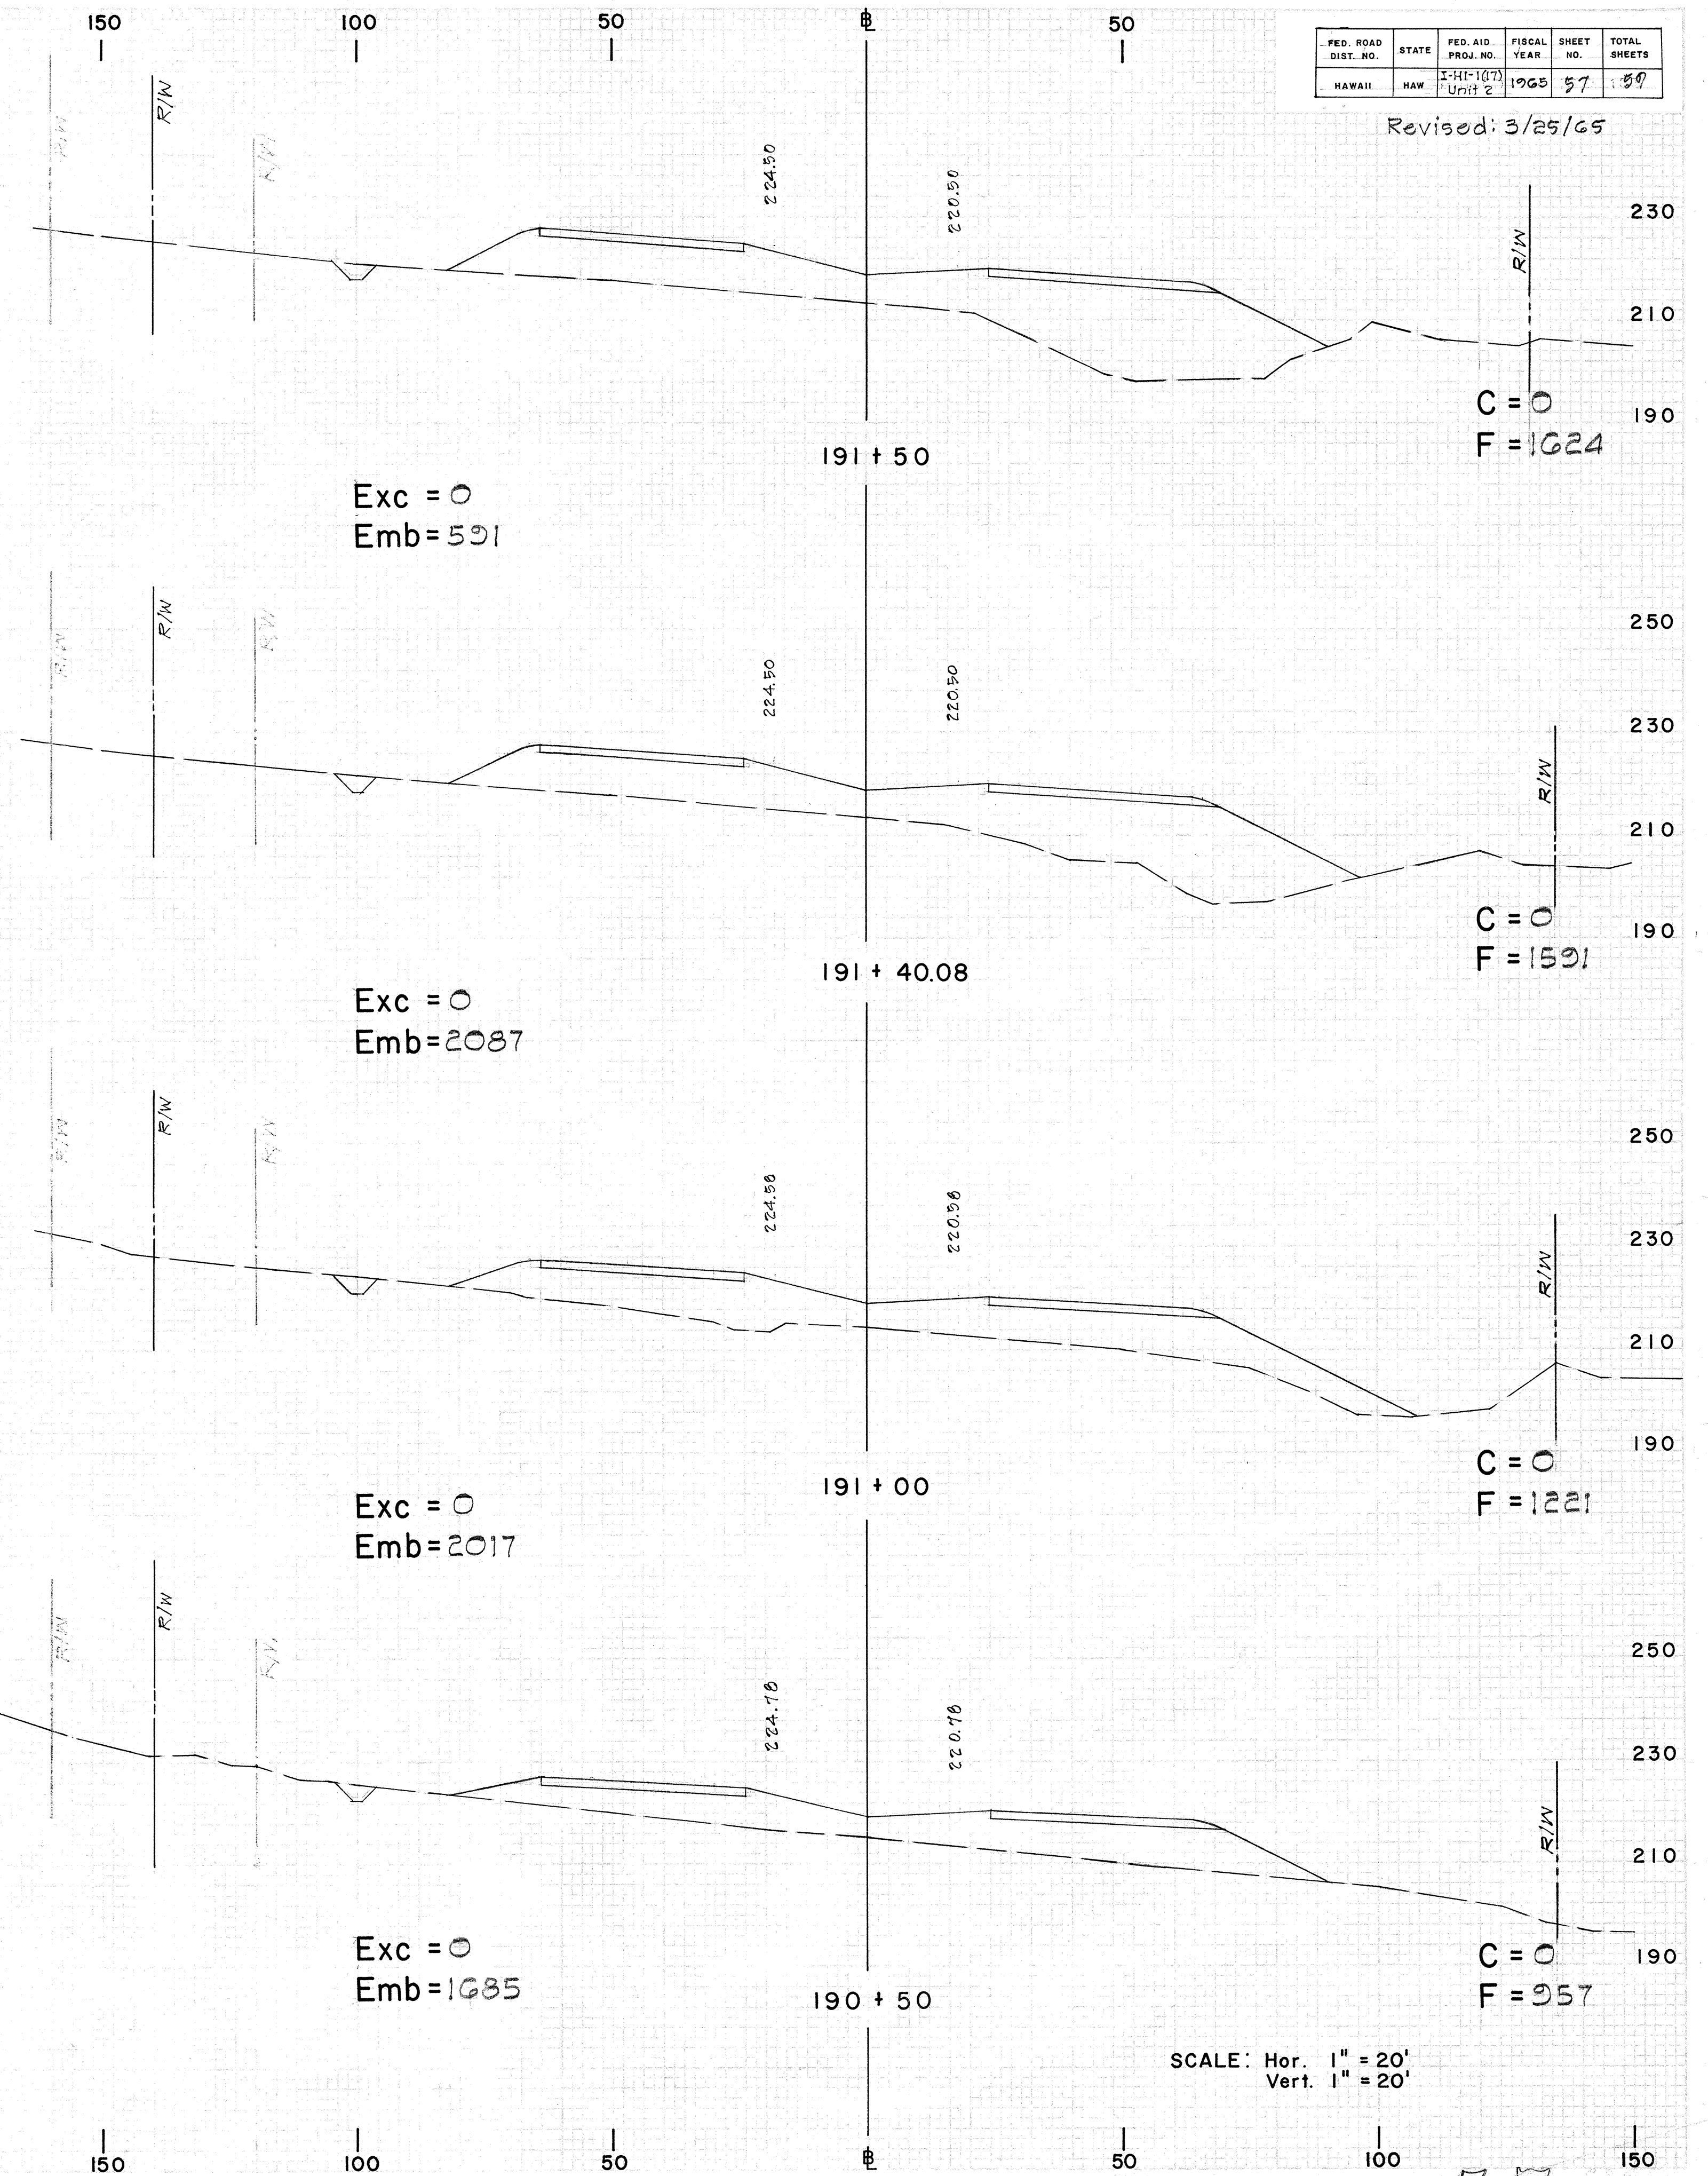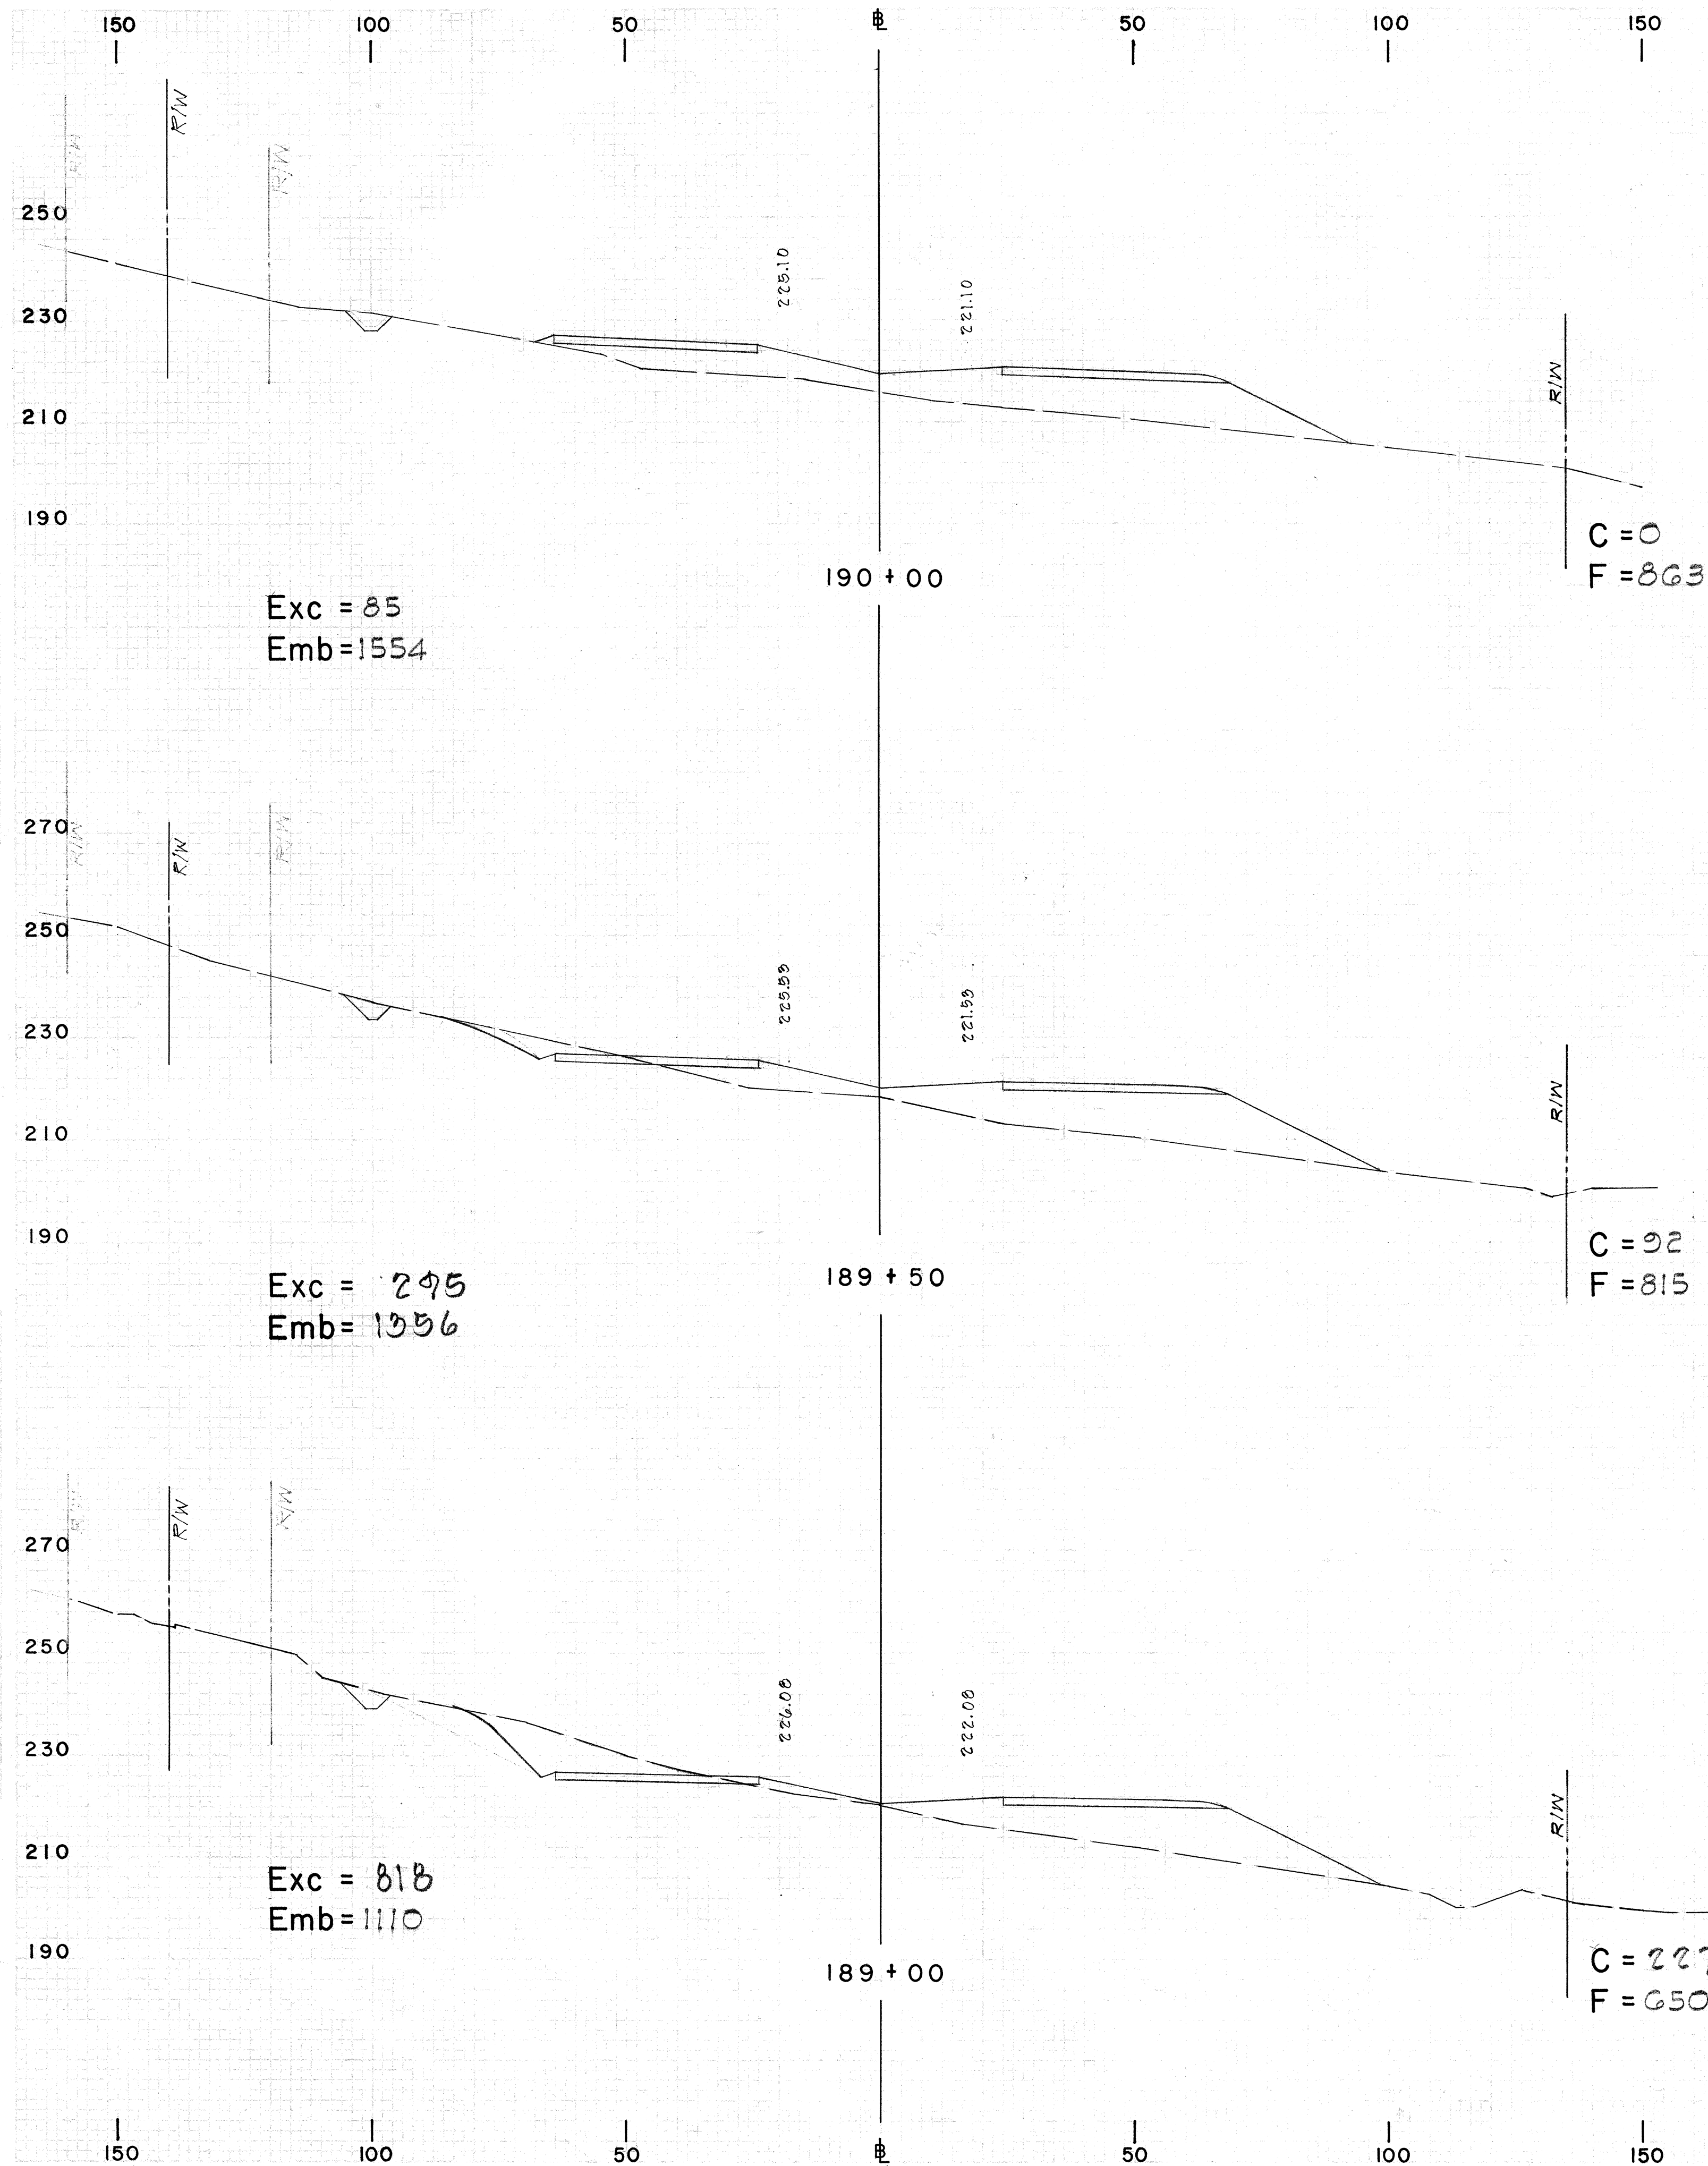

SCALE: Hor. 1" = 20'
Vert. 1" = 20'

FED. ROAD DIST. NO.	STATE	FED. AID PROJ. NO.	FISCAL YEAR	SHEET NO.	TOTAL SHEETS
HAWAII	HAW	1-HI-107 Unit 2	1965	58	89

Revised 3/25/65

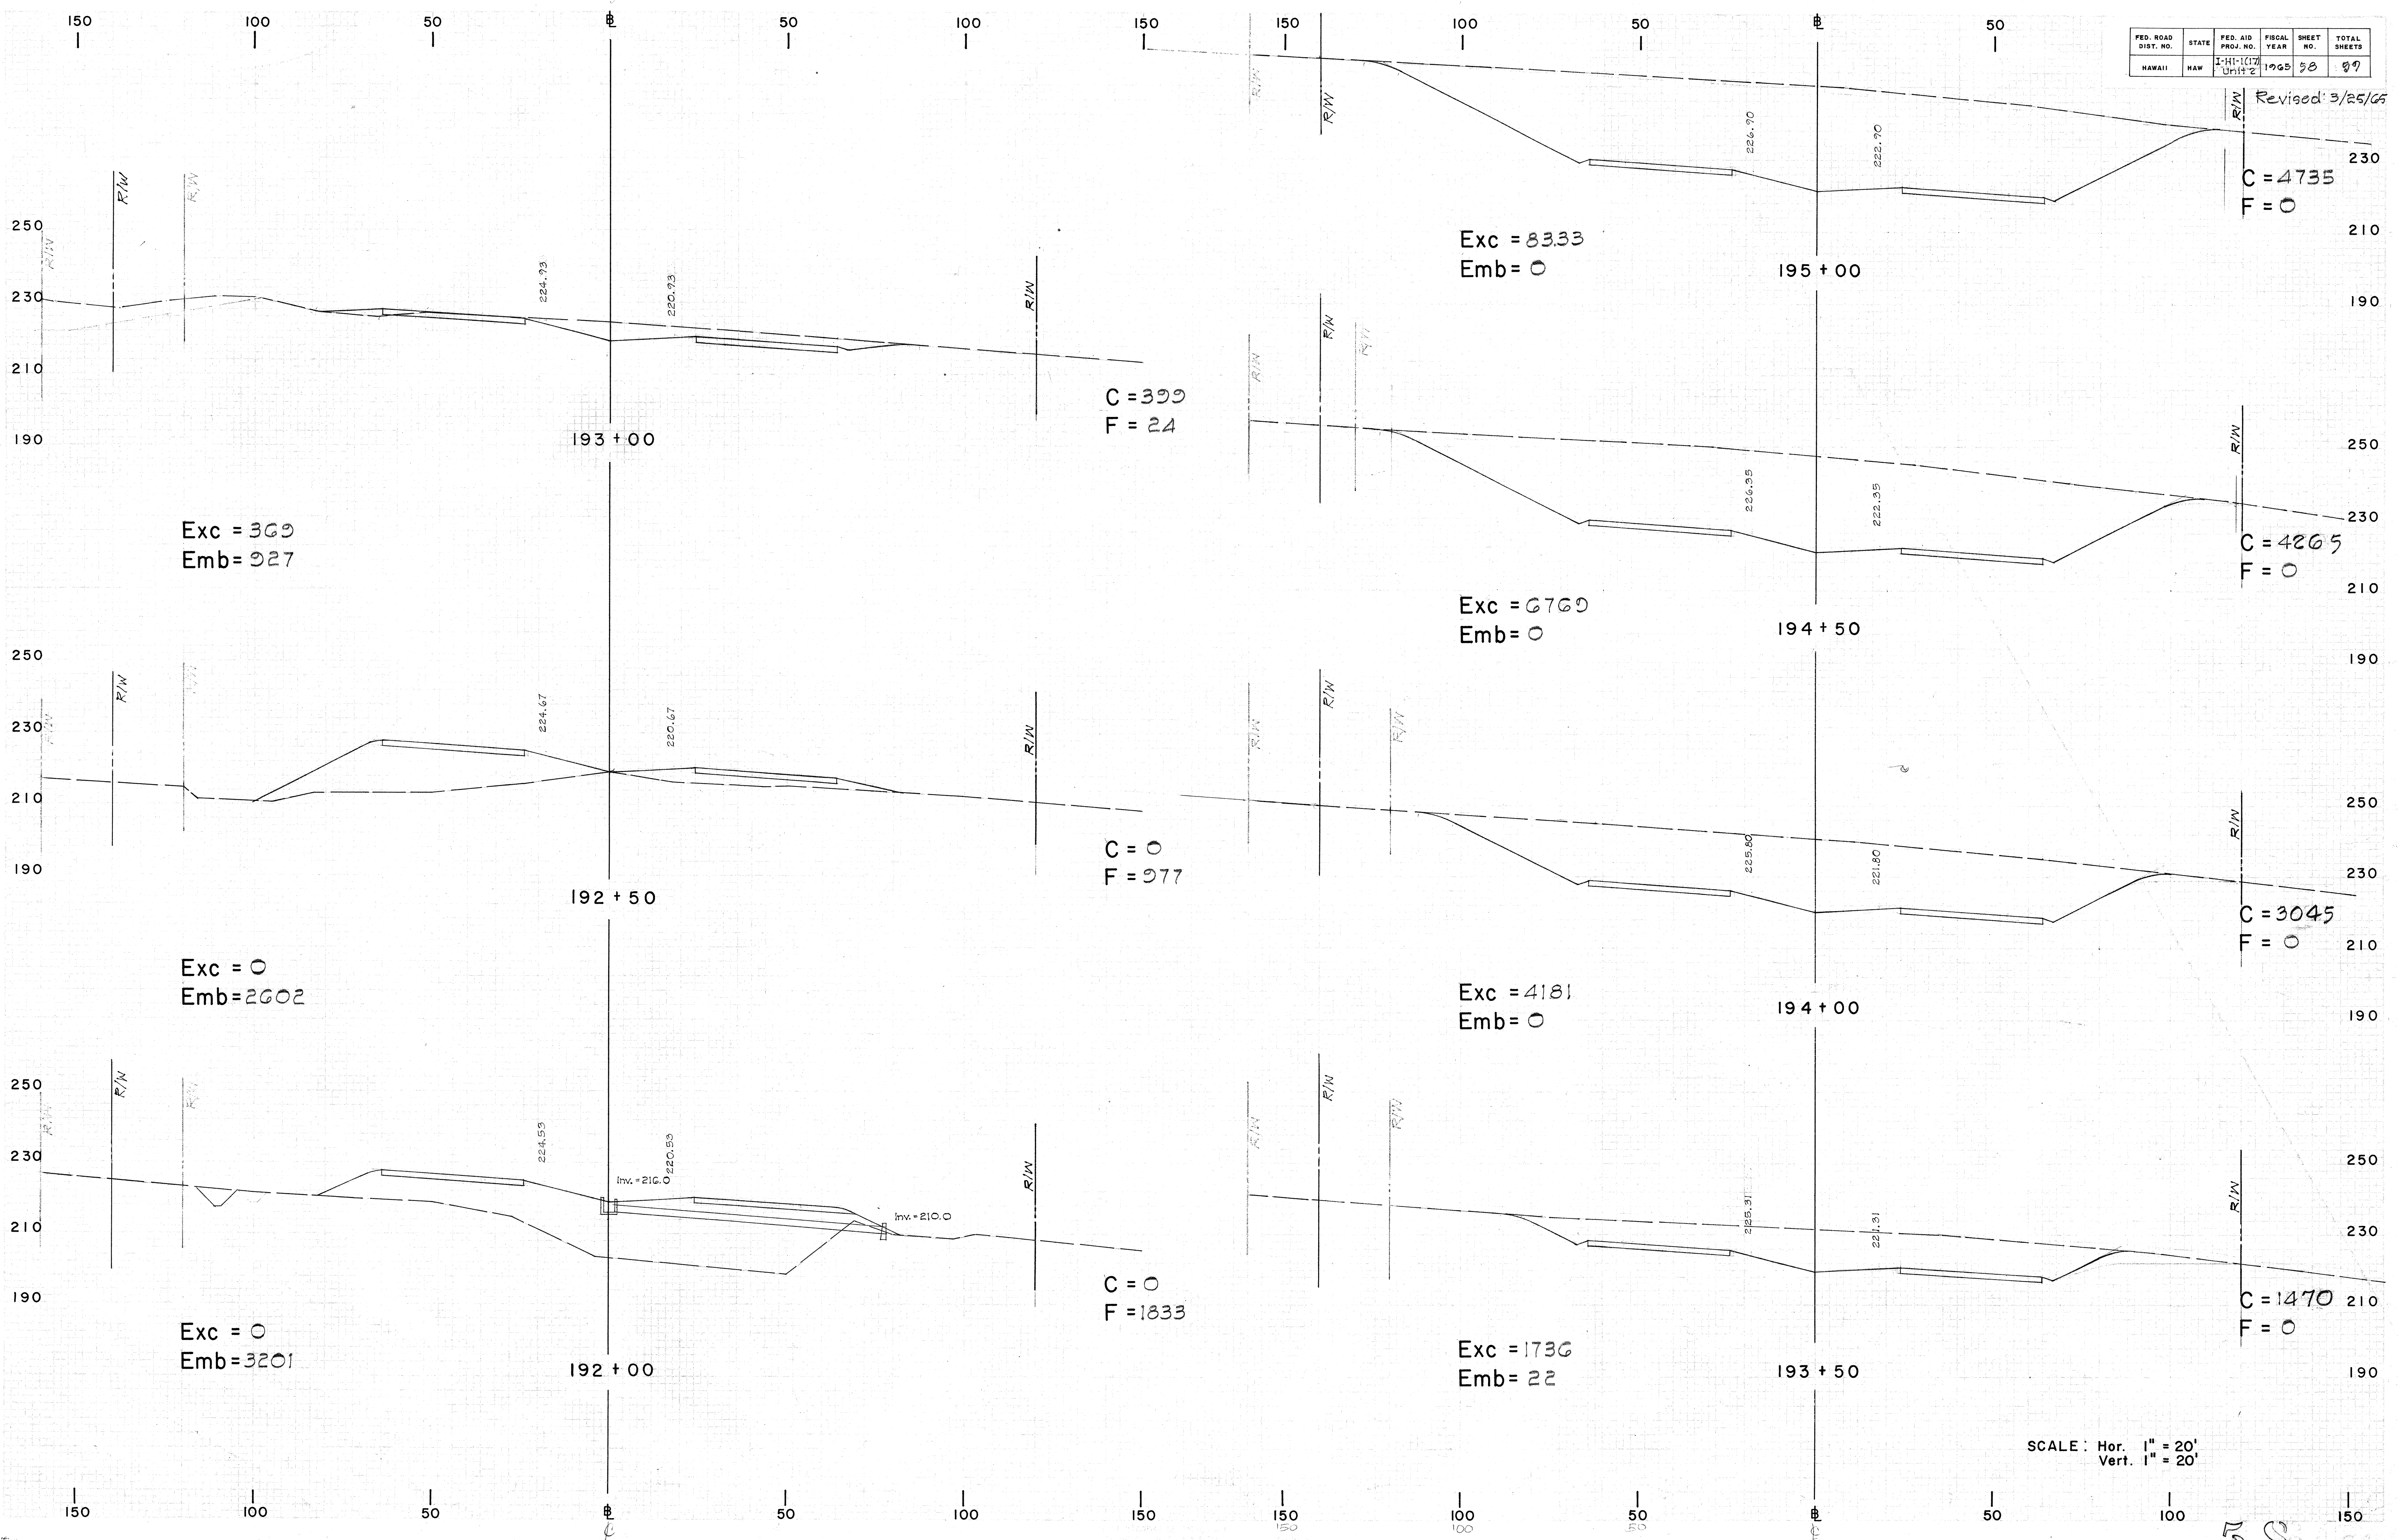

SCALE: Hor. 1" = 20'
Vert. 1" = 20'

58

DD-413

FED. ROAD DIST. NO.	STATE	FED. AID PROJ. NO.	FISCAL YEAR	SHEET NO.	TOTAL SHEETS
HAWAII	HAW.	I-H-1(17) UNIT 2	1965	50	50

Revised: 3/25/65

