

STATE OF HÁWAII

DEPARTMENT OF TRANSPORTATION
HIGHWAYS DIVISION

HONOLULU, HAWAII
"AS BUILT"
PLANS FOR

CONSTRUCTION OF A PORTION OF

INTERSTATE ROUTE H-1

BARBERS POINT TO KUNIA ROAD


(MAKAKILO TO PALEHUA ROAD)

FEDERAL AID INTERSTATE PROJECT No. I-HI-I(17) UNIT 2


GRADING AND STRUCTURES

DISTRICT OF EWA ISLAND OF OAHU

SCALES:

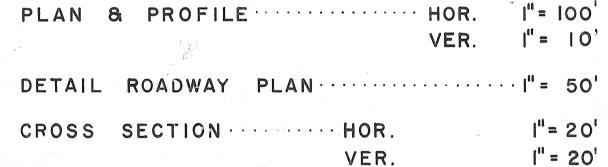



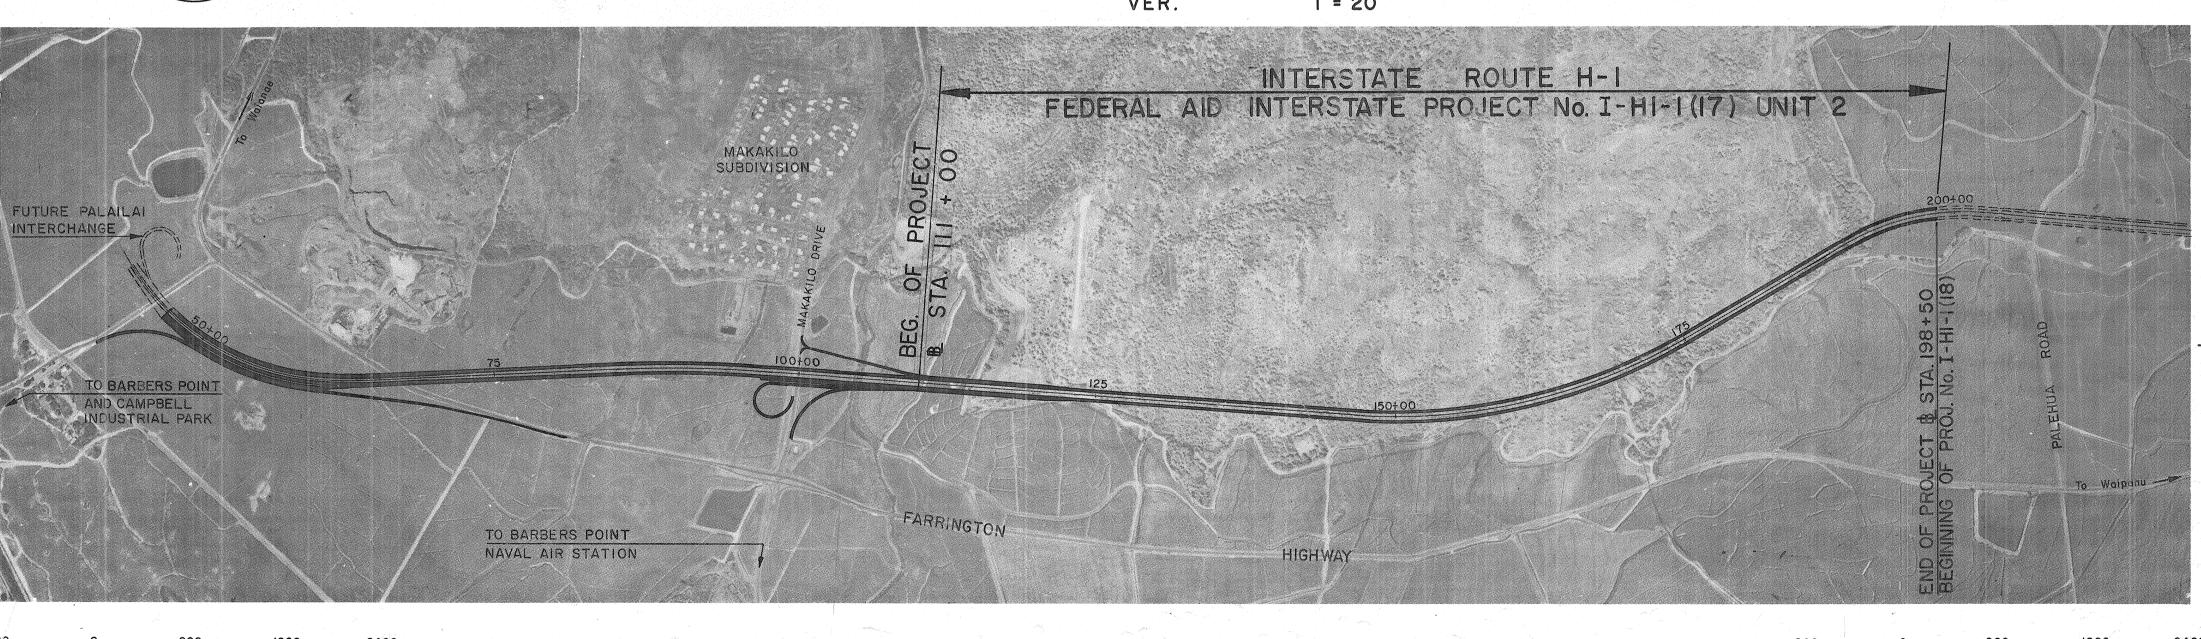

DESIGN CLASSIFICATION

LOCATION OF PROJECT NO.


Federal Aid Projects Previously Constructed Or Under Construction

ADT (1962) 9,000
DESIGN ADT (1984) 31,700
DHV 11 %
D 60/40
T 8 %
V 70 M.P.H.

NOTE:

ALL CHANGES MADE DURING CONSTRUCTION HAVE BEEN NOTED ON THESE TRACINGS IN RED AND CHECKED BY:

J. J. Jakakawa PROJECT ENGINEER OCC-12, 1967 DATE

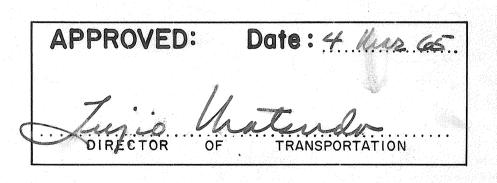

DEPARTMENT OF COMMERCE
BUREAU OF PUBLIC ROADS

APPROVED:

John B Dalhous March 30,1965

DIVISION ENGINEER DATE

LAYOUT

800 0 800 1600 <u>2</u>

GROSS LENGTH OF PROJECT 1.657 MI BRIDGES OVER 20.00' SPAN 0.000 MI NET LENGTH OF ROADWAY 1.657 MI.

PLAN

ORIG:NAL DESIGNED BY DESIGNED BY DRAWN BY TRACED BY OUANTITIES BY OUANTITIES BY CHECKED BY CHECKED

3