

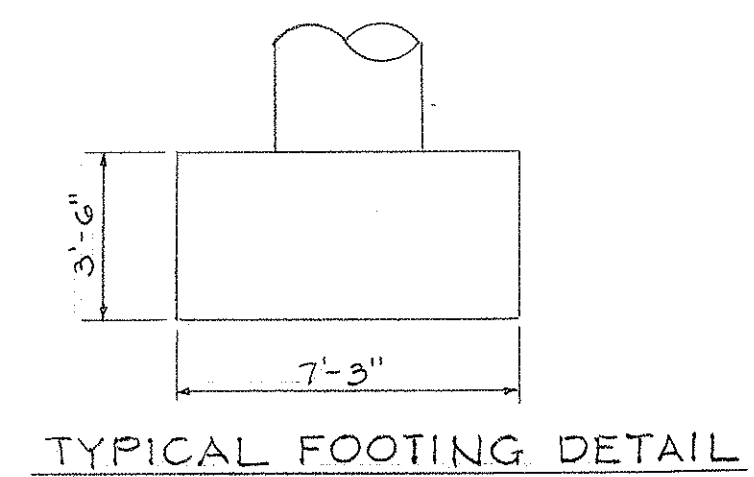
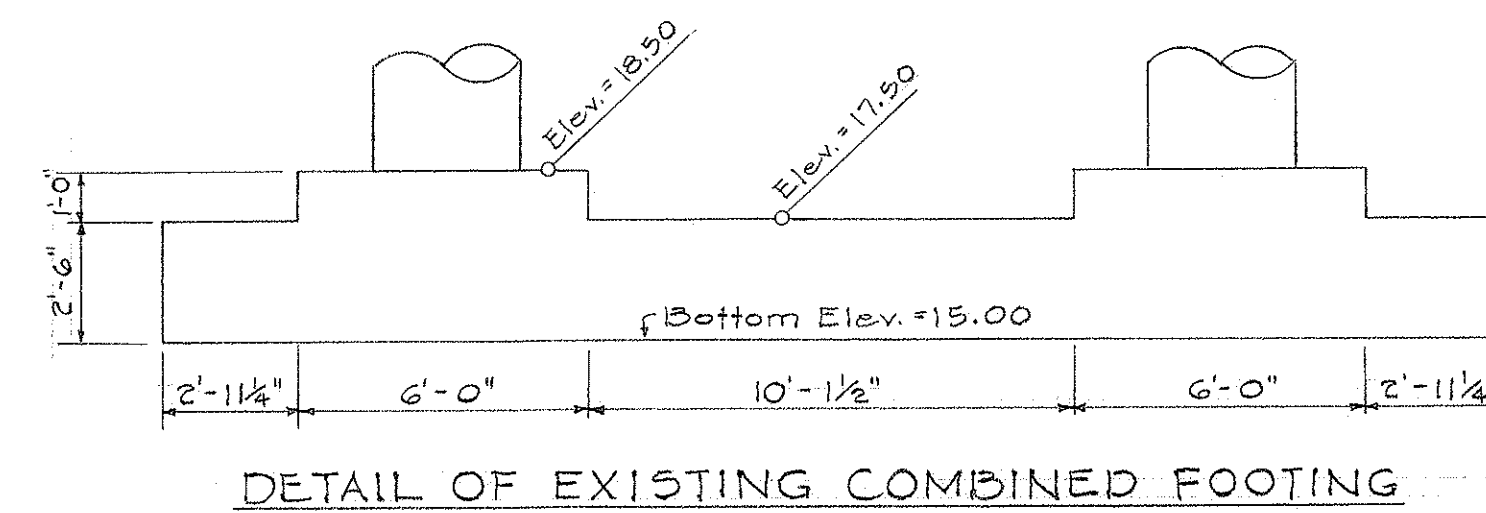
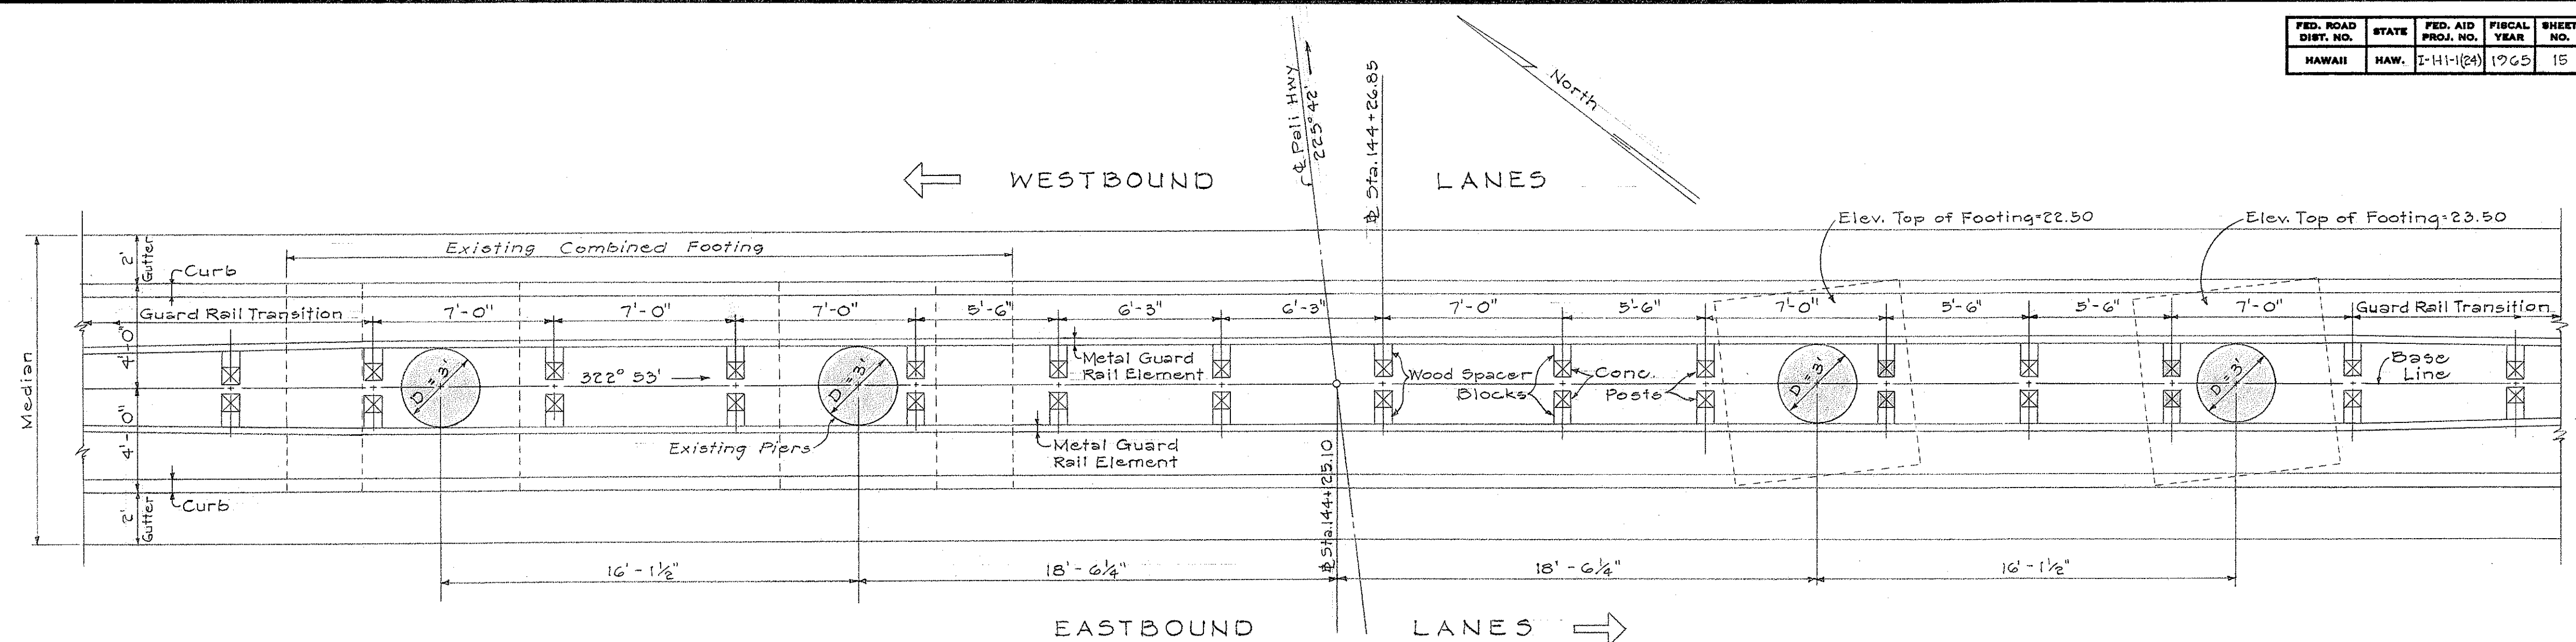
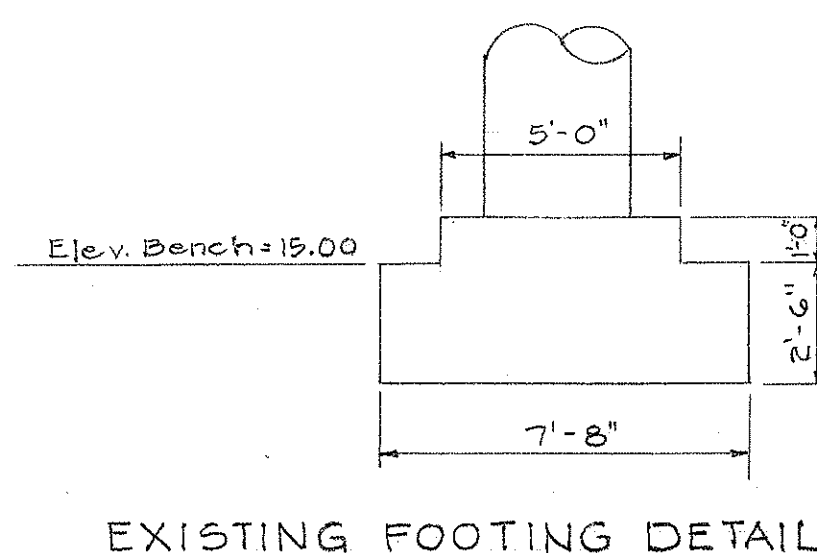


FED. ROAD DIST. NO.	STATE	FED. AID PROJ. NO.	FISCAL YEAR	SHEET NO.	TOTAL SHEETS
HAWAII	HAW.	I-141-1(24)	1965	15	64

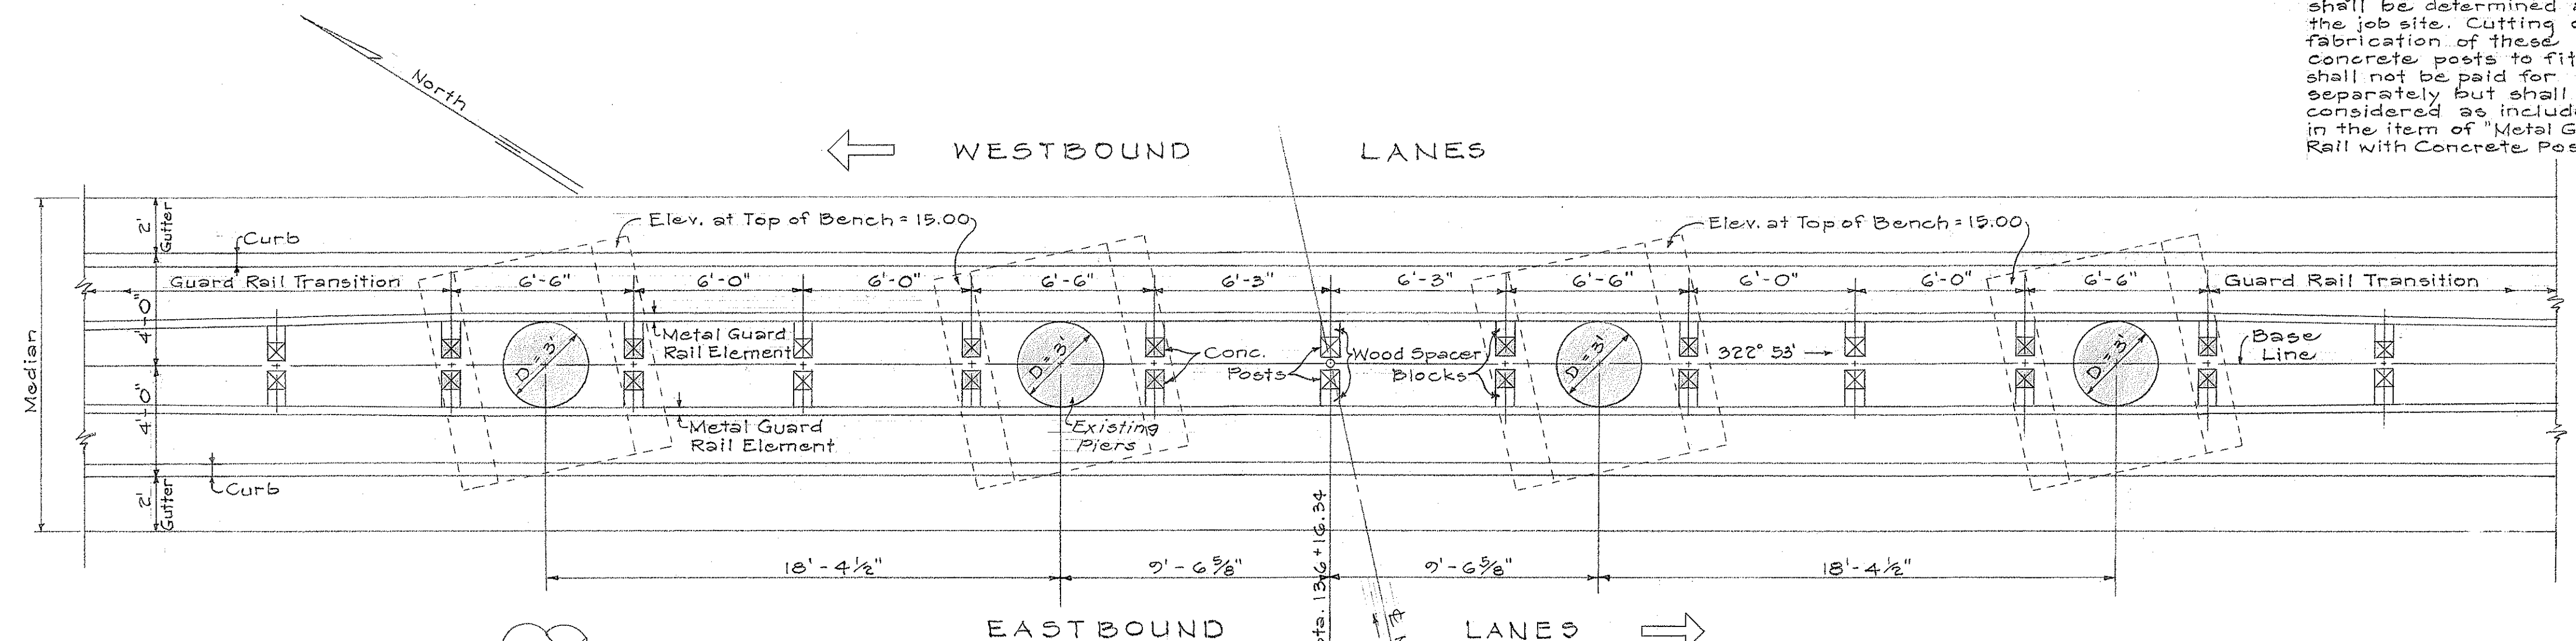

PLAN OF GUARD RAIL POST SPACING AT EXISTING STRUCTURE NO. 1 PIERS (PALI HIGHWAY SEPARATION)
Scale: 1/4" = 1'-0"

NOTE: Concrete Guard Rail Posts that are shown shaded shall be less than the normal 6 feet in length, and shall rest on top of the existing concrete footings. Exact lengths of these posts shall be determined at the job site. Cutting or fabrication of these concrete posts to fit shall not be paid for separately but shall be considered as included in the item of "Metal Guard Rail with Concrete Posts".

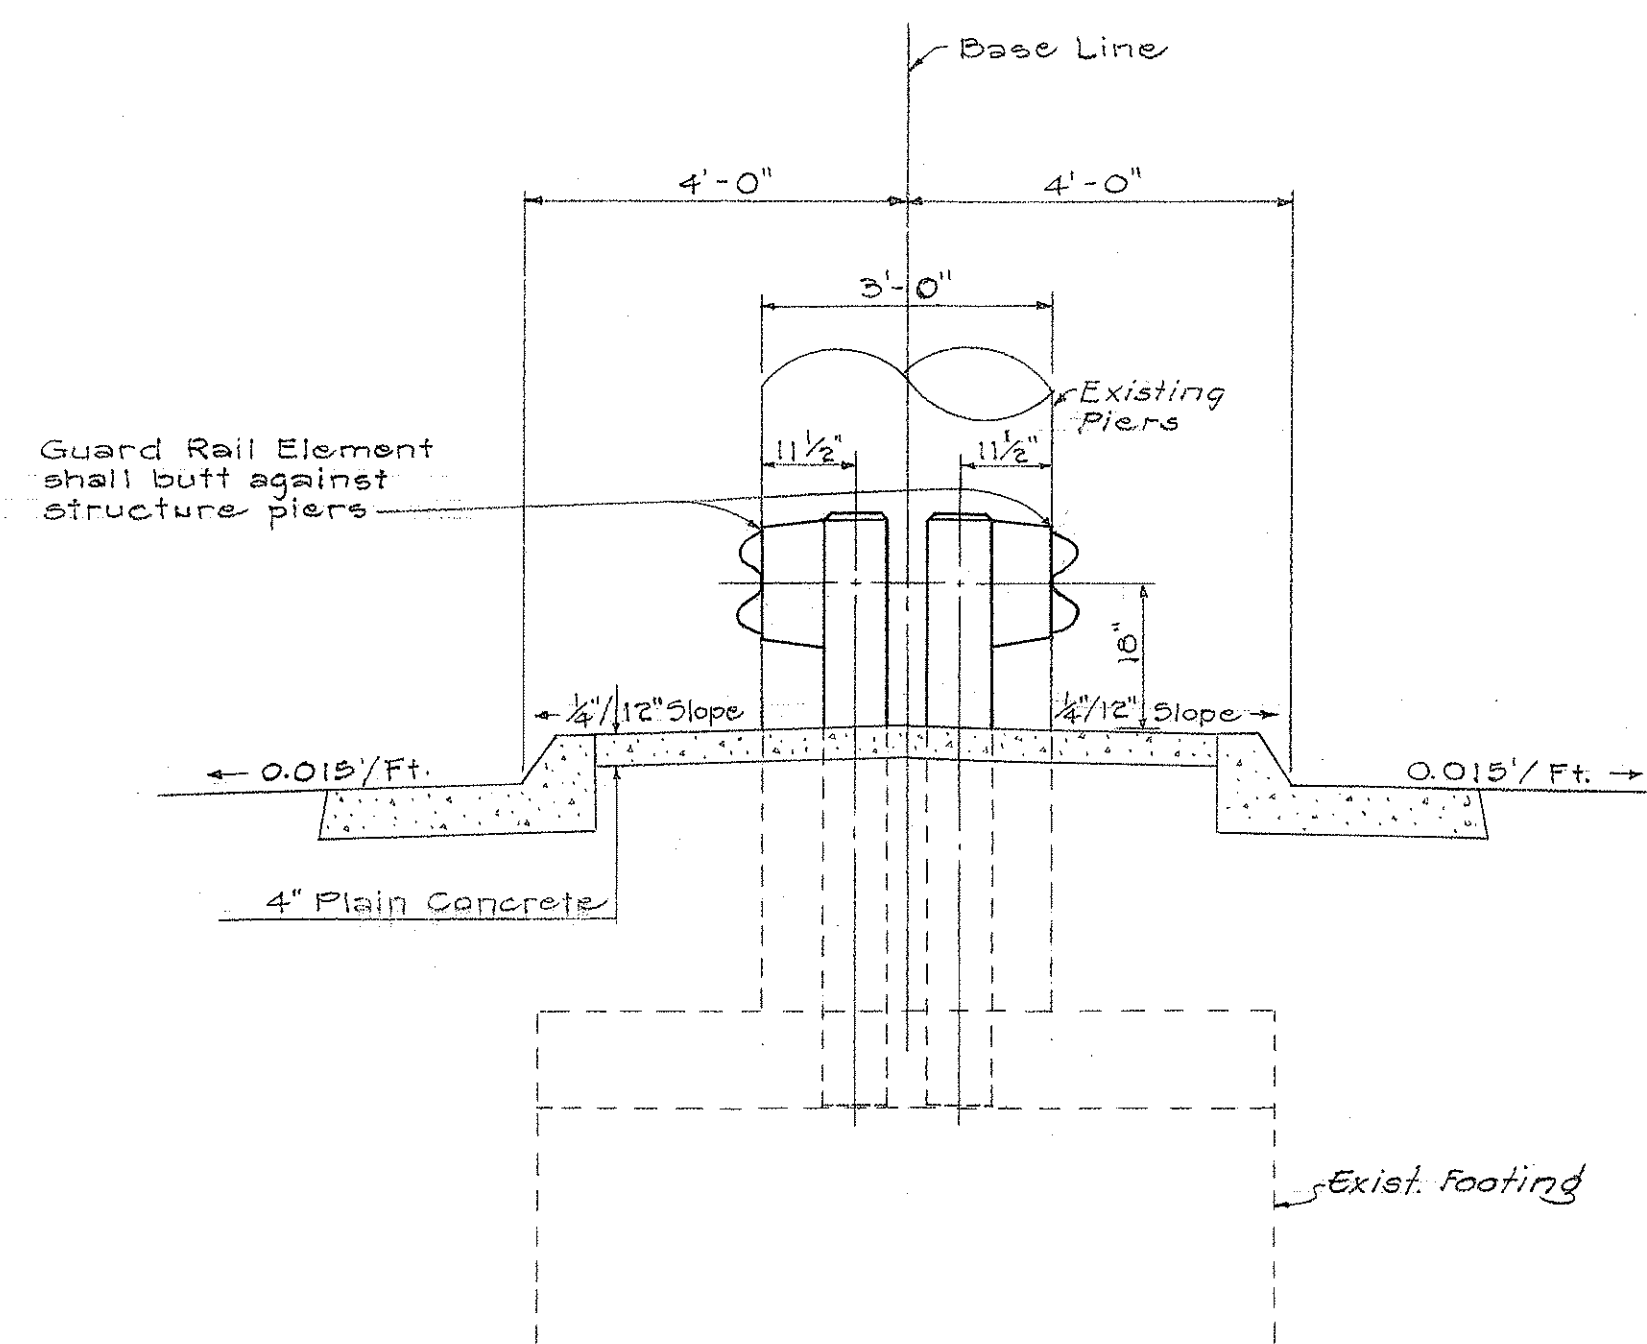

TYPICAL GUARD RAIL POST AND ELEMENT SETTING DETAIL AT STRUCTURE PIERS
Scale: 1/2" = 1'-0"

PLAN OF GUARD RAIL POST SPACING AT EXISTING STRUCTURE NO. 11 PIERS (NUUANU AVENUE SEPARATION)
Scale: 1/4" = 1'-0"

STATE OF HAWAII DEPARTMENT OF TRANSPORTATION HIGHWAYS DIVISION					
DETAILS OF GUARD RAIL POST SPACING AT EXISTING SEPARATION STRUCTURE PIERS					
INTERSTATE HIGHWAY (LUNALILO FWY) F.A.I. PROJ. NO. I-141-1(24)					
SCALE: AS NOTED					
JUNE, 1965					
SHEET No. 15 OF 64 SHEETS					