


SPRINKLER HEAD SPECIFICATIONS

TYPE OF HEAD	DESCRIPTION	RADIUS (FT.) SEE NOTE 1	PRESSURE (PSI) SEE NOTE 2	FLOW (GPM) SEE NOTE 3	RISER SIZE (IN.)
L-9 F	Lawn - Full Circle	9	15	2.5	1/2
L-10 F	Lawn - Full Circle	10	20	3.0	1/2
L-8 H	Lawn - Half Circle	8	10	1.0	1/2
L-9 H	Lawn - Half Circle	9	15	1.7	1/2
L-10 H	Lawn - Half Circle	10	20	2.5	1/2
L-8 Q	Lawn - Quarter Circle	8	10	0.9	1/2
L-9 Q	Lawn - Quarter Circle	9	15	1.5	1/2
L-10 Q	Lawn - Quarter Circle	10	20	2.0	1/2
S-9 H	Shrubbery Half Circle	11	15	1.7	1/2
S-10 H	Shrubbery Half Circle	14	20	2.5	1/2
J-(21) *	Rocket Jet Part Circle	21	10	2.7	3/4

- NOTE:
- "Radius of coverage" is the minimum radius at the tabulated pressure.
 - "Pressure" is the minimum pressure, in pounds per square inch, which is available at the base of the last head. The operating pressure for acceptable heads must not exceed this value when operating at the tabulated flow and radius.
 - "Flow" is the maximum flow, in gallons per minute which is discharged at the tabulated "pressure".
- * The J-21 sprinkler shall be an adjustable part circle sprinkler with a 3/4" nozzle and a 3/4" riser pipe size.

GENERAL NOTES:

- All pipes under pavement shall be copper unless otherwise noted on plans.
- In the water piping diagrams, all pipes are to be galvanized iron screw pipes, and all fittings are to be galvanized malleable iron fittings, unless otherwise noted on the plans.
- Unless otherwise stipulated or directed by the Engineer, the center line feeder pipe shall be located back from concrete curb or green asphalt strip on shoulder and 12" from fence line or Right-of-Way line.
- After complete installation of the Sprinkler system, each sprinkler head shall be adjusted to the satisfaction of the Engineer.
- All angle control valves shall be furnished with precast concrete angle control box. See Sht. No. 62 for details.

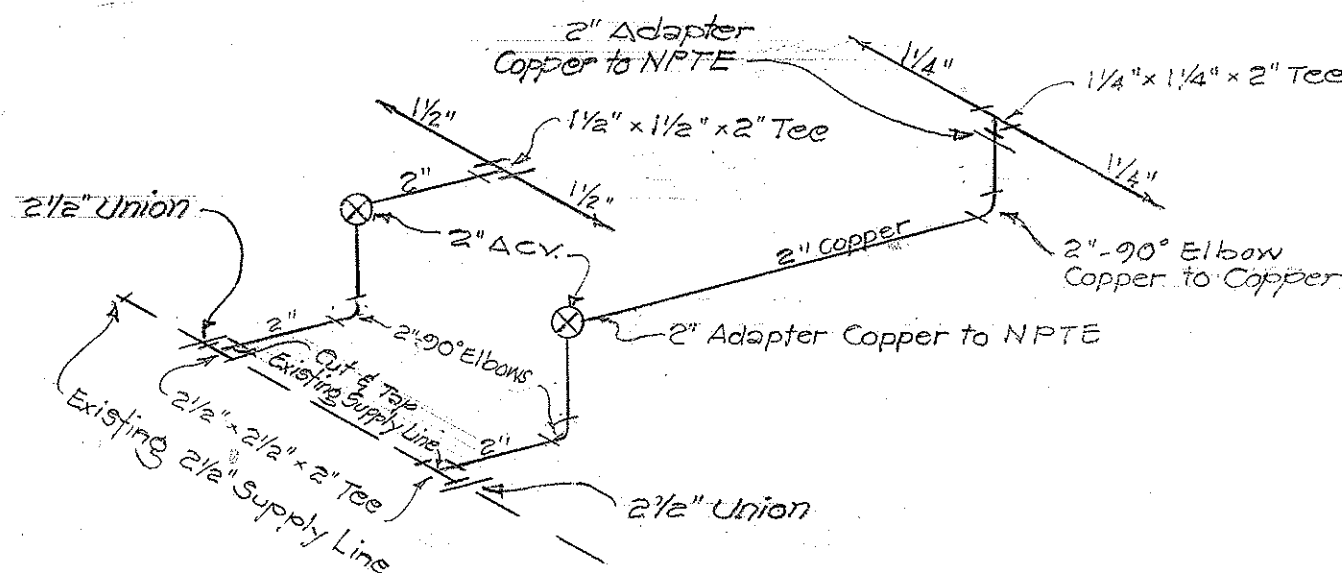

SYSTEM 1-C

TOTAL PLANT LIST

KEY	BOTANICAL NAME	COMMON NAME	QUANTITY	SPECIFICATIONS
KEY	BOTANICAL NAME	COMMON NAME	QUANTITY	SPECIFICATIONS
LT	Ligustrum Texanum	Texas Privet	192 ea.	12'-18" Tall, 1 qt. can, Plant 8' apart or o.c.
WT	Medelia Trilobata	Medelia	2,161 ea.	10' Runners, 1 qt. can, Plant 30" o.c. as ground cover
CD	Cynodon Dactylon	Bermuda Grass	48,882 sq.ft.	See Standard Specifications

TYPICAL LAYOUT- MEDIAN SPRINKLER SYSTEM
@ STA. 127+18 TO 130+20

PLANT LIST

THIS SHEET


KEY	BOTANICAL NAME	COMMON NAME	QUANTITY
LT	Ligustrum Texanum	Texas Privet	48 ea.
CD	Cynodon Dactylon	Bermuda Grass	9,890 sq.ft.


STATE OF HAWAII
DEPARTMENT OF TRANSPORTATION
HIGHWAYS DIVISION
INTERSTATE HIGHWAY (LUNALILO FWY)
F.A.I. PROJ. NO. I-HI-1(24)

LANDSCAPE & SPRINKLER PLAN





SCALE: 1" = 20'

SHEET NO. 1 OF 5 SHEETS

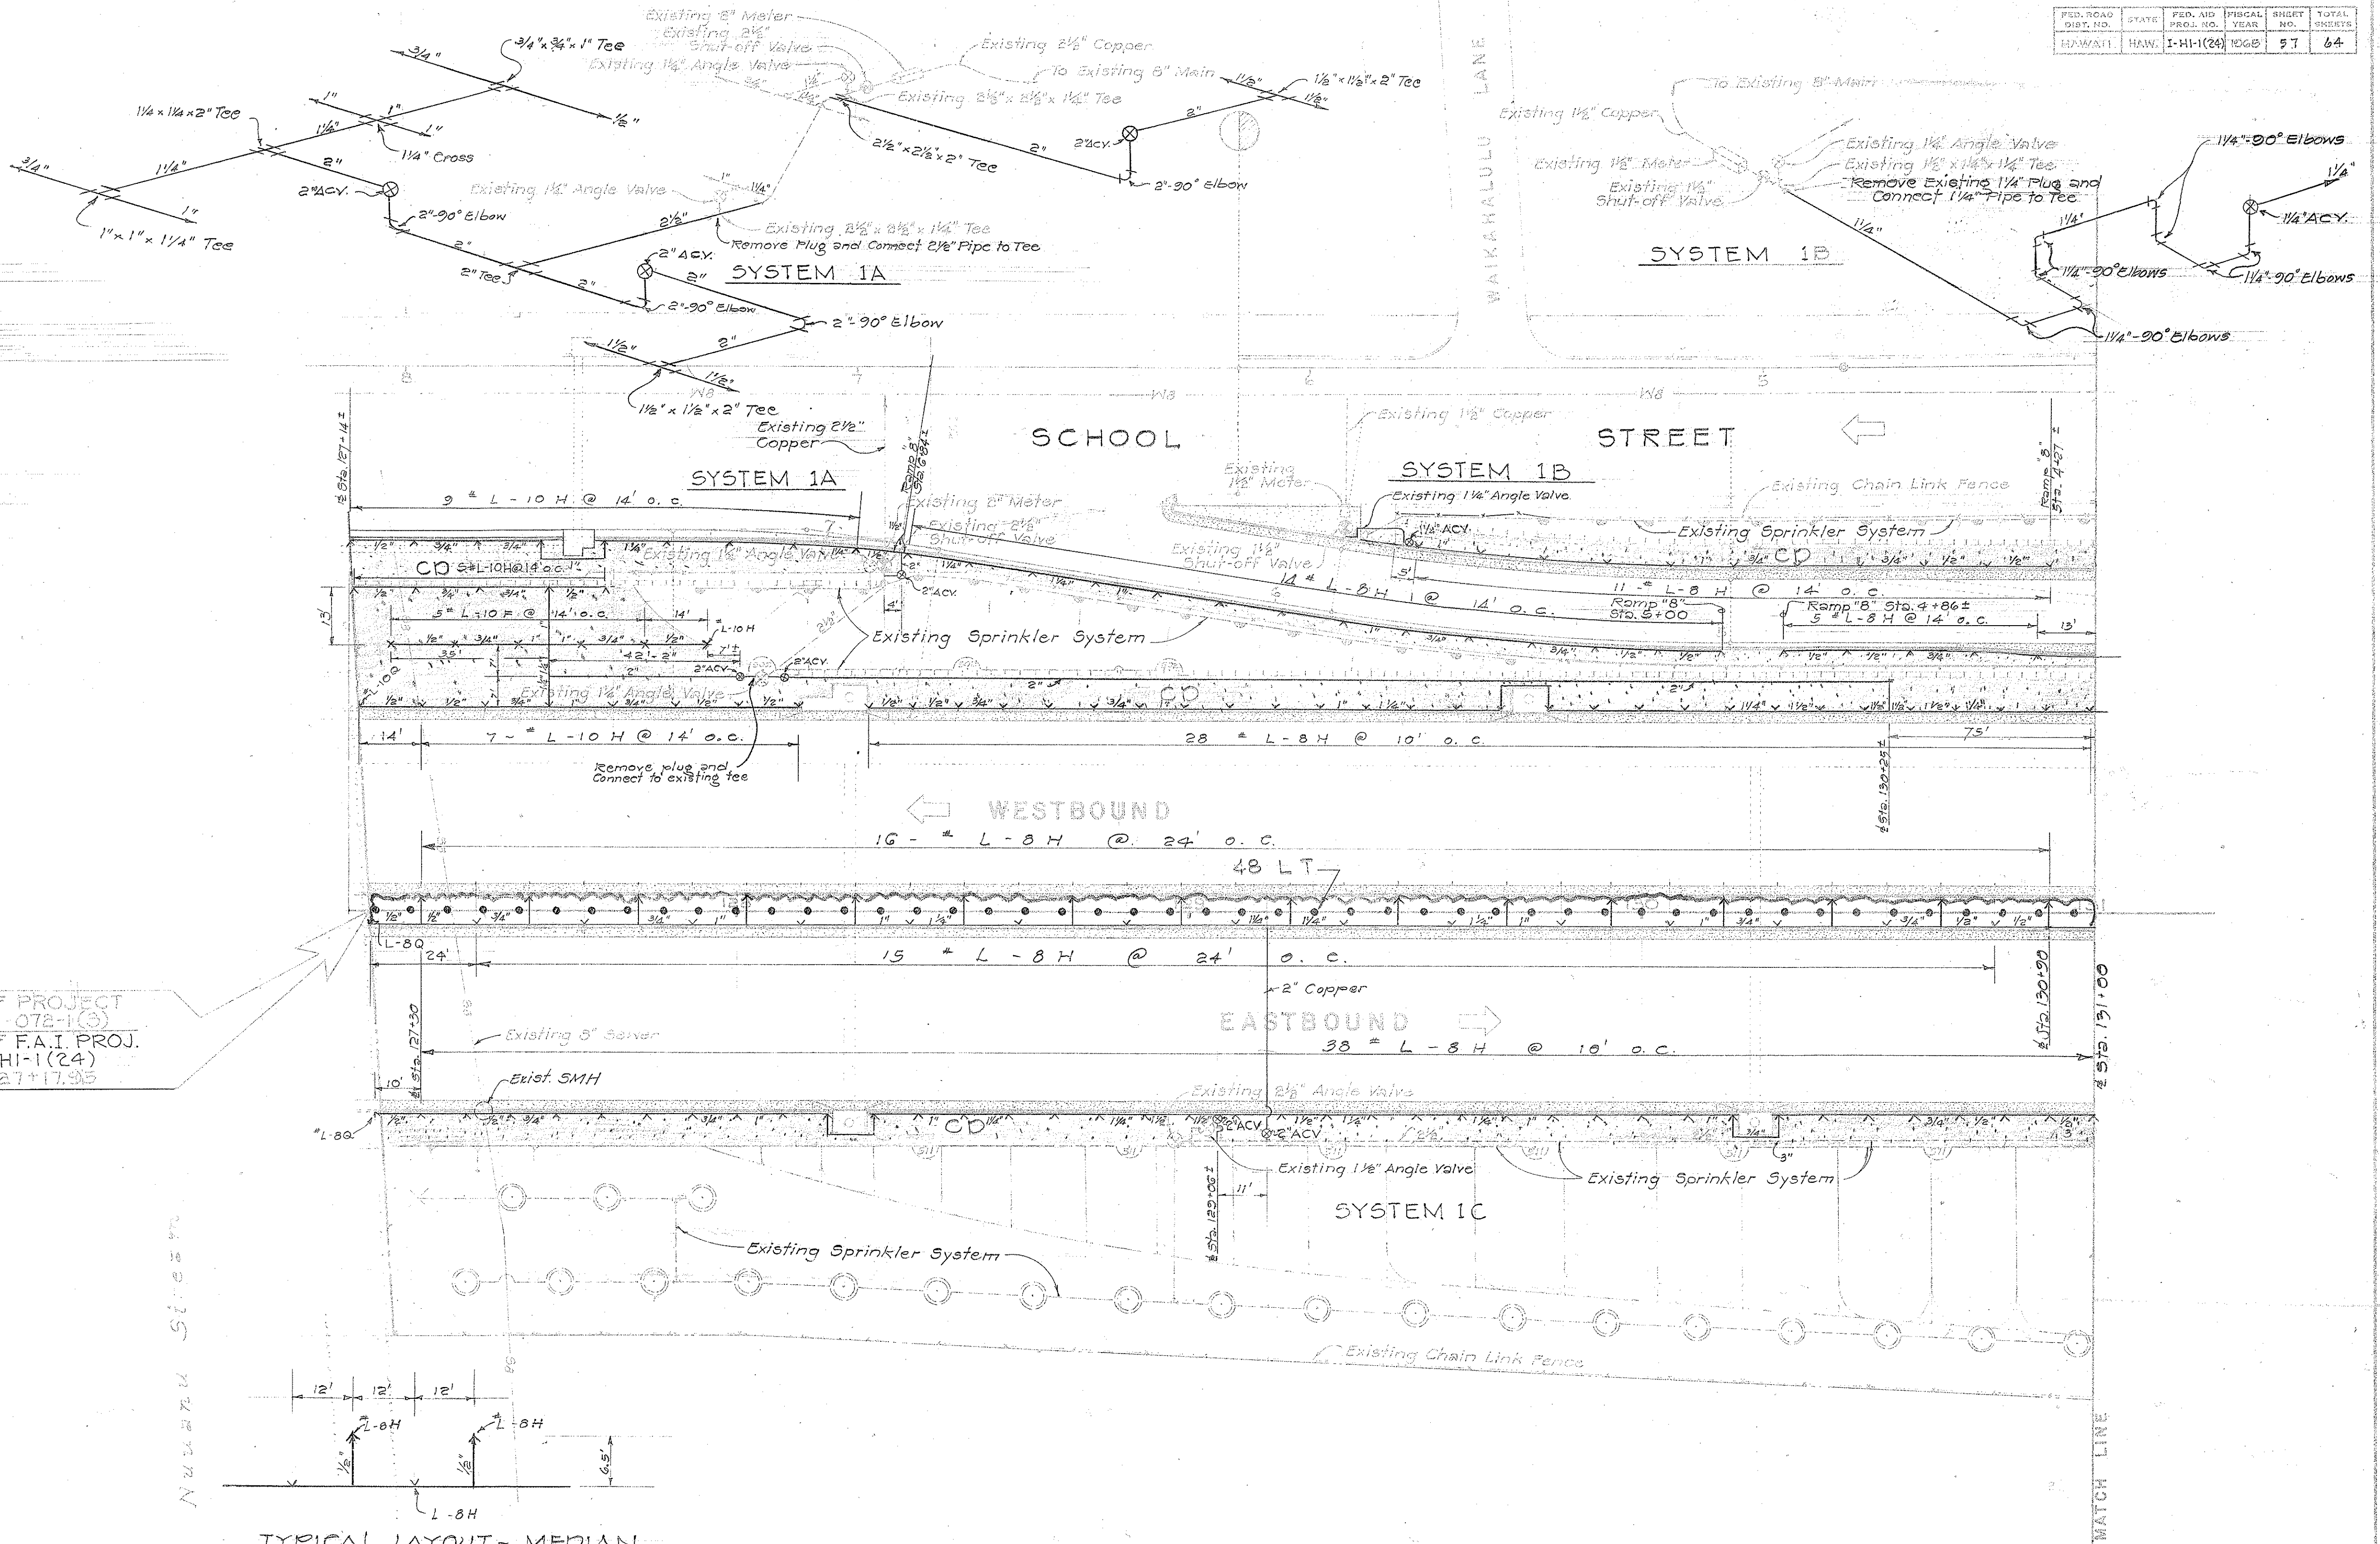

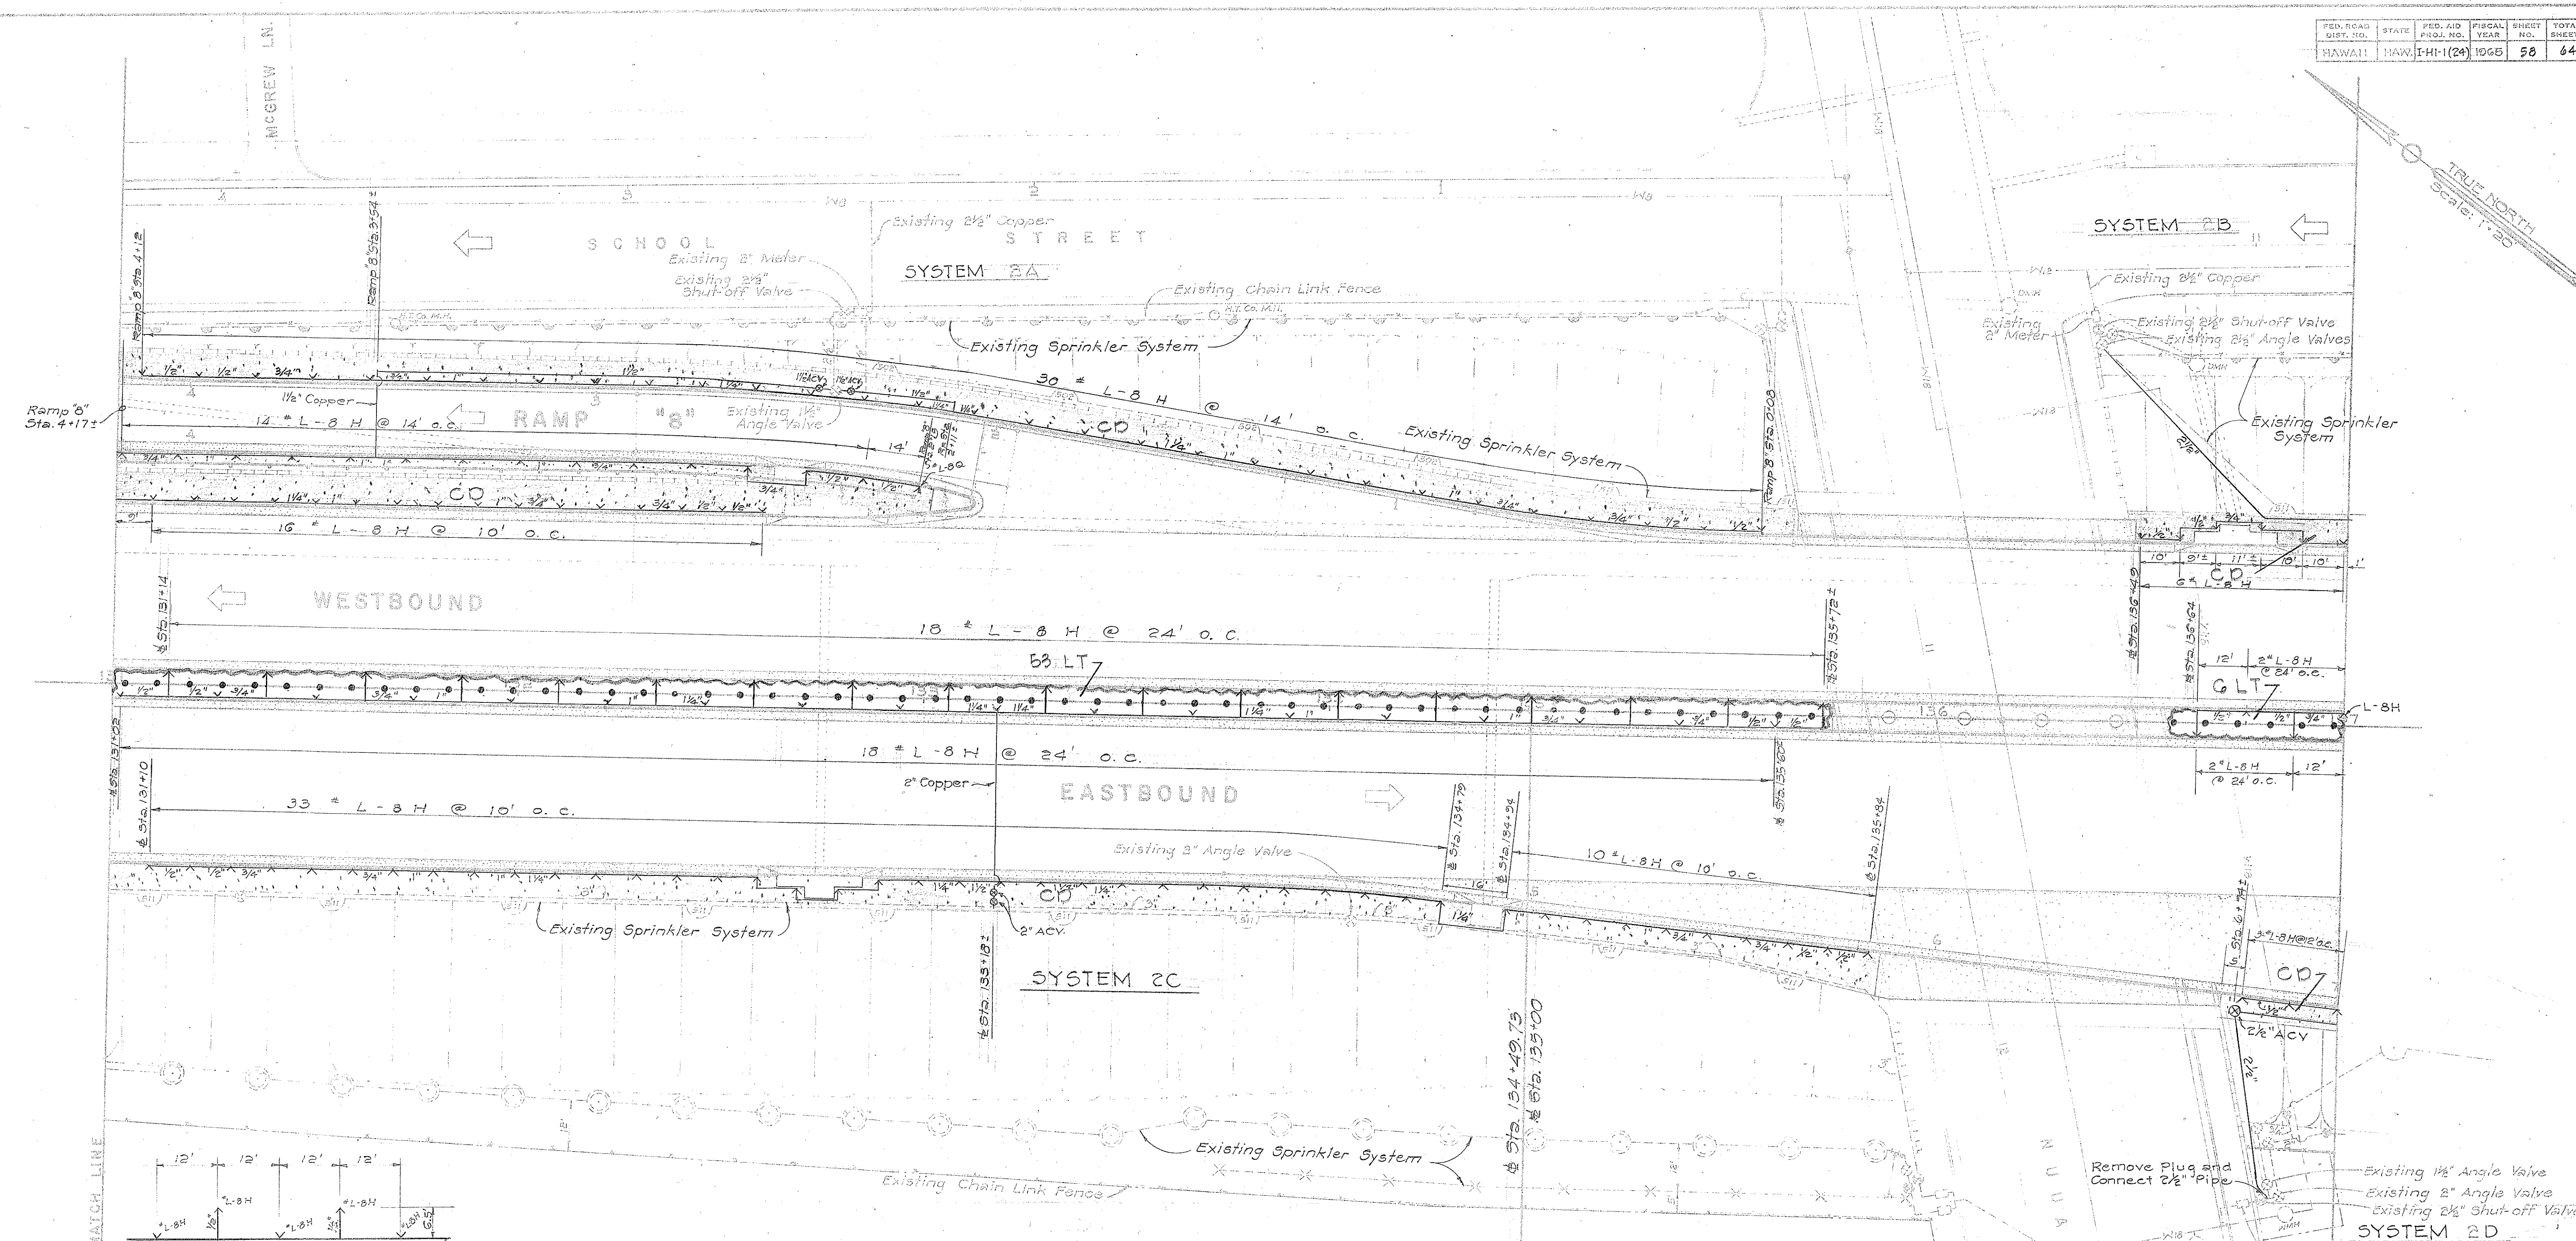


PLANT LIST		THIS SHEET	
KEY	BOTANICAL NAME	COMMON NAME	QUANTITY
LT	Ligustrum Texanum	Texas Privet	50 ea.
CD	Cynodon Dactylon	Bermuda Grass	8,450 sqf

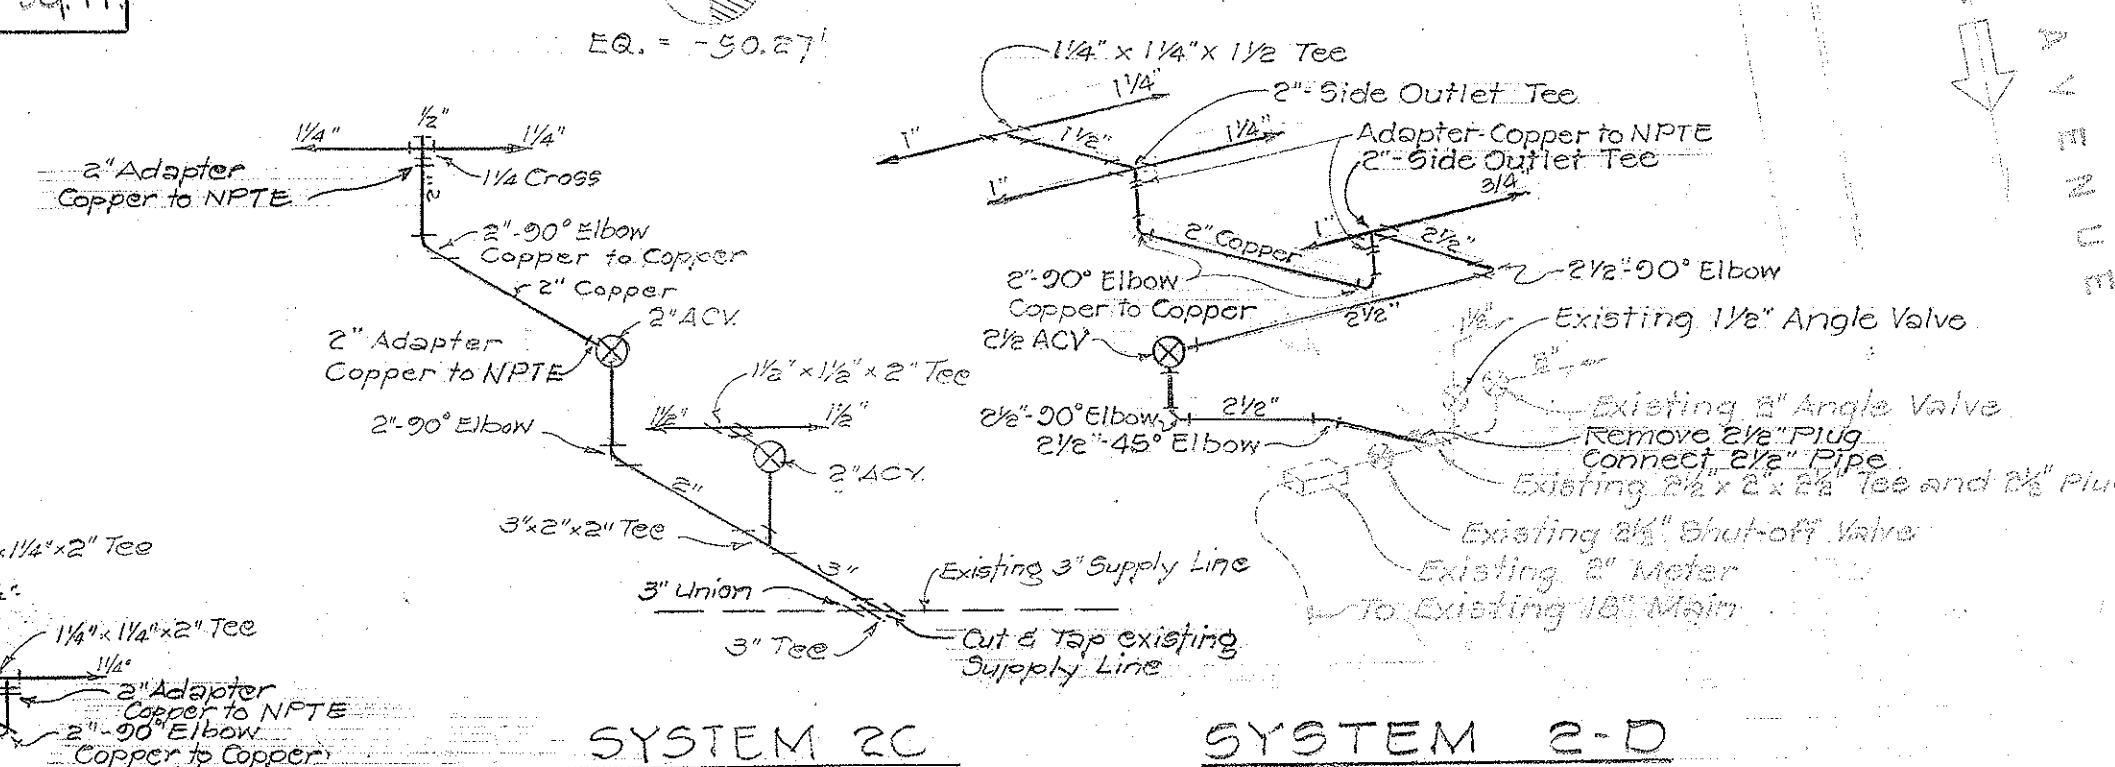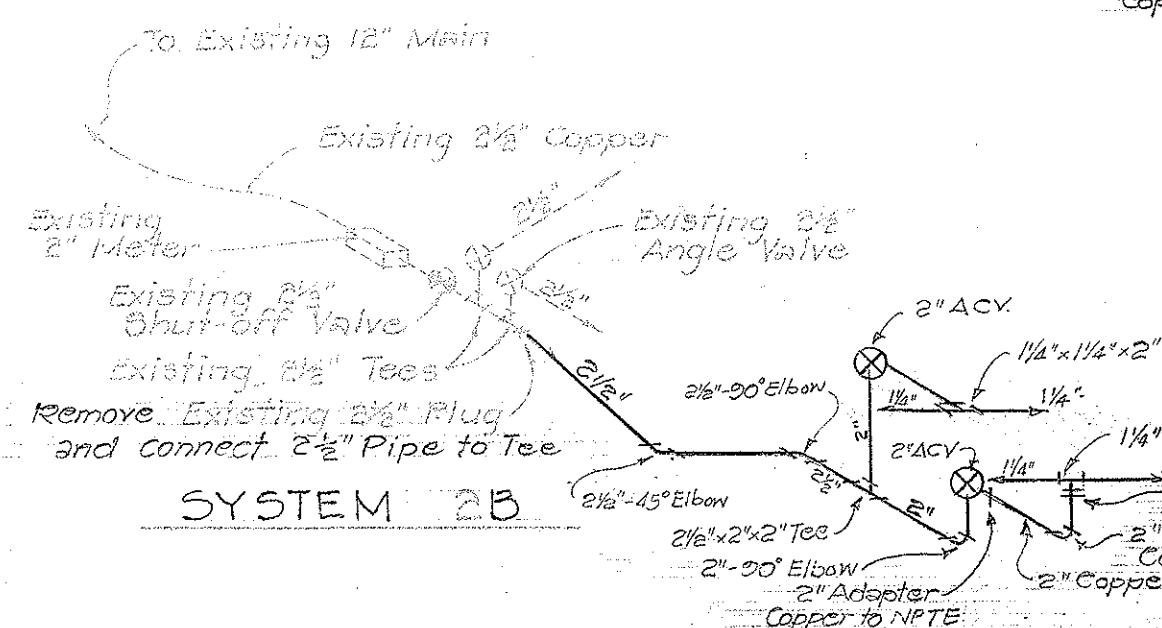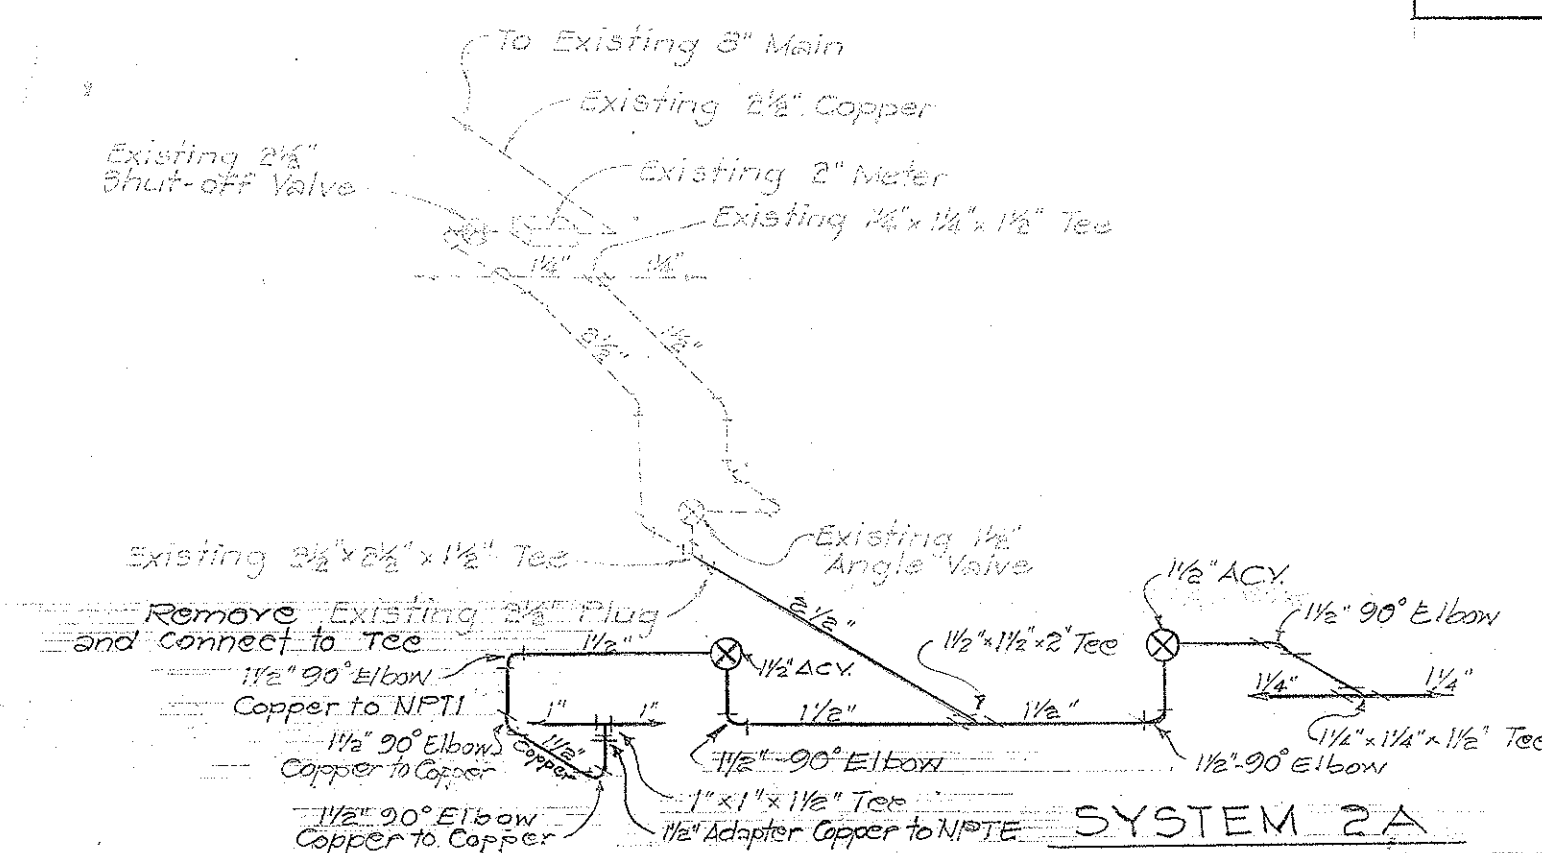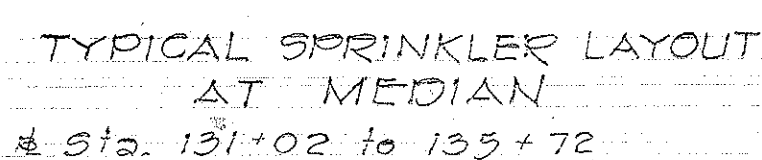

STATE OF HAWAII
DEPARTMENT OF TRANSPORTATION
HIGHWAYS DIVISION
INTERSTATE HIGHWAY (LUNALILO FWY)
E.A.I. PROJ. NO. I-HI-1(24)
LANDSCAPE & SPRINKLER PLAN
SCALE: 1" = 20'
SHEET NO. 2 OF 8 SHEETS


TYPICAL LAYOUT-MEDIAN SPRINKLER SYSTEM

Sta. 136+64 to 140+24
Sta. 140+33 to 143+69

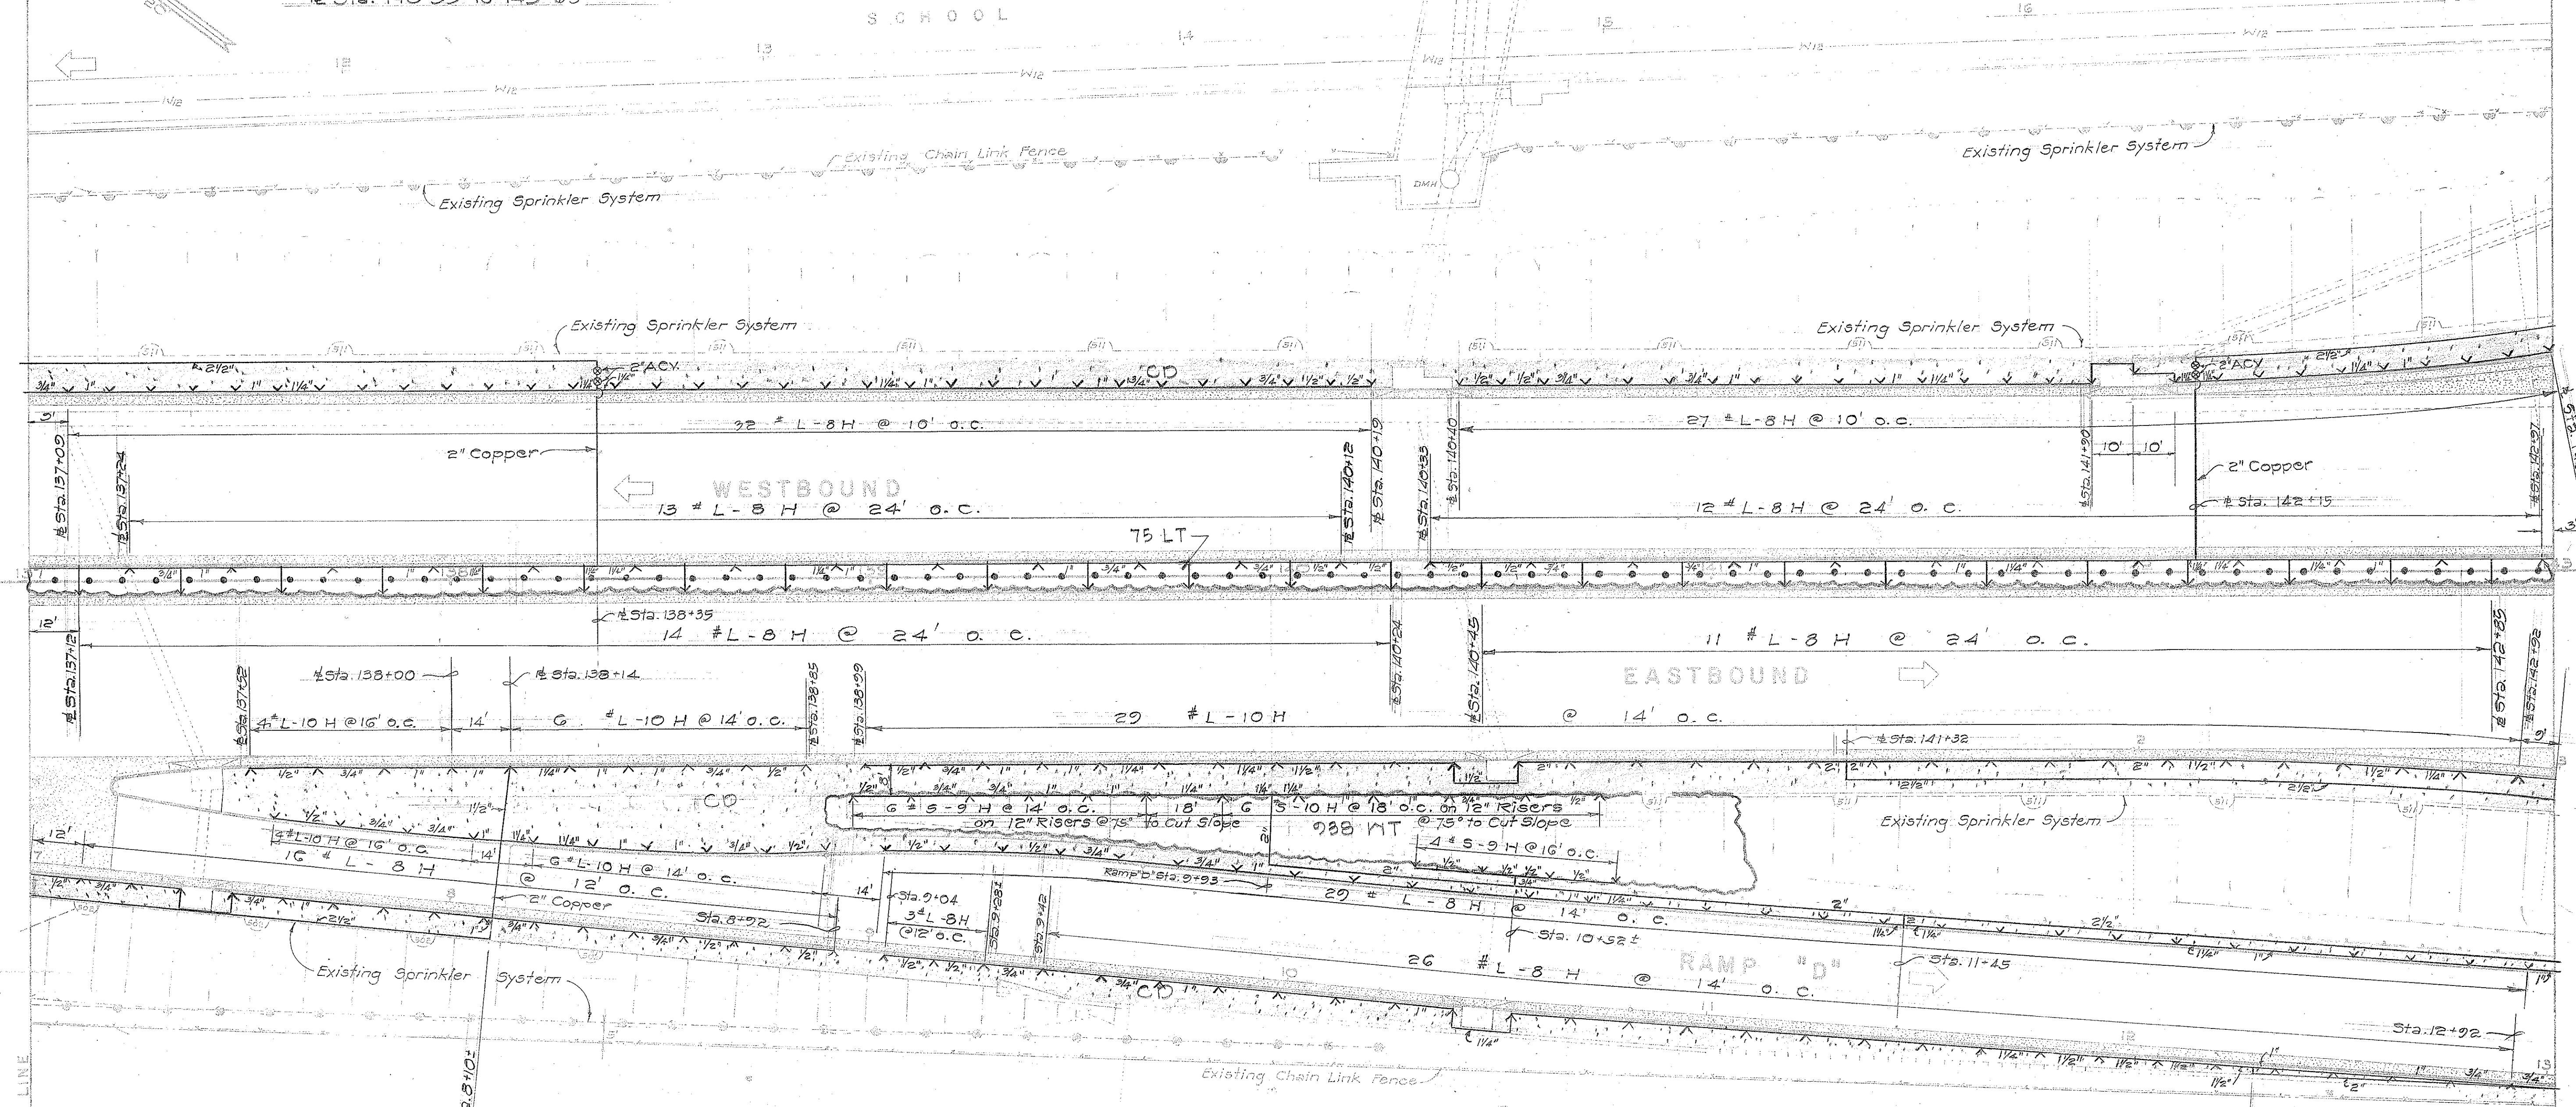


PLANT LIST - THIS SHEET

KEY	BOTANICAL NAME	COMMON NAME	QUANTITY
LT	Ligustrum Texanum	Texas Privet	75 ea.
WT	Nedelia Trilobata	Nedelia	988 ea.
CD	Cynodon Dactylon	Bermuda Grass	19,120 sq. ft.

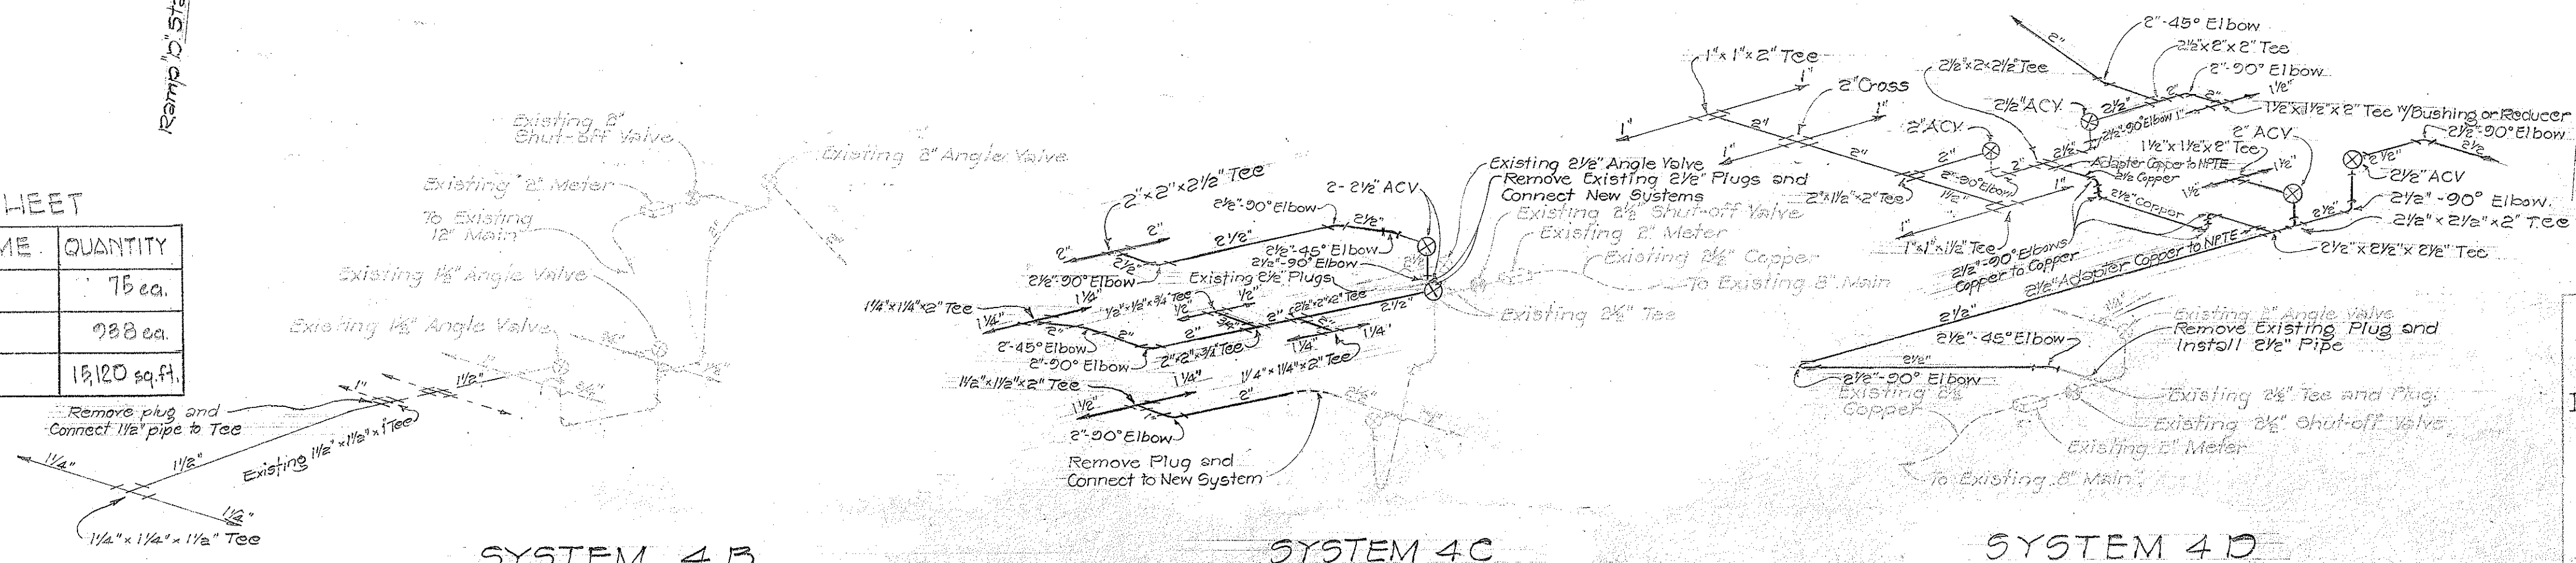


STATE OF HAWAII
DEPARTMENT OF TRANSPORTATION
HIGHWAYS DIVISION
INTERSTATE HIGHWAY (LUNALILO FWY)
F.A.I. PROJ. NO. I-HI-1(24)
LANDSCAPE & SPRINKLER PLAN
SCALE: 1" = 20'
SHEET NO. 5 OF 8 SHEETS

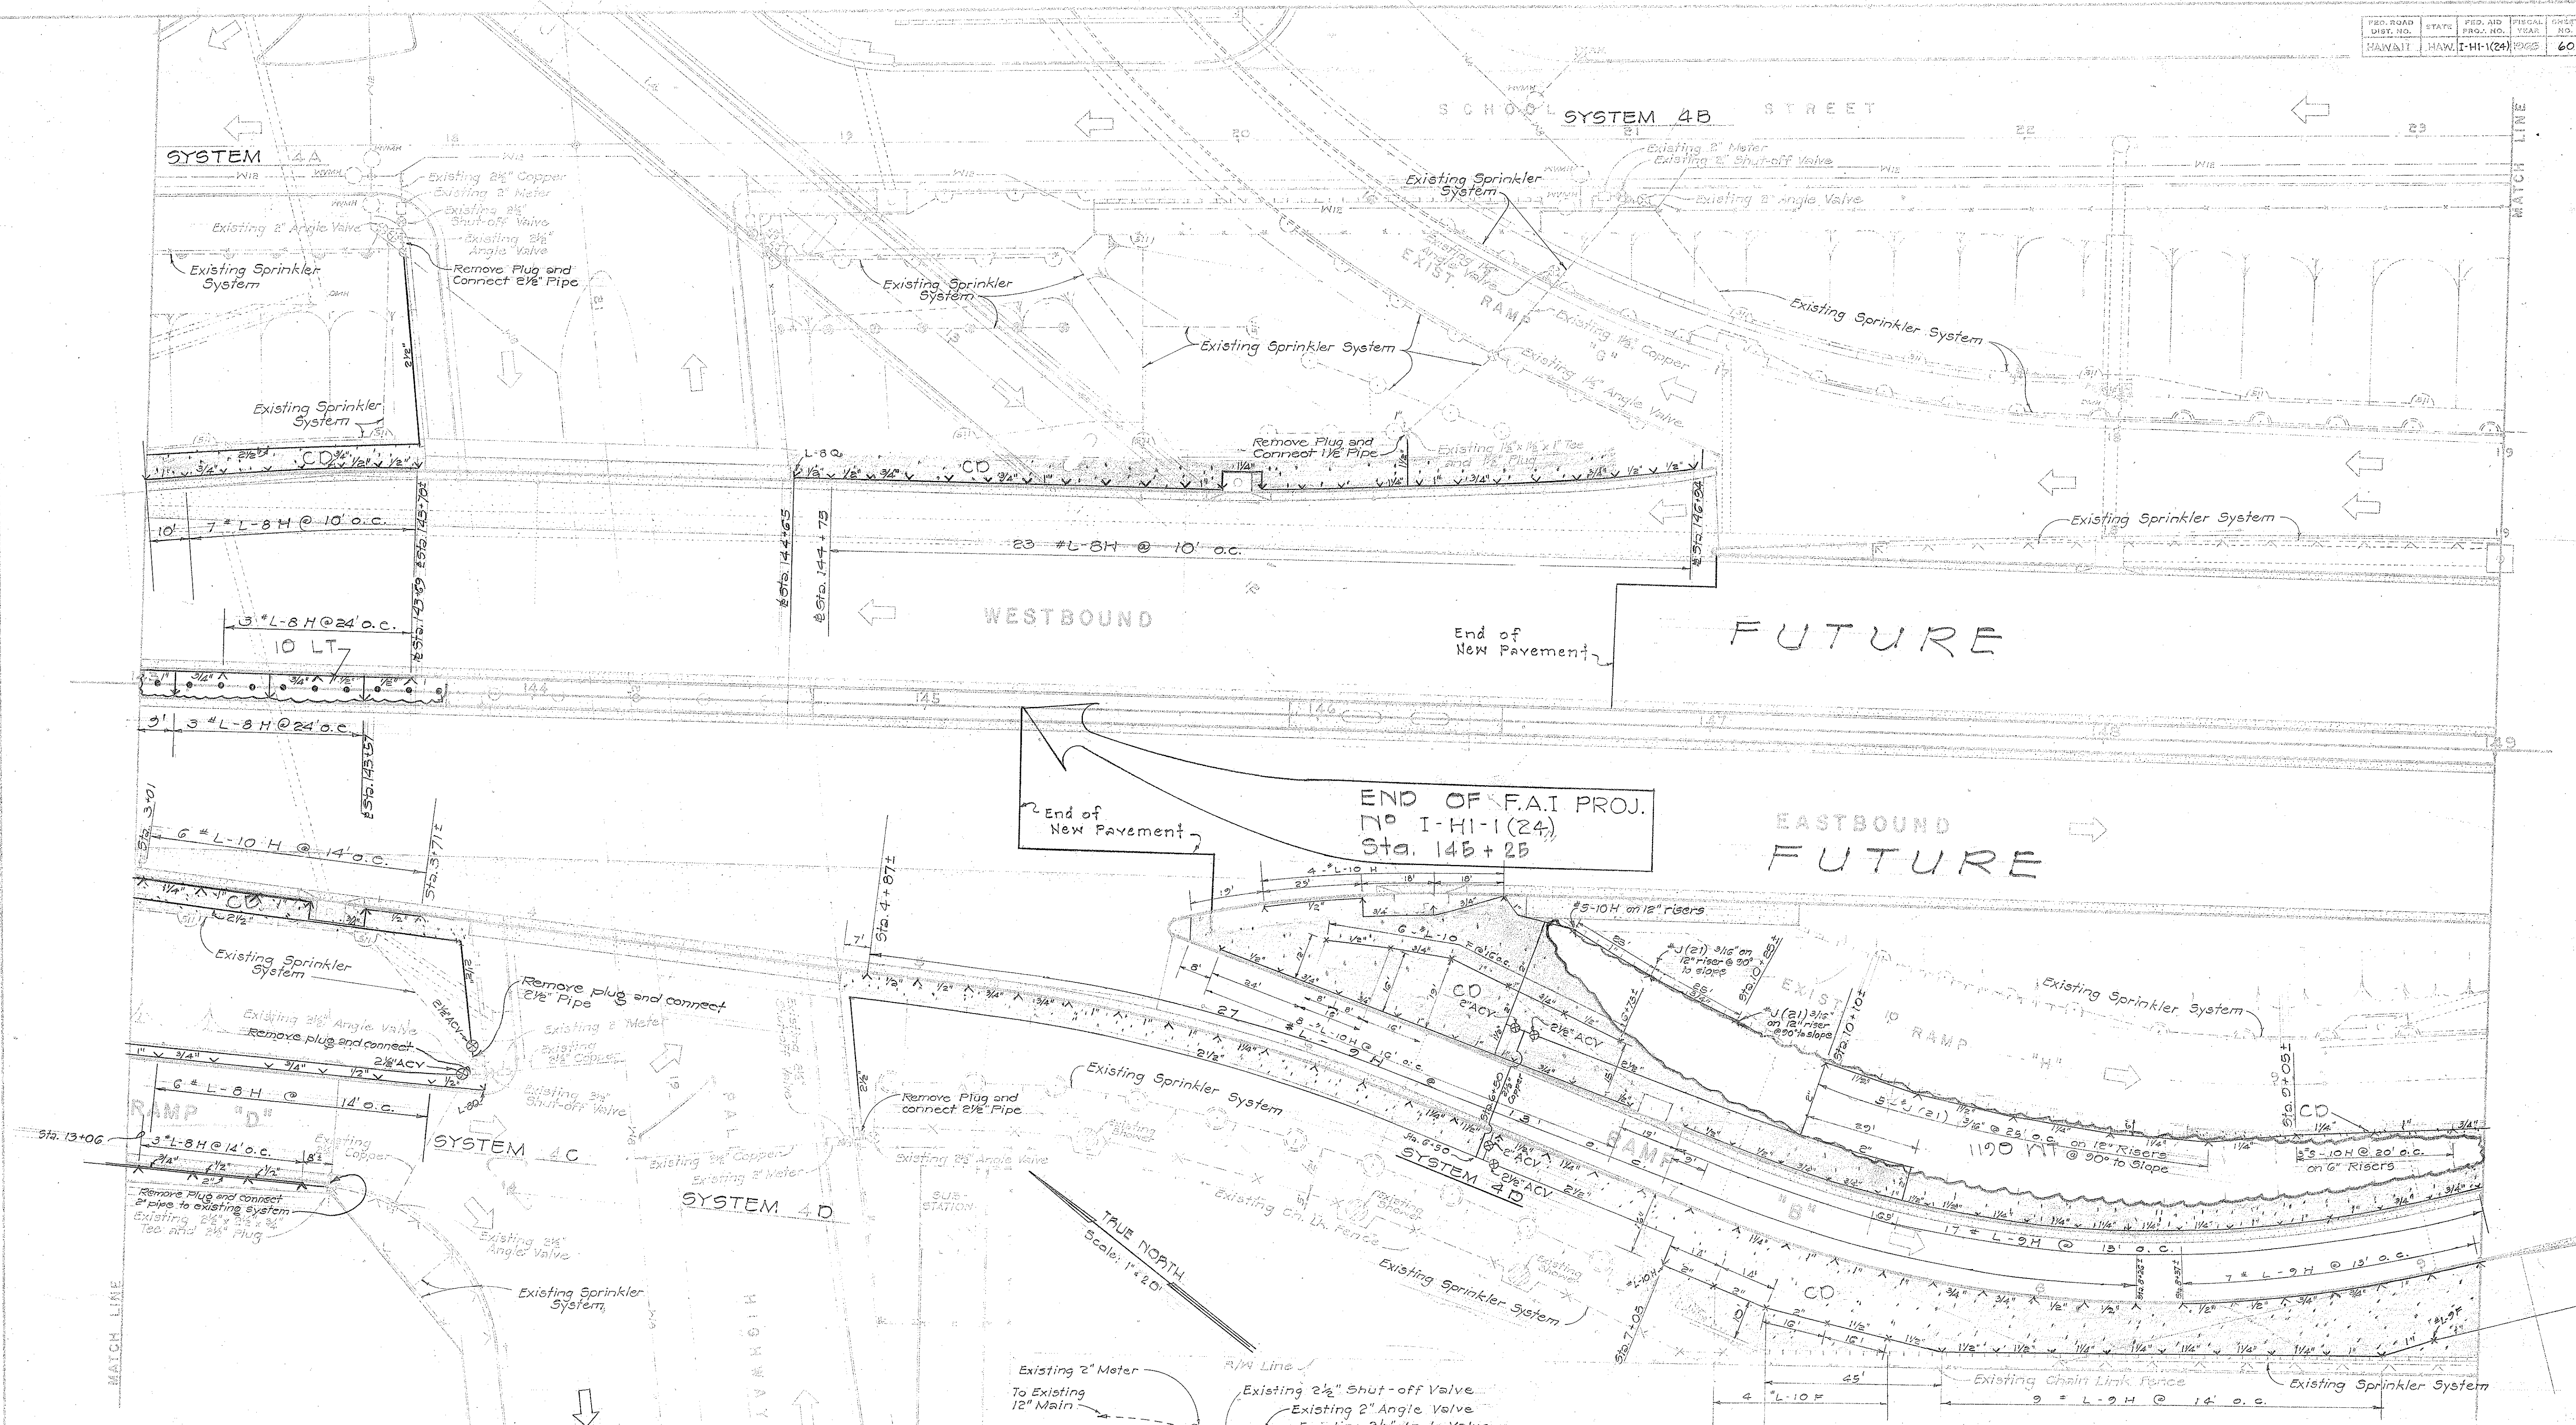


DATE: _____
SERVED BY: _____
DRAWN BY: _____
CHECKED BY: _____
NOTE BOOK: _____
QUANTITIES: _____

KEY	BOTANICAL NAME	COMMON NAME	QUANTITY
LT	Ligustrum Texanum	Texas Privet	10 ea.
WT	Nedelia Trilobata	Nedelia	1190 ea.
CD	Cynodon Dactylon	Bermuda Grass	12730 sq. ft.

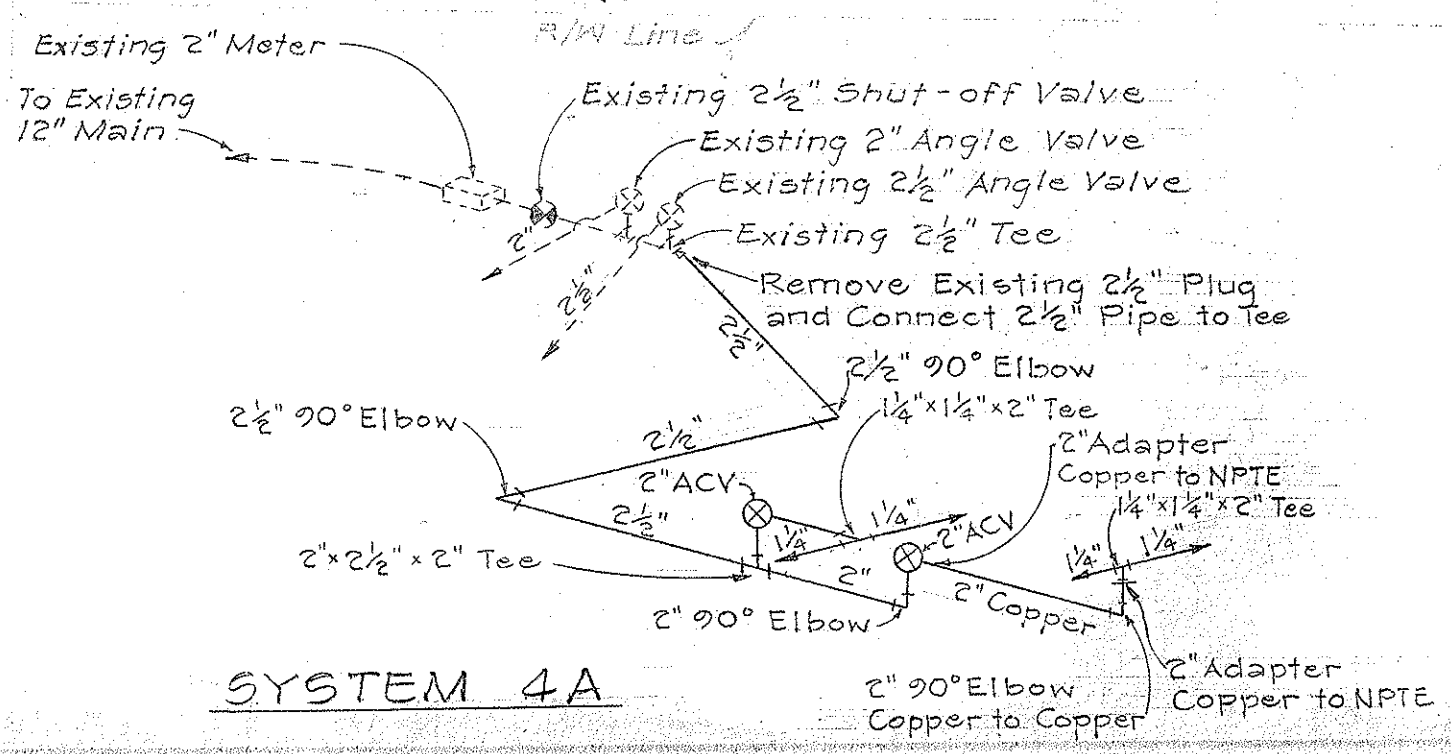

STATE OF HAWAII
DEPARTMENT OF TRANSPORTATION
HIGHWAYS DIVISION
INTERSTATE HIGHWAY (LUNALILO FWY)
F.A.I. PROJ. NO. I-HI-1(24)
LANDSCAPE & SPRINKLER PLAN
SCALE: 1" = 20'
SHEET NO. 4 OF 8 SHEETS

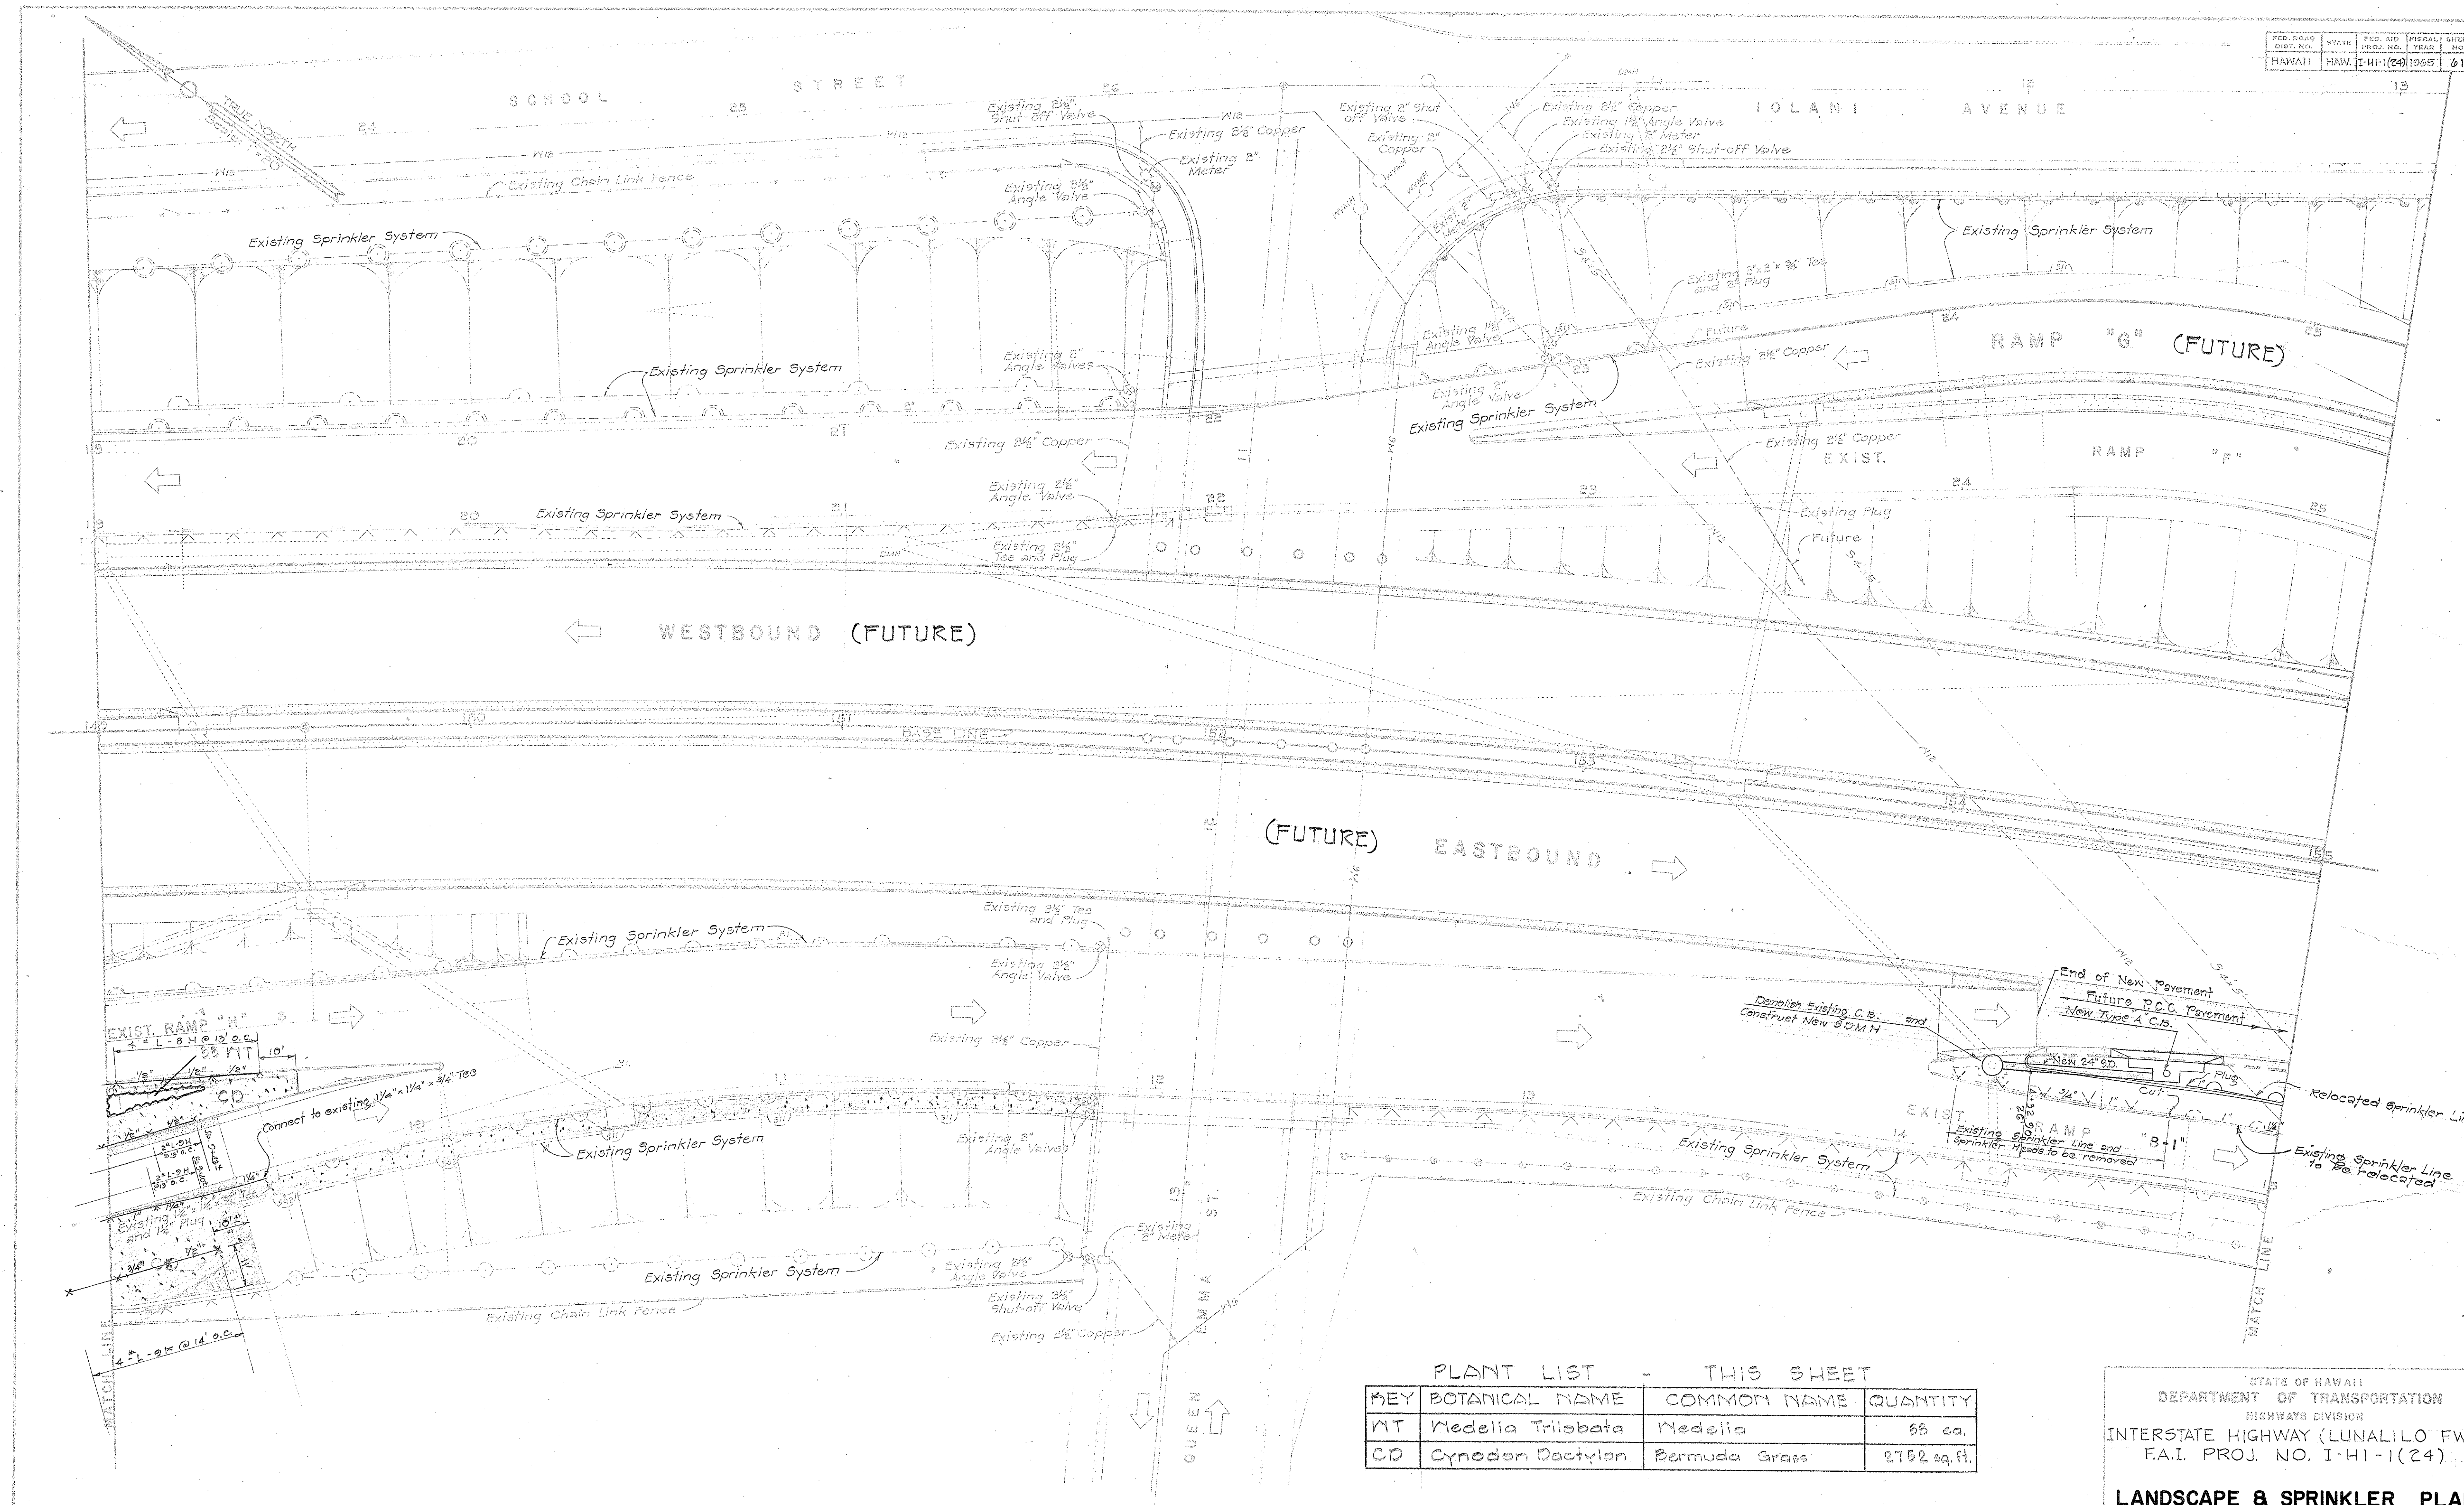

CHECKED BY: _____
 DESIGNED BY: _____
 DRAWN BY: _____
 NOTE BOOK: _____
 NO. _____

PLANT LIST - THIS SHEET





KEY	BOTANICAL NAME	COMMON NAME	QUANTITY
NT	Nedelia Trilobata	Nedelia	88 ea.
CD	Cynodon Dactylon	Bermuda Grass	2752 sq.ft.

STATE OF HAWAII
 DEPARTMENT OF TRANSPORTATION
 HIGHWAYS DIVISION
 INTERSTATE HIGHWAY (LUNALILO FWY)
 F.A.I. PROJ. NO. I-HI-1(24)
LANDSCAPE & SPRINKLER PLAN
 SCALE: 1" = 20'
 SHEET NO. 5 OF 8 SHEETS

FED. ROAD DIST. NO.	STATE	FED. AID PROJ. NO.	FISCAL YEAR	SHEET NO.	TOTAL SHEETS
HAWAII	HAW.	I-H-1(24)	1963	62	64

CURVE DATA

	B-8	B-9	B-10
Δ	85° 54' 30"	59° 30' 59"	49° 35' 30"
R	200.00	240.84	224.00
T	186.20	137.71	103.30
L	299.88	250.19	173.88

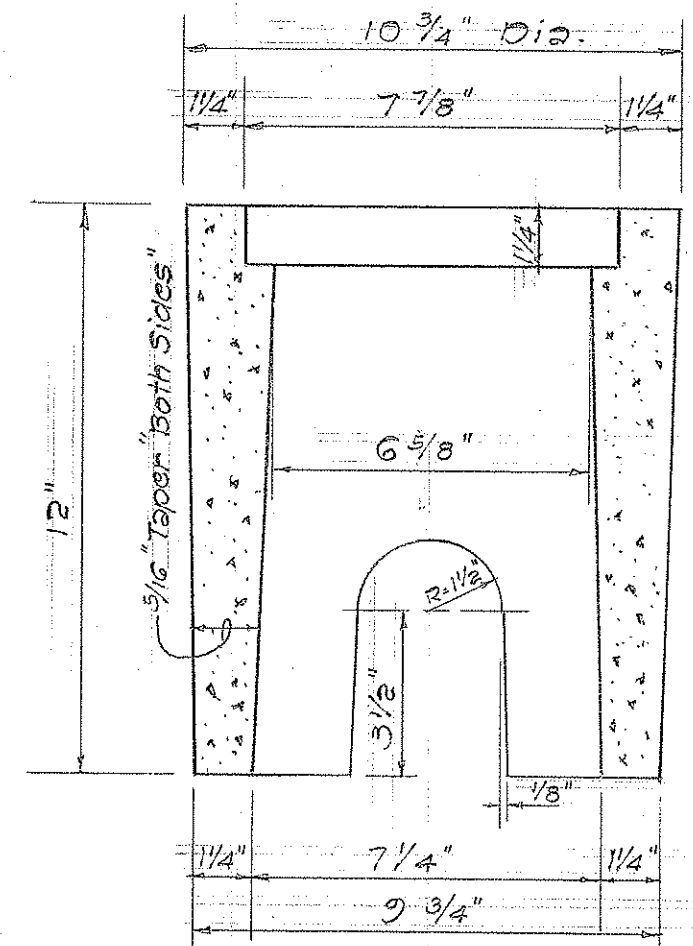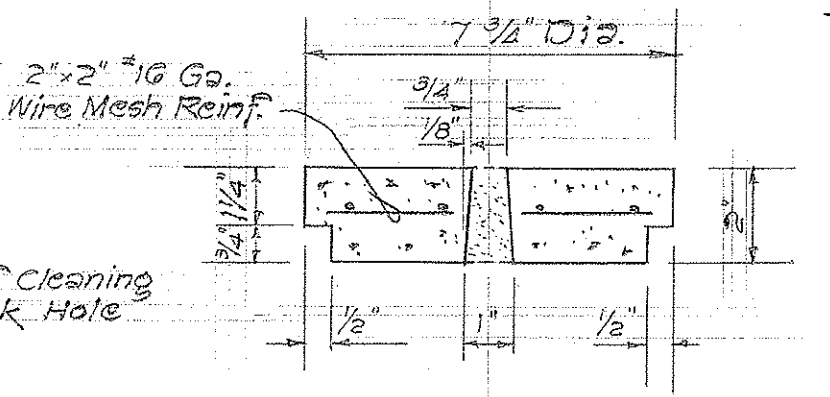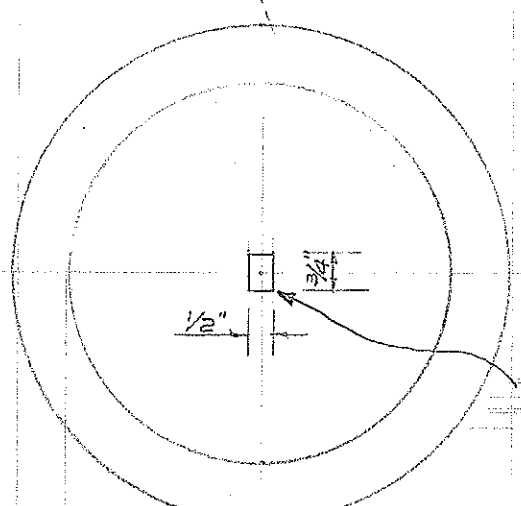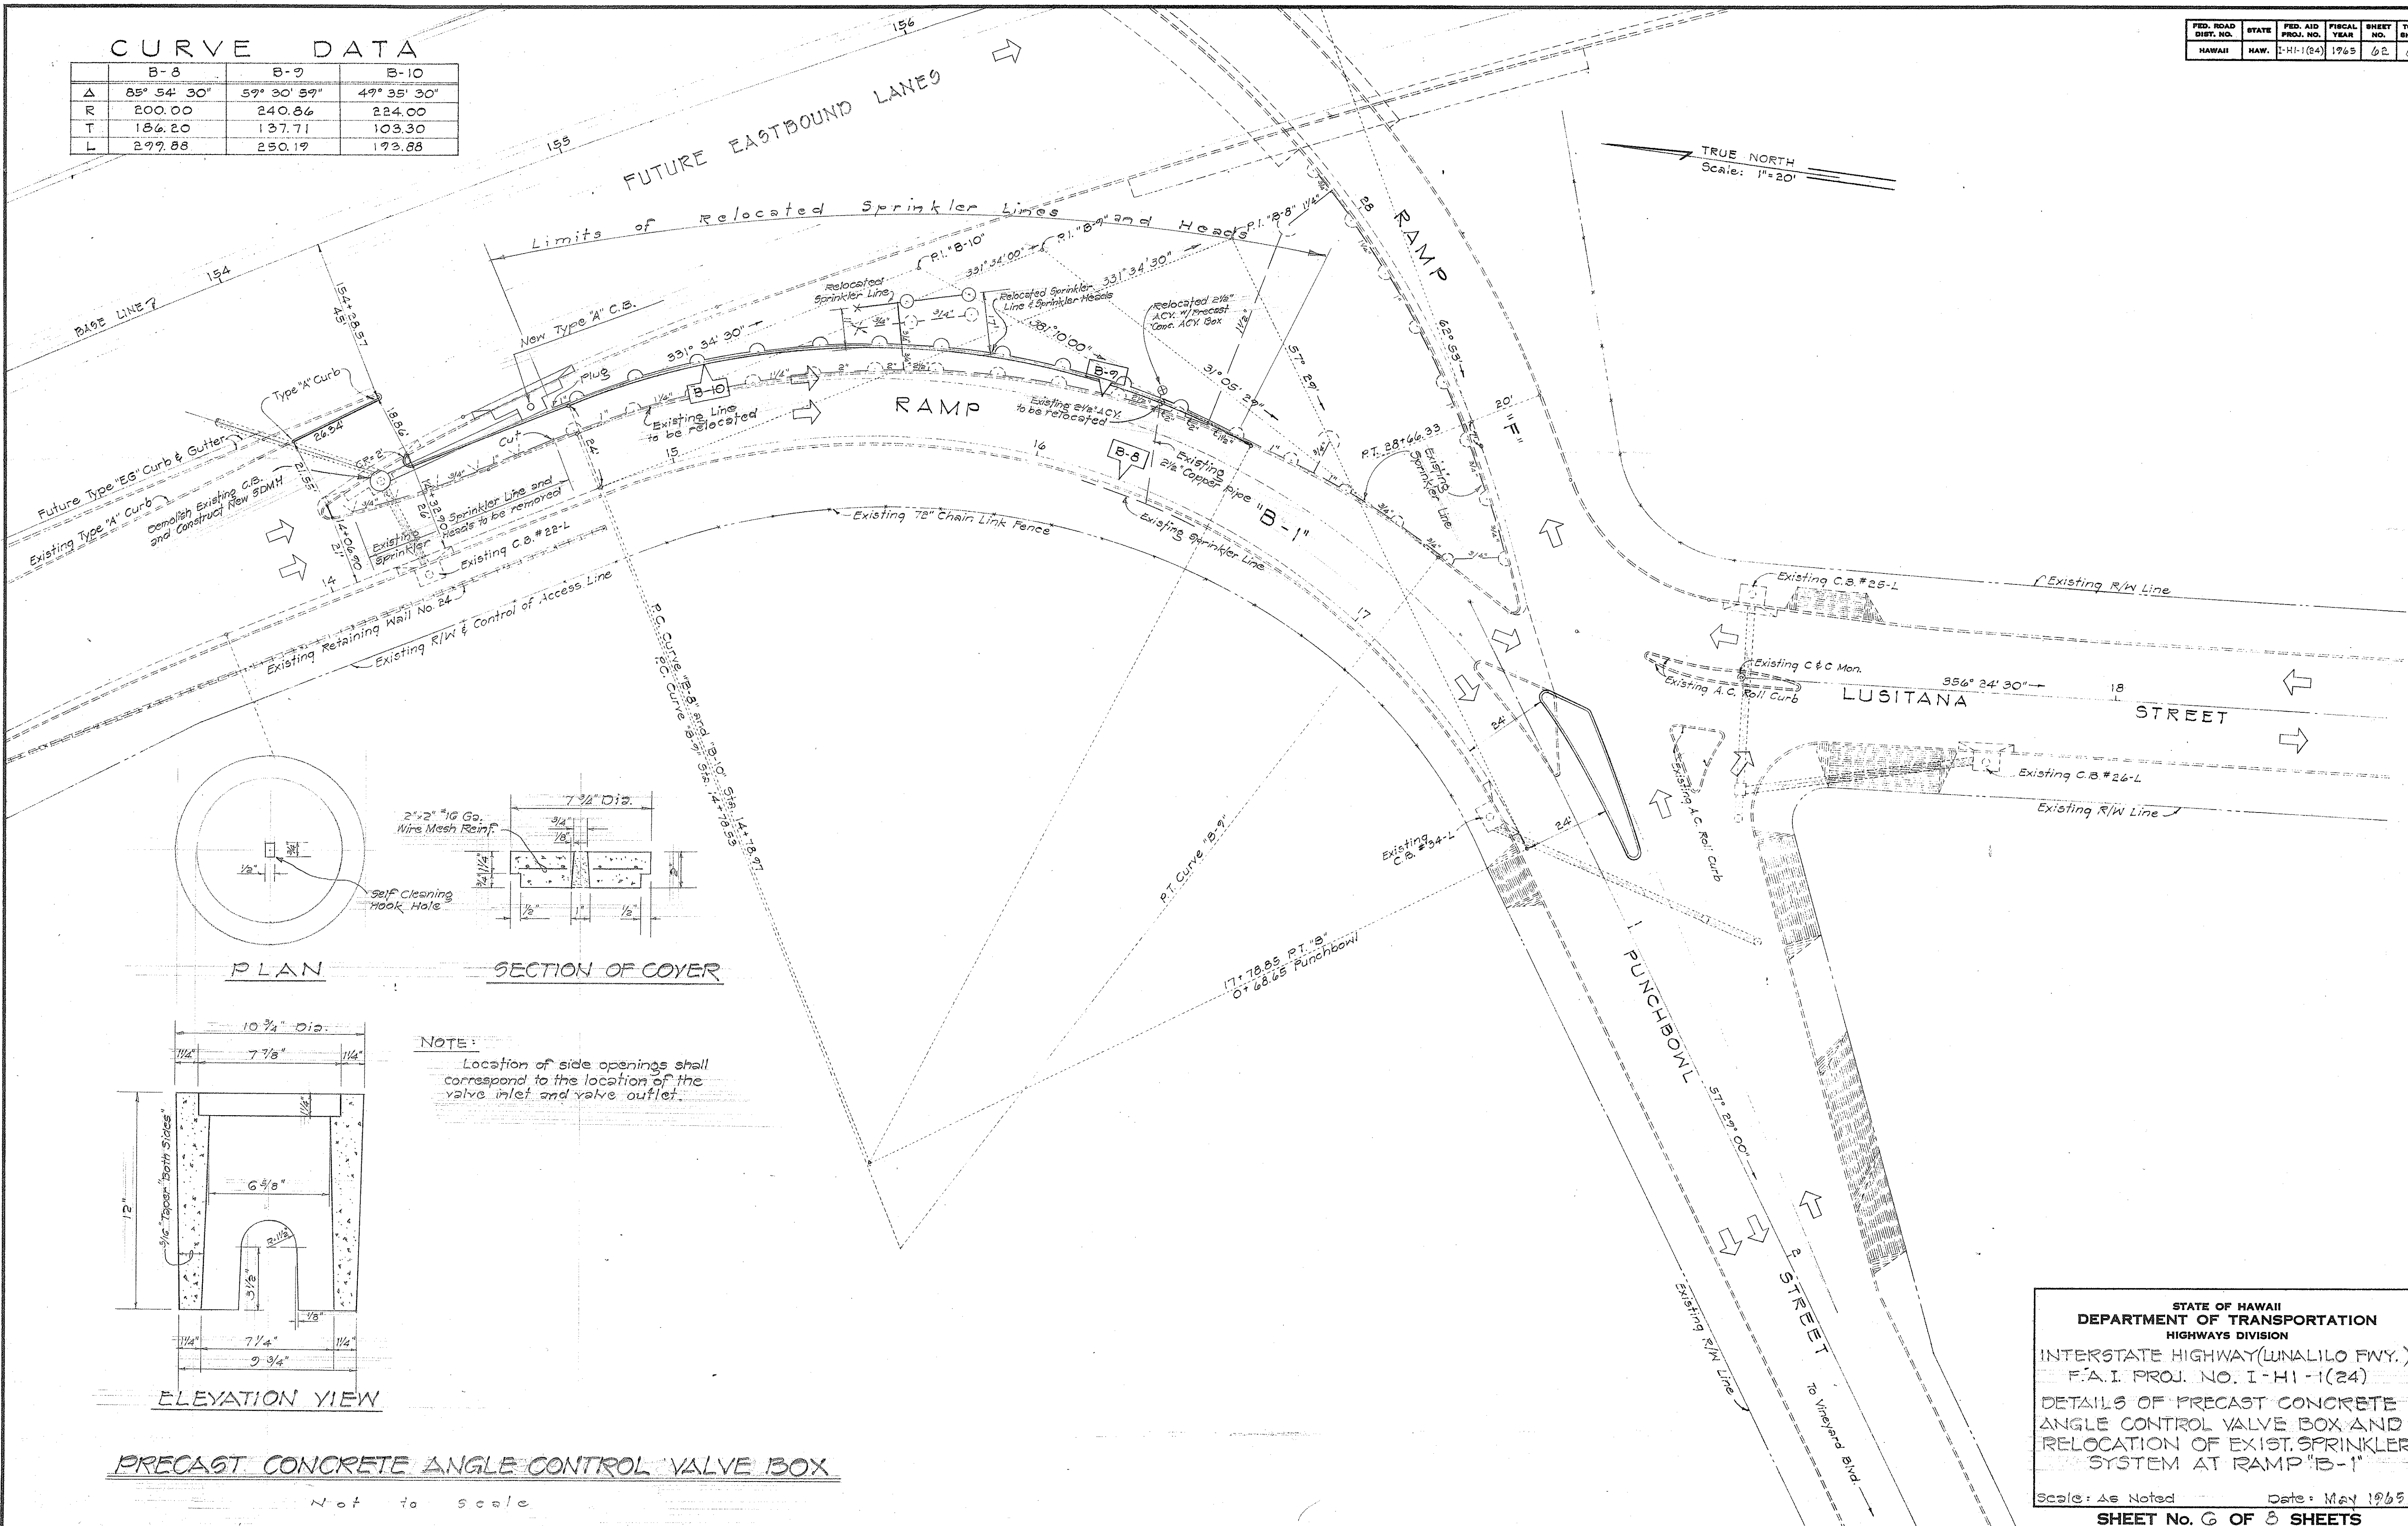

NOTE:
Location of side openings shall correspond to the location of the valve inlet and valve outlet.

PRECAST CONCRETE ANGLE CONTROL VALVE BOX

Not to scale

STATE OF HAWAII

DEPARTMENT OF TRANSPORTATION

HIGHWAYS DIVISION

INTERSTATE HIGHWAY(LUNALILO FWY.)

F.A.I. PROJ. NO. I-H-1(24)

DETAILS OF PRECAST CONCRETE

ANGLE CONTROL VALVE BOX AND

RELOCATION OF EXIST. SPRINKLER

SYSTEM AT RAMP "B-1"


Scale: As Noted

Date: May 1963


SHEET No. 6 OF 8 SHEETS

62


ORIGINAL	DATE
SURVEY PLOTTED BY	
DRAWN BY	
TRACED BY	
CHECKED BY	
NOTE BOOK	
QUANTITIES BY	
CHECKED BY	

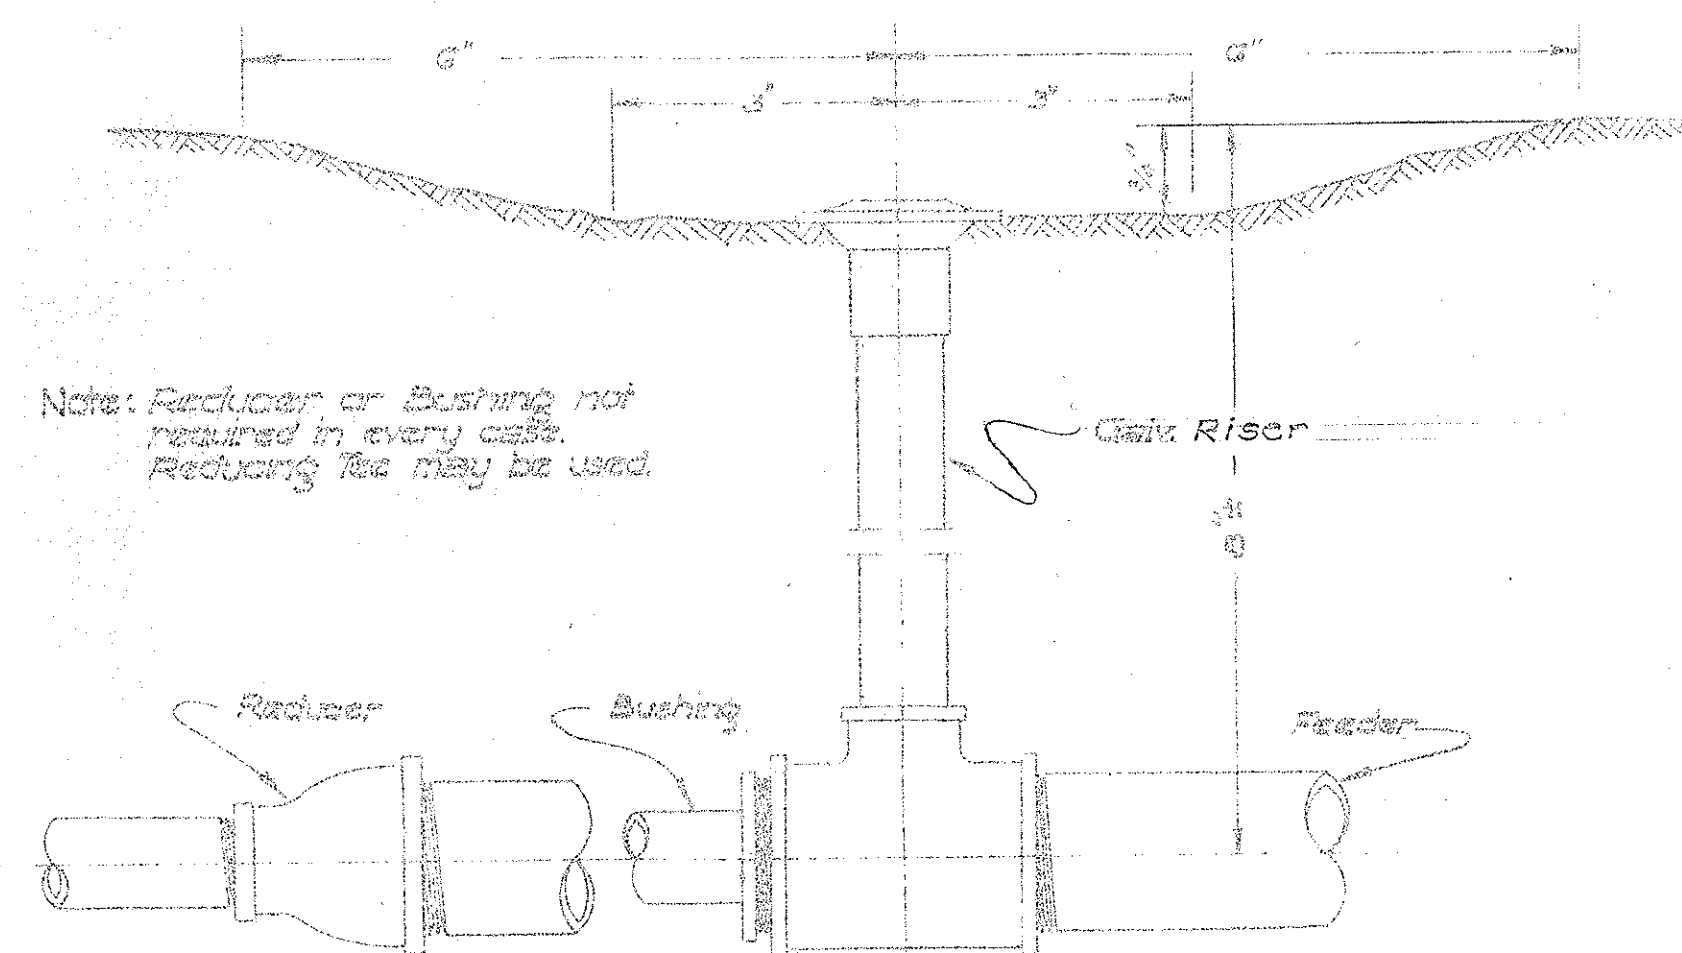


CONNECTION OF SPRINKLER HEAD TO FEEDER PIPE
Not to Scale

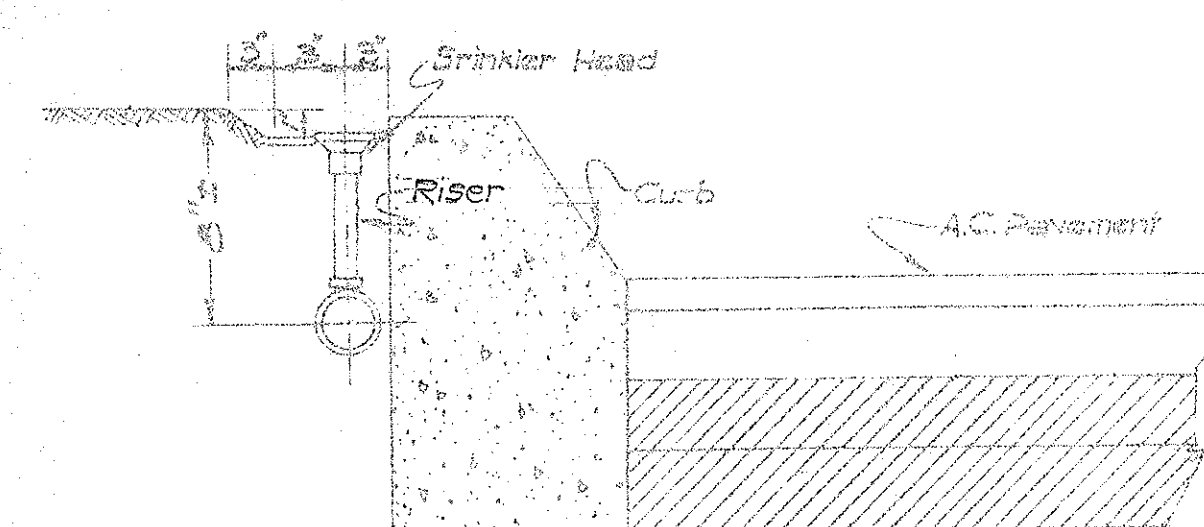


TYPICAL DETAIL OF SPRINKLER AT CONC. CURB
Not to Scale

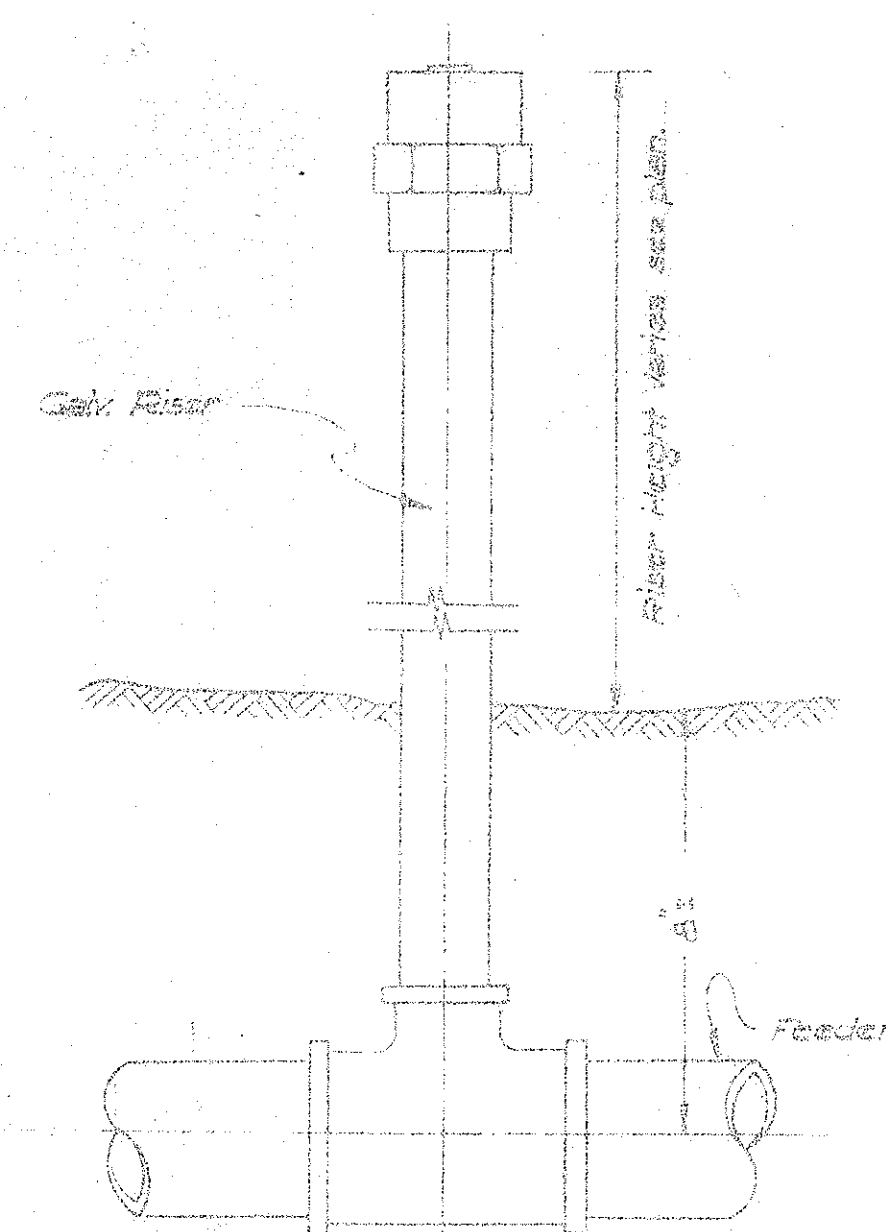


DETAIL OF SHRUBBERY HEAD
Not to Scale

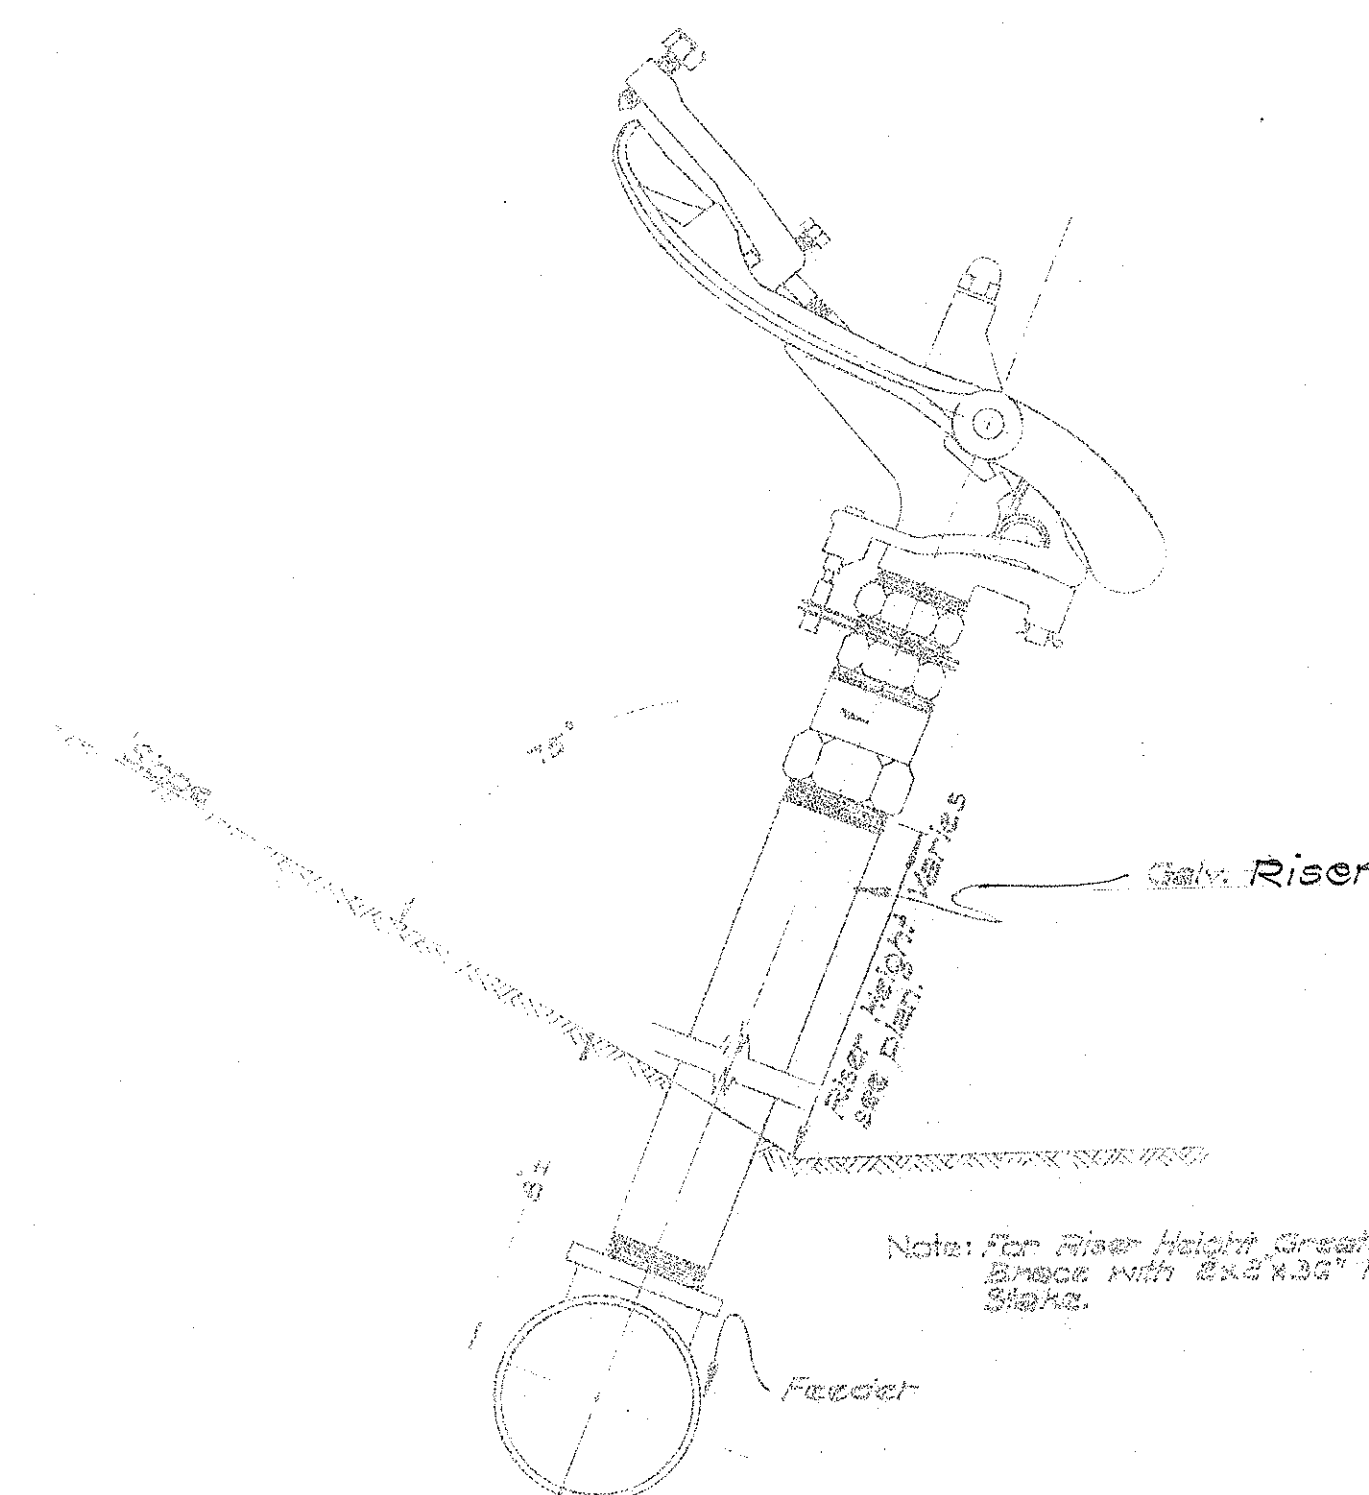


INSTALLATION OF JET SPRINKLER ON SLOPE
Not to Scale

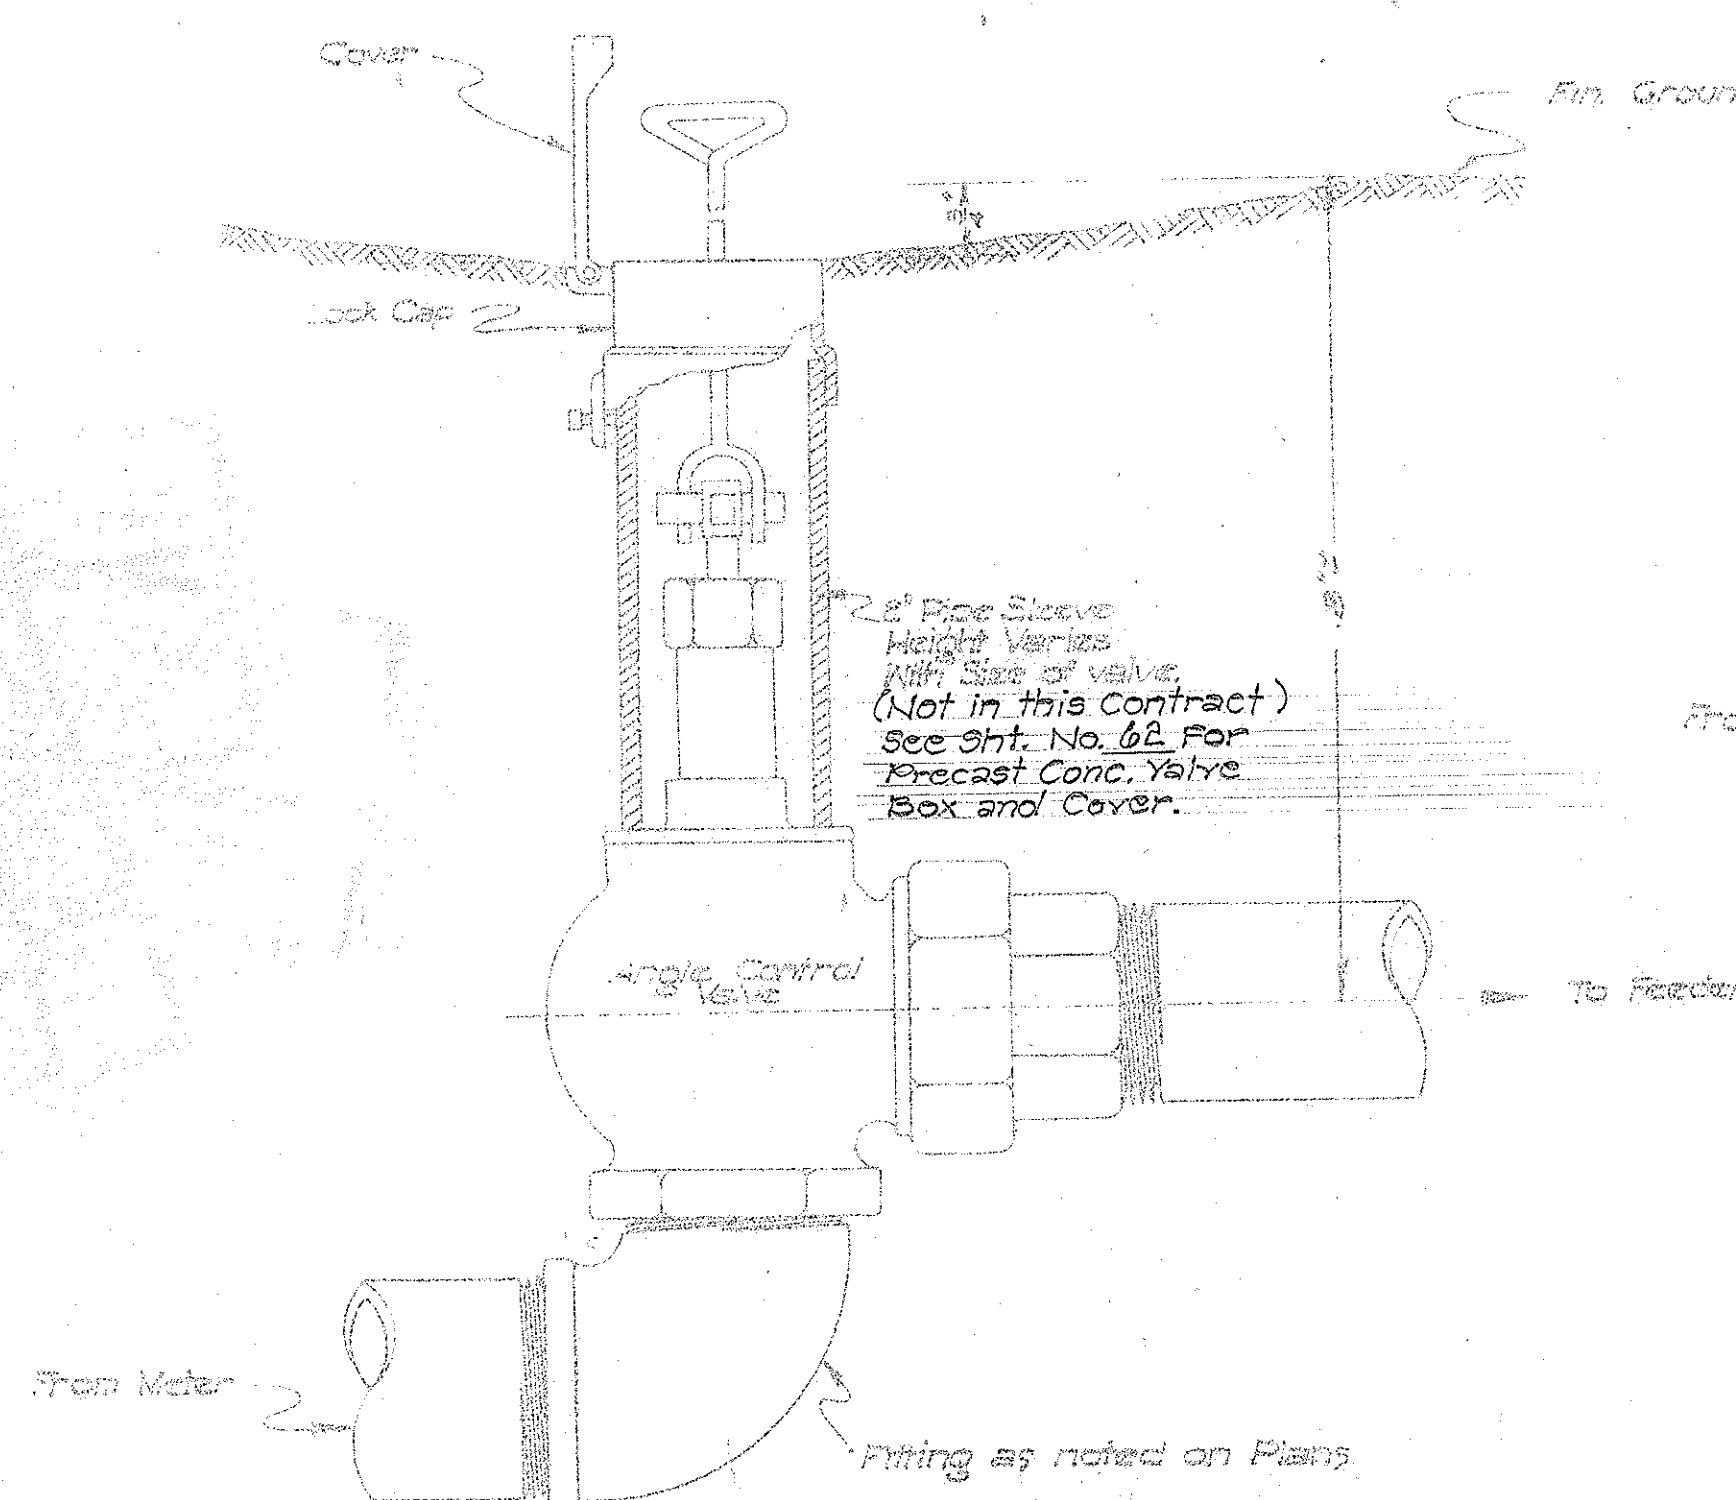

ANGLE CONTROL VALVE HOUSING & CAP
Not to Scale

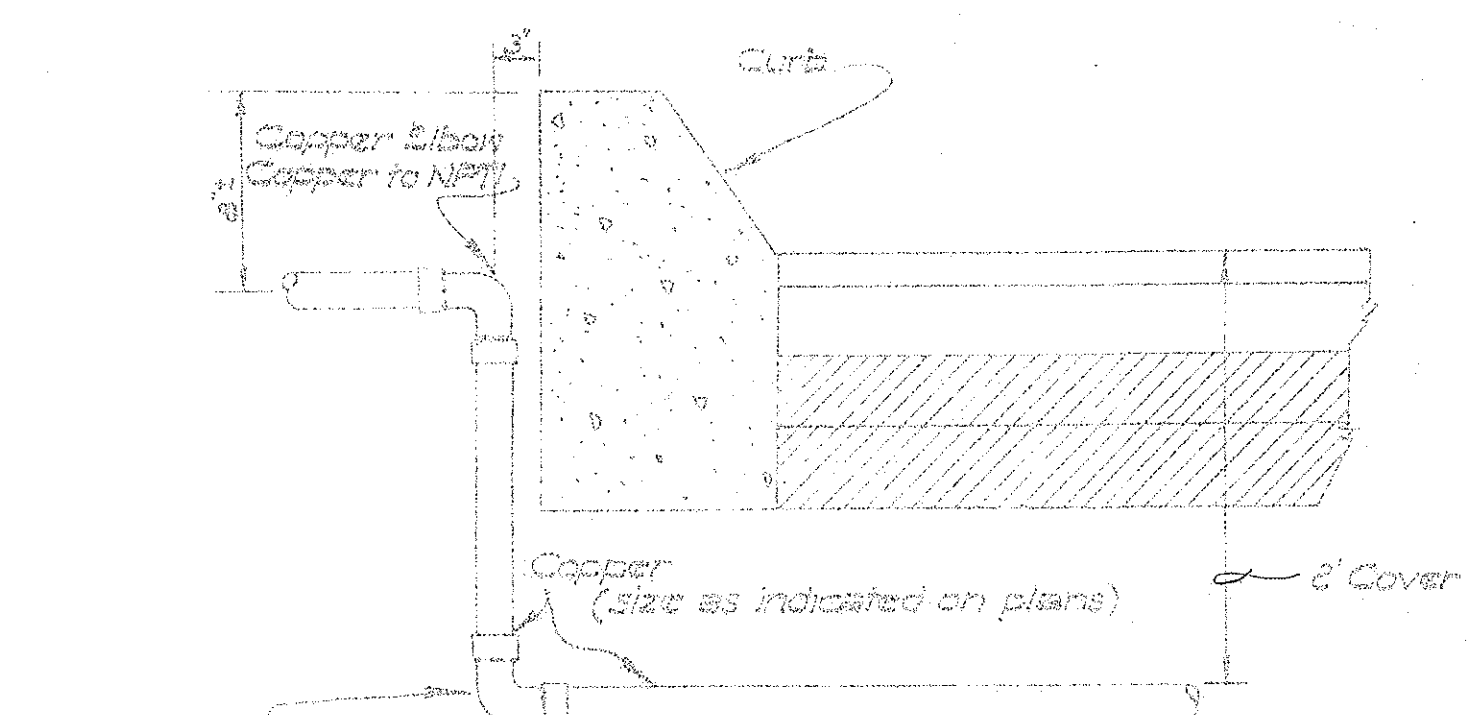

TYPICAL DETAIL OF ROADWAY CROSSING
Not to Scale

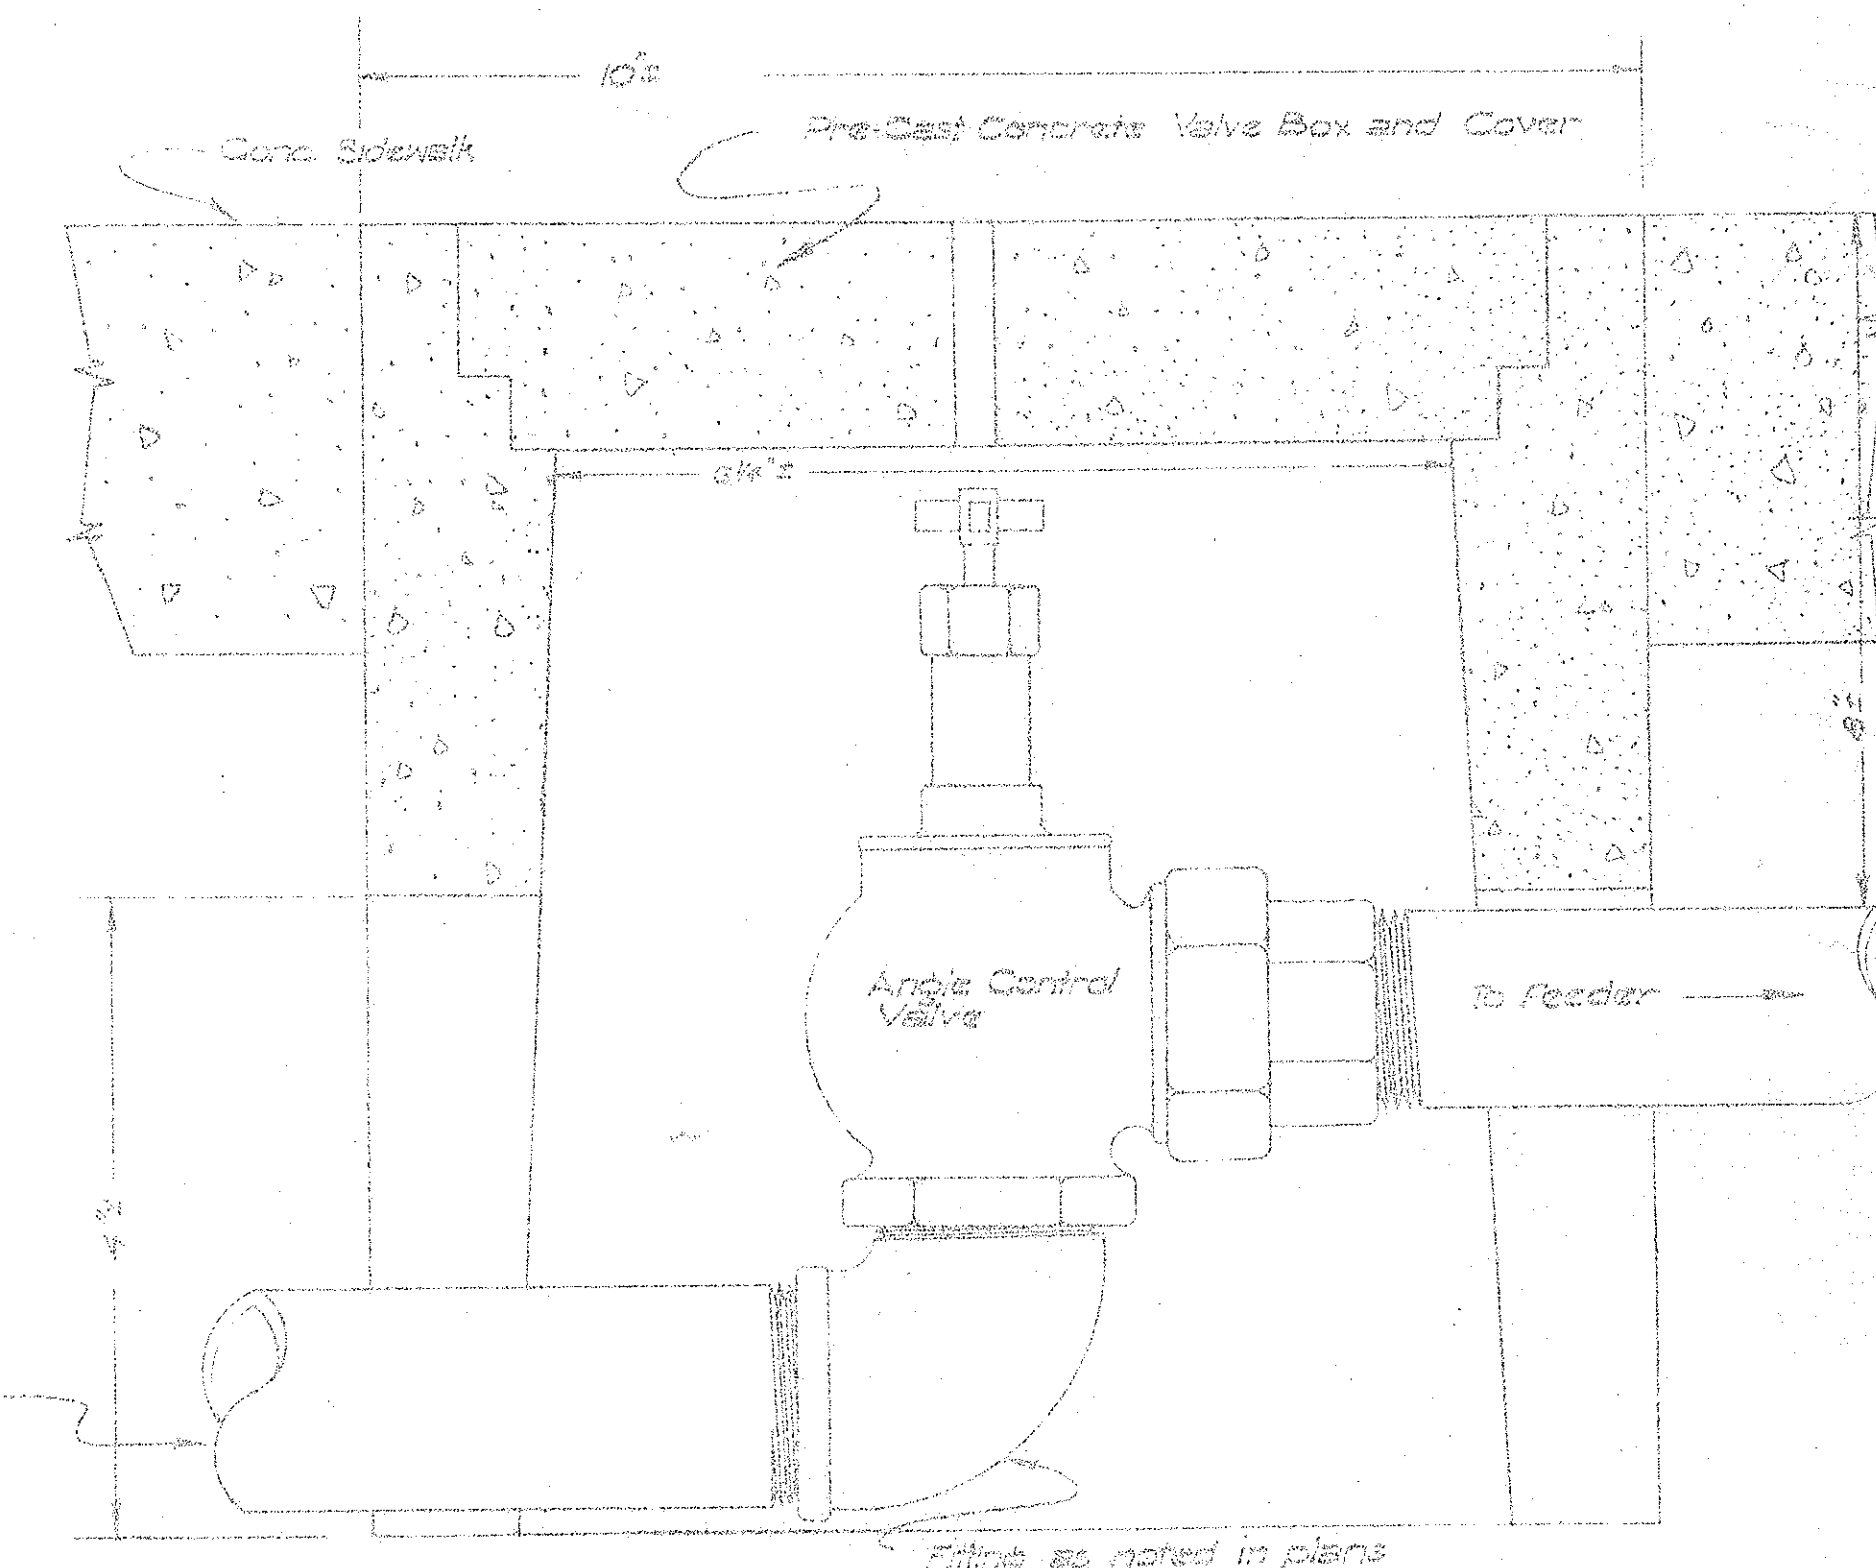

ANGLE CONTROL VALVE IN SIDEWALK AREA
Not to Scale

GENERAL NOTES

1. All copper pipes shall be connected with solder type fittings of bronze castings or wrought copper.
2. Pipes not noted "Copper" are to be Galvanized Steel pipes, and fittings not noted "Copper" are to be Galvanized Malleable Iron Fittings.
3. After complete installation of the sprinkler system, each sprinkler head shall be adjusted to the satisfaction of the Engineer.

APPROVED _____ DATE Aug. 25, 1959
STATE HIGHWAY ENGINEER

DEPARTMENT OF TRANSPORTATION
DIVISION OF HIGHWAYS
STATE OF HAWAII

STANDARD DETAILS SPRINKLER SYSTEM

Not to Scale

SHEET No. 7 OF 8 SHEETS

SPRINKLER

SUMMARY

[illegible]

ORIGINAL	SUBMIT FLOATED BY	DATE
PLAN	IRRAWAY CO.	
	TEACHER BY	
NOTE BOOK	PRESIDENT BY	
	QUANTITIES BY	
	CORRECTED BY	