


FED. ROAD DIST. NO.	STATE	FED. AID PROJ. NO.	FISCAL YEAR	SHEET NO.	TOTAL SHEETS
HAWAII	HAW.	I-H-1 (84)	1965	7	64

PLAN	DATE	BY
SURVEYED		
PLOTTED		
NOTE BOOK		
RT. OF WAY CHECKED		
NO.		

PROFILE	DATE	BY
SURVEYED		
PLOTTED		
NOTE BOOK		
STRUCTURE NOTATIONS CHVD.		
NO.		

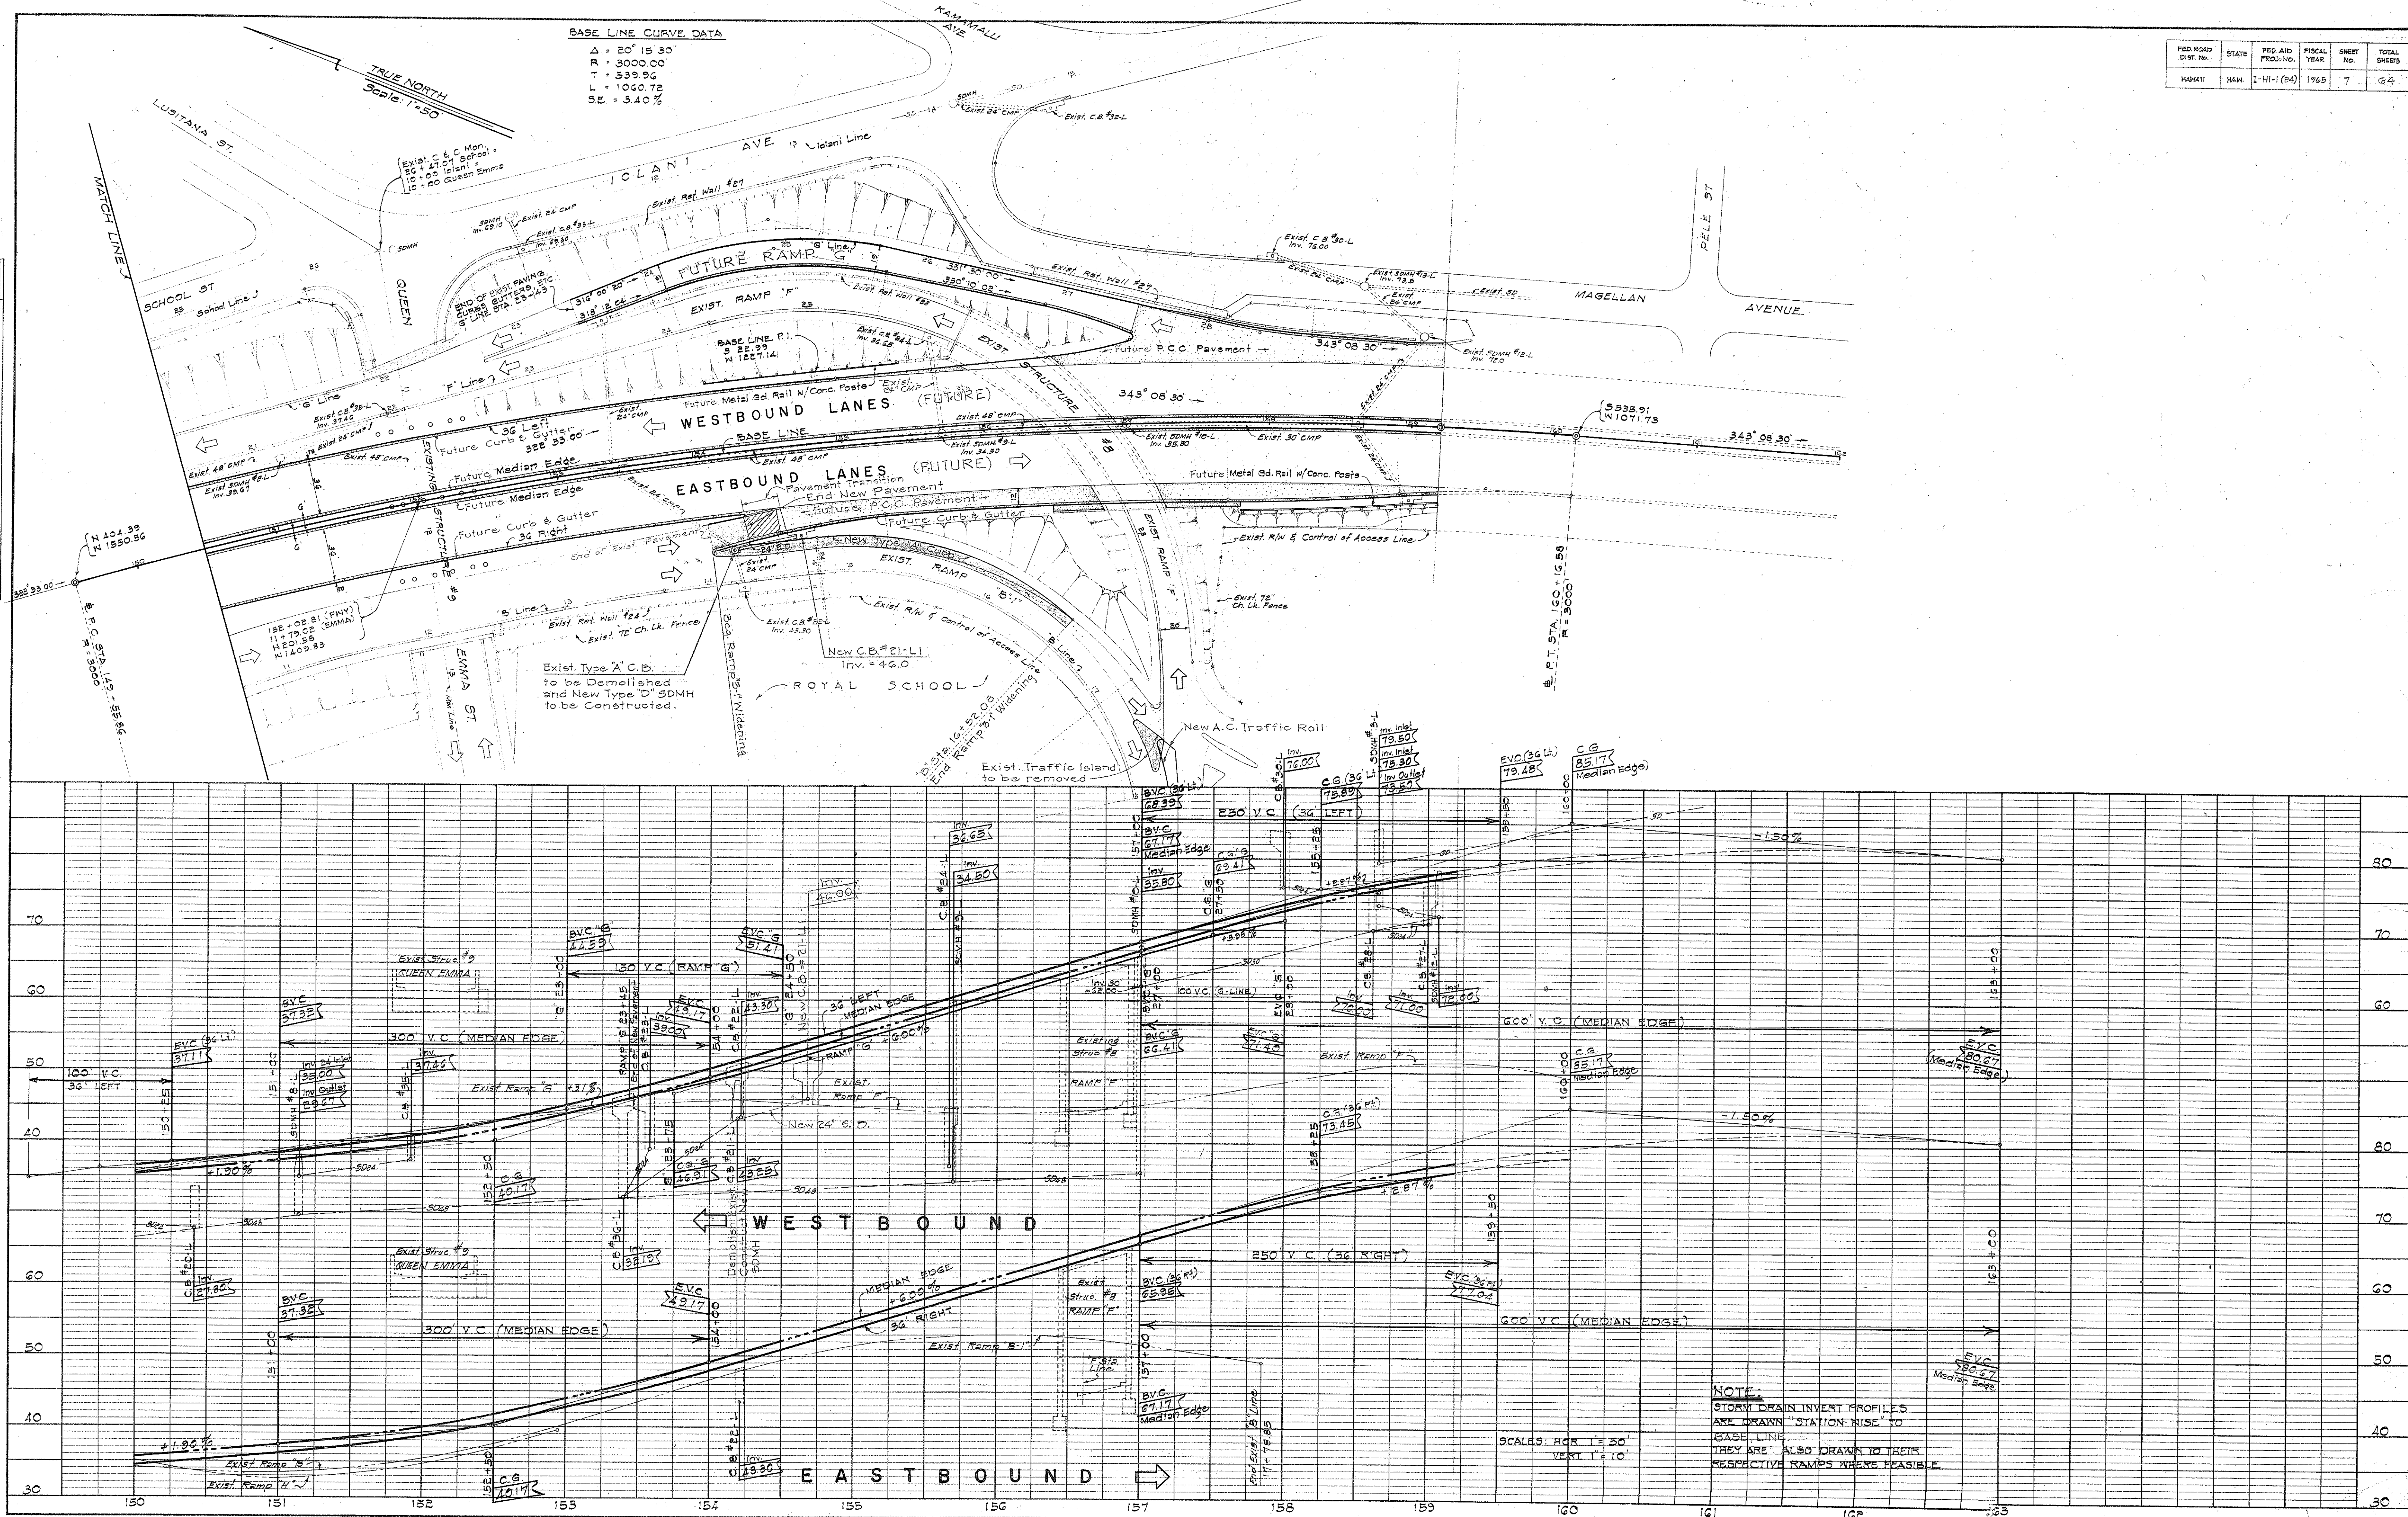

00-H-6