

1. Azimuths referred to Round Top "Trig" Station
2. Coordinates referred to Kaimuki "Trig" Station
3. Bench Mark elevations referred to Mean Sea Level Datum
4. Existing Dwellings, Garages, Patios, or Sheds numbered (B-1) to (B-4) inclusive shall be demolished. See "Special Provisions."

B.M. *K-25 El. 180.55
C & C Mon. 14th Ave and
Harding Ave.



$\Delta = 45^\circ 40' 30''$	
$R = 2200.00$	Rev
$T = 926.49$	of
$L = 1753.79$	

Original Log
of 35' E.P.

Note: The pole hole is completed at original location to be abandoned.

Line

D. $\frac{1}{24}$

50' E P.C. to C (14th Ave)



Time No 301

Cut-off Ditch

[illegible]

— 100 —

[illegible][illegible][illegible]

Case	Country	Year	Population	Age	Gender	Occupation	Education	Marital Status	Religion	Health Status	Family Size	Income	Assets	Debt	Other
1	USA	1995	250,000,000	35	M	Teacher	High School	Married	Protestant	Good	3	\$20,000	House, Car	\$5,000	
2	USA	1995	250,000,000	45	F	Homemaker	High School	Married	Catholic	Good	2	\$15,000	House, Car	\$3,000	
3	USA	1995	250,000,000	55	M	Retired	High School	Married	Protestant	Good	2	\$25,000	House, Car	\$7,000	
4	USA	1995	250,000,000	65	F	Retired	High School	Married	Catholic	Good	2	\$20,000	House, Car	\$5,000	
5	USA	1995	250,000,000	75	M	Retired	High School	Married	Protestant	Good	2	\$25,000	House, Car	\$7,000	
6	USA	1995	250,000,000	85	F	Retired	High School	Married	Catholic	Good	2	\$20,000	House, Car	\$5,000	
7	USA	1995	250,000,000	95	M	Retired	High School	Married	Protestant	Good	2	\$25,000	House, Car	\$7,000	
8	USA	1995	250,000,000	105	F	Retired	High School	Married	Catholic	Good	2	\$20,000	House, Car	\$5,000	
9	USA	1995	250,000,000	115	M	Retired	High School	Married	Protestant	Good	2	\$25,000	House, Car	\$7,000	
10	USA	1995	250,000,000	125	F	Retired	High School	Married	Catholic	Good	2	\$20,000	House, Car	\$5,000	



Existing Ground

[illegible]

Country	Year	Population (millions)	Urban population (millions)	Urban population (%)	Population density (per sq km)
Algeria	1980	10.5	5.5	52.4	10.5
Algeria	1985	11.5	6.5	56.5	11.5
Algeria	1990	12.5	7.5	60.0	12.5
Algeria	1995	13.5	8.5	62.2	13.5
Algeria	2000	14.5	9.5	65.5	14.5
Algeria	2005	15.5	10.5	67.7	15.5
Algeria	2010	16.5	11.5	70.0	16.5
Algeria	2015	17.5	12.5	71.4	17.5
Algeria	2020	18.5	13.5	72.9	18.5
Algeria	2025	19.5	14.5	74.4	19.5
Algeria	2030	20.5	15.5	75.6	20.5
Algeria	2035	21.5	16.5	76.7	21.5
Algeria	2040	22.5	17.5	77.8	22.5
Algeria	2045	23.5	18.5	78.7	23.5
Algeria	2050	24.5	19.5	79.6	24.5
Algeria	2055	25.5	20.5	80.4	25.5
Algeria	2060	26.5	21.5	81.1	26.5
Algeria	2065	27.5	22.5	81.8	27.5
Algeria	2070	28.5	23.5	82.5	28.5
Algeria	2075	29.5	24.5	83.4	29.5
Algeria	2080	30.5	25.5	83.6	30.5
Algeria	2085	31.5	26.5	84.1	31.5
Algeria	2090	32.5	27.5	84.6	32.5
Algeria	2095	33.5	28.5	85.1	33.5
Algeria	2100	34.5	29.5	85.5	34.5
Algeria	2105	35.5	30.5	86.0	35.5
Algeria	2110	36.5	31.5	86.3	36.5
Algeria	2115	37.5	32.5	86.7	37.5
Algeria	2120	38.5	33.5	87.0	38.5
Algeria	2125	39.5	34.5	87.4	39.5
Algeria	2130	40.5	35.5	87.7	40.5
Algeria	2135	41.5	36.5	88.0	41.5
Algeria	2280	70.5	65.5	96.7	70.5

[illegible]

New Storm Drain
(Sizes Indicated)

1	2	3	4
5	6	7	8
9	10	11	12
13	14	15	16
17	18	19	20
21	22	23	24
25	26	27	28
29	30	31	32
33	34	35	36
37	38	39	40
41	42	43	44
45	46	47	48
49	50	51	52
53	54	55	56
57	58	59	60
61	62	63	64
65	66	67	68
69	70	71	72
73	74	75	76
77	78	79	80
81	82	83	84
85	86	87	88
89	90	91	92
93	94	95	96
97	98	99	100

1	2	3	466
---	---	---	---	---	---	---	---	---	----	----	-----	-----	
[illegible]

Figure 1 displays 16 small plots arranged in a 4x4 grid, showing the spatial distribution of the number of species per 100 m². The plots are labeled with numbers 1 through 16 in the top left corner of each plot. The plots show varying degrees of species richness and spatial heterogeneity, with some plots showing high species richness and others showing low species richness.

[illegible]


Category	Sub-category	Item	Item description	Item description
1. General information	1.1. General information	1.1.1. General information	1.1.1. General information	1.1.1. General information
		1.1.2. General information	1.1.2. General information	1.1.2. General information
		1.1.3. General information	1.1.3. General information	1.1.3. General information
		1.1.4. General information	1.1.4. General information	1.1.4. General information
2. Specific information	2.1. Specific information	2.1.1. Specific information	2.1.1. Specific information	2.1.1. Specific information
		2.1.2. Specific information	2.1.2. Specific information	2.1.2. Specific information
		2.1.3. Specific information	2.1.3. Specific information	2.1.3. Specific information
		2.1.4. Specific information	2.1.4. Specific information	2.1.4. Specific information
3. Additional information	3.1. Additional information	3.1.1. Additional information	3.1.1. Additional information	3.1.1. Additional information
		3.1.2. Additional information	3.1.2. Additional information	3.1.2. Additional information
		3.1.3. Additional information	3.1.3. Additional information	3.1.3. Additional information
		3.1.4. Additional information	3.1.4. Additional information	3.1.4. Additional information

3 !

[illegible]

Copyright © 2010 John Wiley & Sons, Ltd.

Note: The boring data shown on these plans are for design purposes only, and are for the conveniences of the Engineer in control of earthwork. The borings were carefully taken and are believed to be reliable, however, the Department assumes no responsibility whatsoever in respect to the sufficiency or accuracy of the borings, or of the interpretation thereof, and will not either impliedly or expressly make any guarantee of any of the same.

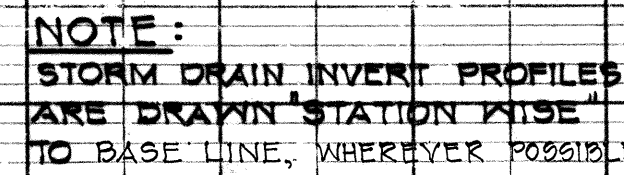

PLAN	DATE	BY
SURVEYED		
ALIGNED		
NOTE BOOK		
RT. OF WAY CHECKED		
NO.		

PROFILE	DATE	BY
SURVEYED		
PLOTTED		
NOTE BOOK		
GRADES CHECKED		
STRUCTURE NOTATIONS CHKO.		
NO.		

