

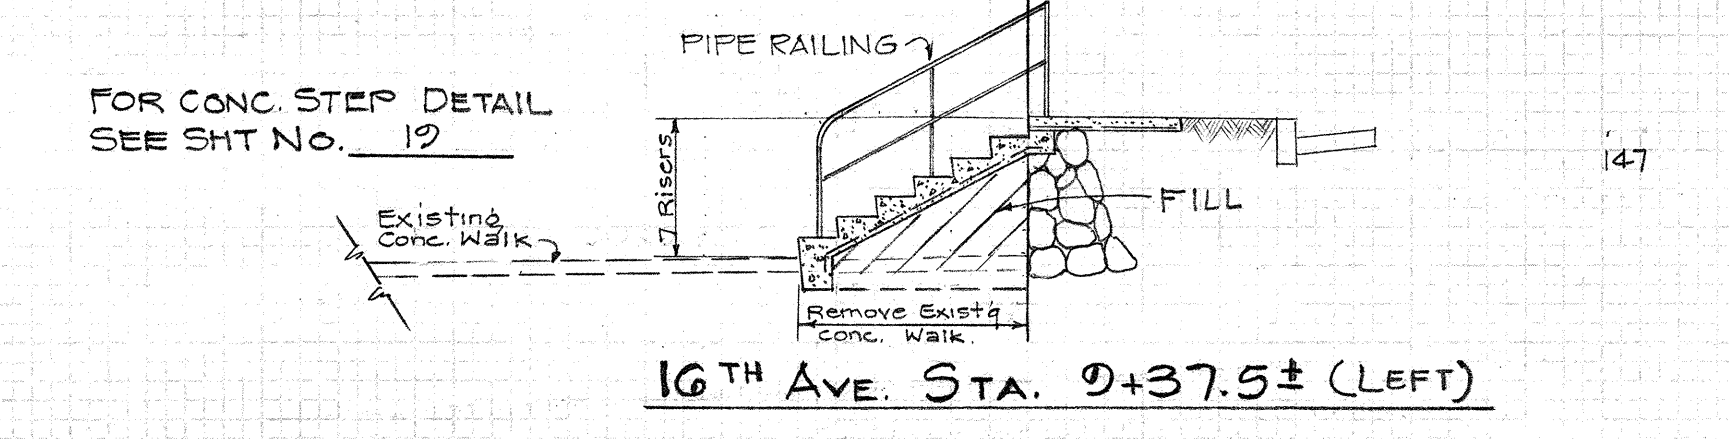
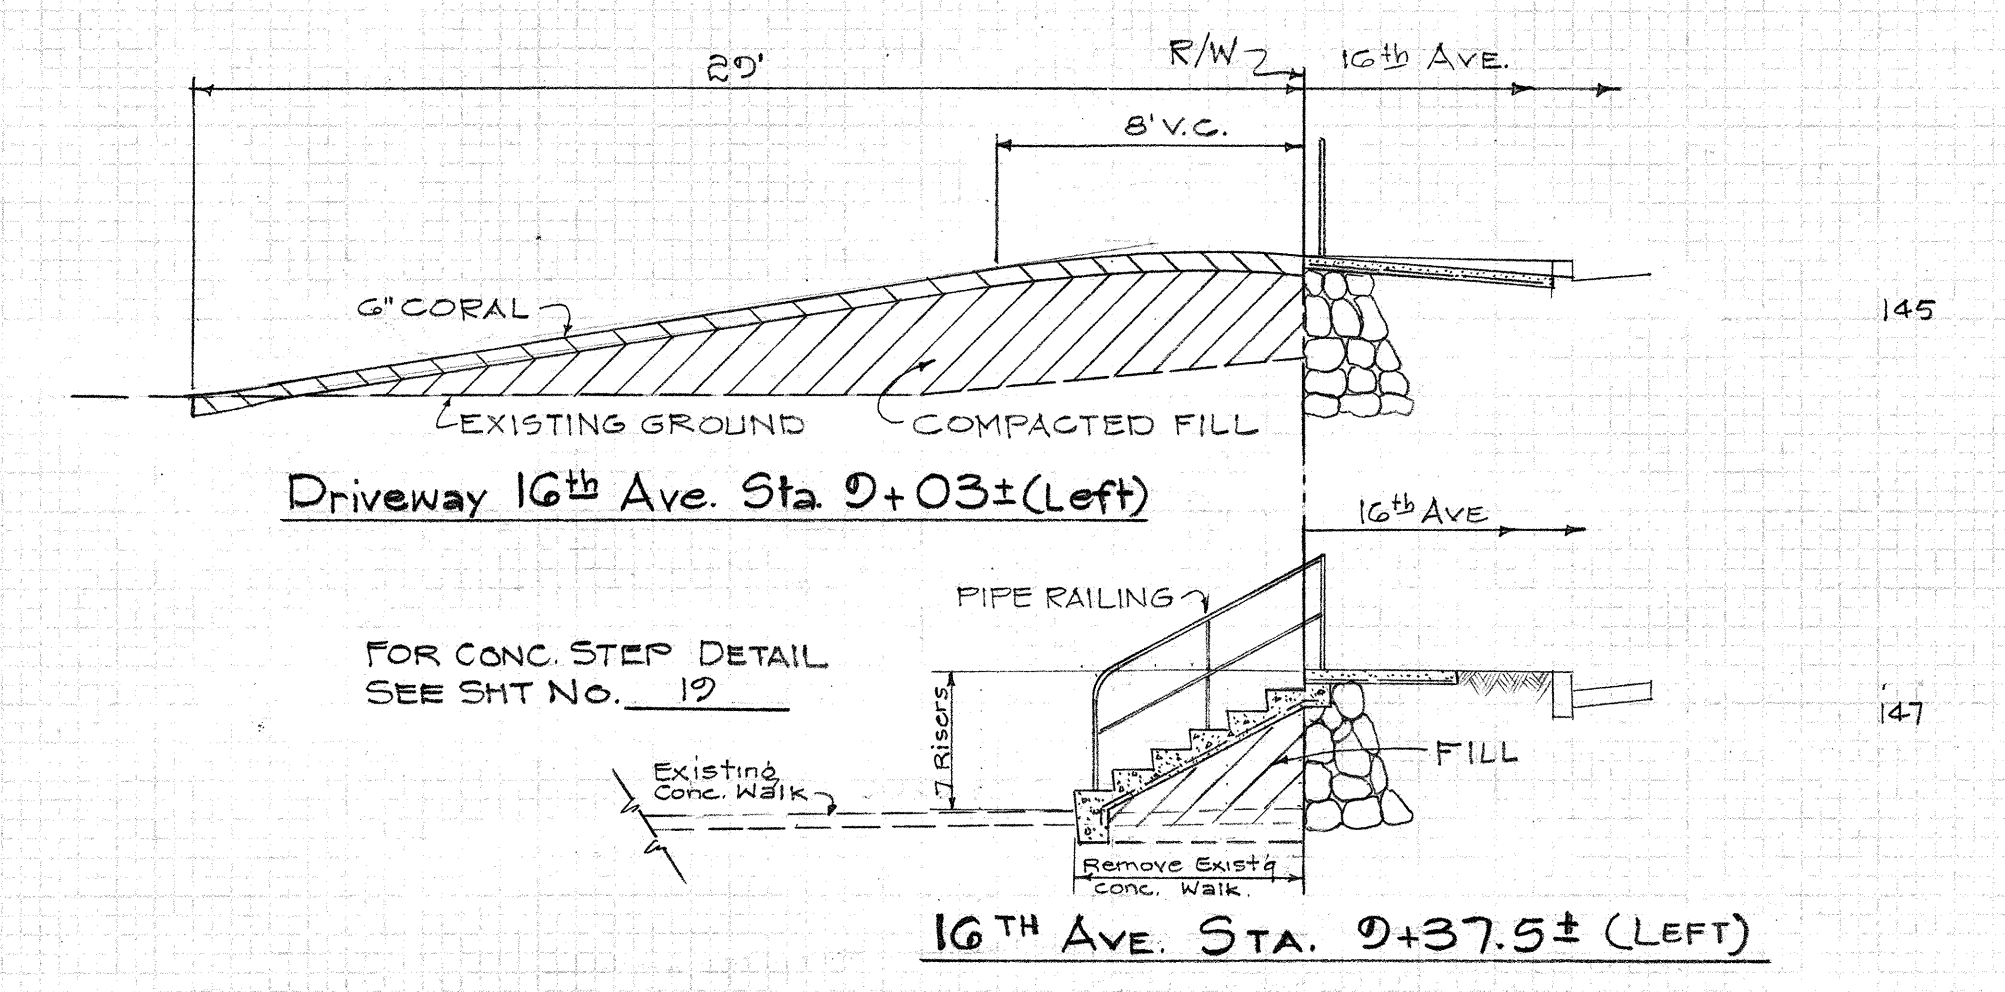
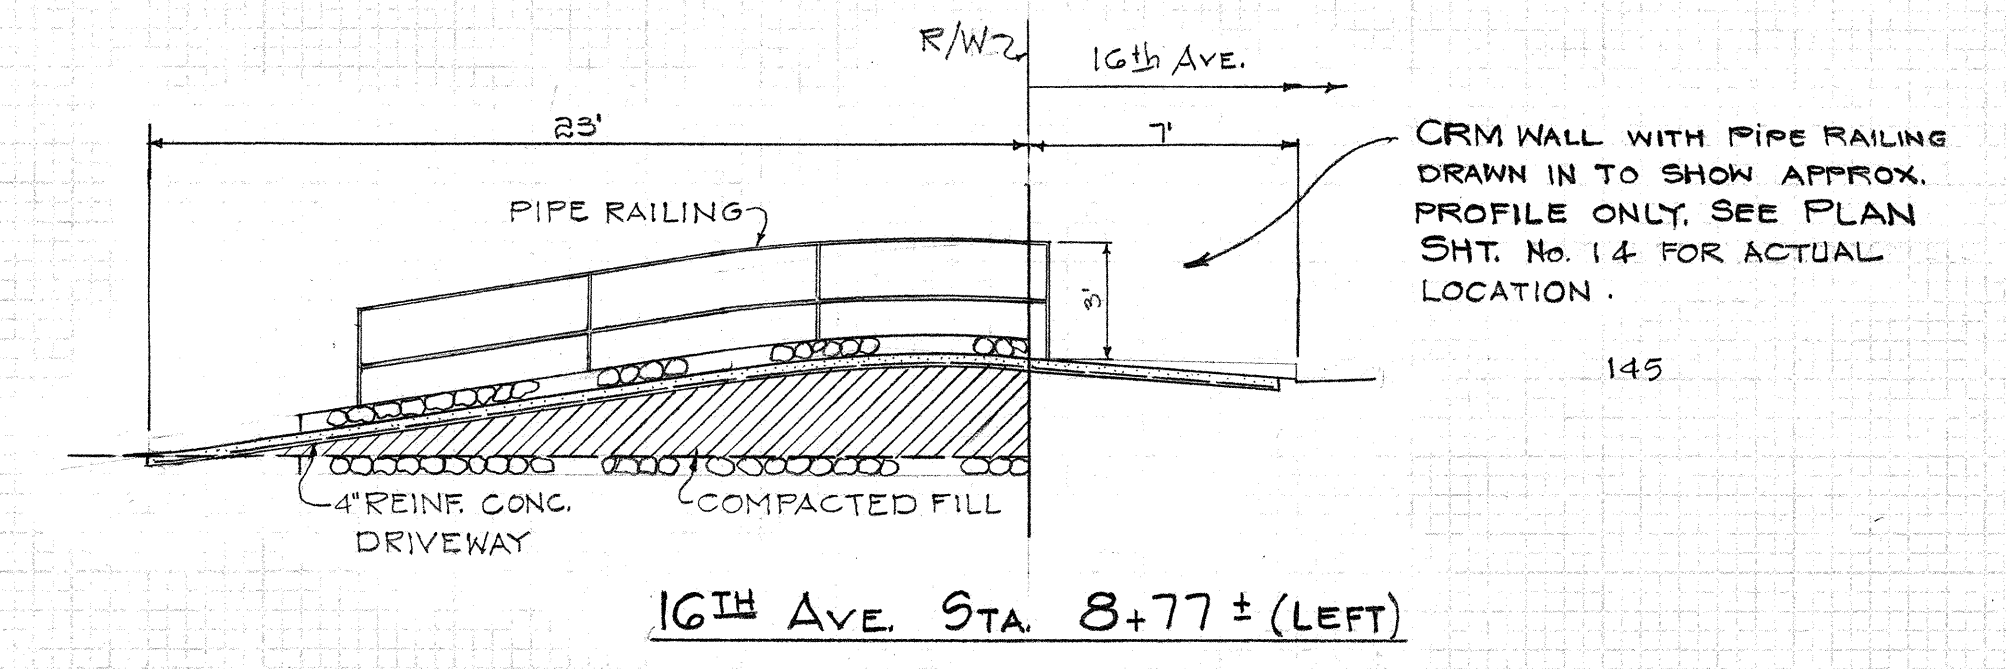
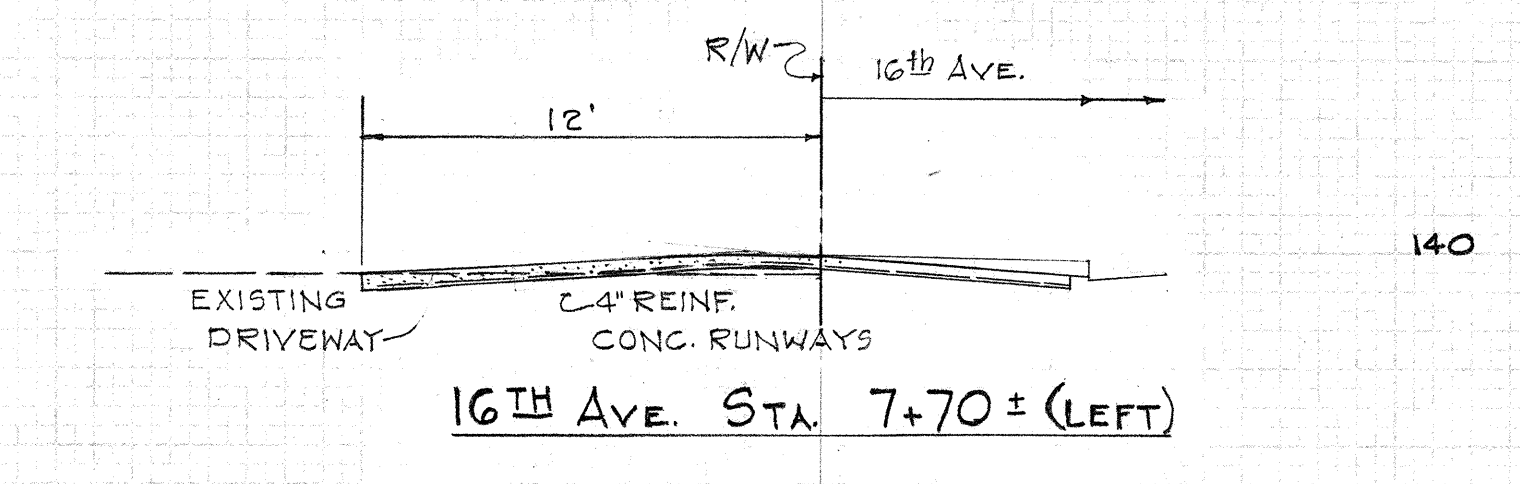
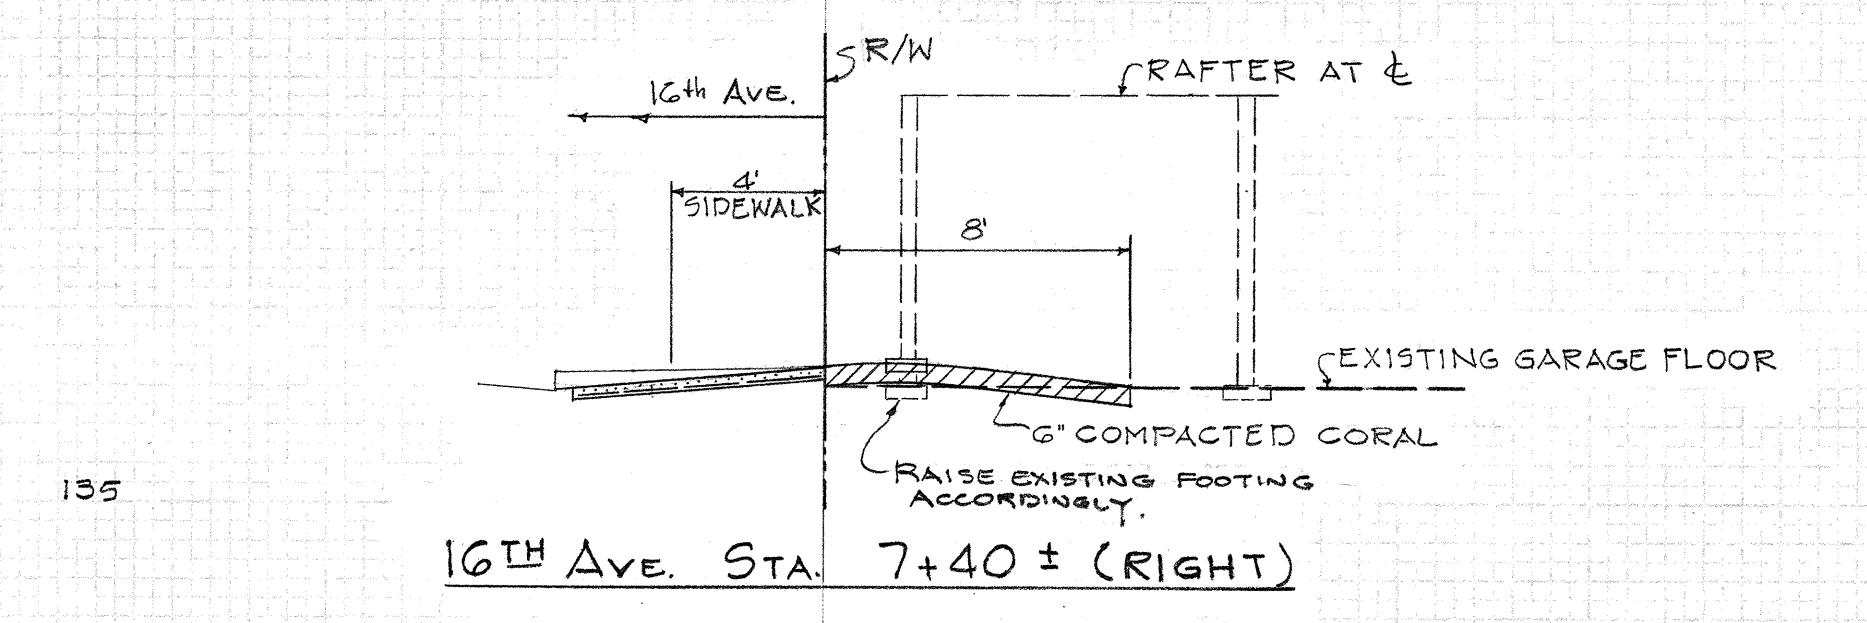
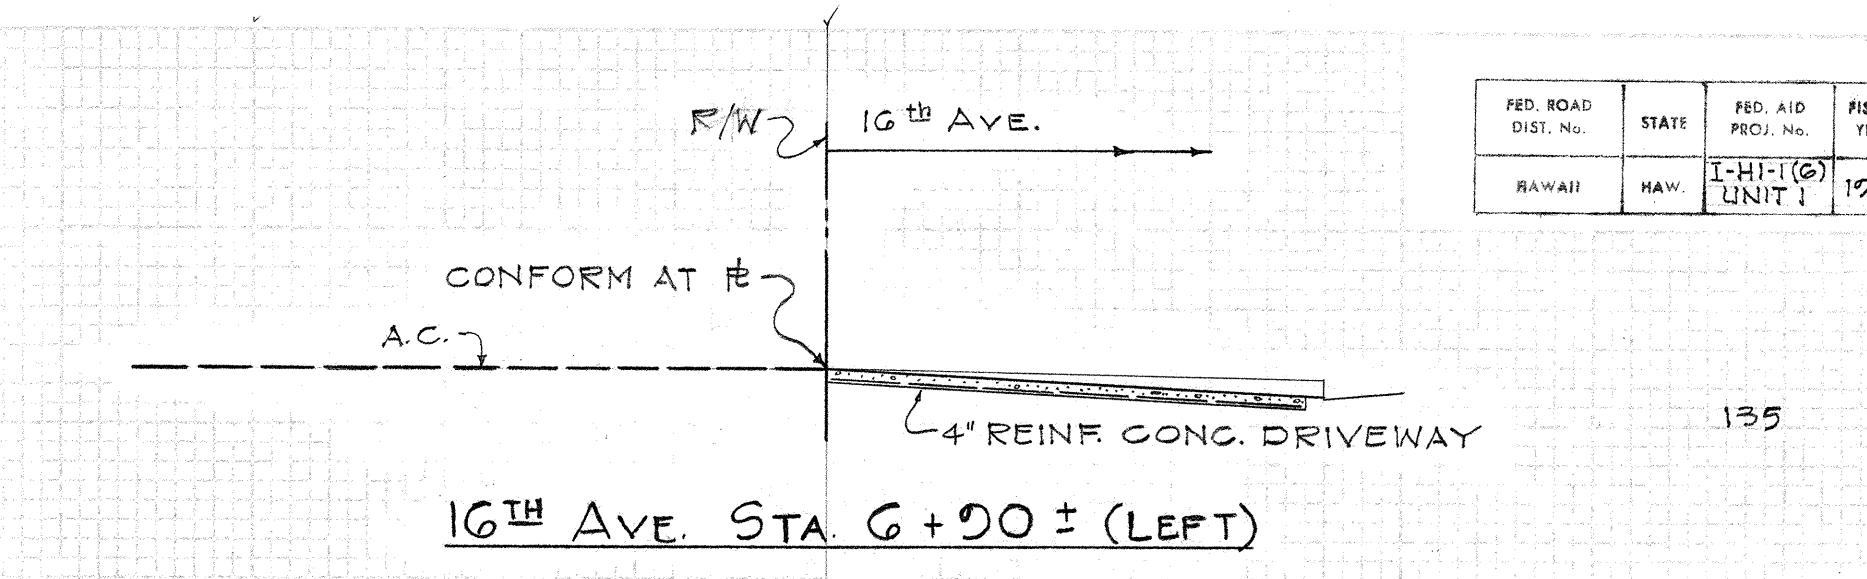
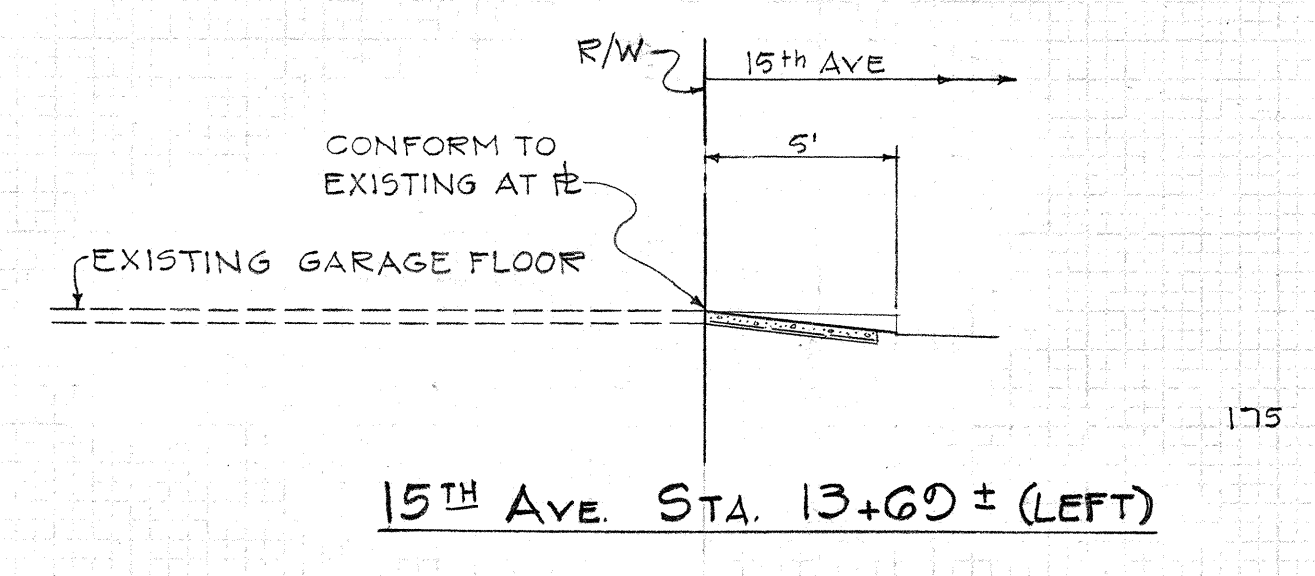
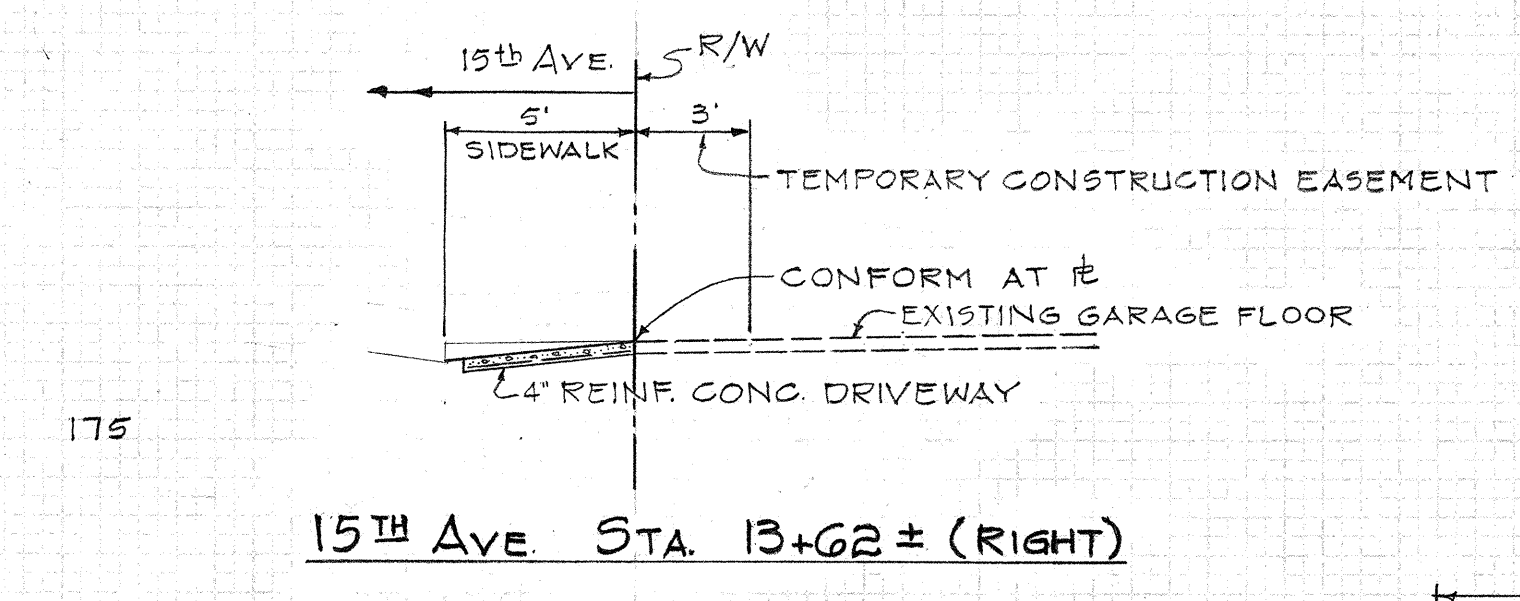
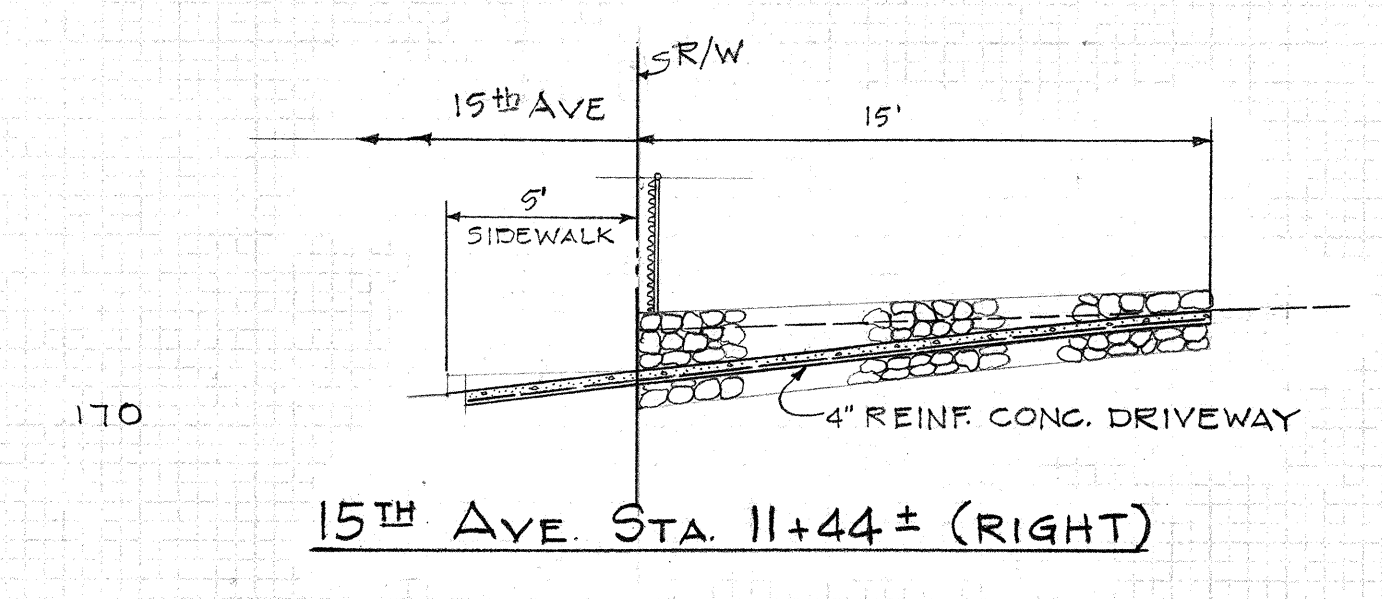
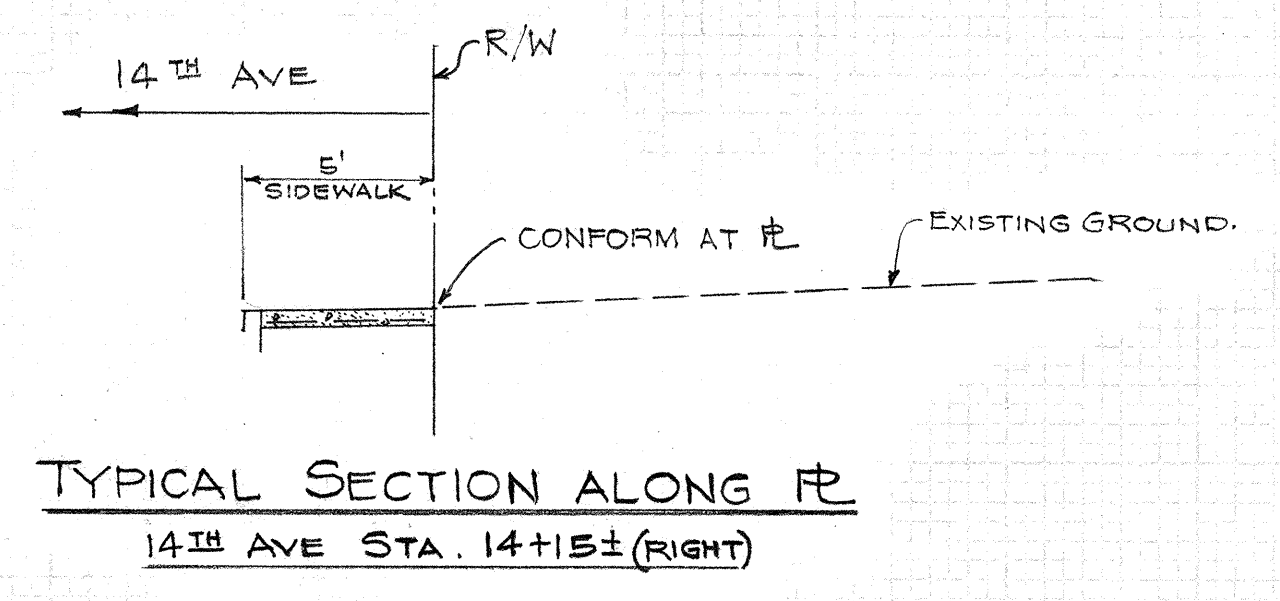
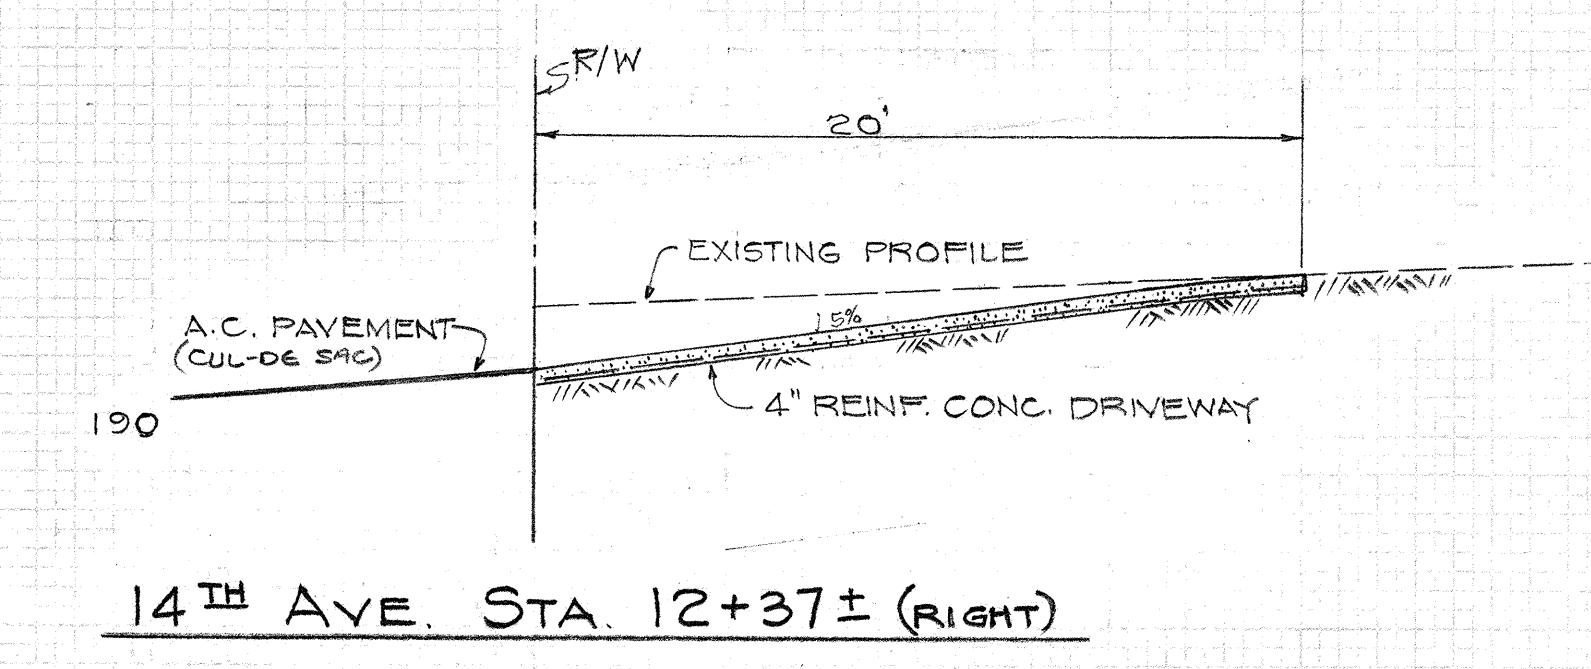
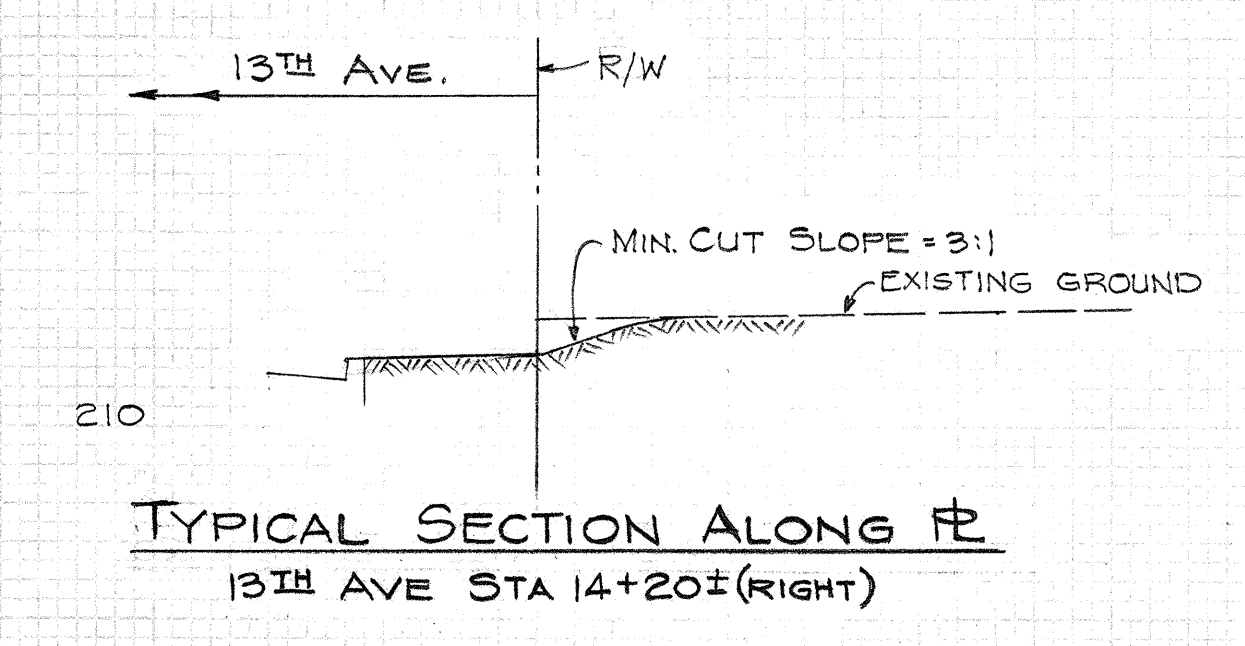
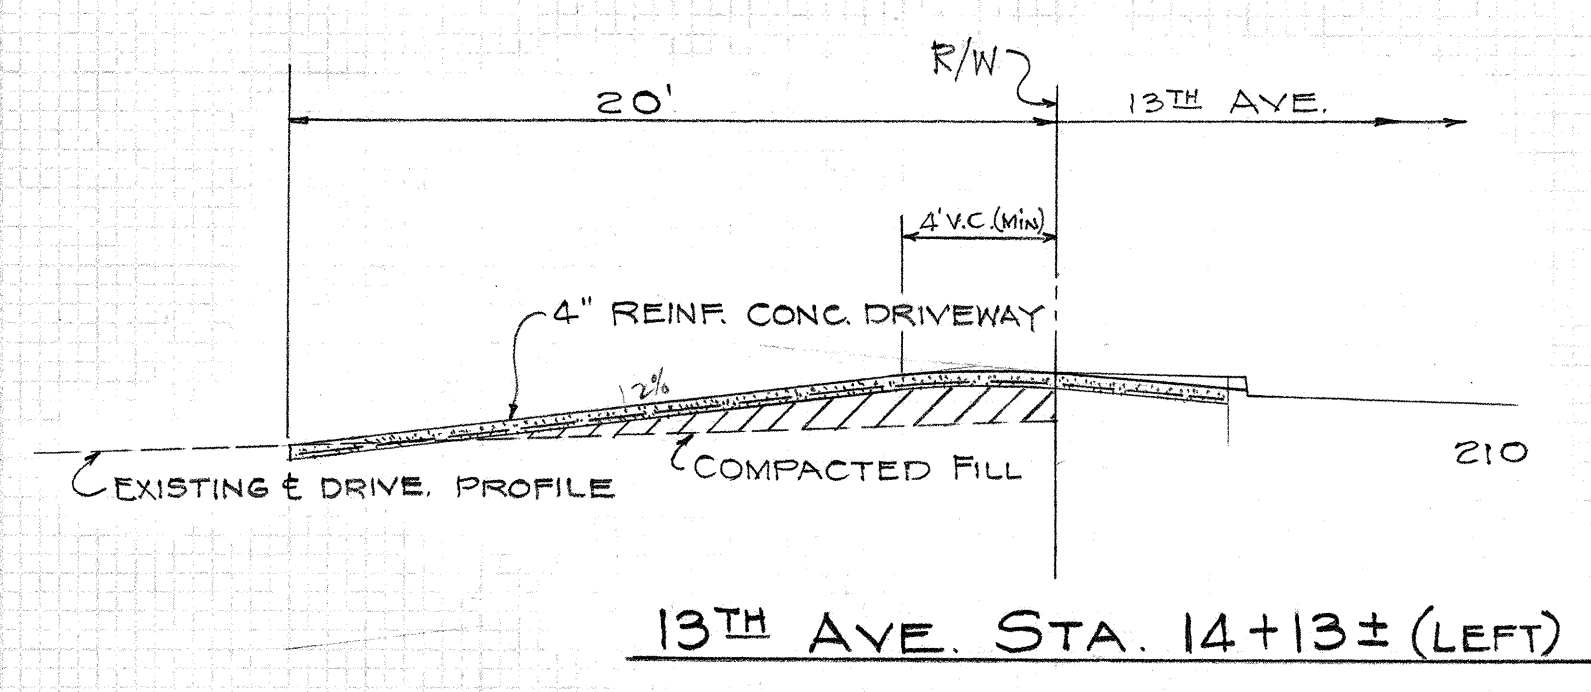
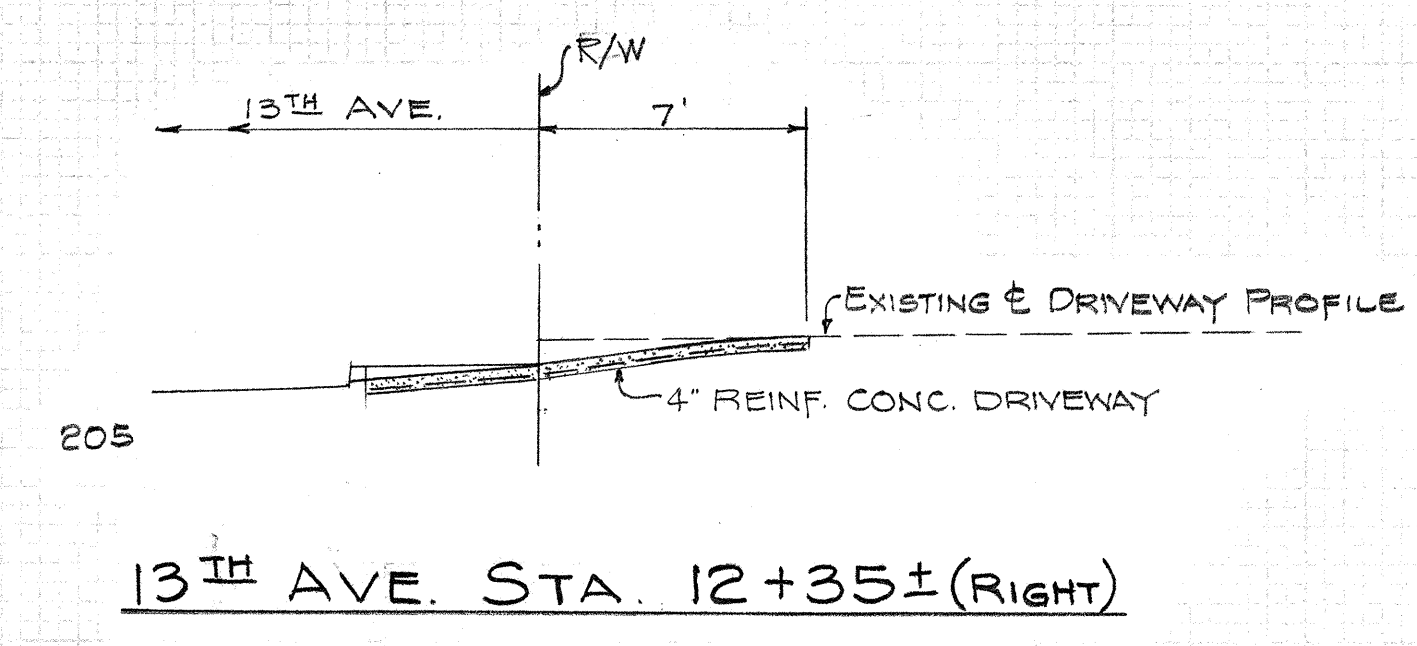
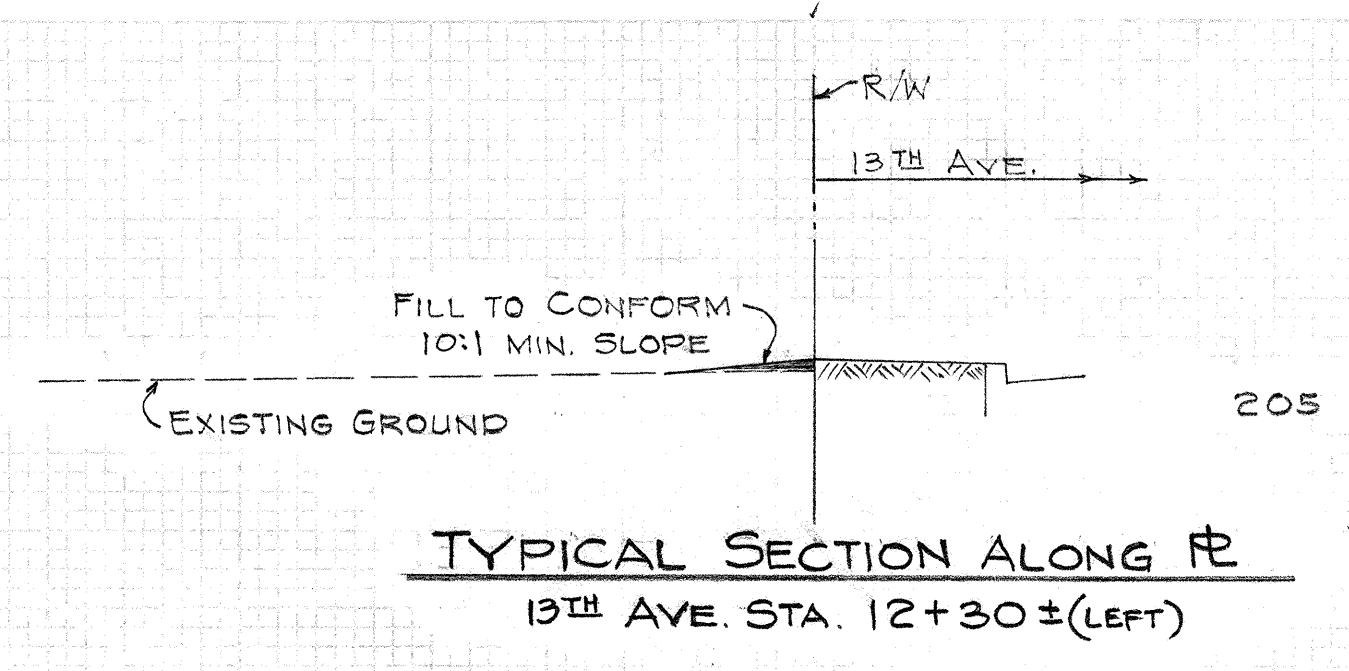
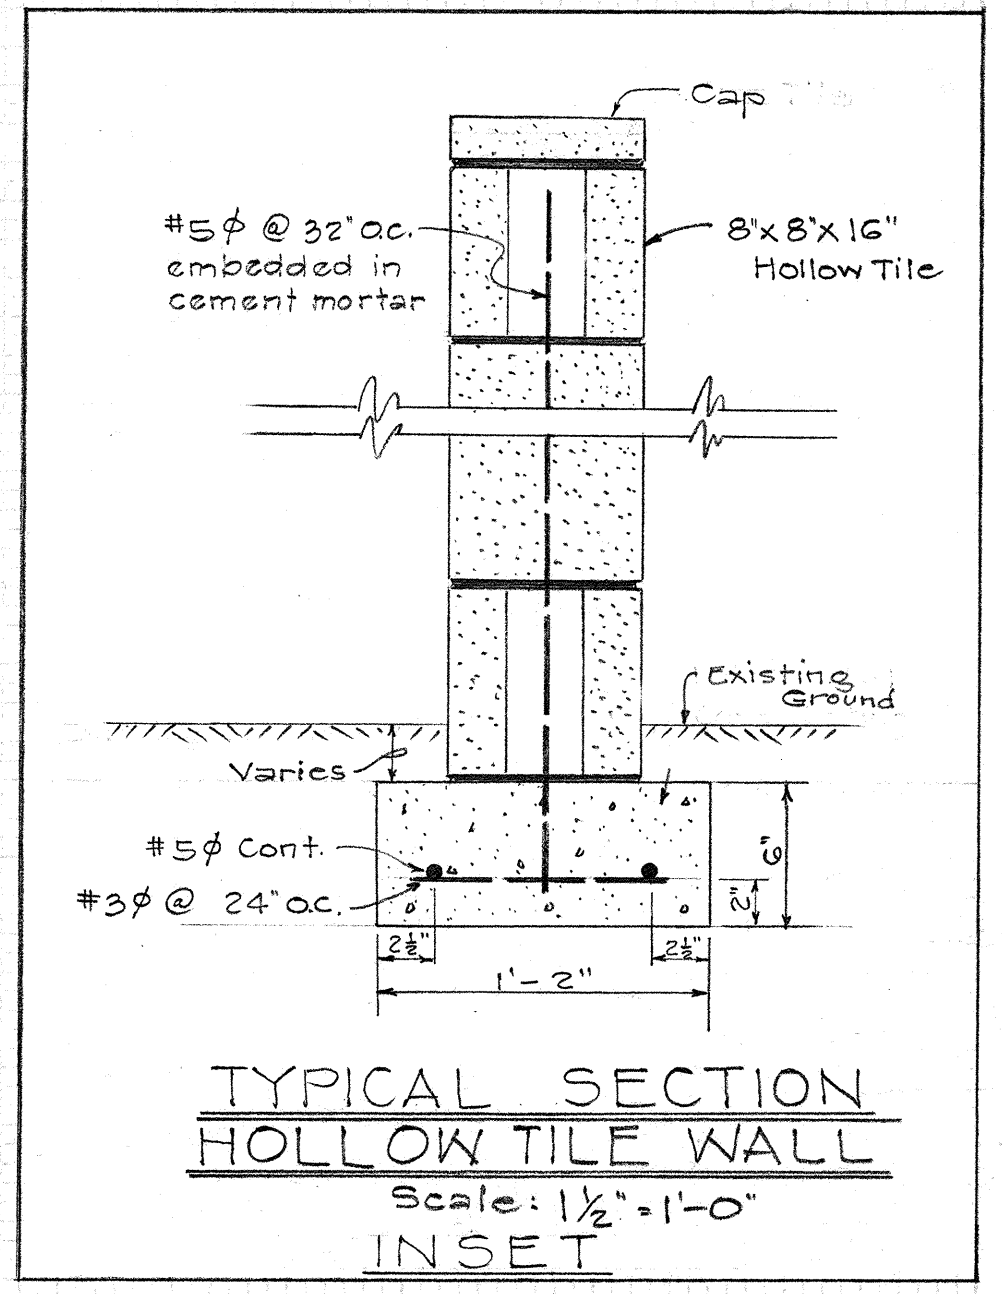
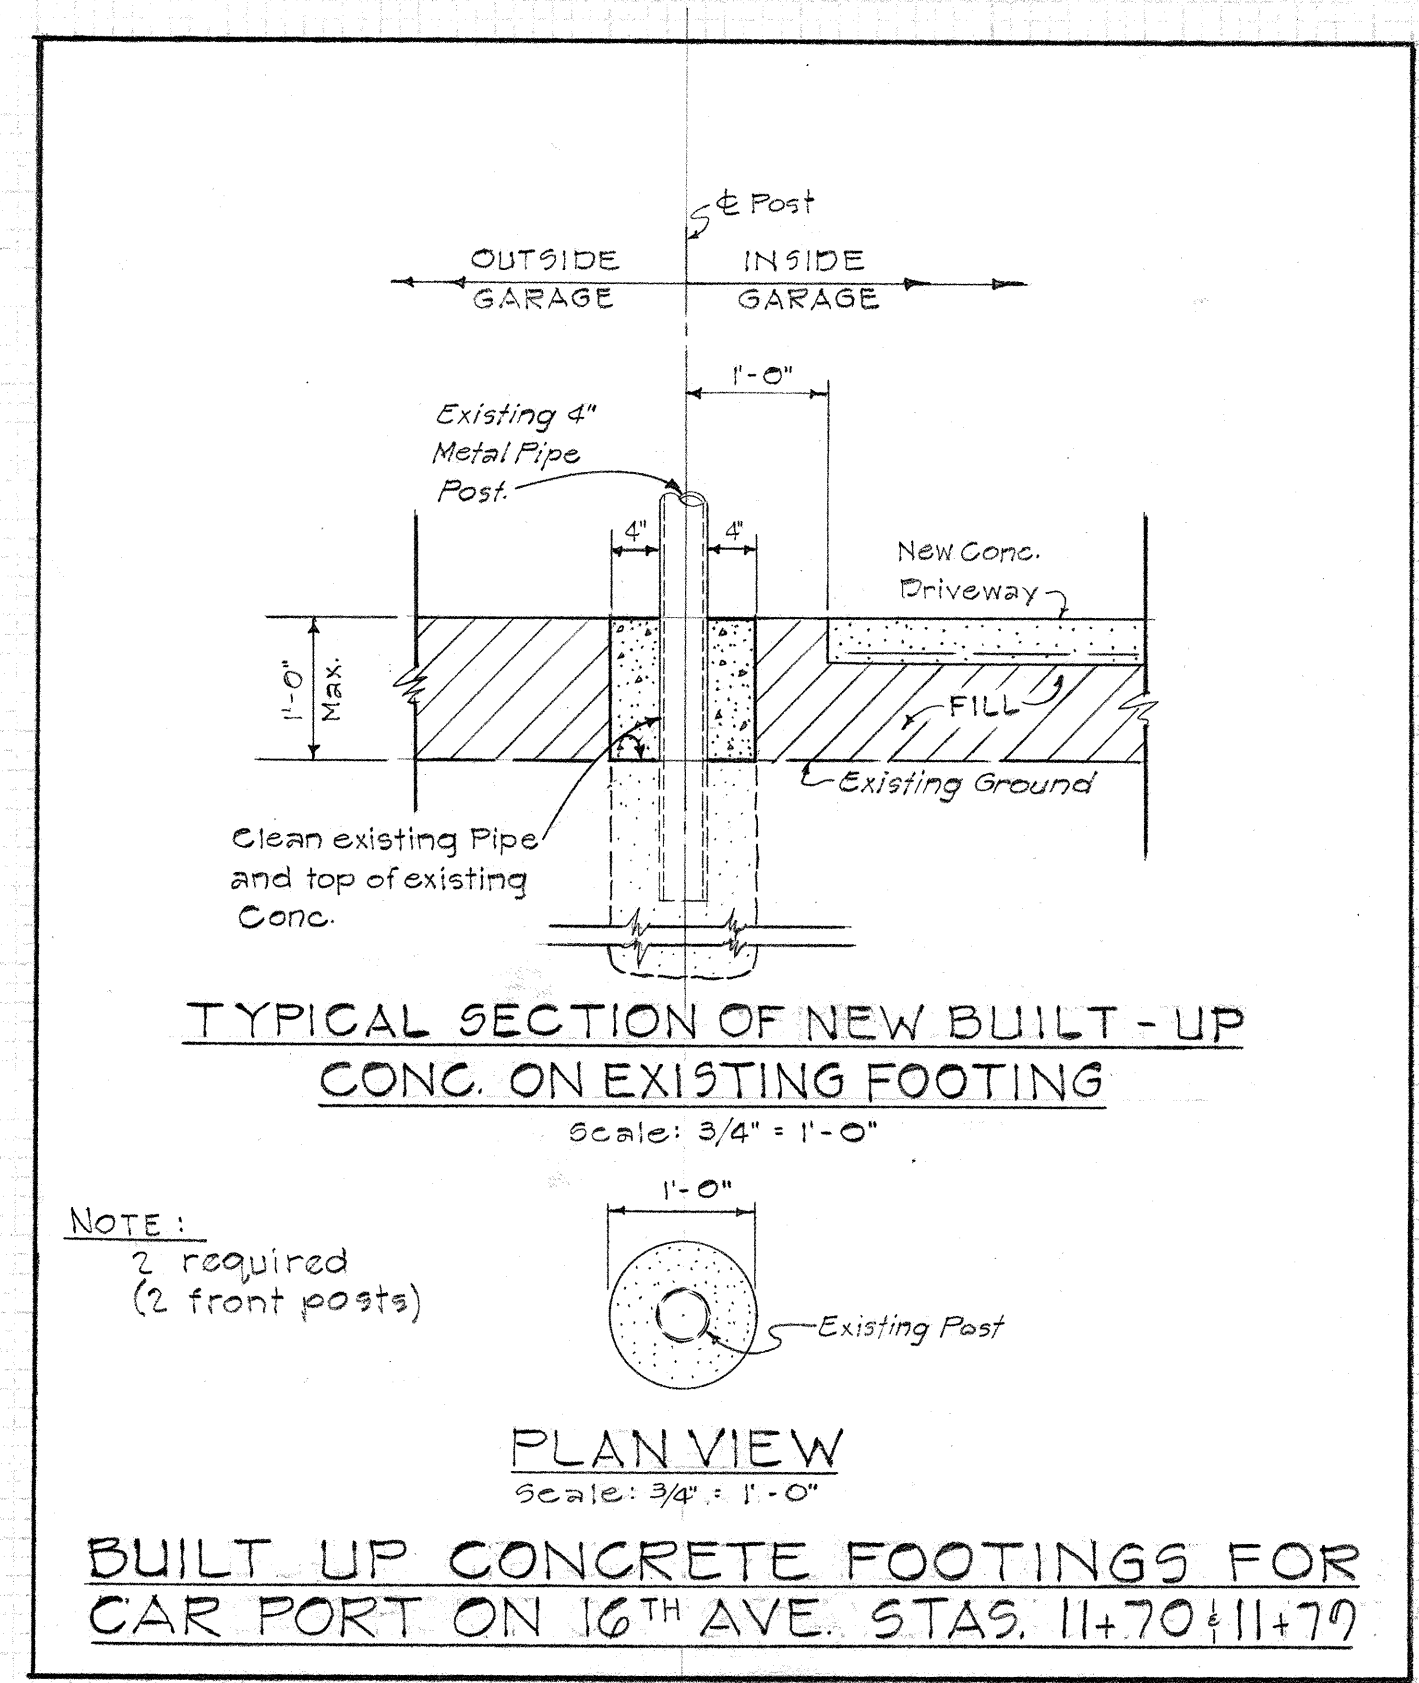
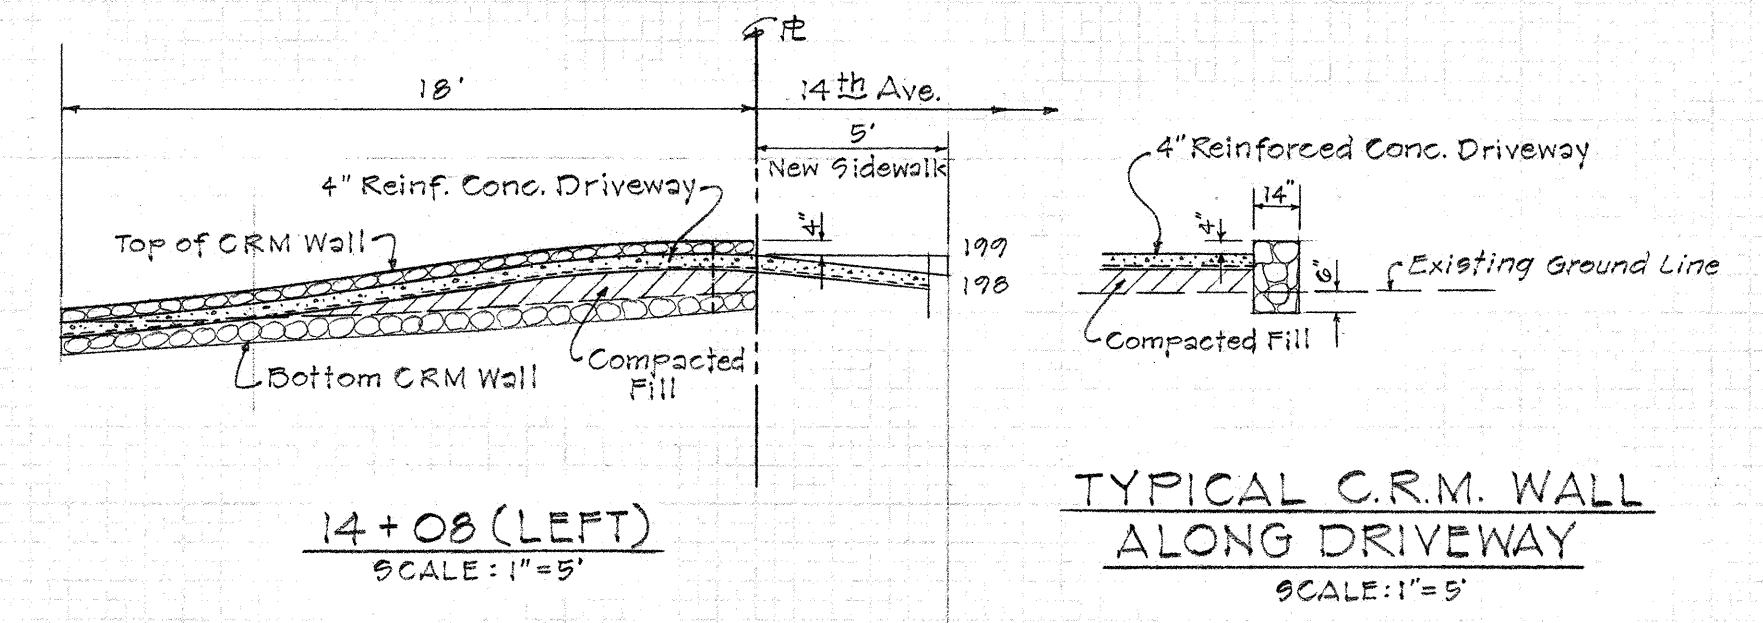
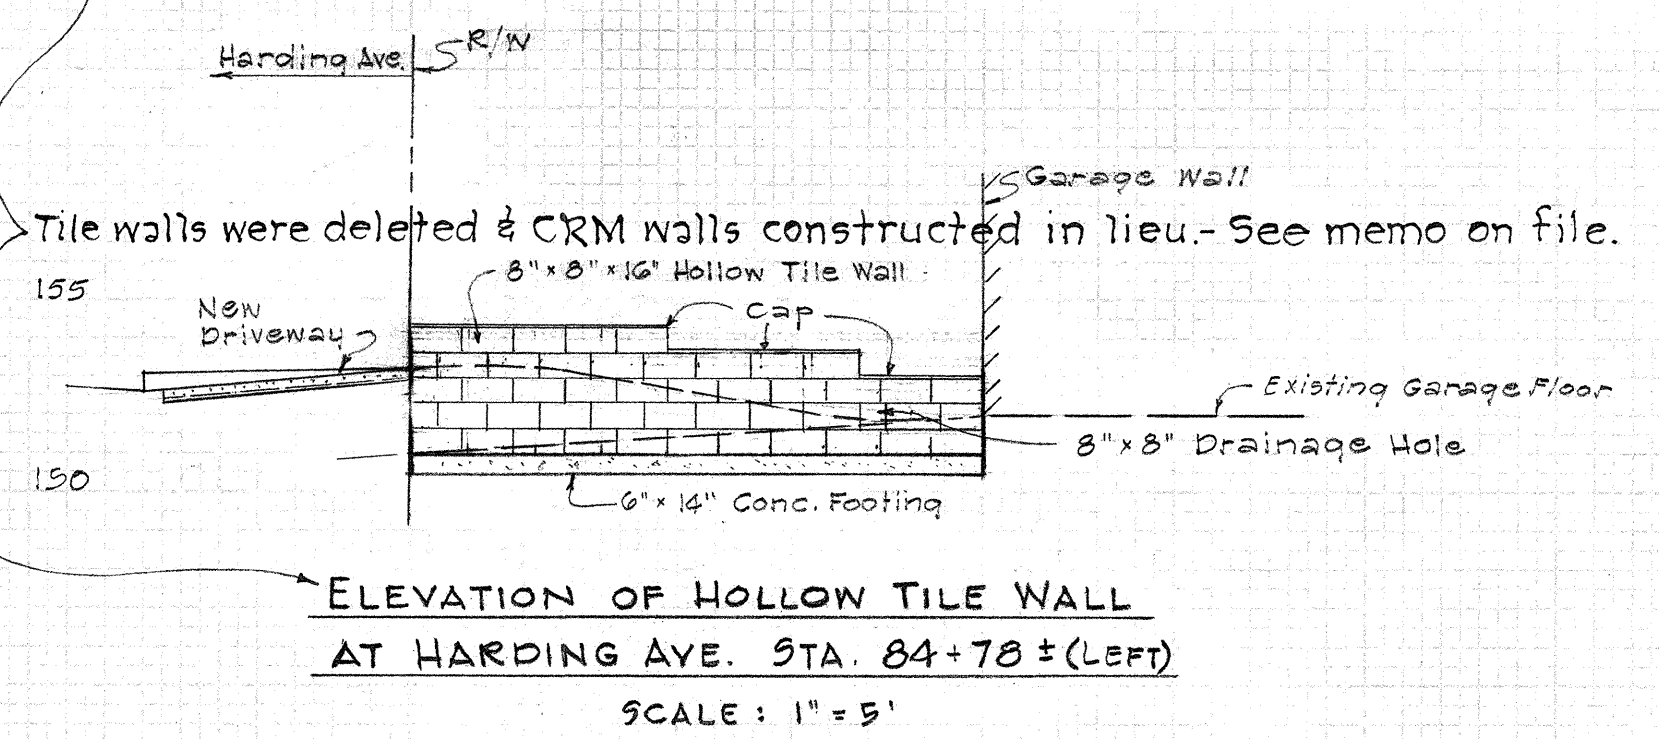
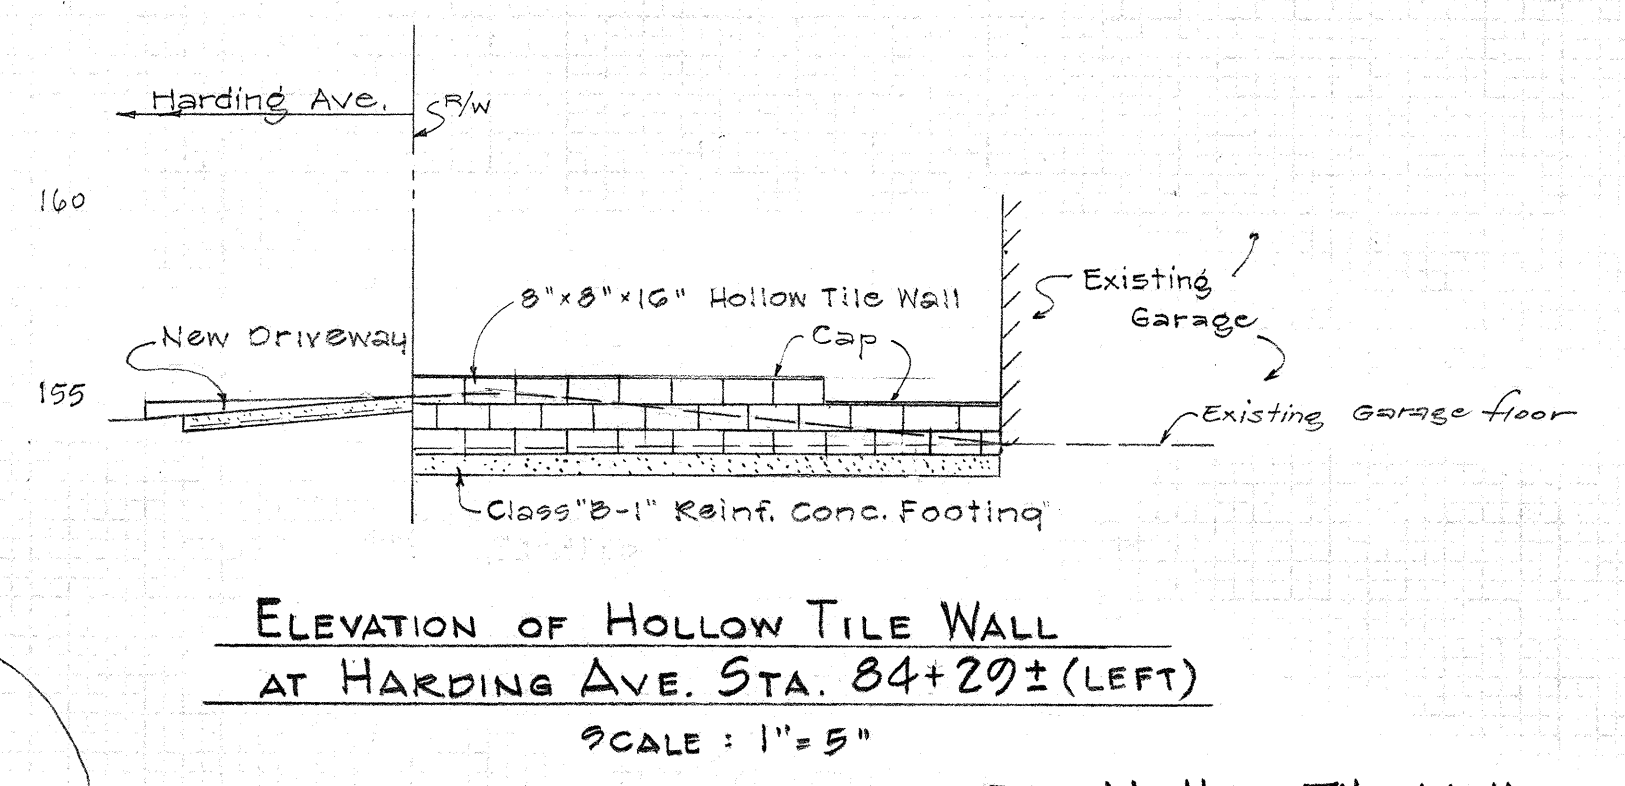
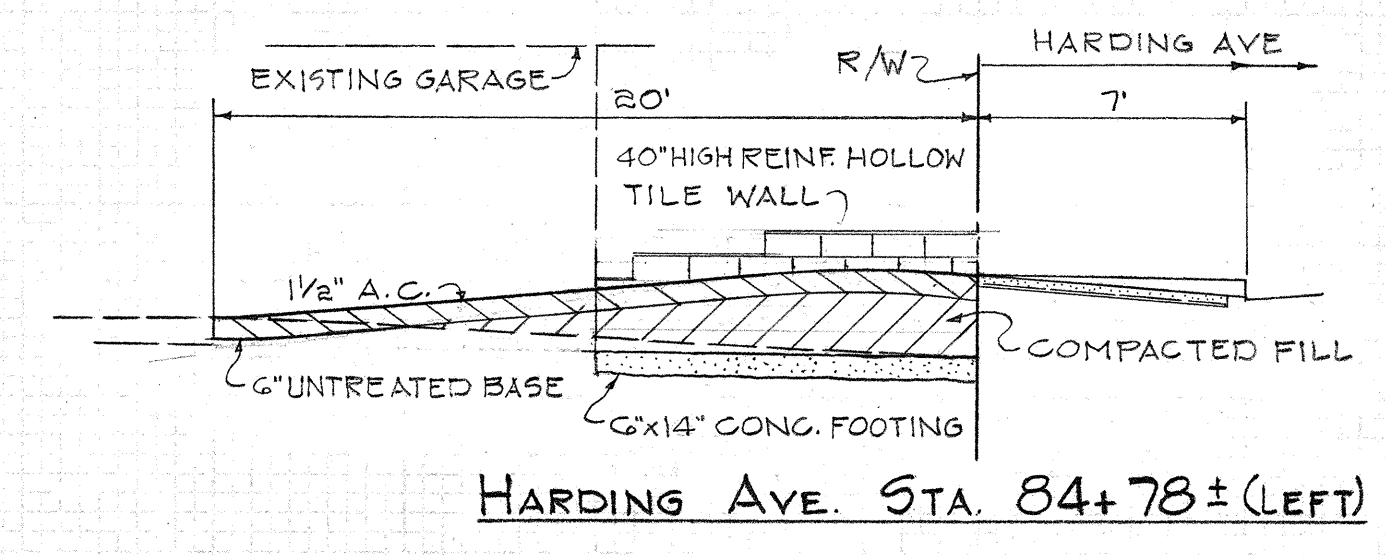
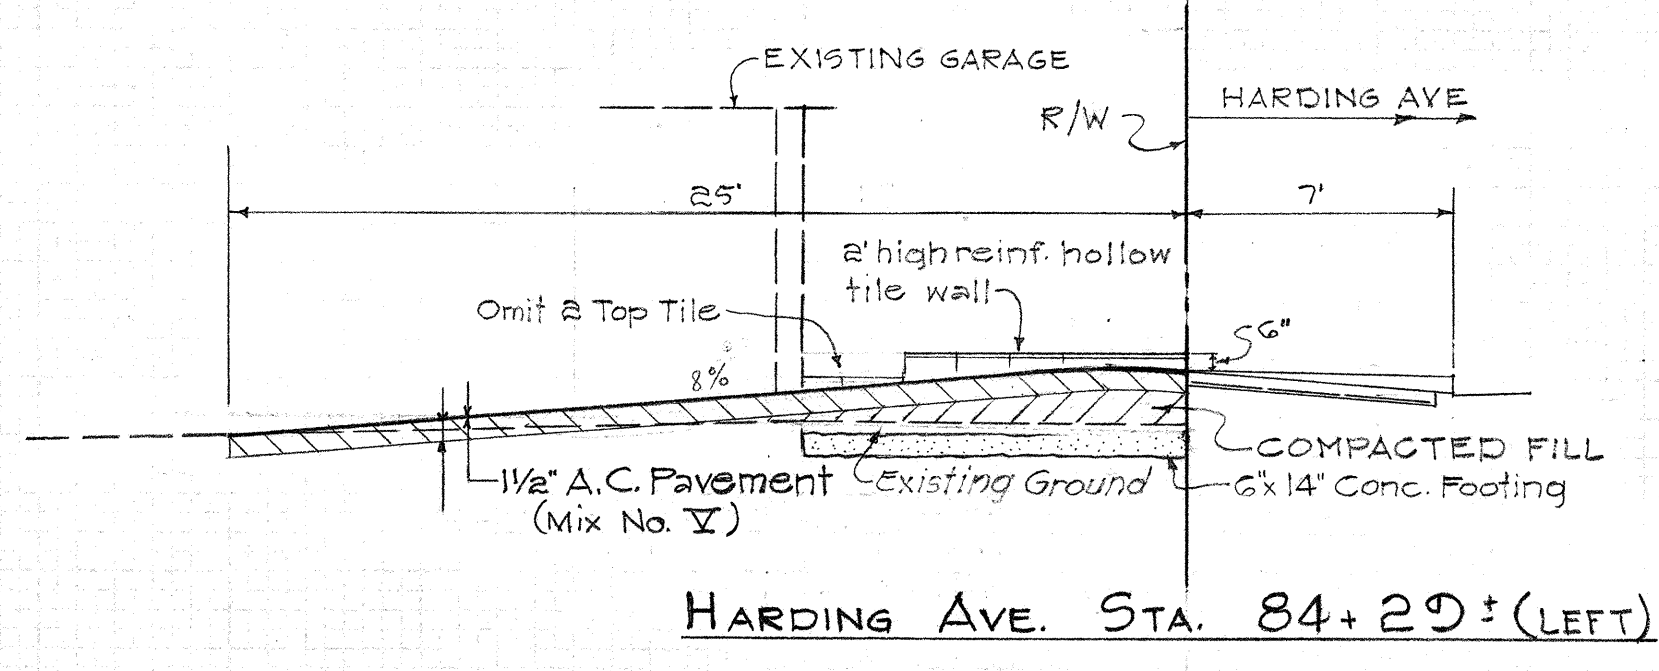
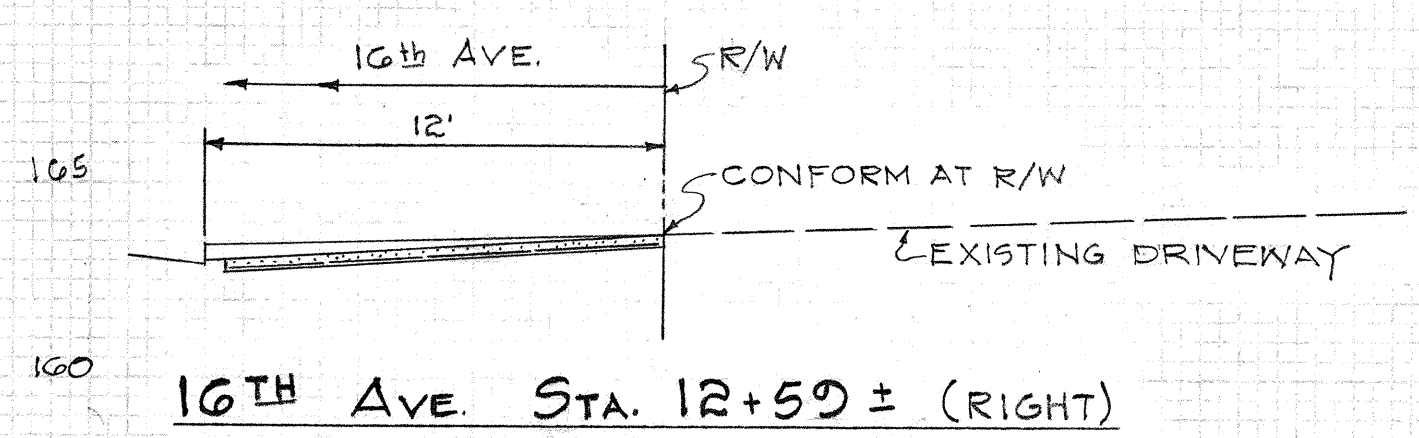
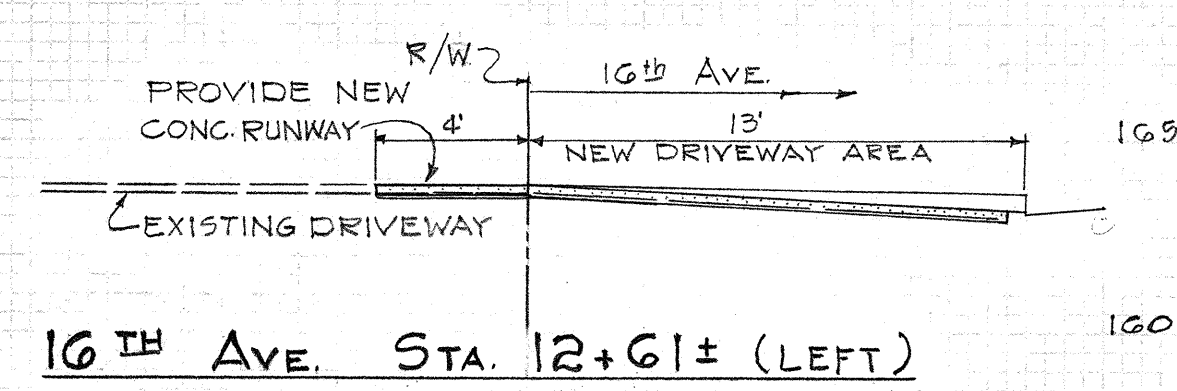
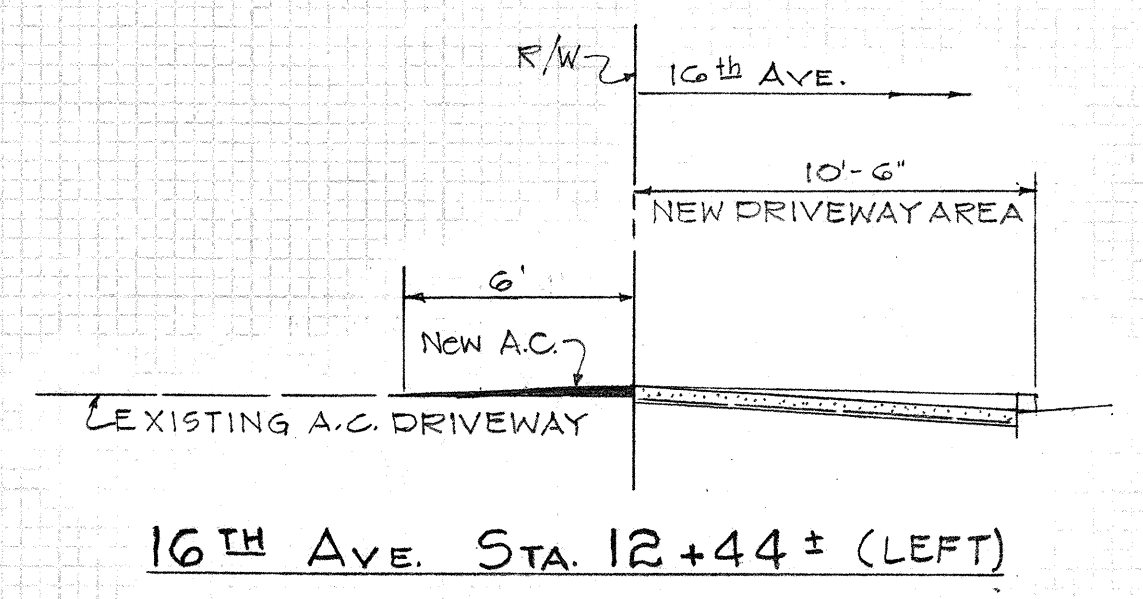


FED. ROAD DIST. No.	STATE	FED. AID PROJ. No.	FISCAL YEAR	SHEET No.	TOTAL SHEETS
RAVW-11	MASS.	1-1-1(6)	1968	21	129

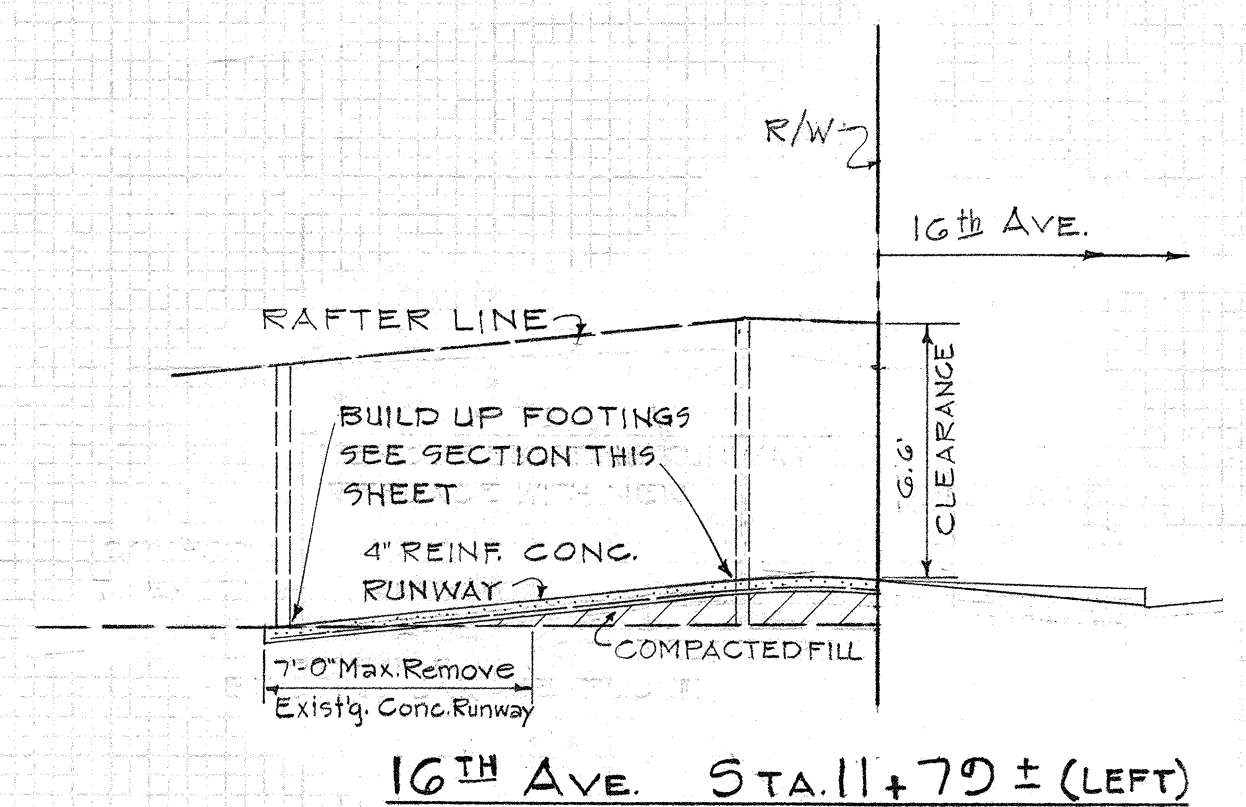

TYPICAL SECTIONS ALONG R/W

FED. ROAD DIST. No.	STATE	FED. AID PROJ. No.	FISCAL YEAR	SHEET No.	TOTAL SHEETS
HAWAII	HAW.	I-11-1(6) UNIT 1	1968	22	127

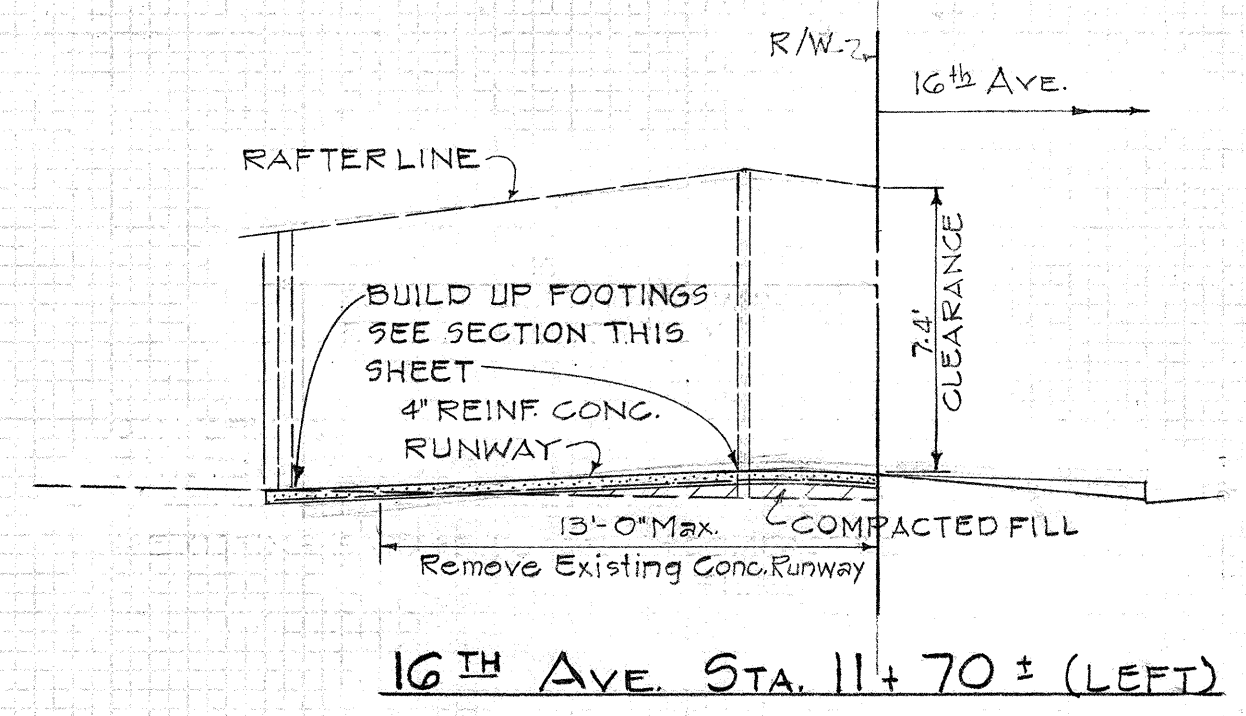

TYPICAL SECTIONS ALONG 16