


FED. ROAD DIST. NO.	STATE	FED. AID PROJ. NO.	FISCAL YEAR	SHEET NO.	TOTAL SHEETS
HAWAII	HAW.	101-1(6)	1965	3	129

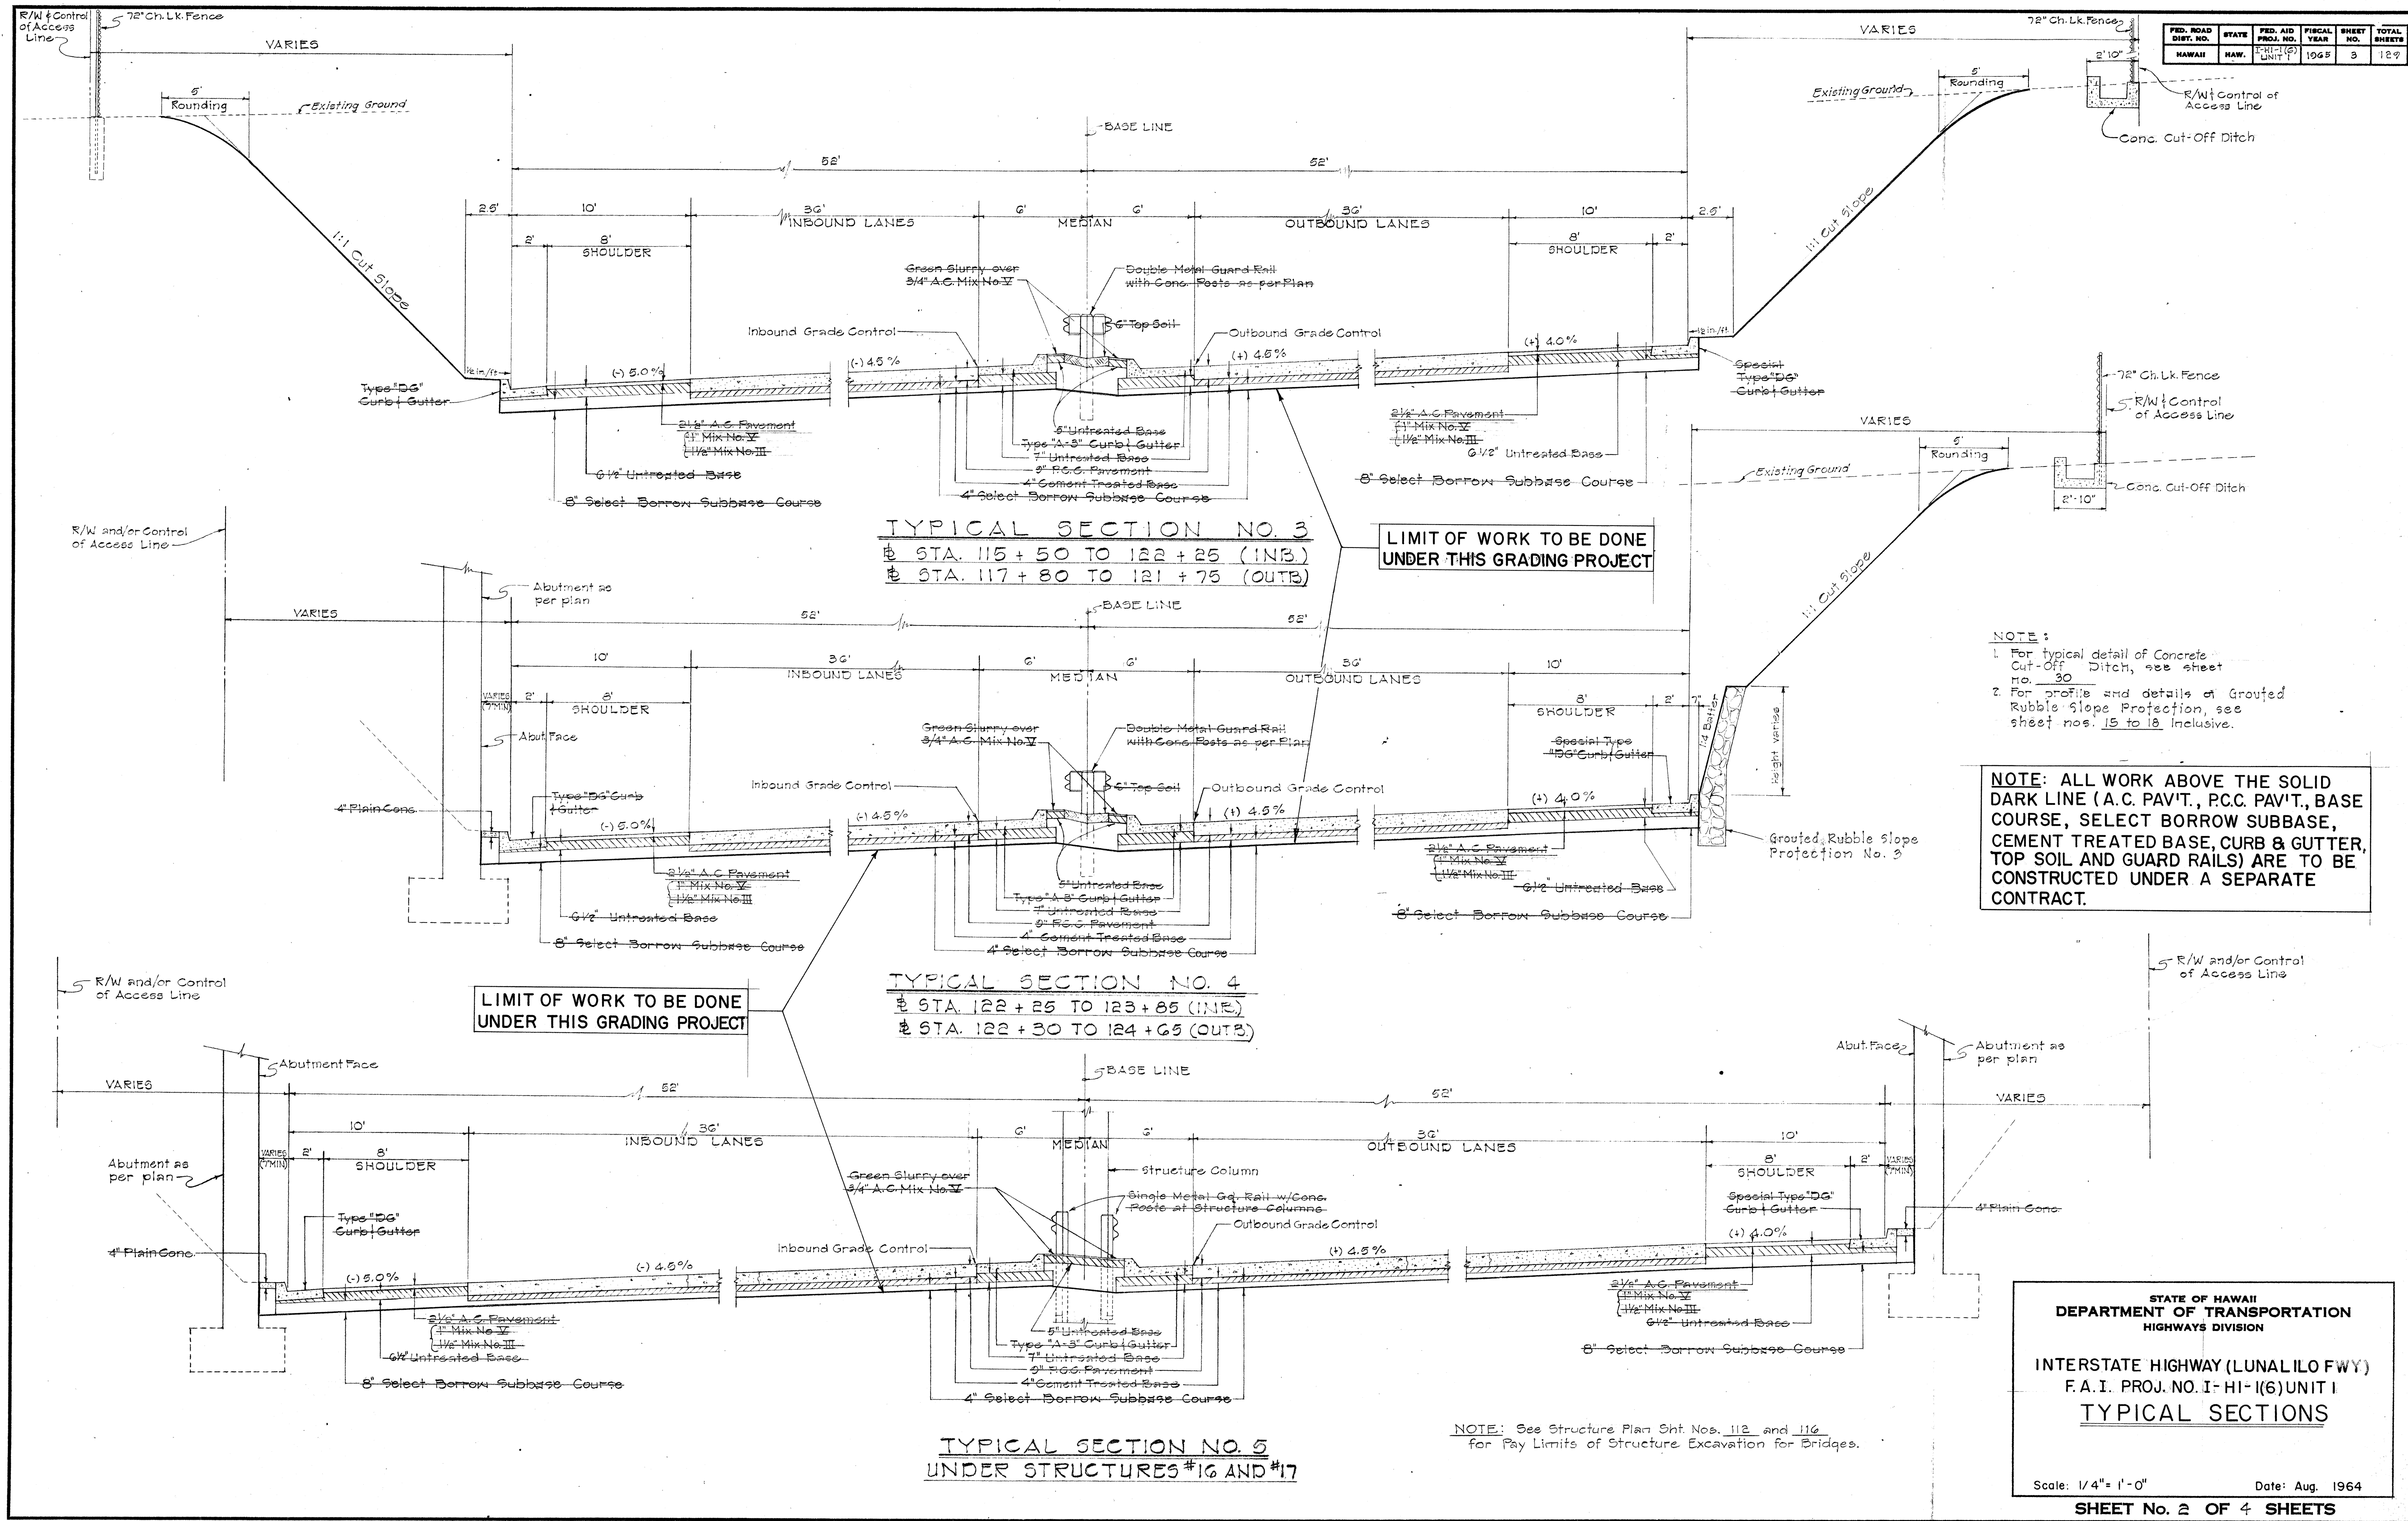


DATE	DESIGNED BY	CHECKED BY
PLAN	DESIGNED BY	CHECKED BY
NOTE BOOK	DESIGNED BY	CHECKED BY
No.	DESIGNED BY	CHECKED BY

FED. ROAD DIST. NO.	STATE	FED. AID PROJ. NO.	FISCAL YEAR	SHEET NO.	TOTAL SHEETS
HAWAII	HAW.	CH-1(6) UNIT 1	1965	4	129

NOTE: 1. For typical detail of Concrete Cut-off Ditch, see sheet no. 30.
2. For profiles and details of Grouted Rubble Slope Protection, see sheet nos. 15 to 18, inclusive.

LIMIT OF WORK TO BE DONE UNDER THIS GRADING PROJECT

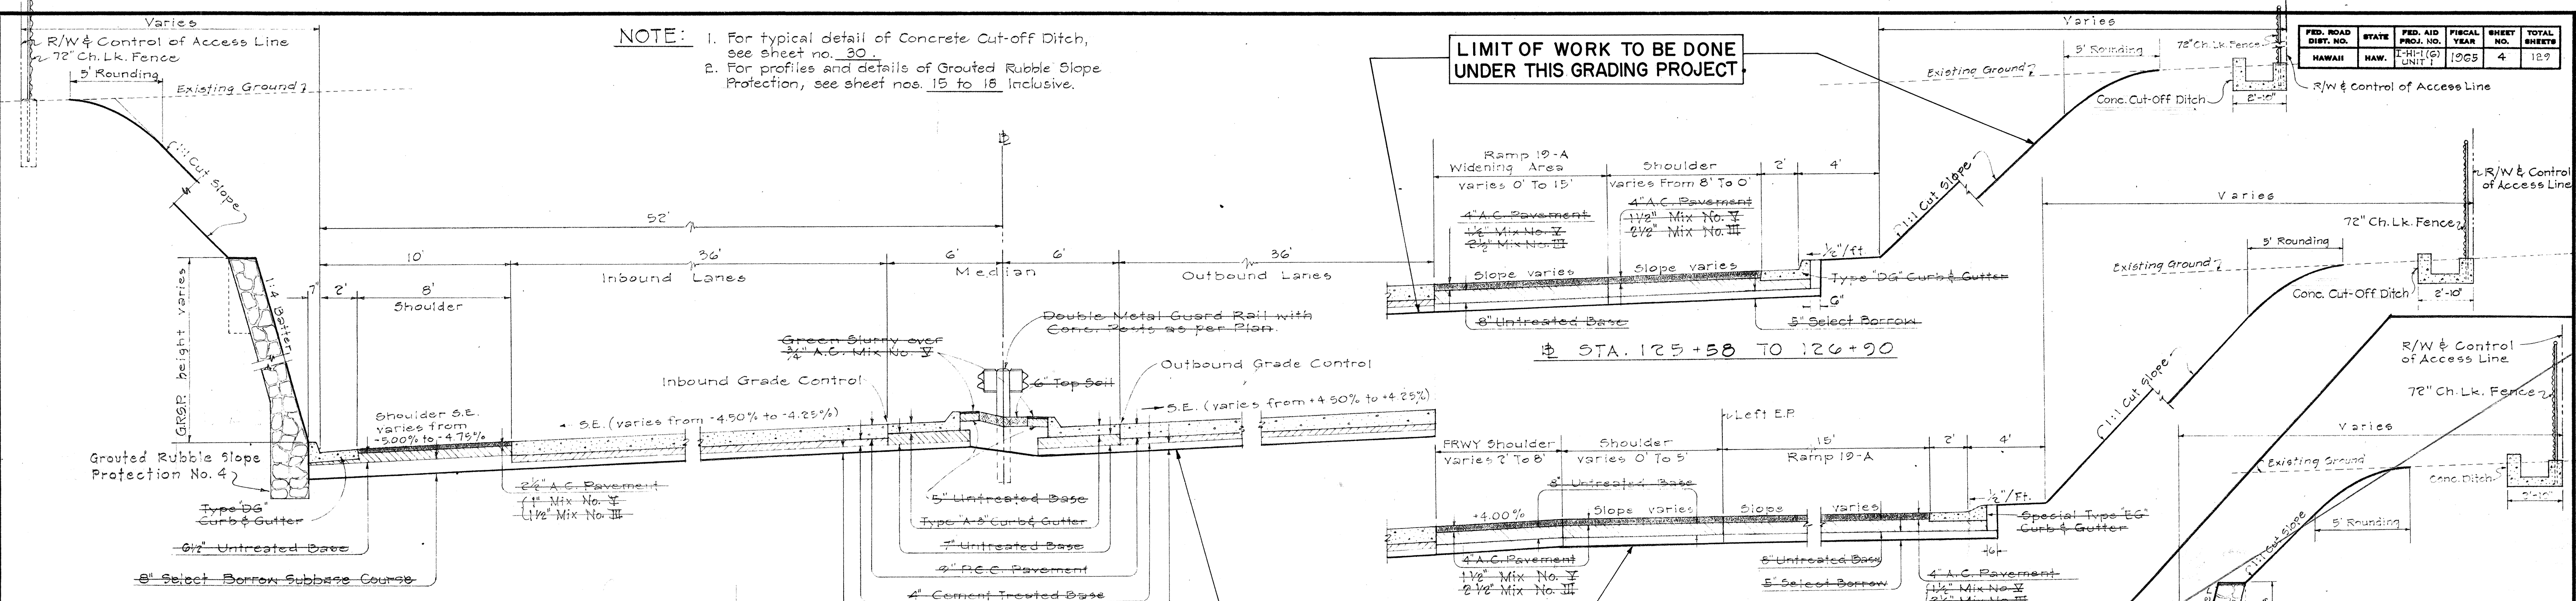


NOTE: ALL WORK ABOVE THE SOLID DARK LINE (A.C. PAV'T, P.C.C. PAV'T, BASE COURSE, SELECT BORROW SUBBASE, CEMENT TREATED BASE, CURB & GUTTER, TOP SOIL AND GUARD RAILS) ARE TO BE CONSTRUCTED UNDER A SEPARATE CONTRACT.

TYPICAL SECTION NO. 6

± STA. 123+85 TO 128+75 (INB.)
± STA. 125+58 TO 128+75 (OUTB.)

NOTE: PROJ. ENDS AT ± STA. 127+50


LIMIT OF WORK TO BE DONE UNDER THIS GRADING PROJECT

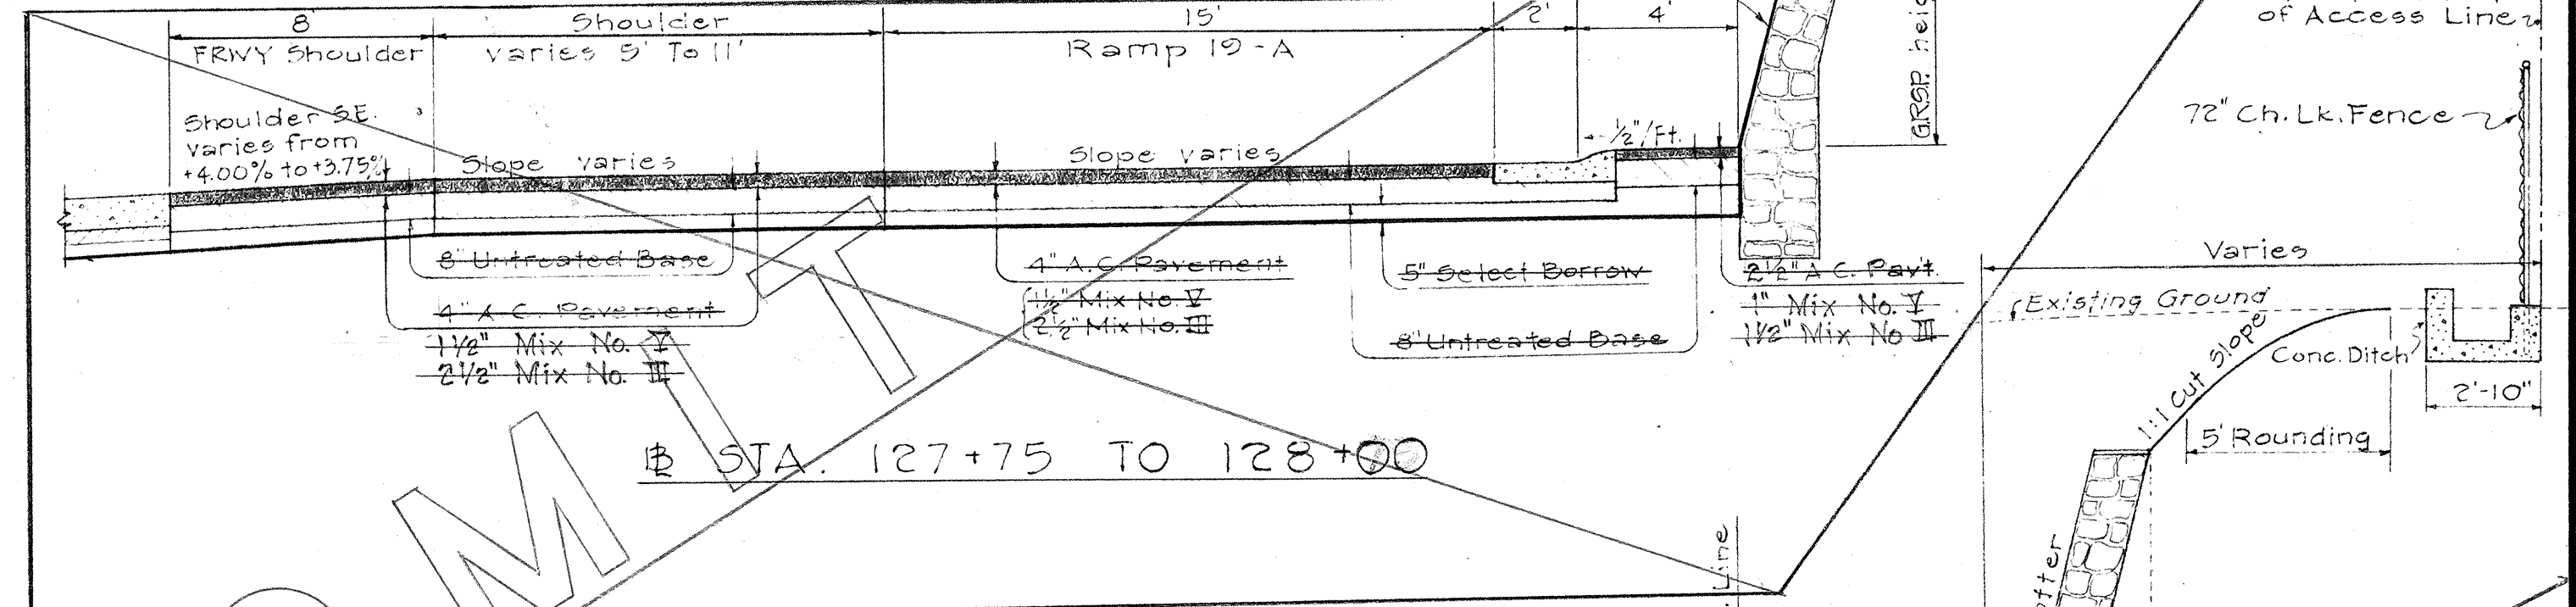

TYPICAL CUT SLOPE ROUNDING DETAIL

Scale: 1/2" = 1'-0"

NOTE: The top of excavation slopes shall be rounded as shown on the plans or as directed by the Engineer. Rounding the cut slope will be paid for as "Roadway Excavation" for the quantities involved and no additional compensation will be allowed for such work.

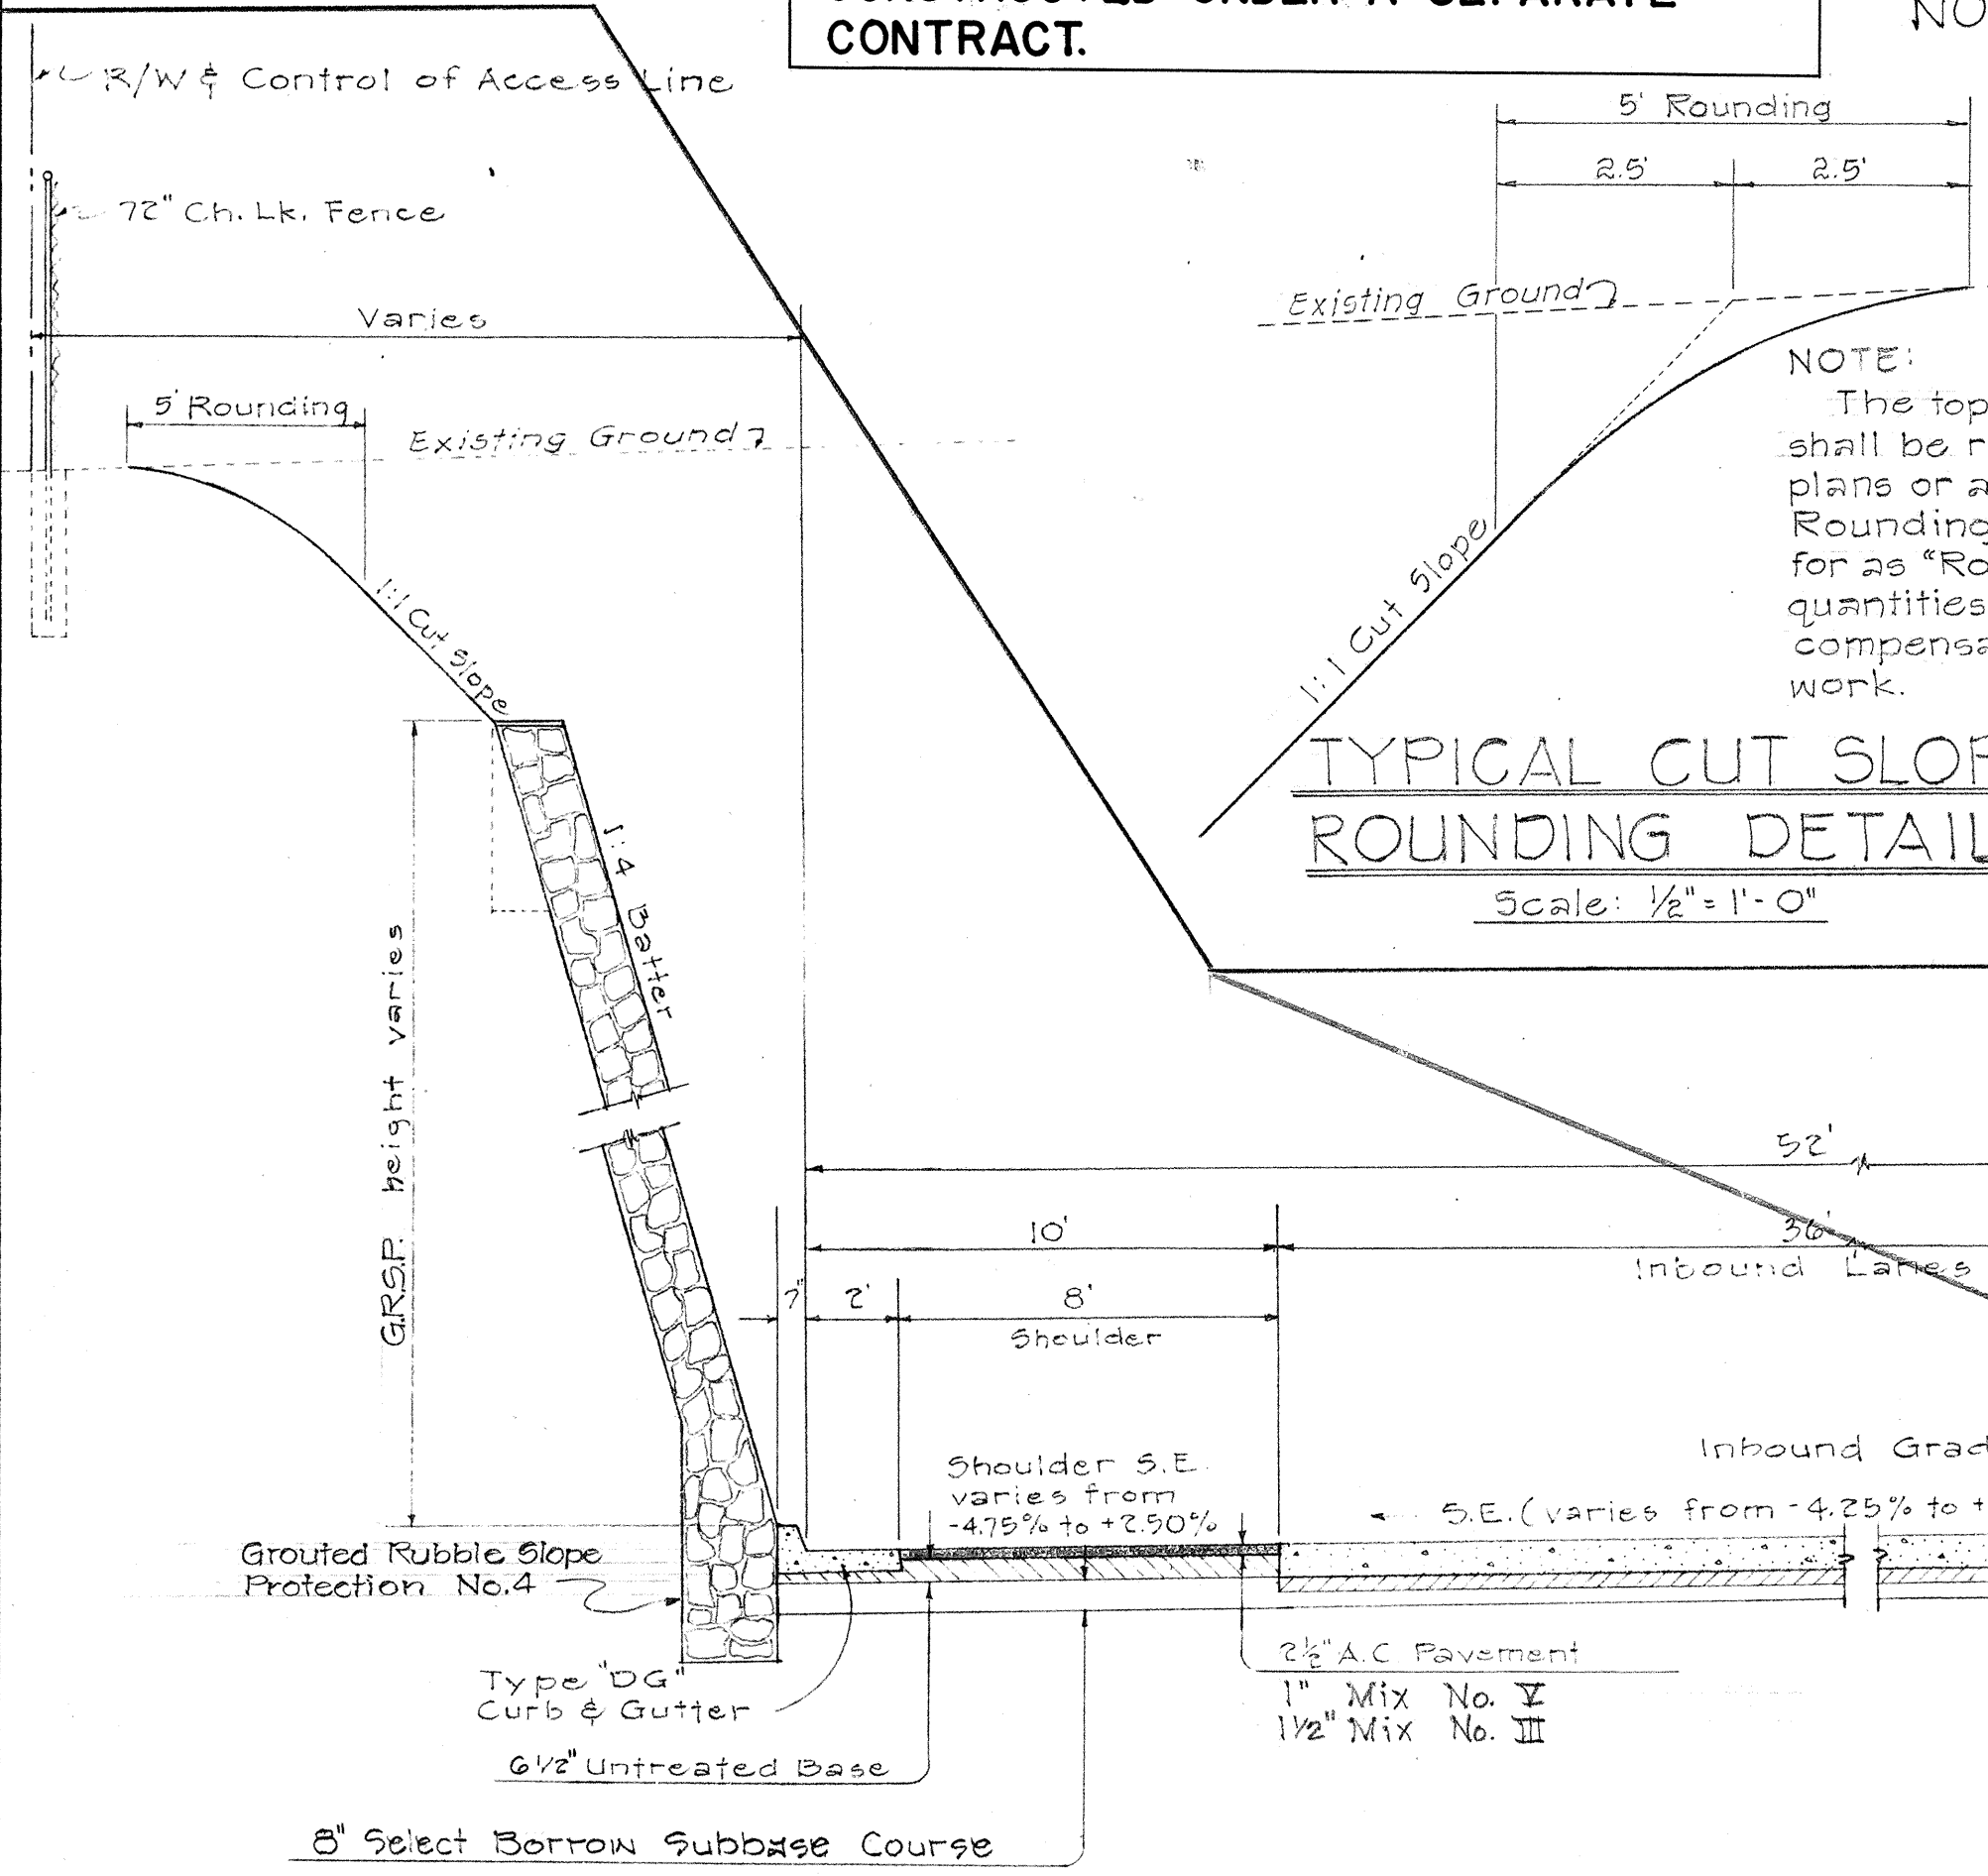

TYPICAL SECTION NO. 7

± STA. 128+75 TO 132+65 (INB.)
± STA. 128+75 TO 132+ (OUTB.)

NOTE: Super slopes other way from approximate ± Station 131+25.

STATE OF HAWAII
DEPARTMENT OF TRANSPORTATION
HIGHWAYS DIVISION

INTERSTATE HIGHWAY (LUNALILO FWY)
F.A.I. PROJ. NO. I-HI-1(6) UNIT 1





TYPICAL SECTIONS

Scale: 1/4" = 1'-0" Date: Aug. 1964

SHEET NO. 3 OF 4 SHEETS

DATE	DESIGNED BY	CHECKED BY
PLANNED BY	TRACED BY	NOTED BY
ORIGINAL PLAN	NOTE BOOK	No.

DATE	_____
SURVEY PLOTTED BY	_____
DESIGNED BY	_____
QUANTITIES BY	_____
CHECKED BY	_____
ORIGINAL PLAN	_____
NOTE BOOK	_____
No.	_____

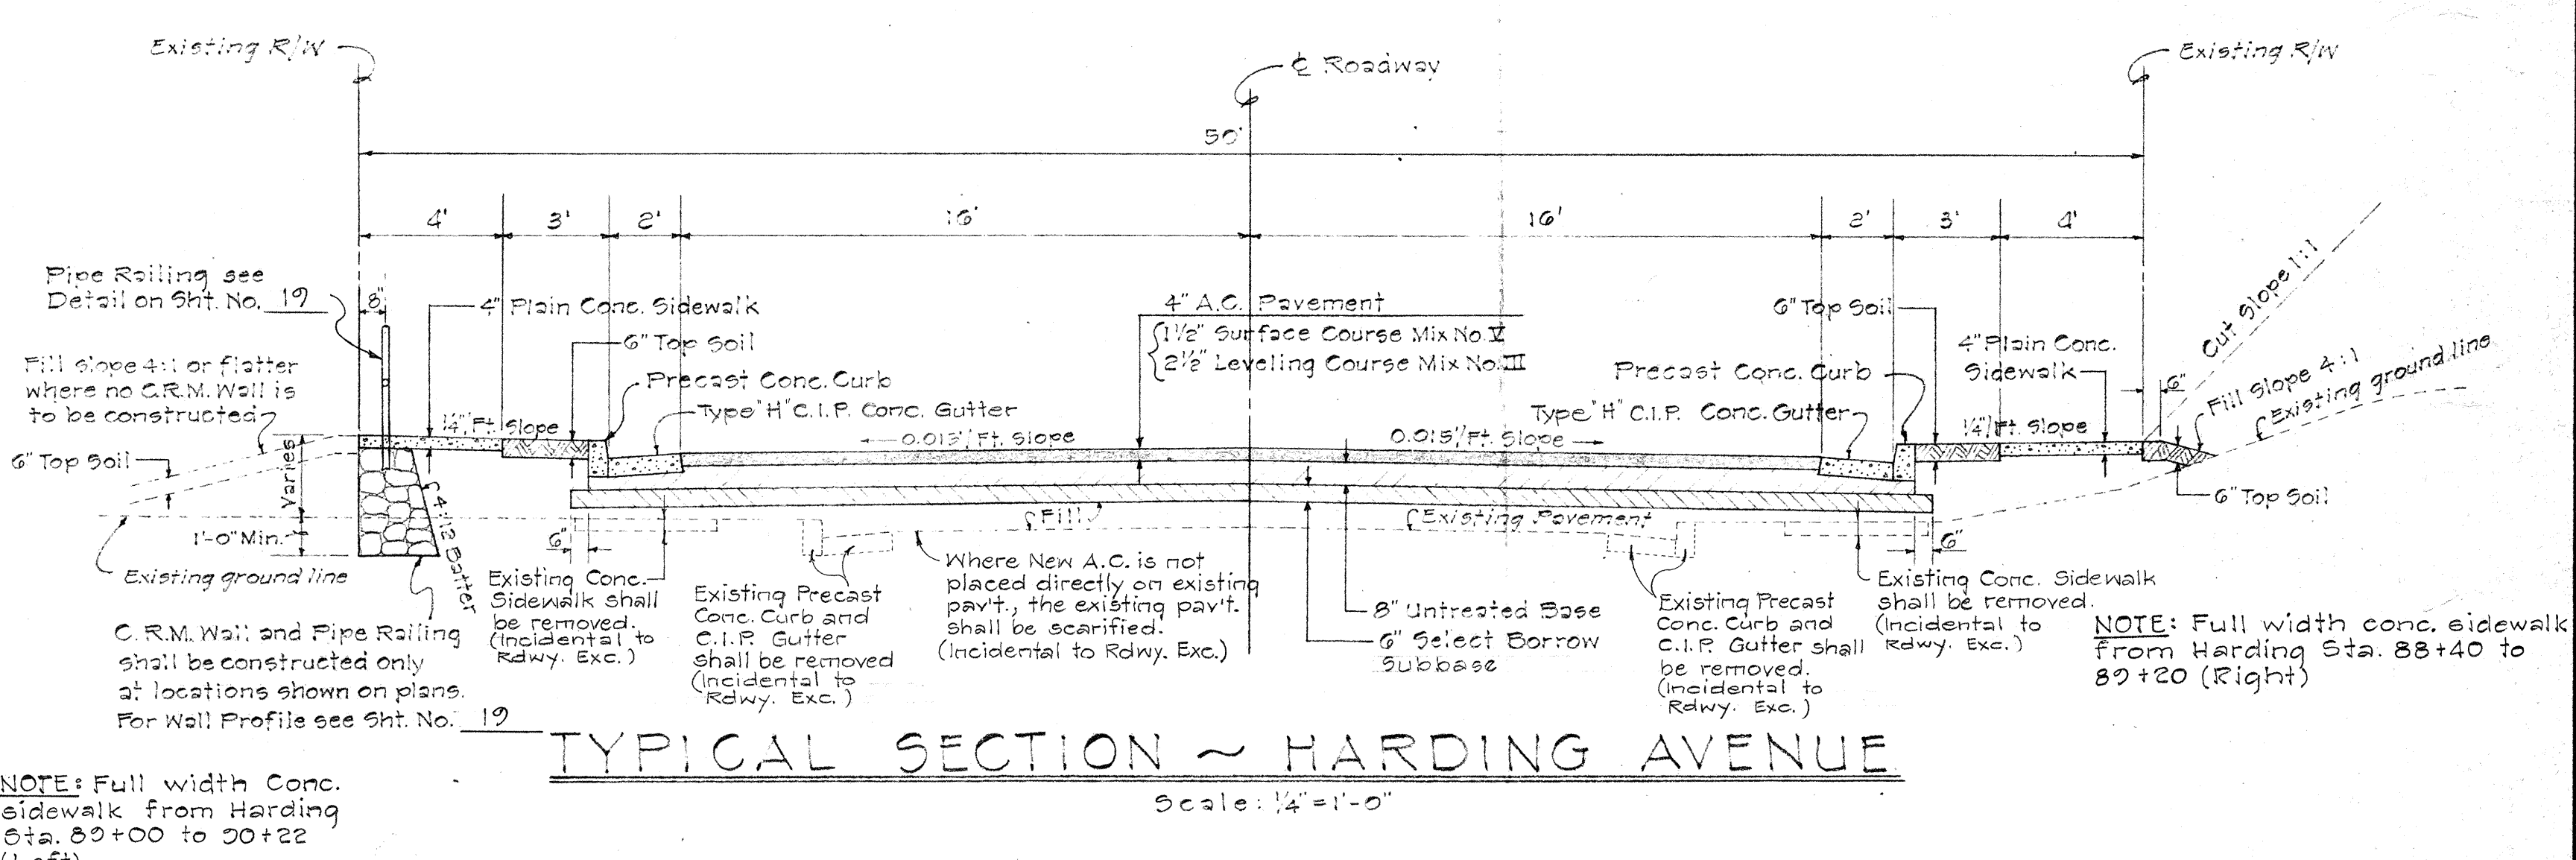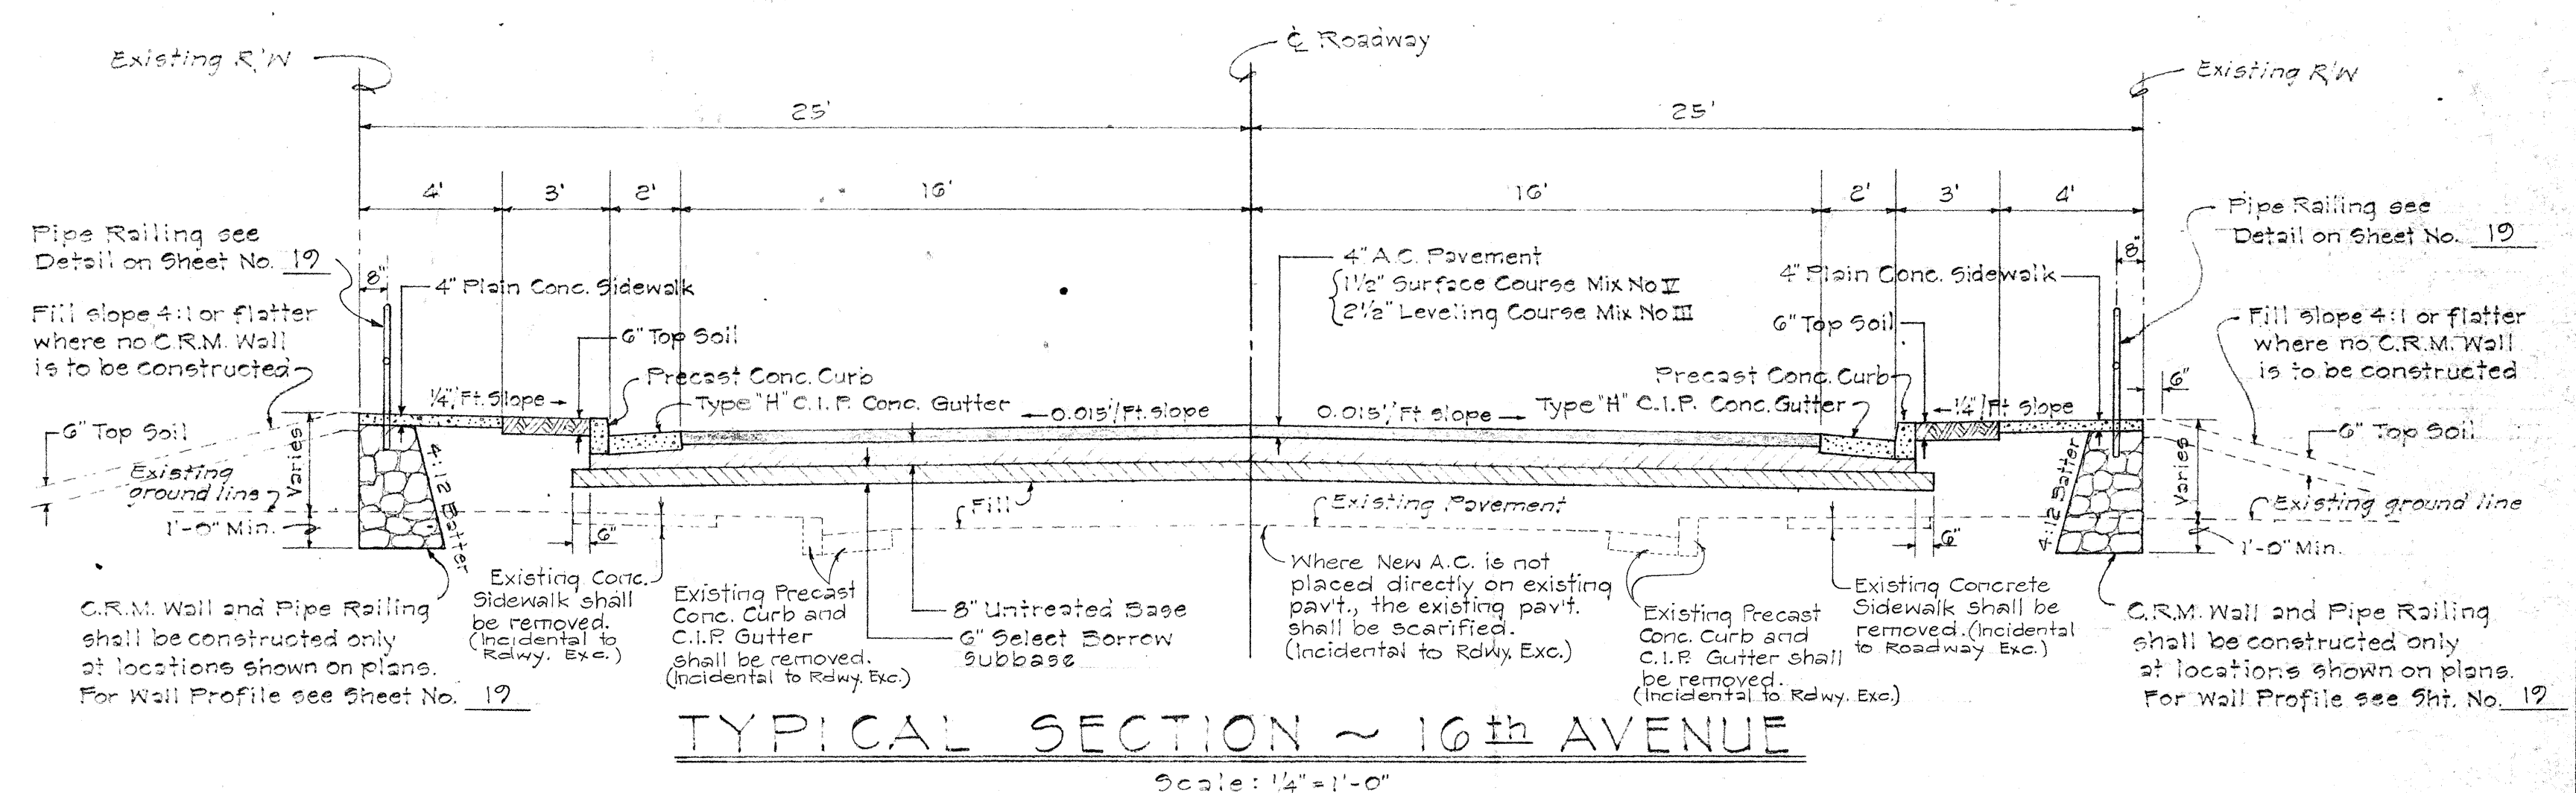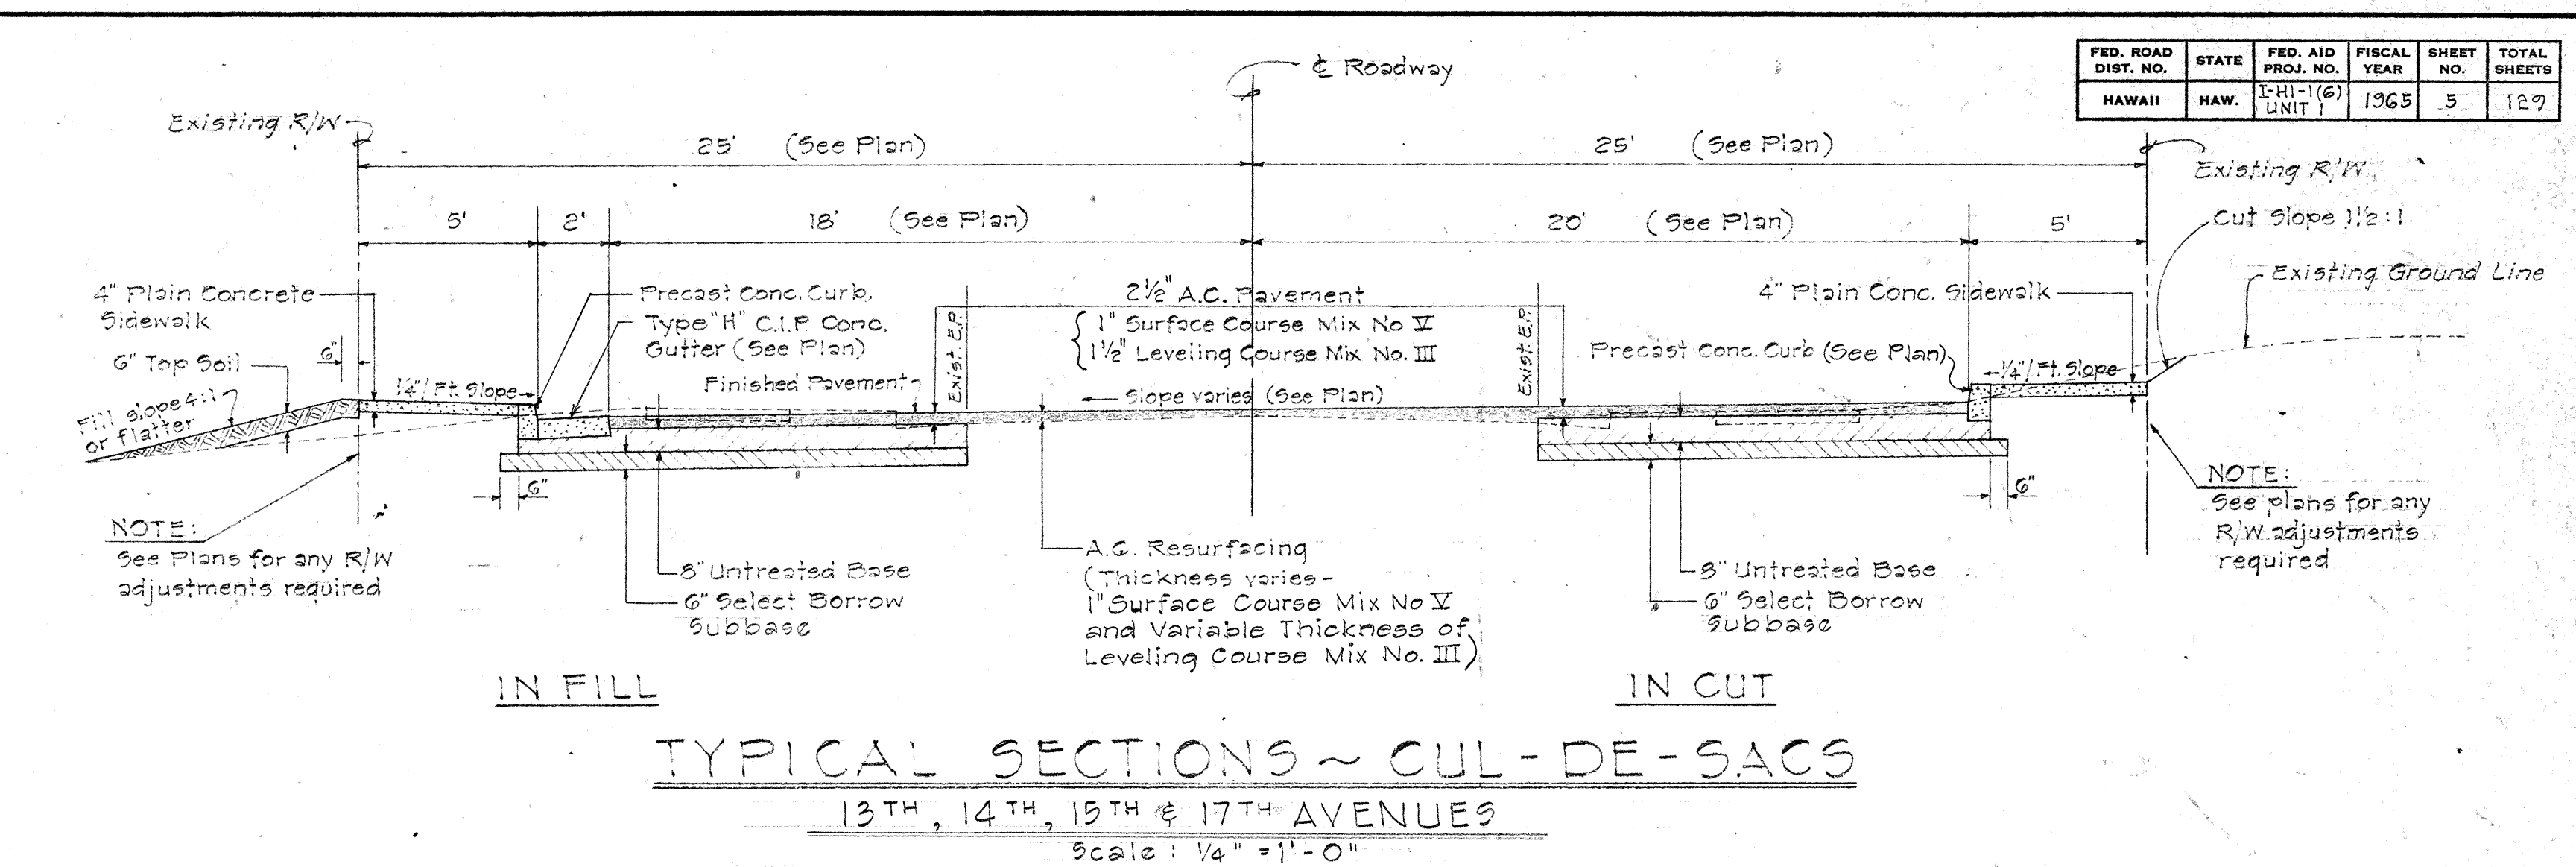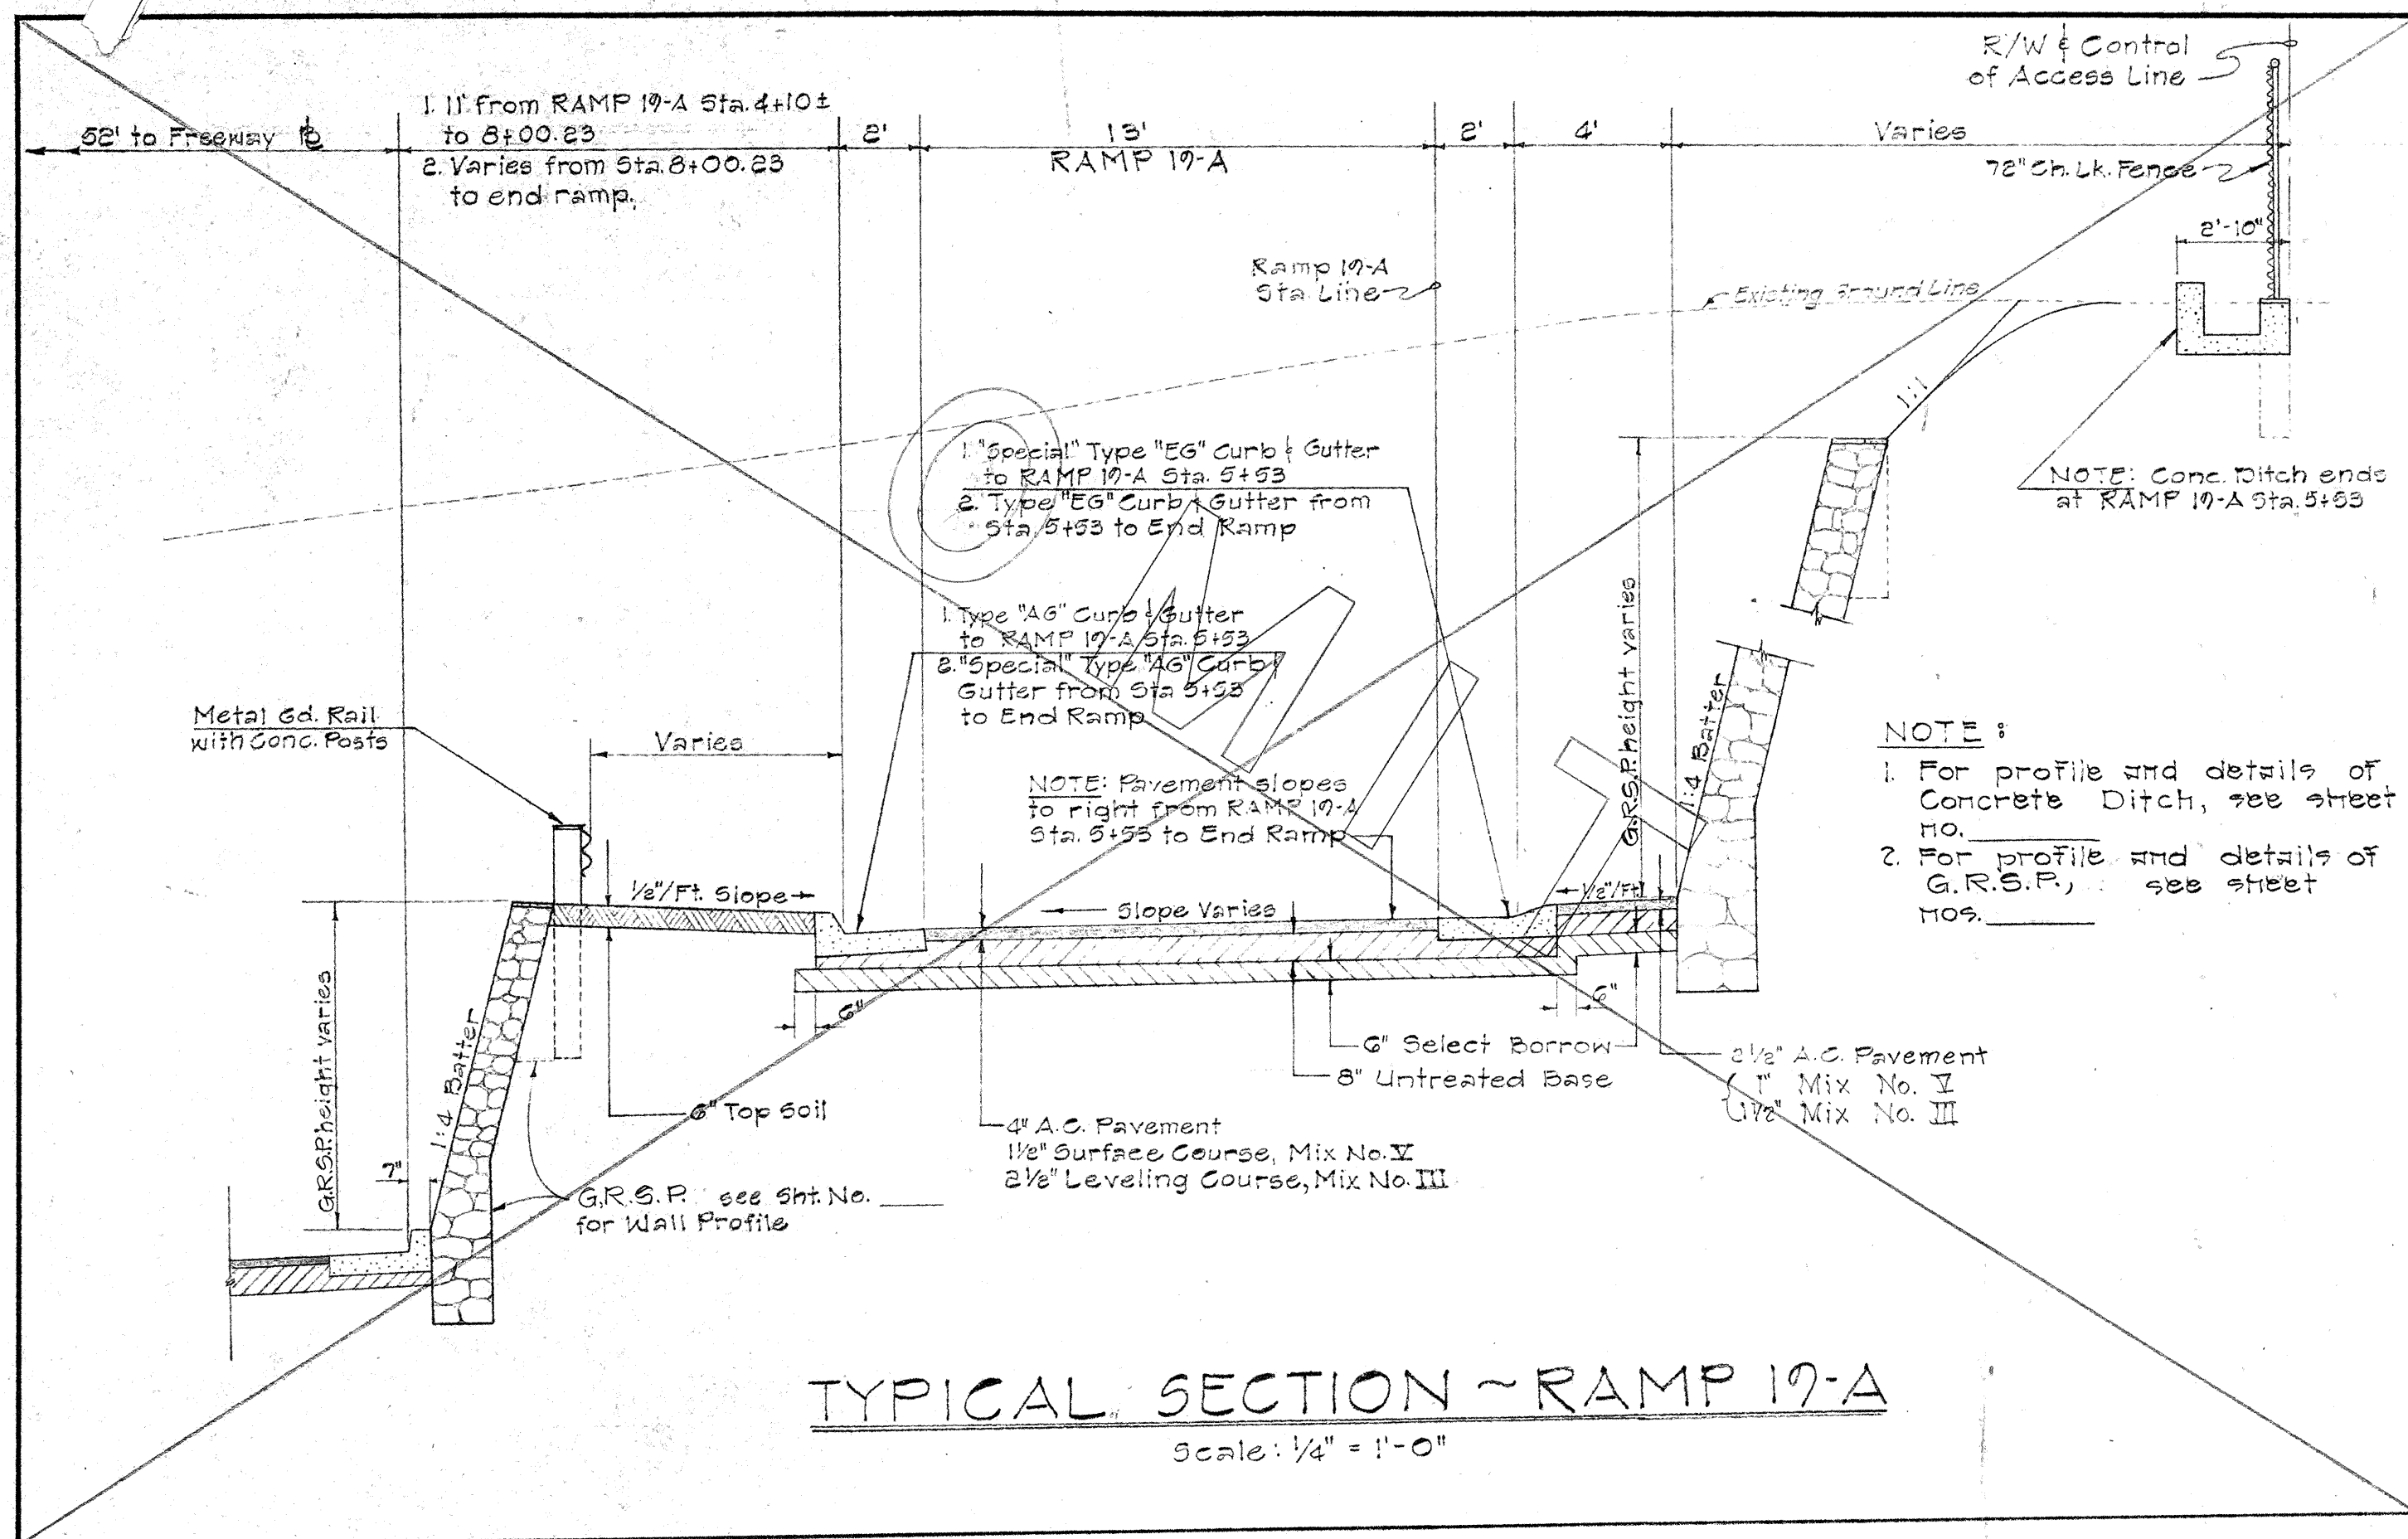

STATE OF HAWAII
DEPARTMENT OF TRANSPORTATION
HIGHWAYS DIVISION

INTERSTATE HIGHWAY (LUNALILO FWY)
F.A.I. PROJ. NO. I-HI-1(6) UNIT I

TYPICAL SECTIONS

Scale: 1/4" = 1'-0" Date: Jan. 1964

SHEET No. 4 OF 4 SHEETS