


STATE OF HAWAII  
DEPARTMENT OF TRANSPORTATION  
HIGHWAYS DIVISION  
HONOLULU, HAWAII  
"AS BUILT"  
RESURFACING OF A PORTION OF LUNALILO FREEWAY  
(ALEXANDER STREET TOWARD OLD WAIALAE ROAD)

PROJECT NO. HI-I-01-66

DISTRICT OF HONOLULU  
ISLAND OF OAHU

NO CHANGE WAS MADE DURING  
CONSTRUCTION OF THIS PROJECT.

*R. T. Samuels* 11-10-81  
for RESIDENT ENGINEER DATE

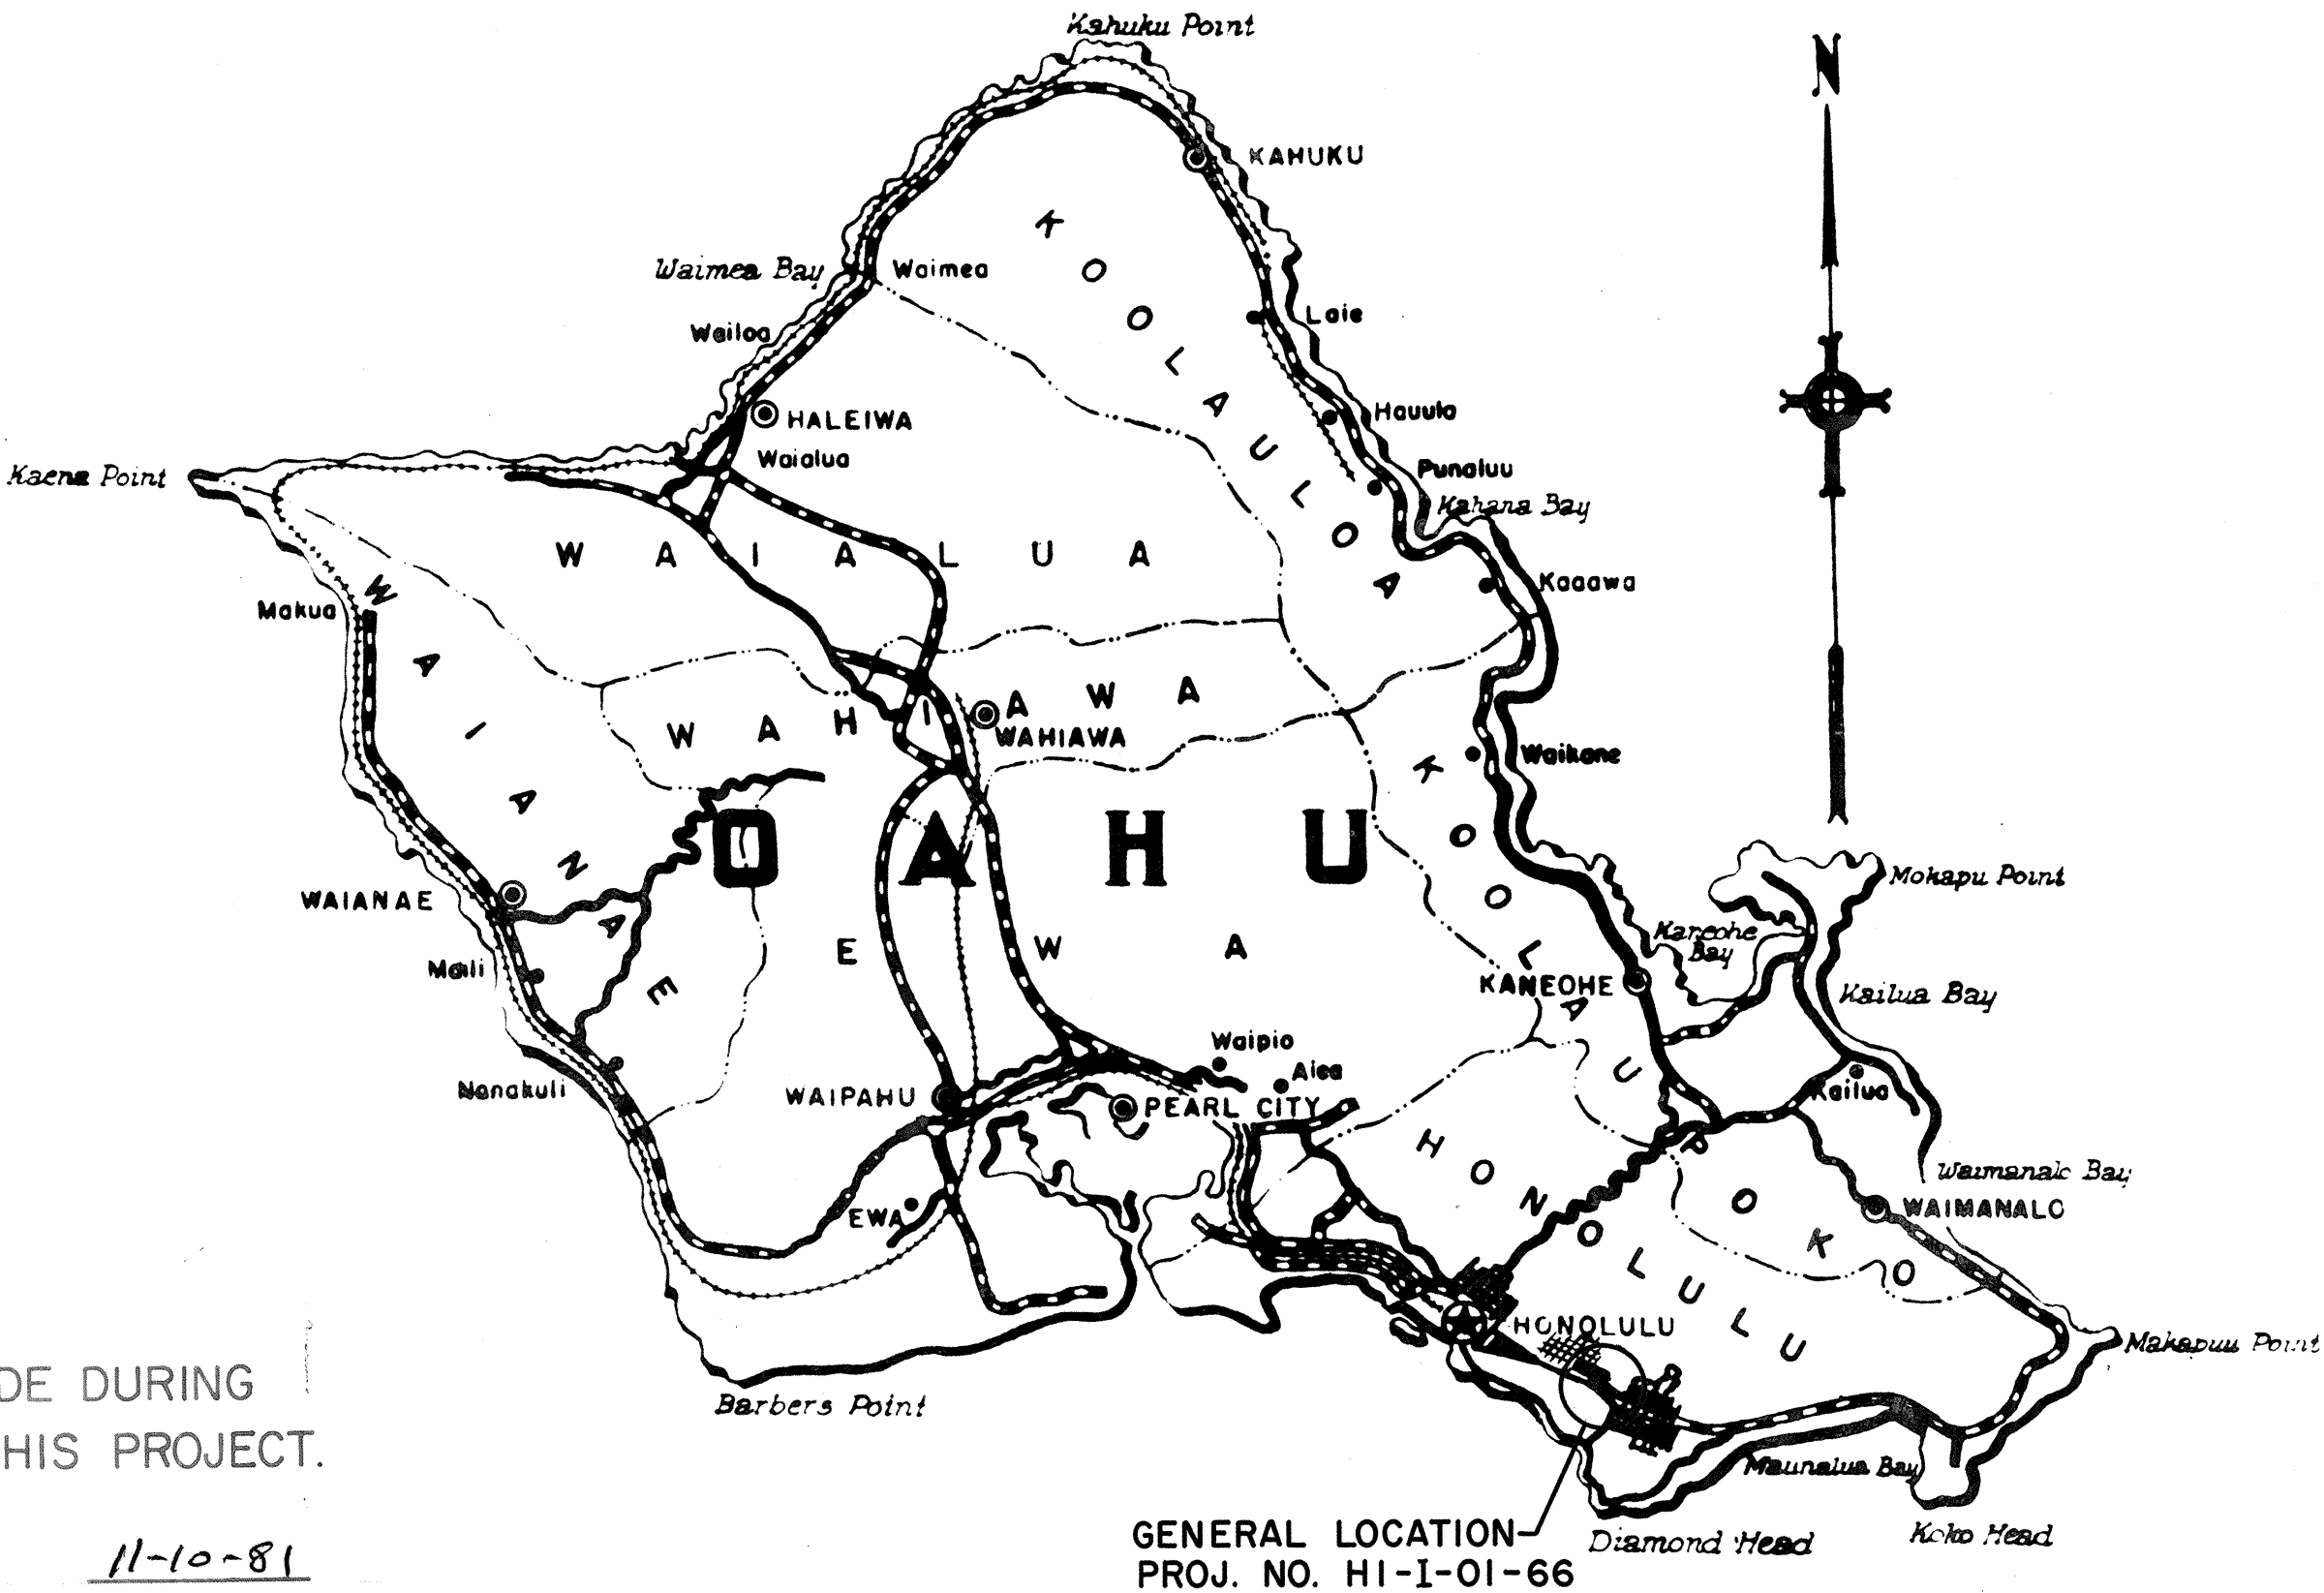

Federal Aid Projects Previously Constructed Or Under Construction


GENERAL NOTES

1. Resurfaced Pavement Thicknesses are as follows:

Inbound Lanes	Width	Thickness
Sta. 256+30 to 281+75	36'	1"
Sta. 1+75 to 30+42.57	36'	1"

Outbound Lanes	Width	Thickness
Sta. 256+30 to 281+75	36'	1"
Sta. 1+75 to 29+46.05	36'	1"
2. Existing Pavement shall be broomed off and tack coated before laying Asphalt Concrete.
3. Pot holes, cracks and crevices in the existing pavement shall be cleaned and paved with A.C. Mix No. V as ordered by the Engineer. No compensation will be made to the Contractor for this work other than the actual quantity of the material incorporated into the work and for which an item is listed in the proposal.
4. All existing Centerline Monuments shall be exposed after resurfacing. Payments to be incidental to Asphalt Concrete Pavement.
5. Smooth riding connections shall be provided at the beginning and end of the project.
6. The edge of pavement shall be feathered to conform with the existing pavement.
7. Resurfacing during peak traffic hours, 7:00 a.m. to 8:30 a.m. and 3:30 p.m. to 5:00 p.m. (Monday through Friday) will not be permitted and all six-lanes of Lunalilo Freeway shall be kept open to traffic. At all other times, resurfacing shall be limited to one lane each in the inbound and outbound lanes.

APPROVED DATE 15 Dec 67  
*Luisio Watanabe*  
DIRECTOR OF TRANSPORTATION

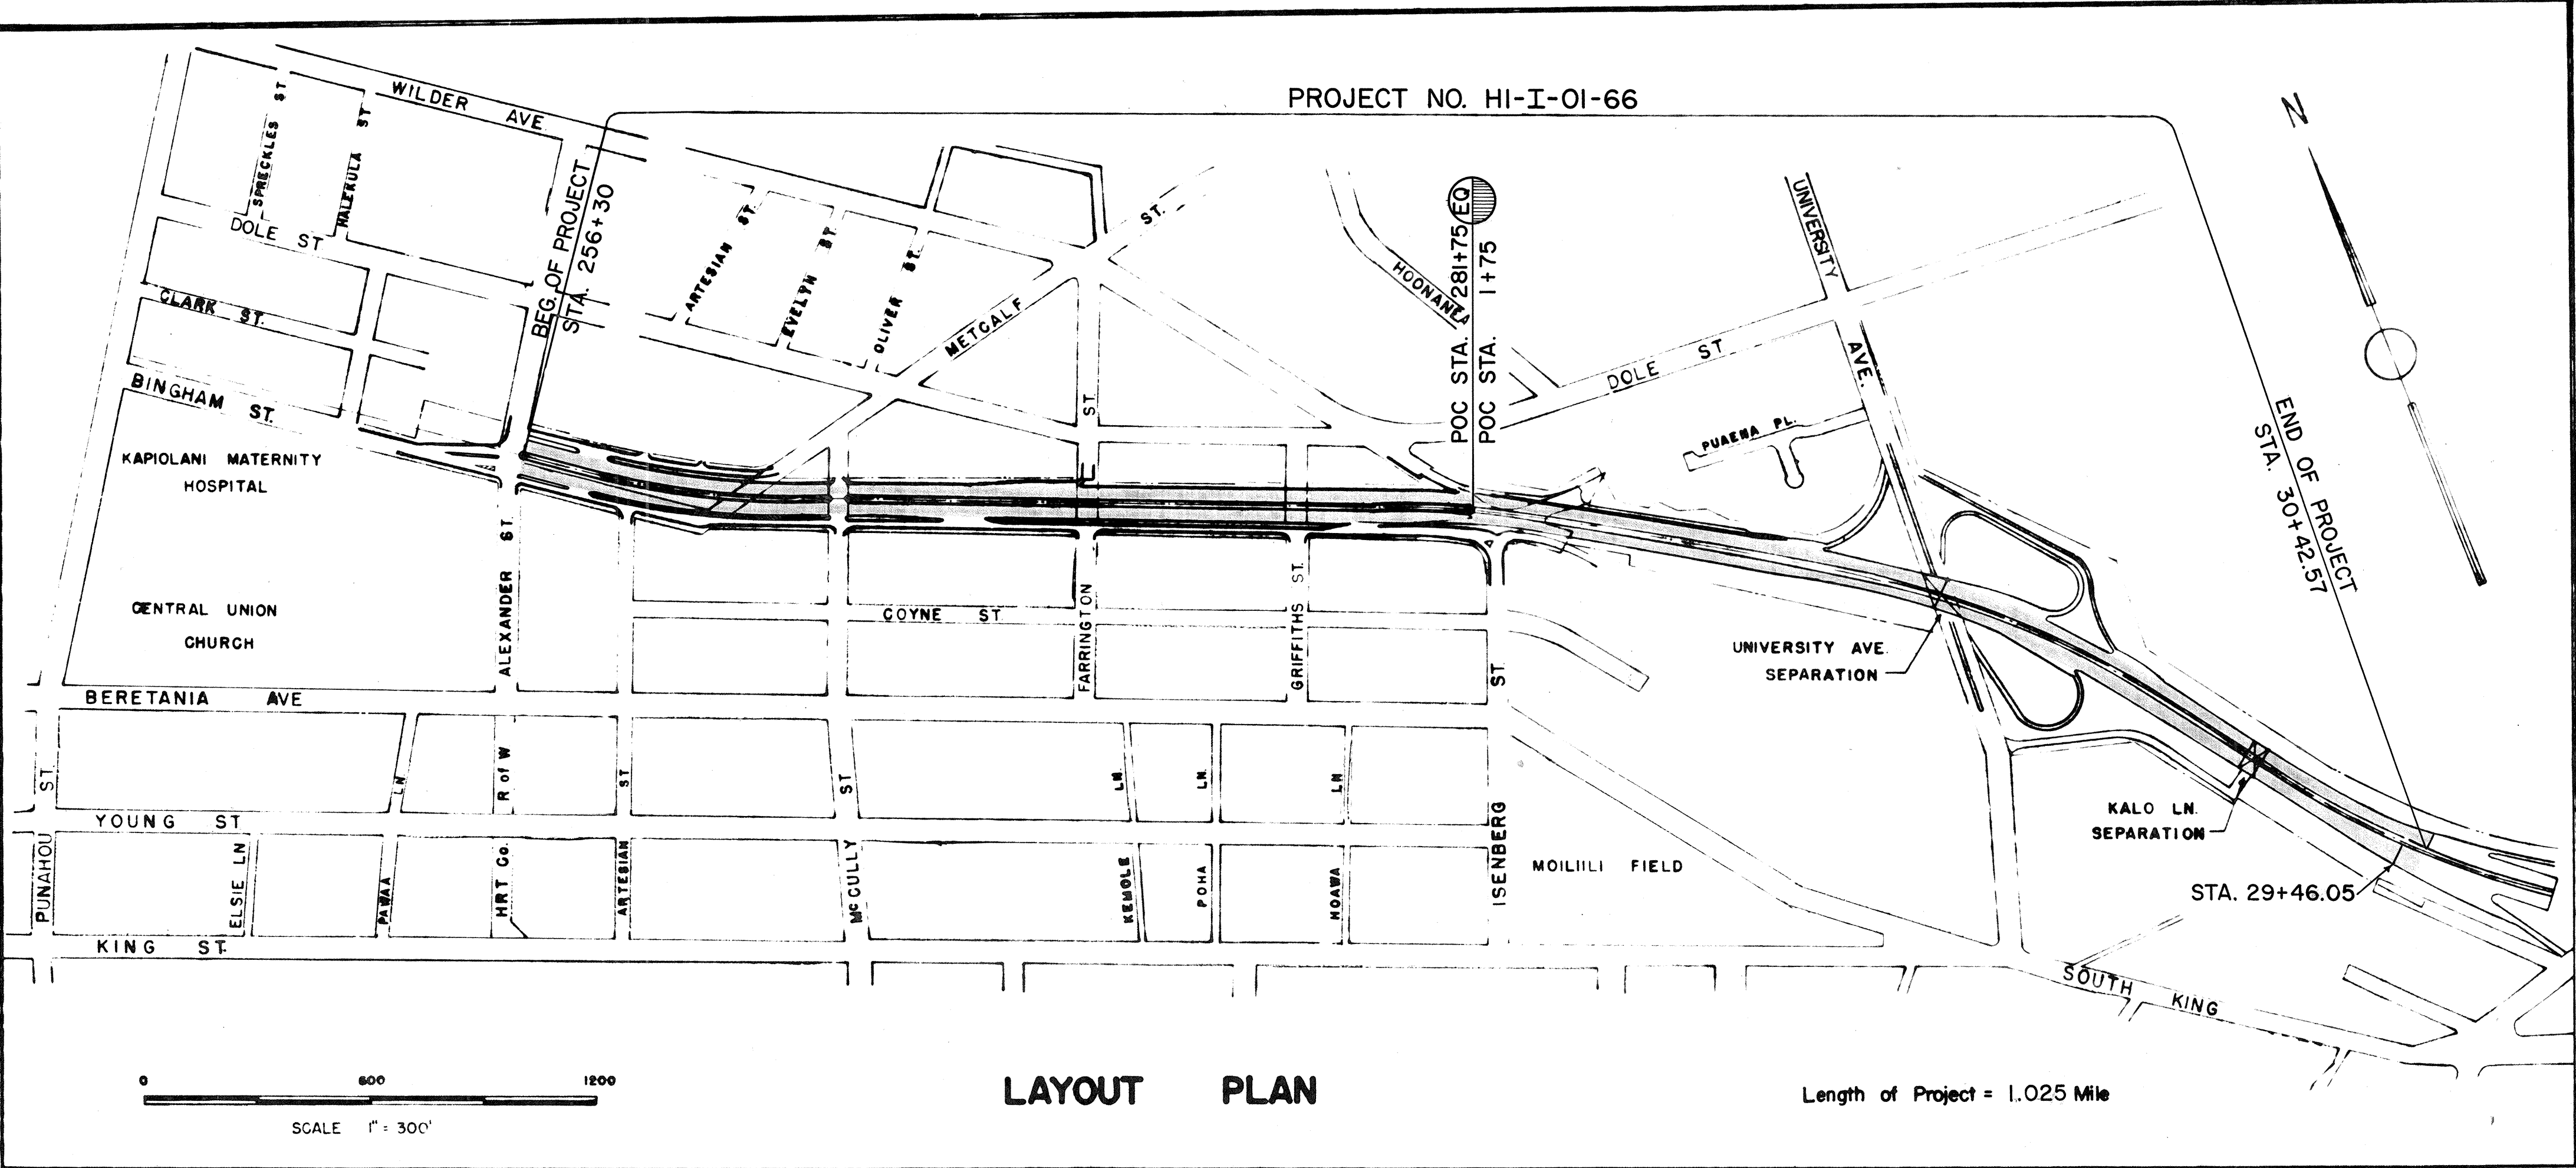

DATE  
DESIGNED BY  
CHECKED BY  
DATE  
DESIGNED BY  
CHECKED BY  
DATE  
DESIGNED BY  
CHECKED BY