




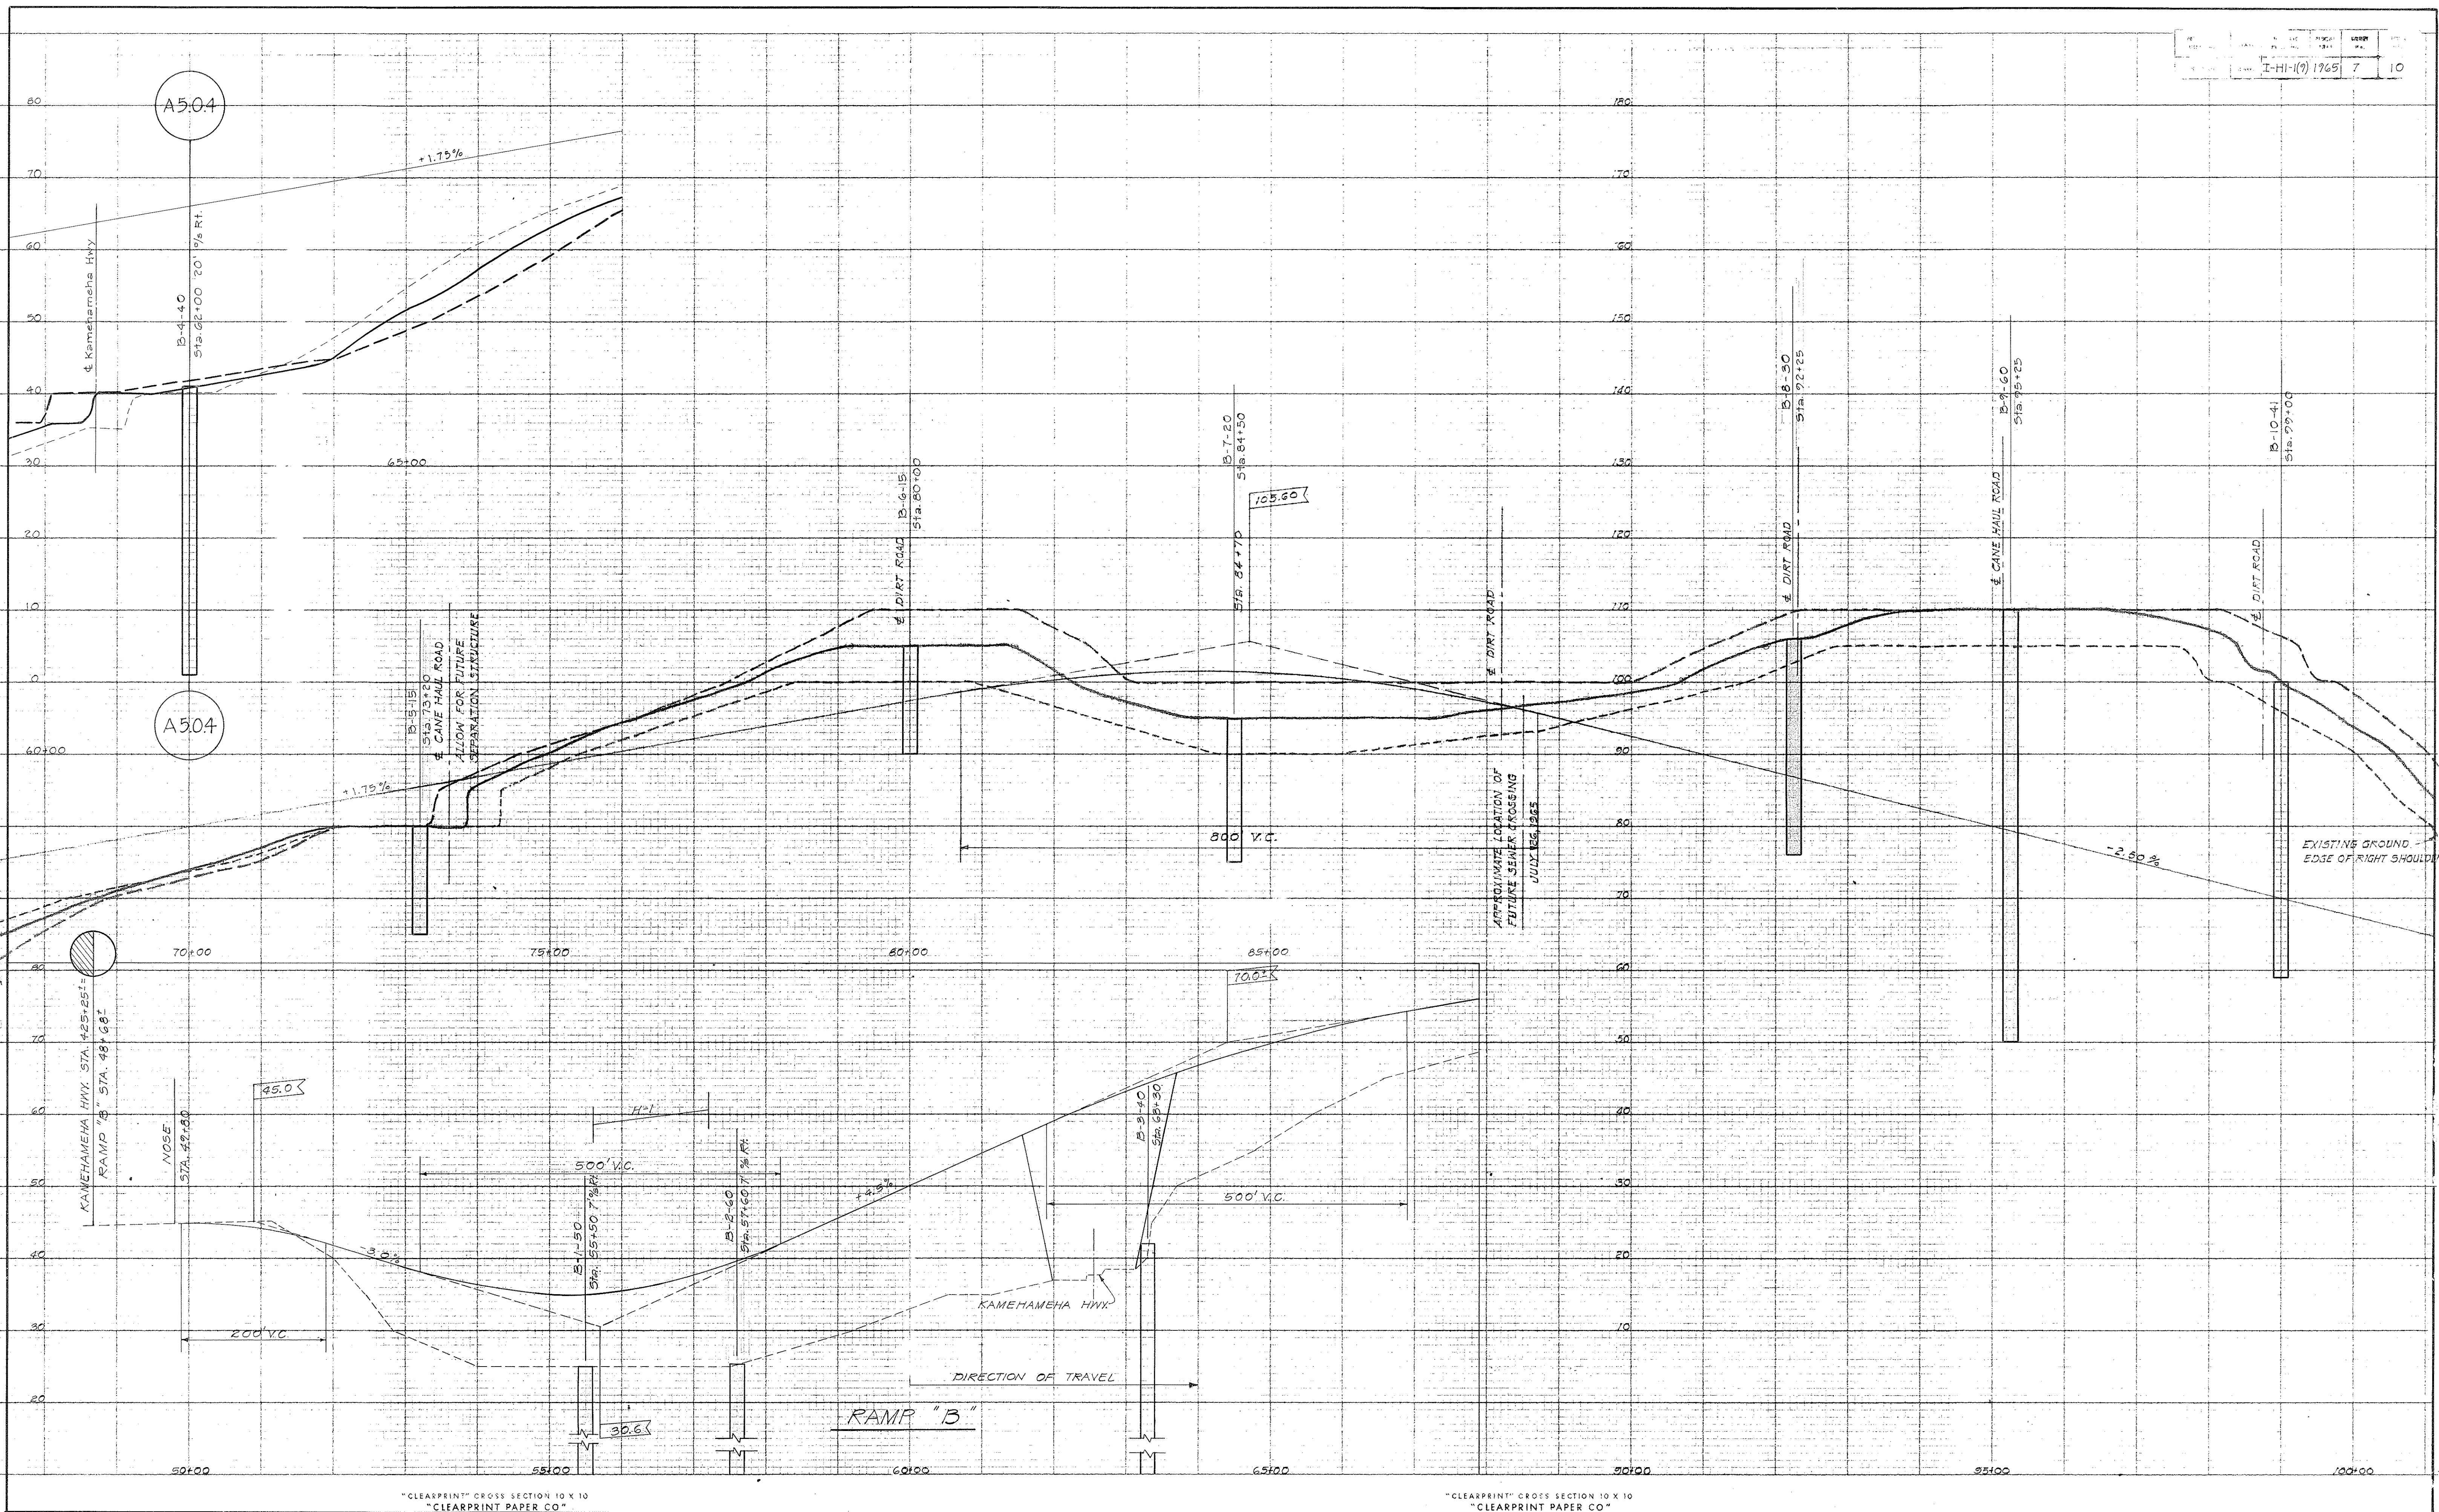

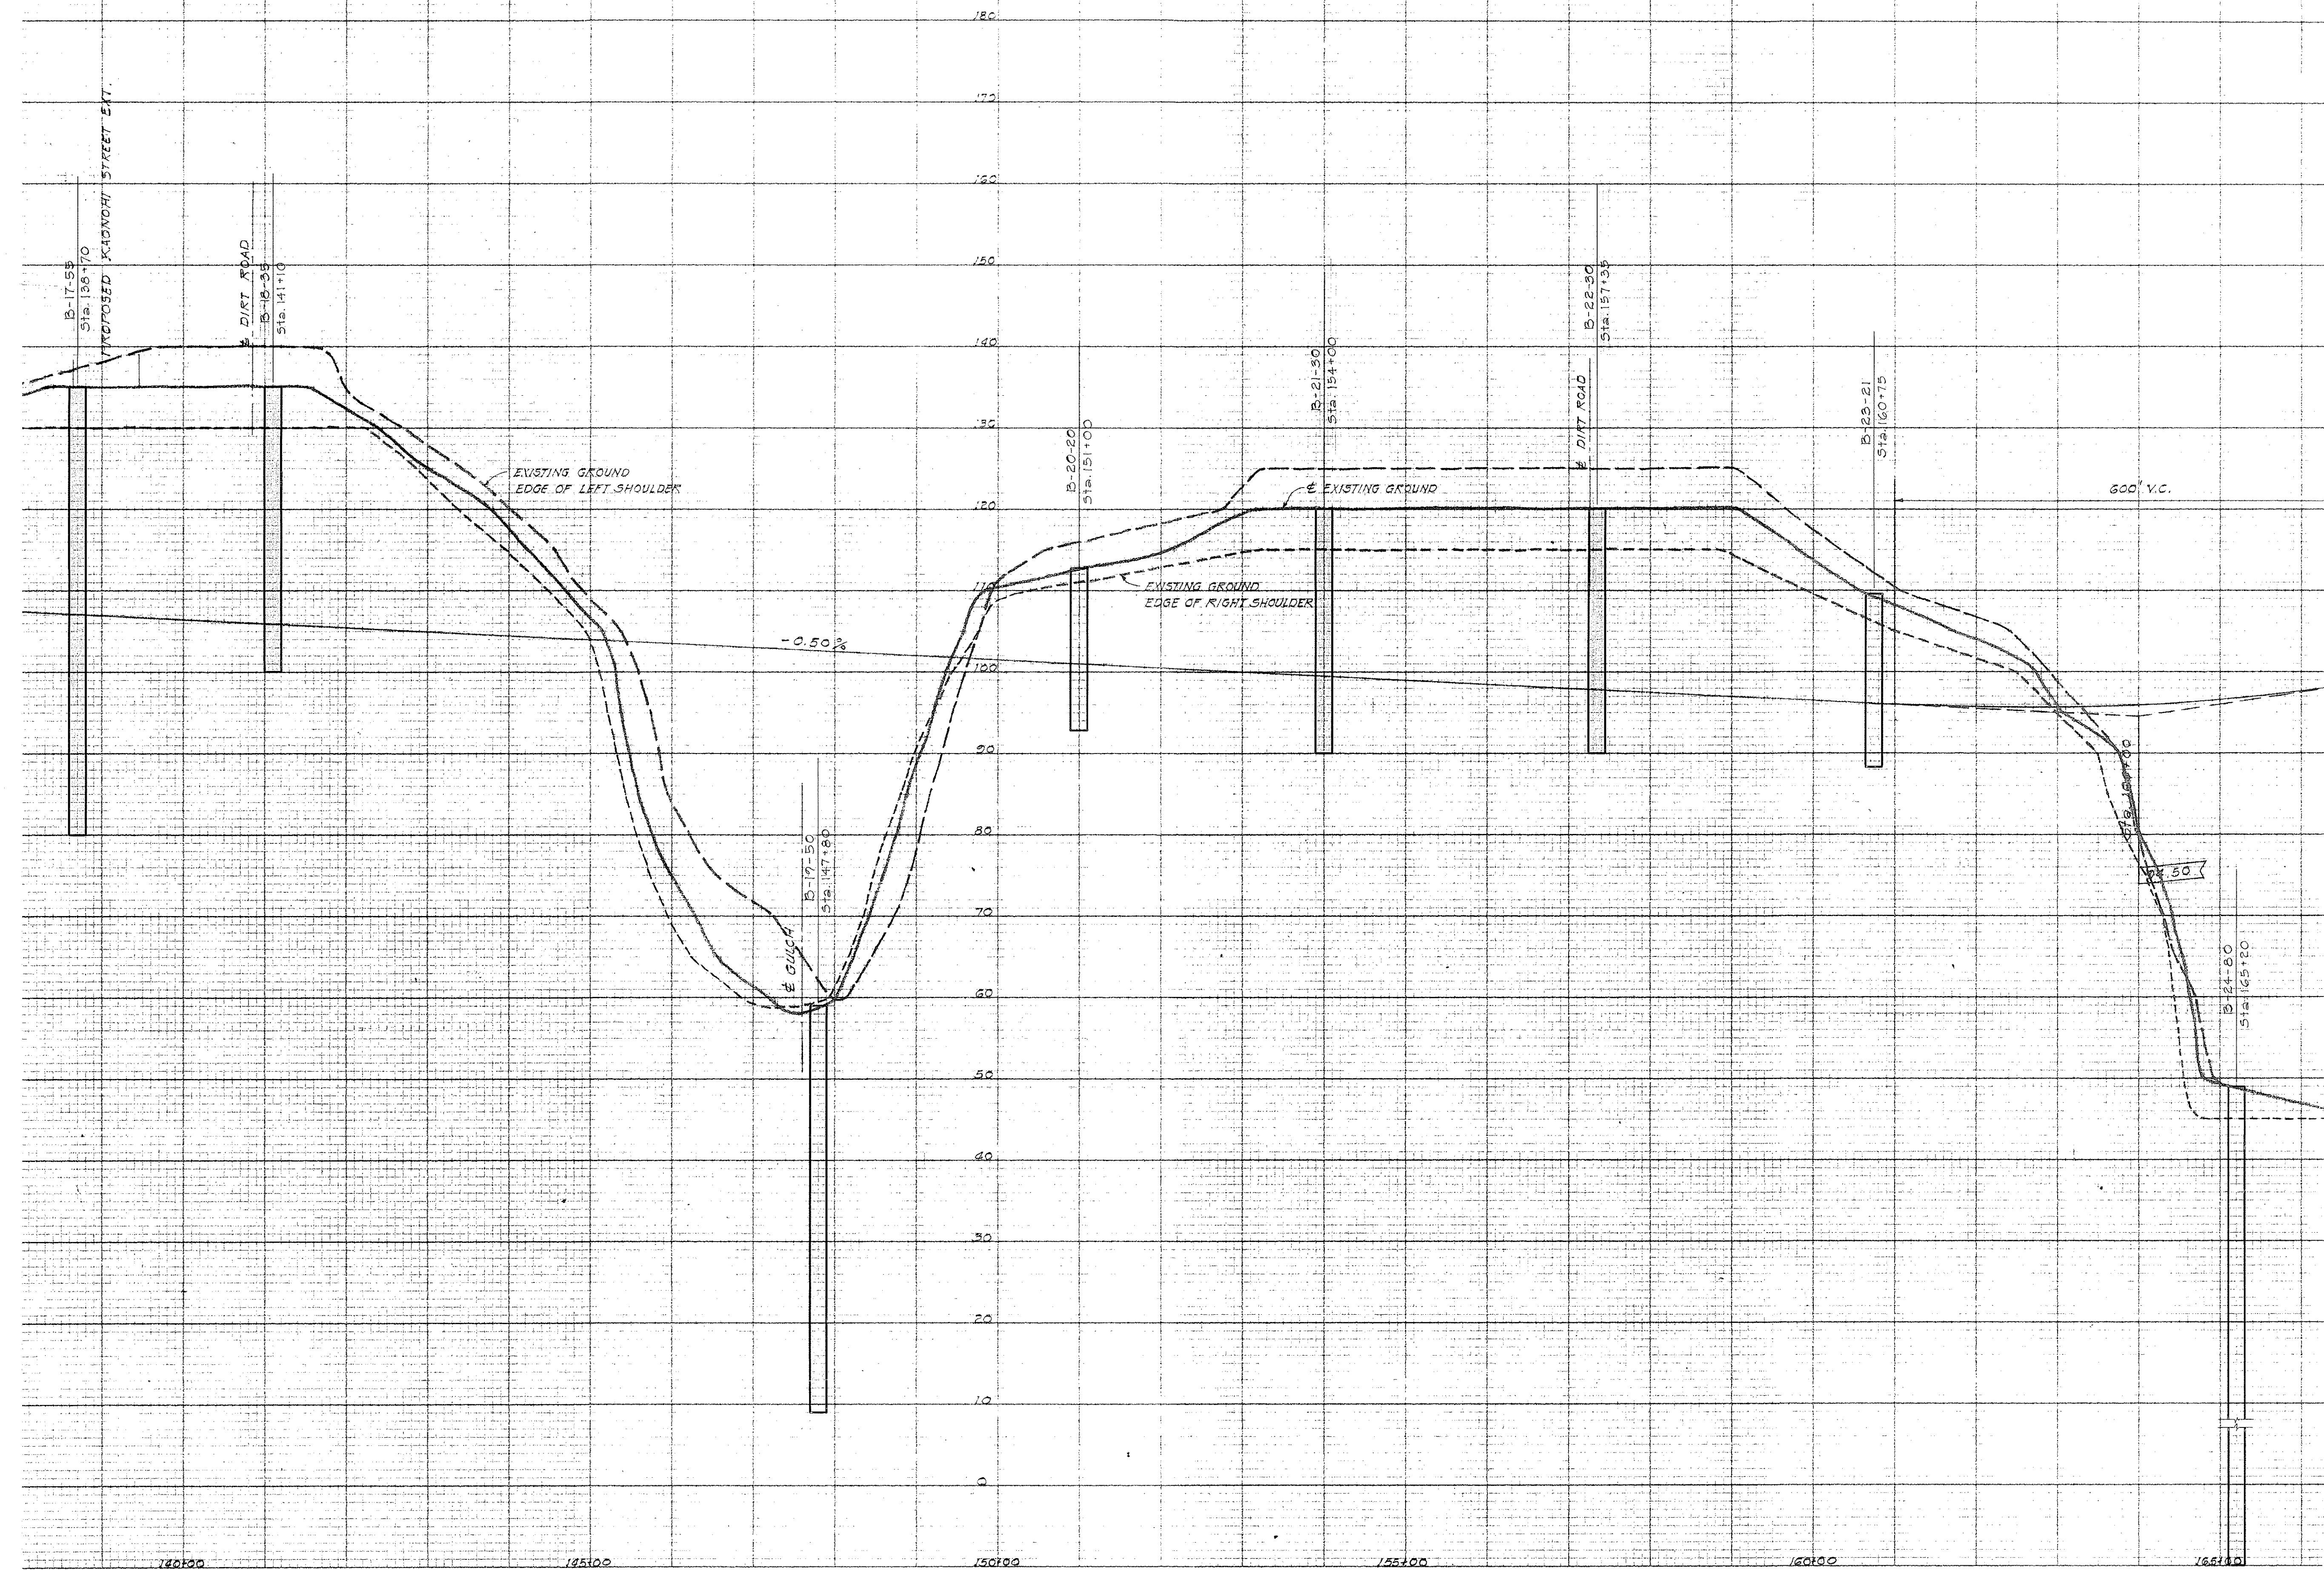

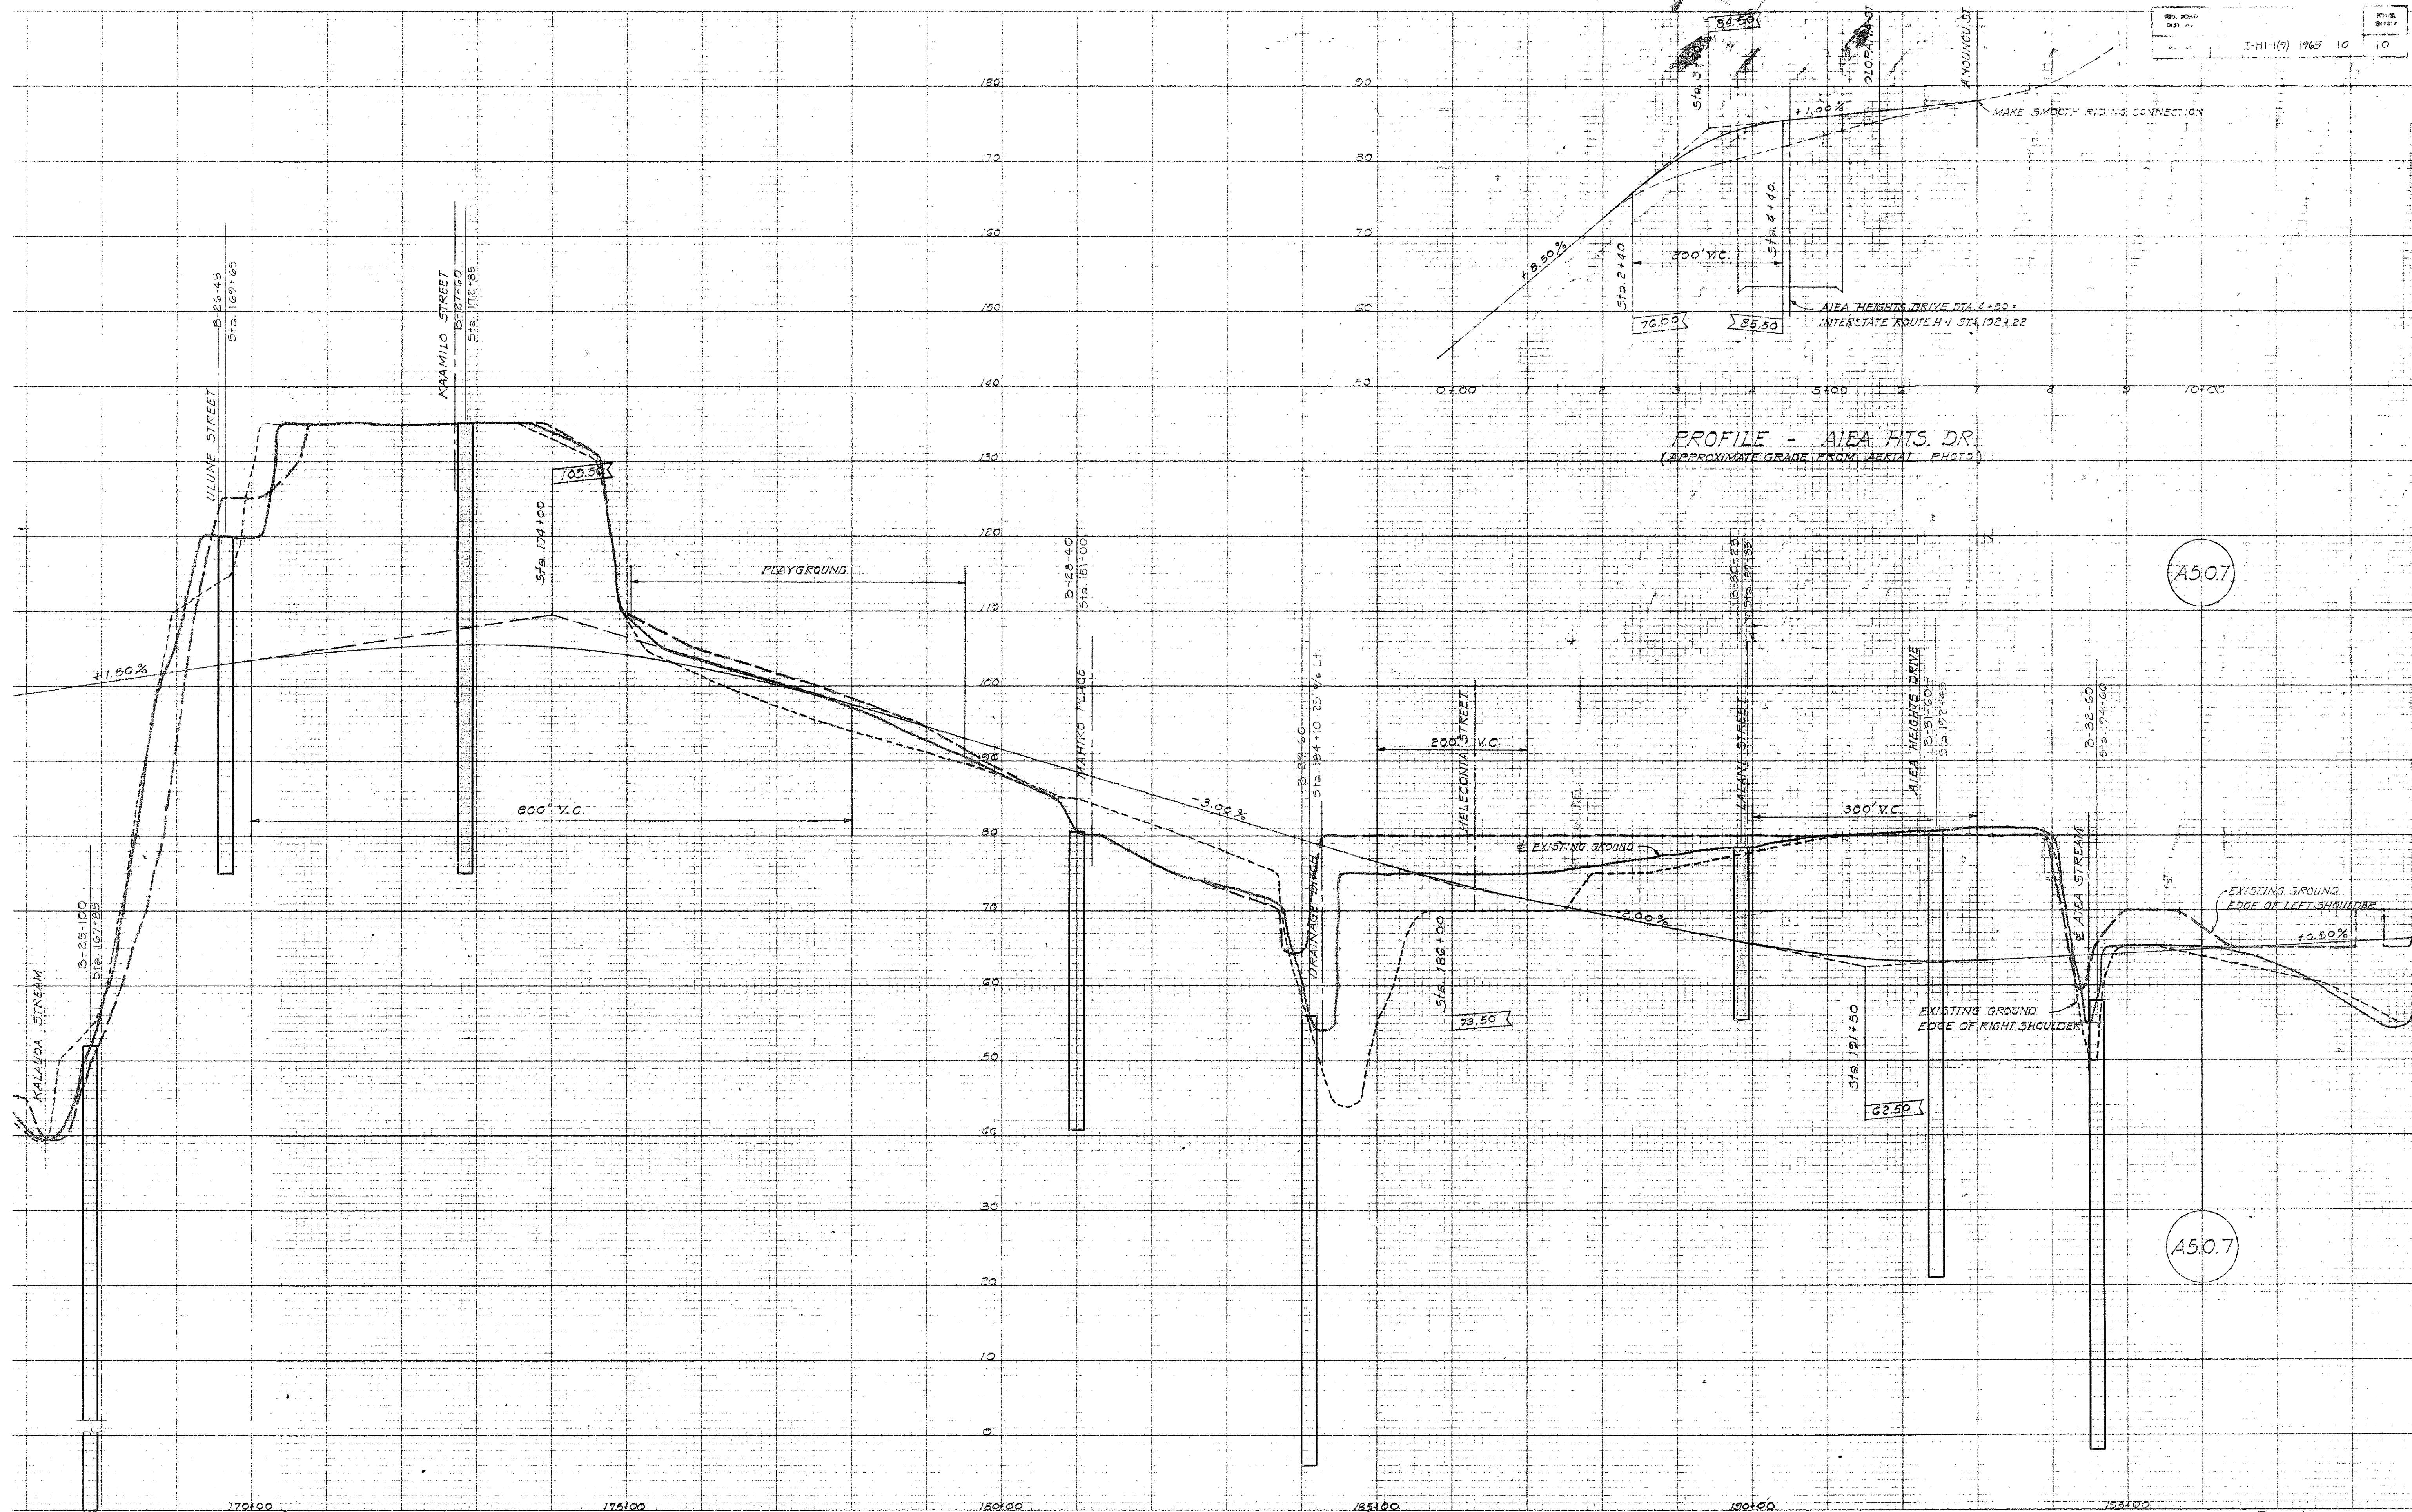

PROFILE - AIEA HTS. DR.
(APPROXIMATE GRADE FROM AERIAL PHOTO)

A50.7

A50.7