


CURVE DATA

	①	②	③	④	⑤	⑥	⑦	⑧
Δ	96° 06' 56"	83° 57' 44"	96° 36' 00"	83° 53' 04"	94° 00' 06"	79° 55' 12"	16° 04' 53"	63° 57' 10"
Δ/2	48° 03' 28"	41° 58' 52"	48° 18' 00"	41° 56' 32"	47° 00' 03"	39° 57' 36"	8° 02' 36.5"	31° 58' 35"
T	50.00	50.00	50.00	50.00	50.00	50.00	180.00	65.00
M	55.64	44.97	56.12	44.93	53.62	41.90	25.43	40.58
C	74.38	66.87	74.66	66.84	73.14	64.23	50.36	68.84
L	83.88	73.27	84.30	73.20	82.03	69.74	50.52	72.55

TRUE NORTH
Scale: 1" = 20'

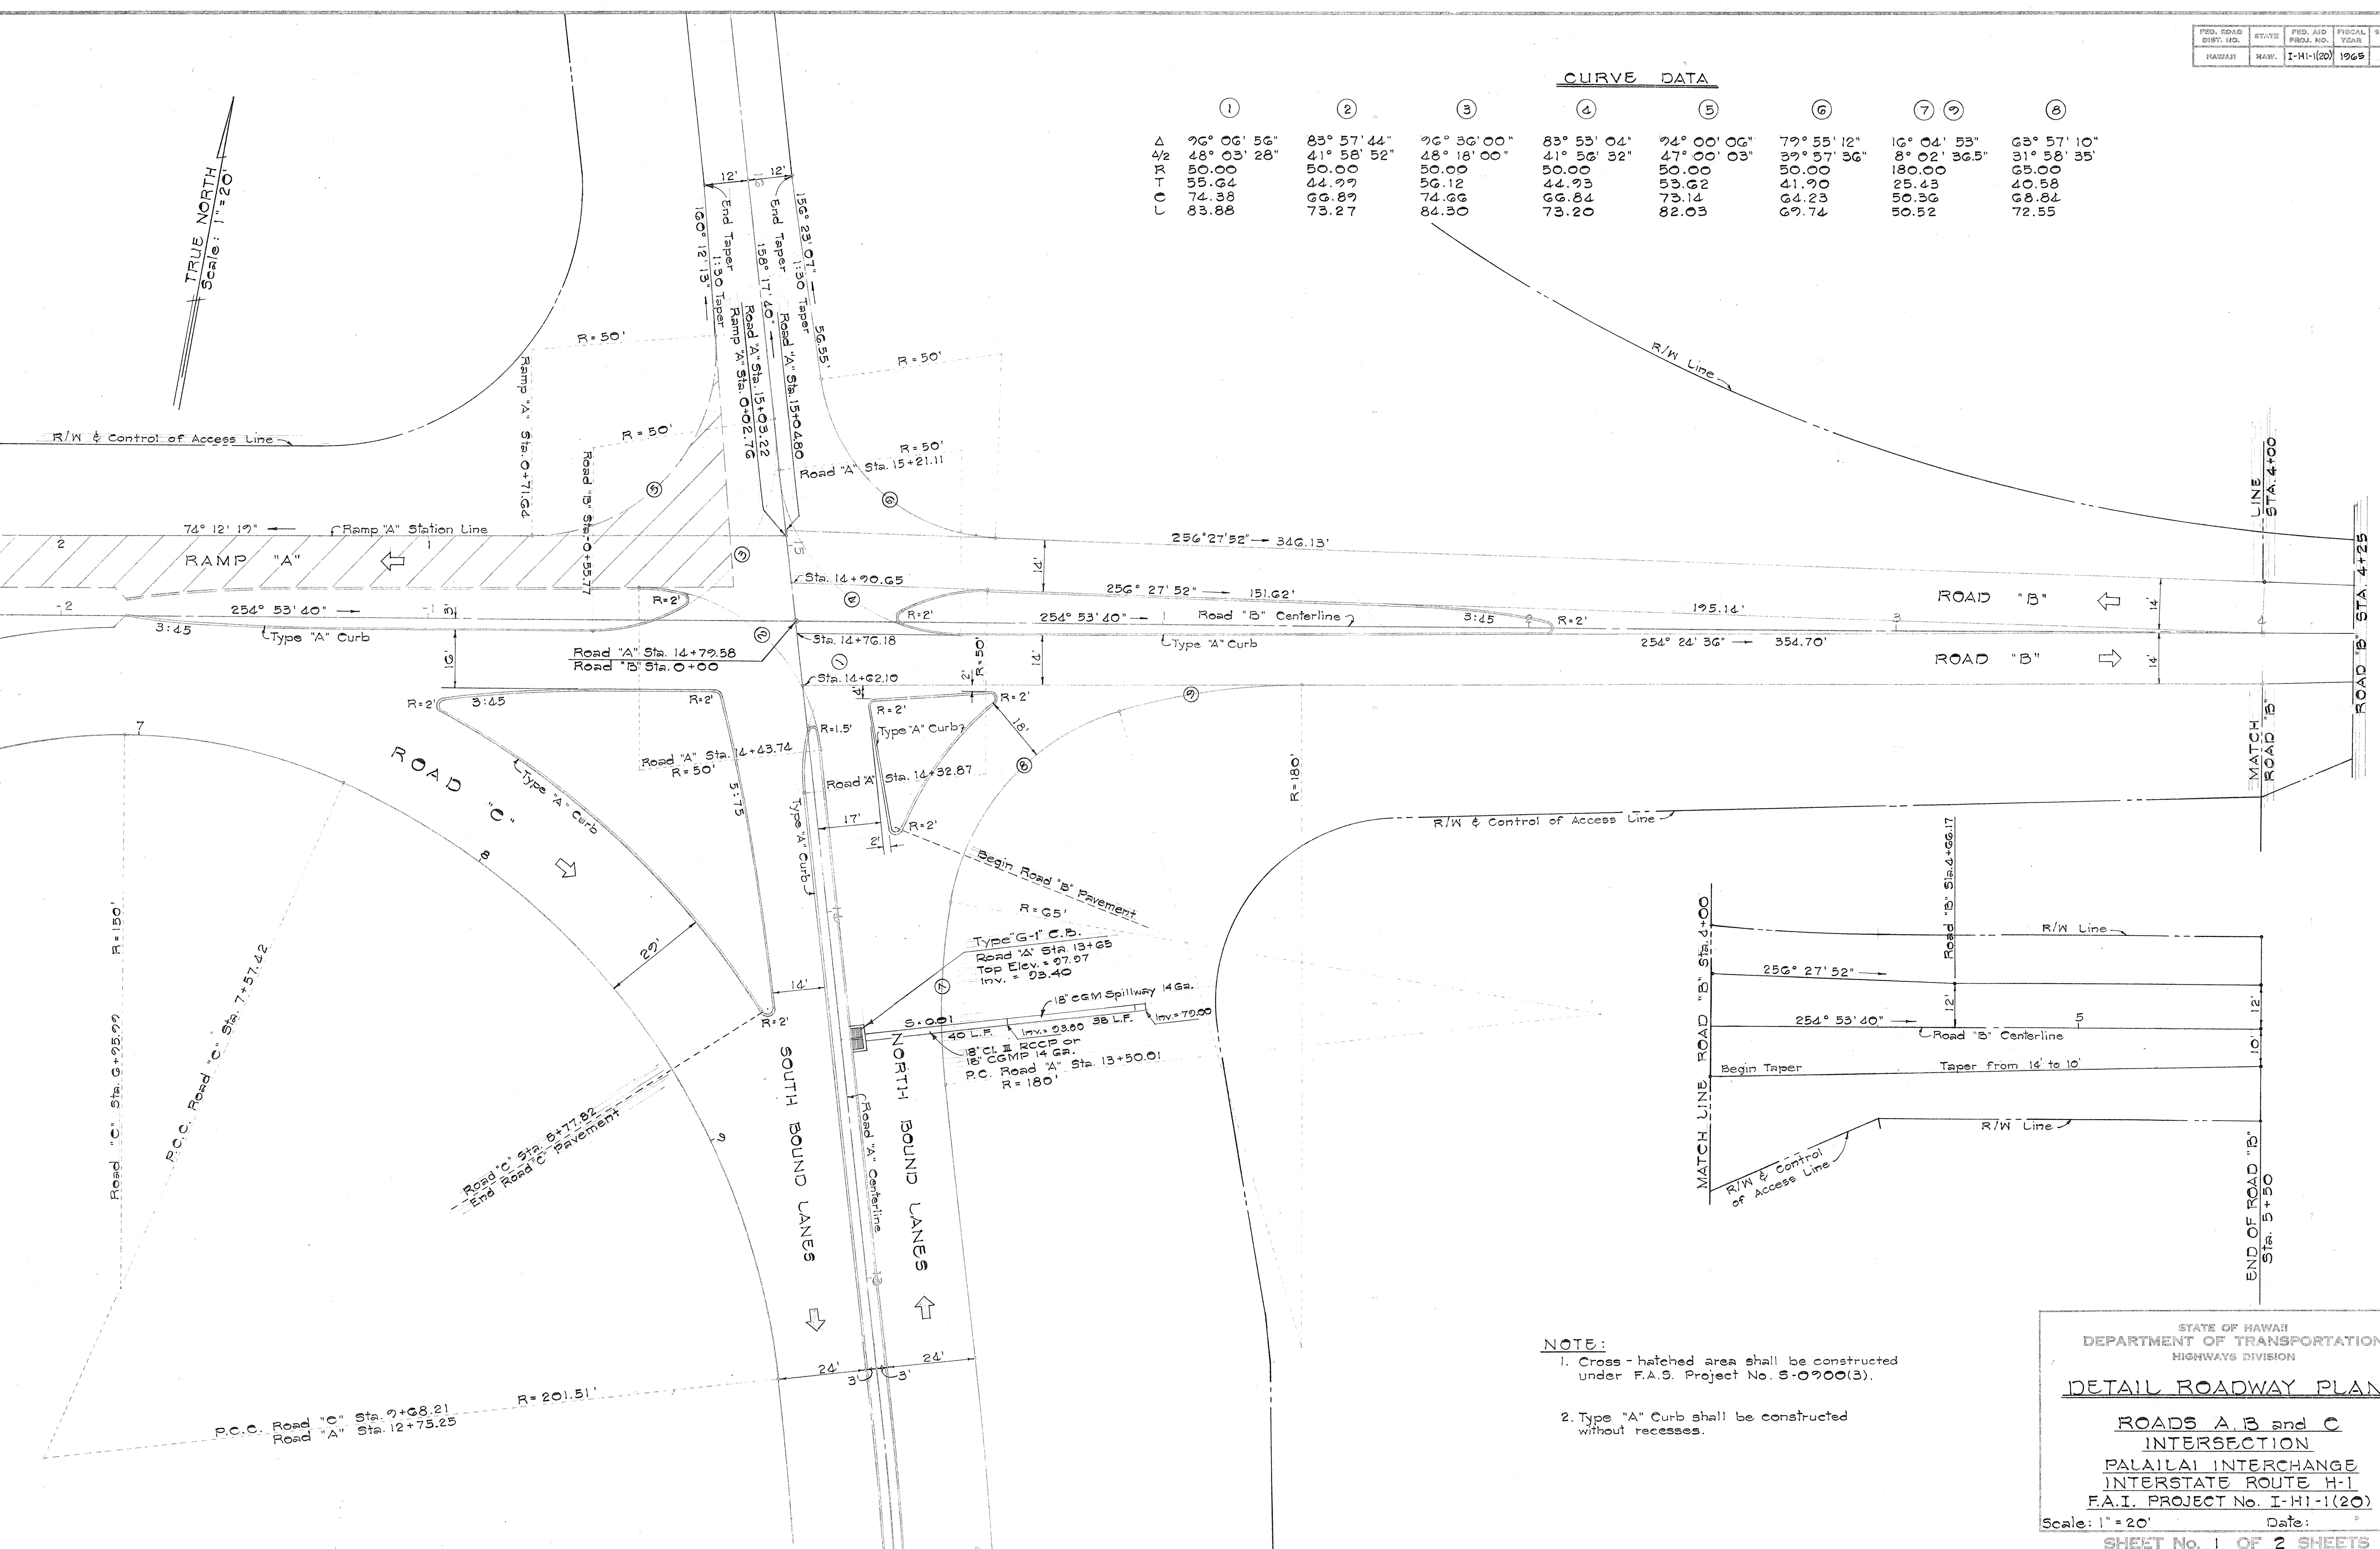

NOTE:
1. Cross-hatched area shall be constructed under F.A.S. Project No. S-0900(3).
2. Type "A" Curb shall be constructed without recesses.

STATE OF HAWAII
DEPARTMENT OF TRANSPORTATION
HIGHWAYS DIVISION

DETAIL ROADWAY PLAN

**ROADS A, B and C
INTERSECTION**

**PALAILAI INTERCHANGE
INTERSTATE ROUTE H-1
F.A.I. PROJECT No. I-HI-1(20)**

Scale: 1" = 20' Date:

SHEET No. 1 OF 2 SHEETS


7. 169

DESIGNED BY	DATE
DRAWN BY	
CHECKED BY	
NOTED BY	
DATE	

FED. ROAD DIST. NO.	STATE	FED. AID PROJ. NO.	FISCAL YEAR	SHEET NO.	TOTAL SHEETS
HAWAII	HAW.	1-HI-1(20)	1965	8	55

Construct Metal Guard Rail W/ Conc. Post.
 O.B. @ Sta. 43+00 (Lt) to O.B. @ Sta. 46+37 (Lt) = 337.5 LF
 O.B. @ Sta. 42+00 (Rt) to O.B. @ Sta. 46+37 (Rt) = 437.5 LF
 I.B. @ Sta. 42+00 (Lt) to I.B. @ Sta. 46+37 (Lt) = 437.5 LF
 I.B. @ Sta. 42+00 (Rt) to I.B. @ Sta. 45+00 (Rt) = 300.0 LF

True North
 Scale: 1" = 50'

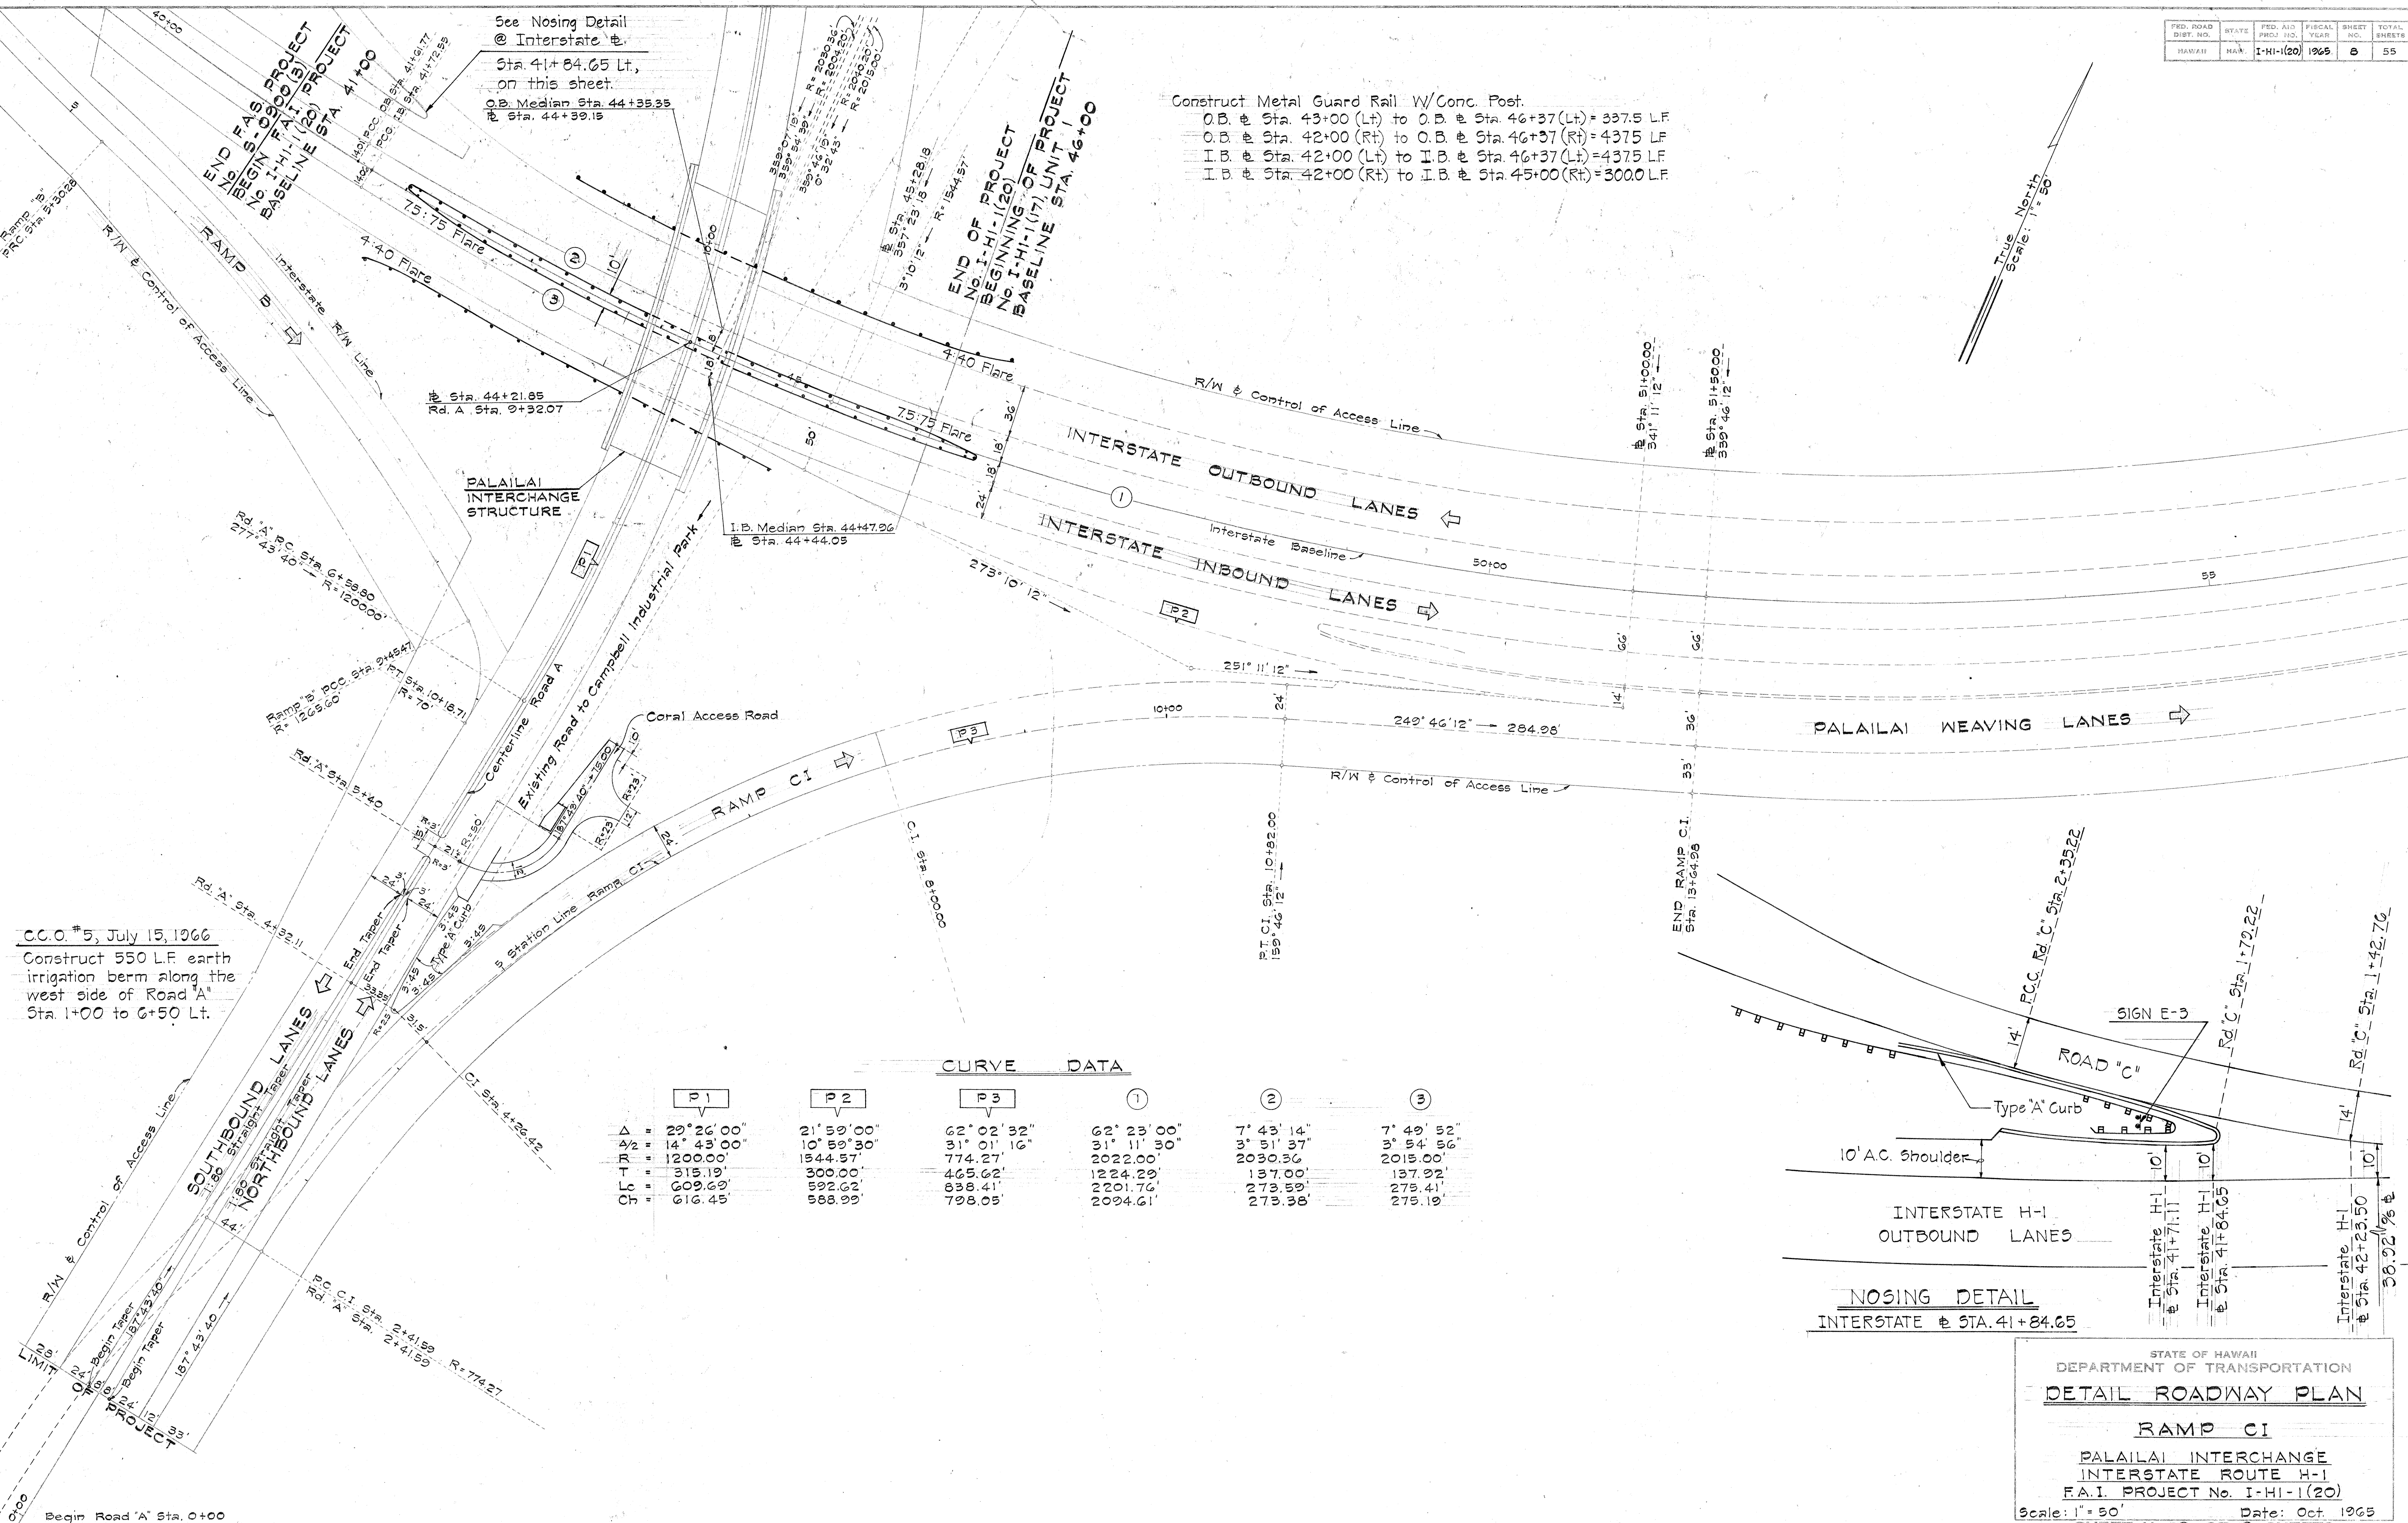

C.C.O. #5, July 15, 1966
 Construct 550 L.F. earth
 irrigation berm along the
 west side of Road "A"
 Sta. 1+00 to G+50 Lt.

CURVE DATA

	P1	P2	P3	①	②	③
Δ	29° 26' 00"	21° 59' 00"	62° 02' 32"	62° 23' 00"	7° 43' 14"	7° 49' 52"
Δ/2	14° 43' 00"	10° 59' 30"	31° 01' 16"	31° 11' 30"	3° 51' 37"	3° 54' 56"
R	1200.00'	1544.57'	774.27'	2022.00'	2030.36'	2015.00'
T	315.19'	300.00'	465.62'	1224.29'	137.00'	137.92'
Q	609.69'	592.62'	838.41'	2201.76'	273.59'	275.41'
Q1	616.45'	588.99'	798.05'	2094.61'	273.38'	275.19'

NOSING DETAIL
 INTERSTATE @ STA. 41+84.65

STATE OF HAWAII
 DEPARTMENT OF TRANSPORTATION
DETAIL ROADWAY PLAN
RAMP C1
 PALAILAI INTERCHANGE
 INTERSTATE ROUTE H-1
 F.A.I. PROJECT No. I-HI-1(20)
 Scale: 1" = 50' Date: Oct. 1965
 SHEET No. 2 OF 2 SHEETS

SURVEY PLATTED BY	DATE
DRAWN BY	" "
DESIGNED BY	" "
QUANTITIES BY	" "
CHECKED BY	" "
ORIGINAL PLAN	No.
NOTE BOOK	" "