
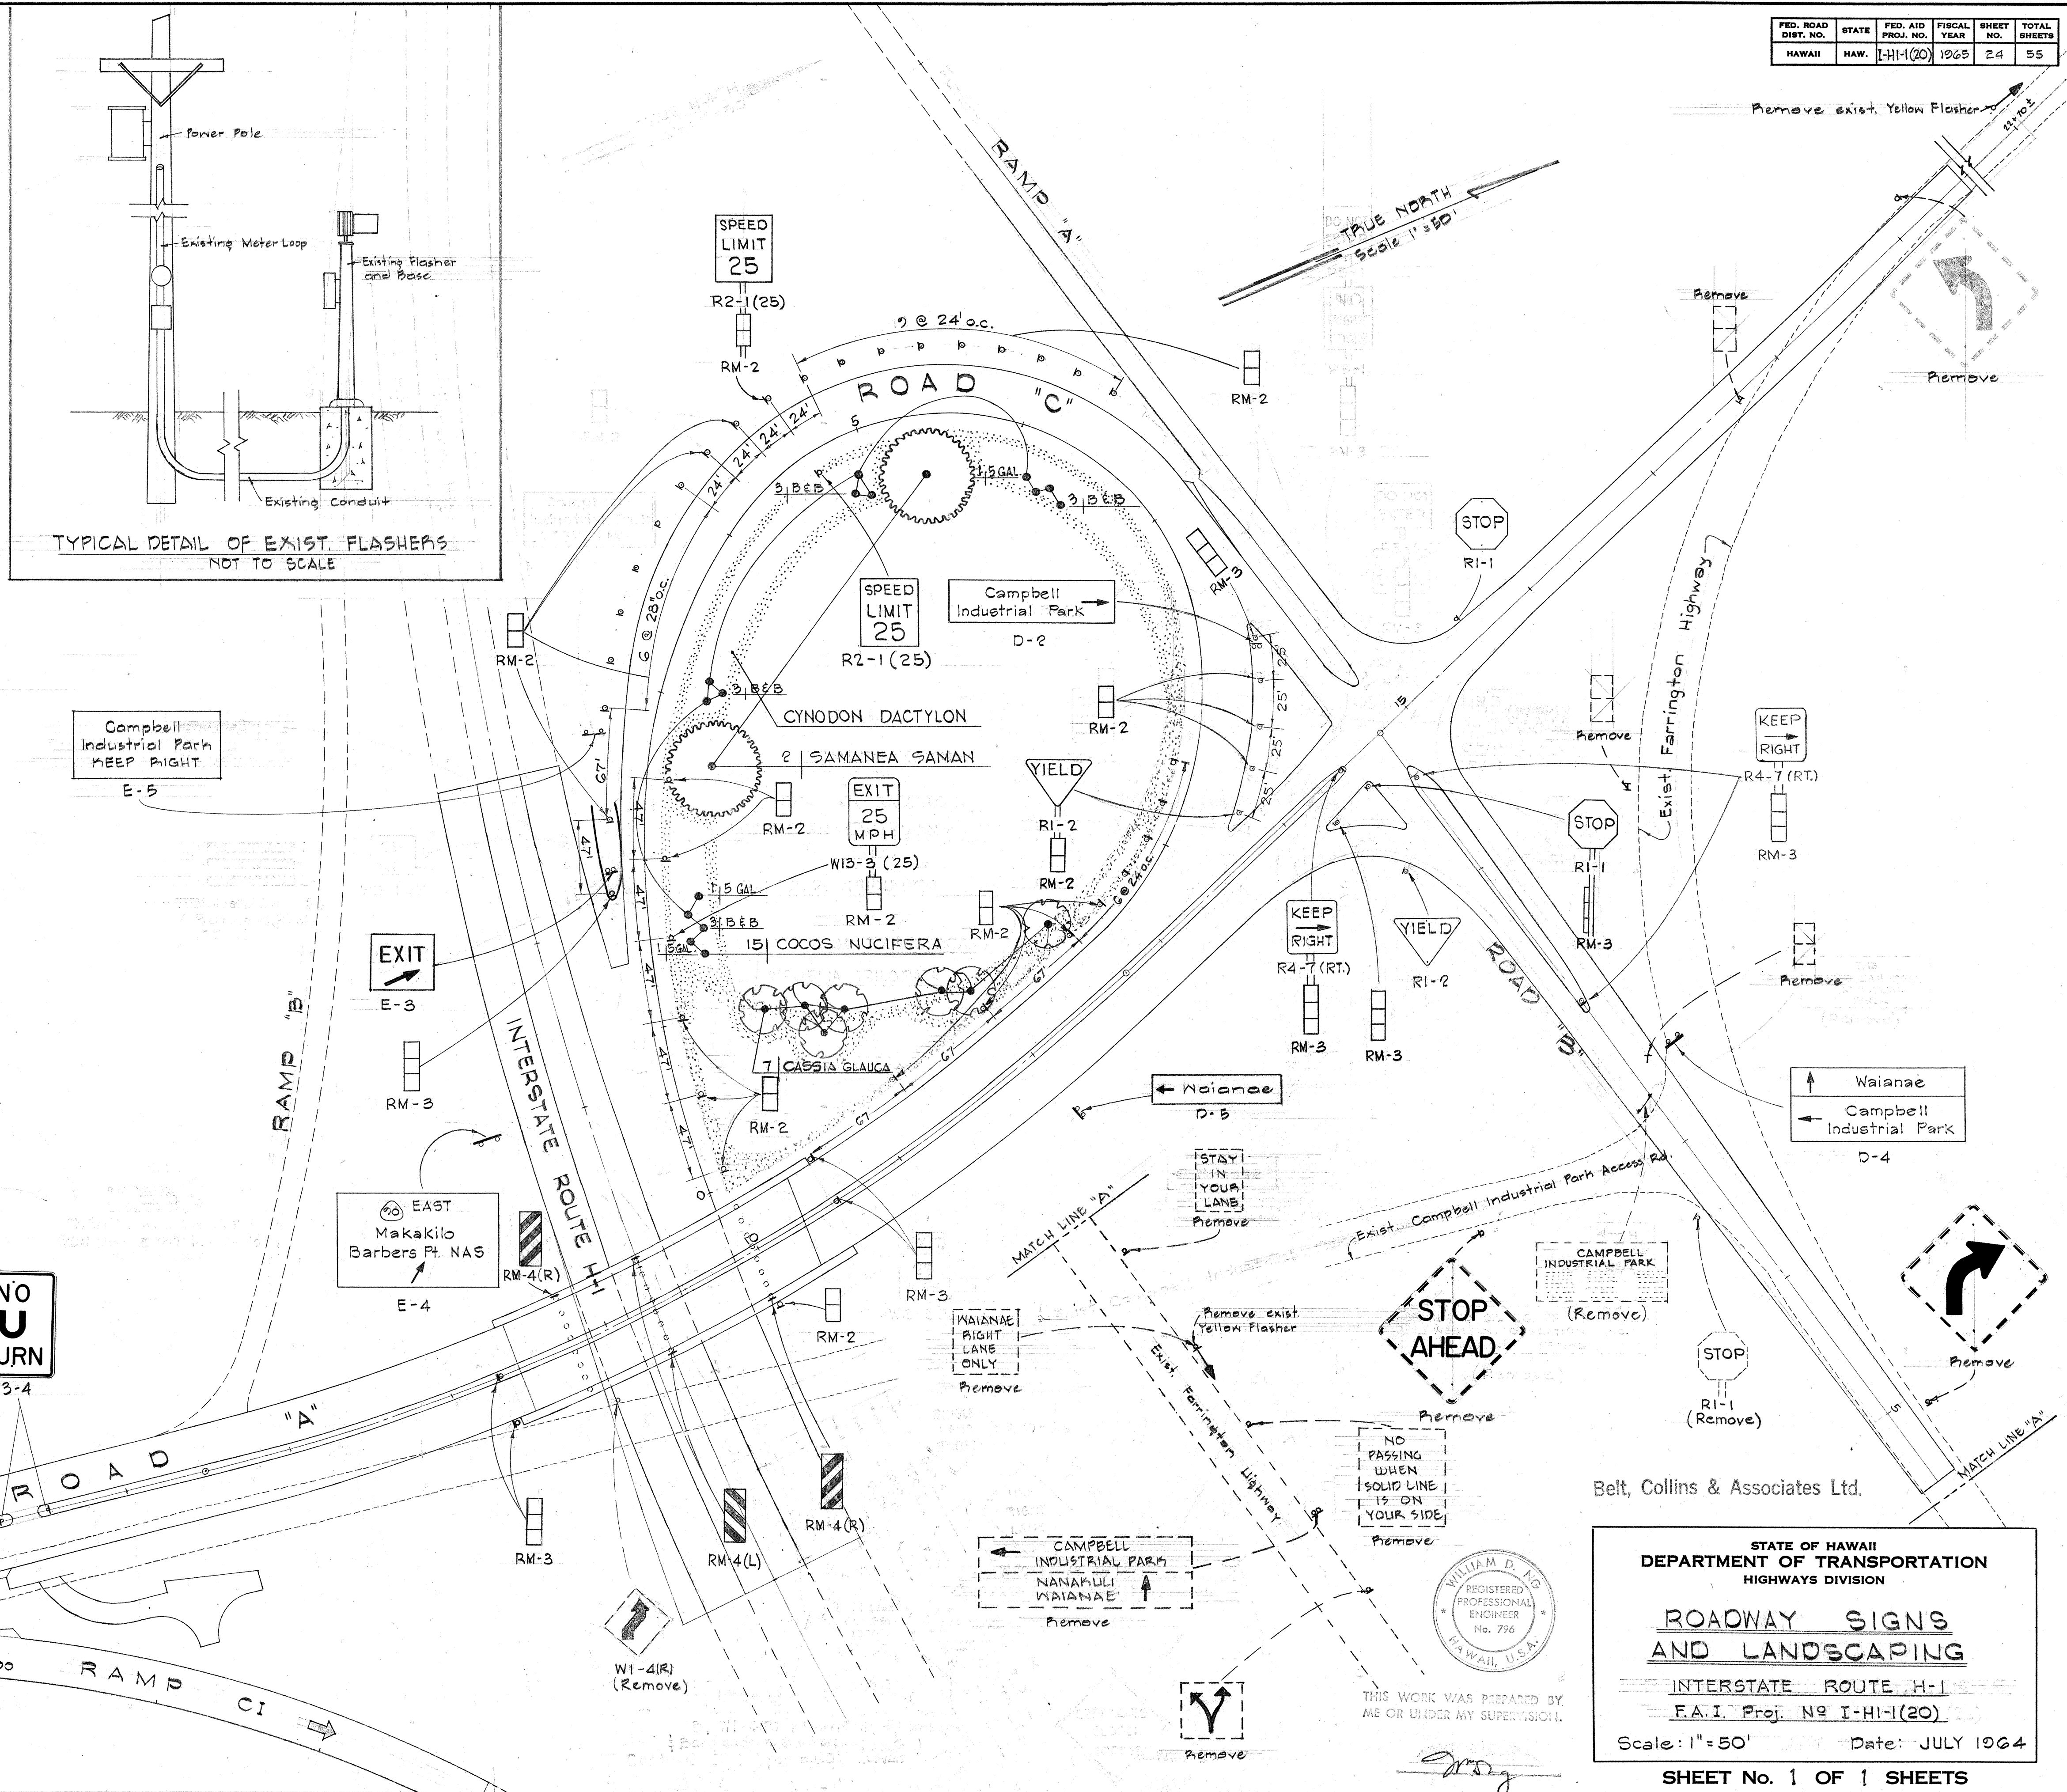


PLANT LIST				
QUANT.	BOTANICAL NAME	COMMON NAME	SIZE	COND.
91,800#	CYNODON DACTYLON	BERMUDA GRASS	SPRIGS	
12	COCOS NUCIFERA	COCONUT	B-B	10' TR
2	SAManea SAMAN	MONKEY POD	B-B	6' TR
7	CASSIA GLAUCA	KALAMONA	1 GAL.	24"
3	COCOS NUCIFERA	COCONUT	5 GAL.	6'-8' *
CCO.#12 65	NERIUM OLEANDERS	OLEANDER	1 GAL.	24"

LANDSCAPE NOTES


- * INDICATES OVERALL HEIGHT OF PLANT
- 50% C.Y. OF TOP SOIL TO BE SPREAD ALONG AREA DESIGNATED BY BERMUDA GRASS TO A DEPTH OF 6 INCHES.

SUMMARY OF DIRECTIONAL, REGULATORY & WARNING SIGNS						
		NO.	SIGN ONLY		SIGN & POST	
			NEW	REL. REM.	NEW	REL. REM.
RI-1	STOP				2	1
RI-2	YIELD				2	
R2-1(25)	SPEED LIMIT 25 MPH				2	
R4-7(R)	KEEP RIGHT				3	
WI-2(S)						1
WI-2(L)						1
W3-1	STOP AHEAD					1
RM-2	REFLECTOR	3		2	35	3
RM-3	REFLECTOR	4			8	
RM-4(L)	REFLECTOR MARKER	2				
RM-4(R)	REFLECTOR MARKER	2				
WI-4(R)						1
WI3-3(25)	EXIT 25 M.P.H.				1	
	STAY IN YOUR LANE					1
	WAIANAE RIGHT LANE ONLY					1
	NO PASSING WHEN SOLID LINE etc.					1
						1
	DESTINATION SIGN					1
R3-4	NO U TURN				2	
	TOTAL	11		2	55	13

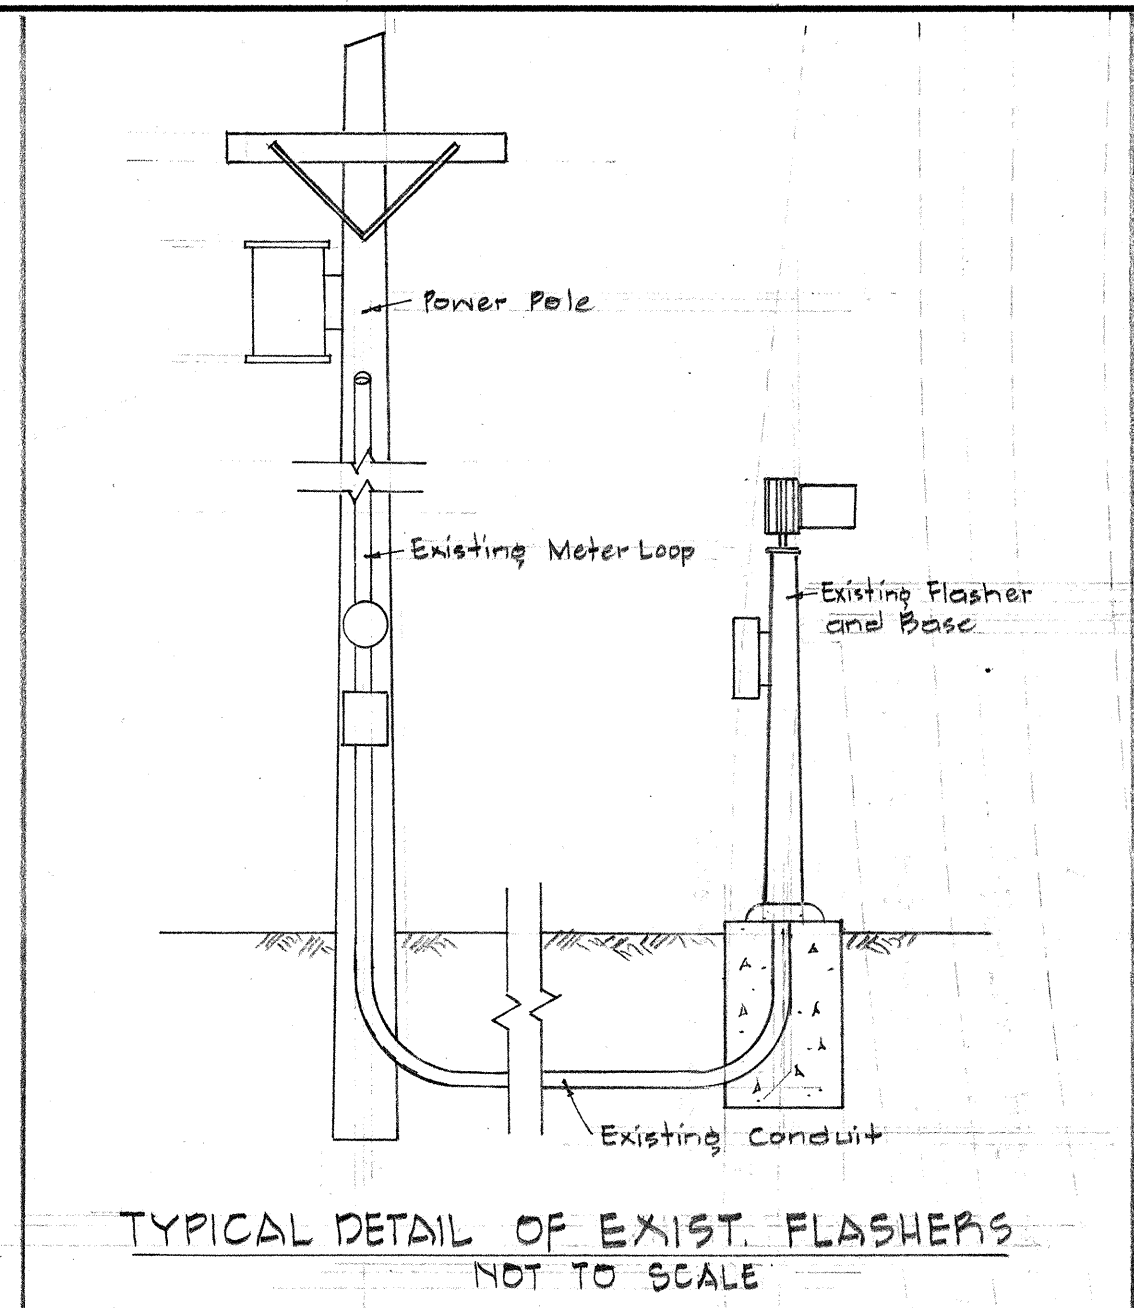

DATE	DATE
DESIGNED BY	DESIGNED BY
TRACED BY	TRACED BY
QUANTITIES BY	QUANTITIES BY
CHECKED BY	CHECKED BY
ORIGINAL PLAN	NOTE BOOK
No.	No.

FED. ROAD DIST. NO.	STATE	FED. AID PROJ. NO.	FISCAL YEAR	SHEET NO.	TOTAL SHEETS
HAWAII	HAW.	[H-1(20)	1965	24	55

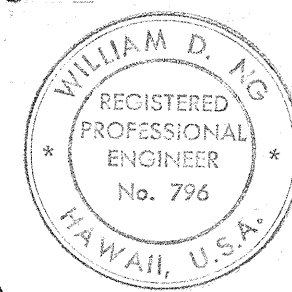

THIS WORK WAS PREPARED BY ME OR UNDER MY SUPERVISION.

STATE OF HAWAII
DEPARTMENT OF TRANSPORTATION
HIGHWAYS DIVISION

ROADWAY SIGNS
AND LANDSCAPING
INTERSTATE ROUTE H-1
F.A.I. Proj. N9 I-HI-1(20)
Scale: 1"=50' Date: JULY 1964
SHEET No. 1 OF 1 SHEETS