


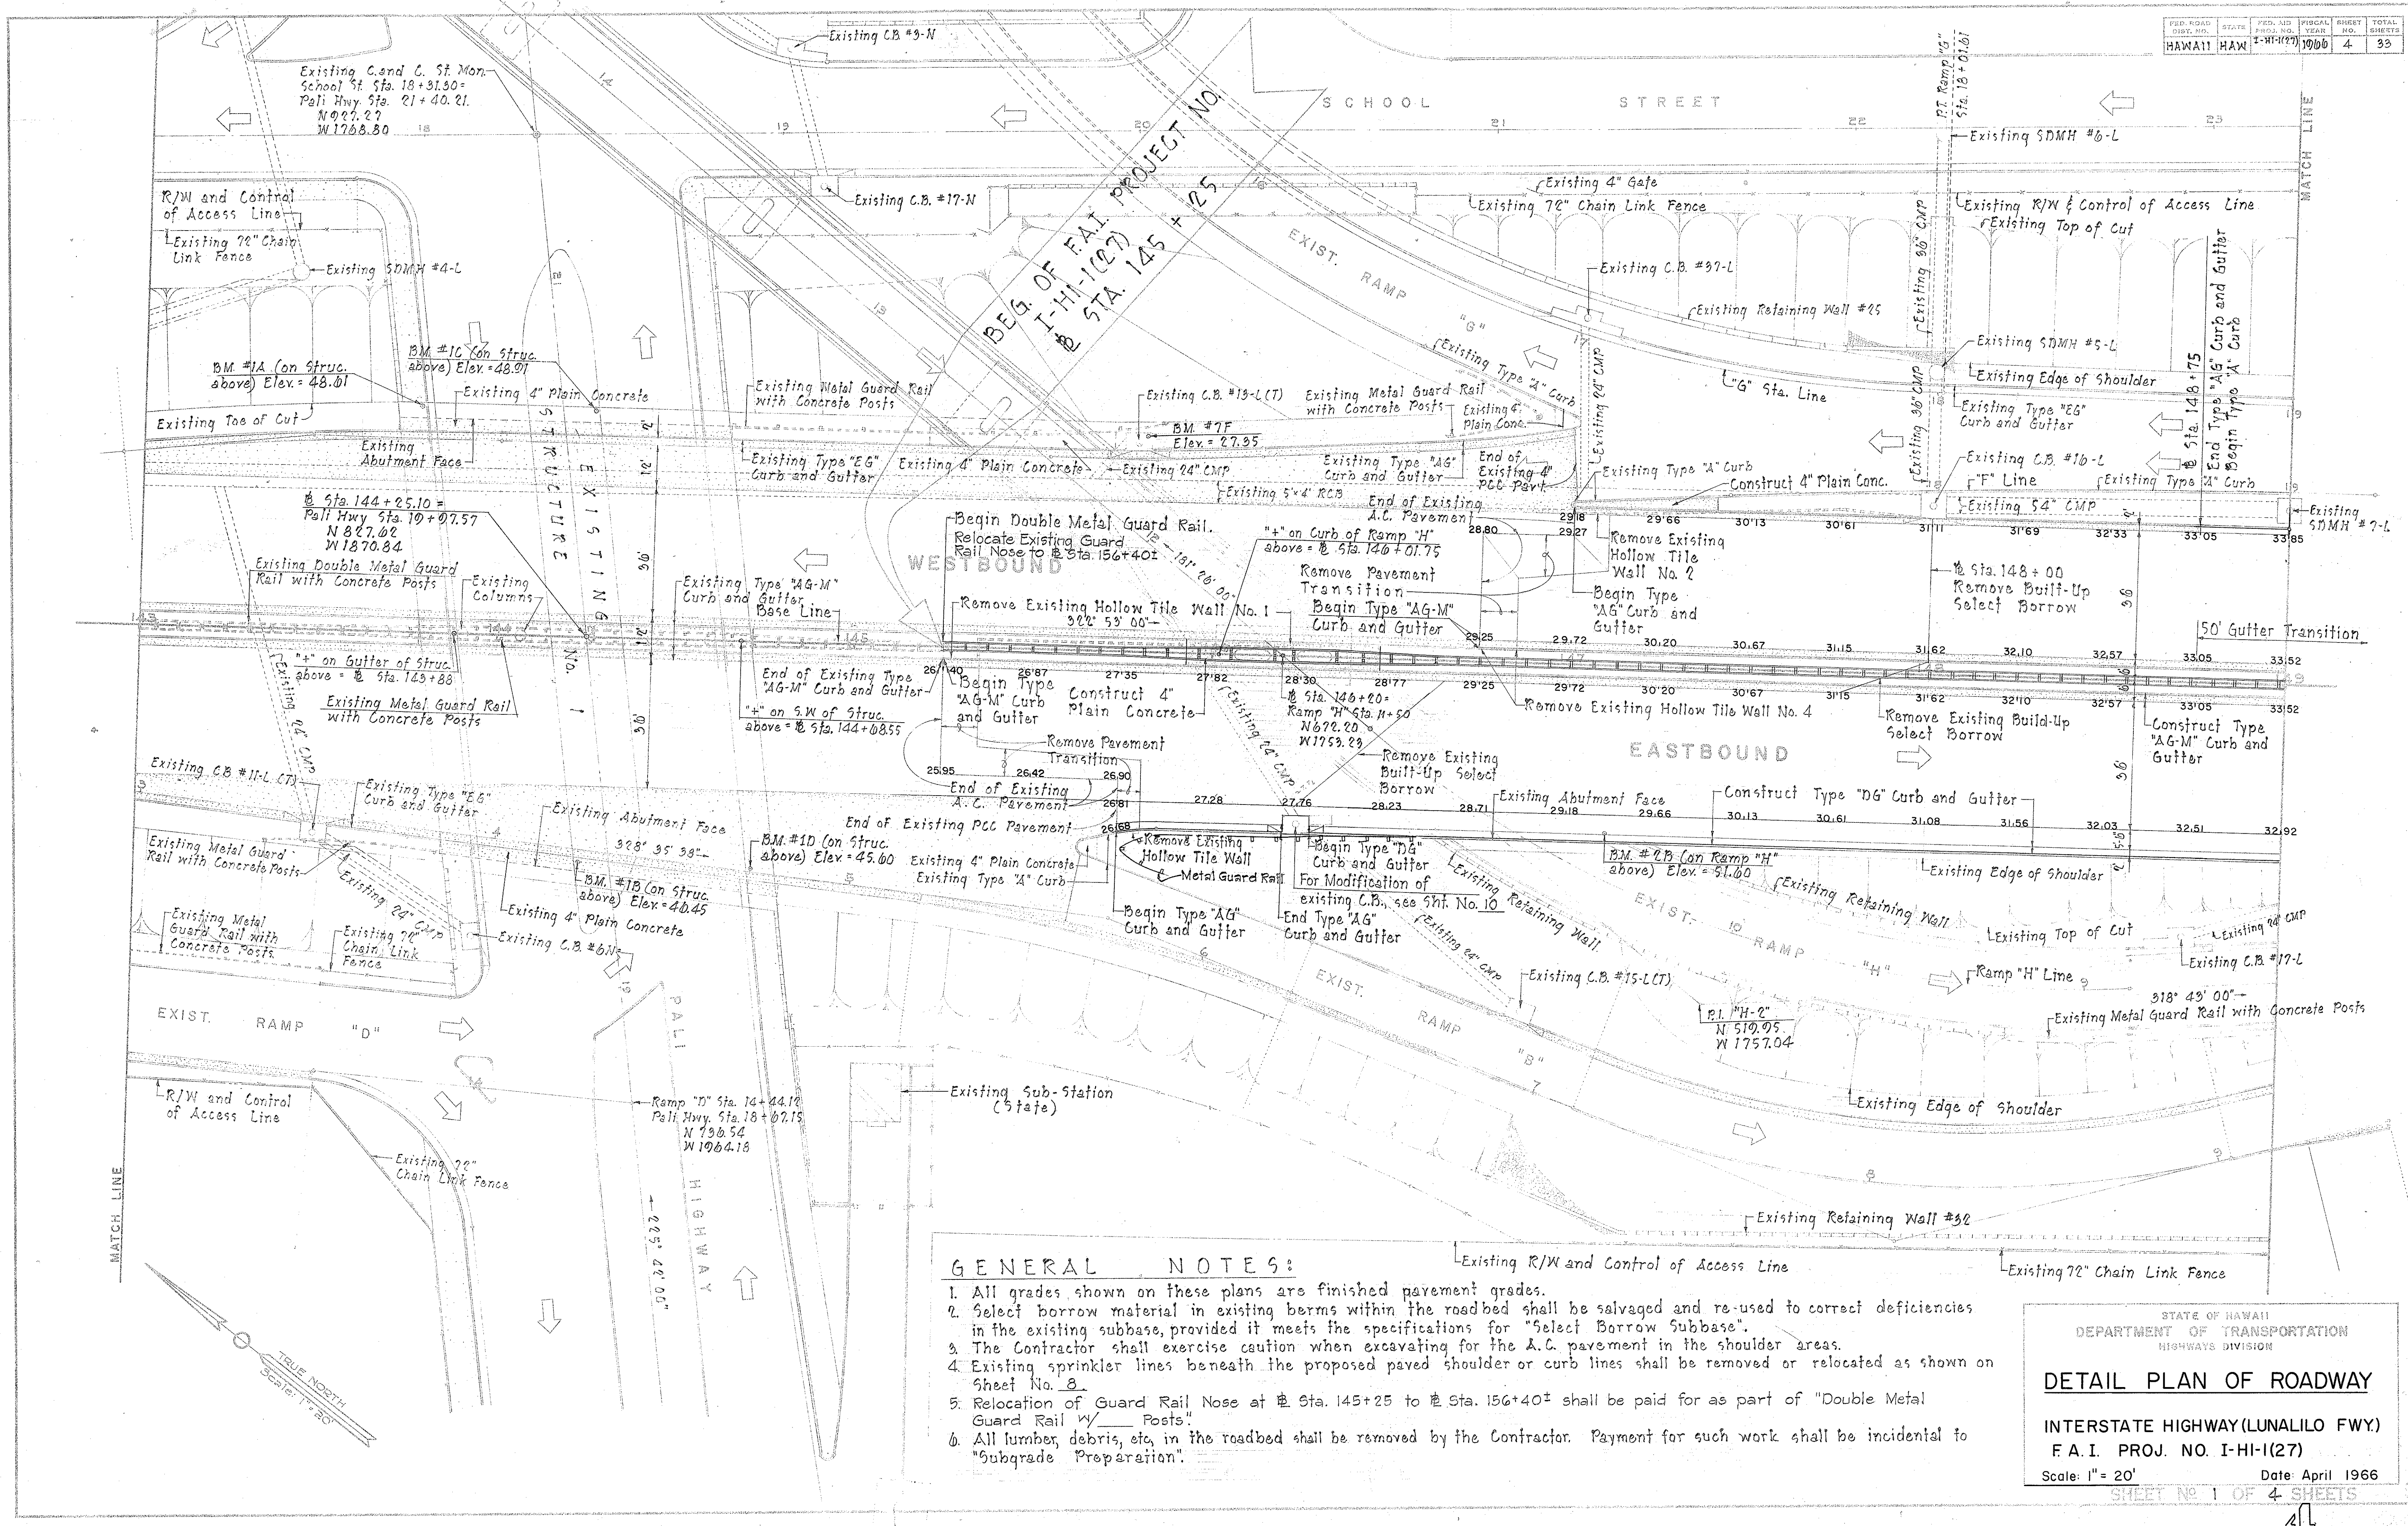

GENERAL NOTES:

1. All grades shown on these plans are finished pavement grades.
2. Select borrow material in existing berms within the roadbed shall be salvaged and re-used to correct deficiencies in the existing subbase, provided it meets the specifications for "Select Borrow Subbase".
3. The Contractor shall exercise caution when excavating for the A.C. pavement in the shoulder areas.
4. Existing sprinkler lines beneath the proposed paved shoulder or curb lines shall be removed or relocated as shown on Sheet No. 8.
5. Relocation of Guard Rail Nose at Sta. 145+25 to Sta. 156+40± shall be paid for as part of "Double Metal Guard Rail w/ Posts".
6. All lumber, debris, etc. in the roadbed shall be removed by the Contractor. Payment for such work shall be incidental to "Subgrade Preparation".

STATE OF HAWAII
DEPARTMENT OF TRANSPORTATION
HIGHWAYS DIVISION

DETAIL PLAN OF ROADWAY

INTERSTATE HIGHWAY (LUNALILO FWY.)
F.A.I. PROJ. NO. I-HI-1(27)

Scale: 1" = 20' Date: April 1966


SHEET NO. 1 OF 4 SHEETS

DESIGNED BY: _____
DRAWN BY: _____
CHECKED BY: _____
DATE: _____

ORIGINAL PLAN NO. _____
NOTE BOOK NO. _____

DS-4-14p

ORIGINAL PLAN	SURVEY PLOTTED BY.....	DATE.....
NOTE BOOK	DESIGNED BY.....	44
	DRAWN BY <i>6</i>	44
	TRACED BY.....	44
	QUANTITIES BY.....	44
No.....	CHECKED BY.....	44

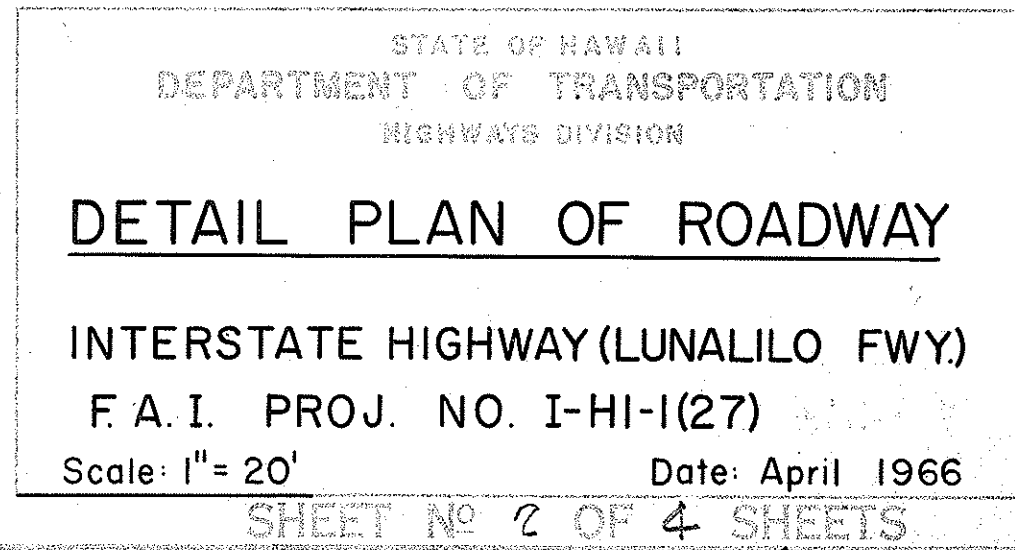

CURVE DATA :		BASELINE AND DETOUR RAMP "D-1" AND "D-2"				
	L - 3	L - 5	G - 4	D - 1	D - 2	D - 2A
Δ	20' 15" 30"	4' 41' 30"	8' 21' 30"	38' 21' 30"	13' 24' 30"	17' 01' 30"
R	9000.00	2940.00	900.00	230.00	500.00	500.00
T	535.90	120.00	45.70	80.00	58.77	74.84
L	1080.72	241.00	131.29	153.98	117.01	148.57

