

1. Azimuths referred to Round Top "Trig" Station
2. Coordinates referred to Kaimuki "Trig" Station
3. Bench Mark elevations referred to Mean Sea Level Datum
4. All work shown as "existing" on roadway and detail plans indicate work which are actually in existence, or which have been or are to be completed under a previously let contract for F.A.I. Project No. I-HI-1(6) Unit 1.

BEG. OF F.A.I. PROJECT
NO. I-HI-1(6) UNIT 2
B STA. 105 + 75.00

BEG. OF GRADING PROJECT
F.A.I. PROJ. NO. I-HI-I (6) UNIT I
B STA. 109 + 00.00
END OF PROJ. NO. I-HI-I(4)

$\Delta = 45^\circ 40' 30''$
$R = 2200.00$
$T = 226.49$
$L = 1753.79$

B.M. #K-25 E.I. 180.55
C & C Mon. 14th Ave and
Harding Ave.

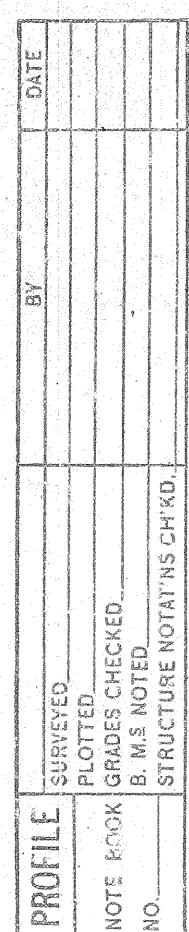
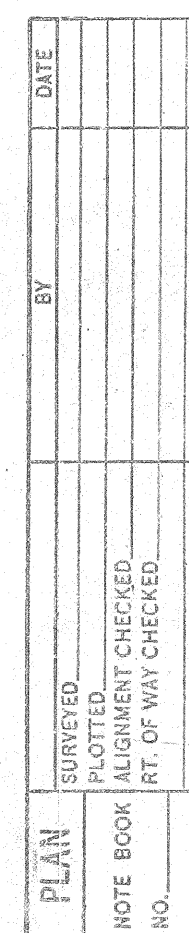


PLATE 1-PLAN-PROFILE "O. F. R. & R. E. STANDARD"
KIMMEL & ESSER CO. NEW YORK.

K & E Co. No. 346-10
TRADE MARK
TRADE MARK
TRADE MARK

DD-H-2

15

71

DATE	BY	REVISION
		1. PLAN
		2. PROFILE
		3. ELEVATION
		4. CROSS SECTION
		5. DETAIL
		6. EROSION CONTROL
		7. TRAFFIC CONTROL
		8. LANDSCAPE ARCHITECTURE
		9. UTILITIES
		10. ENVIRONMENTAL
		11. HISTORIC PRESERVATION
		12. OTHER

DATE	BY	REVISION
		1. PROFILE
		2. ELEVATION
		3. CROSS SECTION
		4. DETAIL
		5. EROSION CONTROL
		6. TRAFFIC CONTROL
		7. LANDSCAPE ARCHITECTURE
		8. UTILITIES
		9. ENVIRONMENTAL
		10. HISTORIC PRESERVATION
		11. OTHER

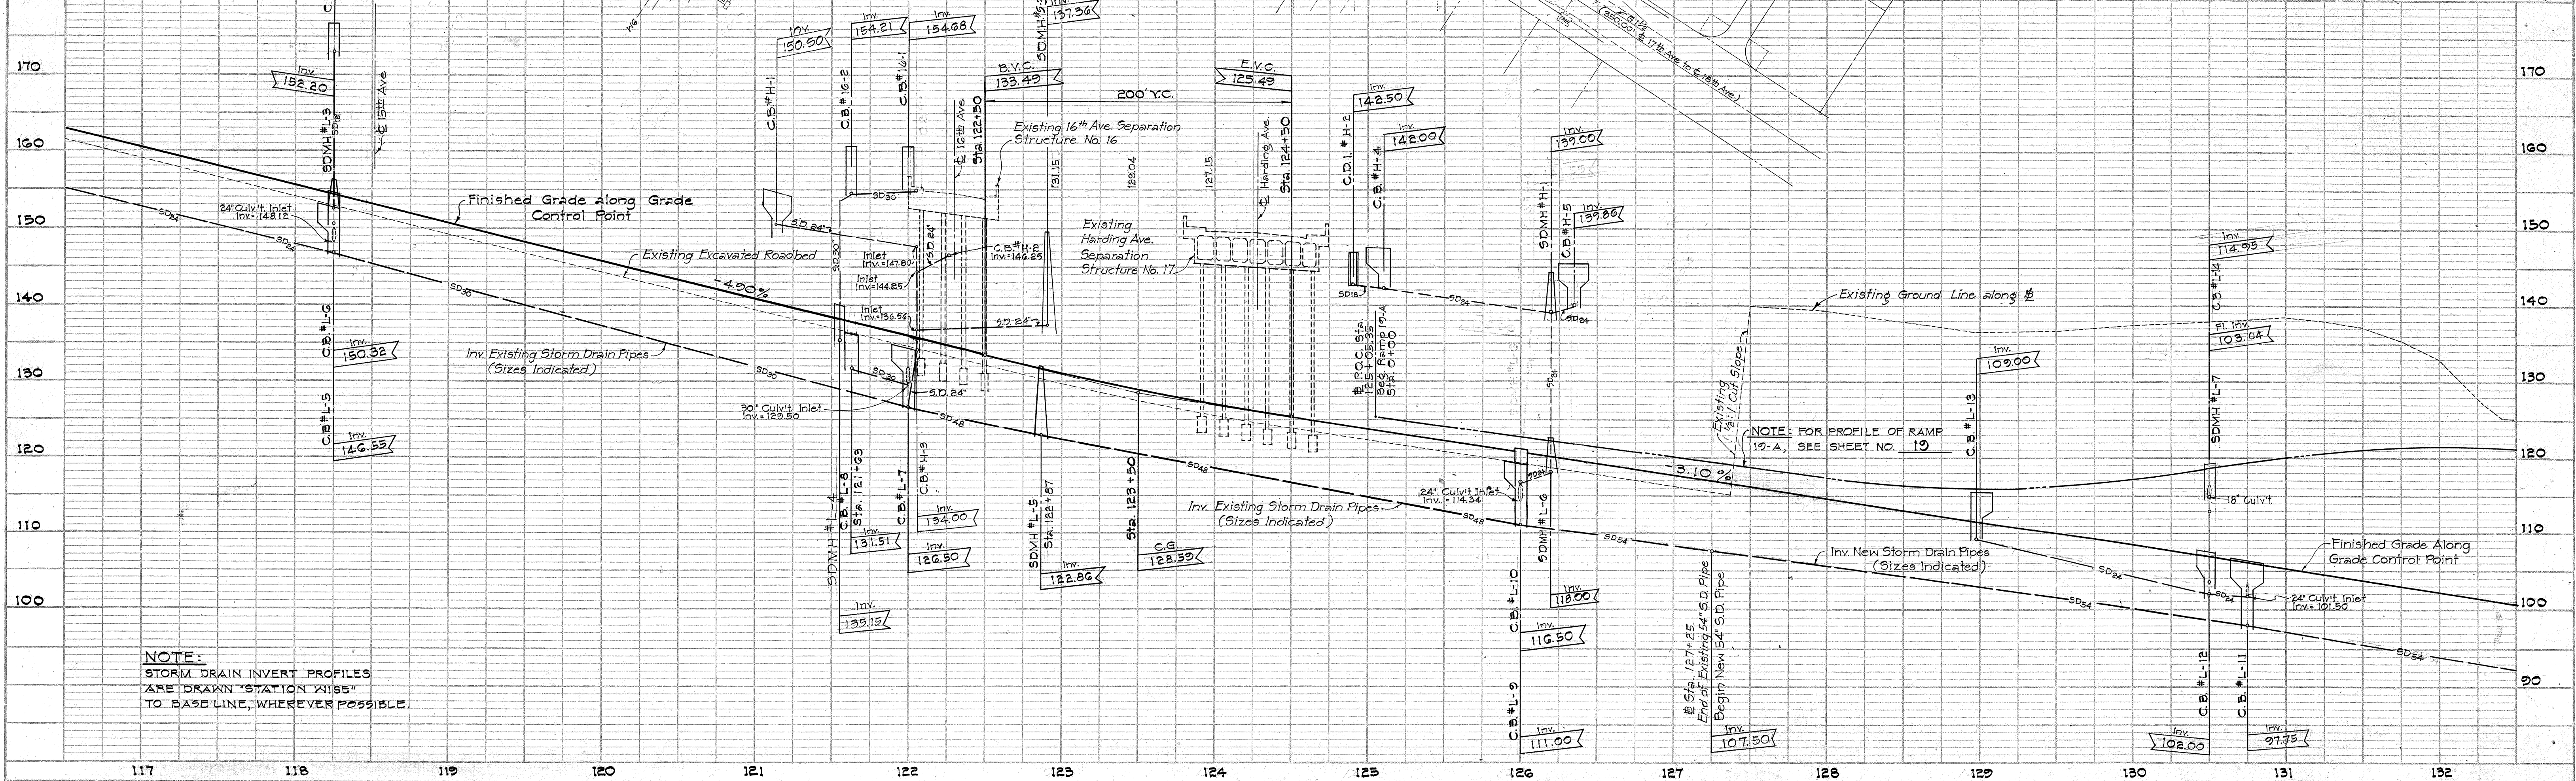
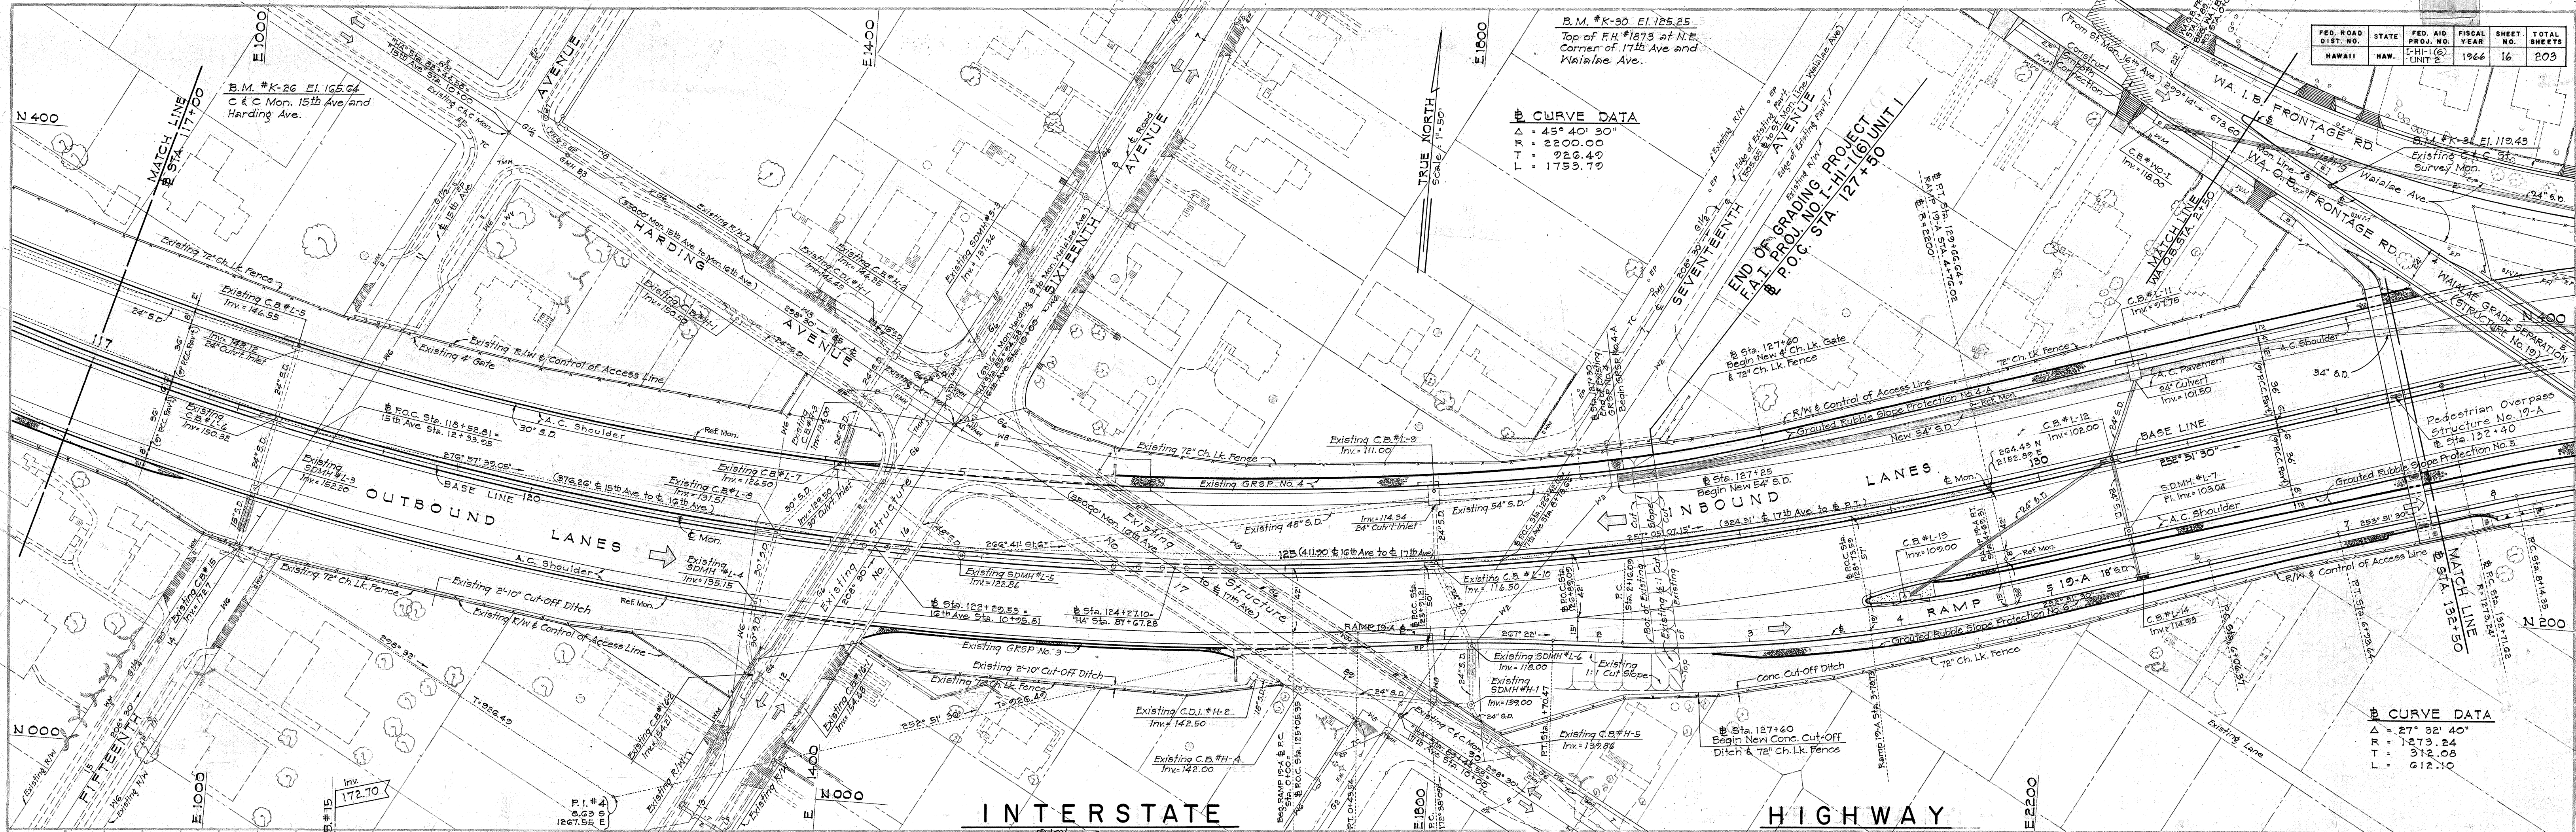


PLATE 1-PLIN-PROFILE 0. P. 2. 3. 4. 100.

REPRODUCED BY THE U.S. GOVERNMENT PRINTING OFFICE




U.S. GOVERNMENT PRINTING OFFICE: 1964 O - 345-100

16

DD-4-2

FED. ROAD DIST. NO.	STATE	FED. AID PROJ. NO.	FISCAL YEAR	SHEET NO.	TOTAL SHEET
HAWAII	HAW	I-HI-1(6) UNIT 2	1966	17	20

OCEANVIEW CEMETER

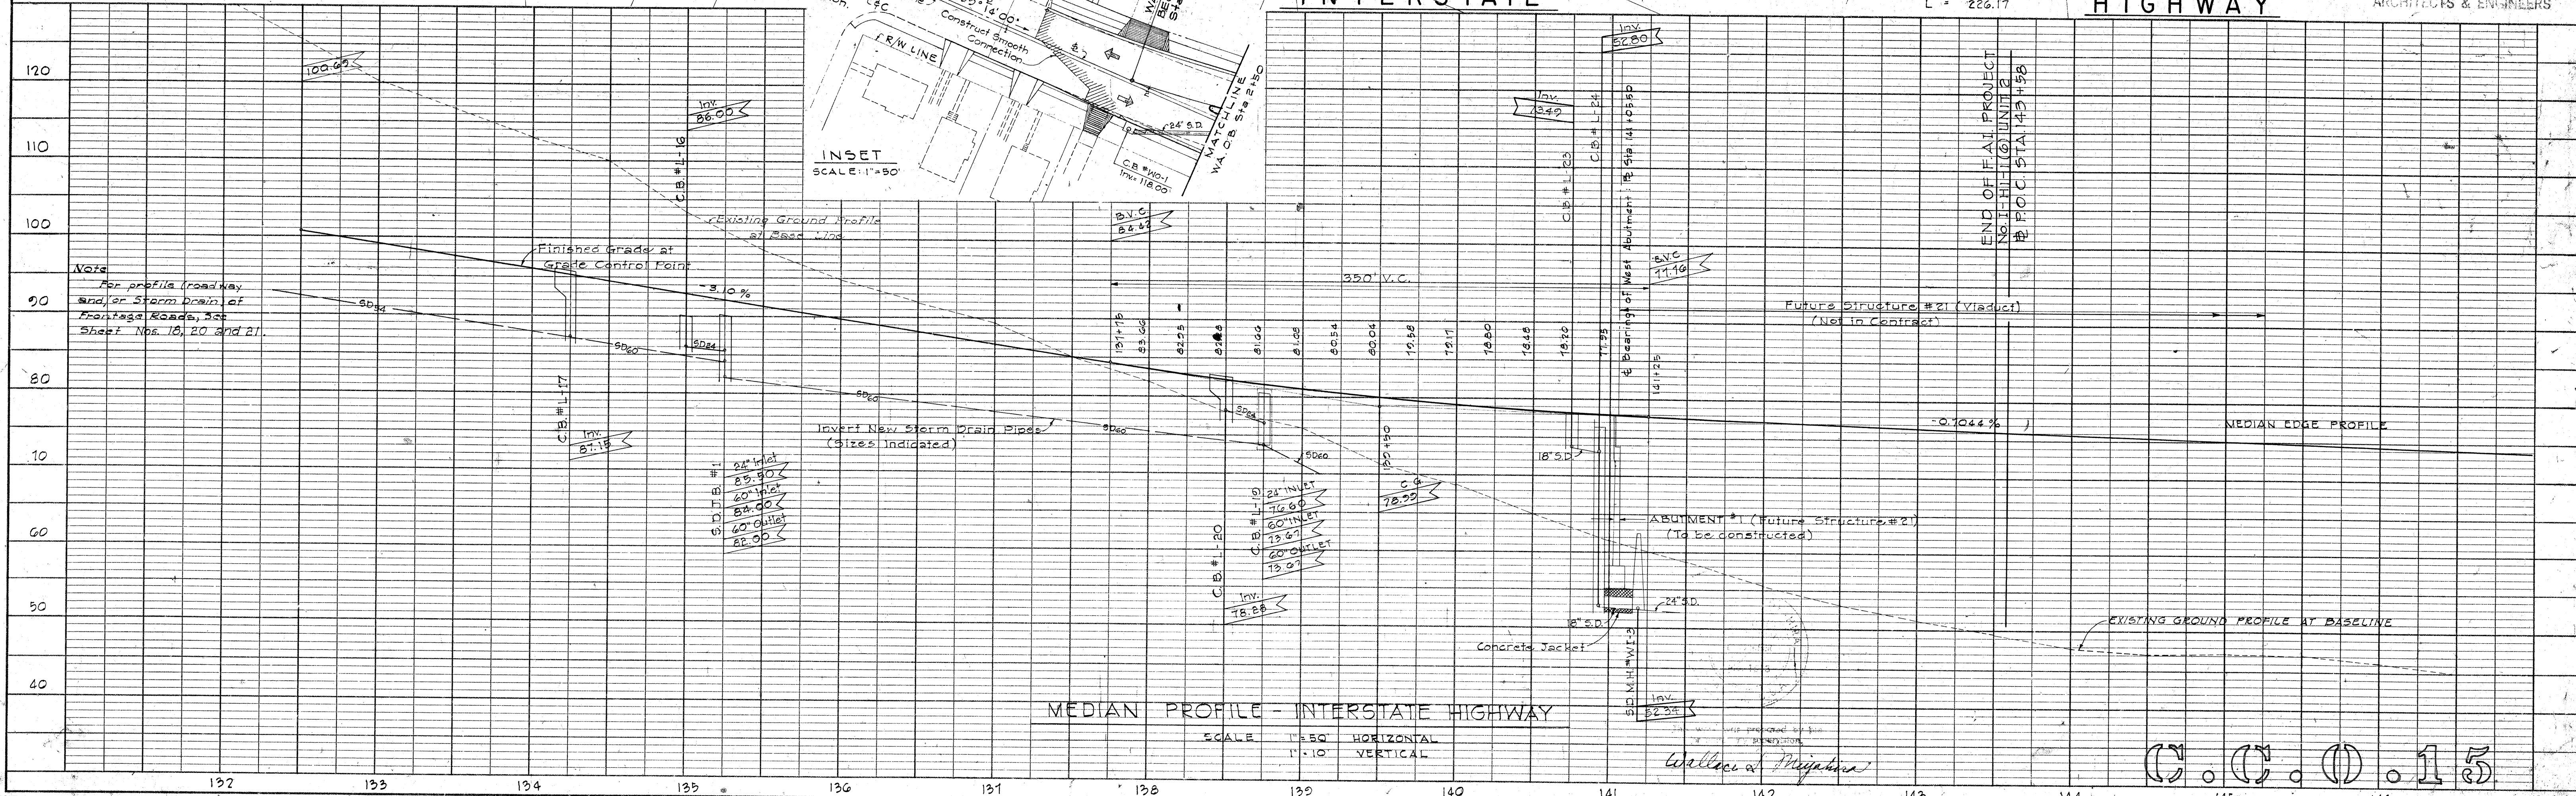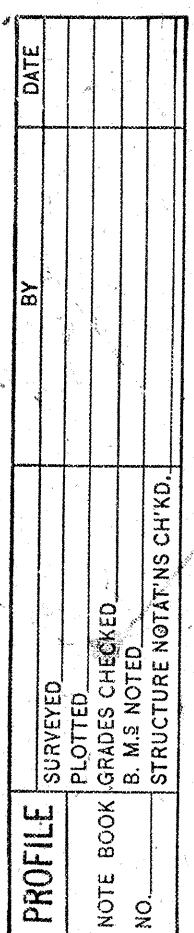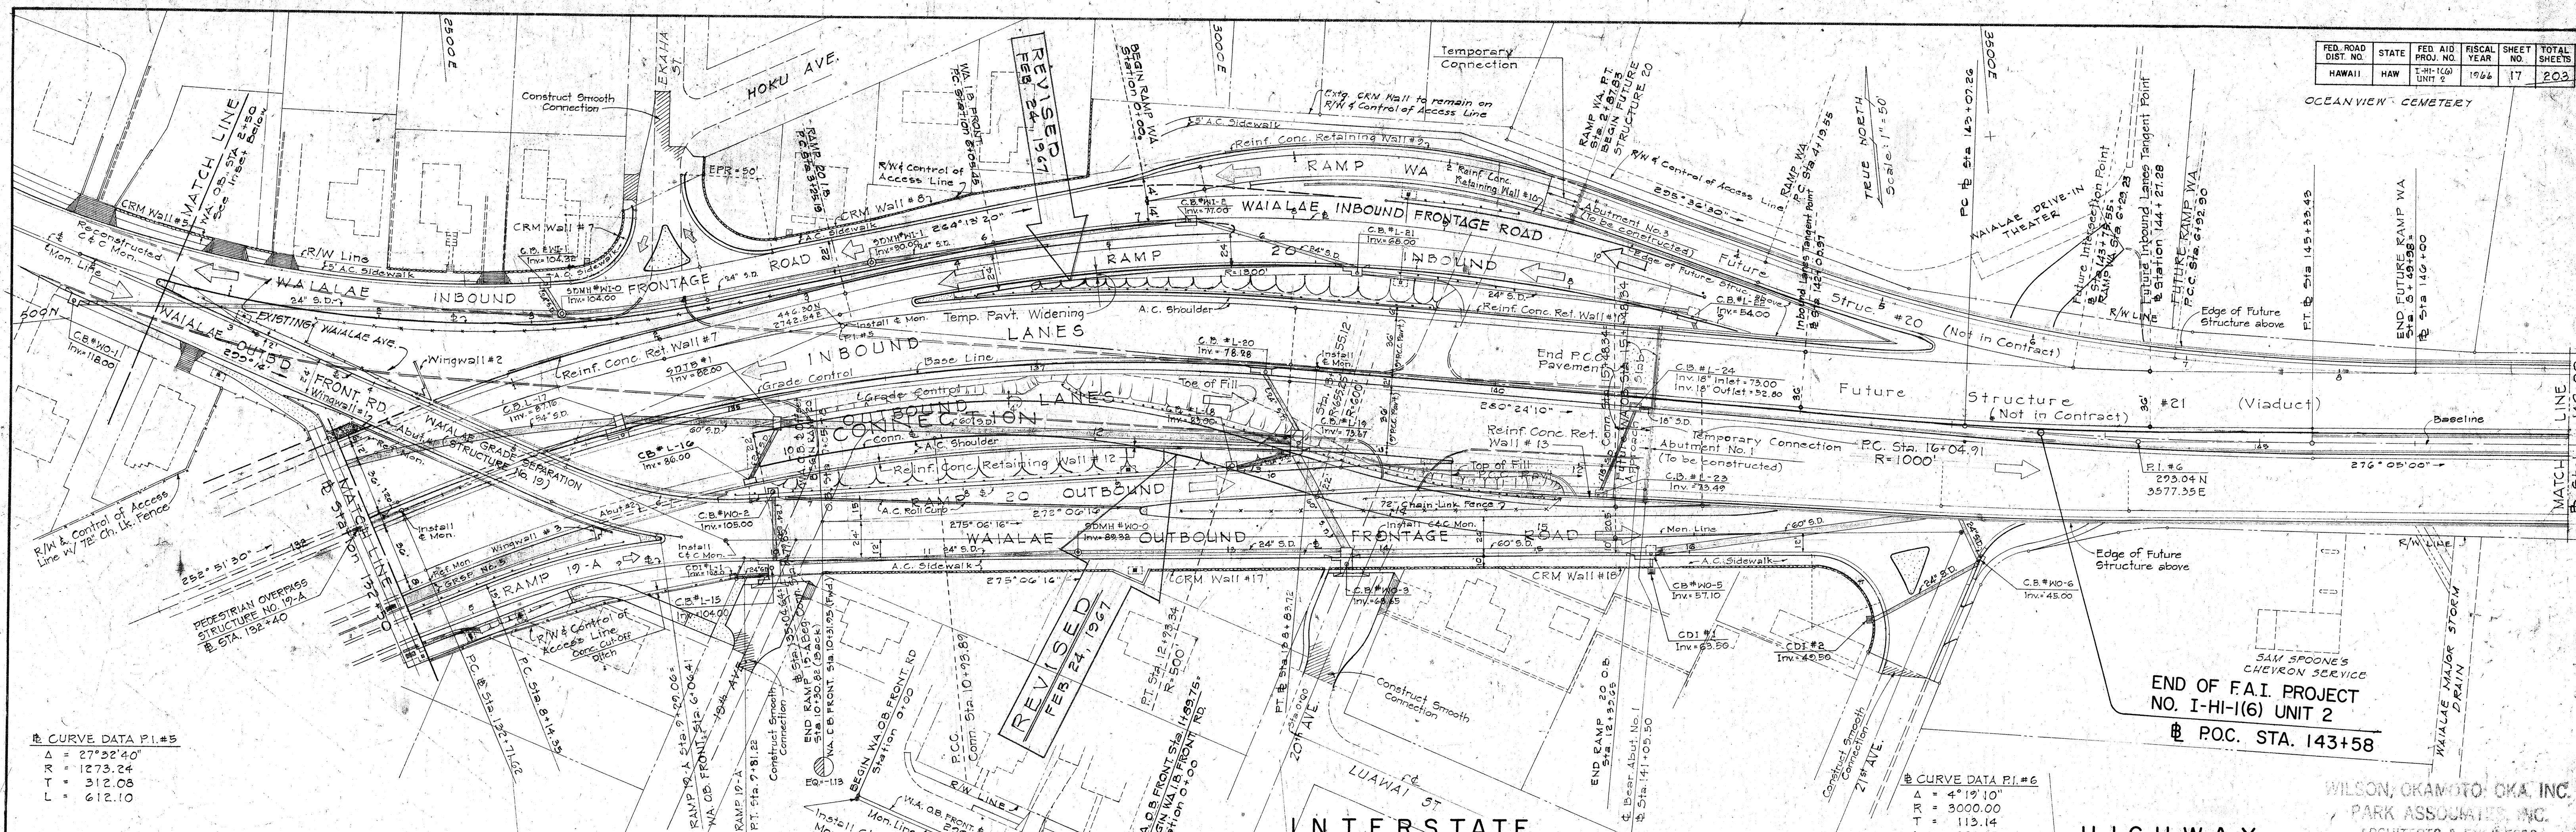

FED. ROAD DIST. NO.	STATE	FED. AID PROJ. NO.	FISCAL YEAR	SHEET NO.	TOTAL SHEETS
HAWAII	HAW.	1-1-160	1966	18	209

END OF F.A.I. PROJECT
NO. I-HI-16) UNIT 2

P.O.C. STA. 143+58

OCEAN VIEW CEMETERY



WAIALAE INBOUND ROAD

BARRY'S UNION SERVICE

WILSON, OKAMOTO, OKA, INC.
PARK ASSOCIATES, INC.
ARCHITECTS & ENGINEERS

PLAN	SURVEYED	DATE
NO.	NO.	NO.

PROFILE	SURVEYED	DATE
NO.	NO.	NO.

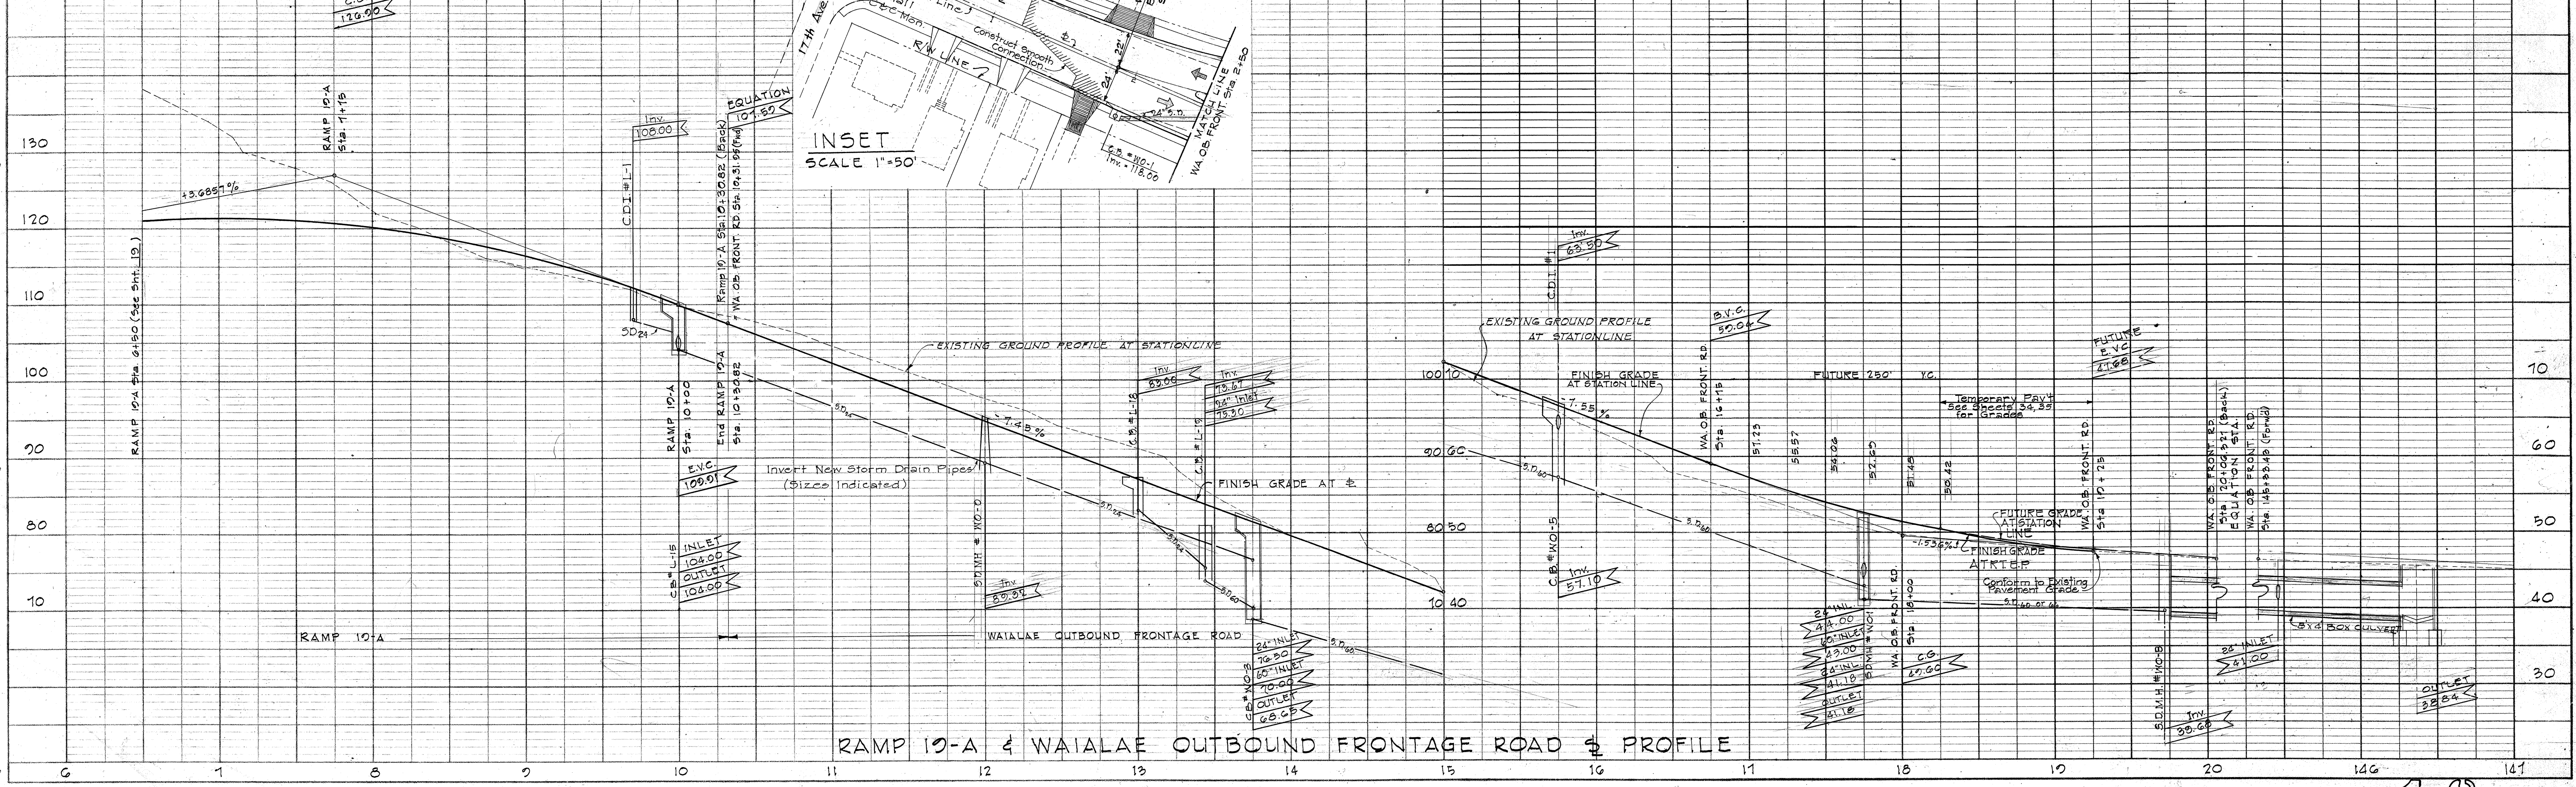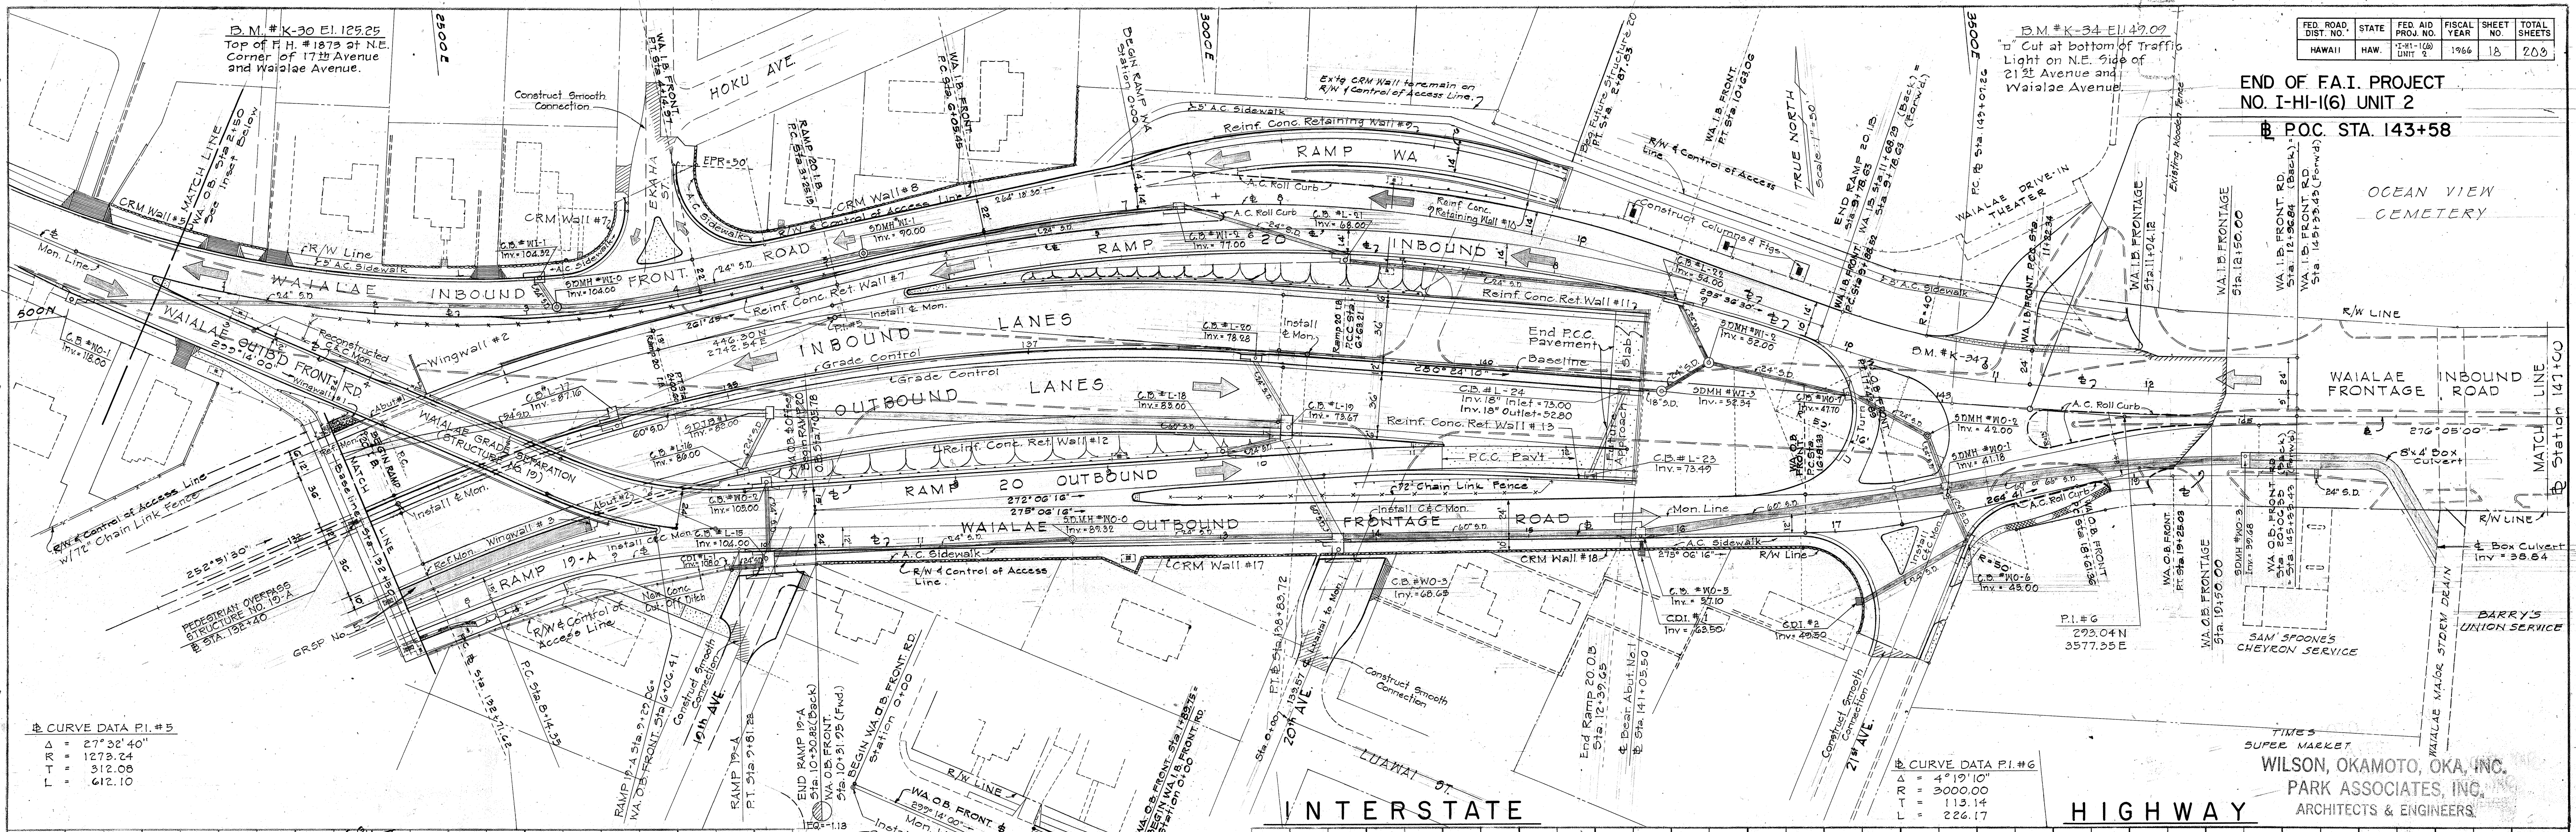

RAMP 10-A & WAIALAE OUTBOUND FRONTAGE ROAD & PROFILE

PLATE 1-PLAN-PROFILE O.P.R. & R.E. STANDARD
KEUFFEL & ESSER CO., NEW YORK
K & E CO. NO. 346-10A

18

SUPERSEDED (See Revised Sht. Dtd. Feb. 24, 1967)

DATE: _____ BY: _____
 SURVEYED: _____
 NOTED: _____
 CHECKED: _____
 NO. _____

DATE: _____ BY: _____
 SURVEYED: _____
 NOTED: _____
 CHECKED: _____
 NO. _____

FED. ROAD DIST. NO.	STATE	FED. AID PROJ. NO.	FISCAL YEAR	SHEET NO.	TOTAL SHEETS
HAWAII	HAW.	1-11-100	1966	18	209

END OF F.A.I. PROJECT
 NO. I-HI-1(6) UNIT 2
 P.O.C. STA. 143+58

