



FED. ROAD DIST. NO.	STATE	FED. AID PROJ. NO.	FISCAL YEAR	SHEET NO.	TOTAL SHEETS
HAWAII	HAW.	I-HI-1(18) Unit 3	1966	C.O. 135	35

Revised: Jan. 16, 1967

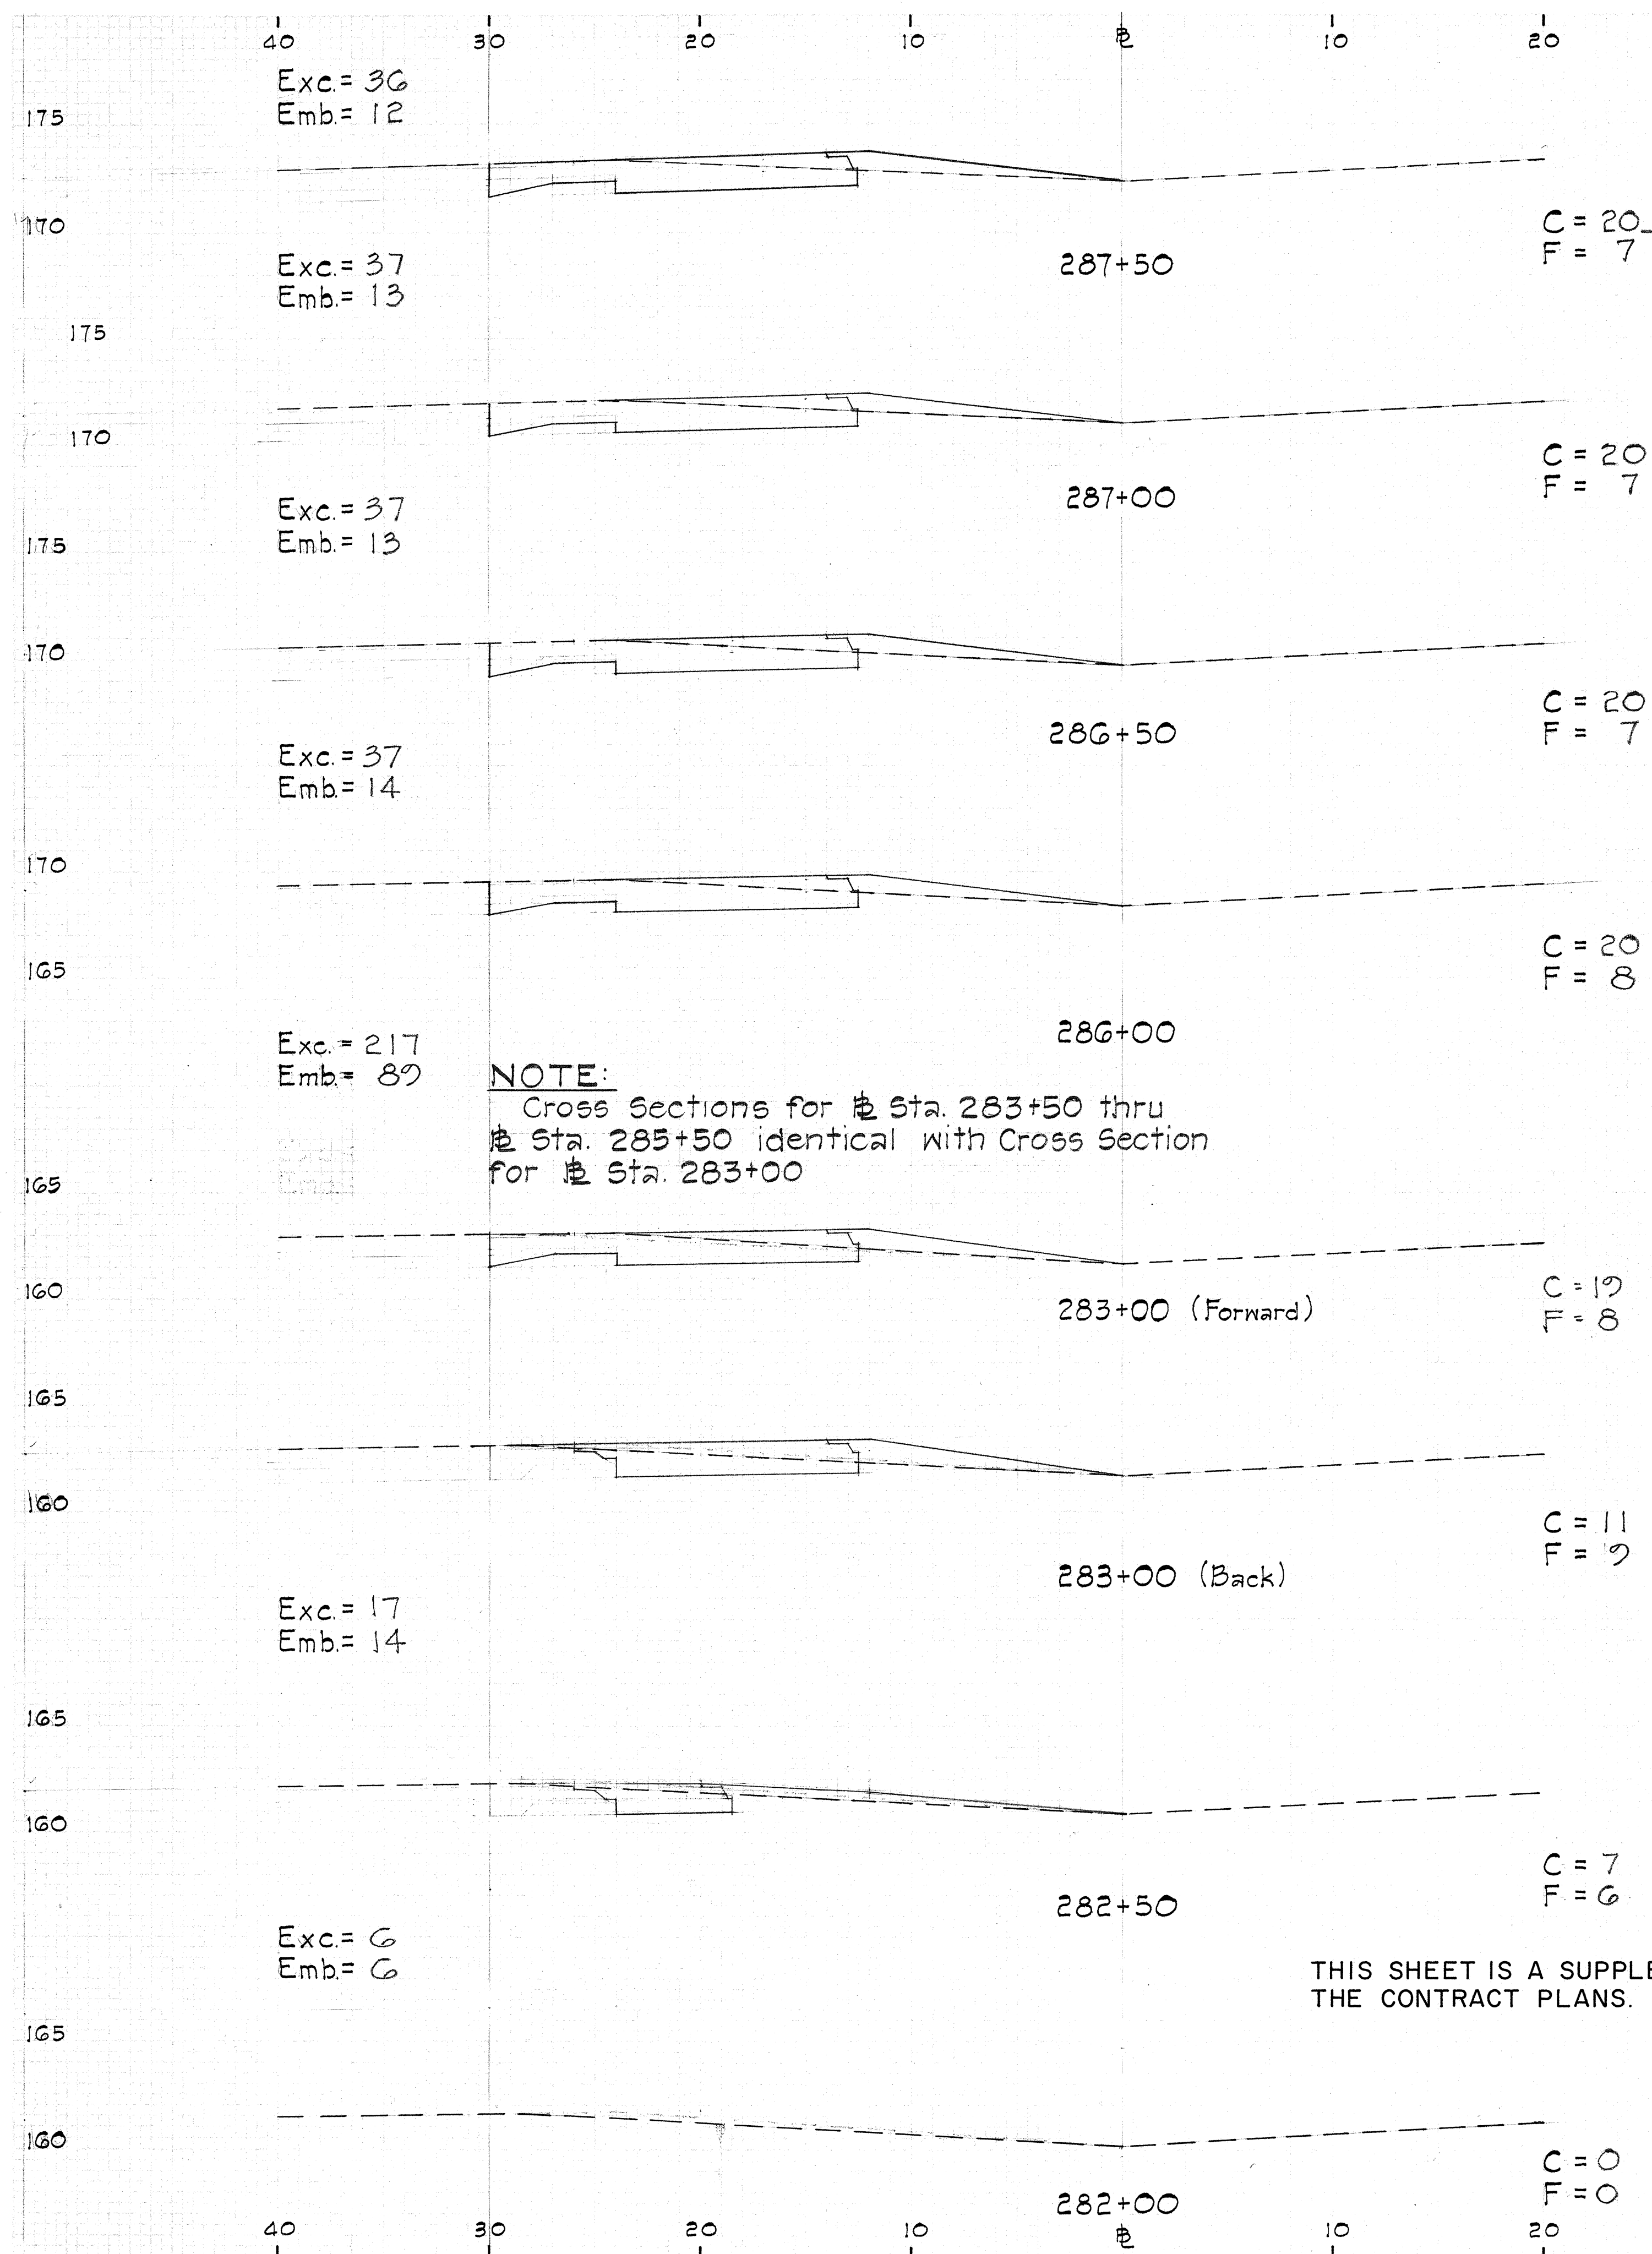


THIS SHEET IS A SUPPLEMENT TO
THE CONTRACT PLANS.

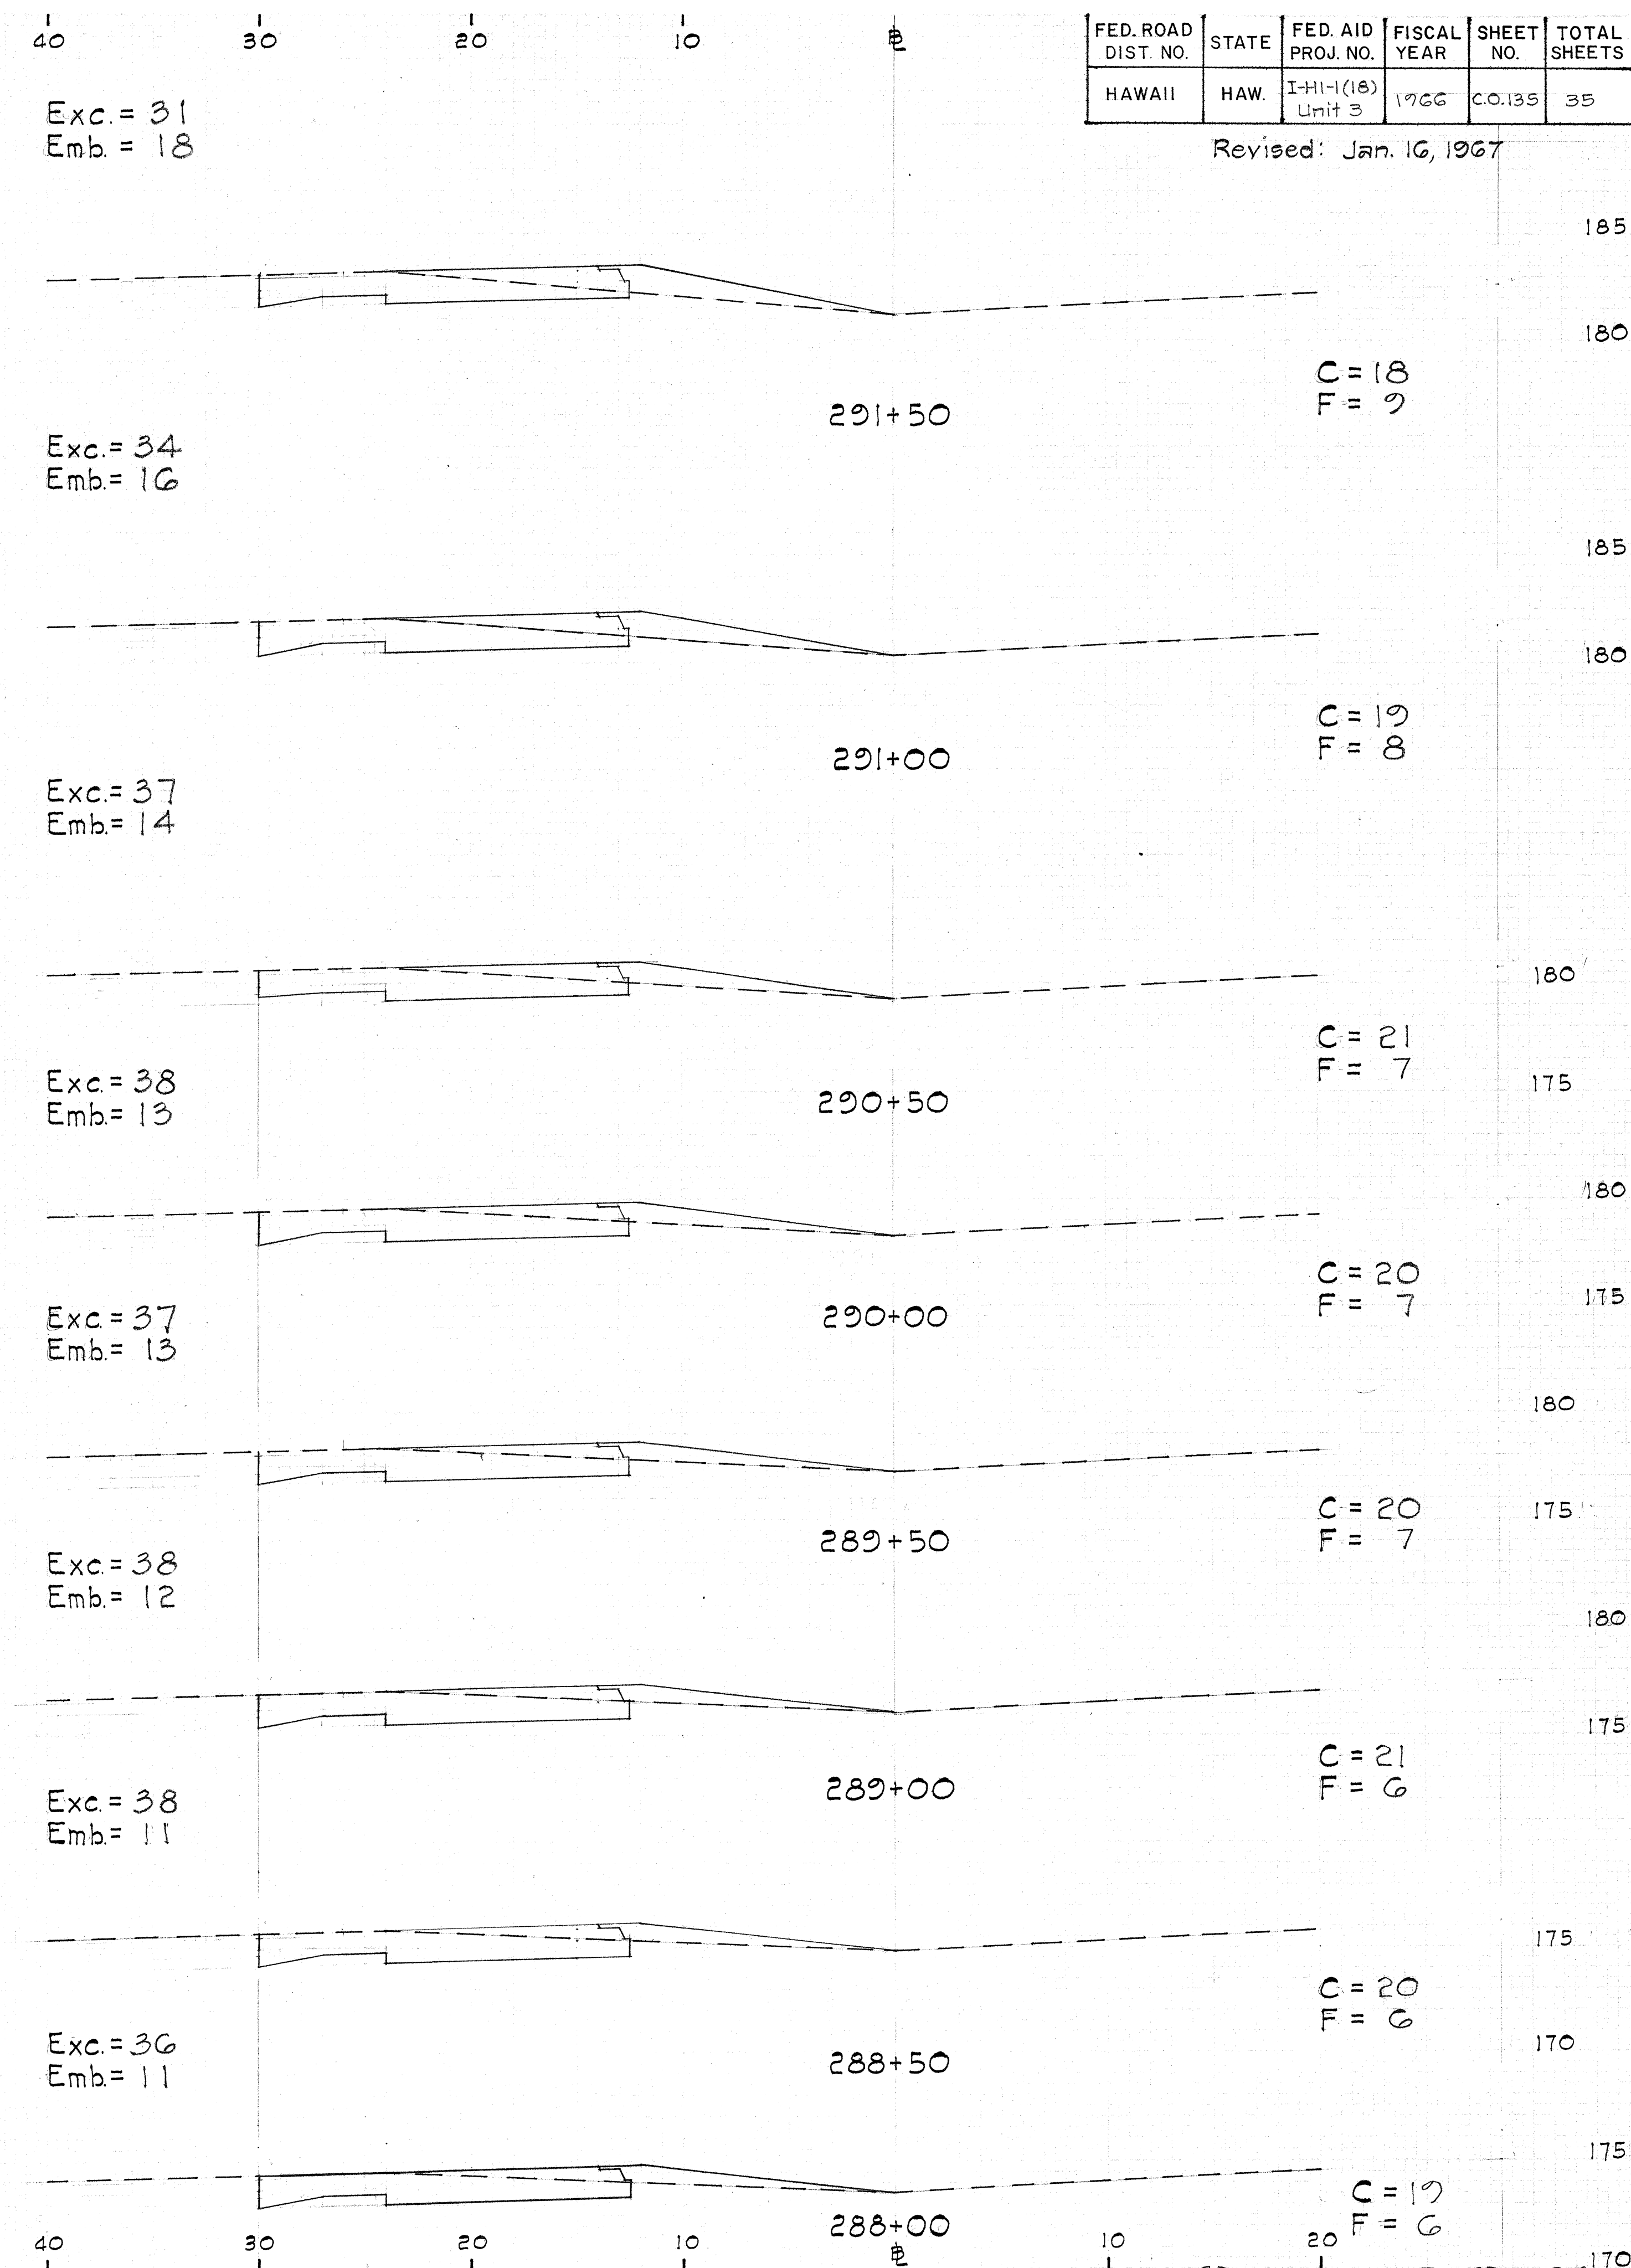



FED. ROAD DIST. NO.	STATE	FED. AID PROJ. NO.	FISCAL YEAR	SHEET NO.	TOTAL SHEETS
HAWAII	HAW.	I-HI-1(18) Unit 3	1966	C.O. 14	35

Revised: Jan. 16, 1967

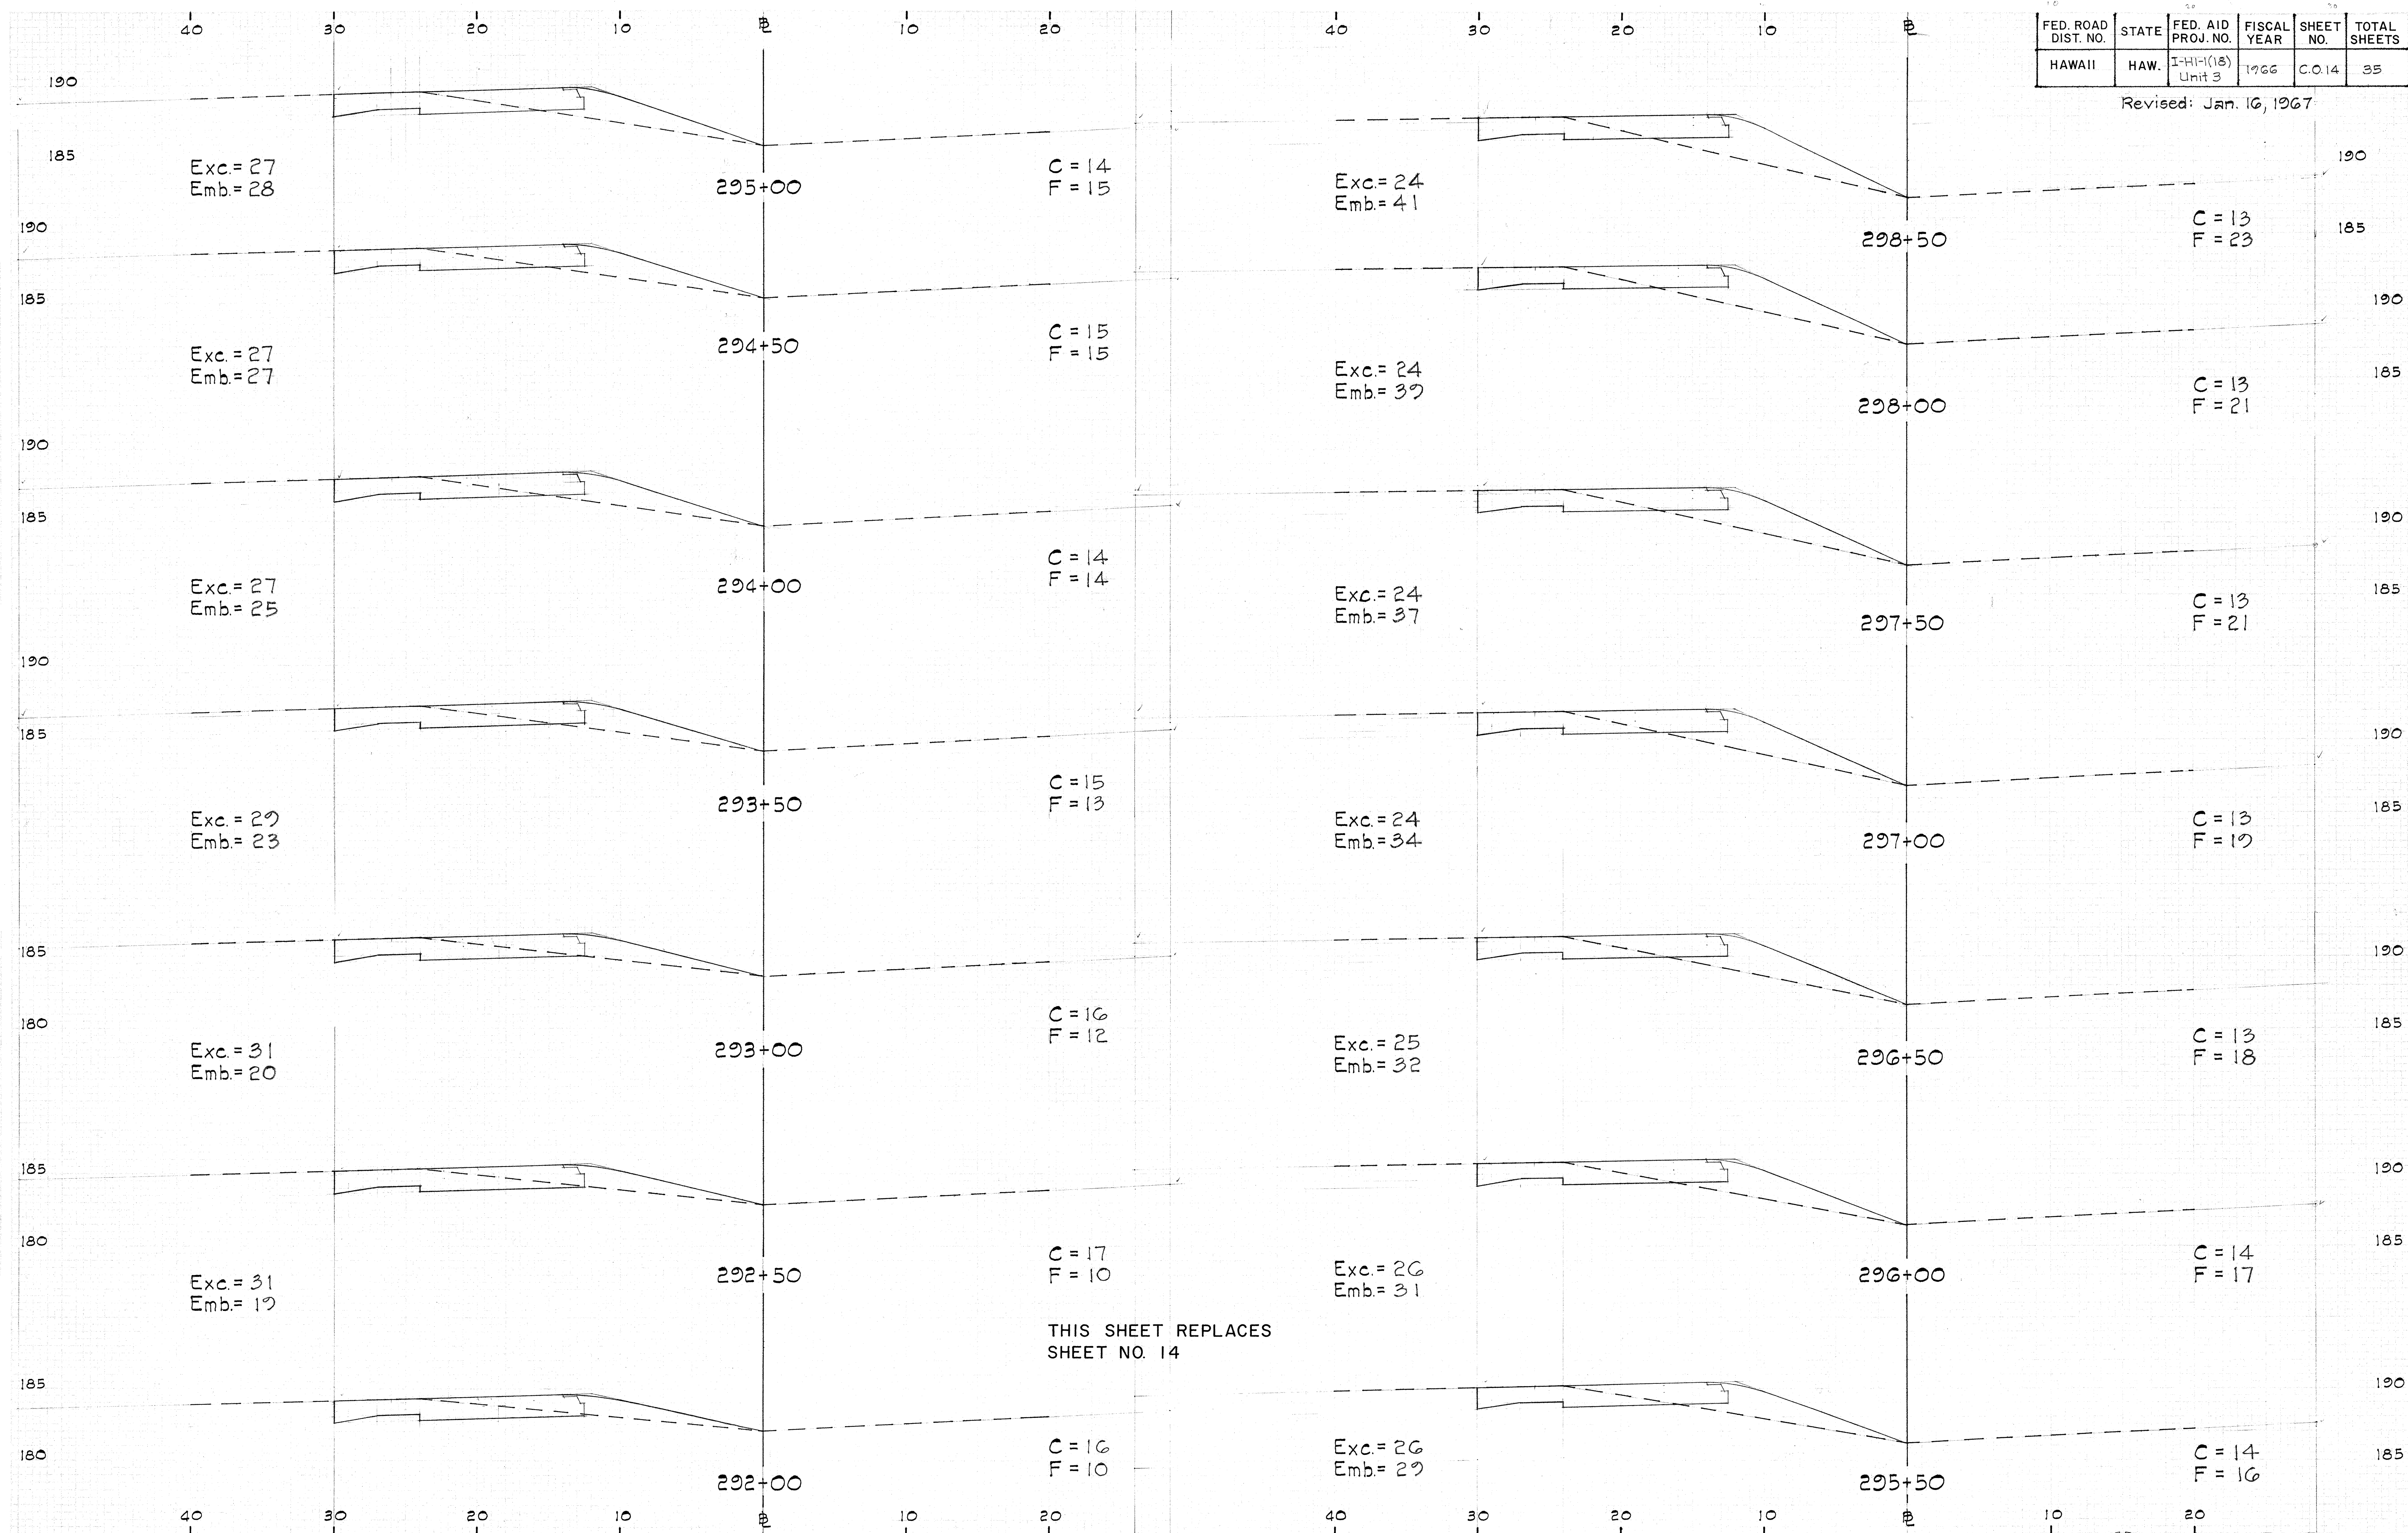



FED. ROAD DIST. NO.	STATE	FED. AID PROJ. NO.	FISCAL YEAR	SHEET NO.	TOTAL SHEETS
HAWAII	HAW	IHI-1(18), Unit 3	1966	C.O. 15	35

Revised: Jan. 10, 1967

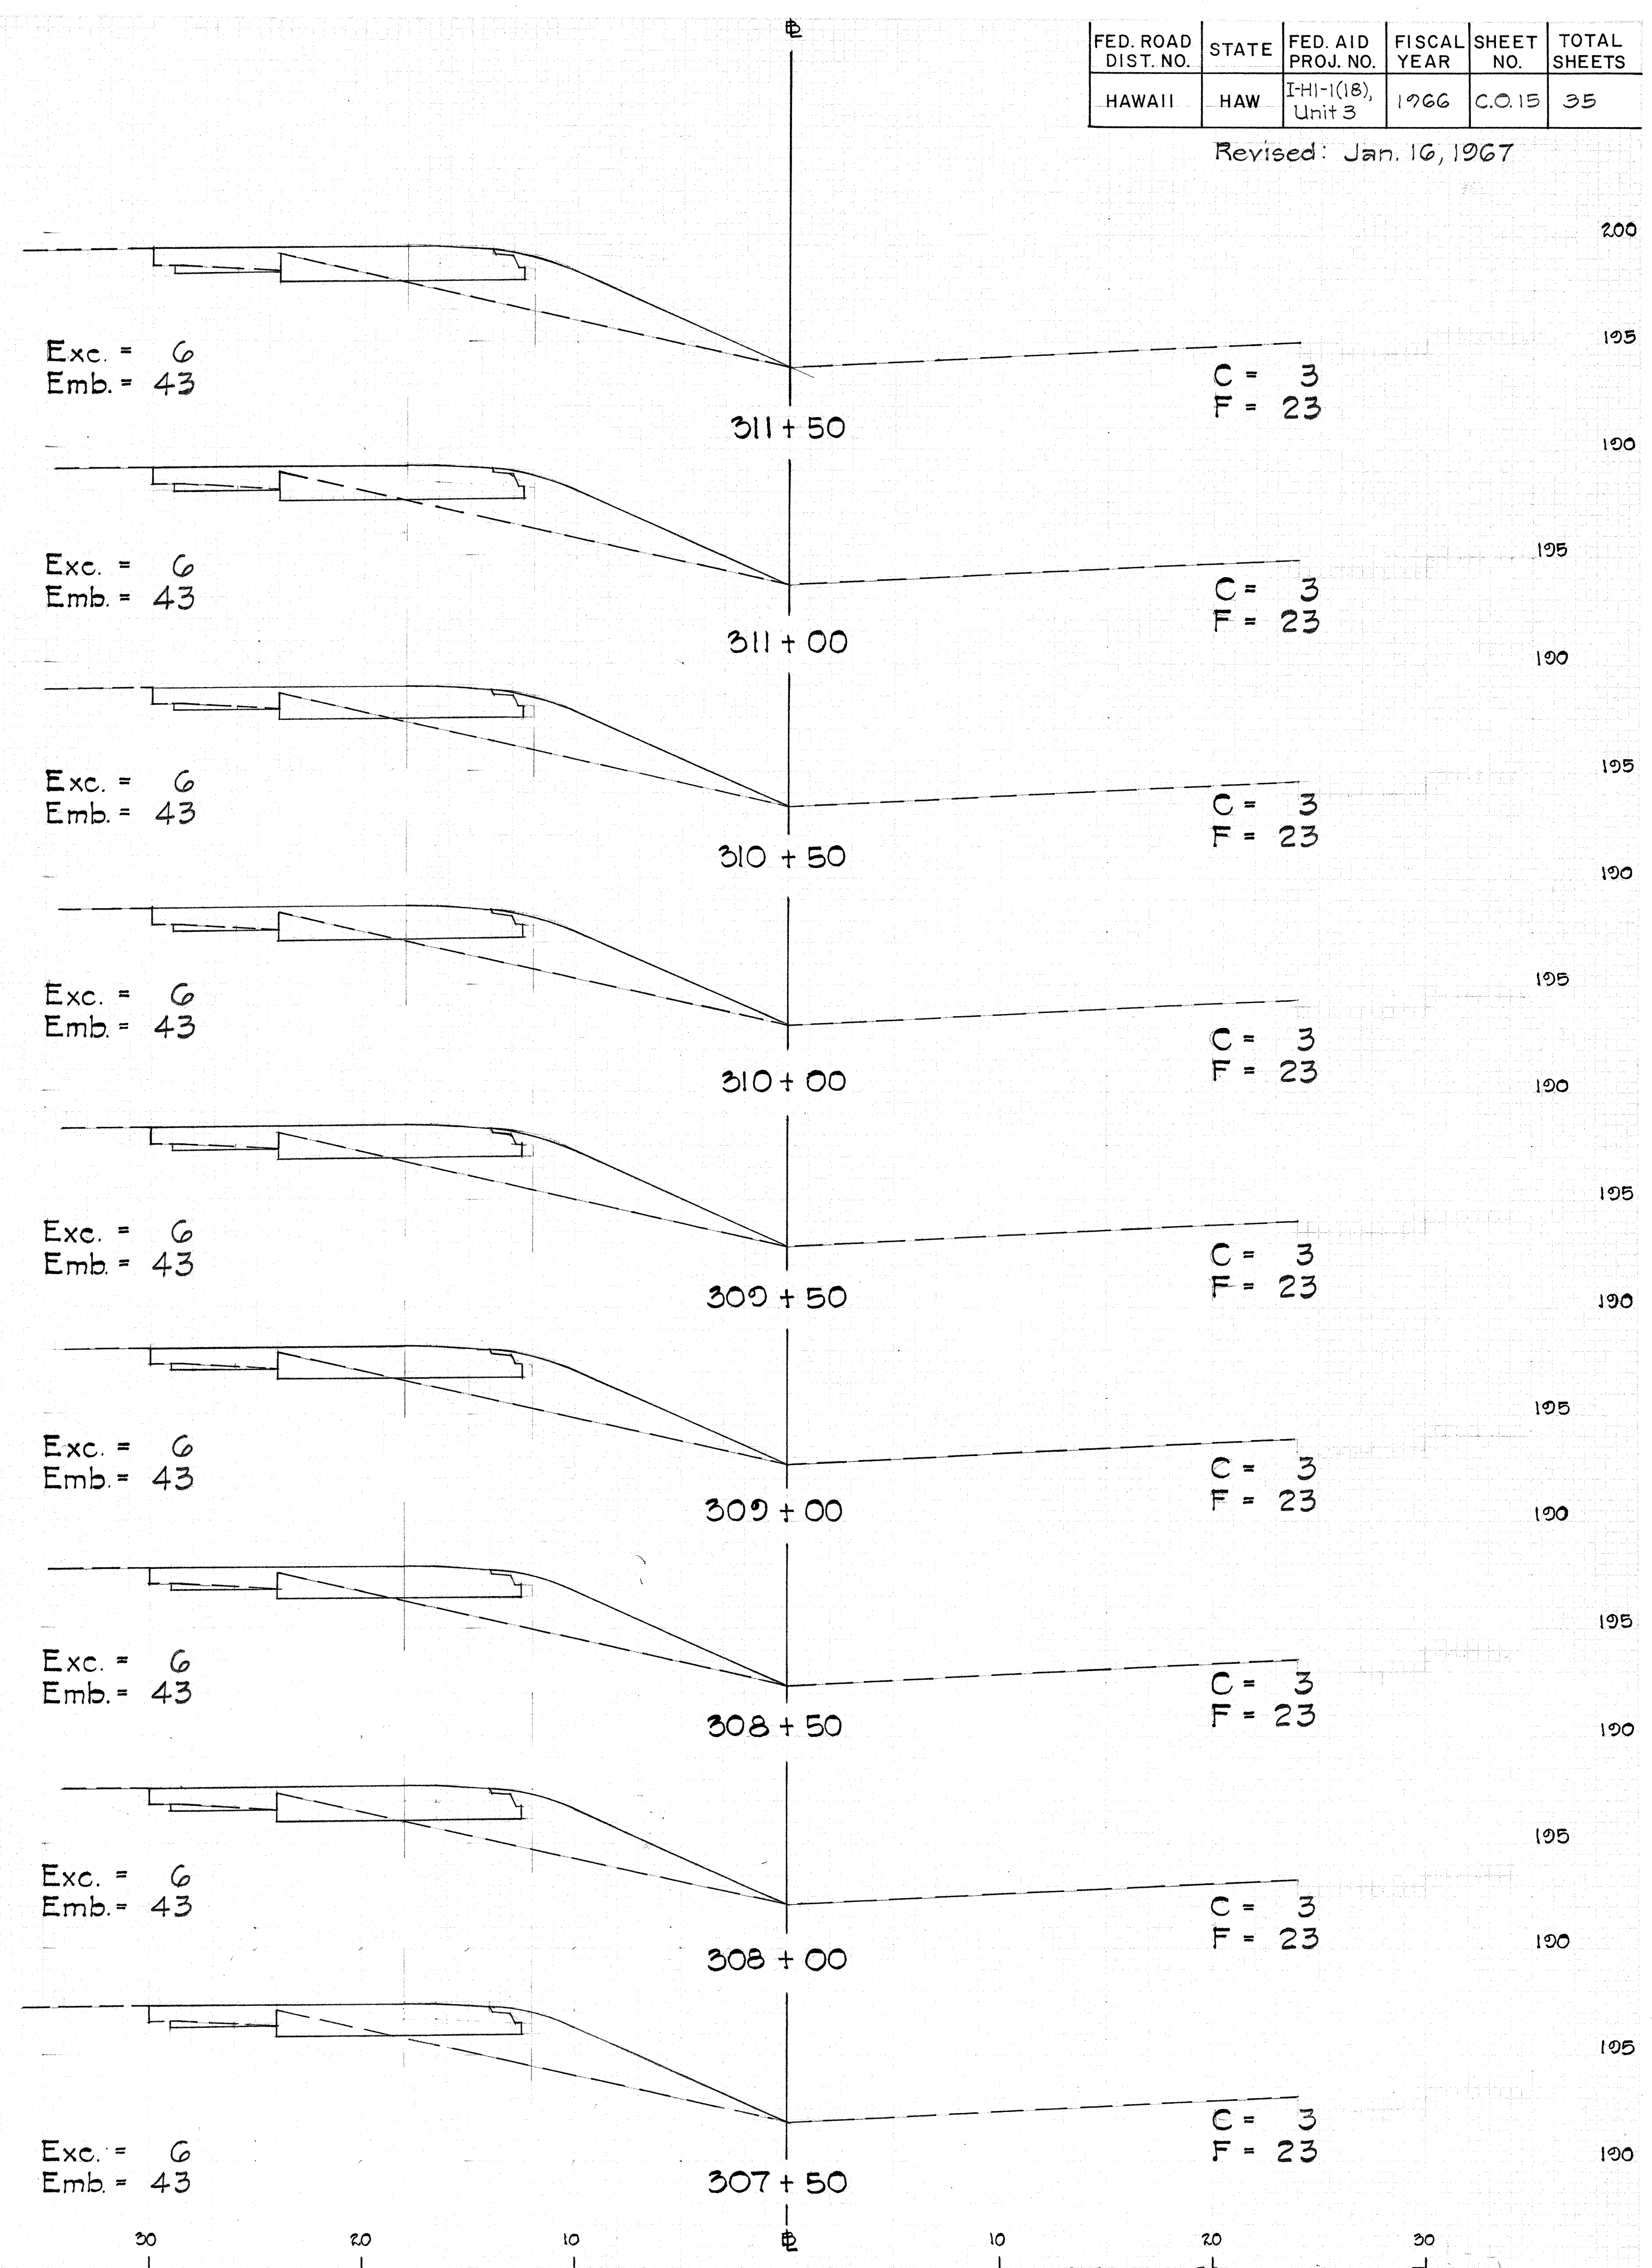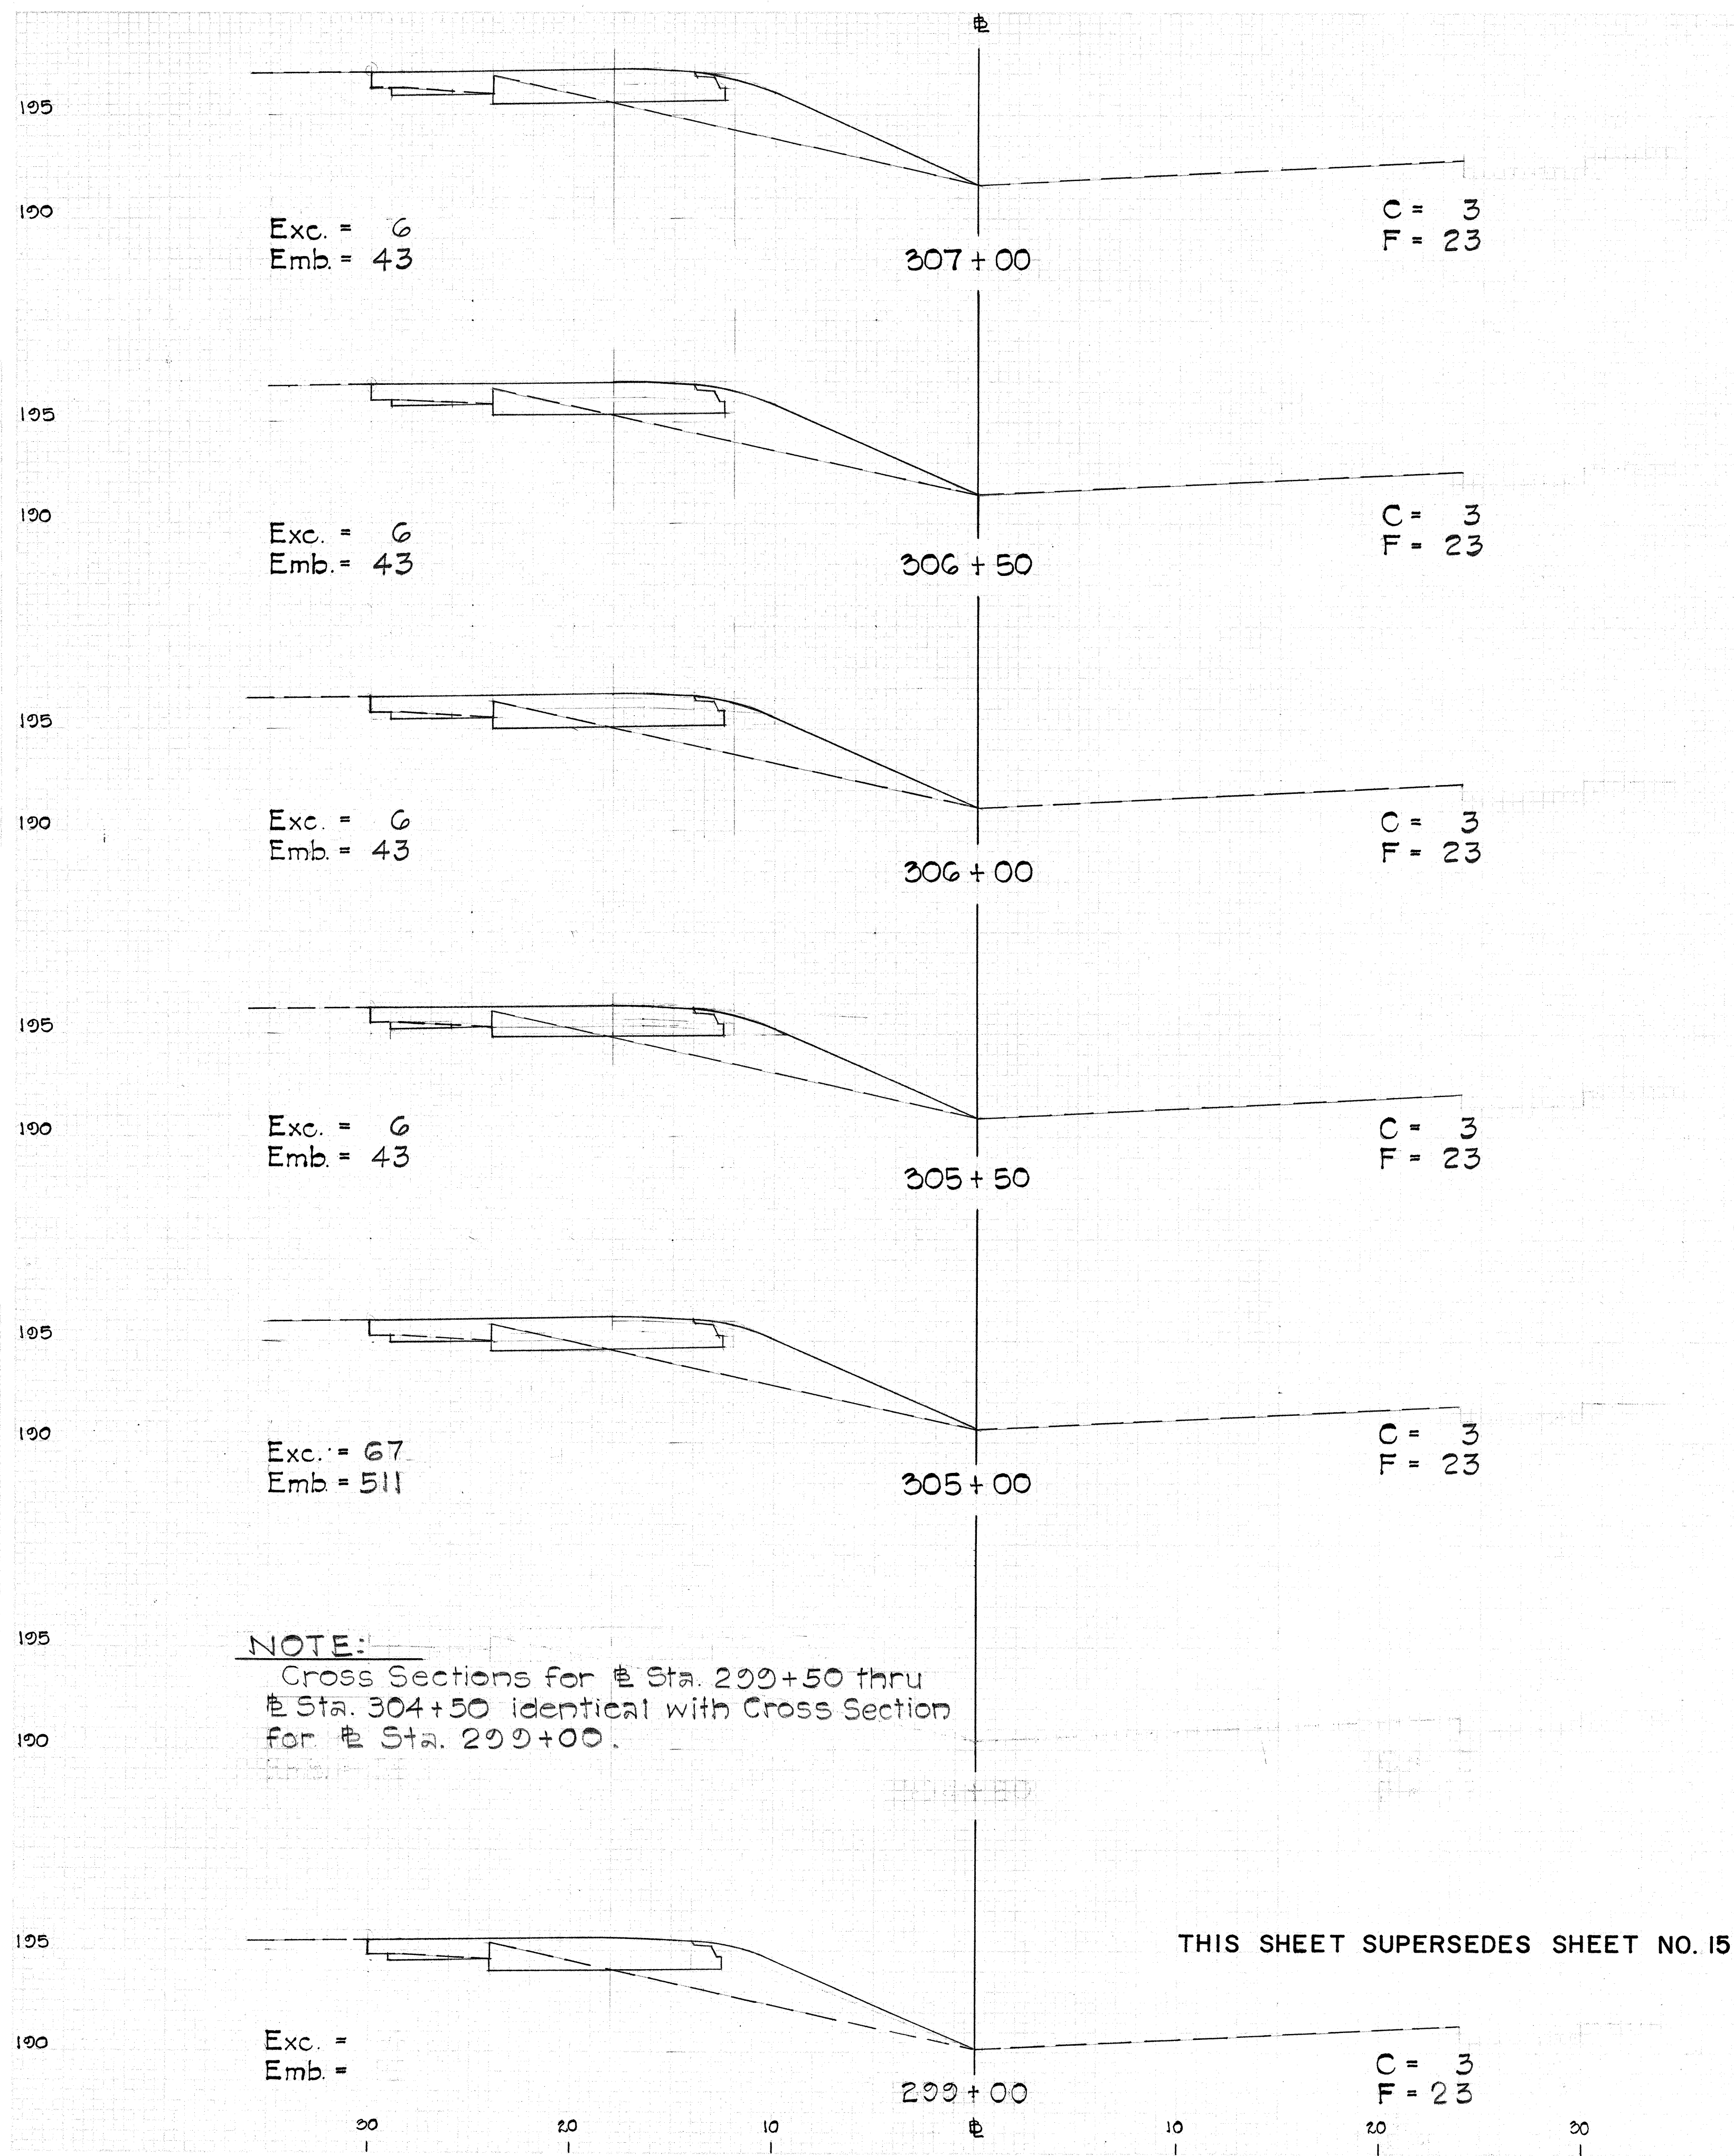

FED. ROAD DIST. NO.	STATE	FED. AID PROJ. NO.	FISCAL YEAR	SHEET NO.	TOTAL SHEETS
HAWAII	HAW	I-HI-1(18), Unit 3	1966	C.O. 16	35

Revised: Jan. 16, 1967

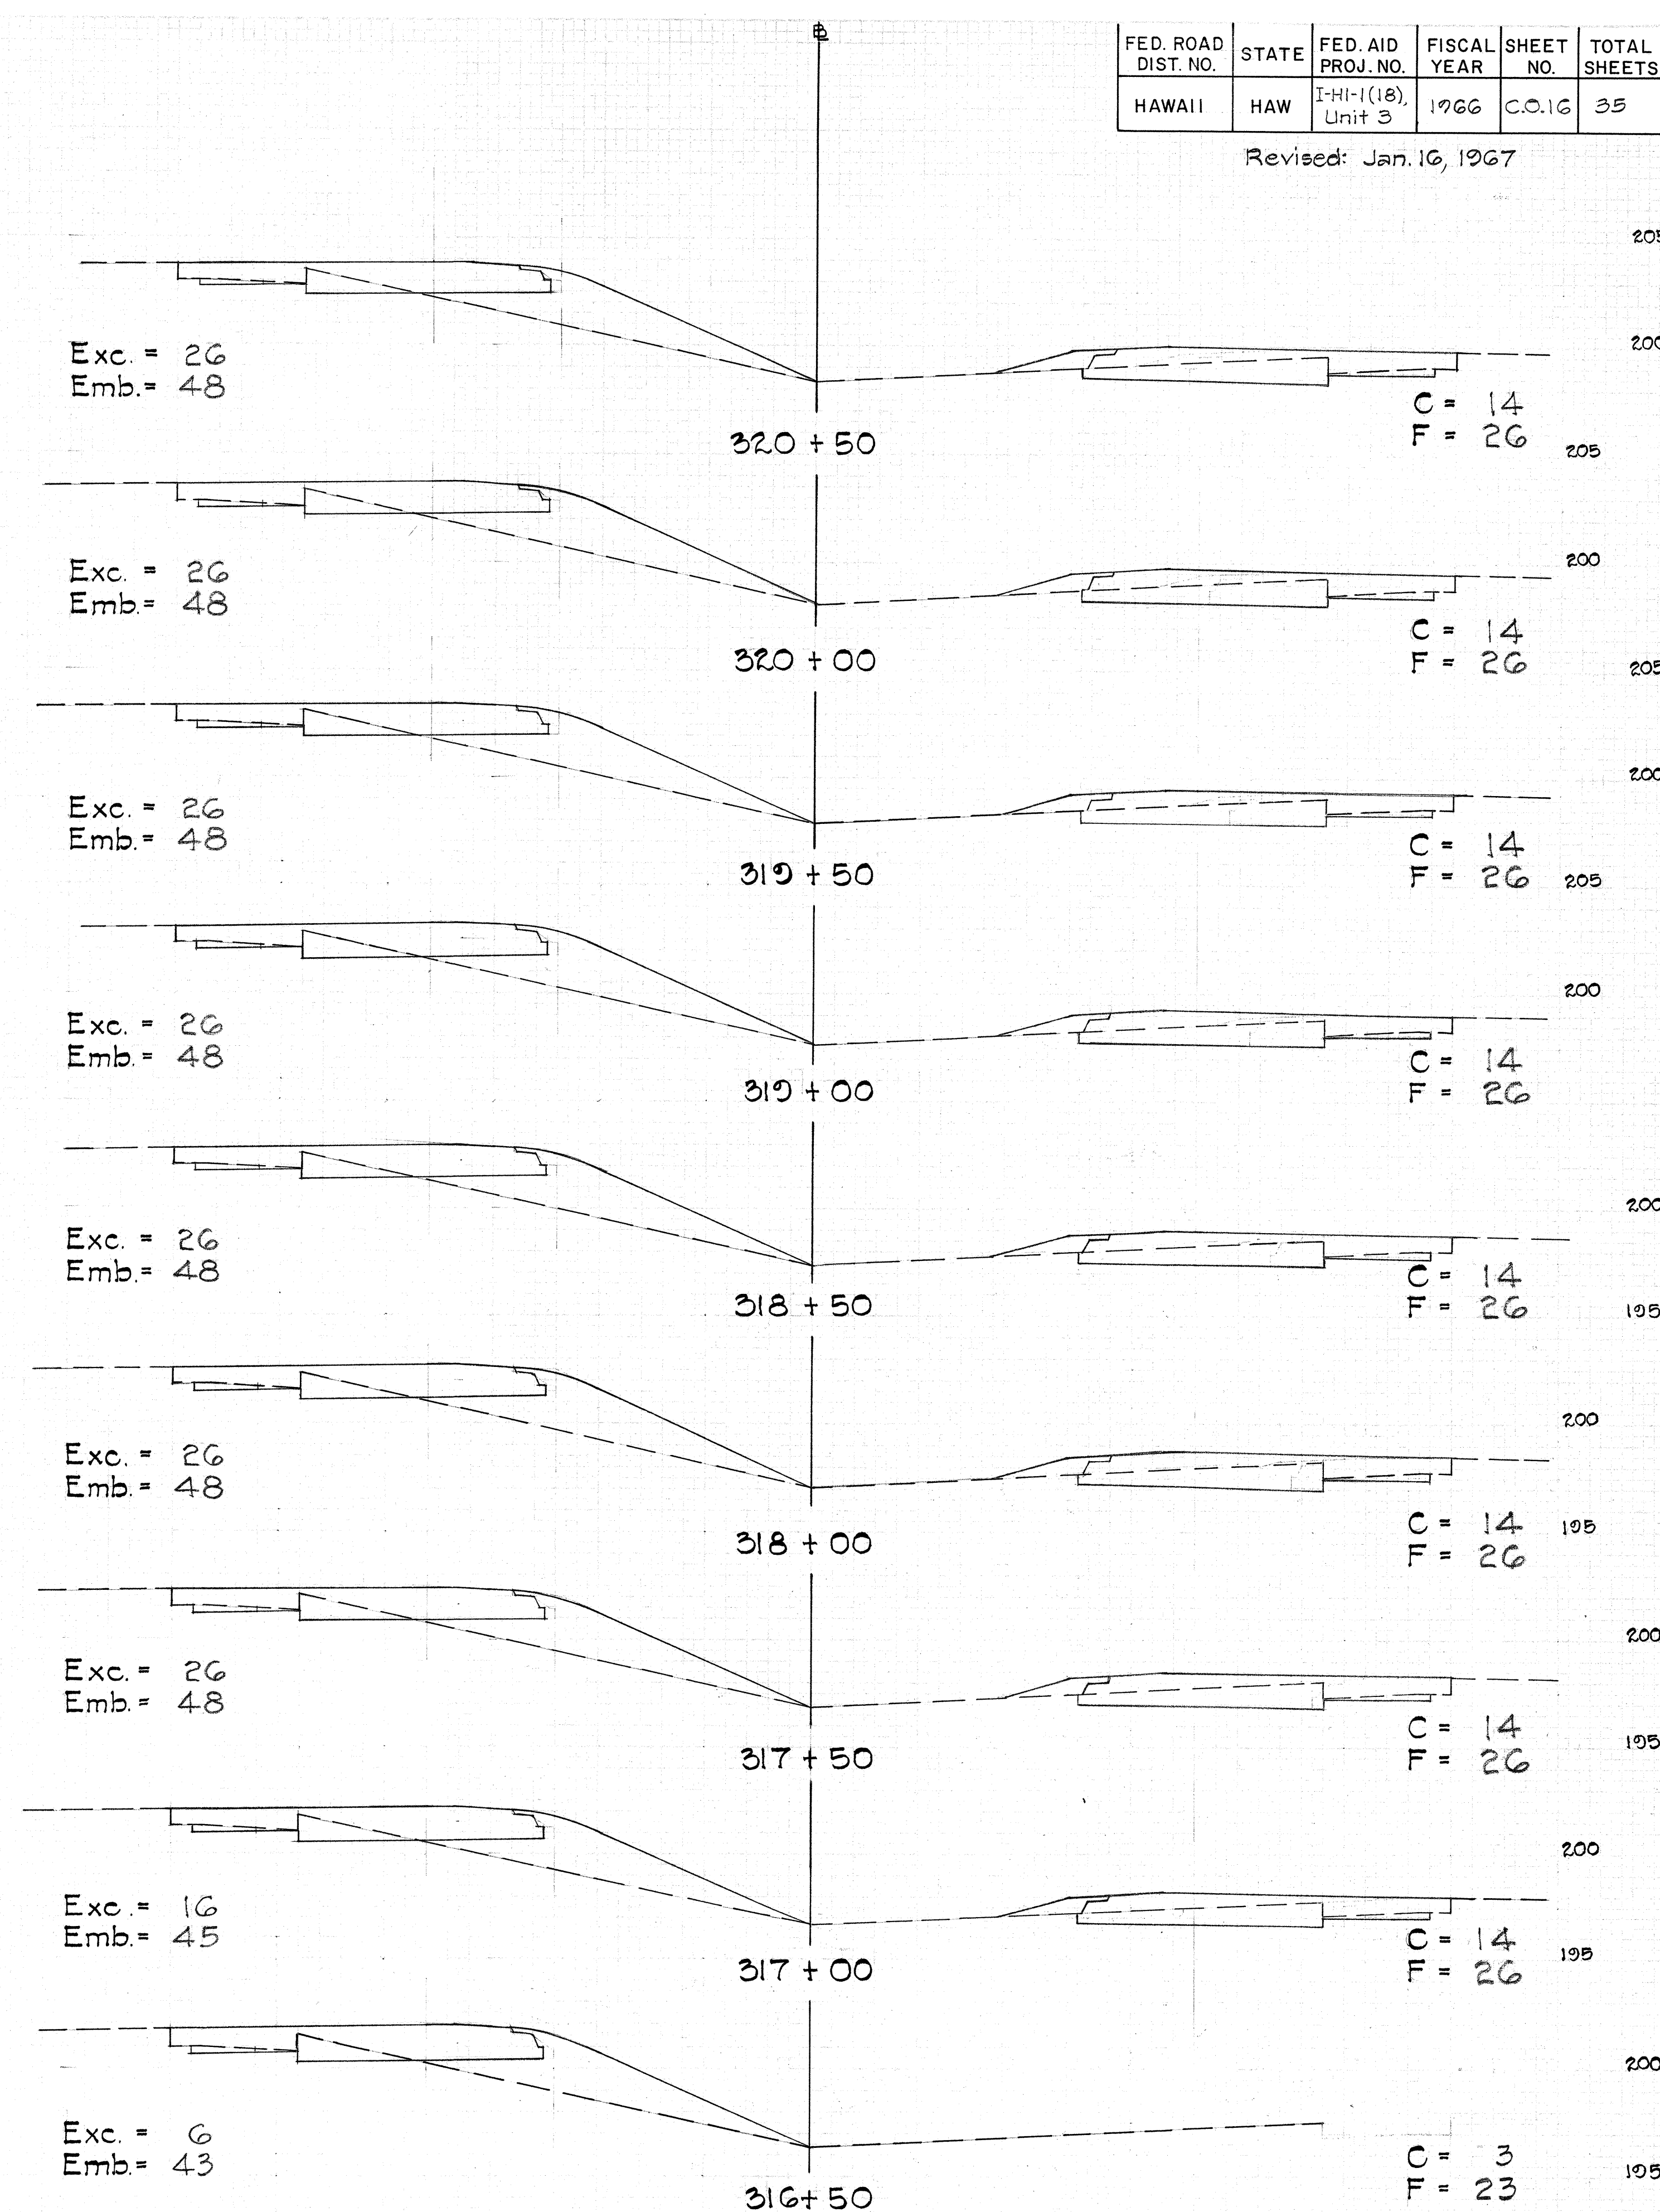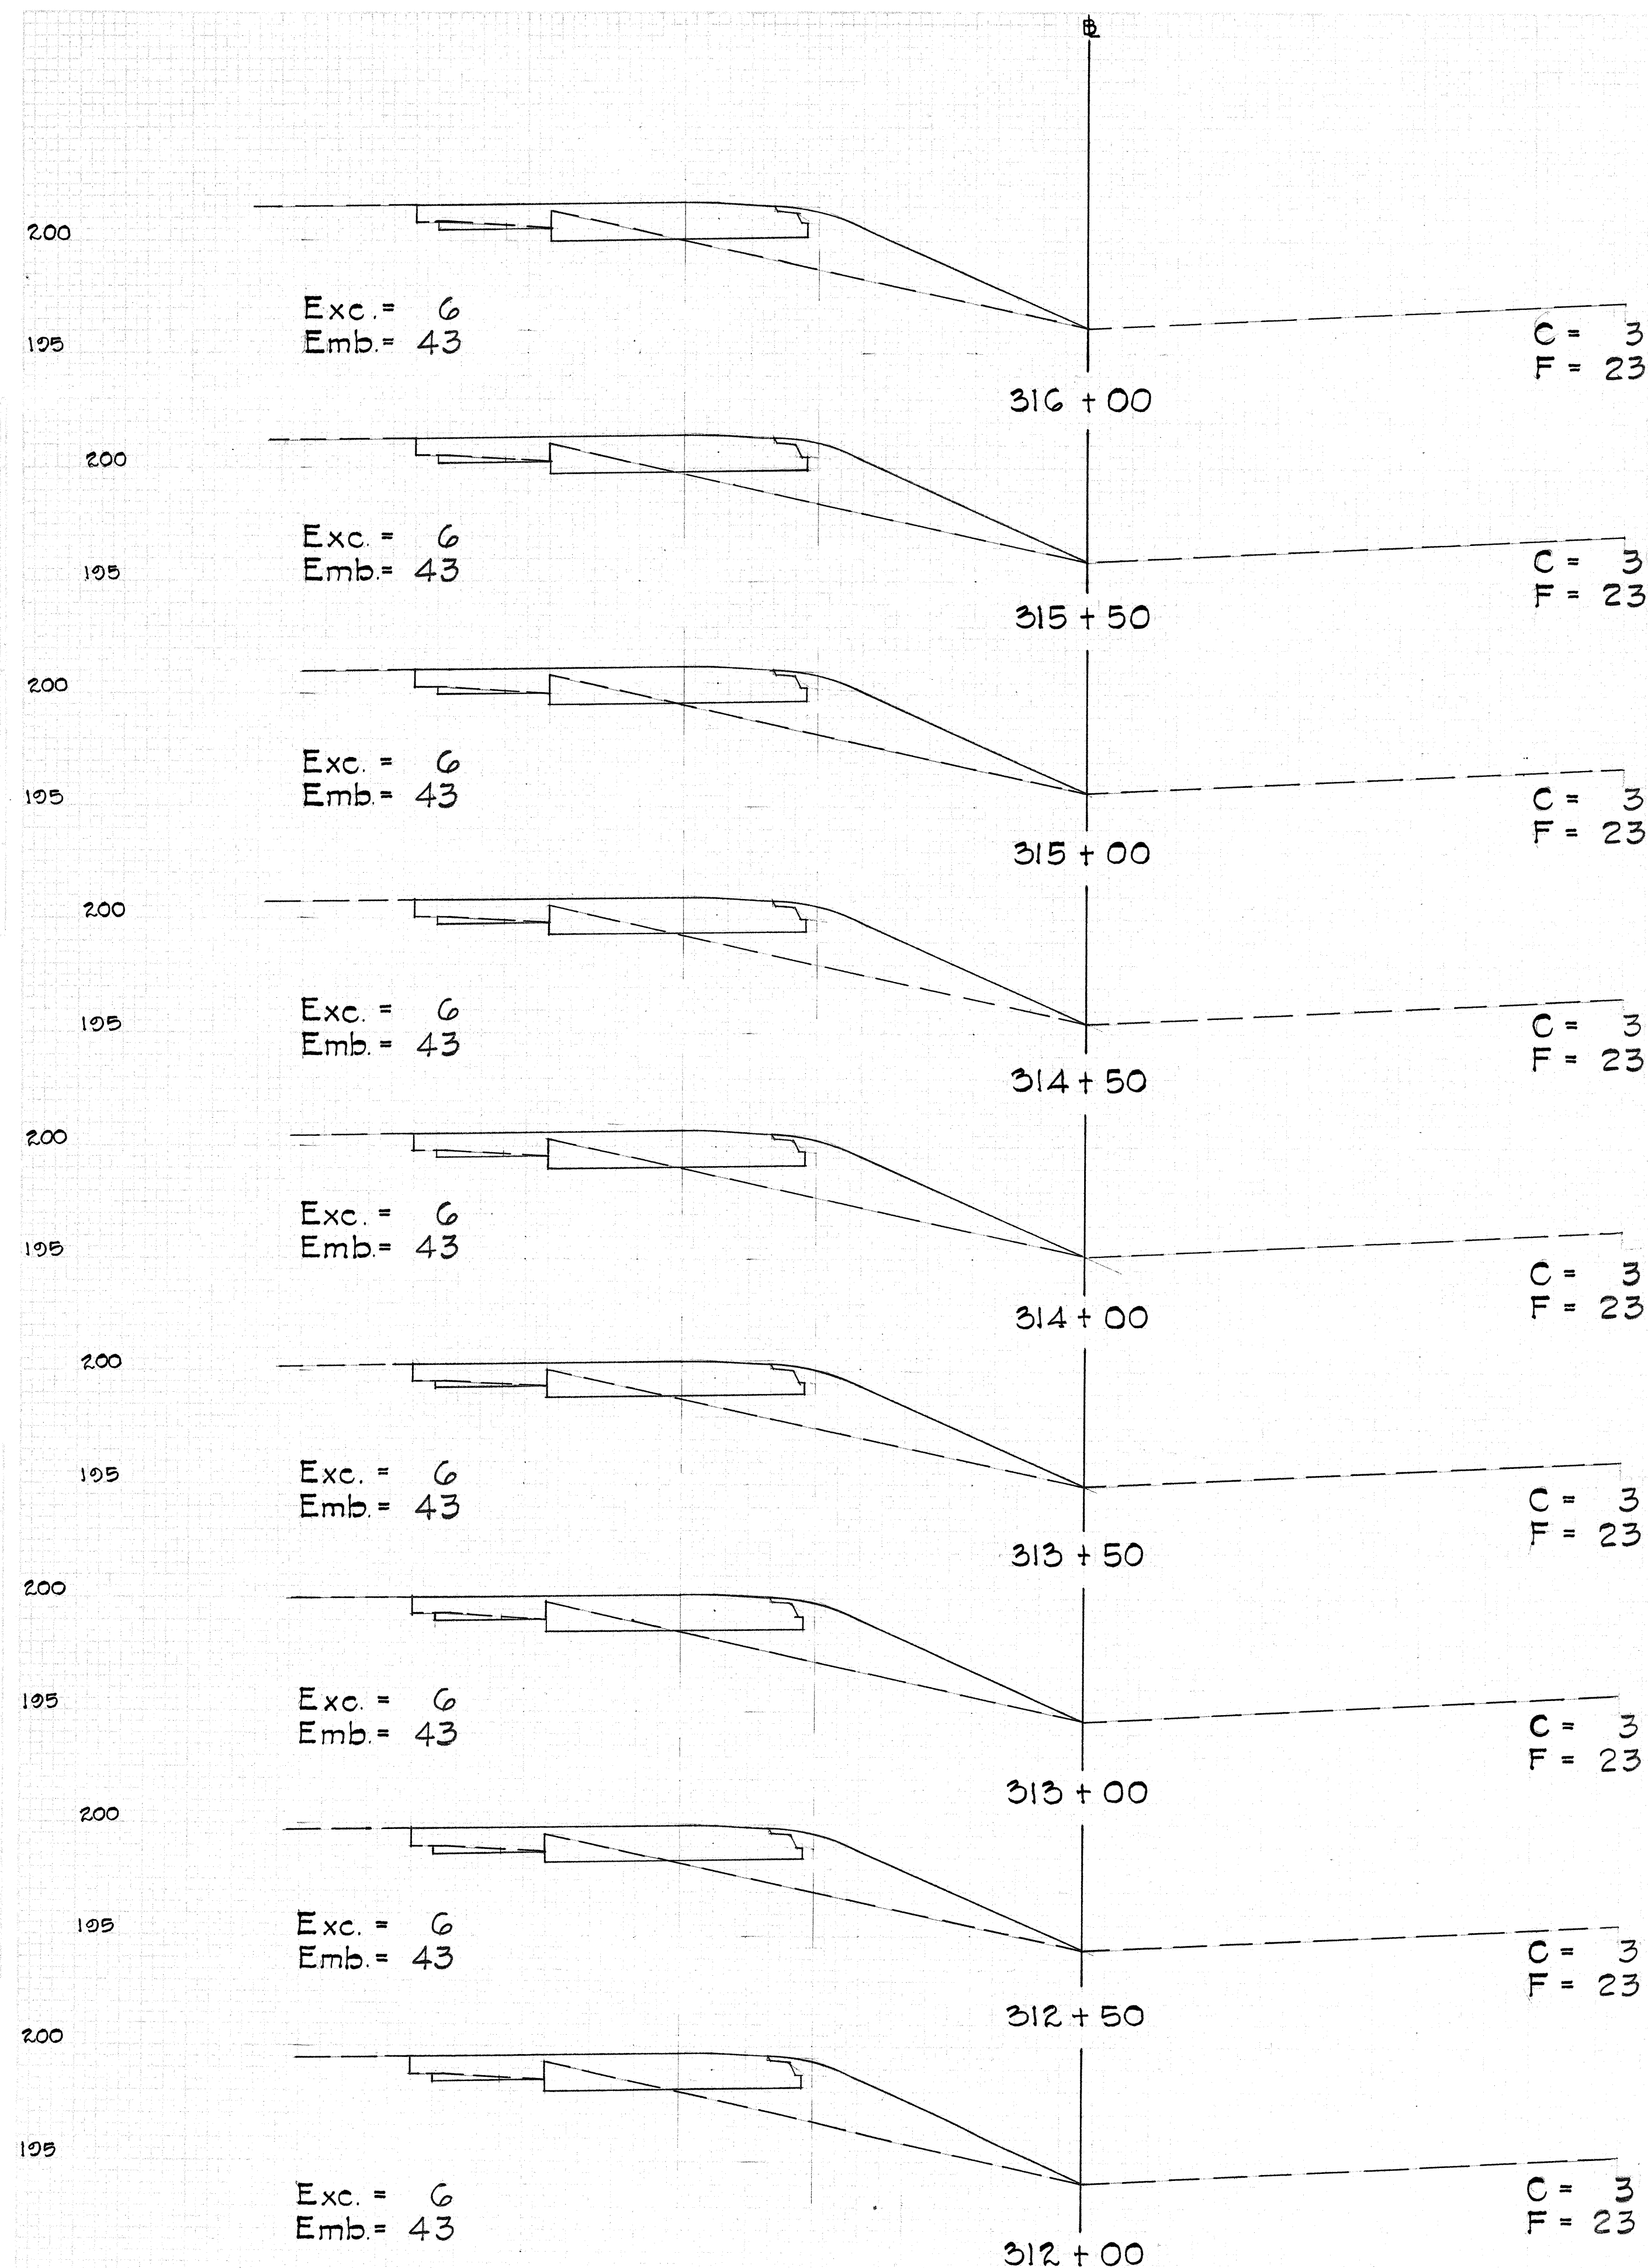


THIS SHEET SUPERSEDES SHEET NO. 16

C. O. 16

FED. ROAD DIST. NO.	STATE	FED. AID PROJ. NO.	FISCAL YEAR	SHEET NO.	TOTAL SHEETS
HAWAII	HAW	I-HI-1(18), Unit 3	1966	C.O.17	35

Revised: Jan. 16, 1967

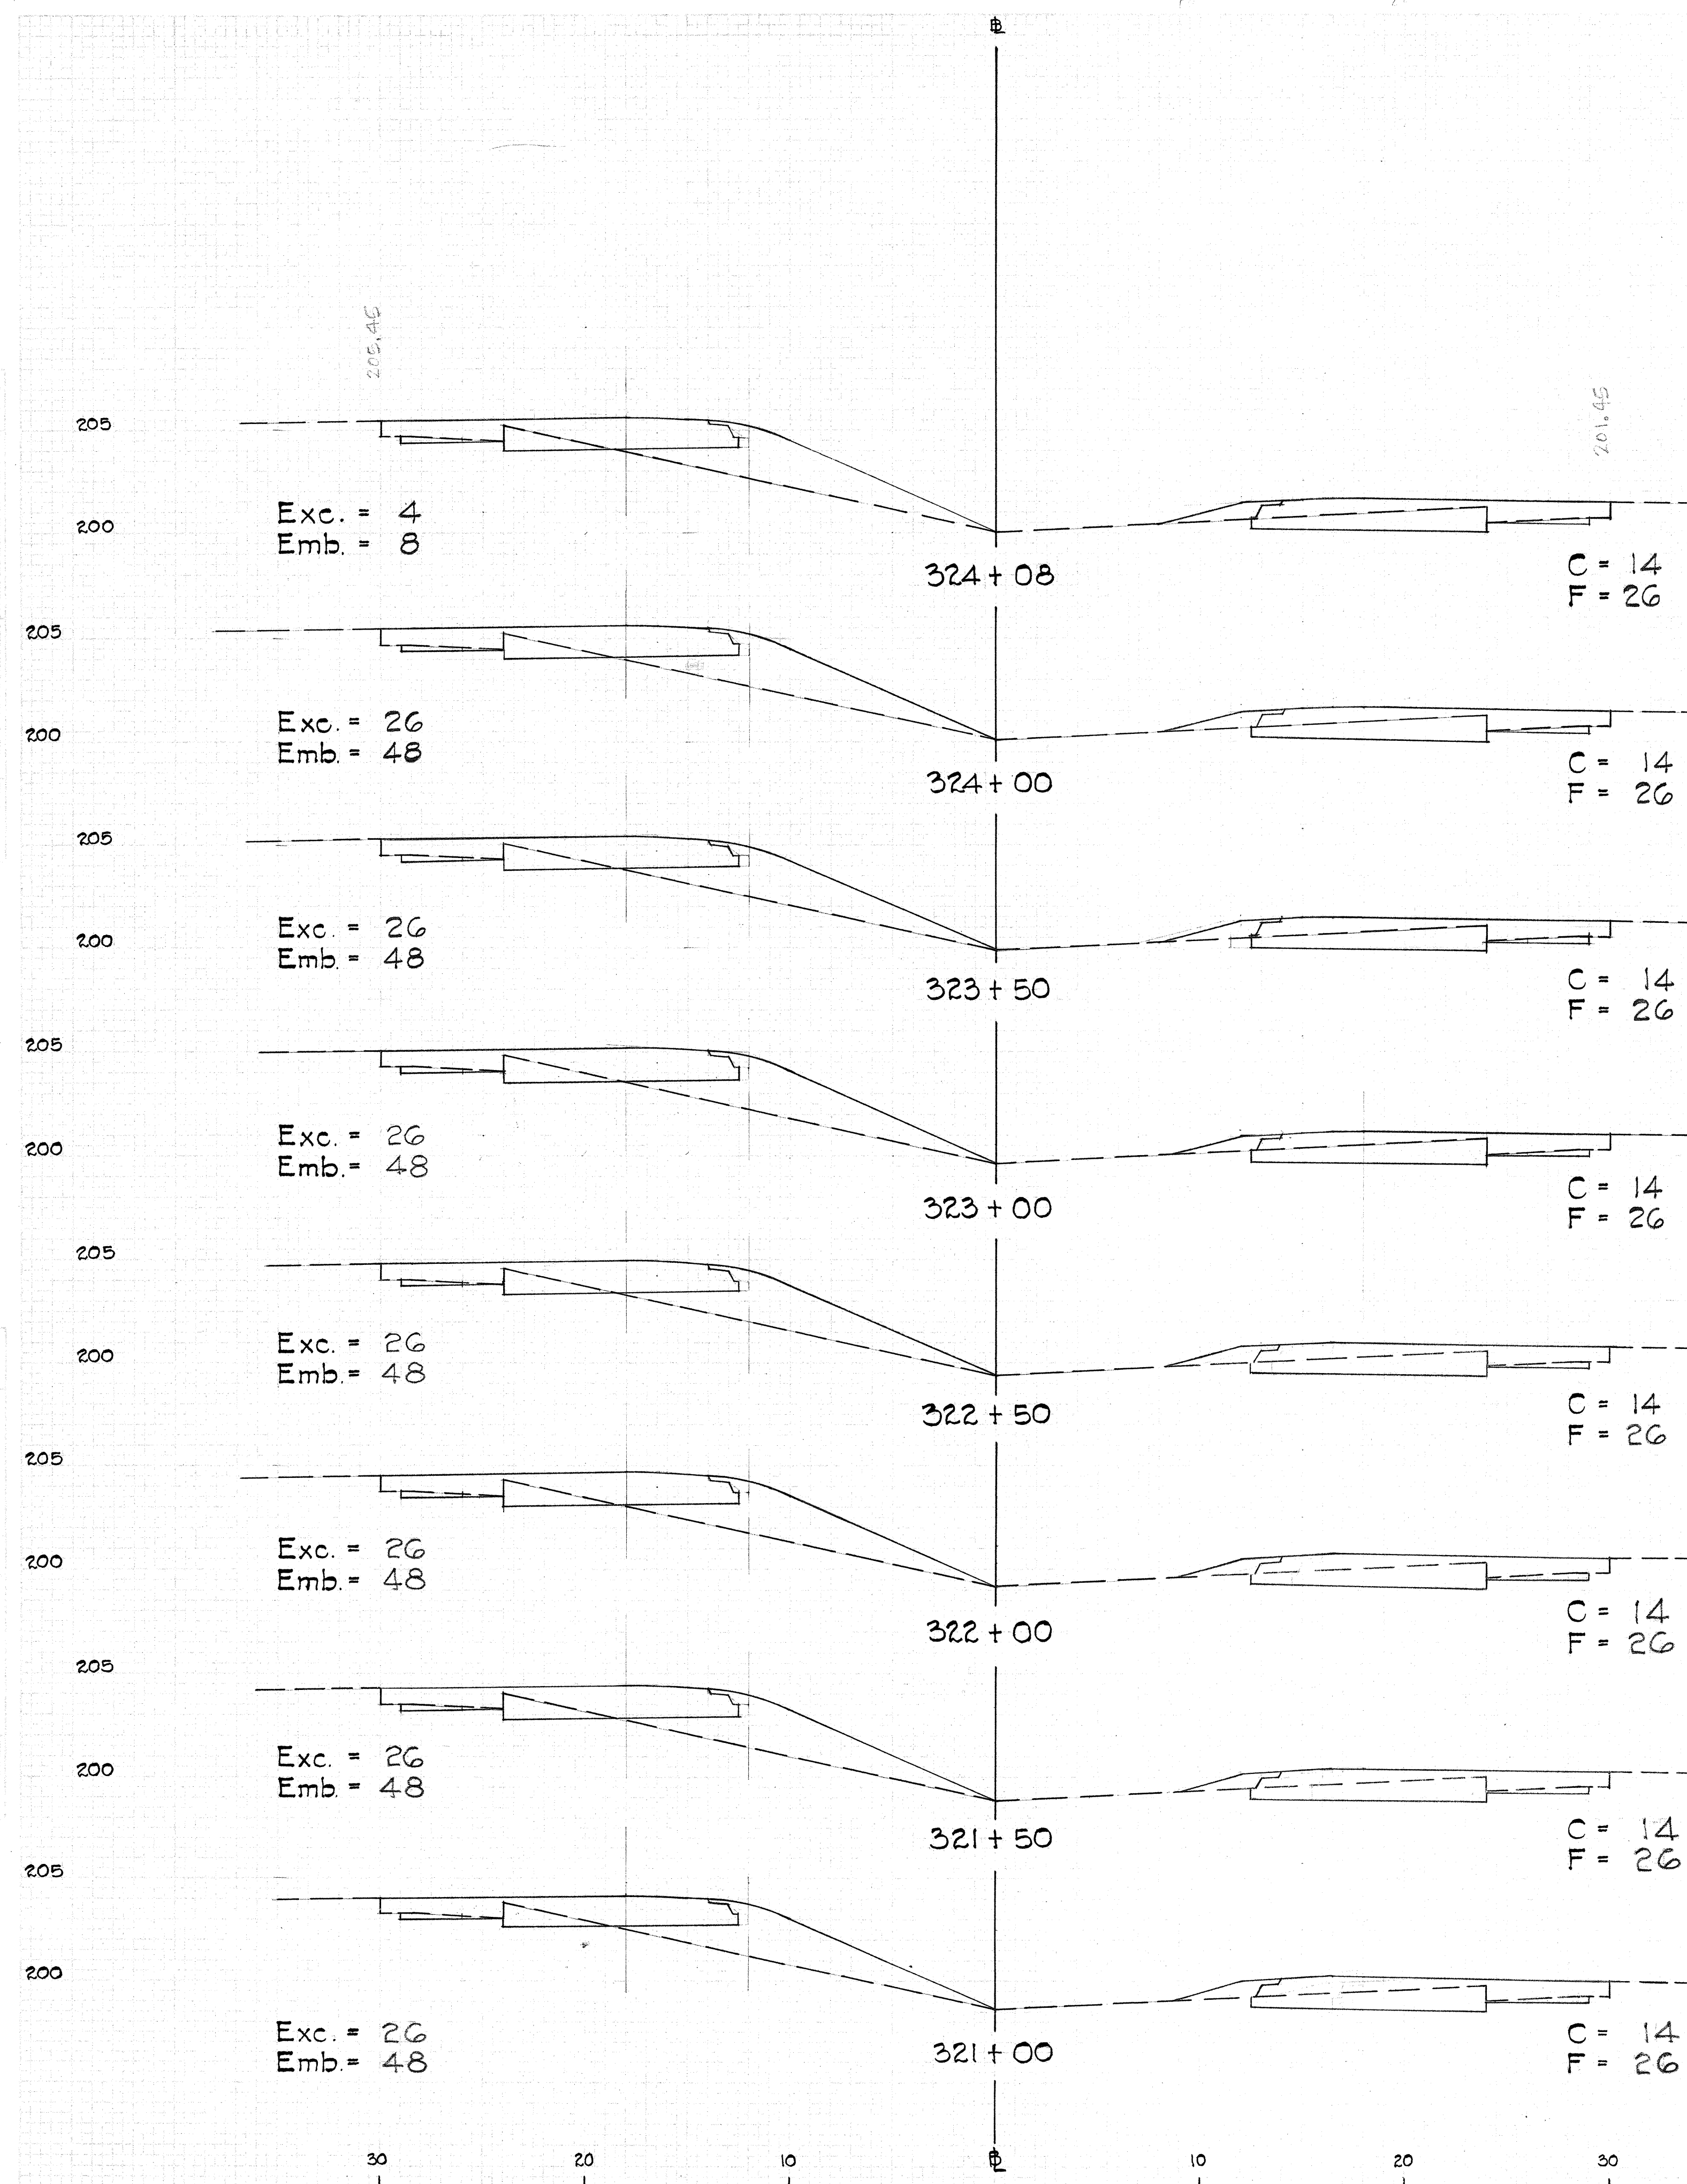

THIS SHEET SUPERSEDES SHEET NO. 17

C.O. 17