



Revised: Jan. 10, 1967


FED. ROAD DIST. NO.	STATE	FED. AID PROJ. NO.	FISCAL YEAR	SHEET NO.	TOTAL SHEETS
HAWAII	HAW.	I-HI-1(18) Unit 3	1966	C.O.3	35

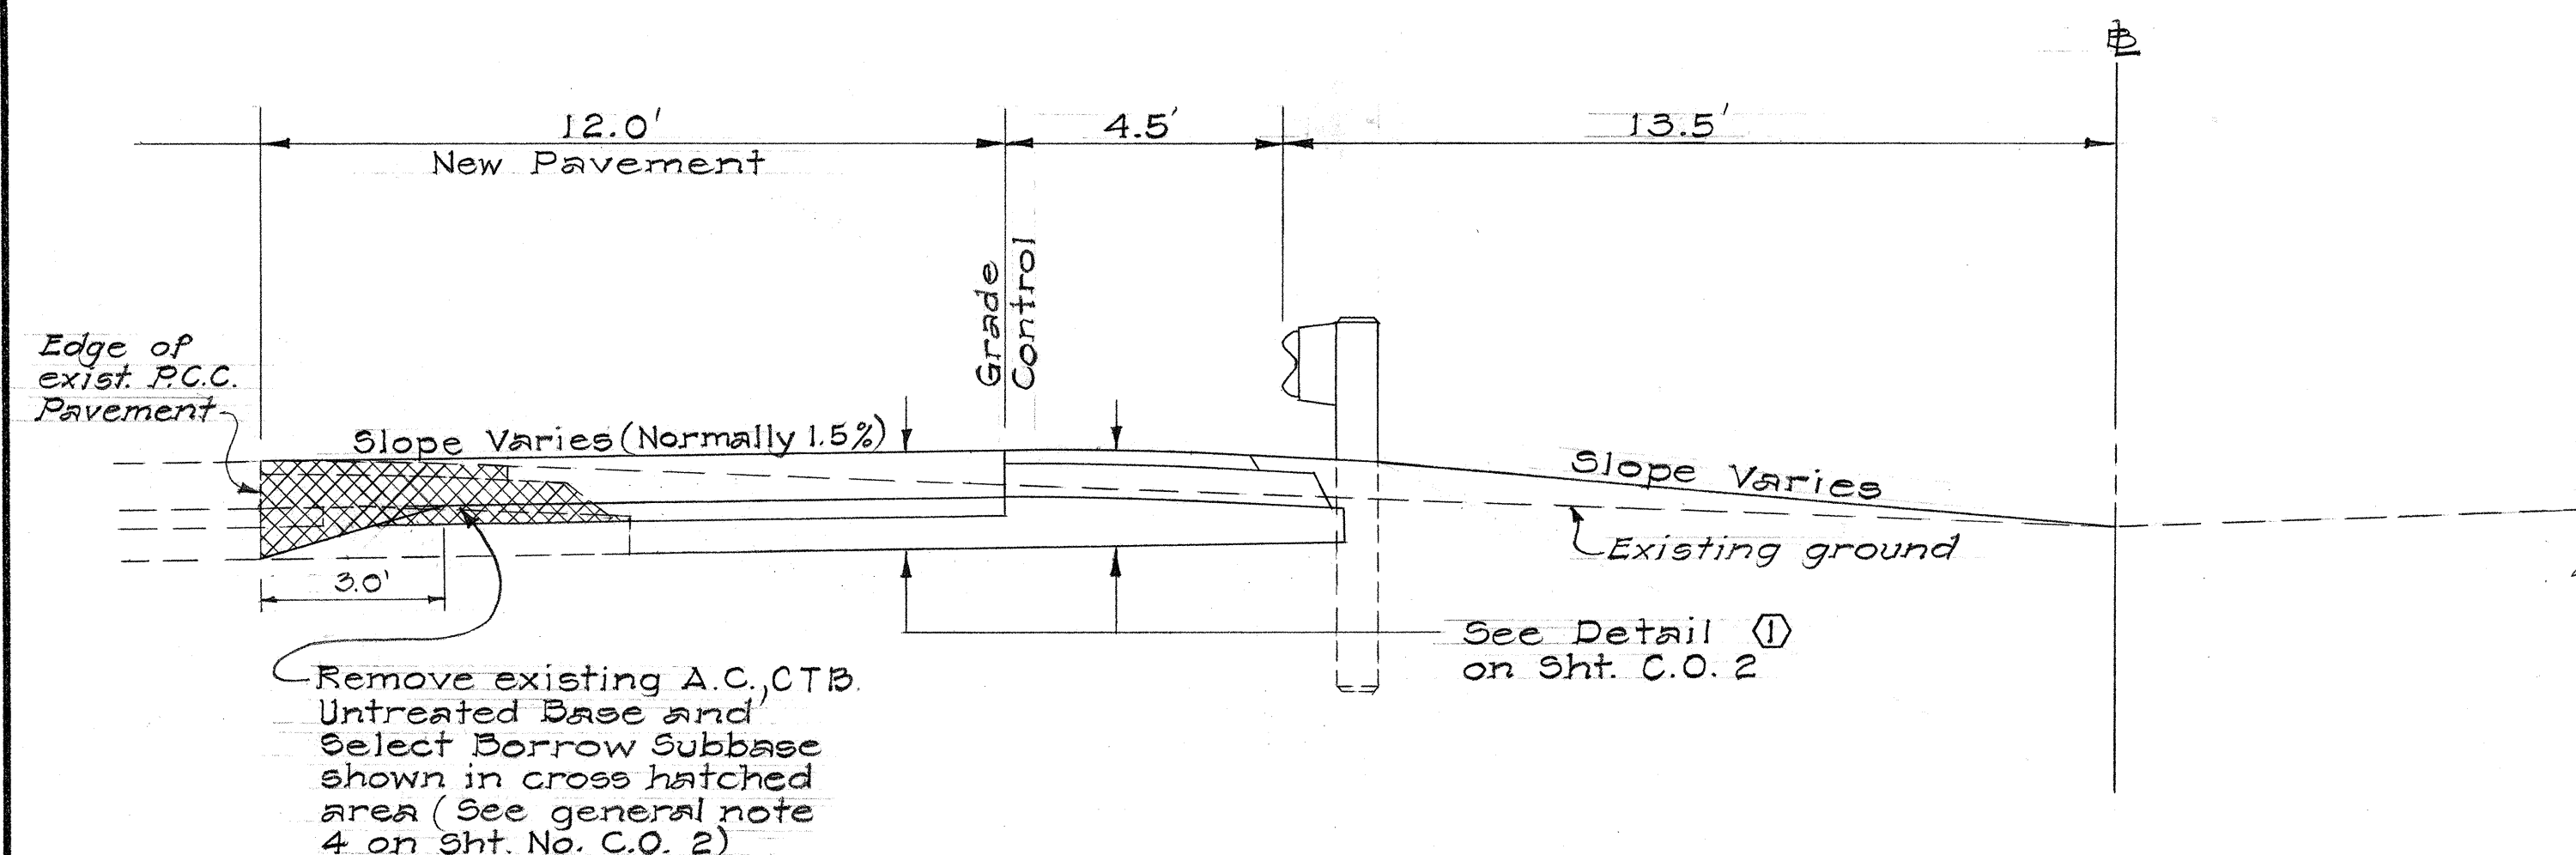


TYPICAL TANGENT SECTION
 Sta. 283+00 to Sta. 298+75
 Scale: $\frac{3}{8}" = 1'-0"$

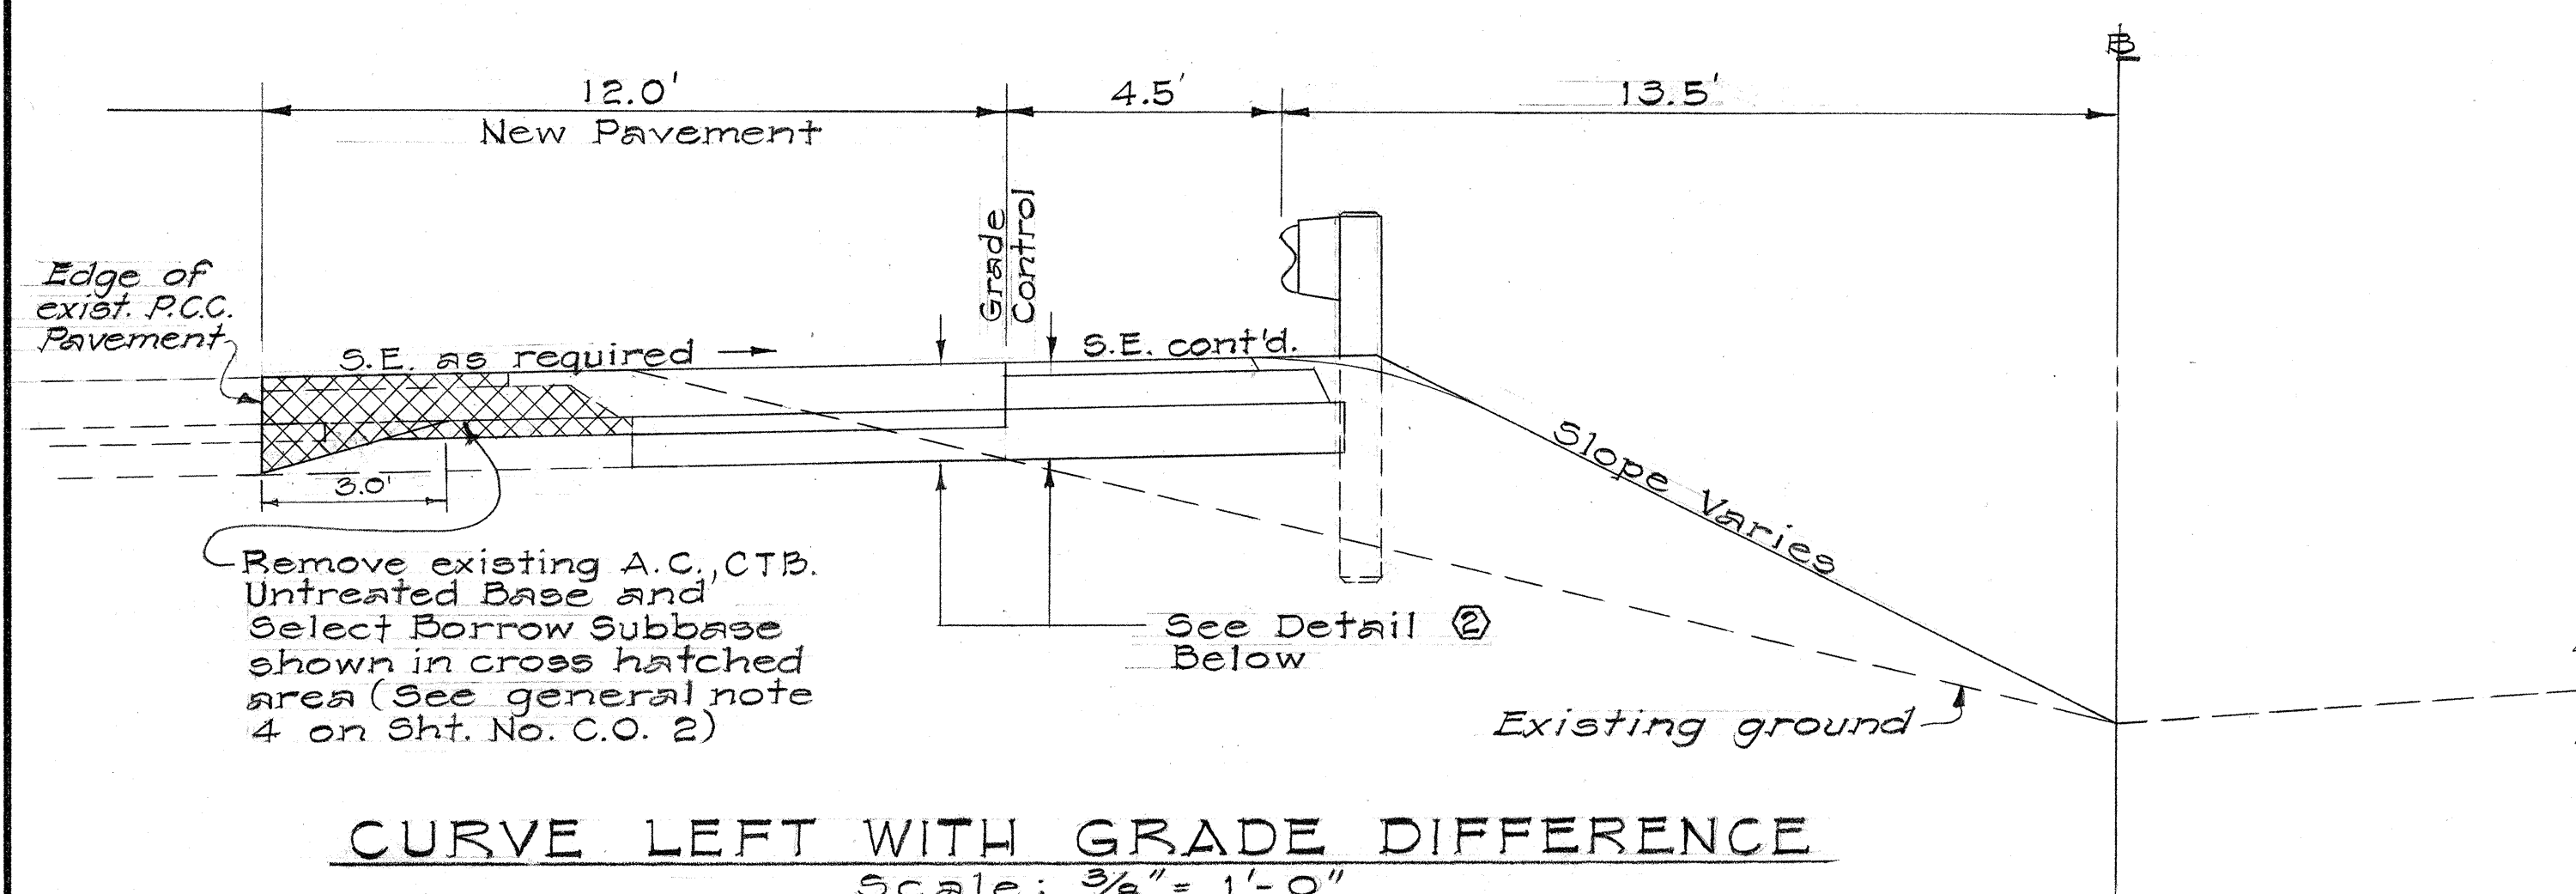


CURVE LEFT WITH GRADE DIFFERENCE
 Scale: $\frac{3}{8}" = 1'-0"$

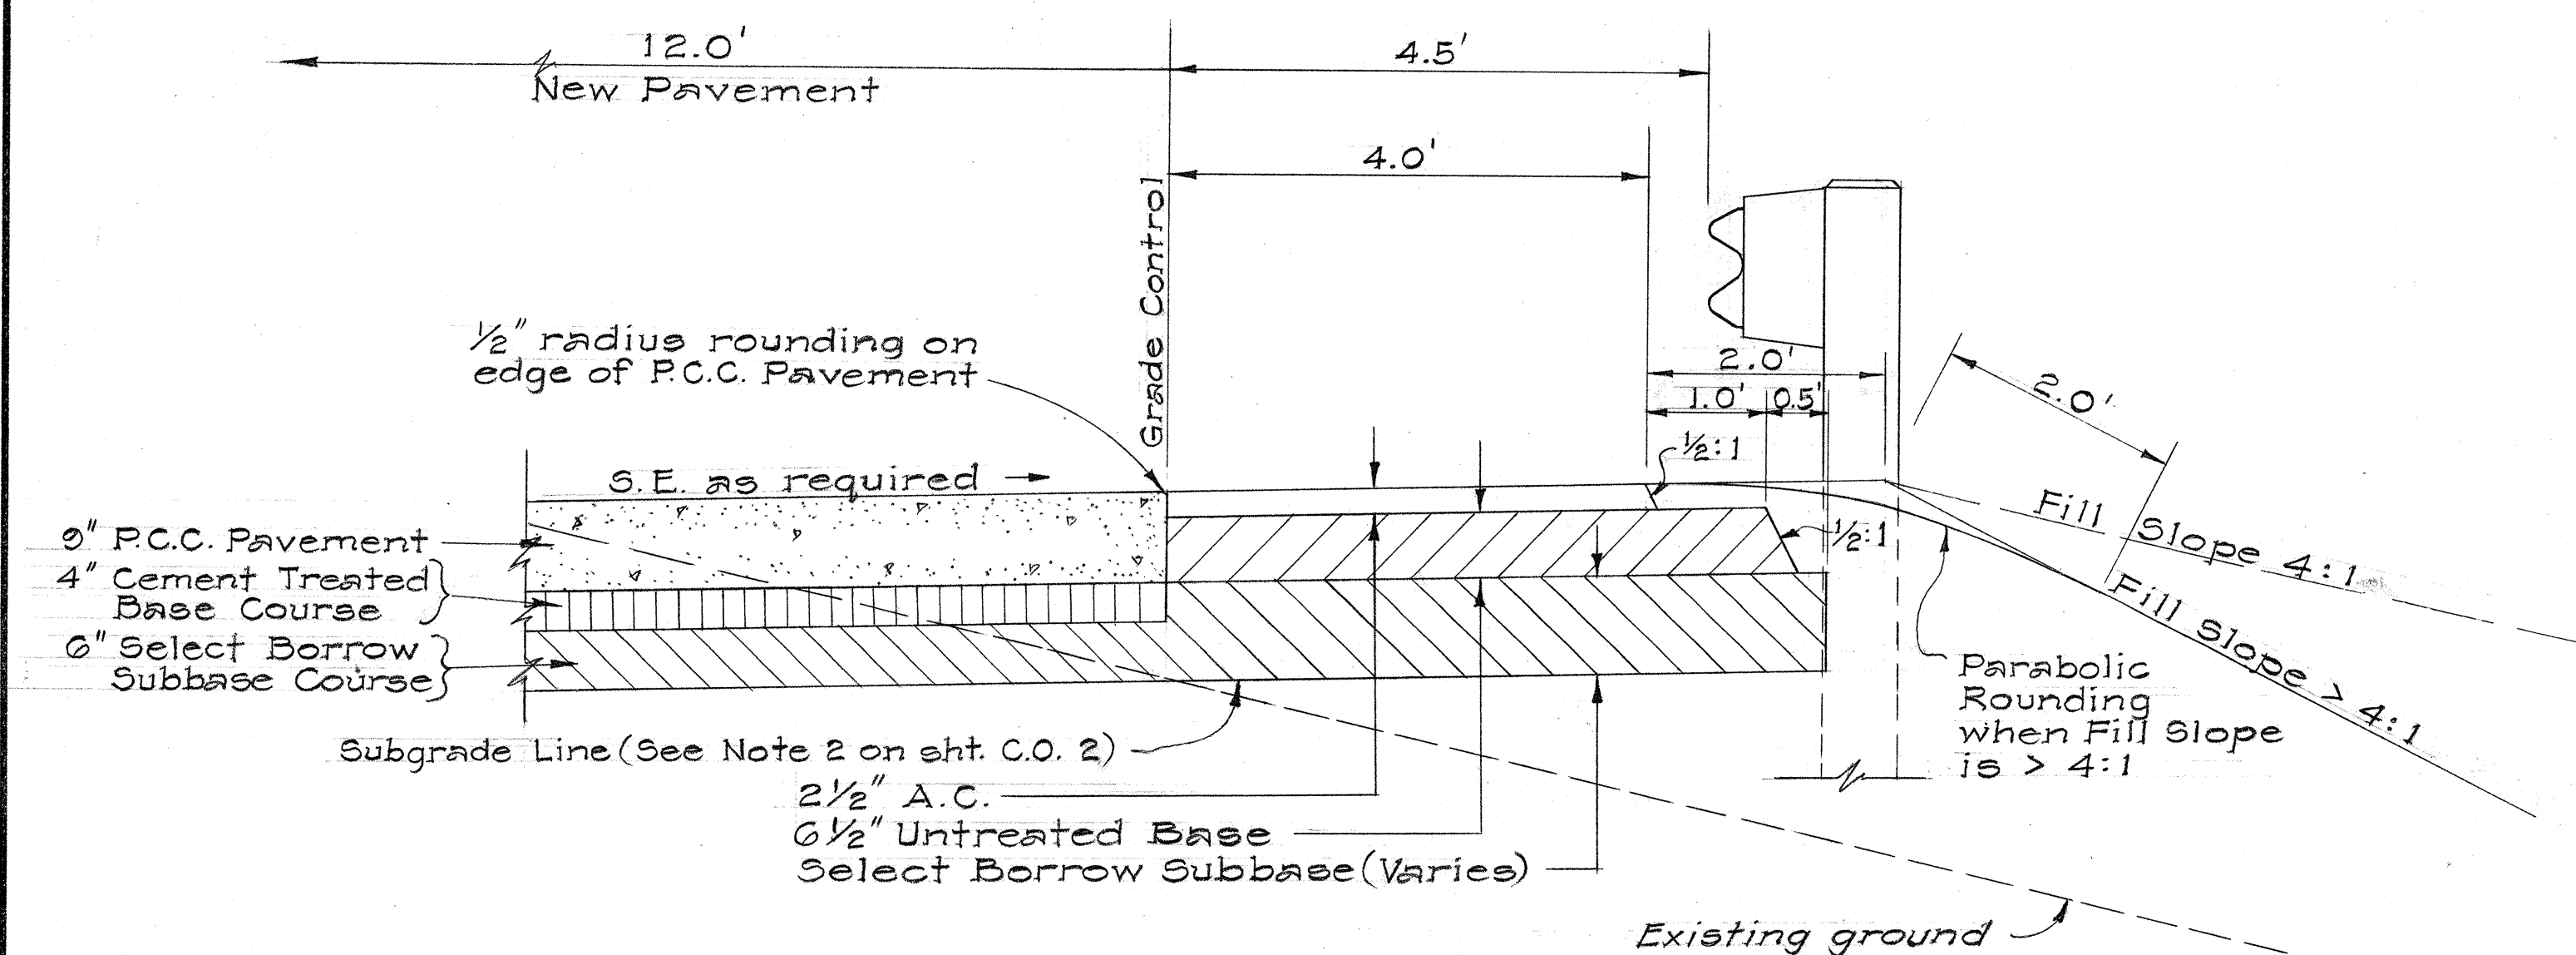


DETAIL ②
 Scale: $\frac{3}{4}" = 1'-0"$

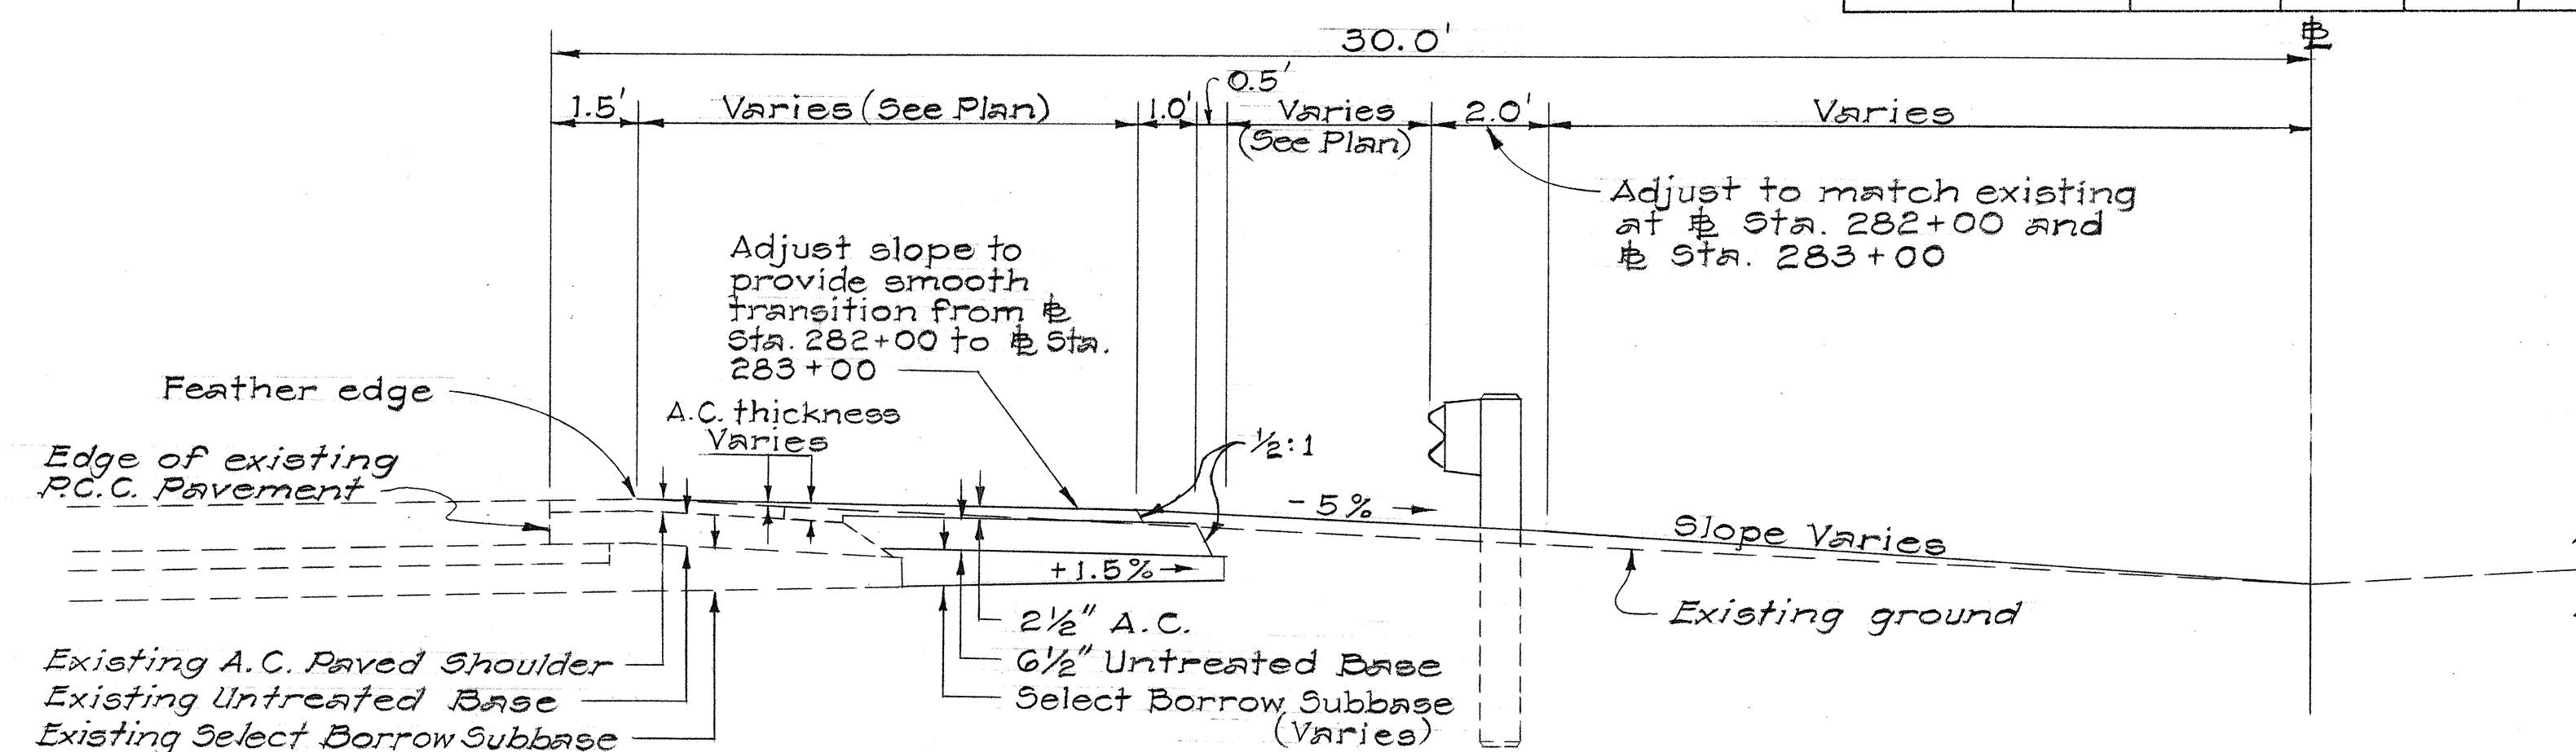

TYPICAL TANGENT SECTION
 Sta. 282+00 to Sta. 283+00
 Scale: $\frac{3}{8}" = 1'-0"$

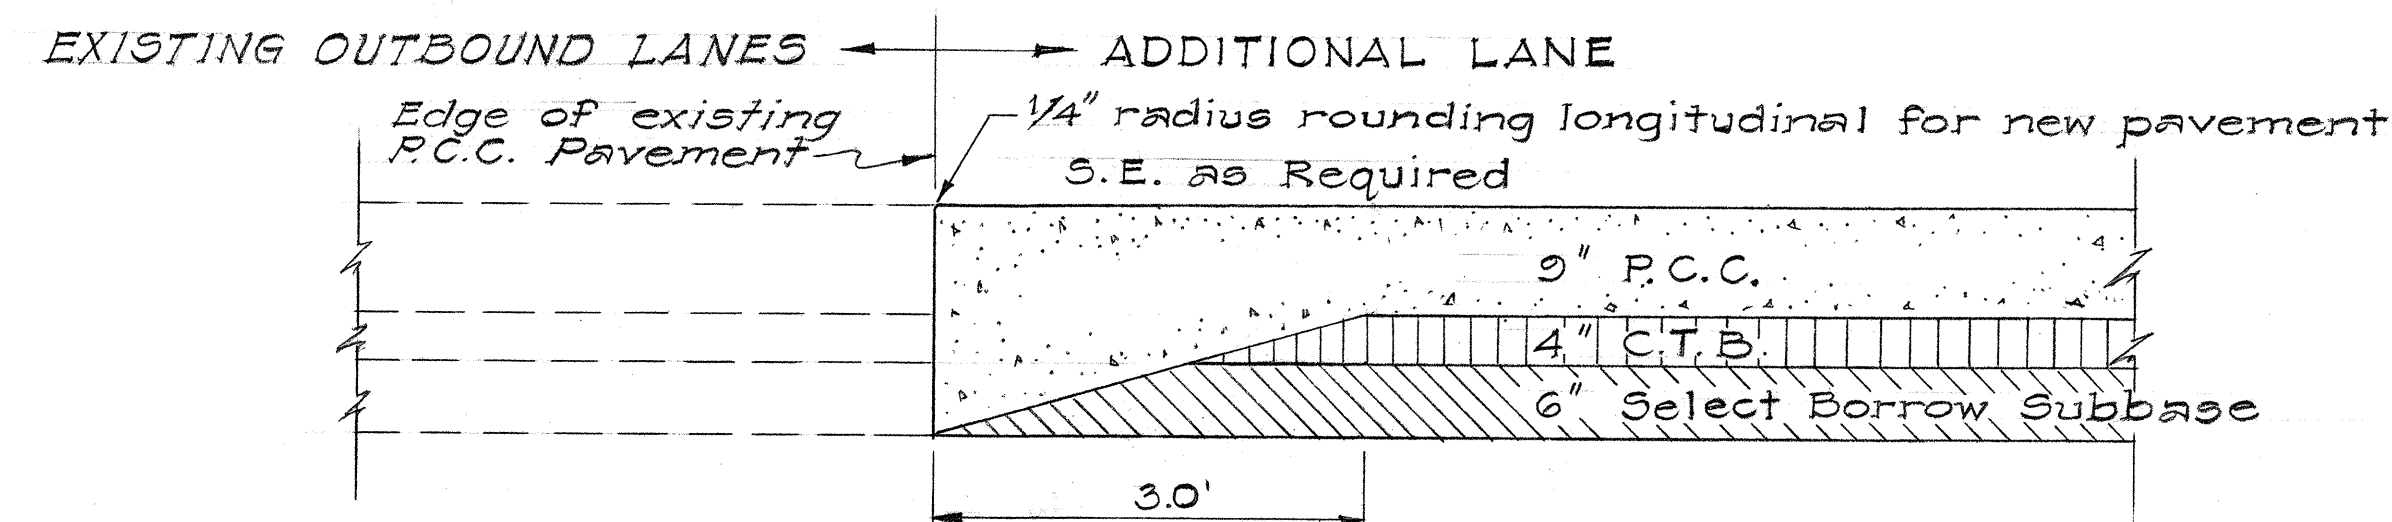

JOINT DETAIL
 Sta. 283+00 to Sta. 298+75
 Scale: $\frac{3}{4}" = 1'-0"$

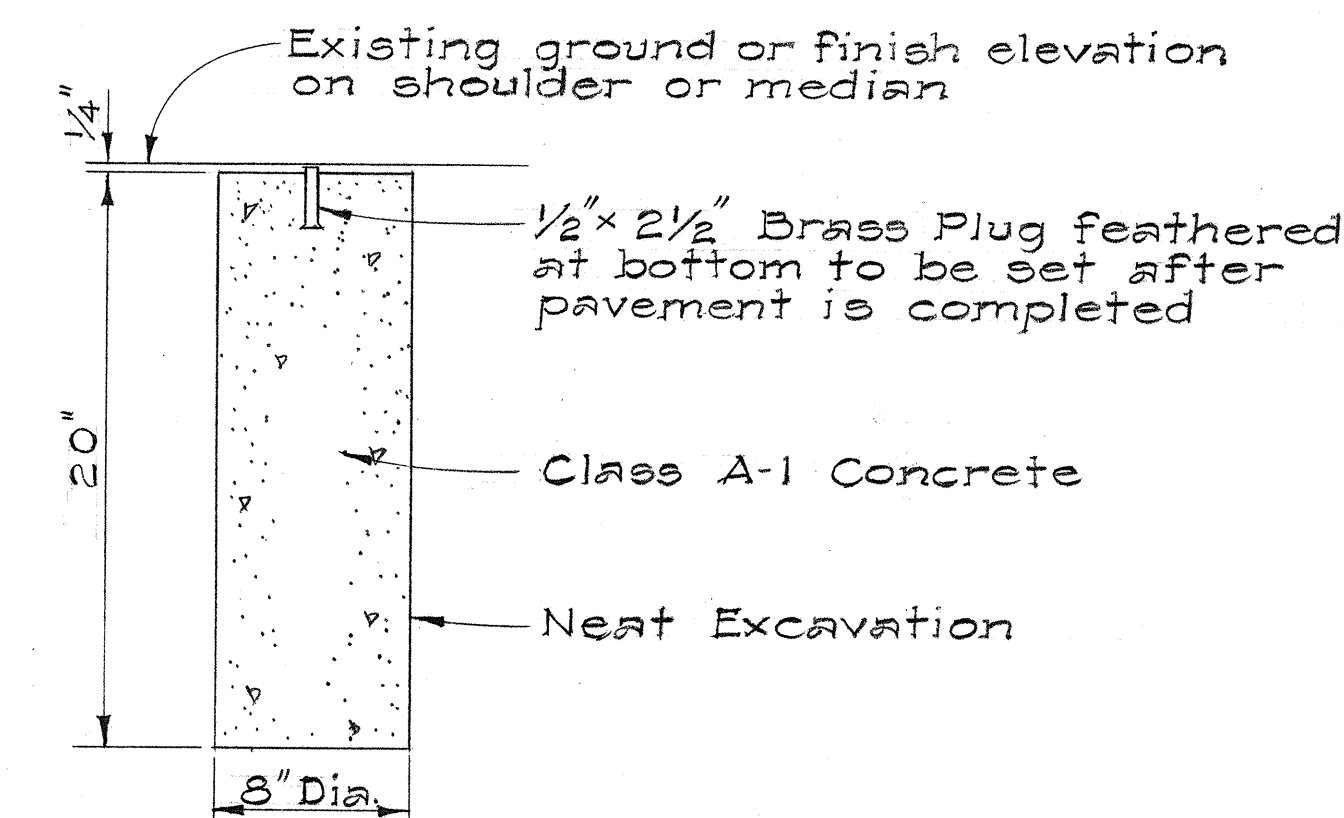

DETAIL FOR SURVEY MONUMENT
 Scale: $\frac{1}{2}" = 1'-0"$

THIS SHEET REPLACES SHEET NO. 3

STATE OF HAWAII
 DEPARTMENT OF TRANSPORTATION
 HIGHWAYS DIVISION

TYPICAL SECTIONS AND SURVEY MONUMENT DETAIL
 INTERSTATE ROUTE H-1
 F.A.I. Proj. No. I-HI-1(18) Unit 3

Scale: As Noted Date: Dec. 1966
 SHEET No. OF SHEETS

C. O. 3

SURVEY PLOTTED BY	DATE
DESIGNED BY	
TRACED BY	
NOTED BY	
CHECKED BY	
ORIGINAL PLAN	
NOTE BOOK	
NO.	

