


Revised: Jan. 16, 1967

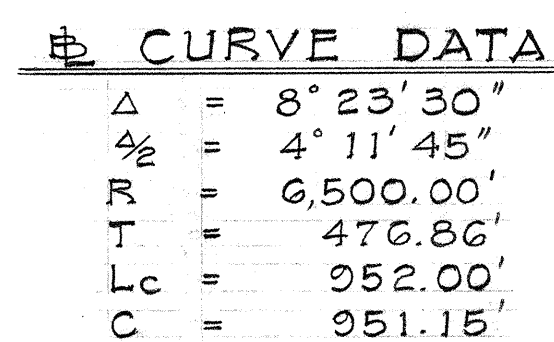


Scale: 1" = 50' Date: Dec. 1966


SHEET No. OF SHEETS

FED. ROAD DIST. NO.	STATE	FED. AID PROJ. NO.	FISCAL YEAR	SHEET NO.	TOTAL SHEETS
HAWAII	HAW.	I-HI-1(18), Unit 3	1966	C.O. 4	35

Revised: Jan. 16, 1967

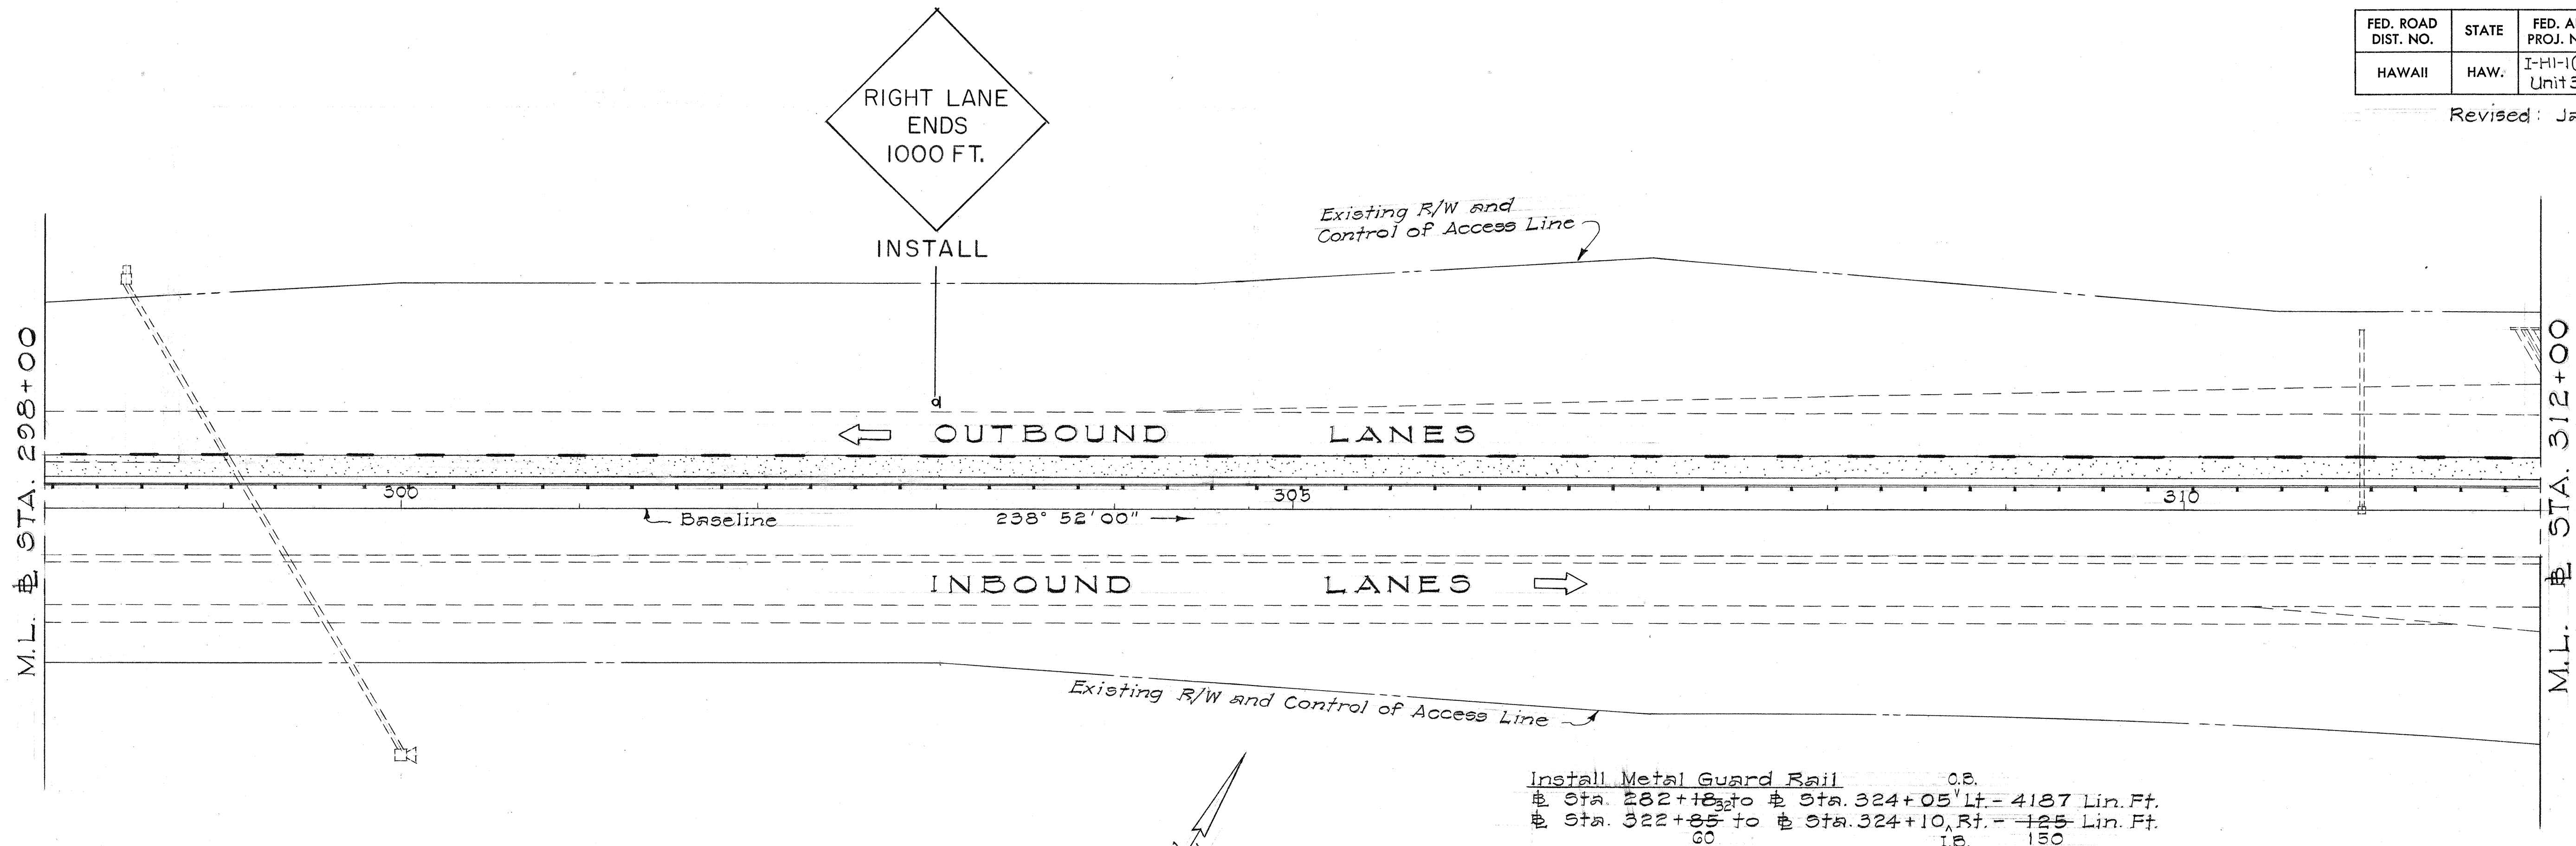

Install Metal Guard Rail O.B.
 E Sta. 282+18 to E Sta. 324+05 Lt. = 4187 Lin. Ft.
 E Sta. 322+65 to E Sta. 324+10 Rt. = 125 Lin. Ft.
 I.B. 150

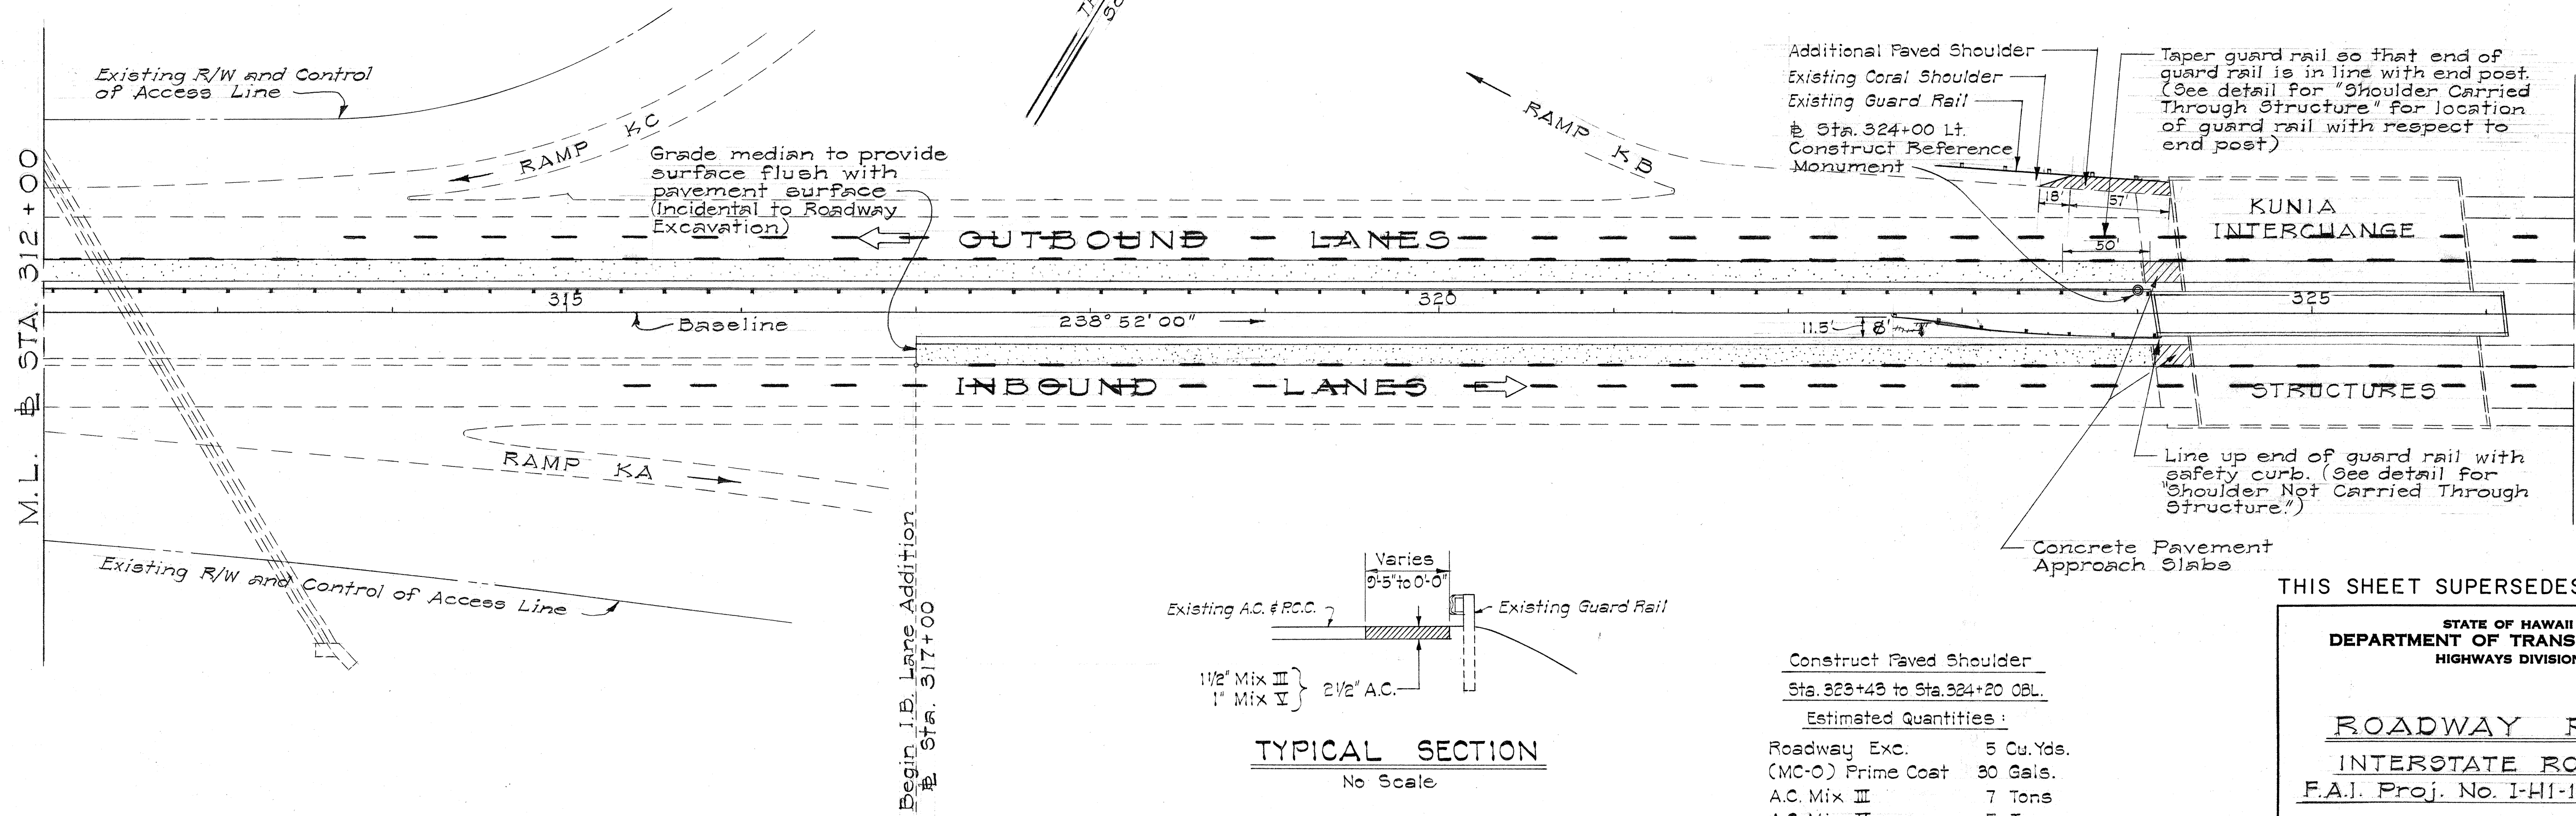

Construct Paved Shoulder
 Sta. 323+43 to Sta. 324+20 O.B.L.
 Estimated Quantities:
 Roadway Exc. 5 Cu. Yds.
 (MC-O) Prime Coat 30 Gals.
 A.C. Mix III 7 Tons
 A.C. Mix V 5 Tons

THIS SHEET SUPERSEDES SHEET NO. 4

STATE OF HAWAII
 DEPARTMENT OF TRANSPORTATION
 HIGHWAYS DIVISION

ROADWAY PLAN
 INTERSTATE ROUTE H-1
 F.A.I. Proj. No. I-HI-1(18), Unit 3

Scale: 1" = 50' Date: Sept. 1966

SHEET NO. OF SHEETS

C.O. 4

SURVEY PLOTTED BY	DATE
DRAWN BY	
DESIGNED BY	
NOTE BOOK	
CHECKED BY	
No.	