
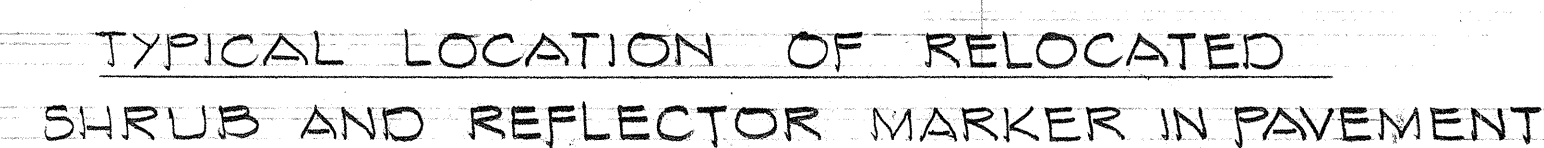



Revised: Jan. 16, 1967

Not to Scale

1. Exact location of signs to be determined in the field by the Engineer.
2. Forming and filling of inset with cold mix asphalt concrete shall be incidental to the installation of the Reflector Marker.

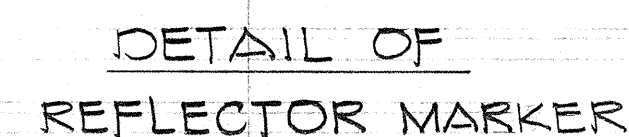

Scale: $1\frac{1}{2}'' = 1'-0''$

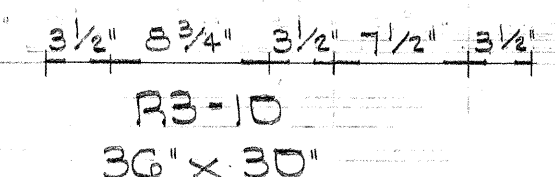

- ① The shape, color, plate details, lettering and reflectorization of signs shall be in accordance with the "Manual on Uniform Traffic Control Devices for Streets and Highways," dated June 1961 and the BPR manual "Standard Highway Signs," dated September 1961 unless otherwise specified.
- ② All signs shall be reflectorized and shall have $\frac{3}{8}$ " bolt holes drilled at appropriate locations.

STATE OF HAWAII
DEPARTMENT OF TRANSPORTATION
HIGHWAYS DIVISION

LANDSCAPING

INTERSTATE ROUTE 44
FAI PROJ I-44-1(18), Unit 3

Scale as Noted

January 1967


SHEET No. OF SHEETS

CURVE DATA

Δ	=	8° 23' 30"
$\frac{R}{2}$	=	4° 11' 45"
R	=	6,500.00'
T	=	476.86'
L _c	=	952.00'
C	=	951.15'

FED. ROAD DIST. NO.	STATE	FED. AID PROJ. NO.	FISCAL YEAR	SHEET NO.	TOTAL SHEETS
HAWAII	HAW.	I-H-1(18), UNIT 3	1966	5	35



Revised: Jan. 10, 1967

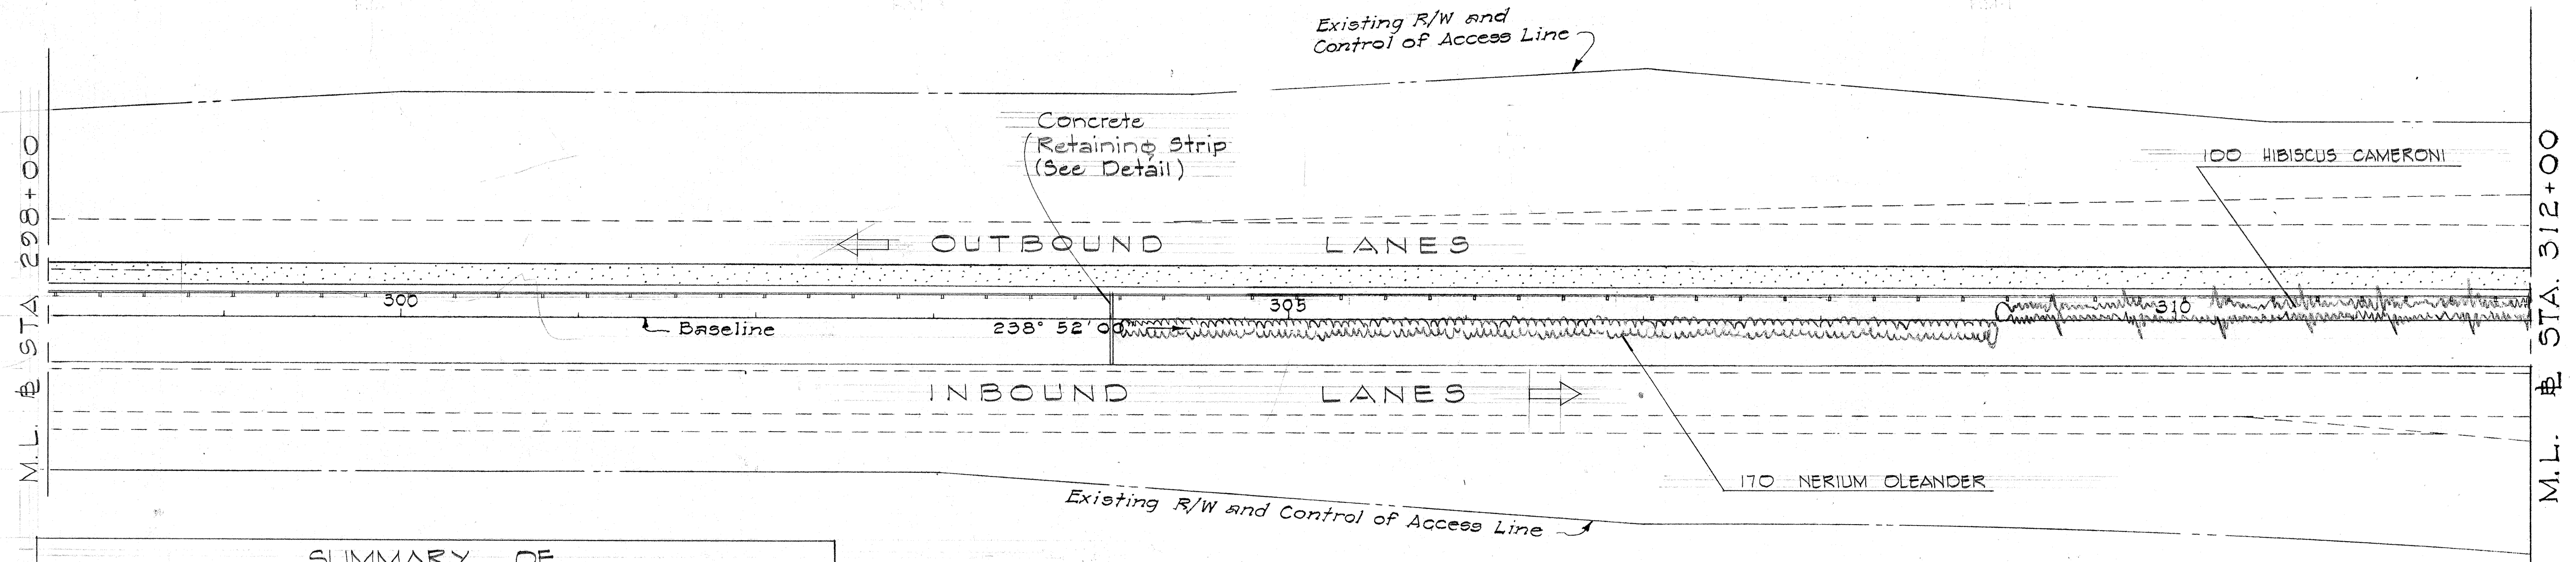

SUMMARY OF TRAFFIC SIGNS			
TYPE	DESCRIPTION	QUANTITY	
		NEW	RELOCATE
R3-10	Lane Use Control	1	
RM-12	Reflector Marker - Clear	14	
R2-1(65)1	SPEED LIMIT 65		2 X

PLANT LIST - SUMMARY				
BOTANICAL NAME	COMMON NAME	QUANTITY	CONTAINER	SIZE
Hibiscus Cameroni	Pink Hibiscus	331 340	1 gal.	24"
Nerium Oleander	Oleander	438 340	1 gal.	24"
Nerium Oleander	Oleander	100 (Transplant)		

KUNIA ROAD STA. 106+17 to 107+65
Spread coarse rock evenly in median area between concrete retaining strips. (See Detail this sheet.) No planting is required in this area.

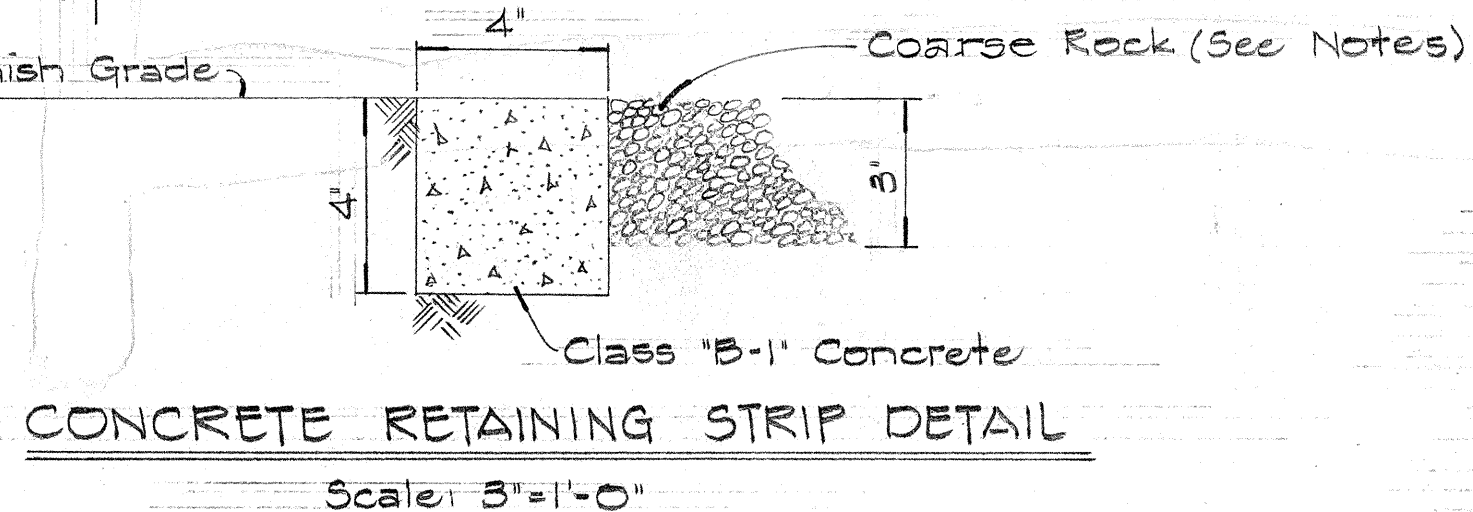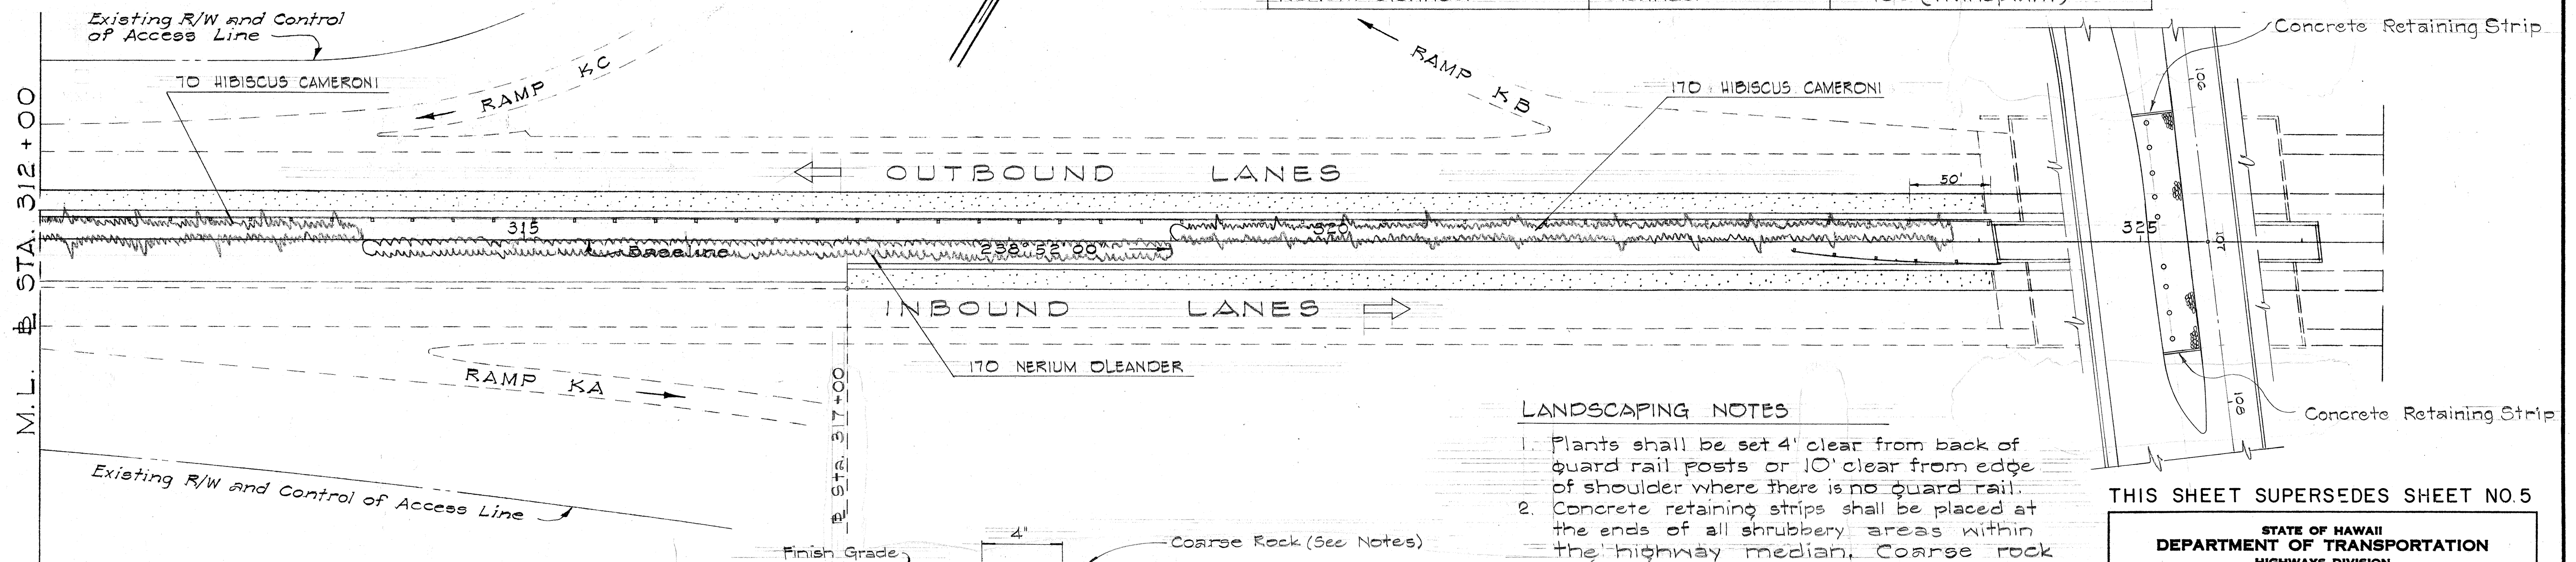

LANDSCAPING NOTES

- Plants shall be set 4' clear from back of guard rail posts or 10' clear from edge of shoulder where there is no guard rail.
- Concrete retaining strips shall be placed at the ends of all shrubbery areas within the highway median. Coarse rock shall be spread evenly on the enclosed median shrubbery areas. (See Detail This Sheet)
- The removing of existing ground for the placement of 3" coarse rock shall be paid for as Roadway Excavation. Where coarse rock is placed on new embankment, the embankment shall be constructed so that excavation will not be required for placement of the coarse rock.

THIS SHEET SUPERSEDES SHEET NO. 5

STATE OF HAWAII
DEPARTMENT OF TRANSPORTATION
HIGHWAYS DIVISION

TRAFFIC SIGNS

LANDSCAPING

INTERSTATE ROUTE H-1
F.A.I. PROJ. I-H-1(18), UNIT 3

SCALE AS NOTED JANUARY 1967

SHEET No. OF SHEETS

5

DATE	_____
SURVEY PLOTTED BY	_____
DRAWN BY	_____
TRACED BY	_____
QUANTITIES BY	_____
CHECKED BY	_____
ORIGINAL PLAN	_____
NOTE BOOK	_____
No.	_____