
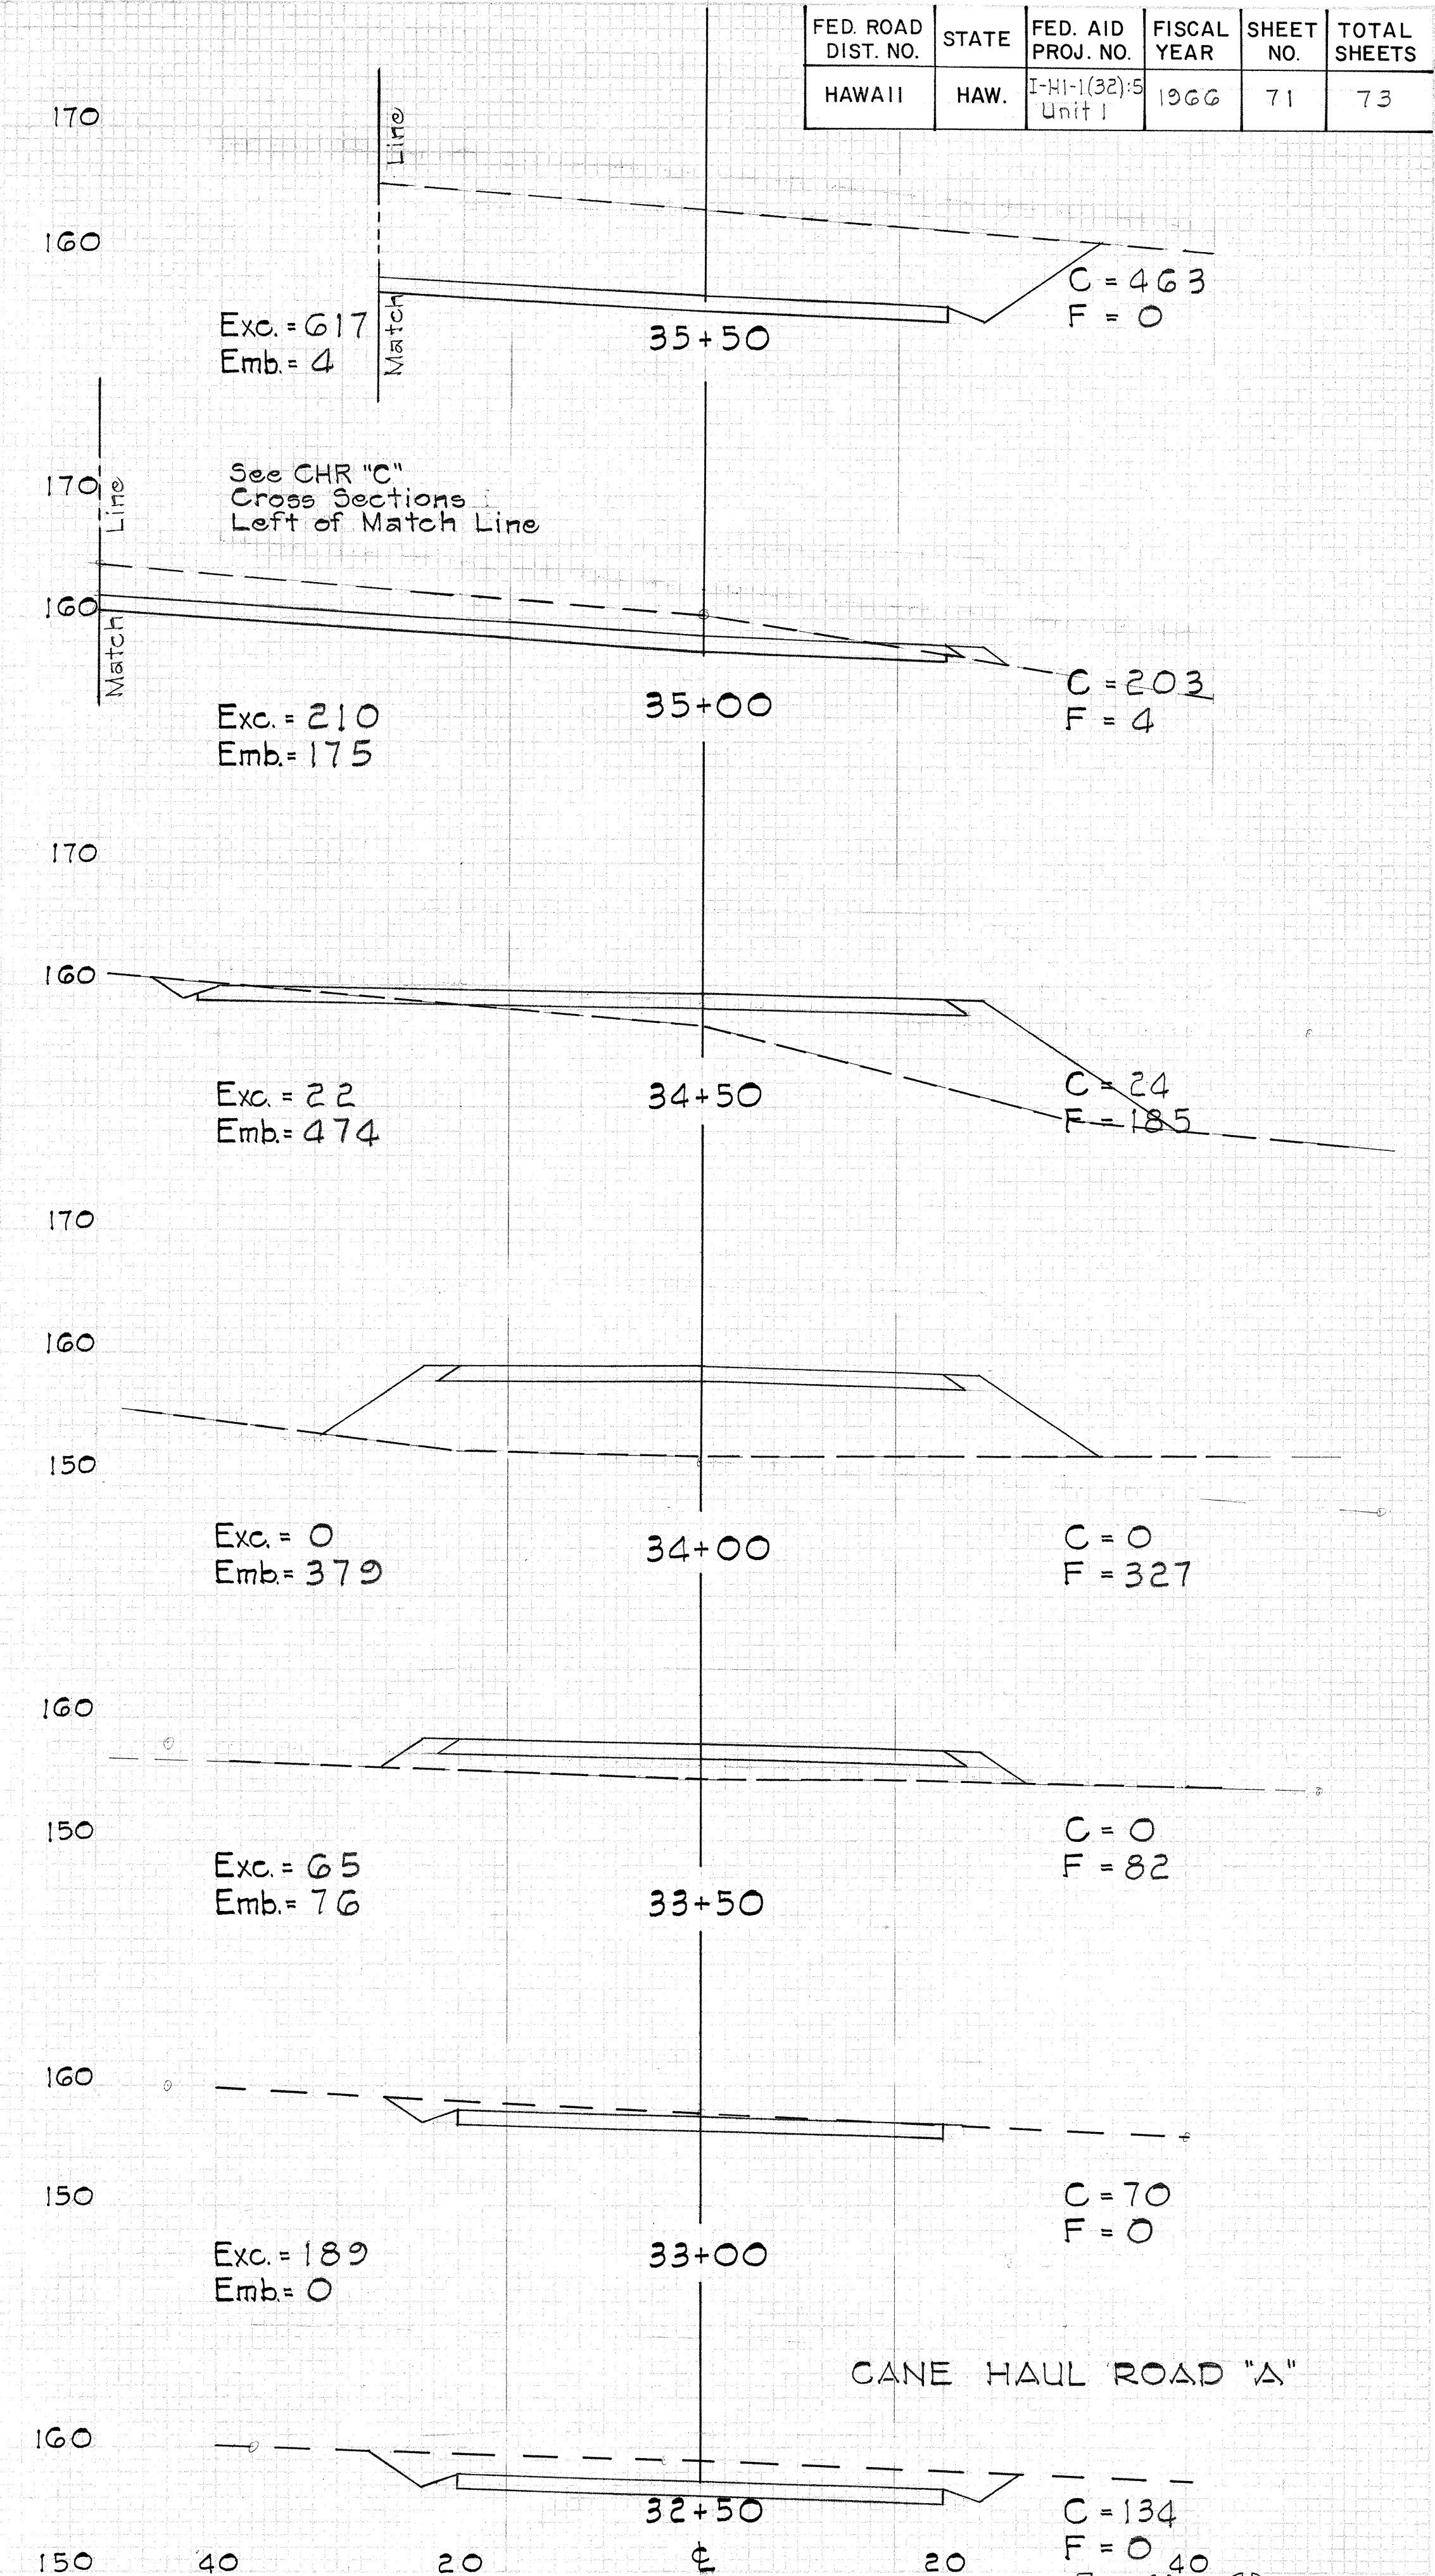
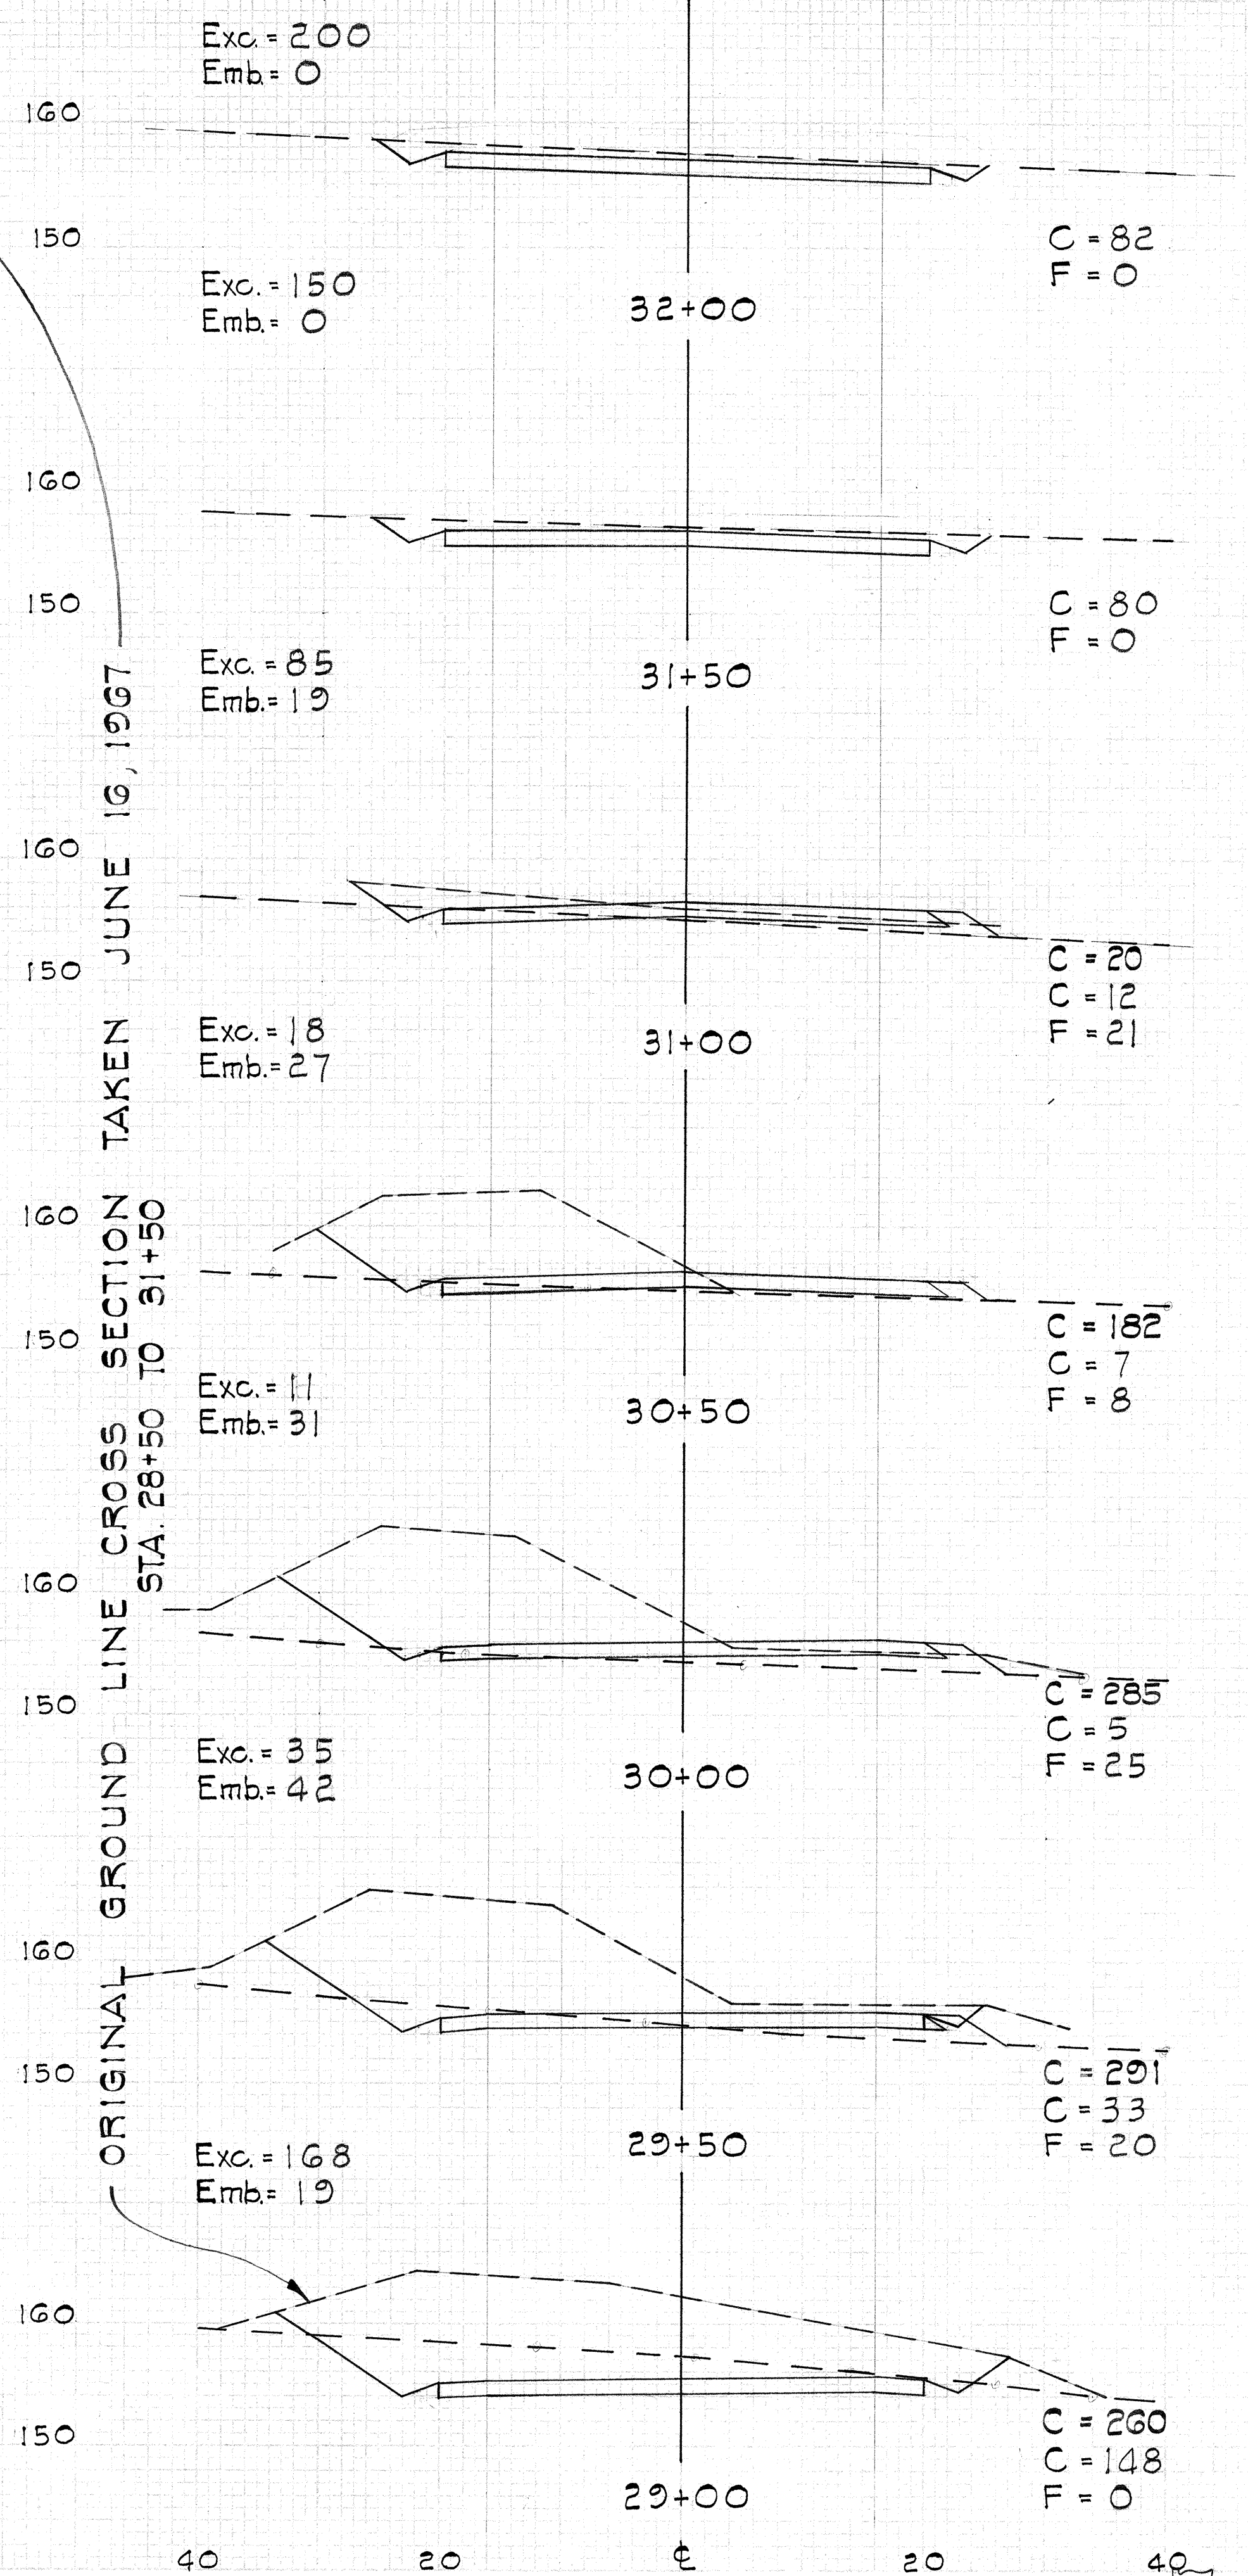


FED. ROAD DIST. NO.	STATE	FED. AID PROJ. NO.	FISCAL YEAR	SHEET NO.	TOTAL SHEETS
HAWAII	HAW.	I-41-1(32):5 Unit 1	1966	71	73

DATE	
BY	
CHECKED	
APPROVED	




DATE	
BY	
CHECKED	
APPROVED	

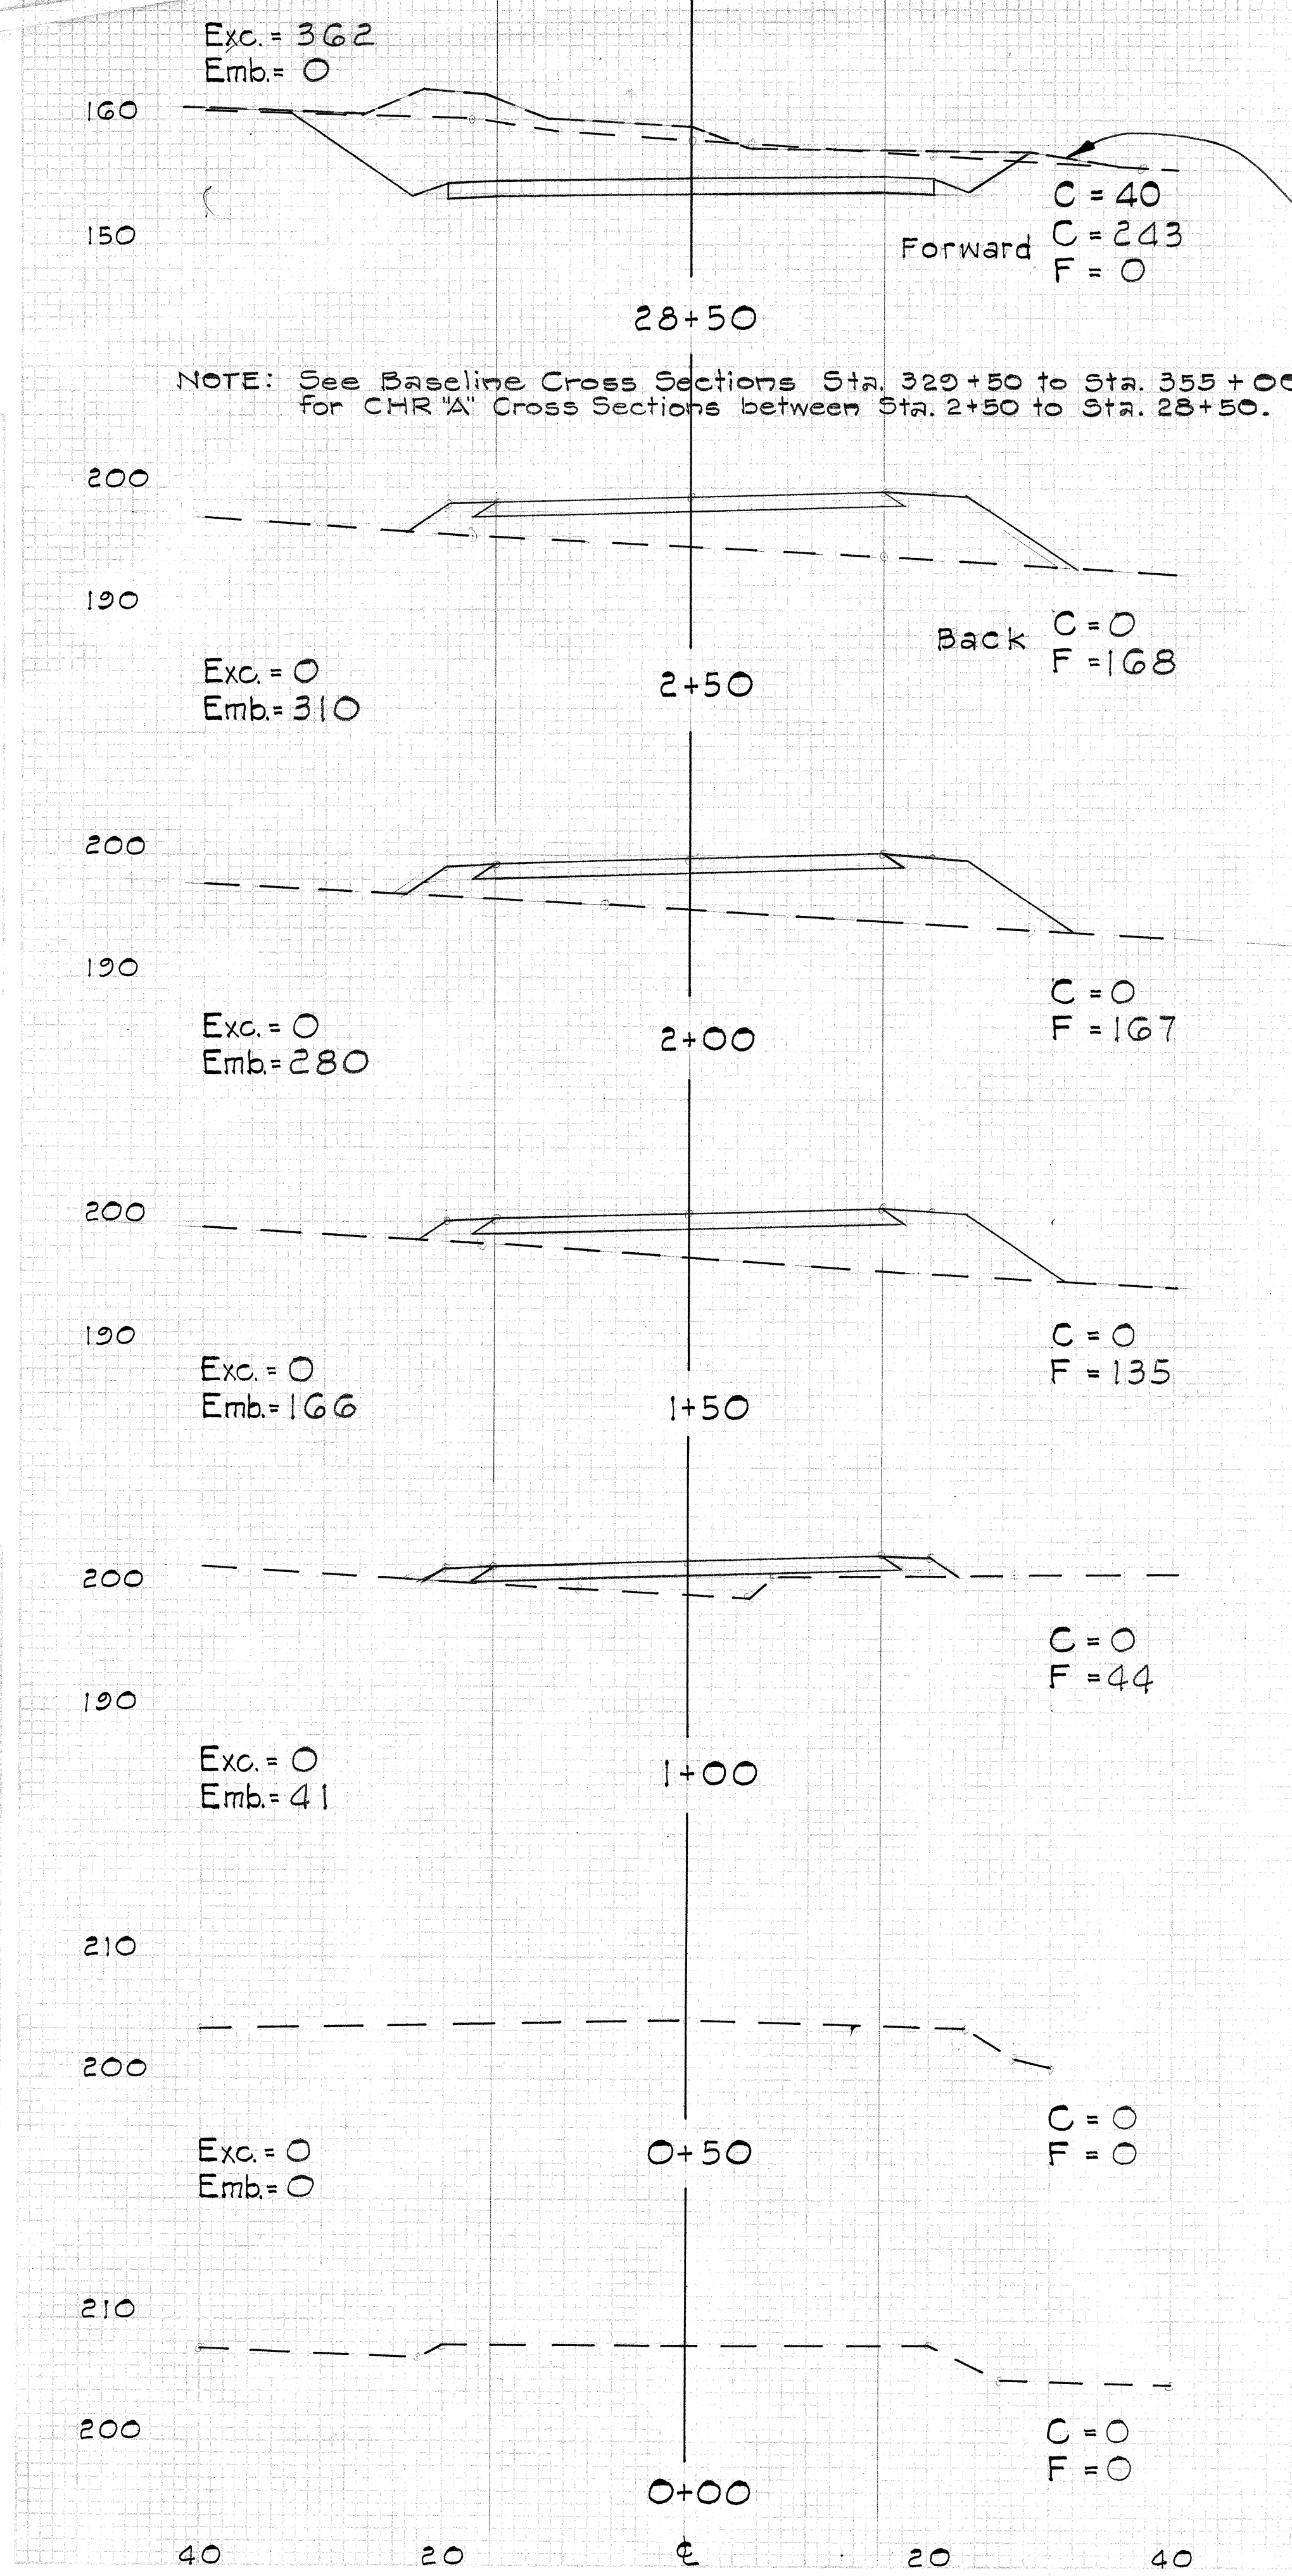

FINAL
SURVEY
DATE
BY
CHECKED
DATE
BY

ORIGINAL
SURVEY
DATE
BY
CHECKED
DATE
BY

FED. ROAD DIST. NO.	STATE	FED. AID PROJ. NO.	FISCAL YEAR	SHEET NO.	TOTAL SHEETS
HAWAII	HAW.	I-HI-1(32)3 Unit 1	1966	73	73

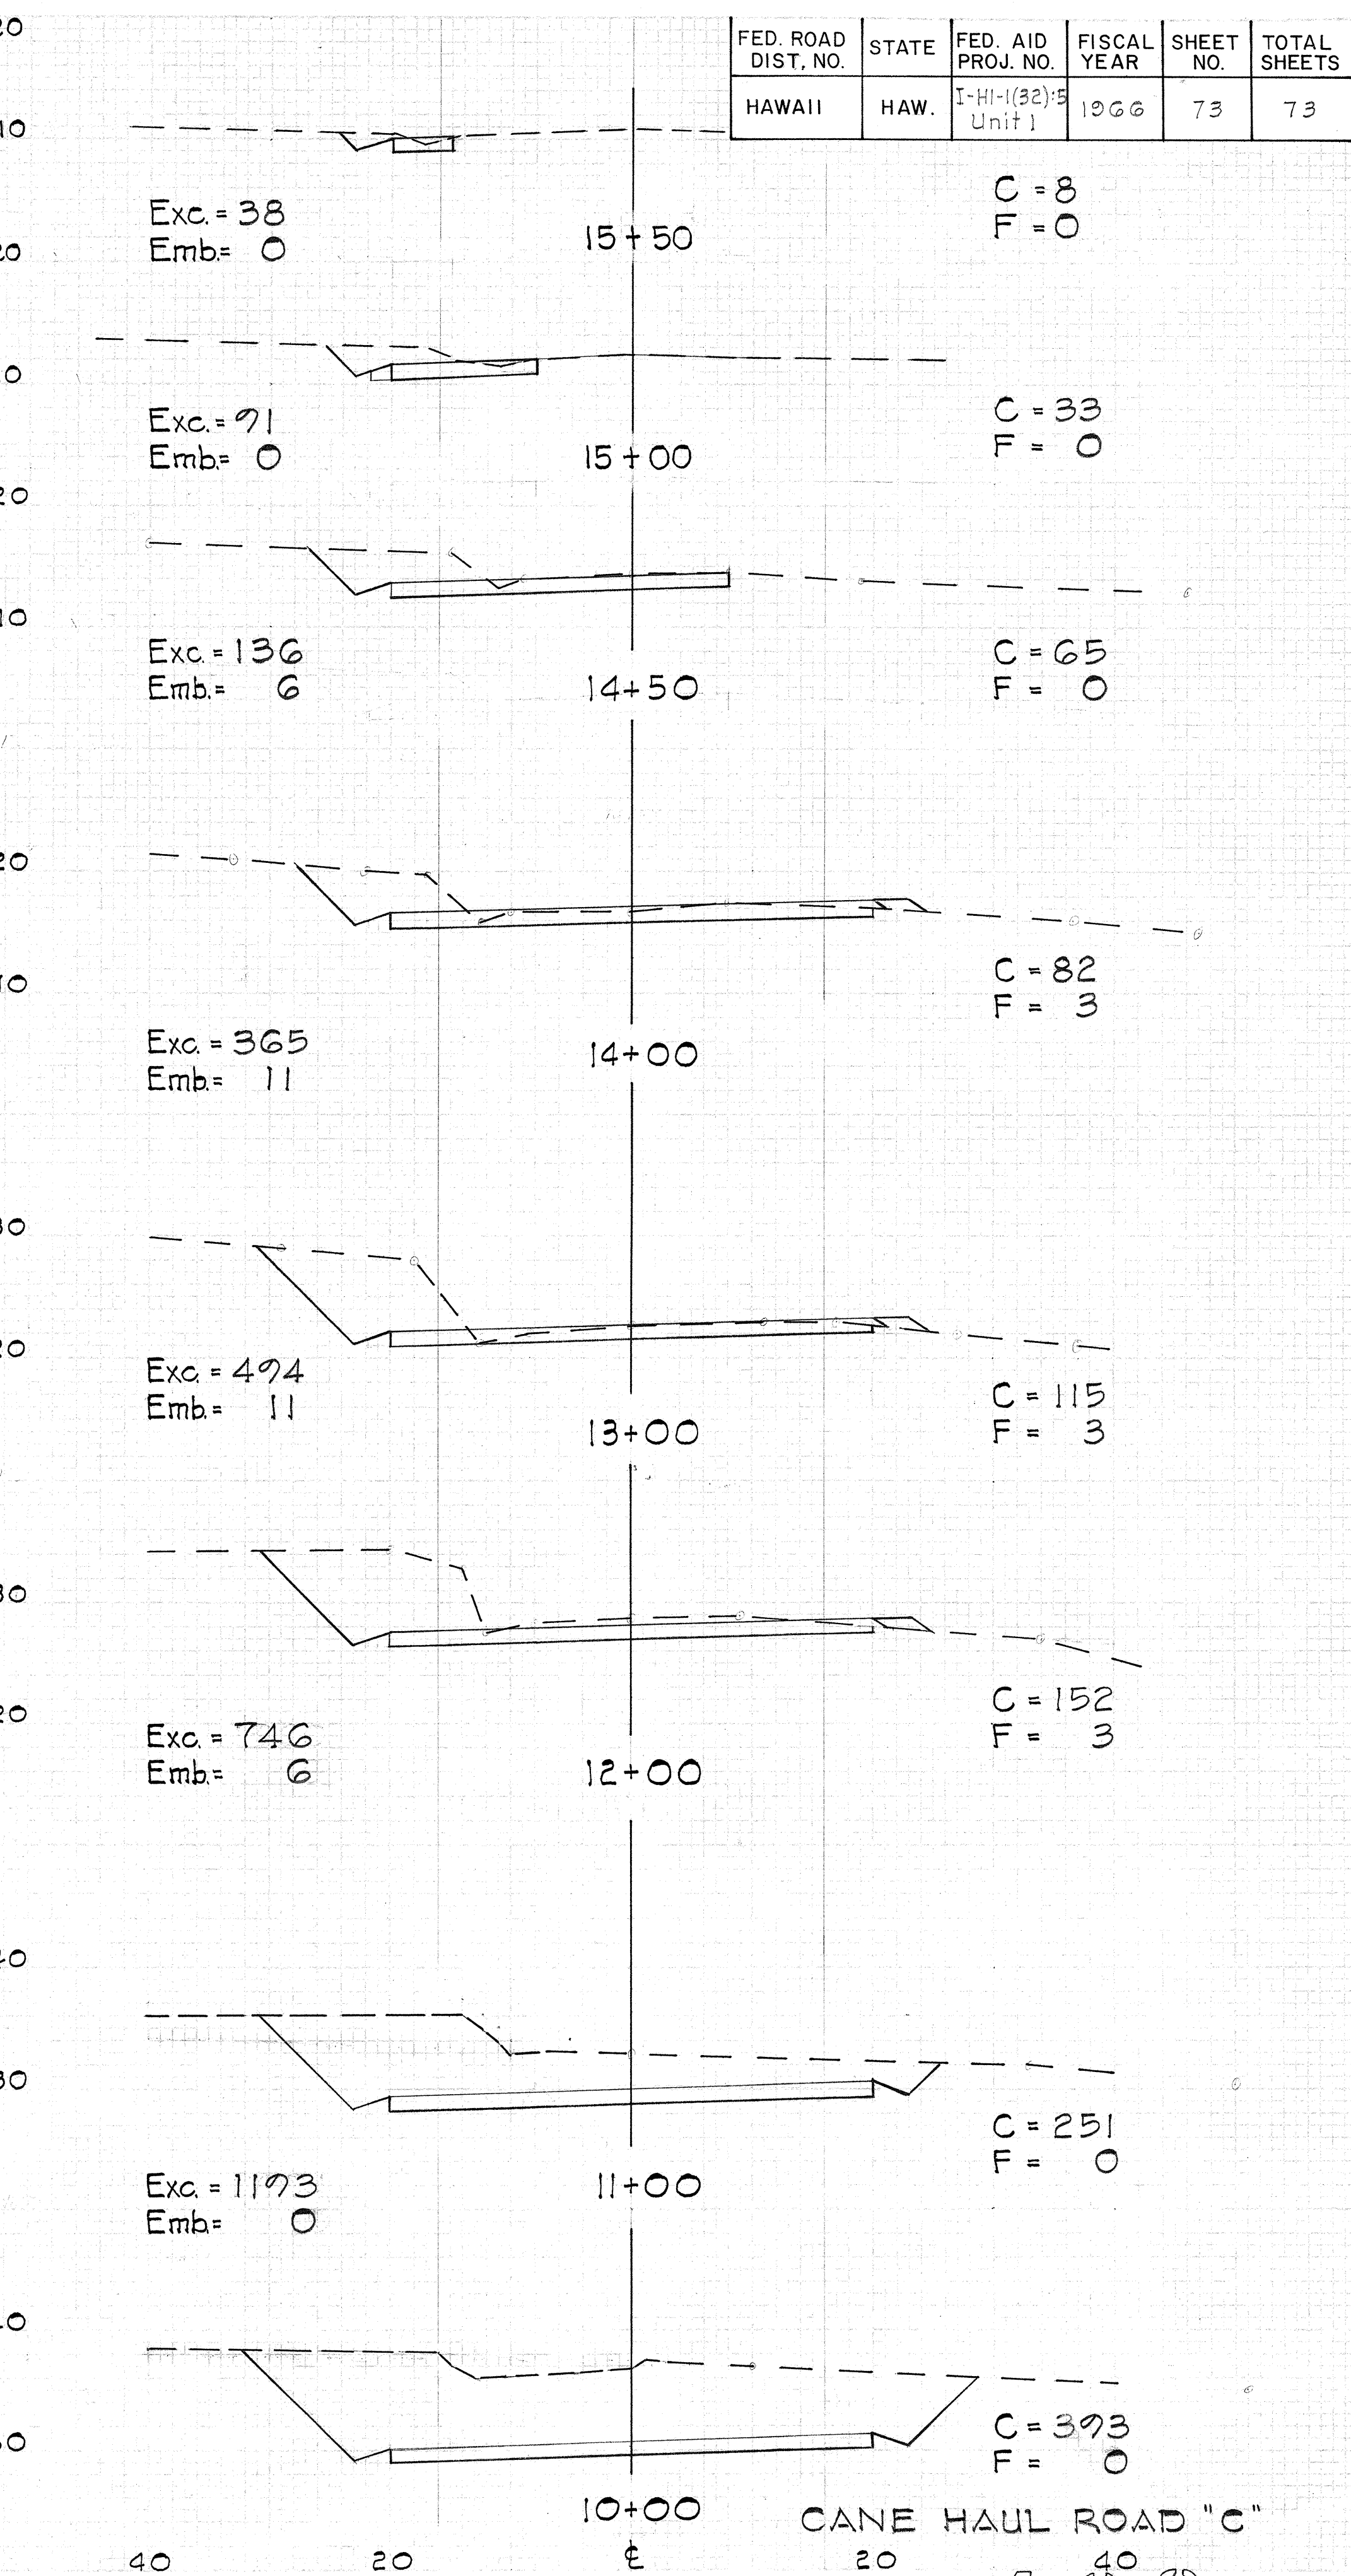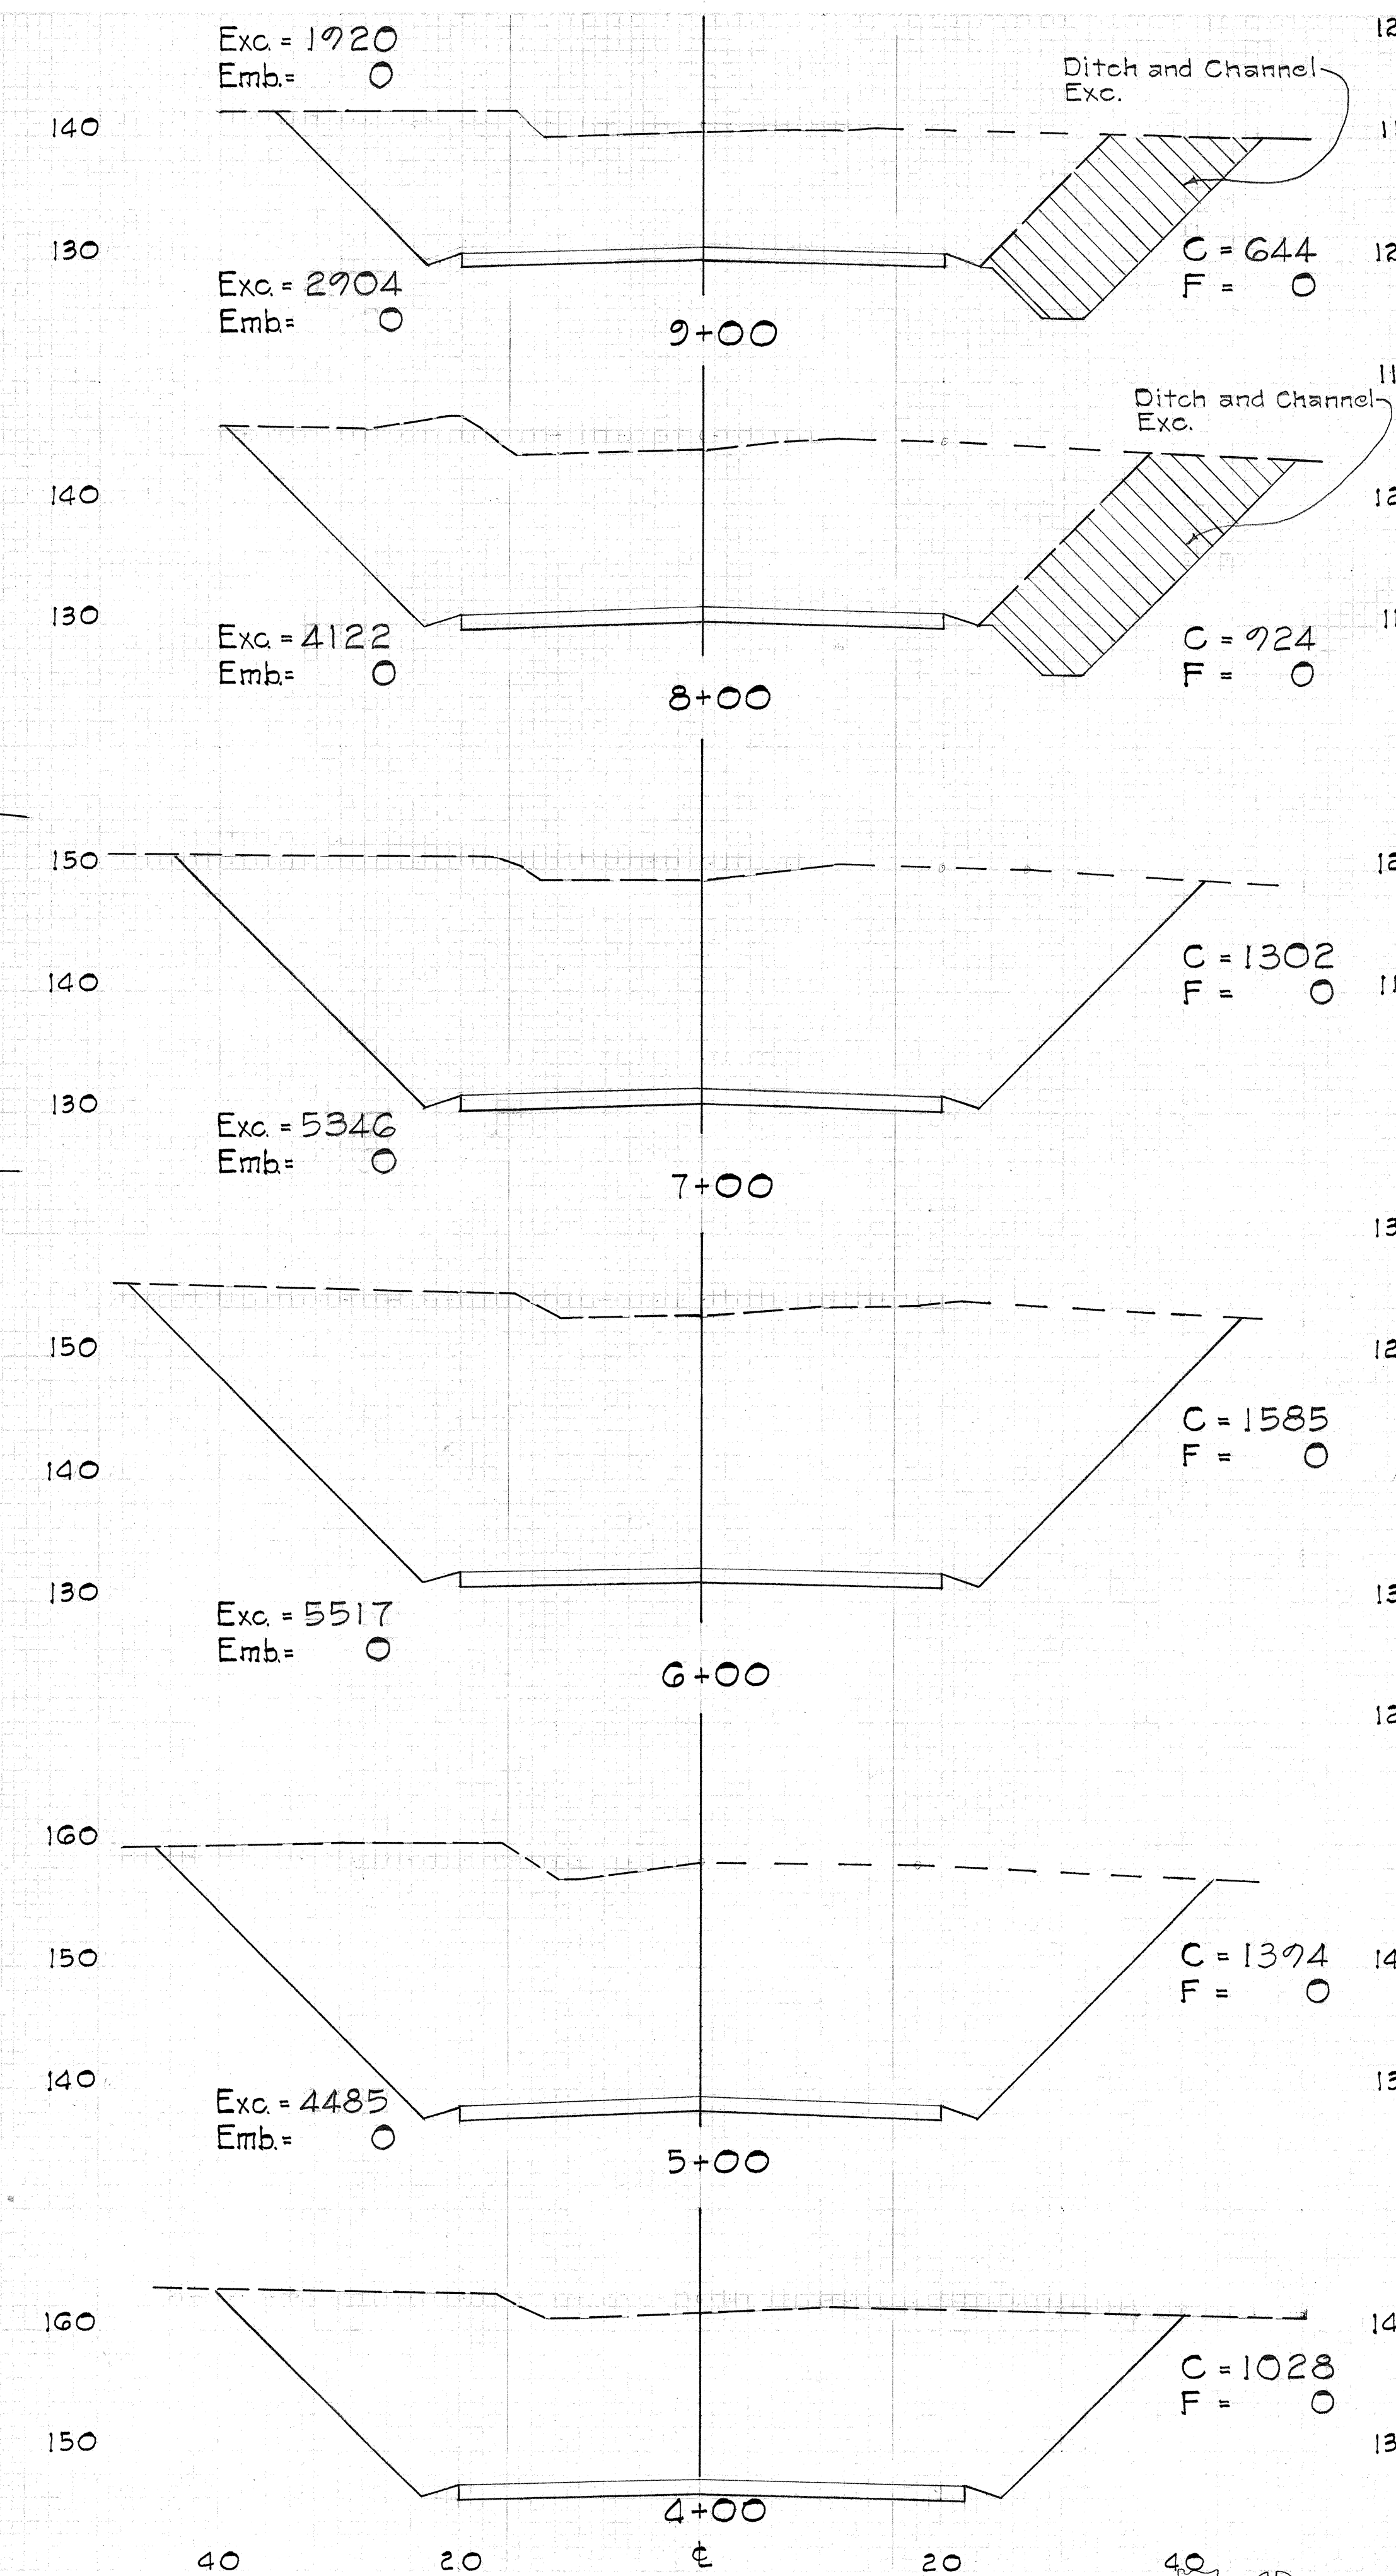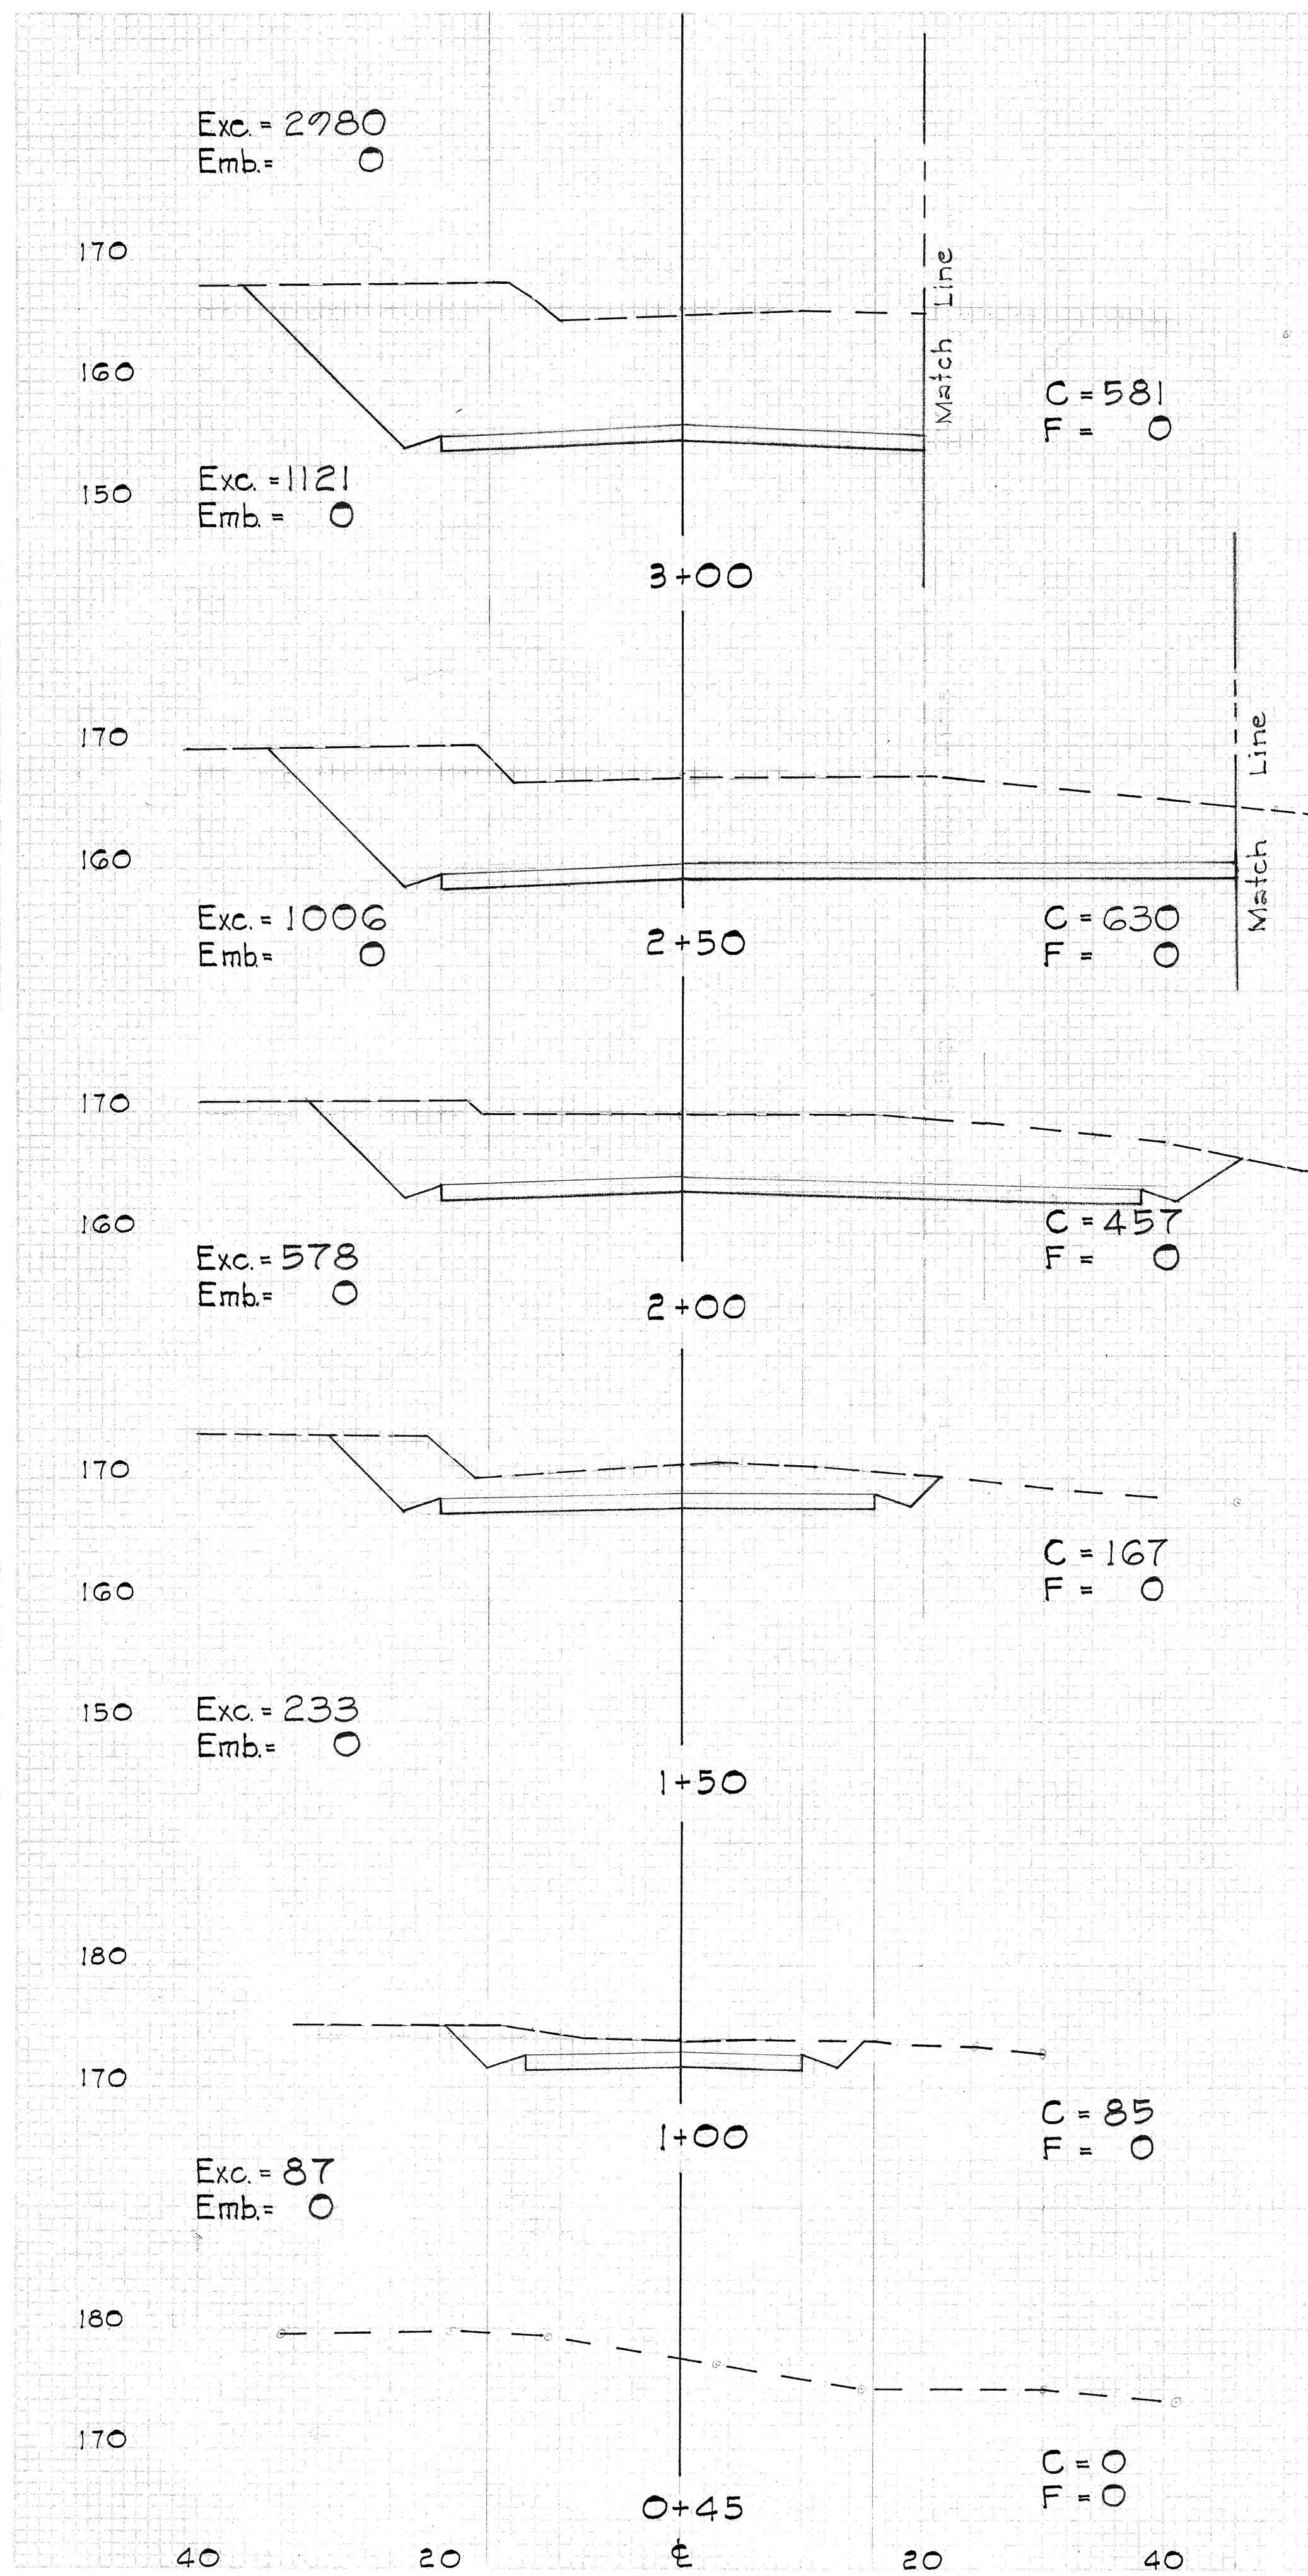

CANE HAUL ROAD "C"

108