


FED. ROAD DIST. NO.	STATE	FED. AID PROJ. NO.	FISCAL YEAR	SHEET NO.	TOTAL SHEETS
HAWAII	HAW.	141-32-5	1966	13	73
Unit 1					

REVISED: Jan. 24, 1967

TRUE NORTH
Scale: 1"=50'

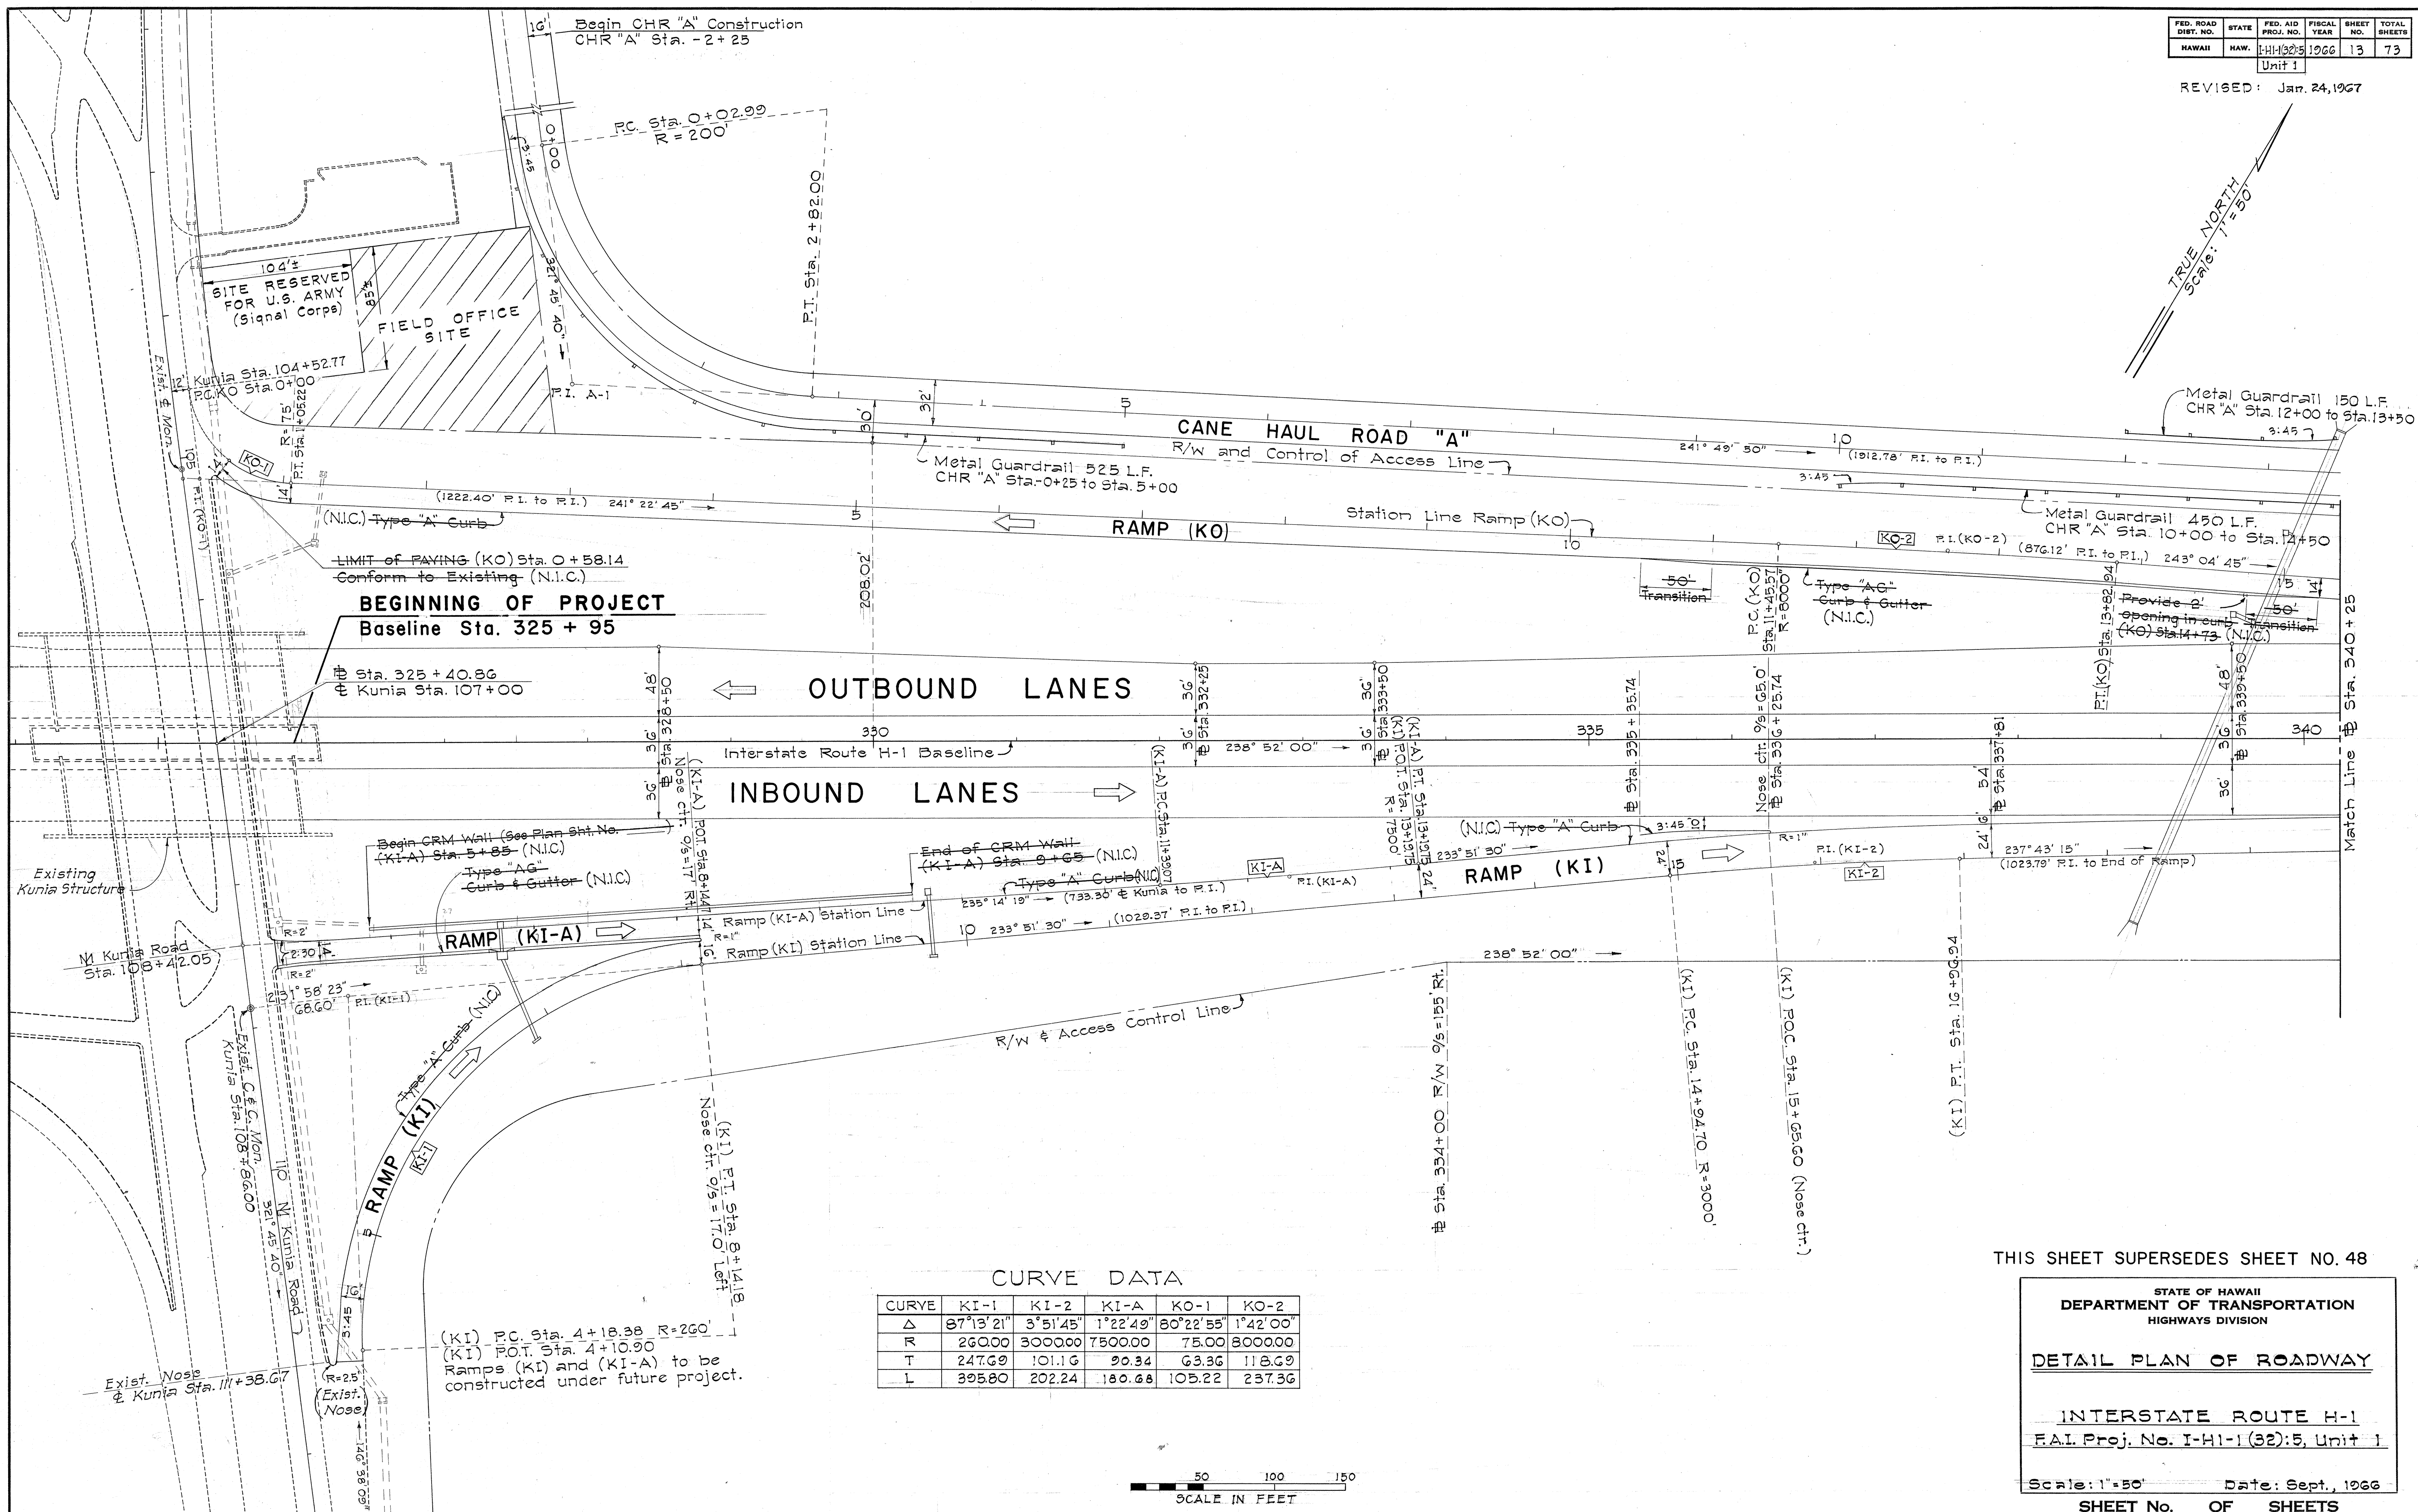

THIS SHEET SUPERSEDES SHEET NO. 48

STATE OF HAWAII
DEPARTMENT OF TRANSPORTATION
HIGHWAYS DIVISION

DETAIL PLAN OF ROADWAY

INTERSTATE ROUTE H-1
F.A.I. Proj. No. I-H-1 (32):5, Unit 1

Scale: 1"=50' Date: Sept., 1966

SHEET NO. OF SHEETS

50 100 150
SCALE IN FEET



CO 13

CO 48

FED. ROAD DIST. NO.	STATE	FED. AID PROJ. NO.	FISCAL YEAR	SHEET NO.	TOTAL SHEETS
HAWAII	HAW.	FAI-101	1966	14	73

CURVE DATA

B-1	CURVE	A-2	A-3	B-1	B-2	B-3	B-4
27°30'	Δ	2°57'50"	54°00'00"	22°30'00"	54°45'55"	127°44'23"	0°27'32"
350.00'	R	4500.00'	300.00'	350.00'	200.00'	100.00'	4484.00'
85.64'	T	116.42'	152.86'	82.41'	103.59'	203.85'	17.96'
167.99'	L	232.78'	282.74'	161.88'	191.17'	222.95'	35.91'

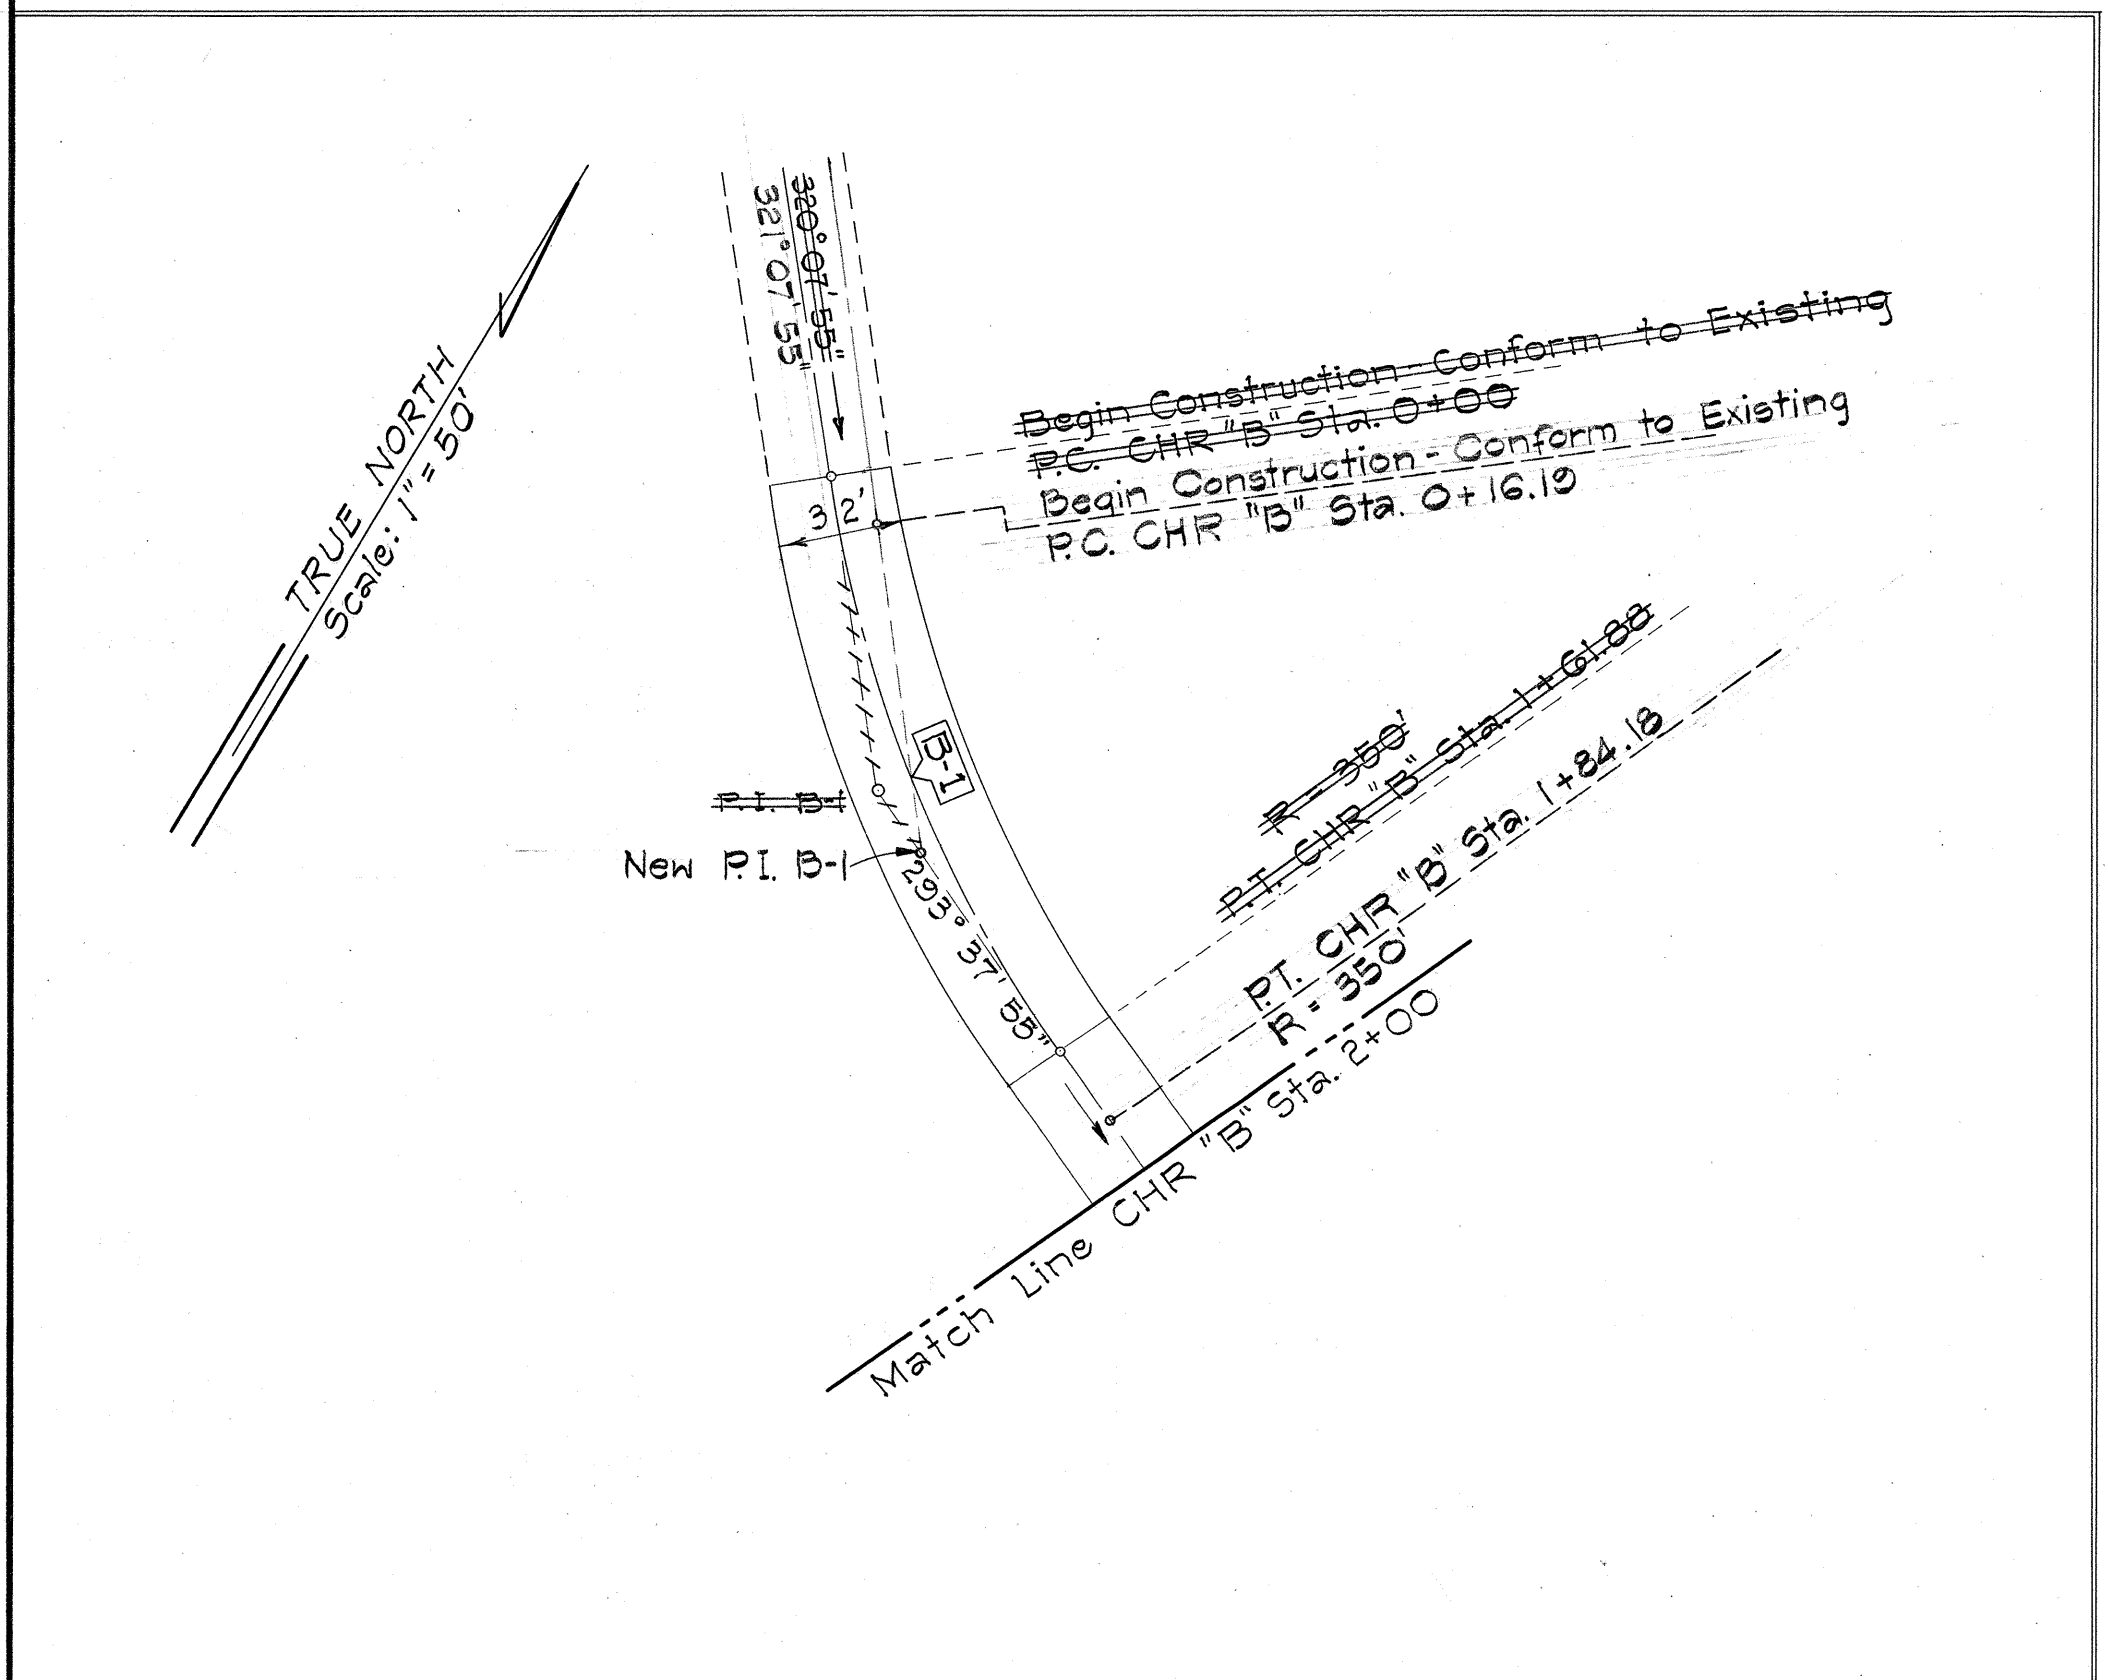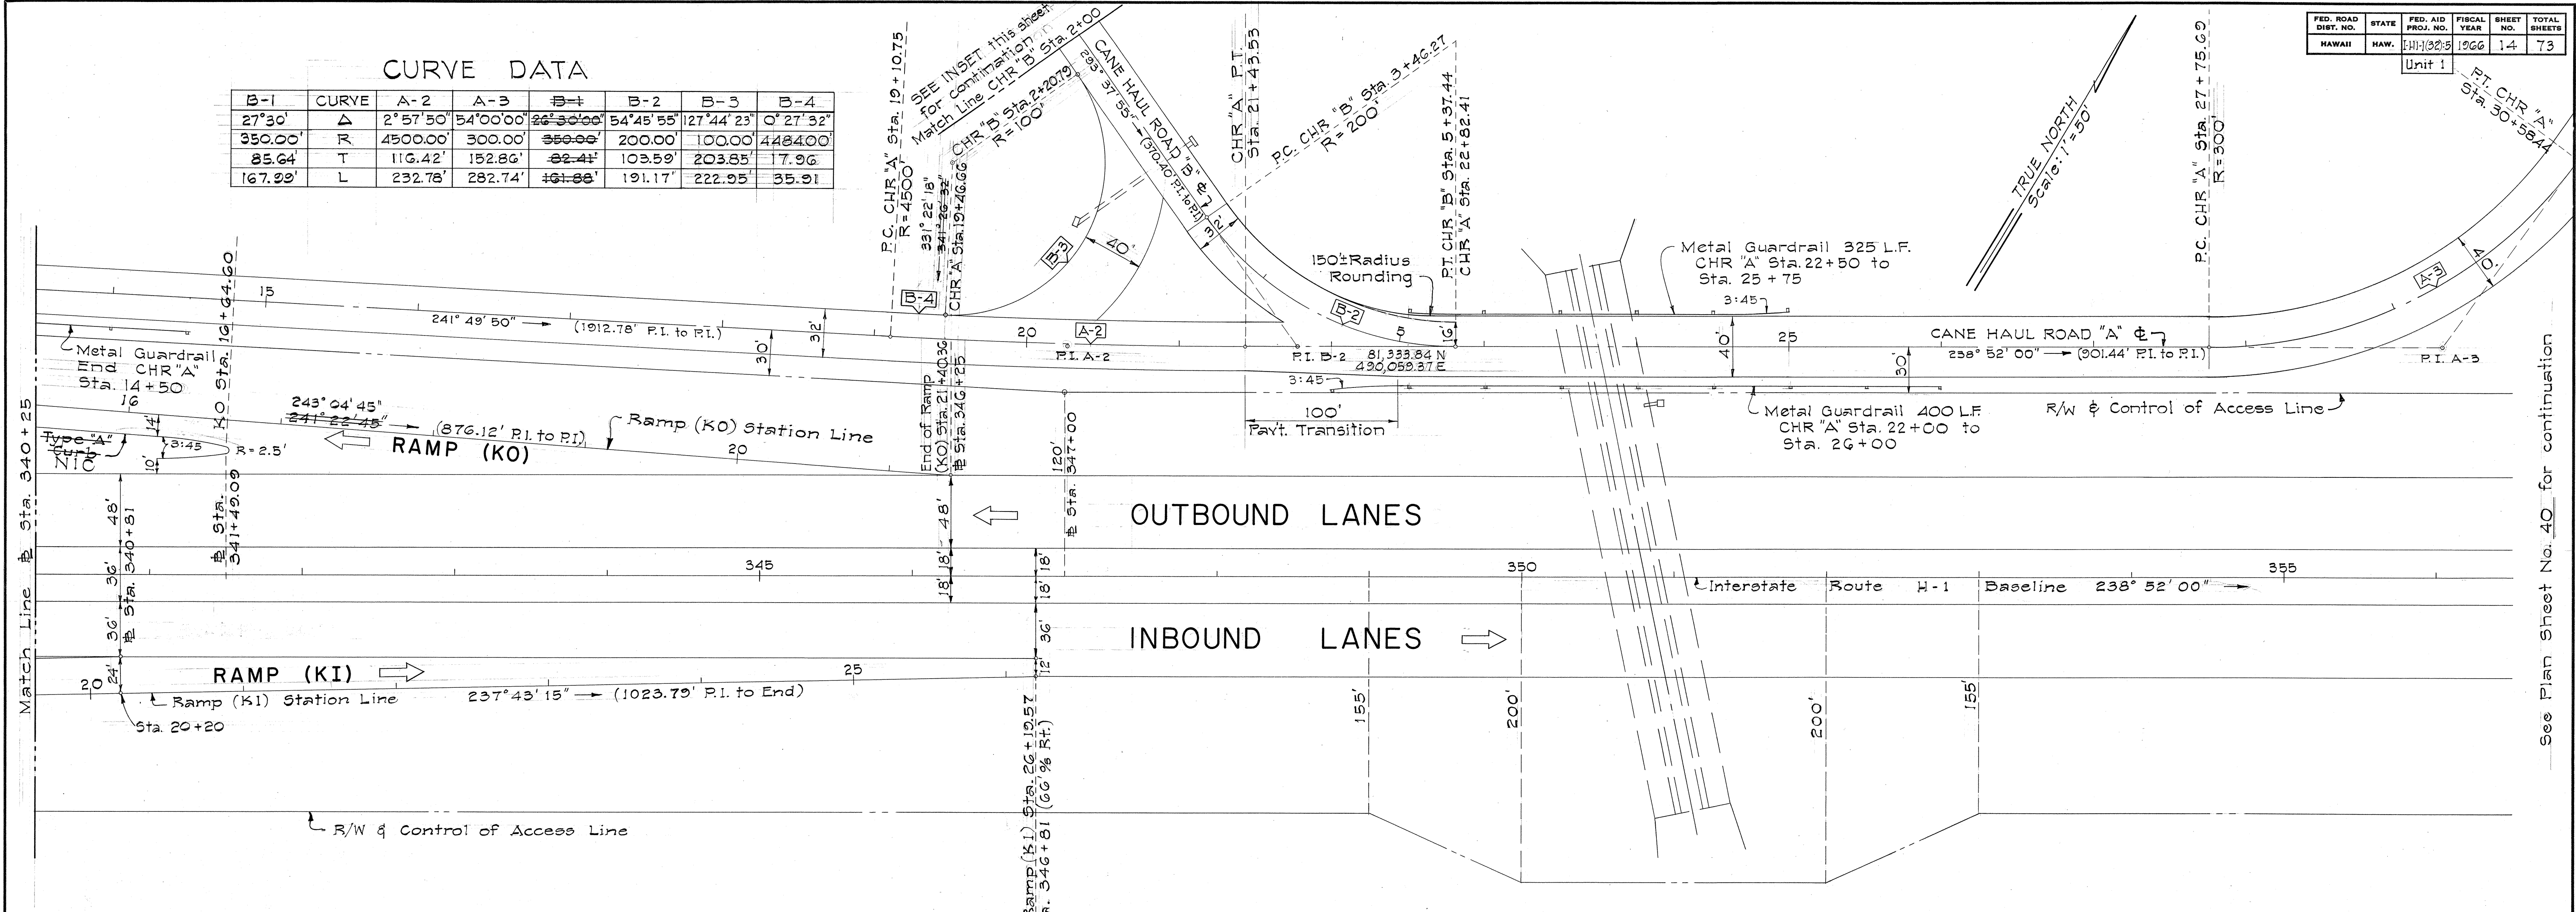

ORIGINAL PLAN	DATE
DRAWN BY	
TRACED BY	
NOTED BY	
CHECKED BY	

STATE OF HAWAII
DEPARTMENT OF TRANSPORTATION
HIGHWAYS DIVISION

DETAIL PLAN OF ROADWAY

INTERSTATE ROUTE H-1
F.A.I. Proj. No. I-H1-1 (32):5, Unit 1

Scale: 1" = 50' Date: Sept., 1966

SHEET No. OF SHEETS