


Revised: Jan. 24, 1967

Sta. 330+00 to 338+00±
Construct Earth Ditch along CHR "A".
For detail see sht. no. D-4
ESTIMATED QUANTITIES 1041.0 cy.
Ditch & Channel Excavation ~~1340.0 cy.~~

Sta. 339+50 ± Lt. 87'±
Construct Type "B" C.D.I.
Install 24" CGMP, 14 Ga.
For detail see sht. no. D-4
ESTIMATED QUANTITIES 24.33
Structure Excavation ~~24.0~~ cy.
Class B-1 Concrete 2.18 ~~2.1~~ cy.
24" Pipe Culvert 16.0 ~~15.8~~ L.F.

Ramp KO Sta. 14+99 ± Lt.
Construct: Type "A" C.D.I.
Install: 24" CGMP, 14 Ga.
For detail see sht. no. D-4
ESTIMATED QUANTITIES
Struct. Exc. 8.32 ~~2.0~~ cy.
Class B-1 Conc. 1.79 ~~1.2~~ cy.
24" Pipe Culvert 3.7 ~~4.0~~ L.F.

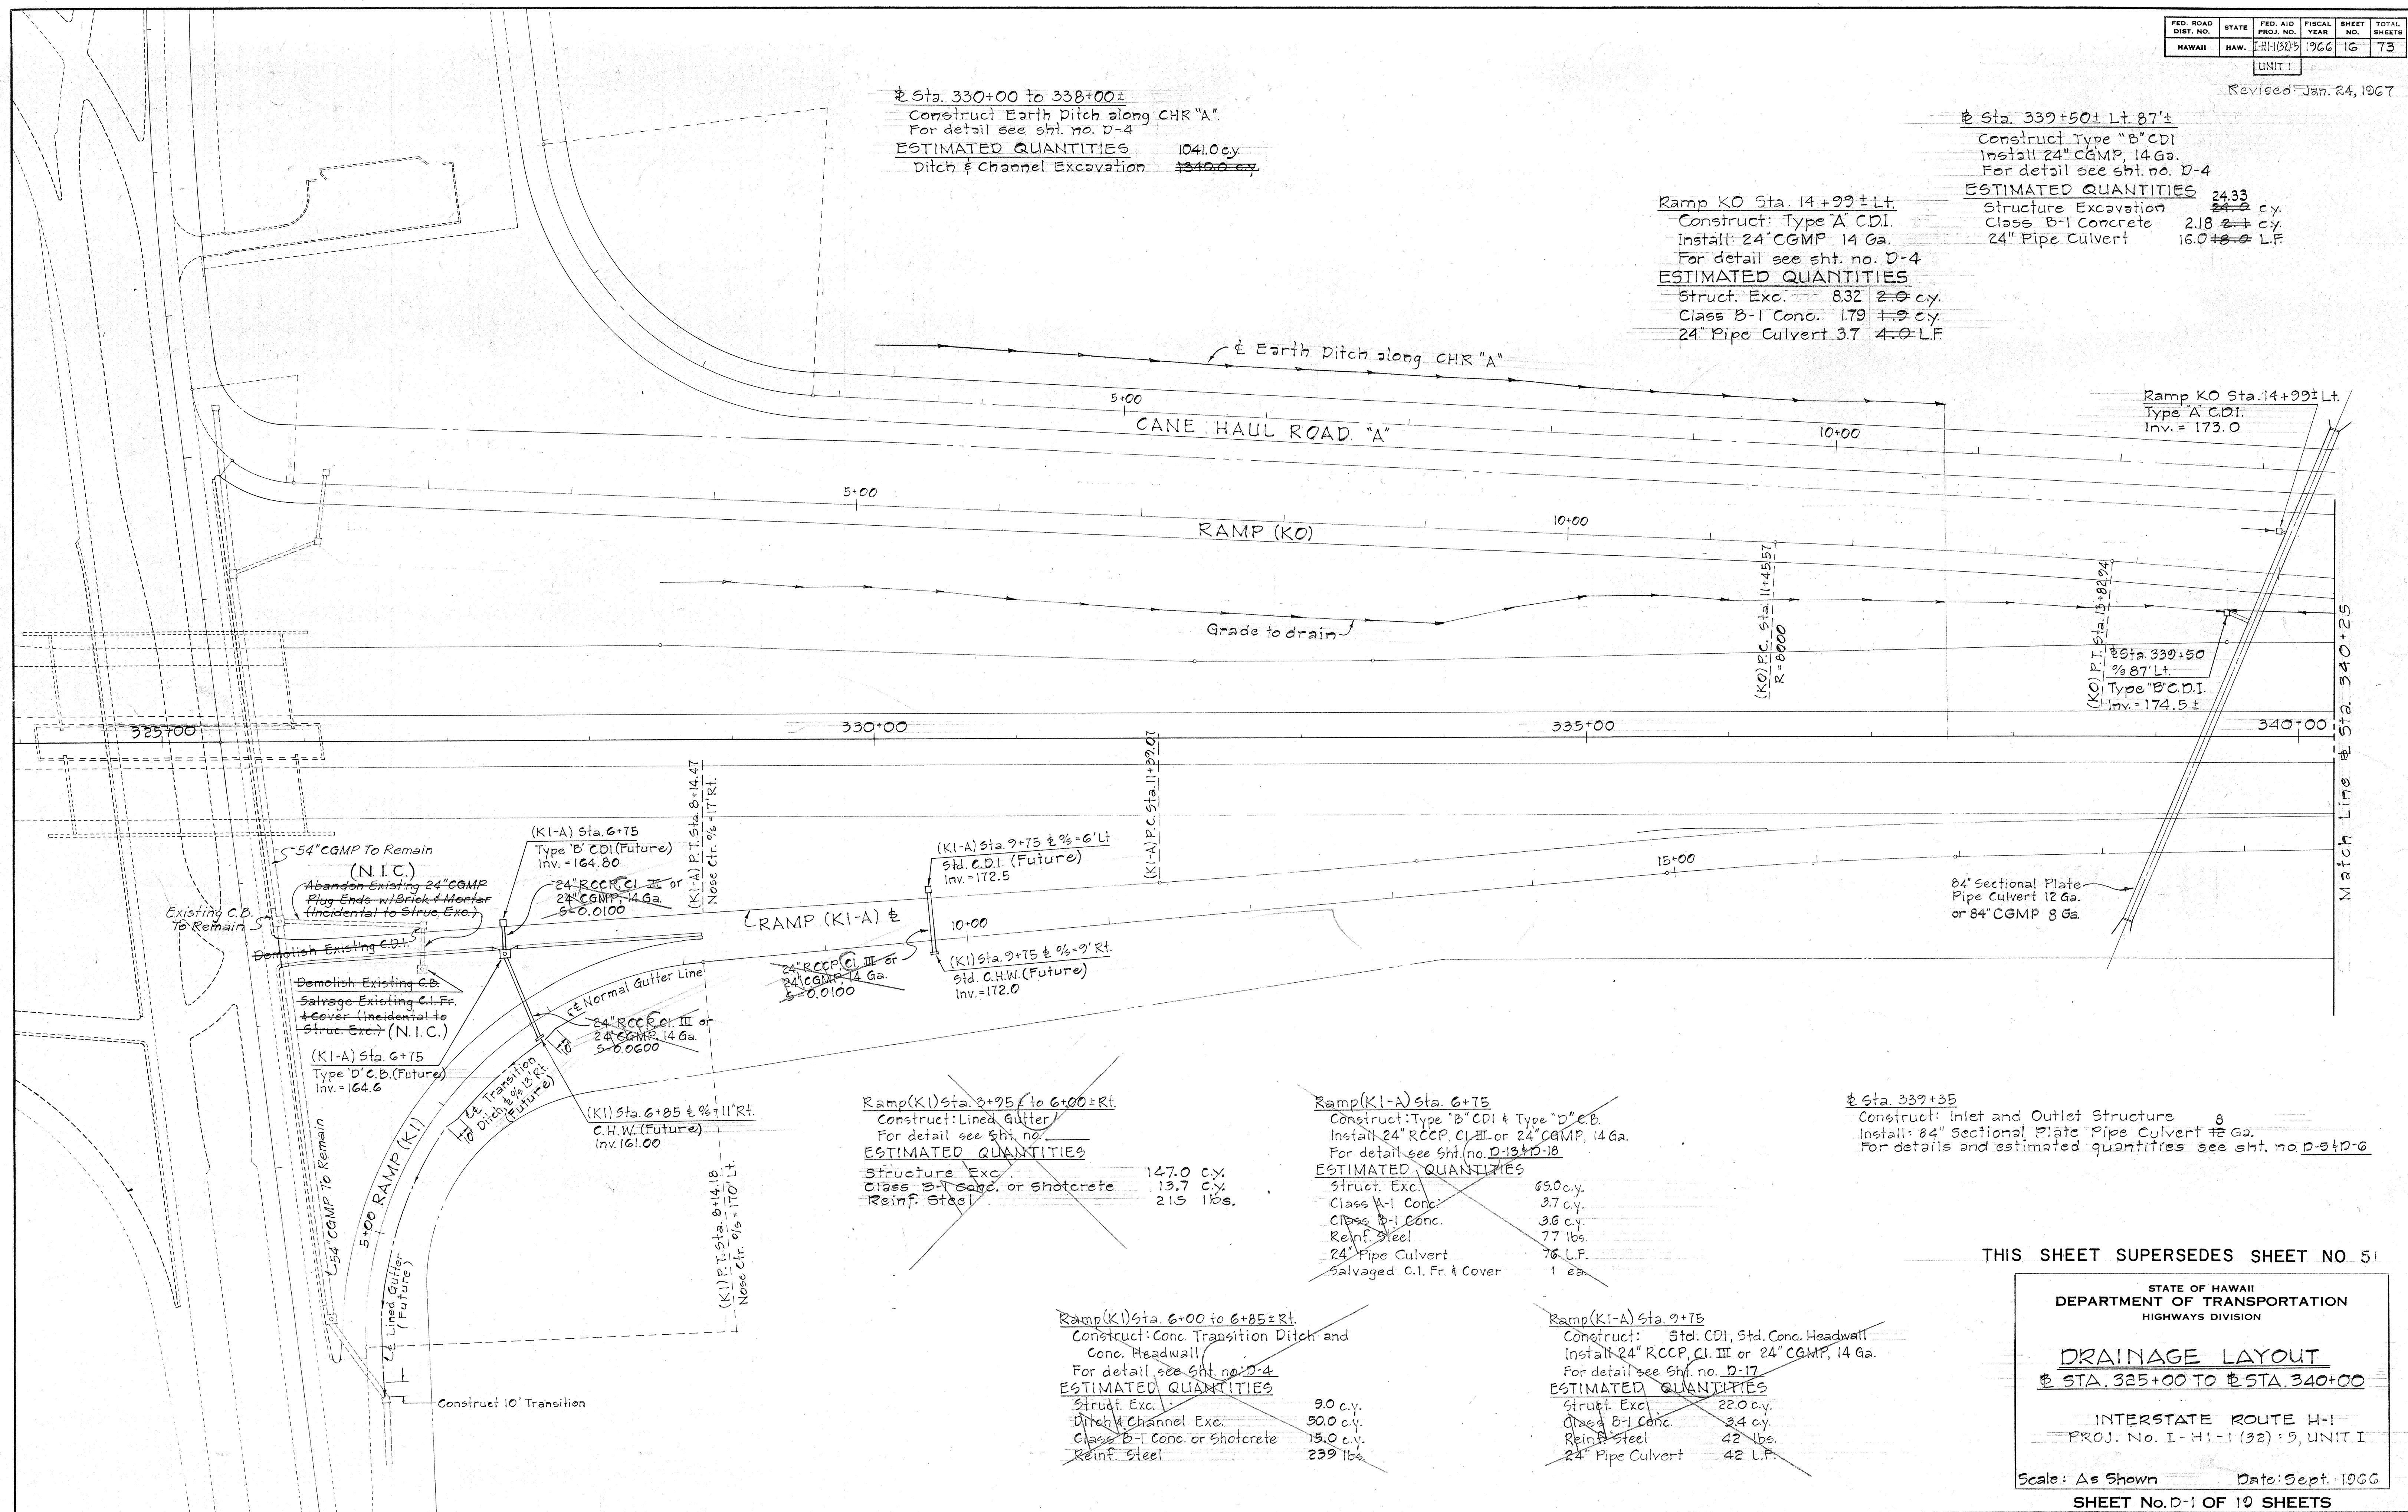

THIS SHEET SUPERSEDES SHEET NO. 51

STATE OF HAWAII
DEPARTMENT OF TRANSPORTATION
HIGHWAYS DIVISION

DRAINAGE LAYOUT
Sta. 325+00 TO Sta. 340+00

INTERSTATE ROUTE H-1
PROJ. No. I-H-1-1 (32) 5, UNIT I

Scale: As Shown Date: Sept. 1966

SHEET No. D-1 OF 10 SHEETS

C. O. 16



C. O. 51

FED. ROAD DIST. NO.	STATE	FED. AID PROJ. NO.	FISCAL YEAR	SHEET NO.	TOTAL SHEETS
HAWAII	HAW.	1-H1-1(32)-5	1966	17	73

Revised: Jan. 24, 1967

CURVE DATA

CURVE	A-2	A-3	B-1	B-2	B-3	B-4
Δ	2° 57' 50"	54° 00' 00"	26° 30' 00"	54° 45' 55"	127° 44' 23"	0° 27' 32"
R	4500.00'	300.00'	350.00'	200.00'	100.00'	4484.00'
T	116.42'	152.86'	82.41'	103.59'	203.85'	17.96'
L	232.78'	282.74'	161.88'	191.17'	222.95'	35.91'

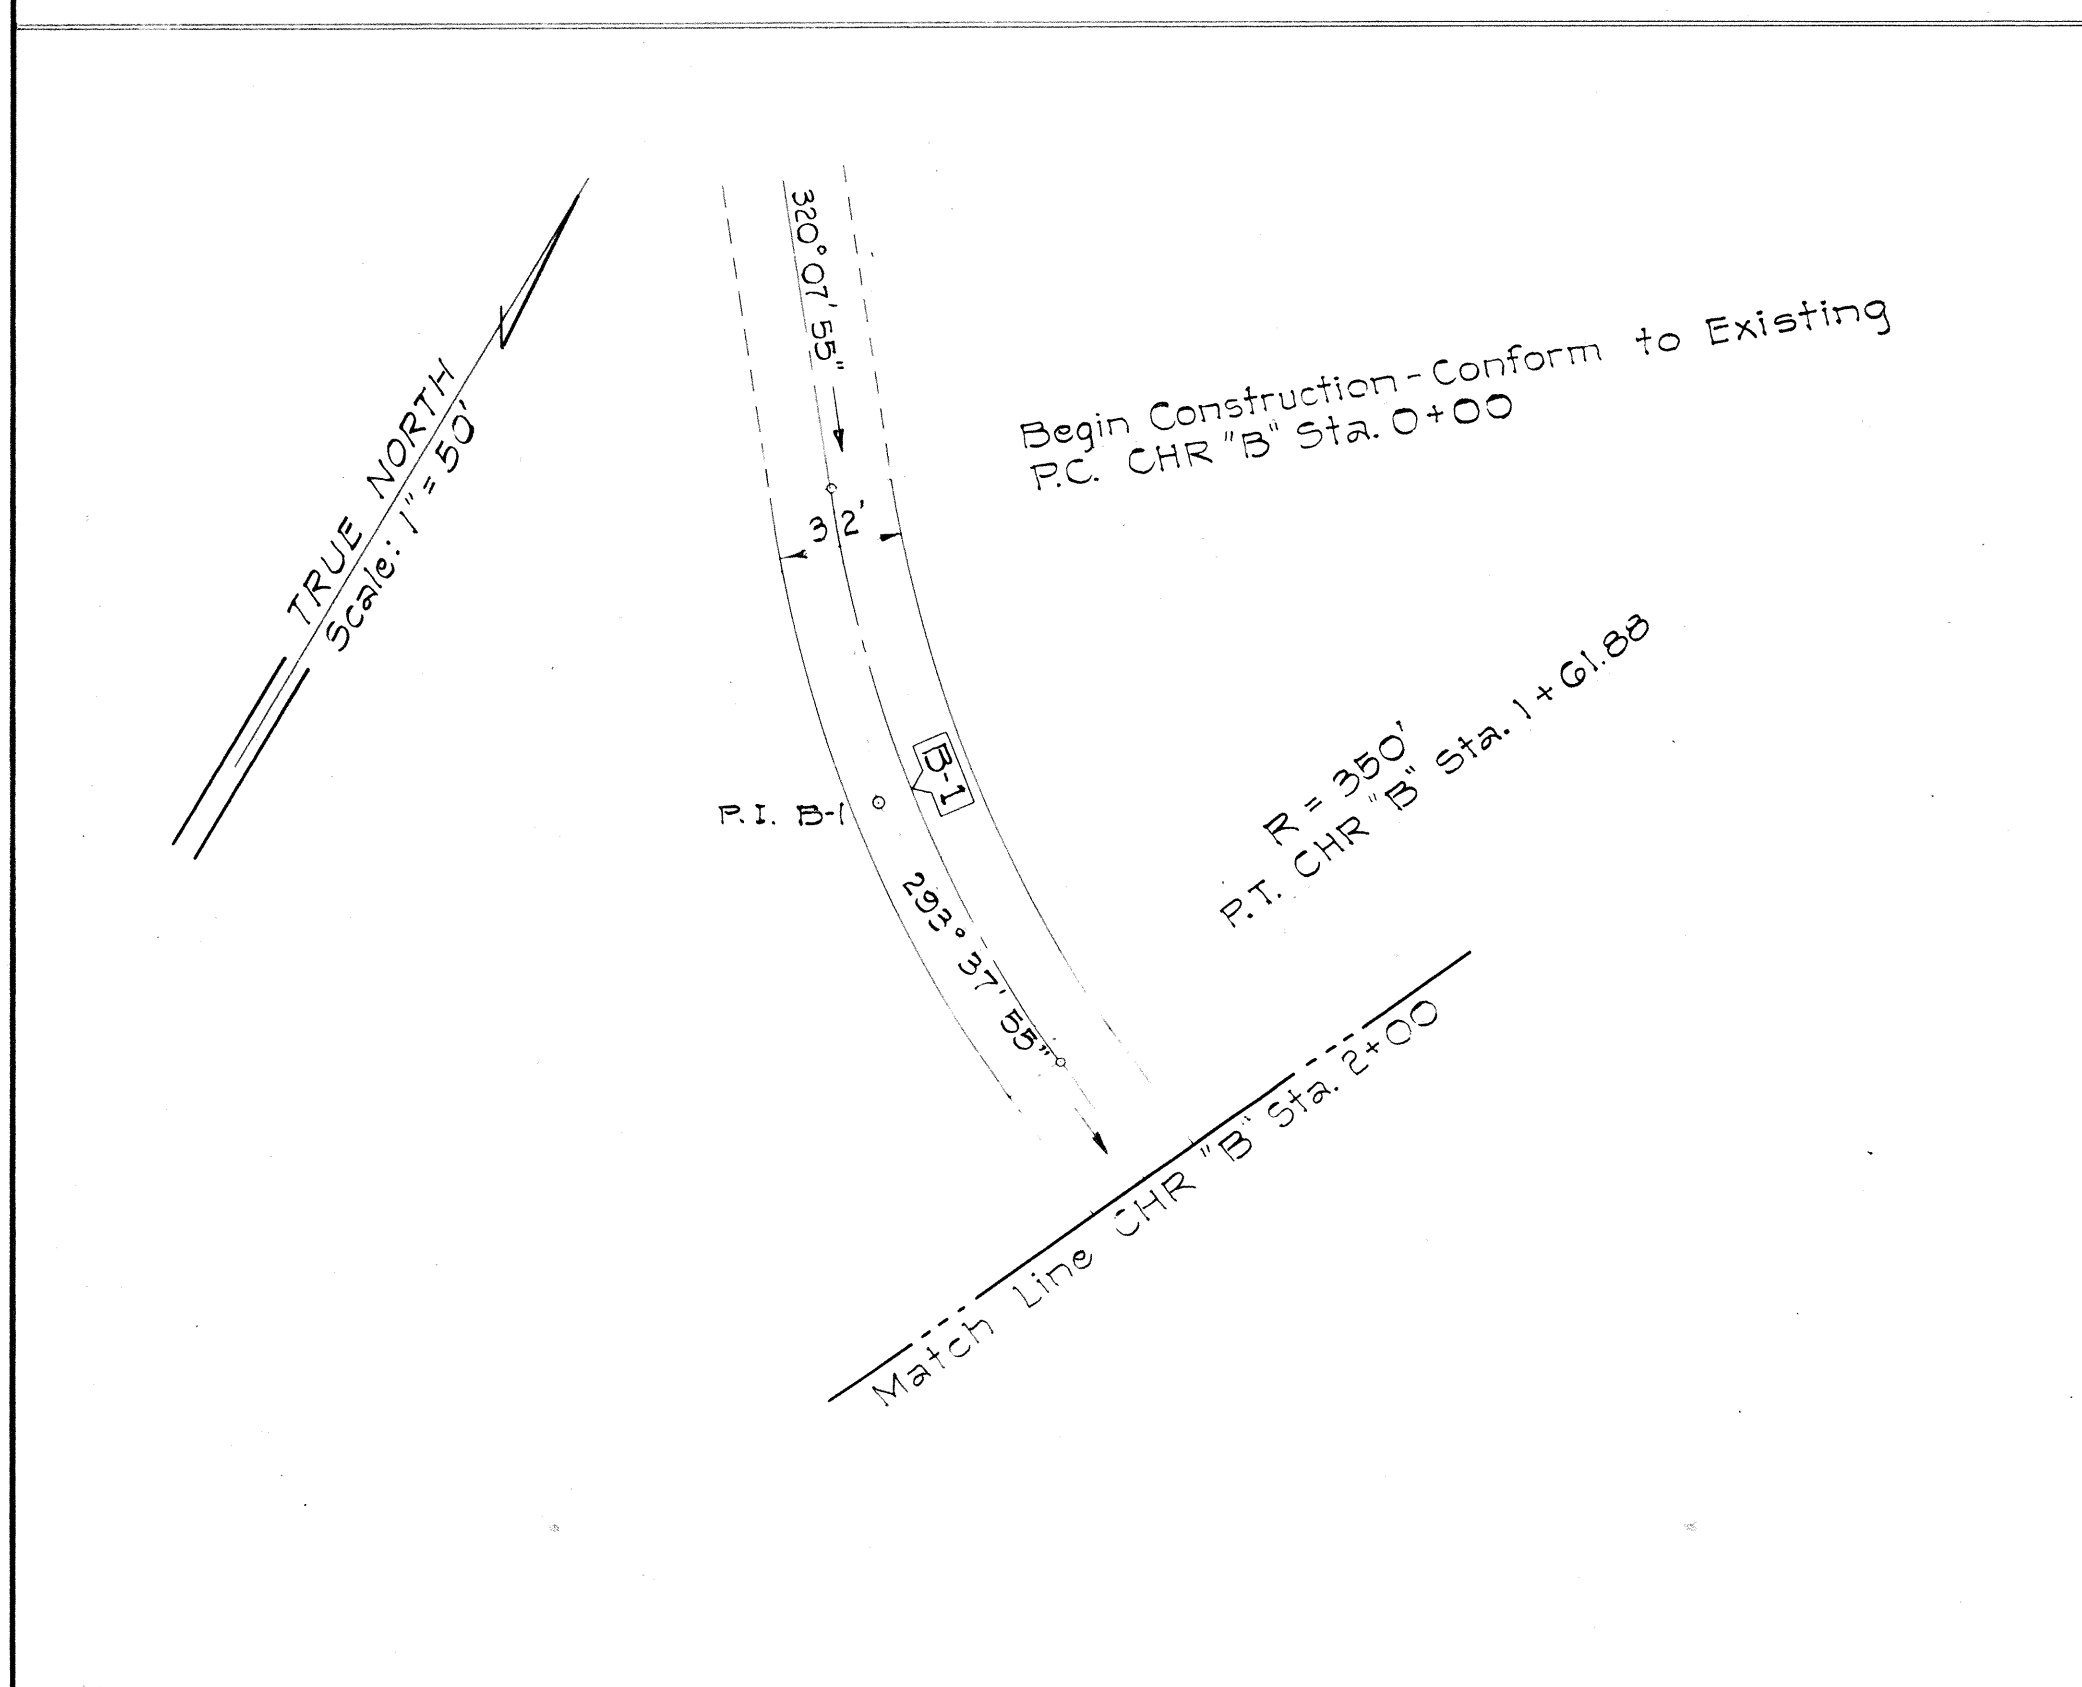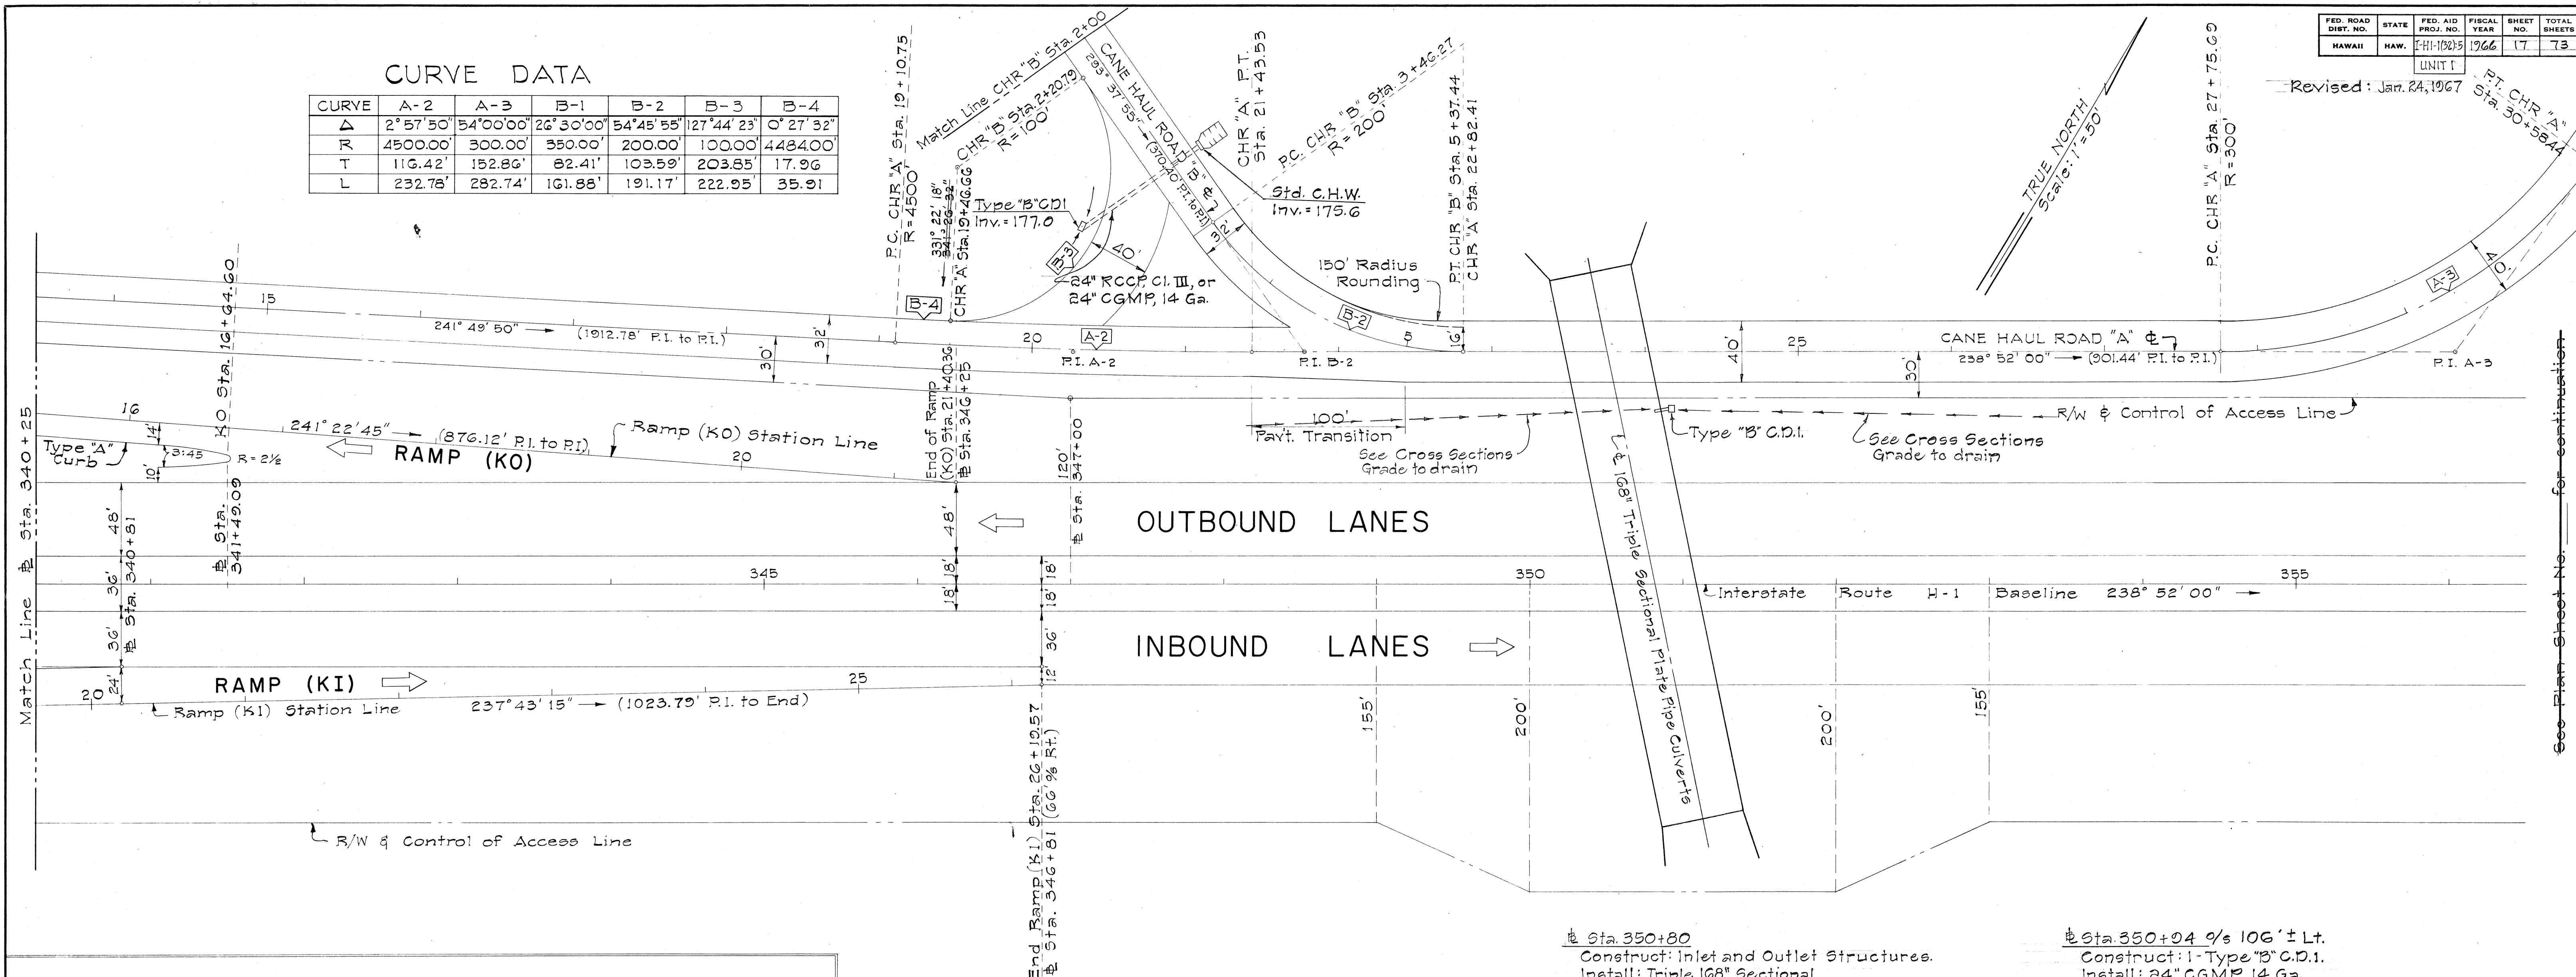

CHR "B" Sta. 3+00

Construct: Type "B" C.D.I., Std Conc. Heavall
Install: 24" RCCP, Cl. III, or 24" CGMP, 14 Ga.

ESTIMATED QUANTITIES

Struc. Exc.	56.41	= 66 c.y.
Ditch & Channel Exc.	69.0	= 80 c.y.
Class B-1 Concrete	3.12	= 30 c.y.
Reinf. Steel		= 42 lbs.
24" Pipe Culvert		= 92 L.F.

Sta. 350+80

Construct: Inlet and Outlet Structures.
Install: Triple 168" Sectional Plate Pipe Culverts.
For details see sht. no. D-7, 8, 9

Sta. 350+24 9/10 ± Lt.

Construct: 1-Type "B" C.D.I.
Install: 24" CGMP, 14 Ga.
For details see sht. no. D-10

ESTIMATED QUANTITIES

Struc. Exc.	14.6	= 10 c.y.
Class B-1 Conc.	1.81	= 10 c.y.
24" Pipe Culvert	14.2	= 10 L.F.

THIS SHEET SUPERSEDES SHEET NO. 52

STATE OF HAWAII
DEPARTMENT OF TRANSPORTATION
HIGHWAYS DIVISION

DRAINAGE LAYOUT
Sta. 340+00 TO Sta. 355+00

INTERSTATE ROUTE H-1
PROJ. No. I-H1-1(32)-5, UNIT 1

Scale: As Shown Date: Sept. 1966

SHEET No. 17 OF 73 SHEETS

50 100 150
SCALE IN FEET

C.O. 17

C.O. 52



See Plan Sheet No. 16 for continuation

DATE: _____
DRAWN BY: _____
CHECKED BY: _____
DESIGNED BY: _____
NOTED BY: _____
REVISIONS: _____

PLAN	SURVEYED	DATE
NO.	BY	
NOTE BOOK	PLOTTED	
	ALIGNMENT CHECKED	
	RT. OF WAY CHECKED	




PROFILE	SURVEYED	DATE
NO.	BY	
NOTE BOOK	PLOTTED	
	ALIGNMENT CHECKED	
	STRUCTURE NOTATION CHECKED	

FED. ROAD DIST. NO.	STATE	FED. AID PROJ. NO.	FISCAL YEAR	SHEET NO.	TOTAL SHEETS
HAWAII	HAW.	I-HI-1(32)-5 UNIT 1	1966	18	73

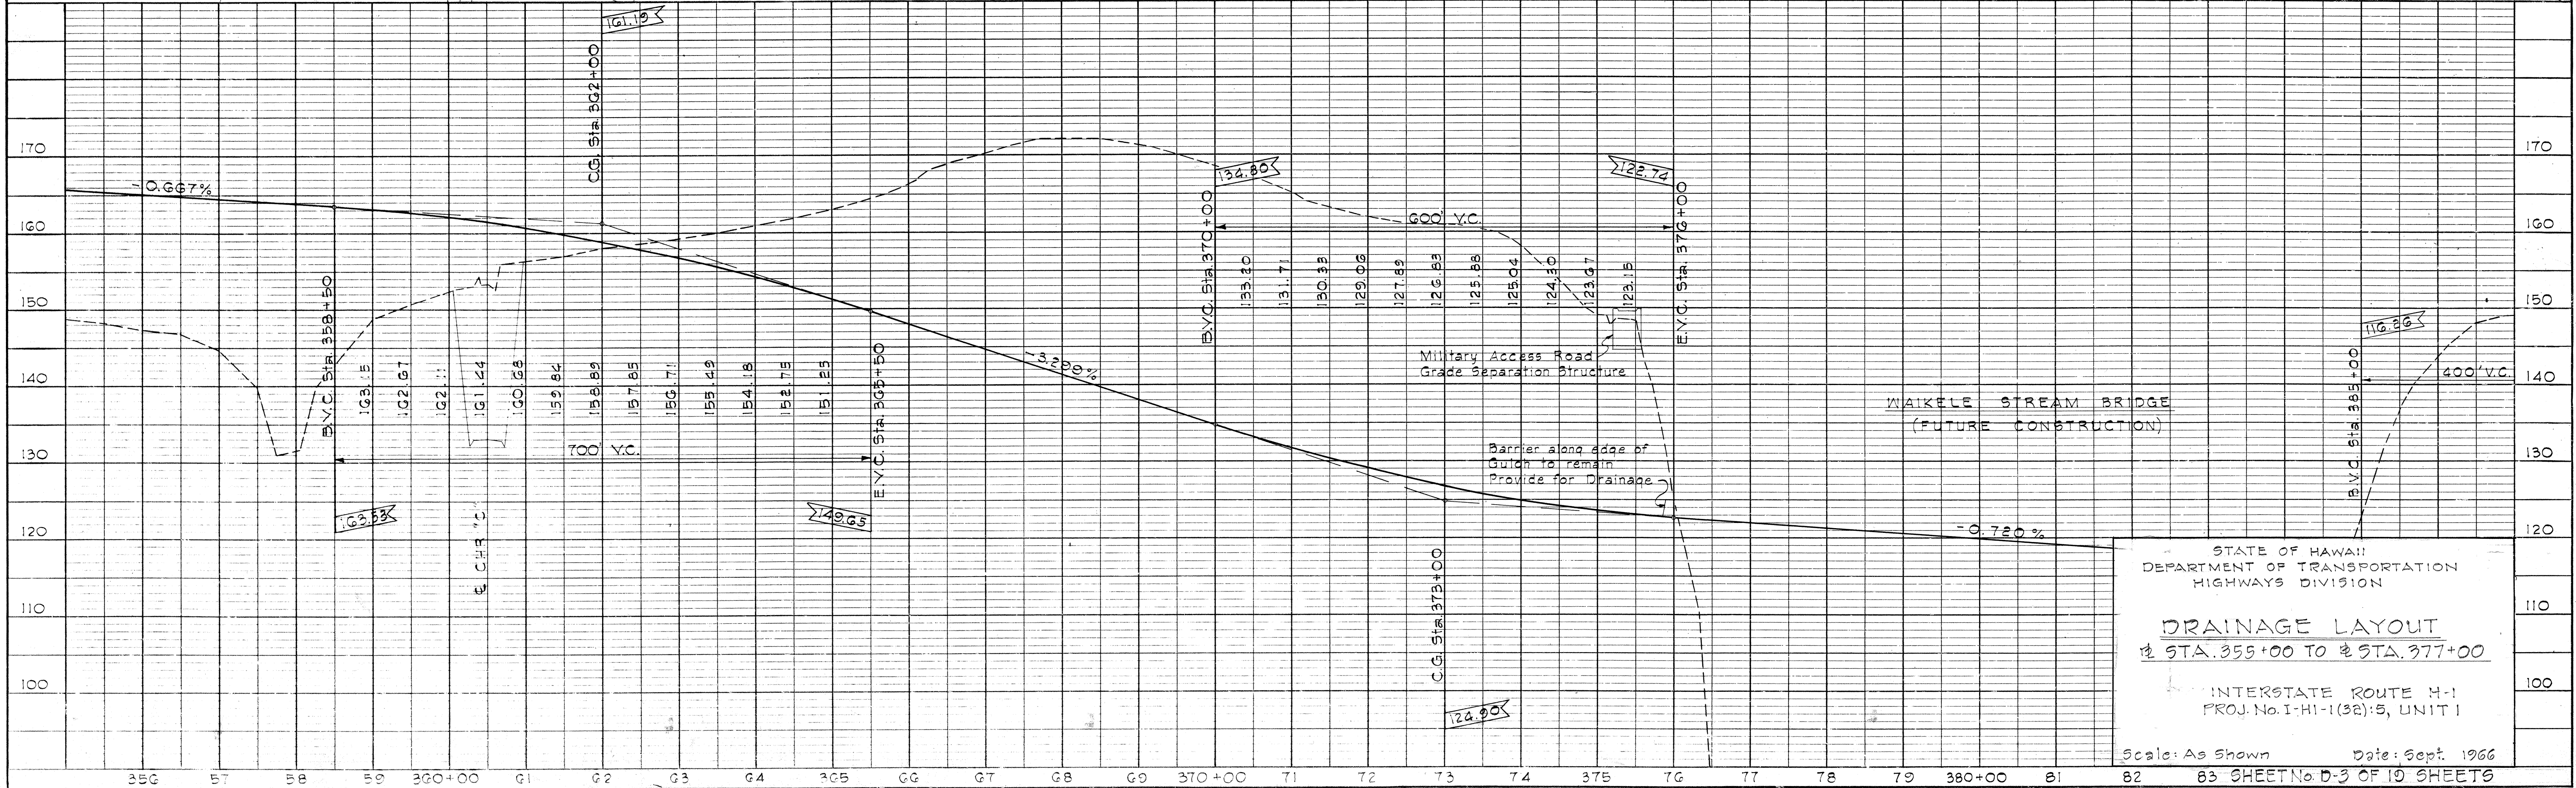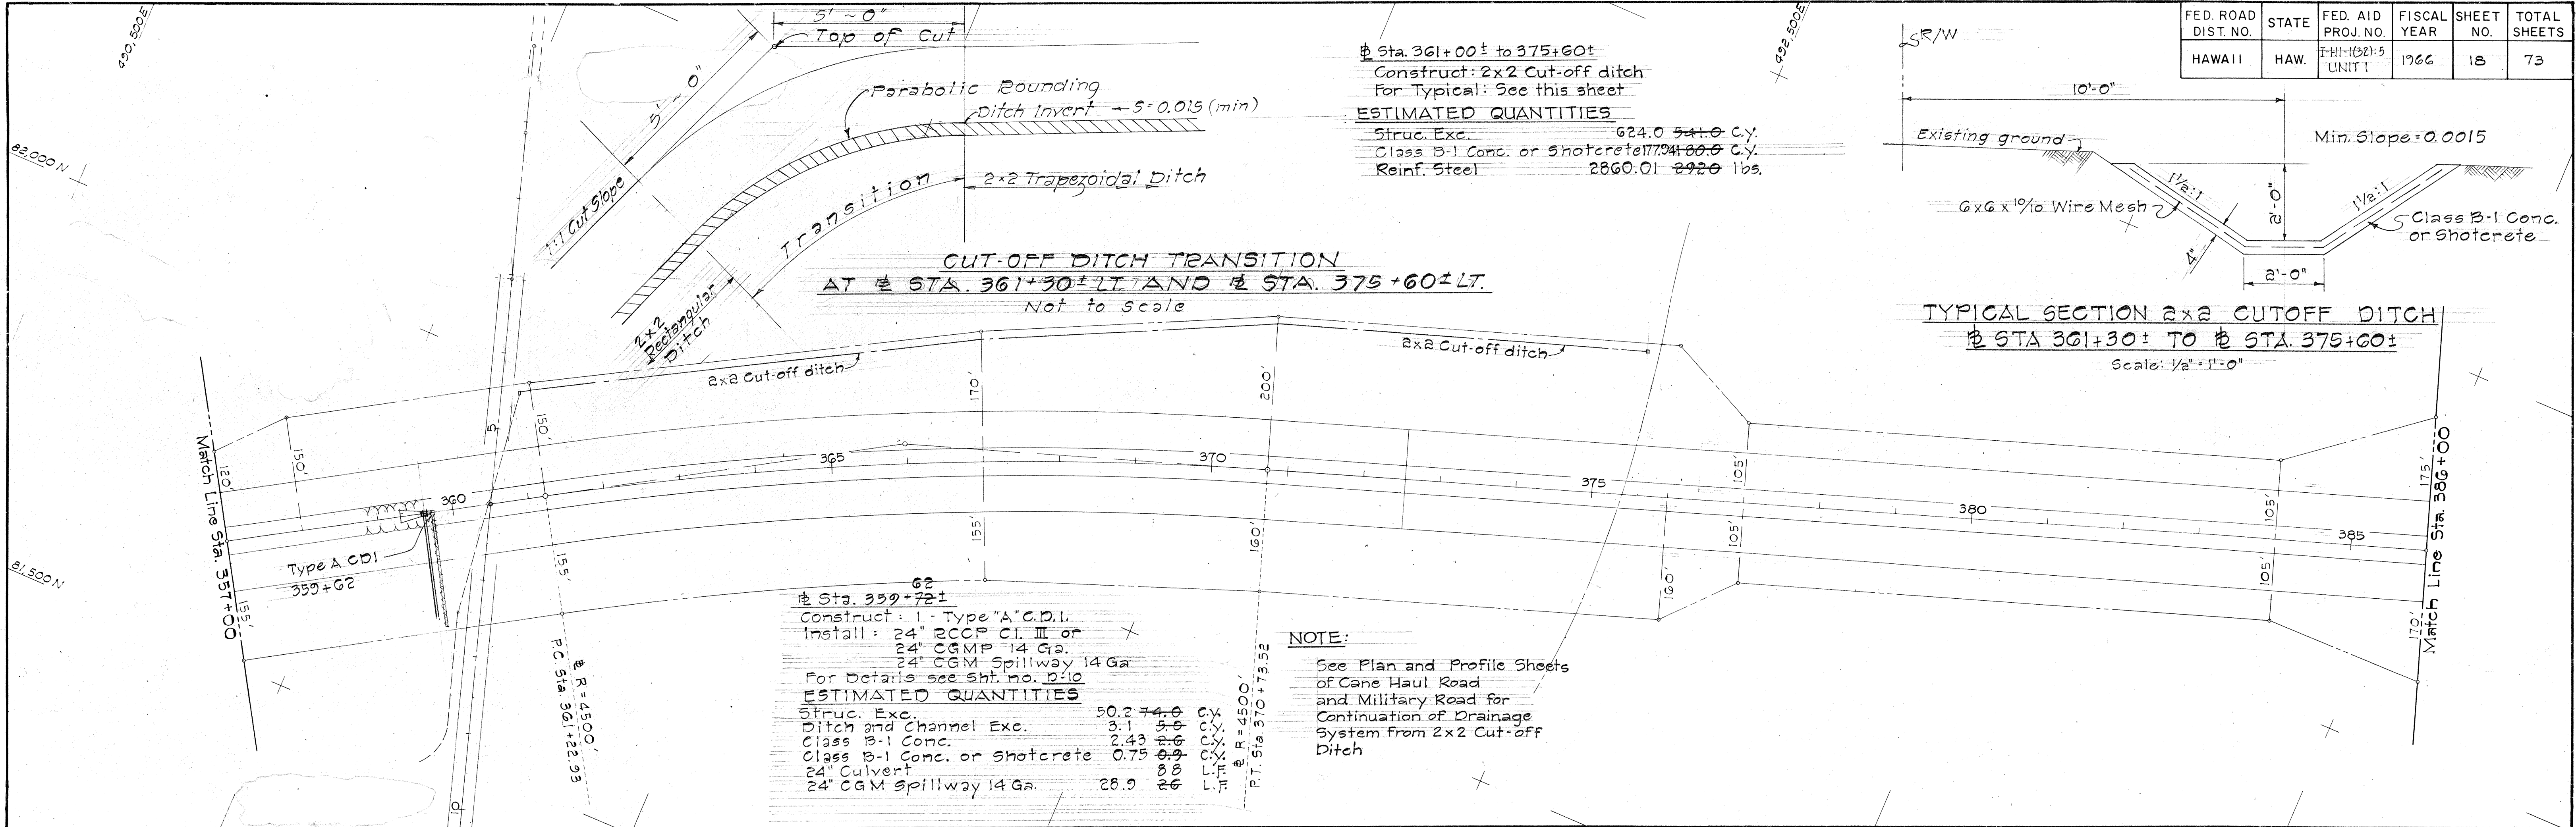

FED. ROAD DIST. NO.	STATE	FED. AID PROJ. NO.	FISCAL YEAR	SHEET NO.	TOTAL SHEETS
HAWAII	HAW.	I-41-1(32)5 Unit 1	1966	19	73

Revised : Jan. 24, 1967

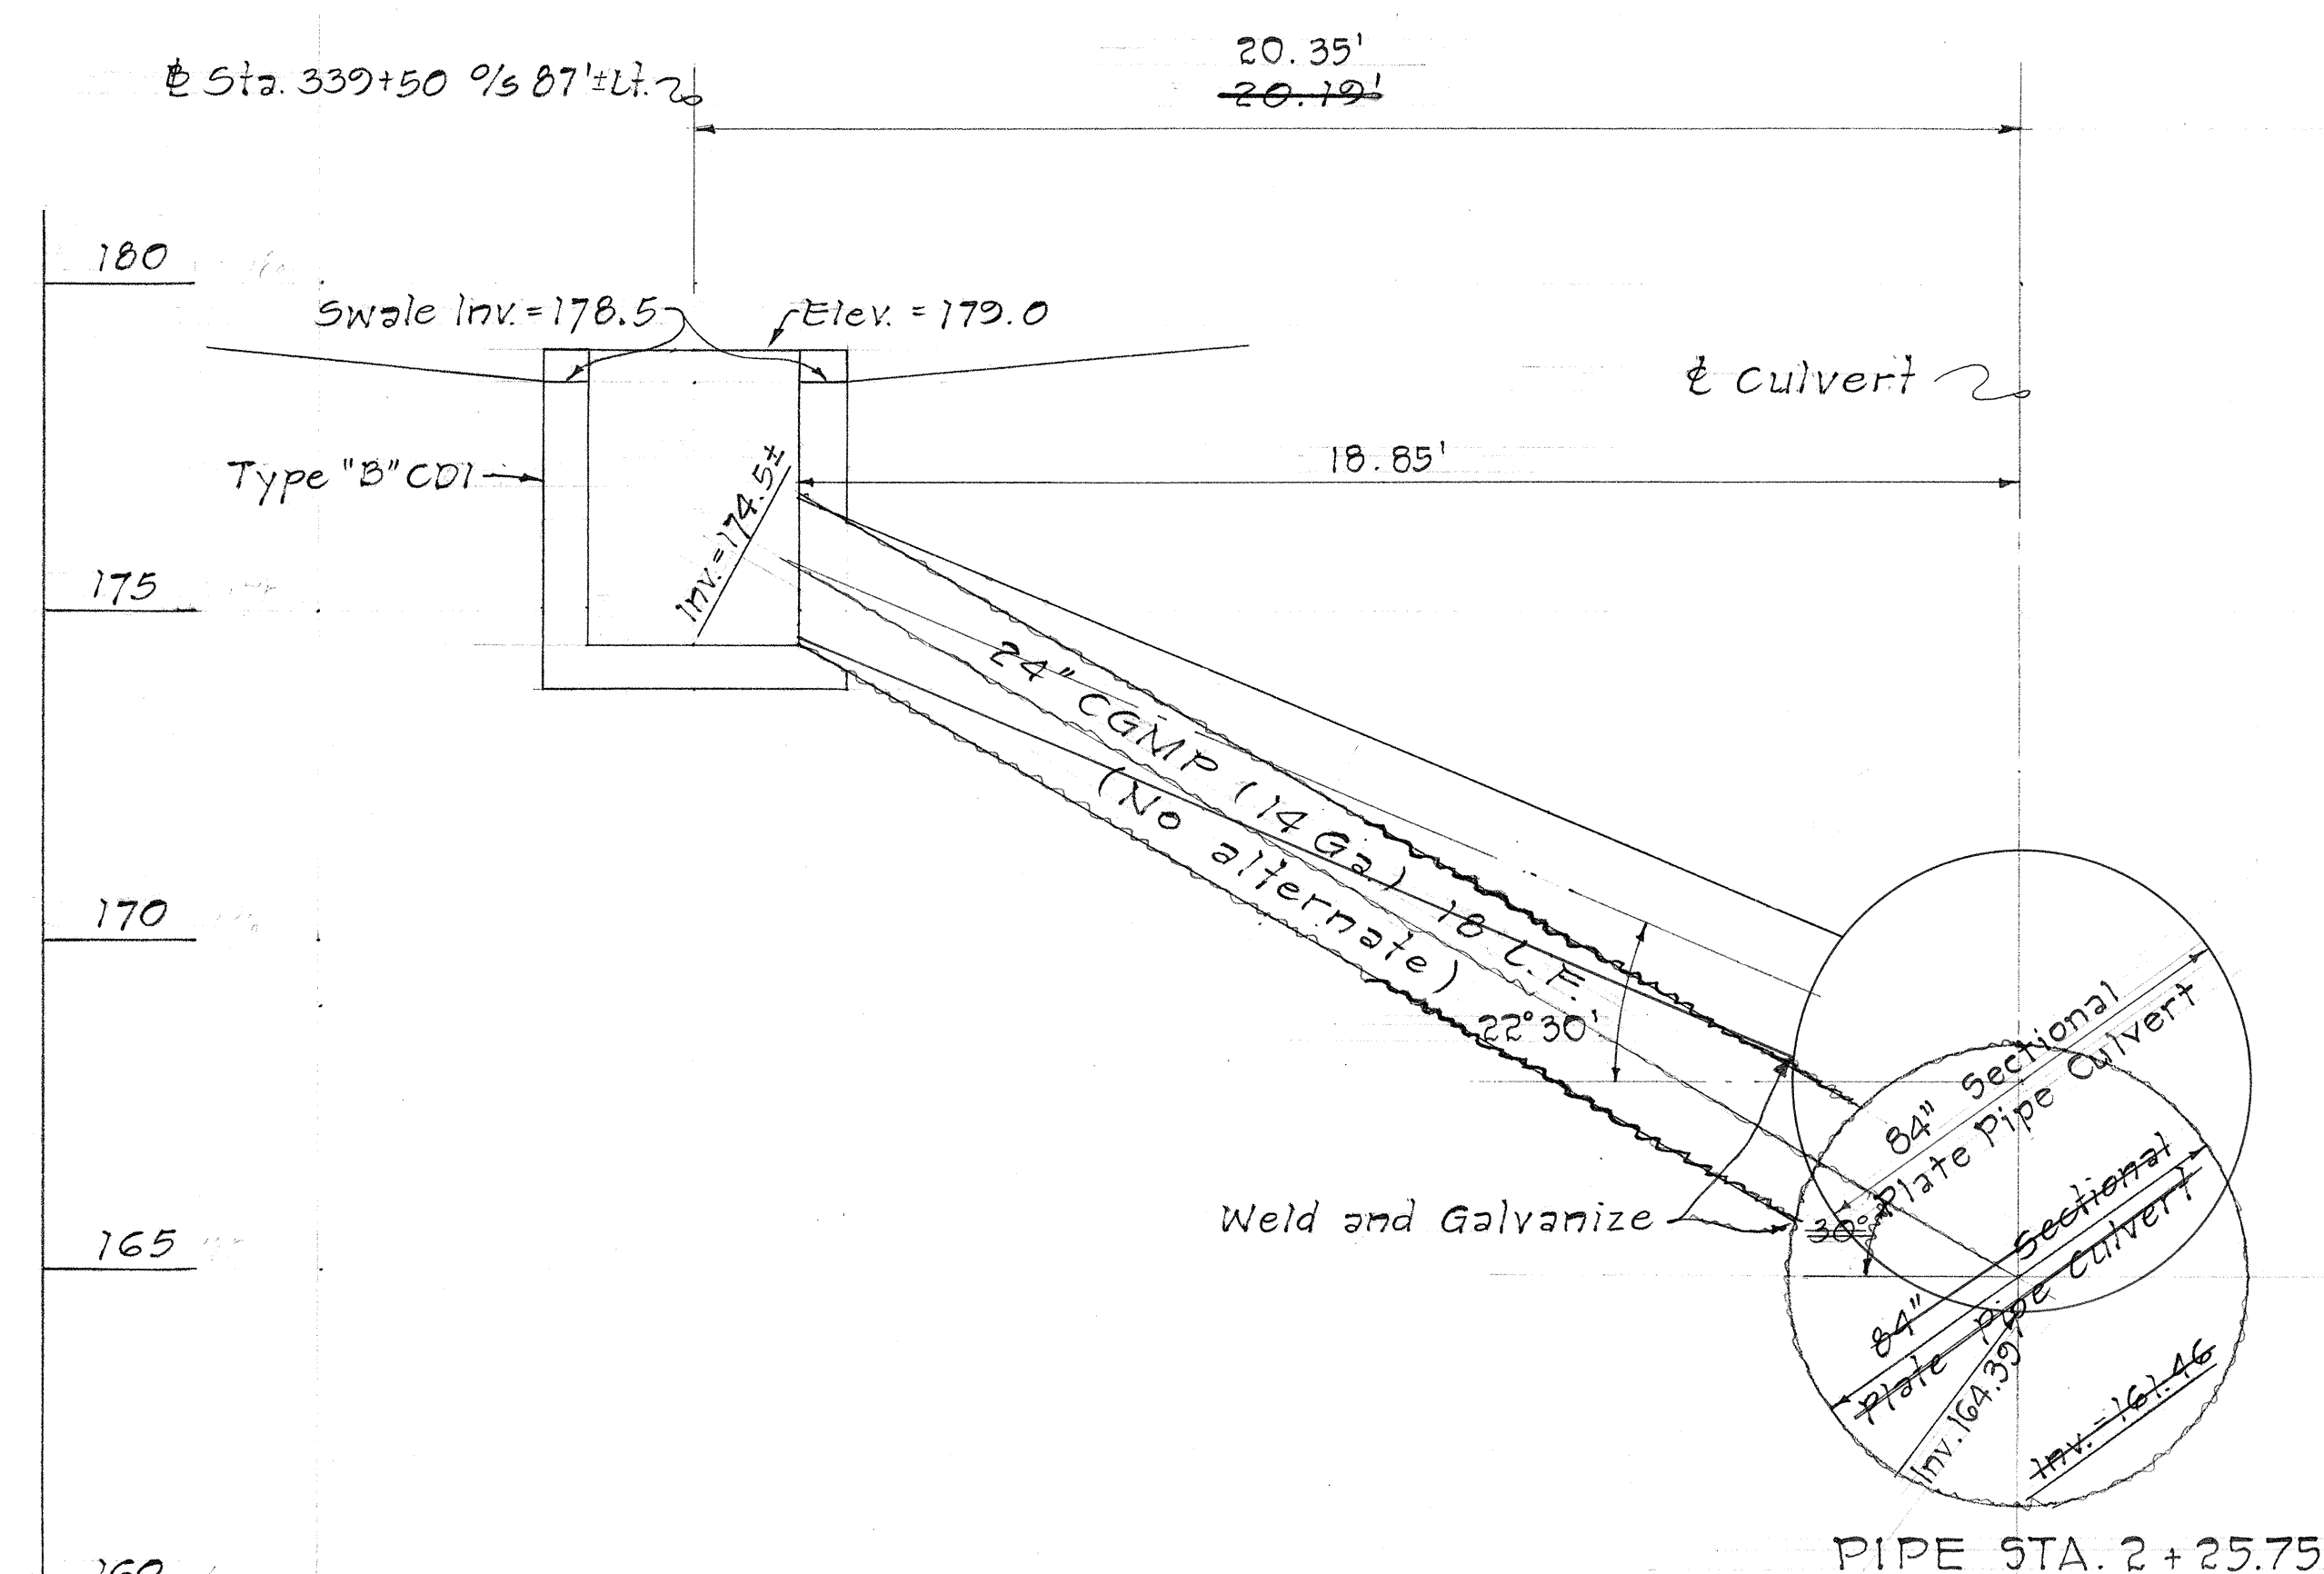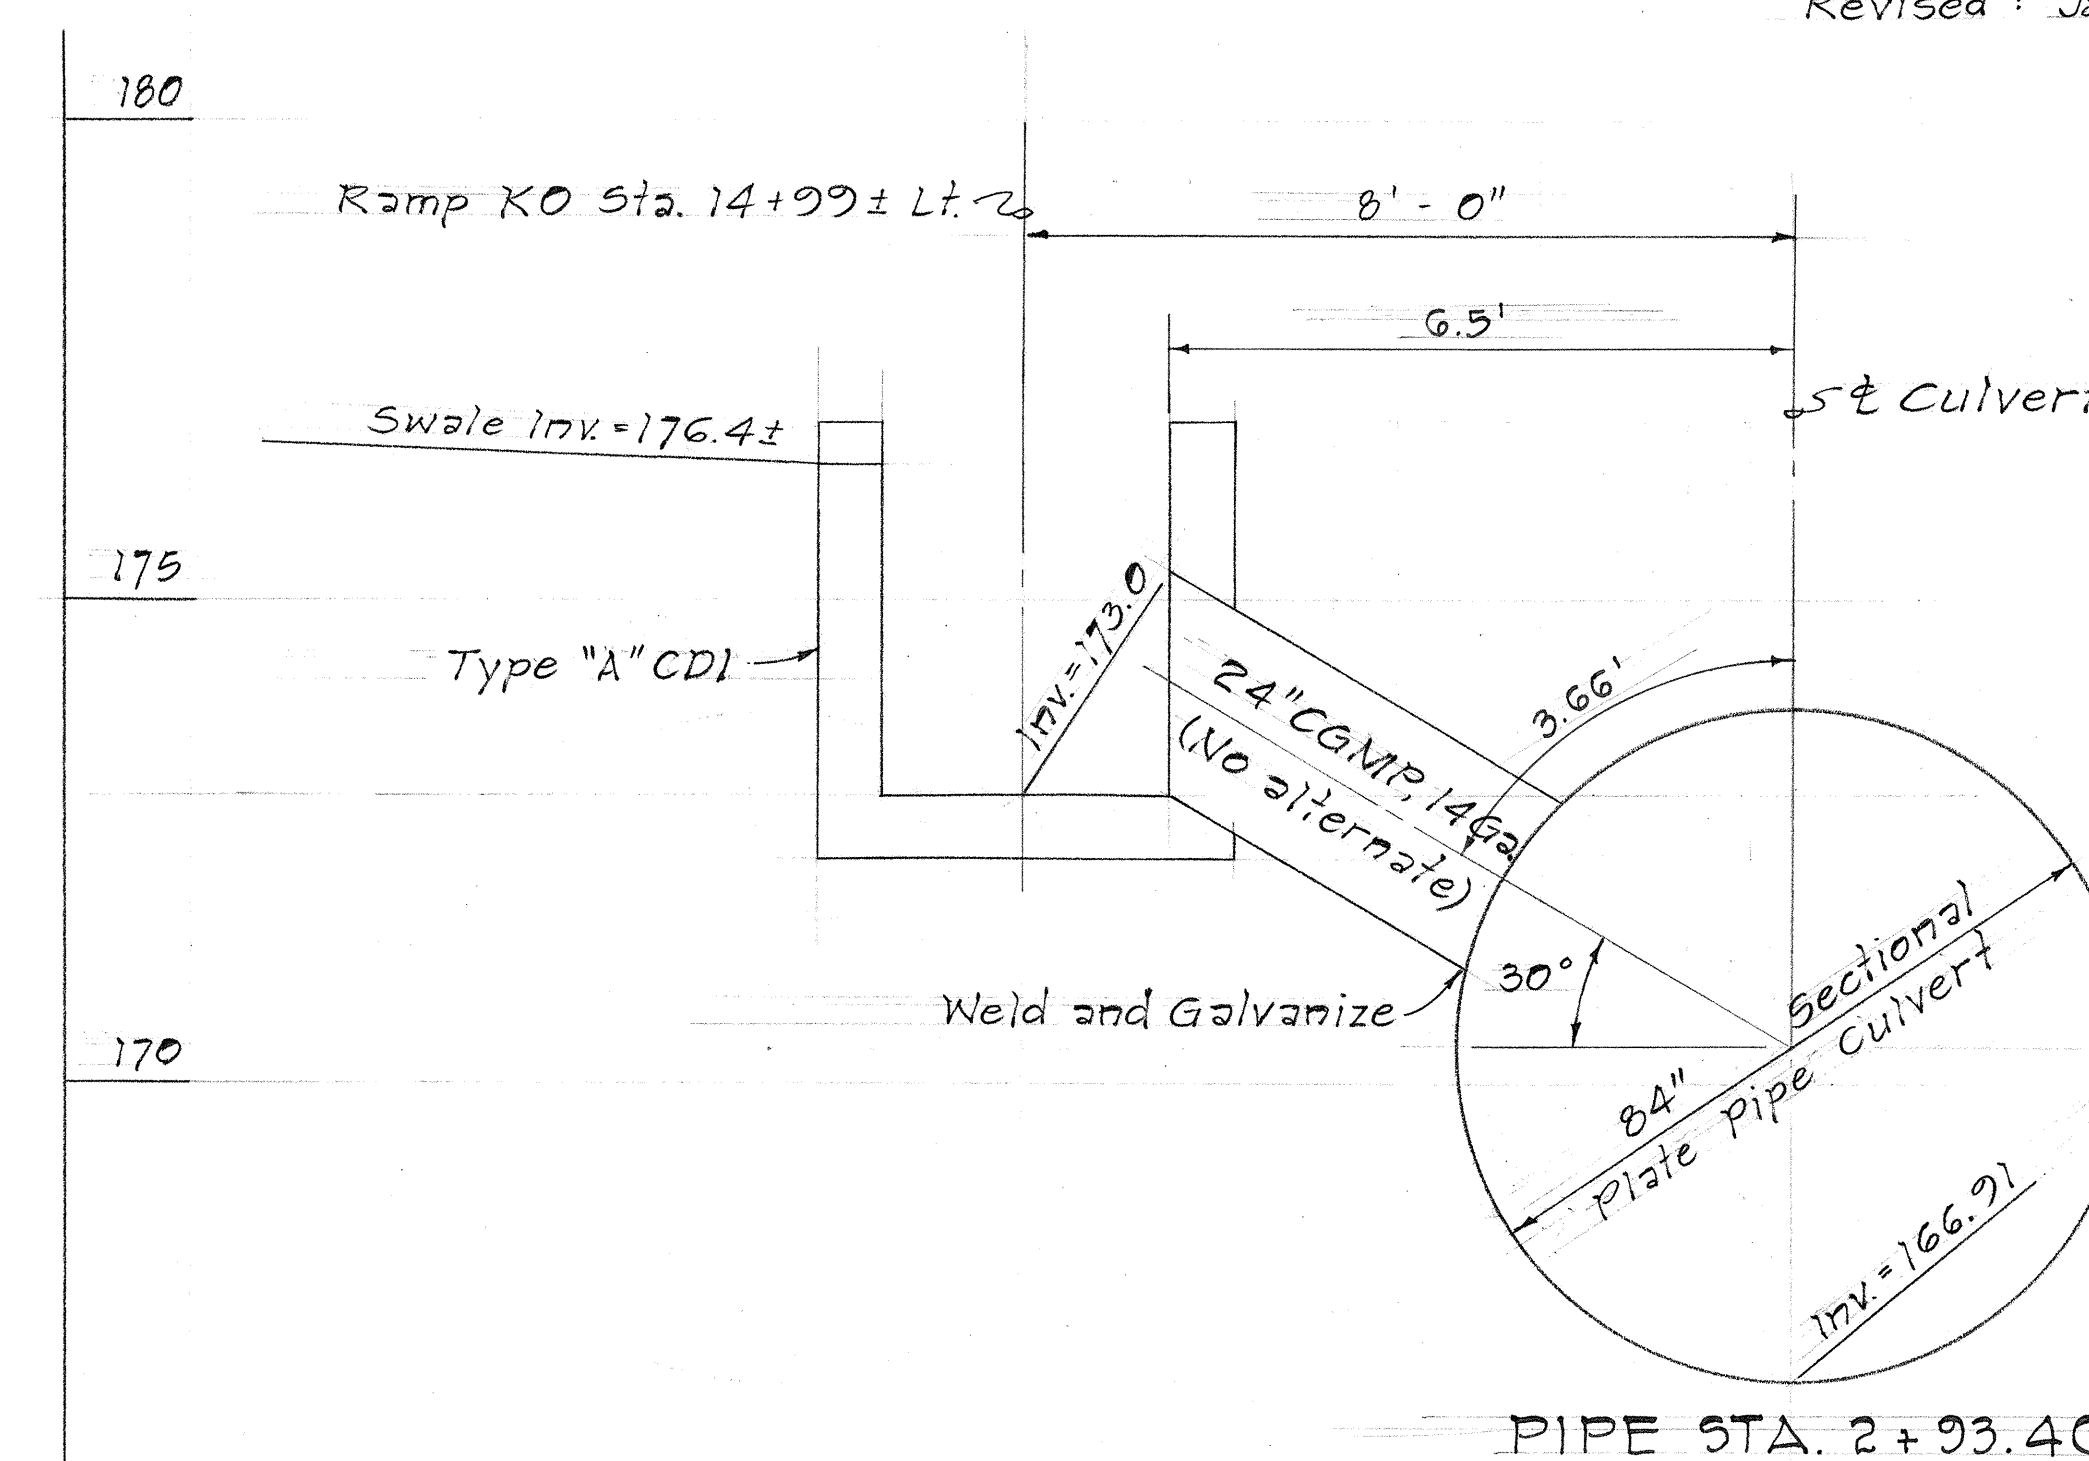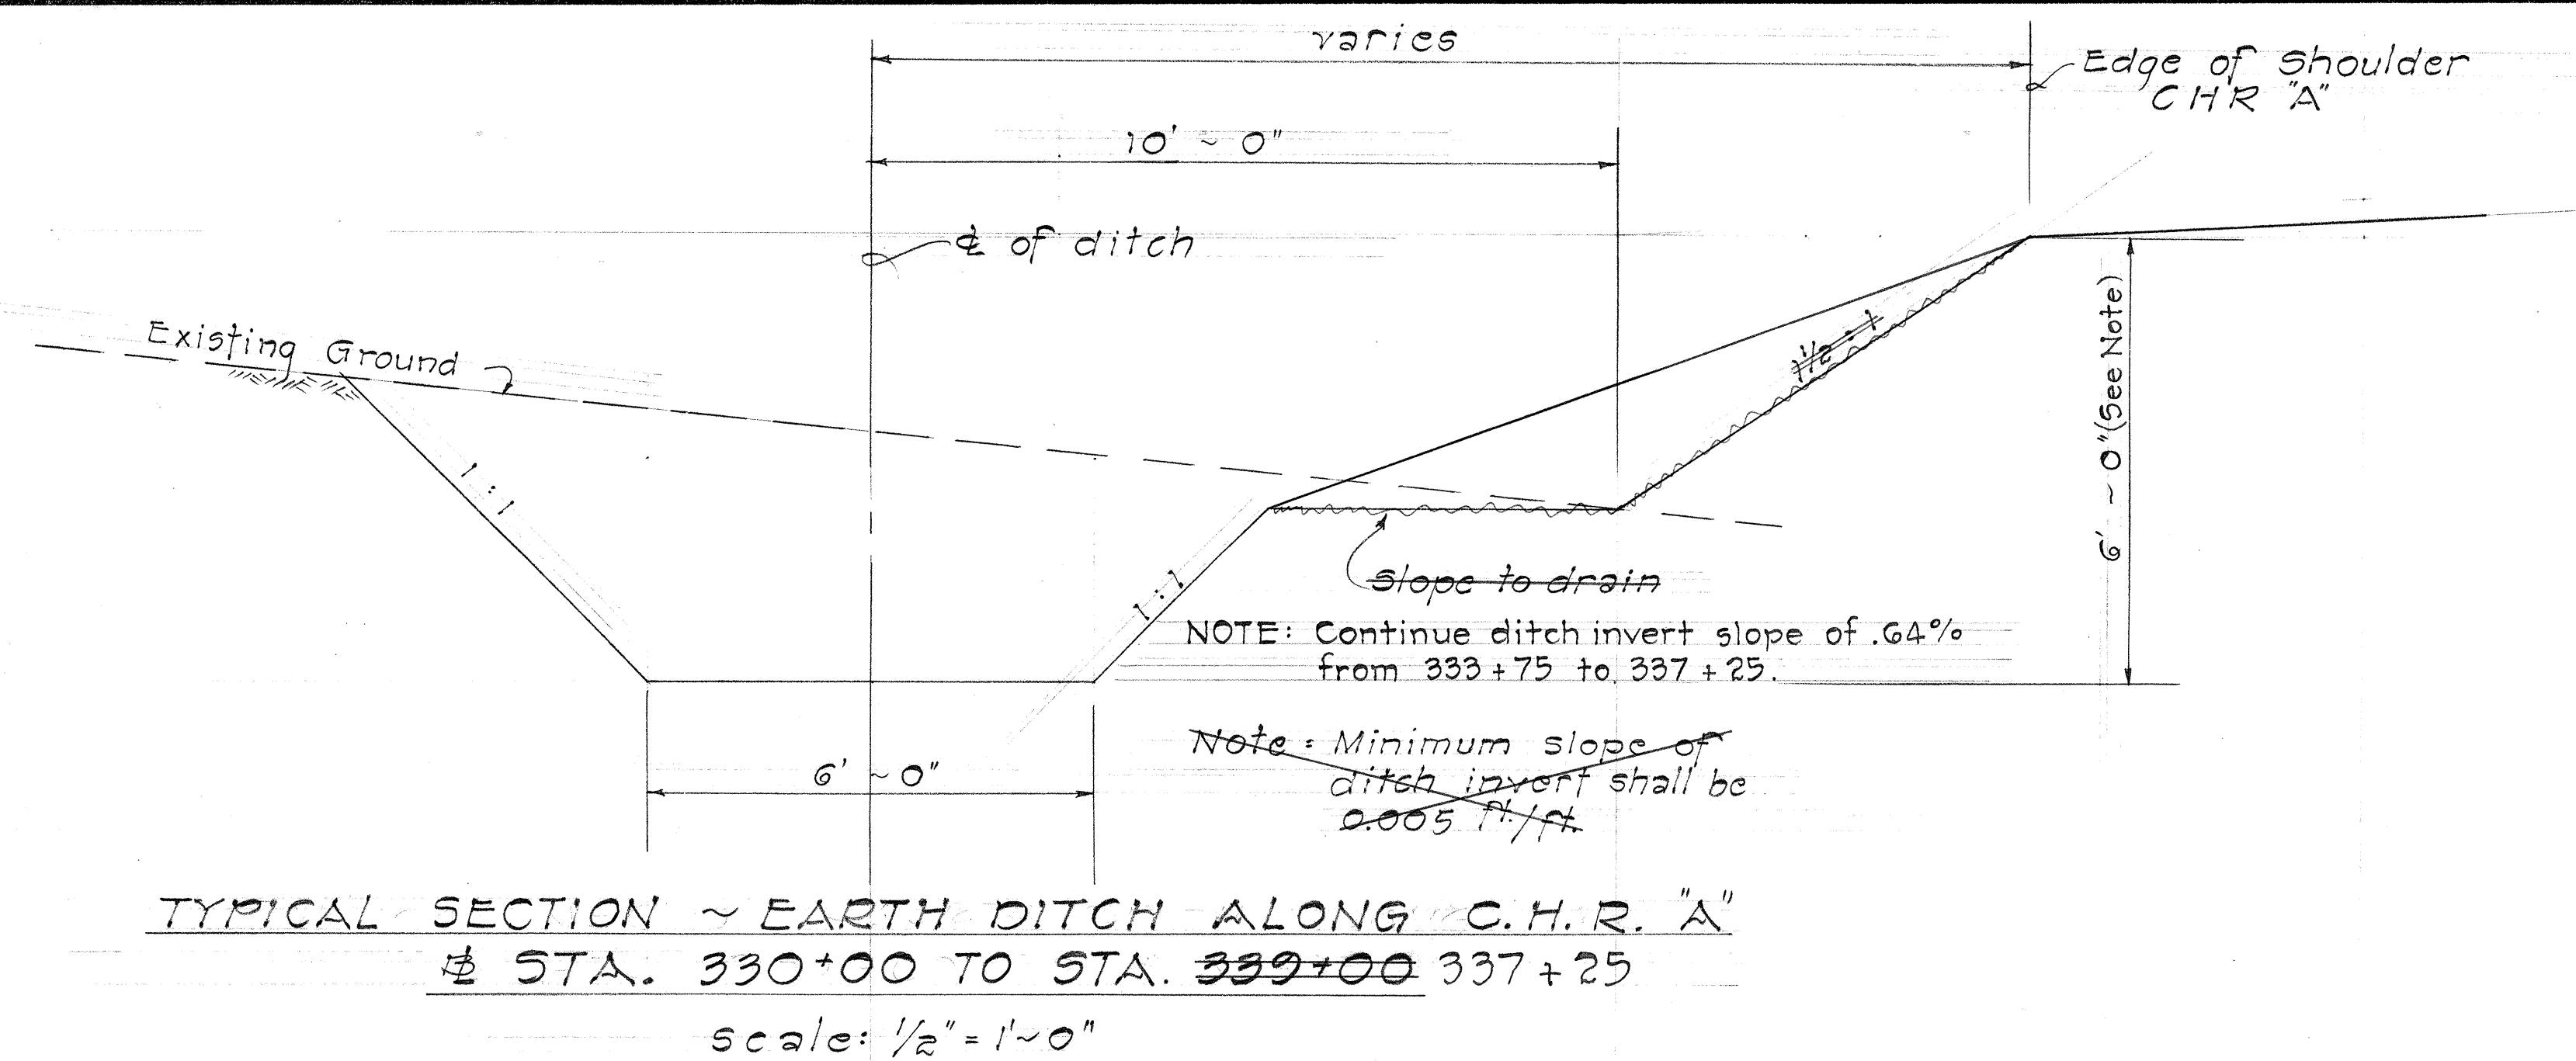

CONNECTION DETAIL - CDI @ STA 339+50±
TO 84" SECTIONAL PLATE PIPE CULVERT

Scale: $\frac{3}{8}'' = 1' - 0''$

CONNECTION DETAIL - CDI @ RAMP KO STA. 14+99±
TO 84" SECTIONAL PLATE PIPE CULVERT

Scale: $\frac{1}{2}'' = 1' - 0''$

THIS SHEET REPLACES SHEET NO. 54

**STATE OF HAWAII
DEPARTMENT OF TRANSPORTATION
HIGHWAYS DIVISION**

DRAINAGE DETAILS

INTERSTATE ROUTE H-1
PROJ. No. I-H-1(32):5, UNIT 1

Scale: As Shown Date: Jan., 1967

SHEET No. D-4 OF 12 SHEETS


BRINKER ON NO. 1000M CLEARBRIM

C. O. 19

C. O. 54


FED. ROAD DIST. NO.	STATE	FED. AID PROJ. NO.	FISCAL YEAR	SHEET NO.	TOTAL SHEETS
HAWAII	HAW.	I-H-1-(32)-5 UNIT 1	1966	20	73

Revised: Jan. 24, 1967

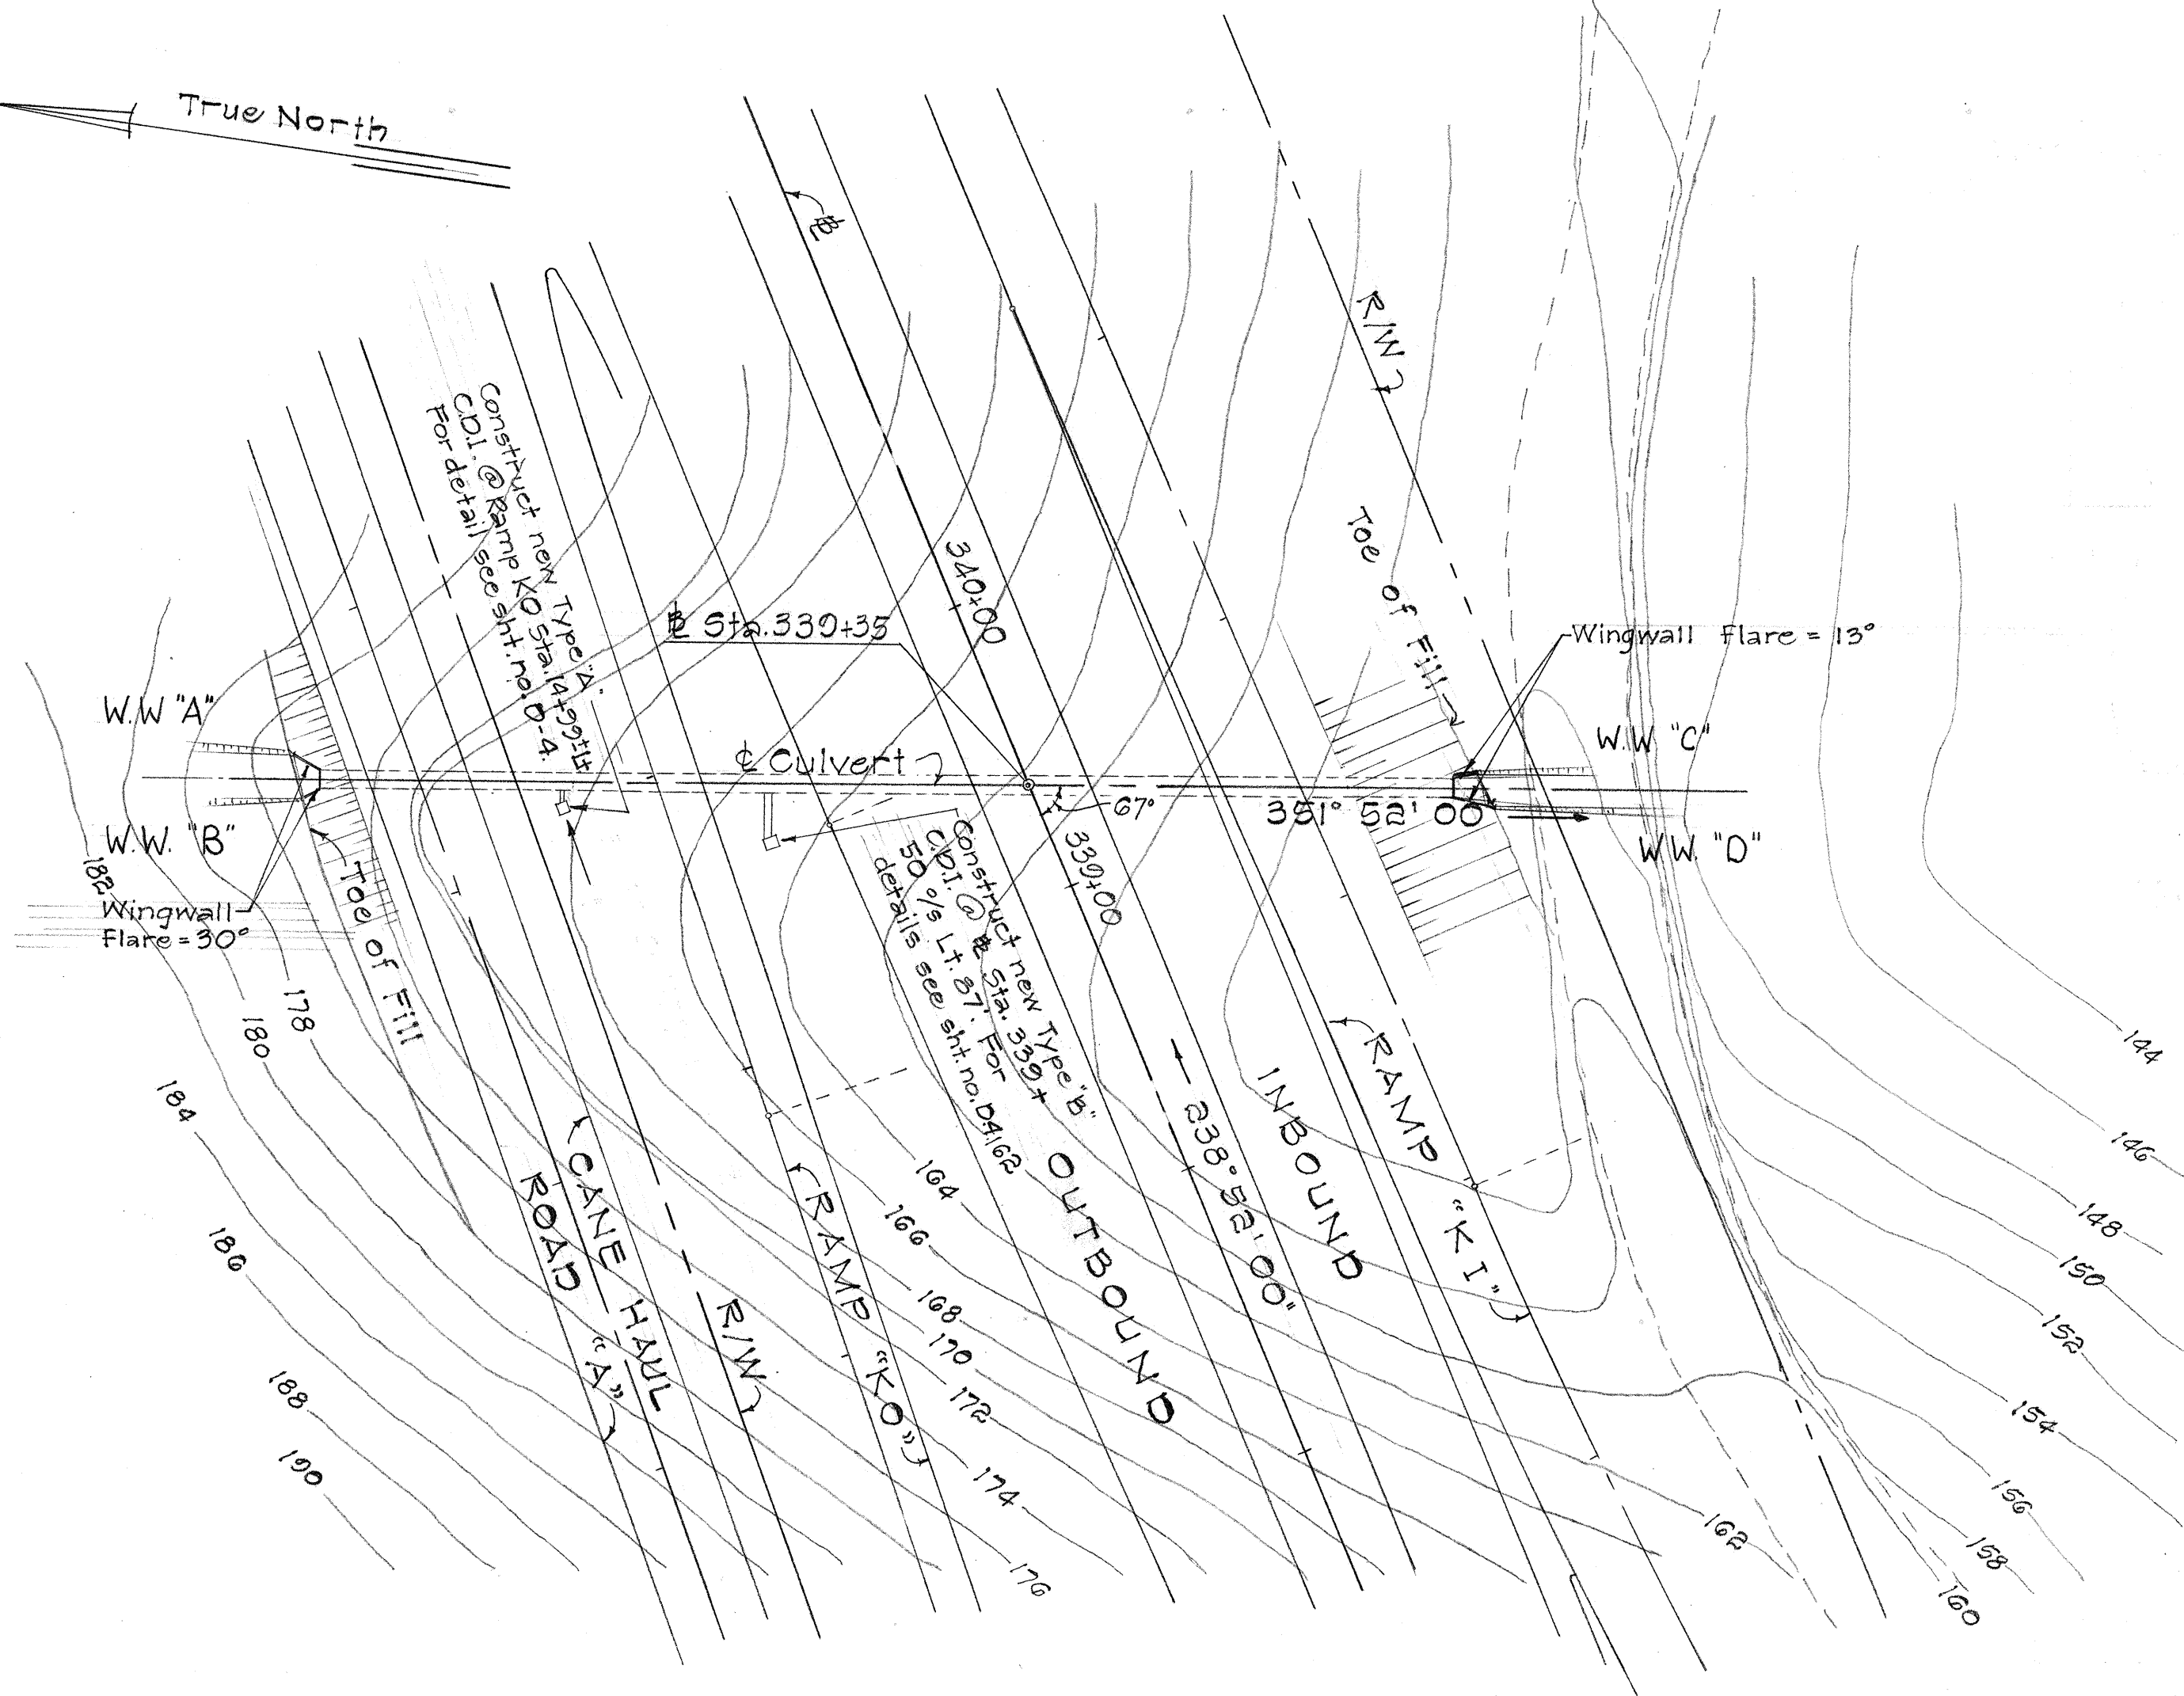

PLAN

Scale: 1" = 50'

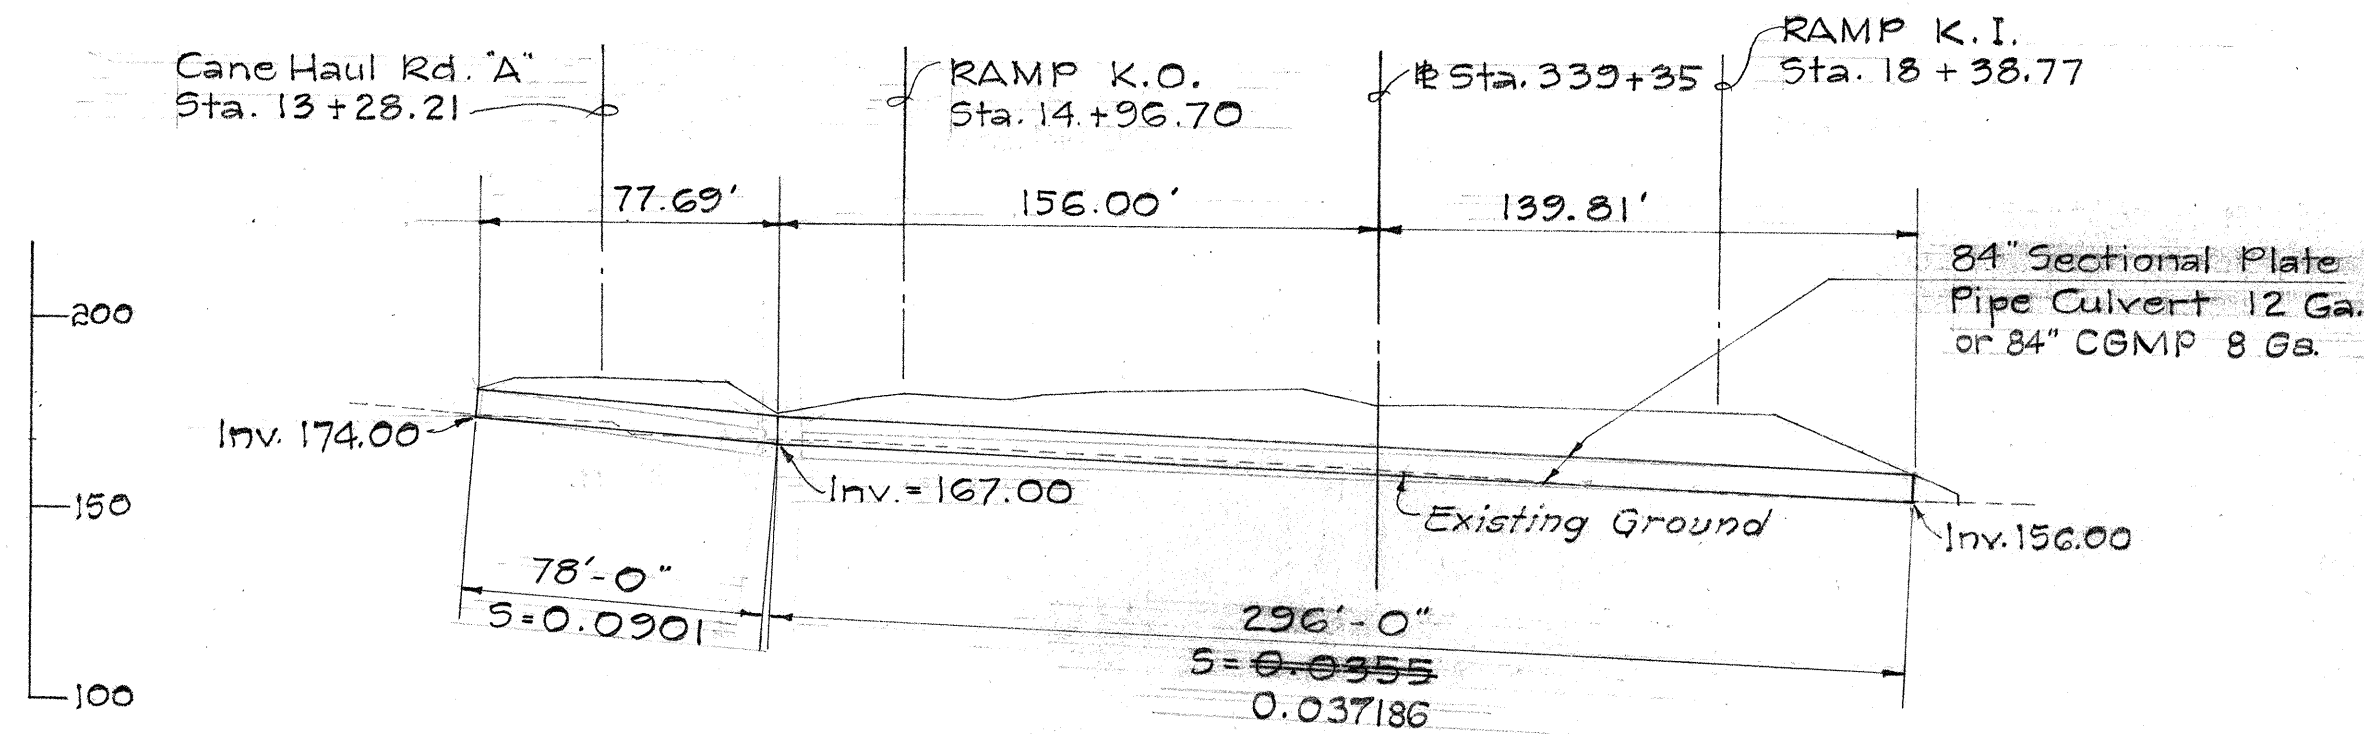

PROFILE - CULVERT AT STA. 330+35

Scale: 1" = 50'

Sta. 339+35

ESTIMATED QUANTITIES

Struct. Exc.	69.34	85 c.y.
Ditch and Channel Exc.	15	c.y.
Untreated Base	62	c.y.
Class A-1 Conc.	27	c.y.
Reinf. Steel	1863	lbs.
84" Sectional Plate Pipe Culvert 12 Ga.	374	L.F.

GENERAL NOTES

1. The 84" Sectional Plate Pipe Culvert shall have its vertical diameter factory elongated 5%.
2. For detail connection of C.D.I.'s to 84" Sectional Plate Pipe Culvert see sht. no. D-4

THIS SHEET SUPERSEDES SHEET NO. 55

STATE OF HAWAII
DEPARTMENT OF TRANSPORTATION
HIGHWAYS DIVISION

DRAINAGE DETAILS
FOR 84" CULVERT AT
STA. 330+35

INTERSTATE ROUTE H-1
PROJ. No. I-H-1-(32)-5, UNIT 1

Scale: As Shown Date: Sept. 1966


SHEET No. 20 OF 73 SHEETS

SURVEY PLOTTED BY	DATE
DRAWN BY	2/2/67
DESIGNED BY	
QUANTITIES BY	
CHECKED BY	
ORIGINAL PLAN	
NOTE BOOK	
No.	

ORIGINAL PLAN	SURVEY PLOTTED BY	DATE
	DRAWN BY <i>M. M.</i>	<i>Aug. 66</i>
	TRACED BY	
	DESIGNED BY	
NOTE BOOK	QUANTITIES BY <i>M. M.</i>	
	CHECKED BY <i>R. K.</i>	
No. _____		


FED. ROAD DIST. NO.	STATE	FED. AID PROJ. NO.	FISCAL YEAR	SHEET NO.	TOTAL SHEETS
HAWAII	HAW.	I-HI-1(32):5 UNIT 1	1966	22	73

Revised: Jan. 24, 1967

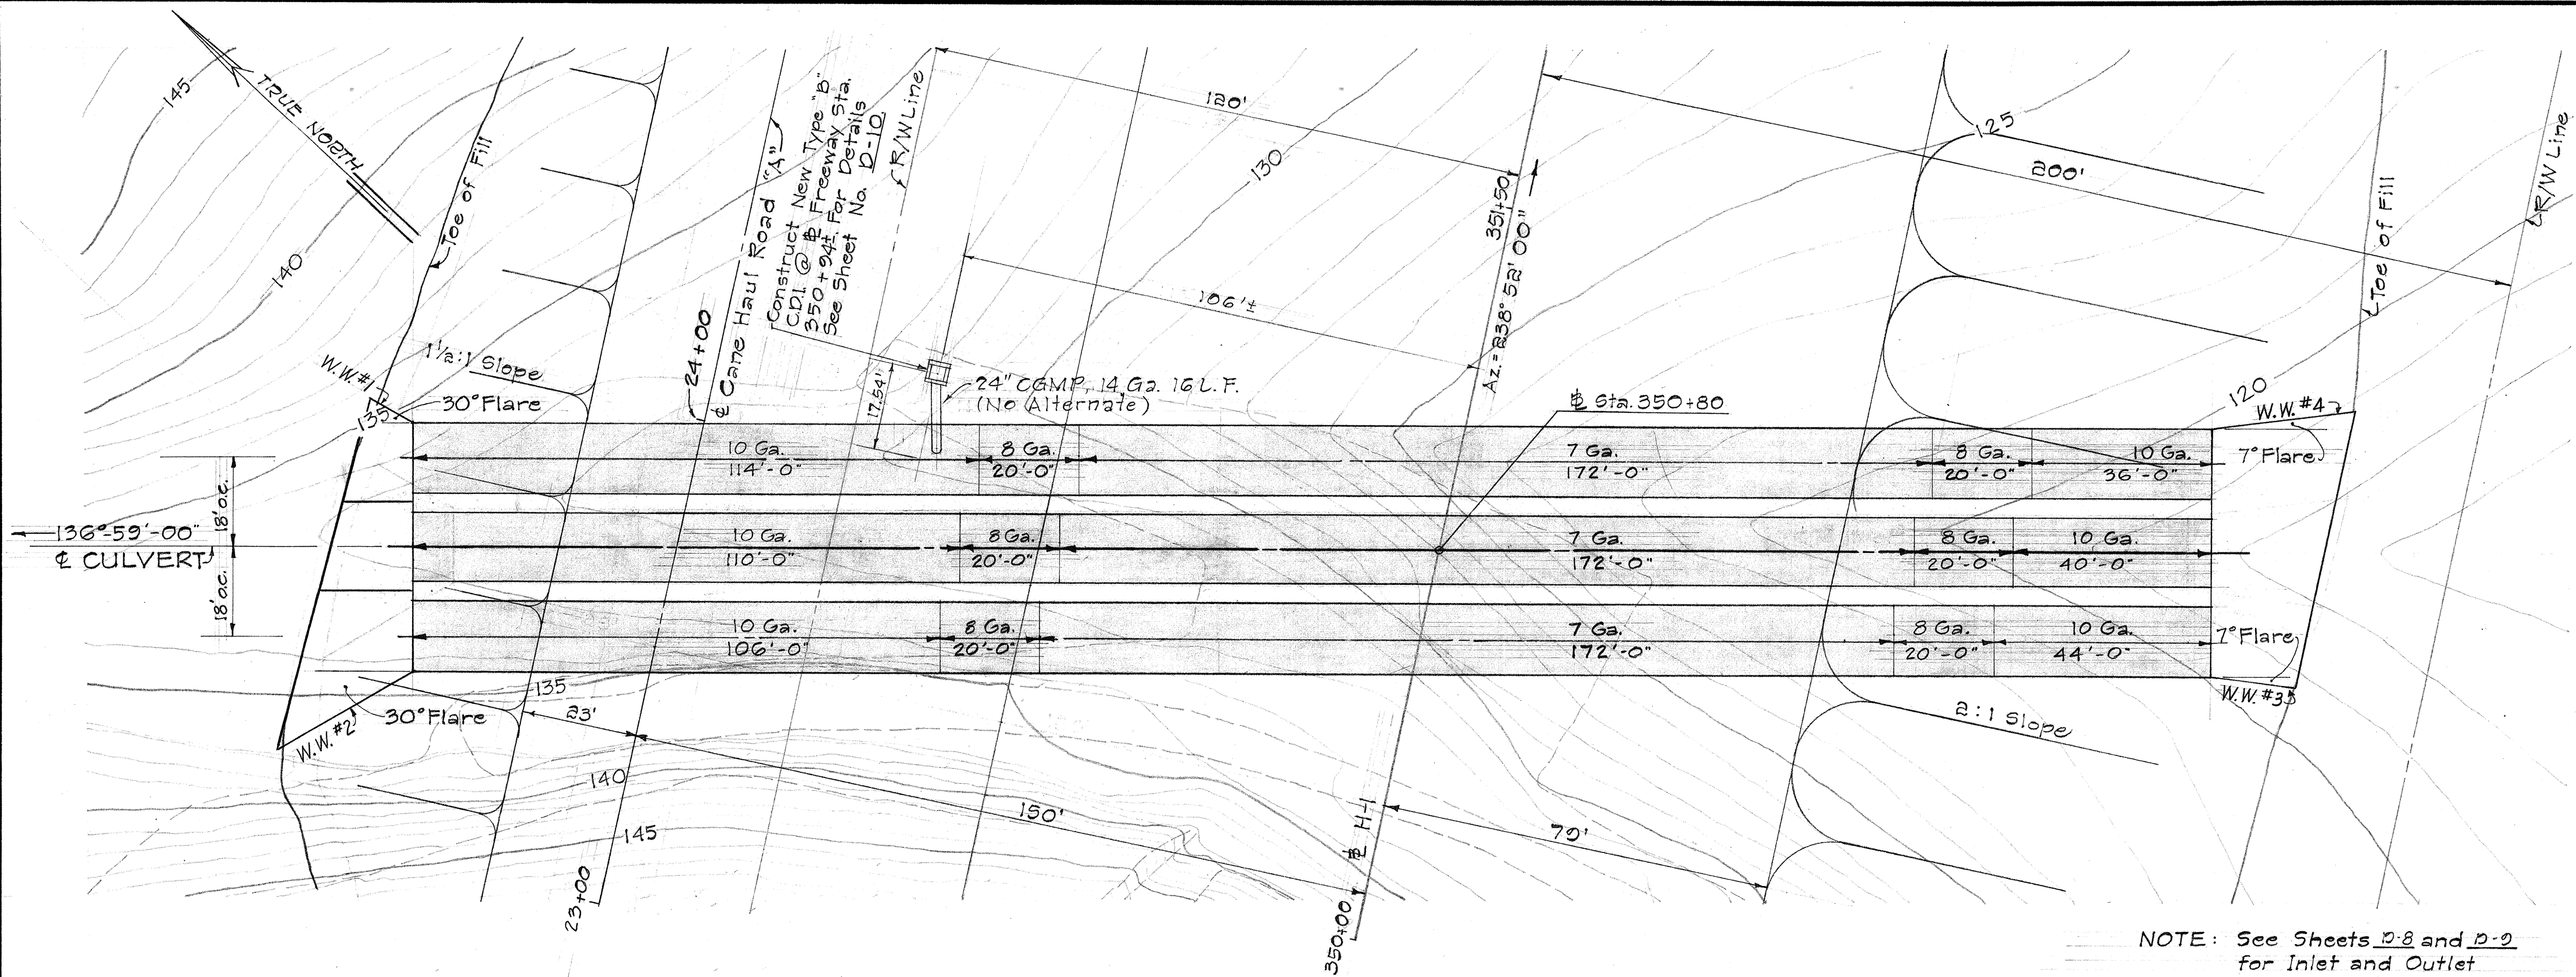

PLAN
Scale: 1" = 20'

NOTE: See Sheets D-8 and D-9
for Inlet and Outlet
Structure Details.

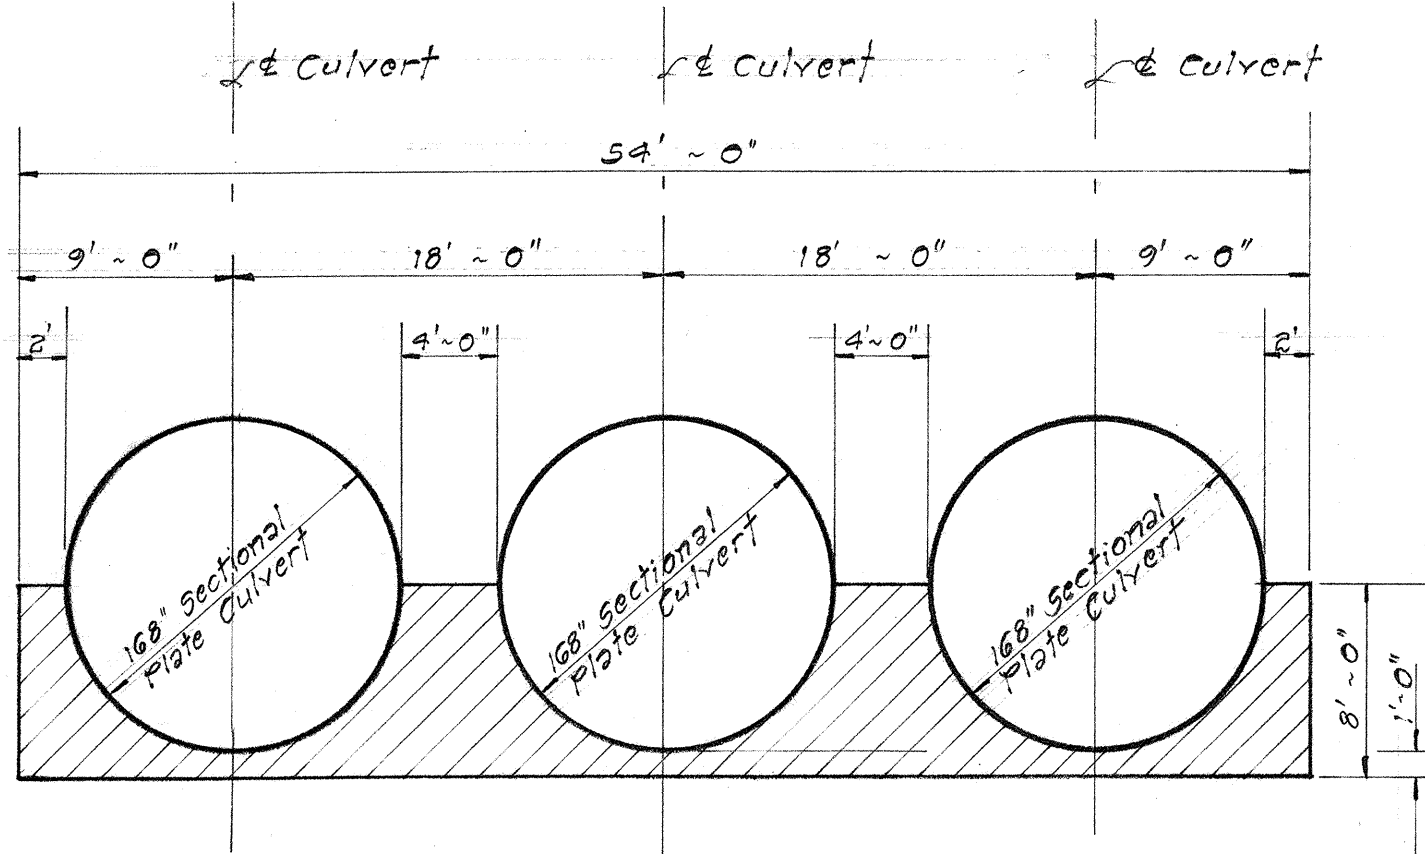

TYPICAL SECTION OF
UNTREATED BASE COURSE FOUNDATION MATERIAL
Scale: 1/8" = 1'-0"

ESTIMATED QUANTITIES

Structure Excavation	3432.18	2520 cy.
Ditch & Channel Excavation		90 cy.
Untreated Base Course for		
Pipe Foundation	3010.11	2700 cy.
Class A-1 Concrete		188 cy.
Reinforcing Steel		17,283 lb.
Filter Material	18.2	22 cy.
168" Sectional Plate Pipe Culvert		1,086 l.f.

GENERAL NOTES

- The Triple 168" Sectional Plate Culvert shall have its vertical diameter factory elongated 5%.

THIS SHEET SUPERSEDES SHEET NO. 57


STATE OF HAWAII
DEPARTMENT OF TRANSPORTATION
HIGHWAYS DIVISION

DRAINAGE STRUCTURE DETAILS
TRIPLE 168" SECTIONAL PLATE
PIPE CULVERTS @ R. STA. 350+80

INTERSTATE ROUTE H-1
PROJ. No. I-HI-1 (32):5, UNIT 1

Scale: As Shown Date: Sept. 1966


SHEET No. D-7 OF 19 SHEETS

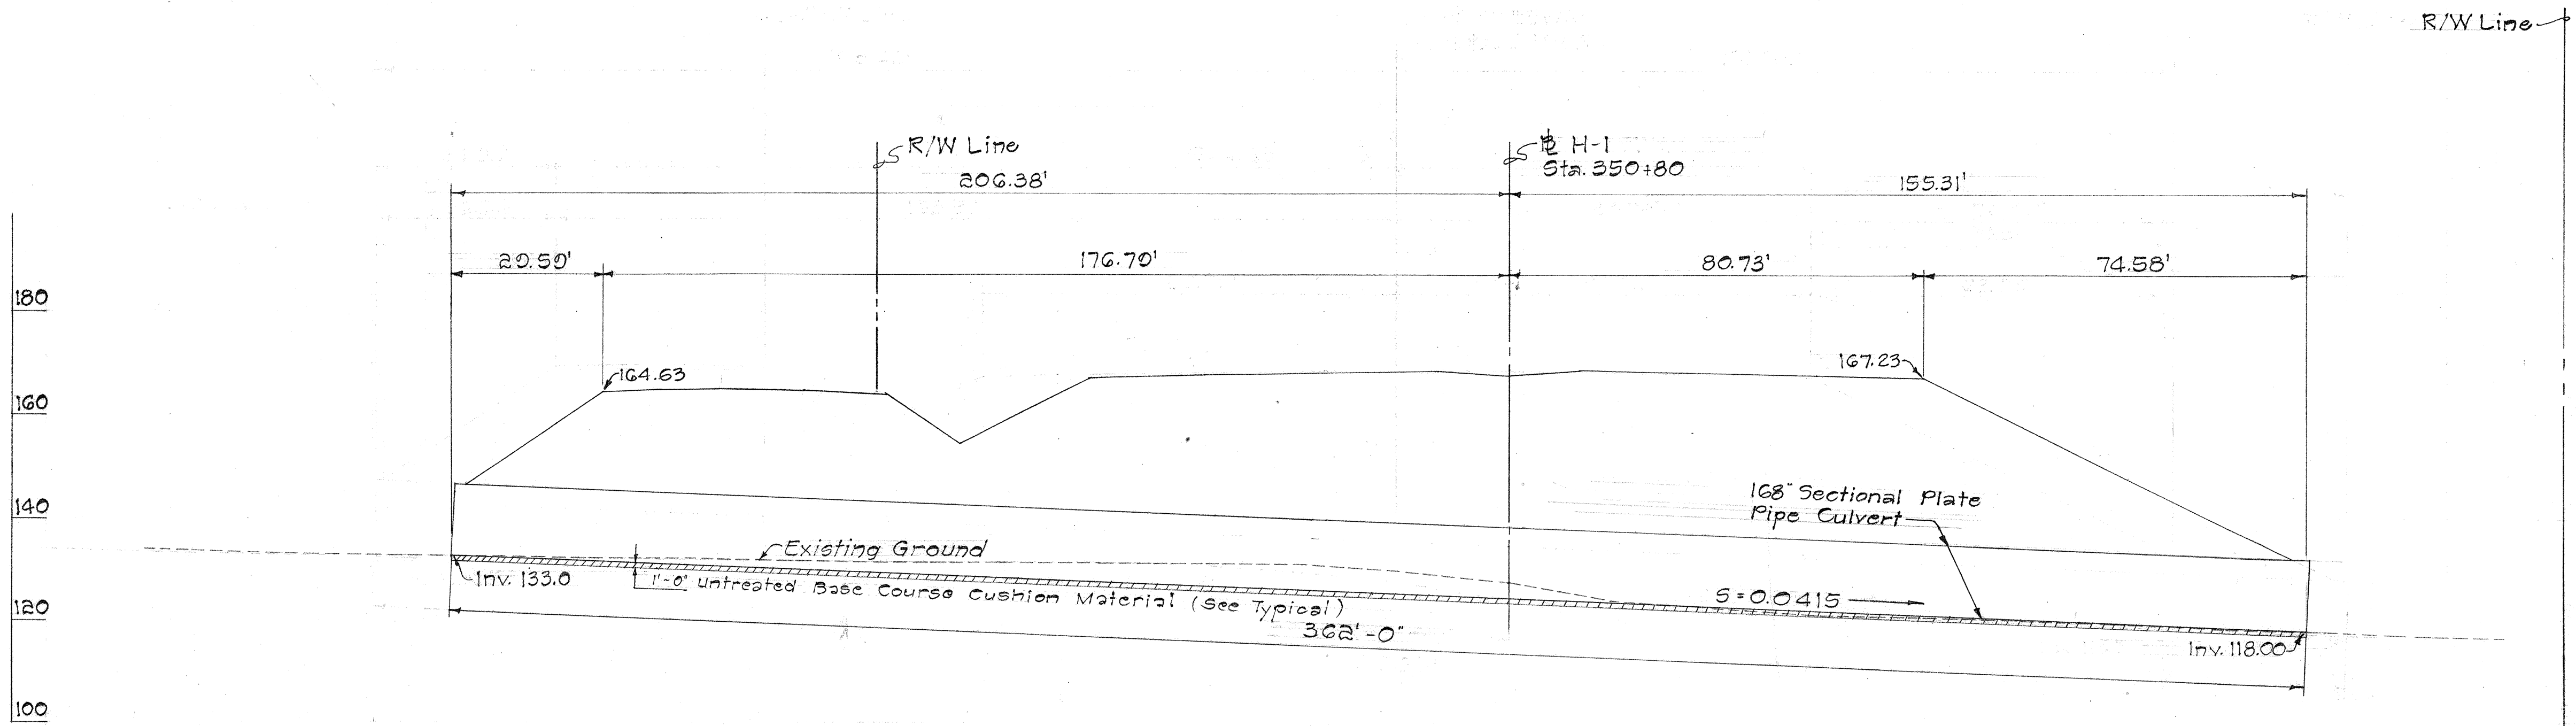


PROFILE @ C. OF TRIPLE 168" SECTIONAL PLATE PIPE CULVERTS
Scale: 1" = 20'

SURVEY PLOTTED BY	DATE
DRAWN BY	
DESIGNED BY	
NOTED BY	
CHECKED BY	
ORIGINAL PLAN	
NOTE BOOK	
No.	

FED. ROAD DIST. NO.	STATE	FED. AID PROJ. NO.	FISCAL YEAR	SHEET NO.	TOTAL SHEETS
HAWAII	HAW.	HI-1305	1966	23	73
UNIT 1					

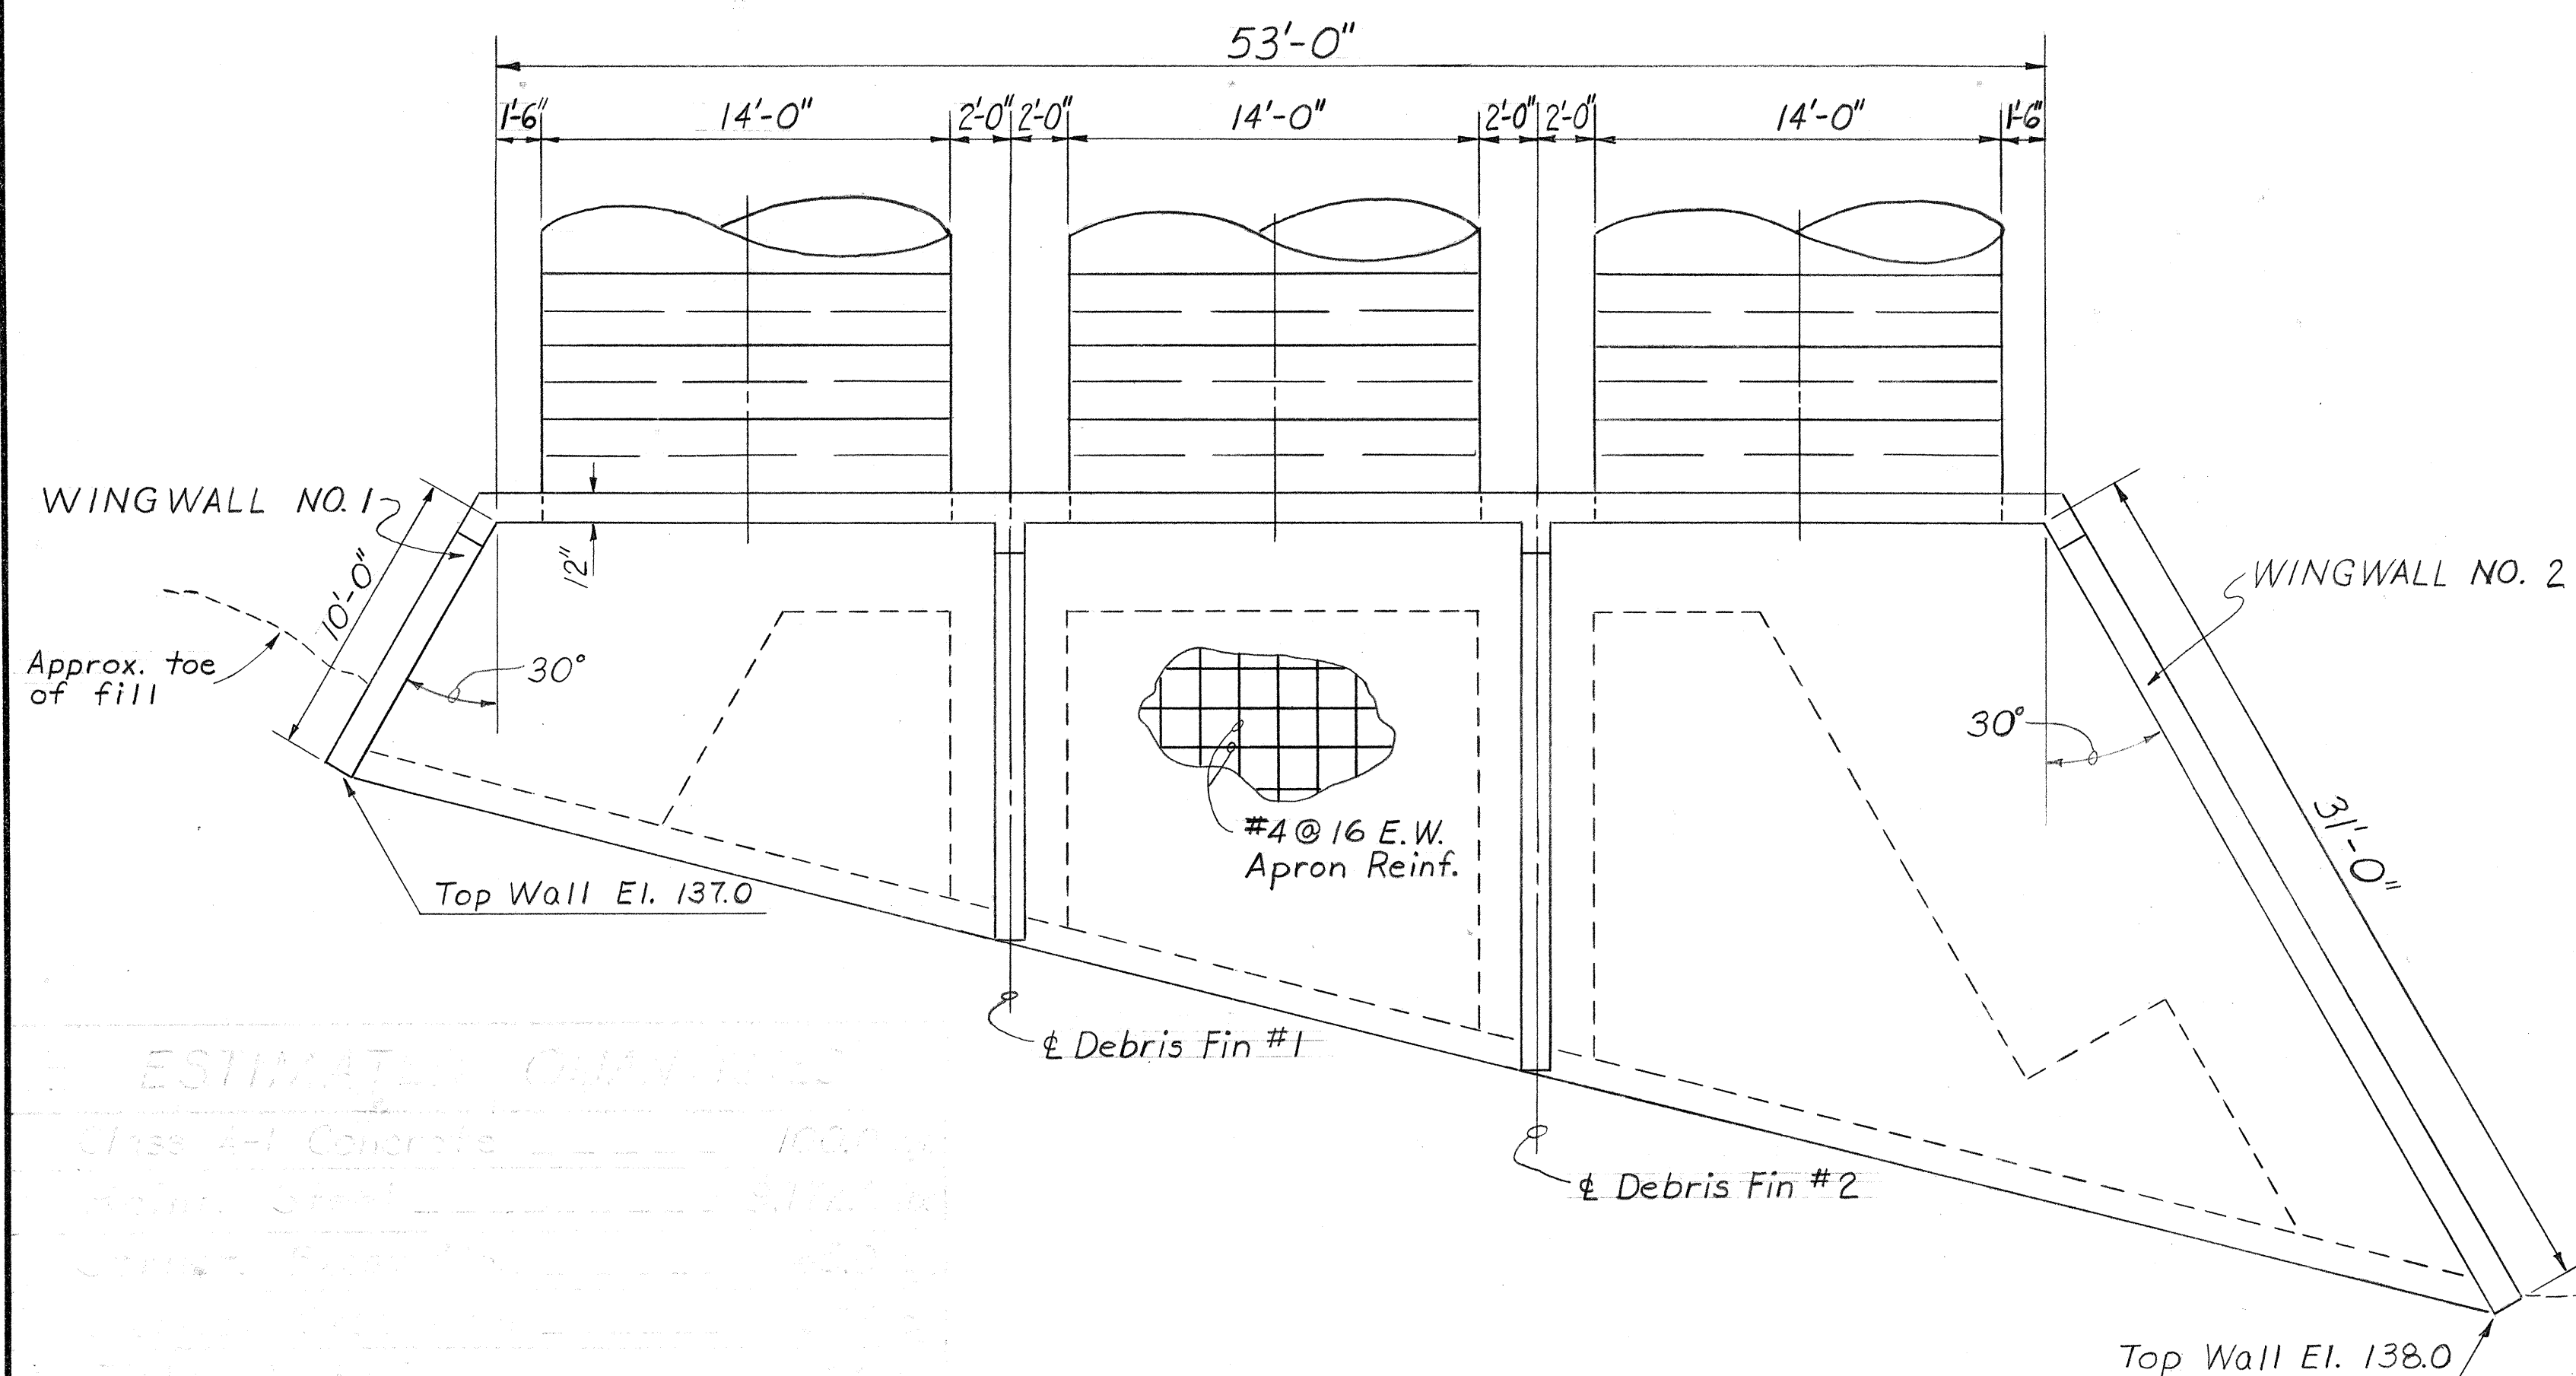


INLET PLAN
Scale 1" = 5'-0"

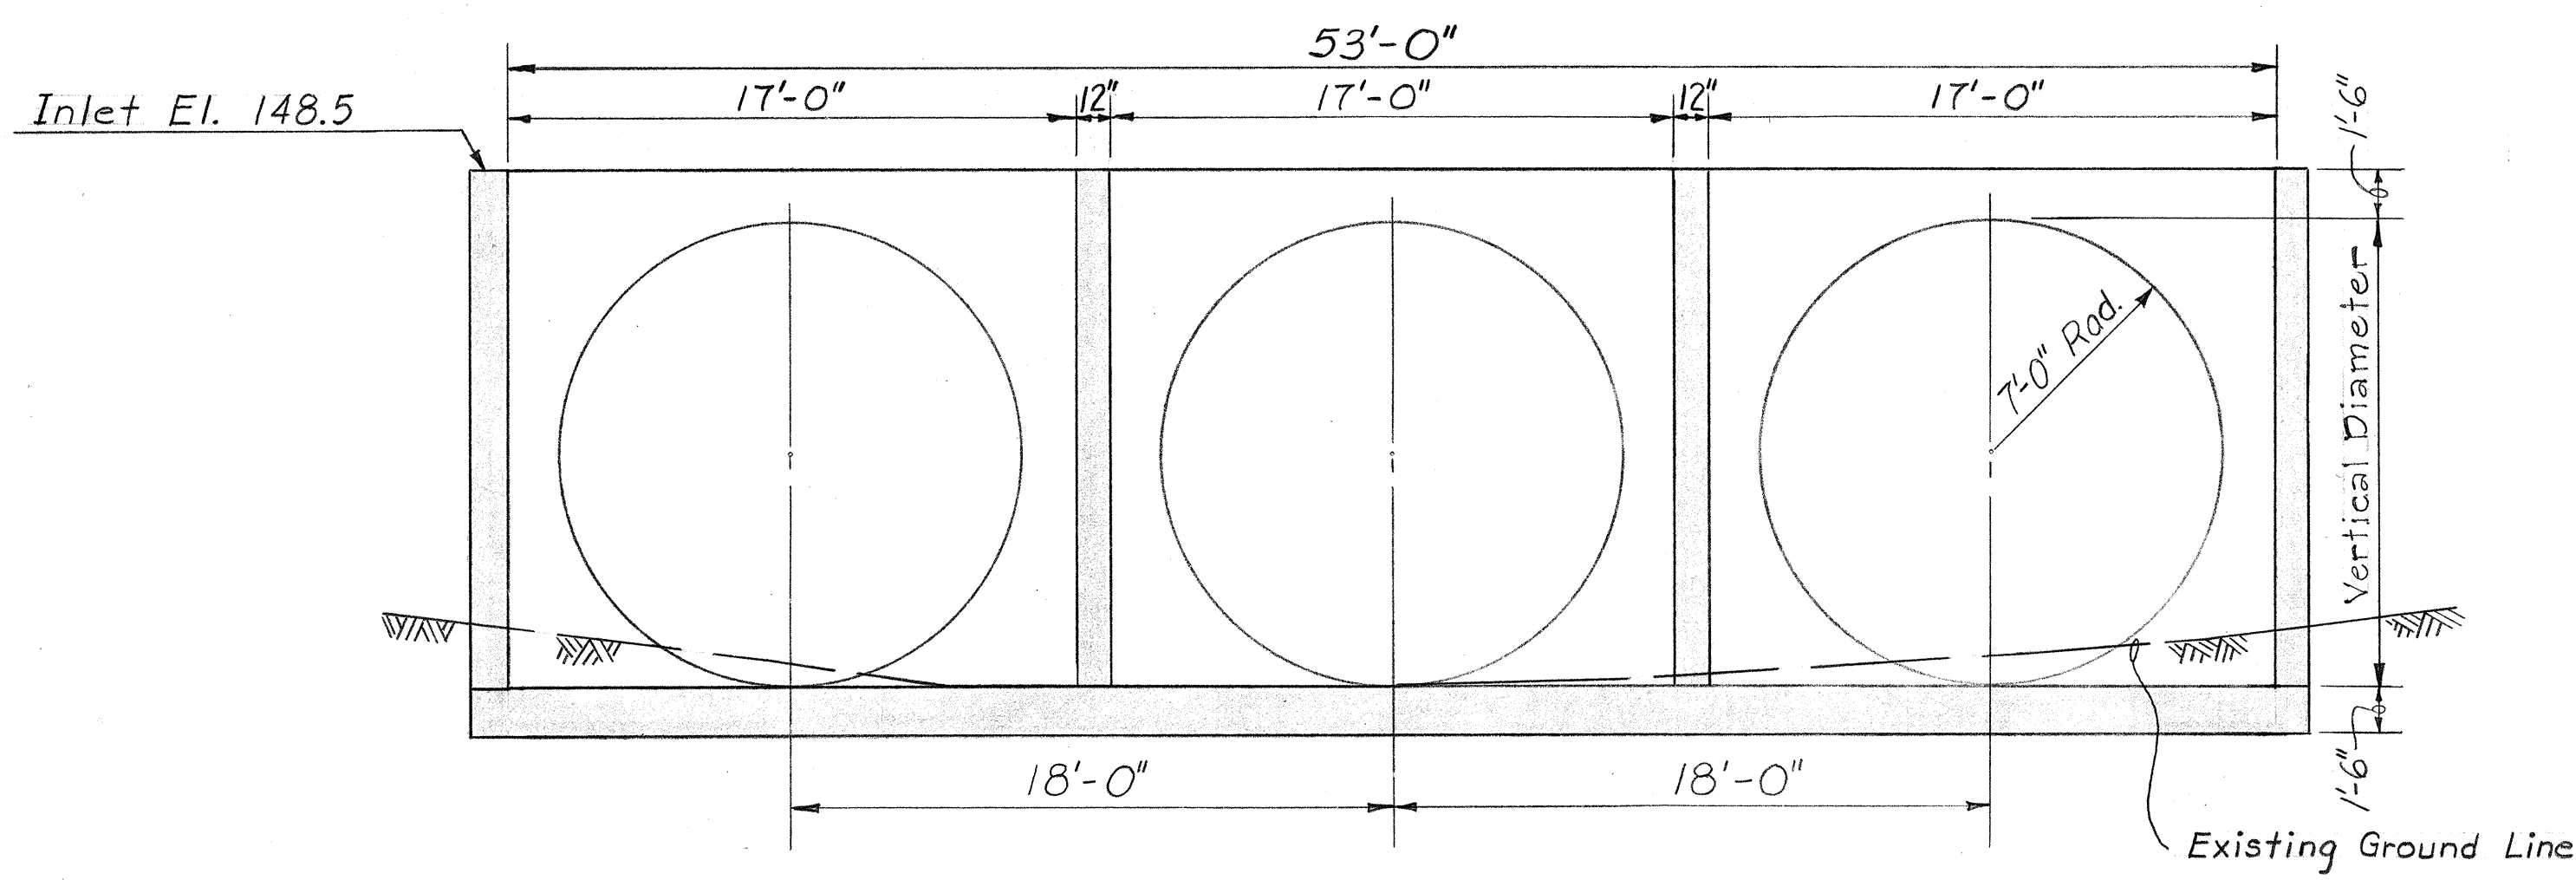


INLET HEADWALL ELEVATION
Scale 1" = 5'-0"


Note:
For reinforcing layout, see Outlet Headwall Elevation.

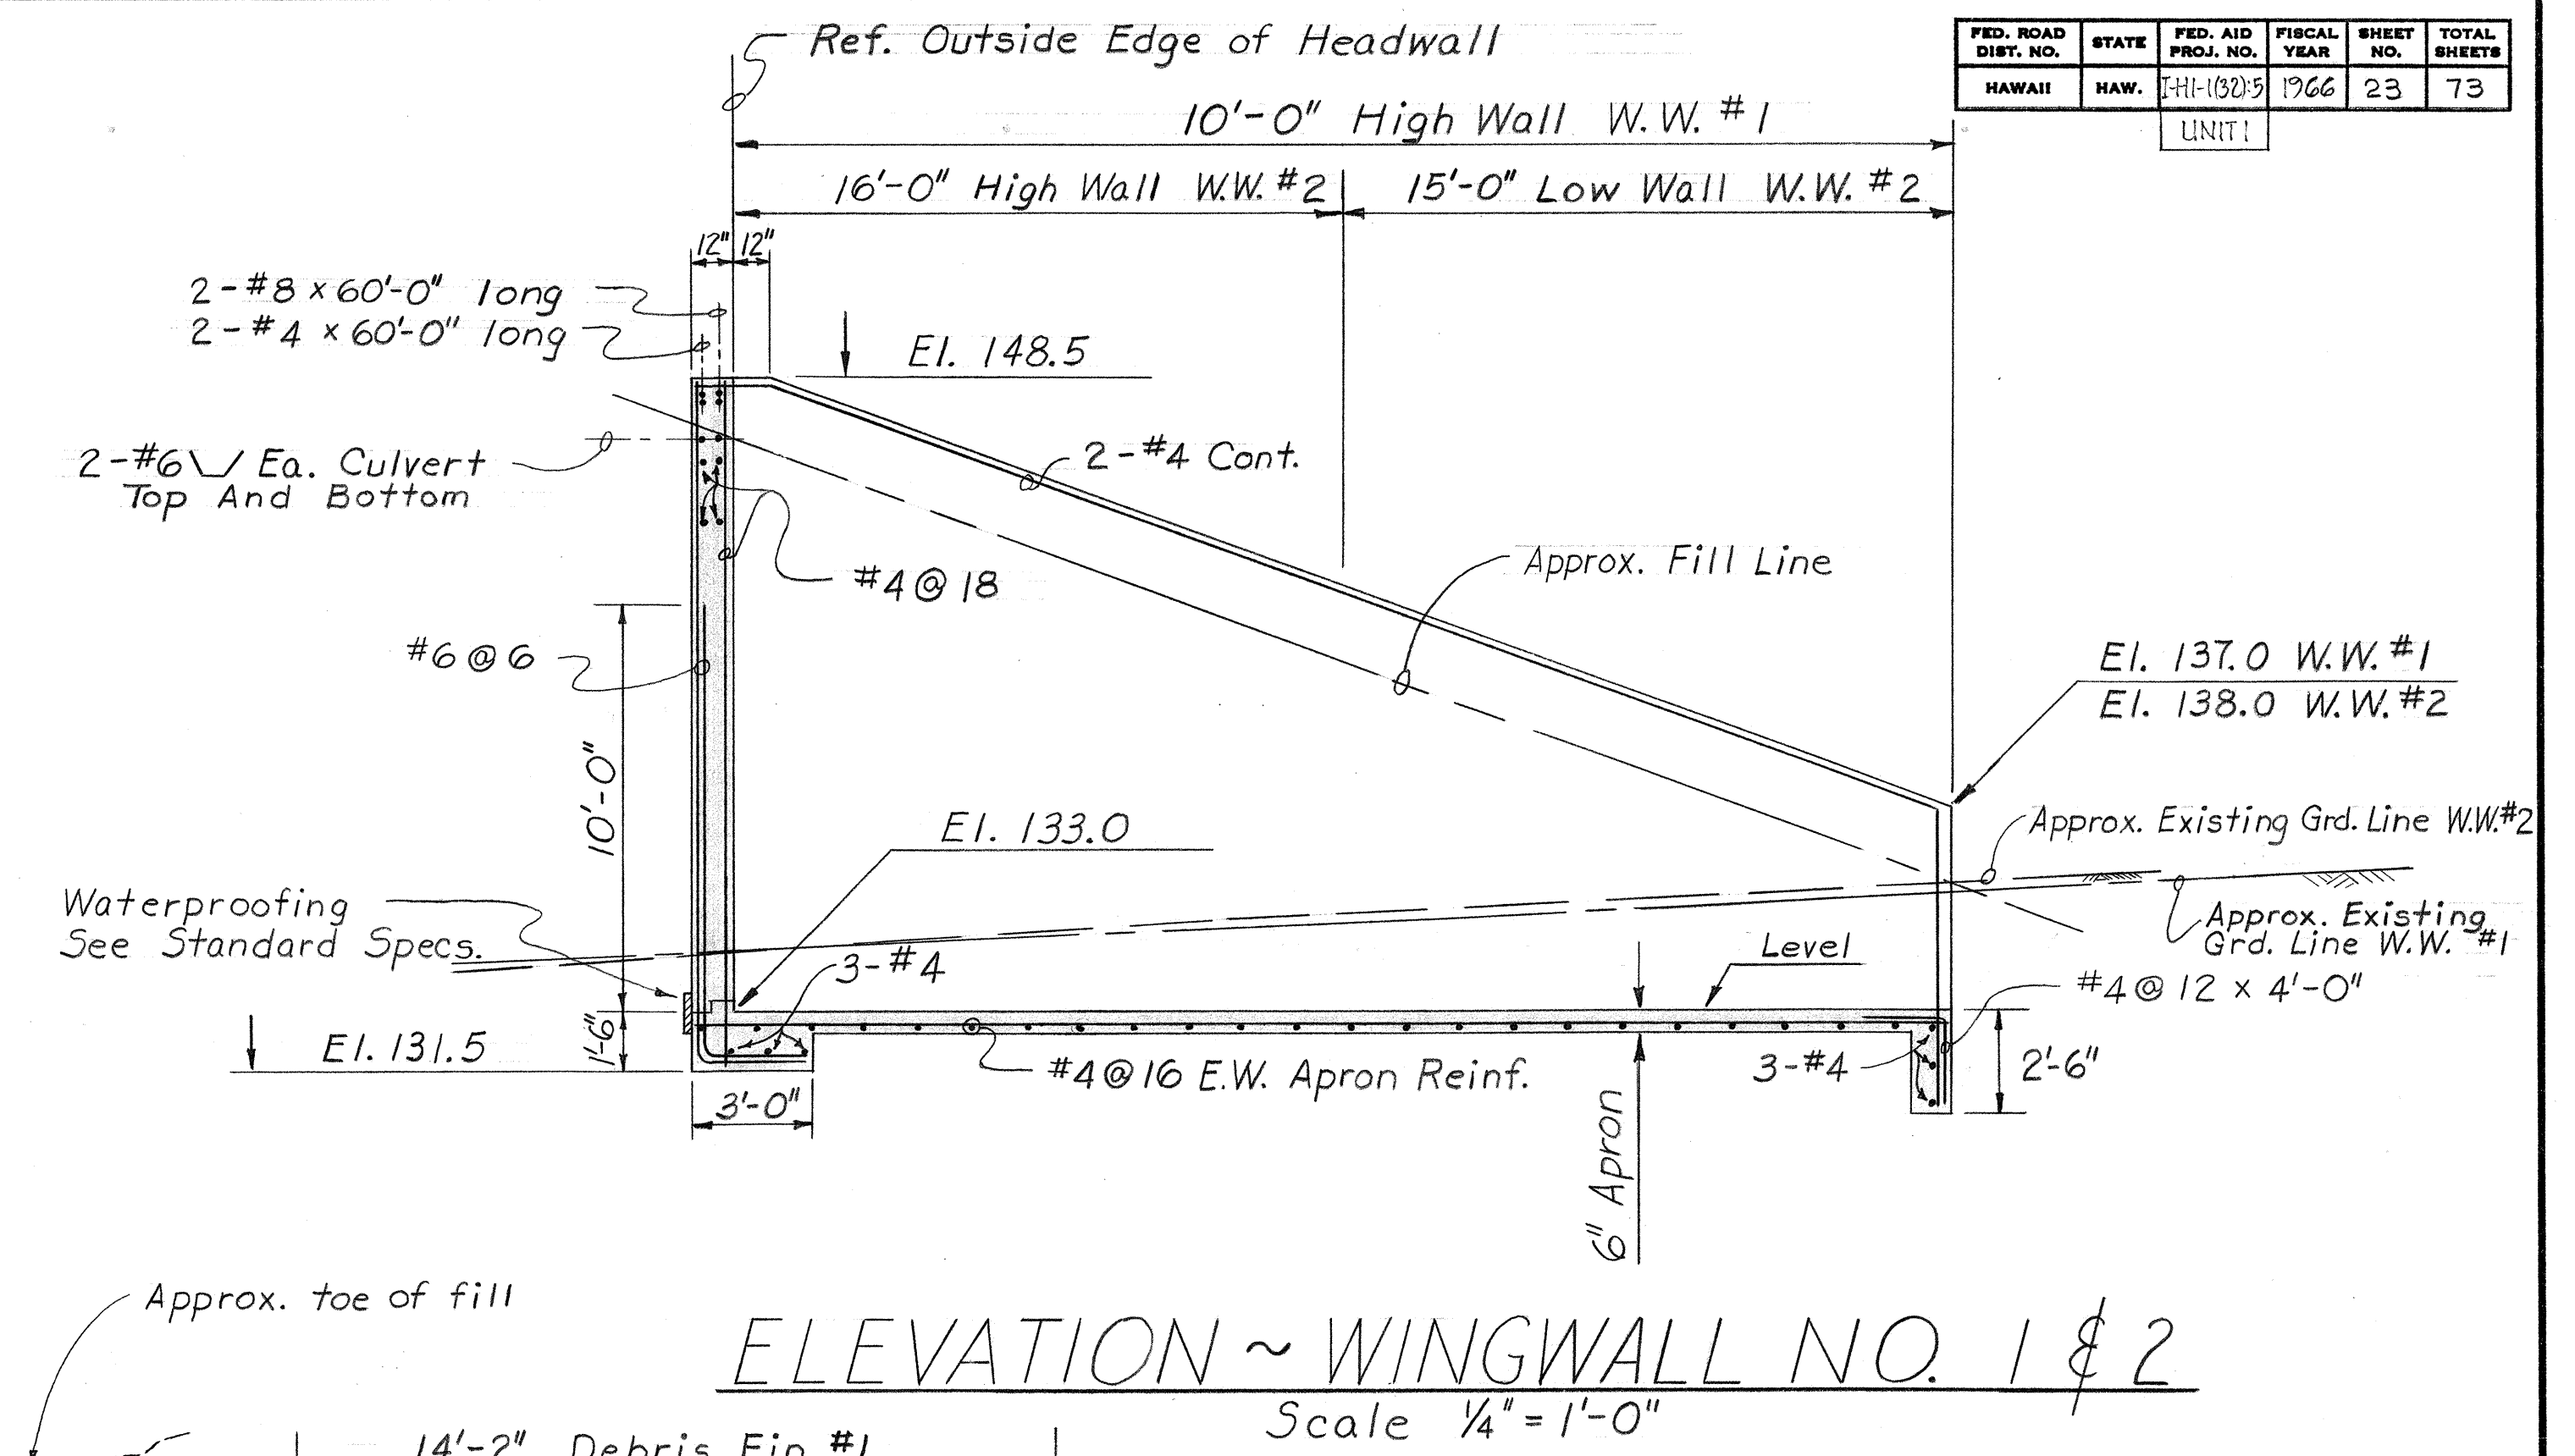


ELEVATION ~ WINGWALL NO. 1 & 2
Scale 1/4" = 1'-0"

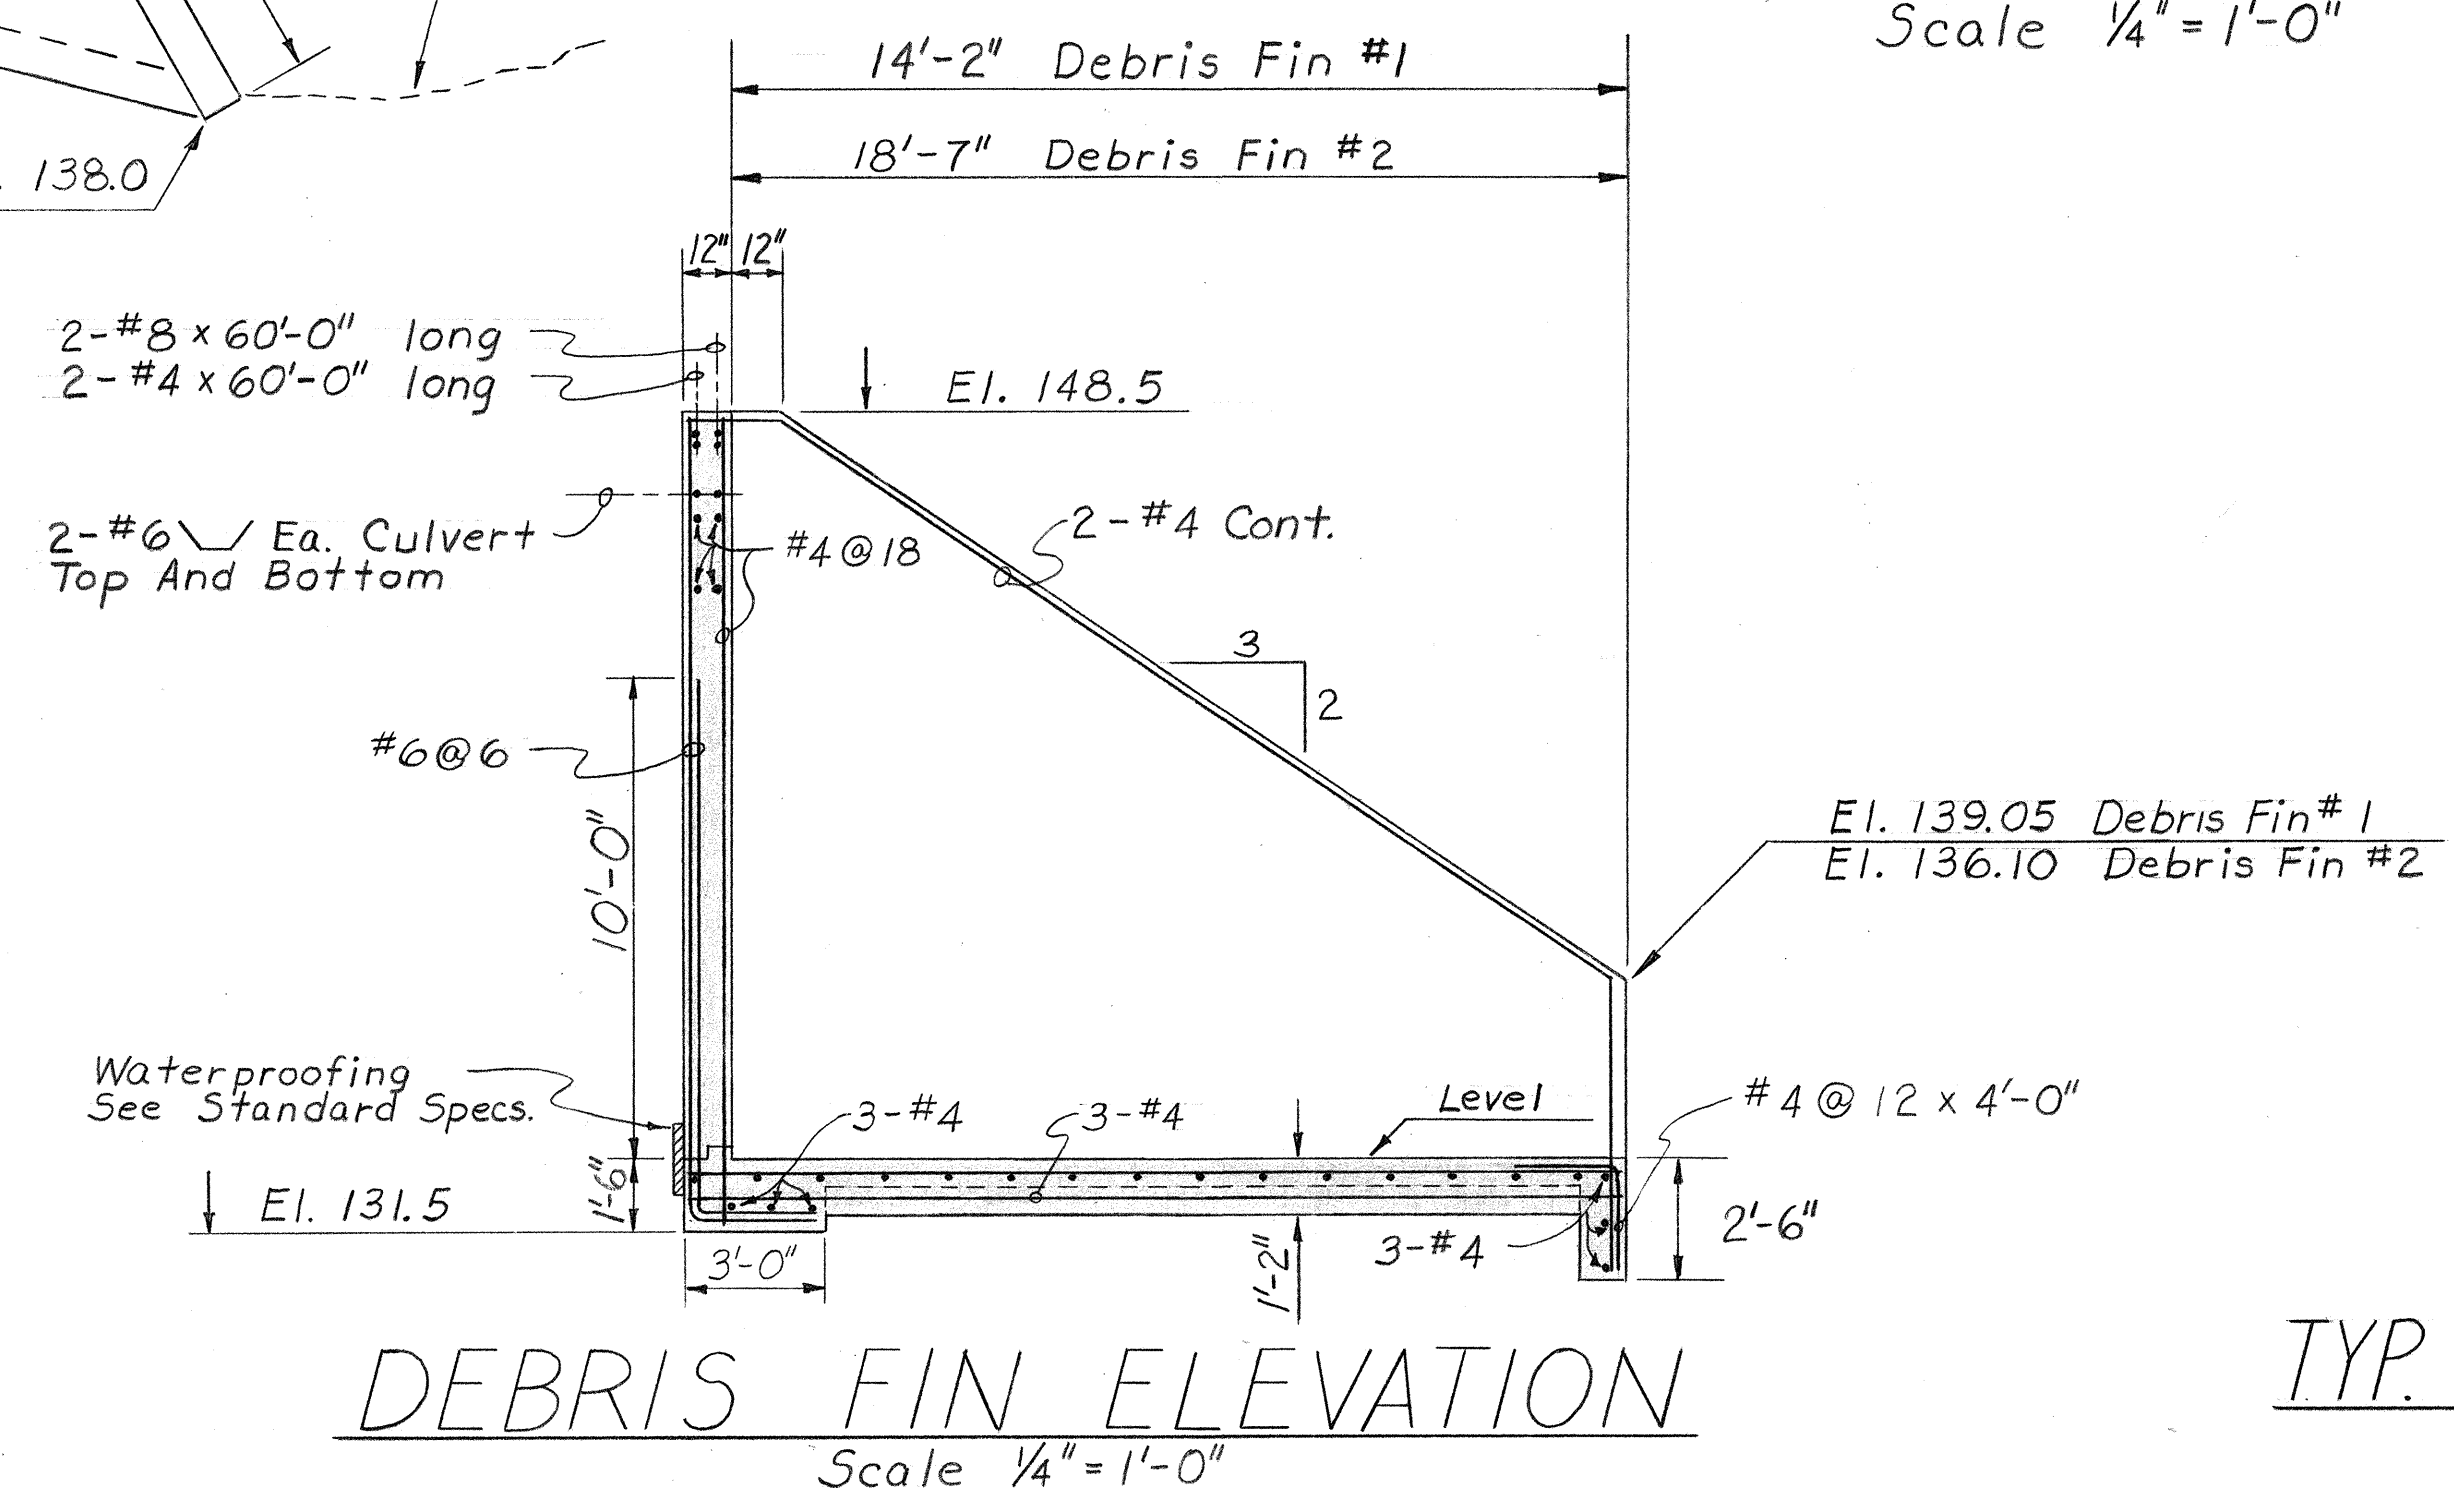

DEBRIS FIN ELEVATION
Scale 1/4" = 1'-0"

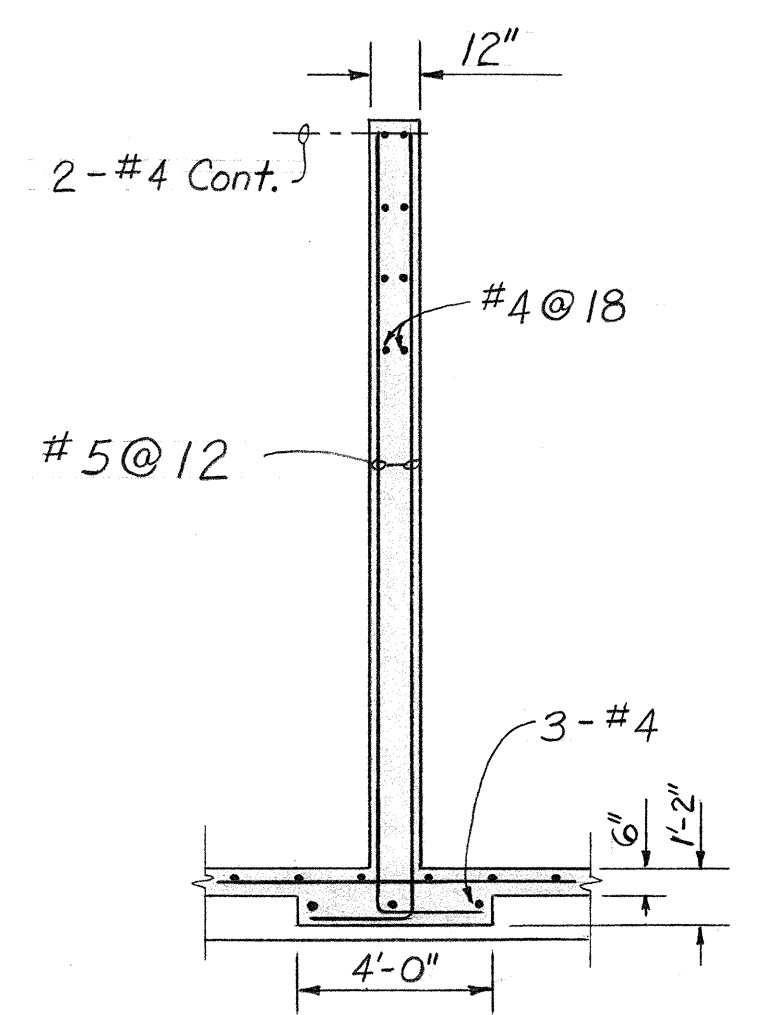

TYP. SECTION THRU FIN
Scale 1/4" = 1'-0"

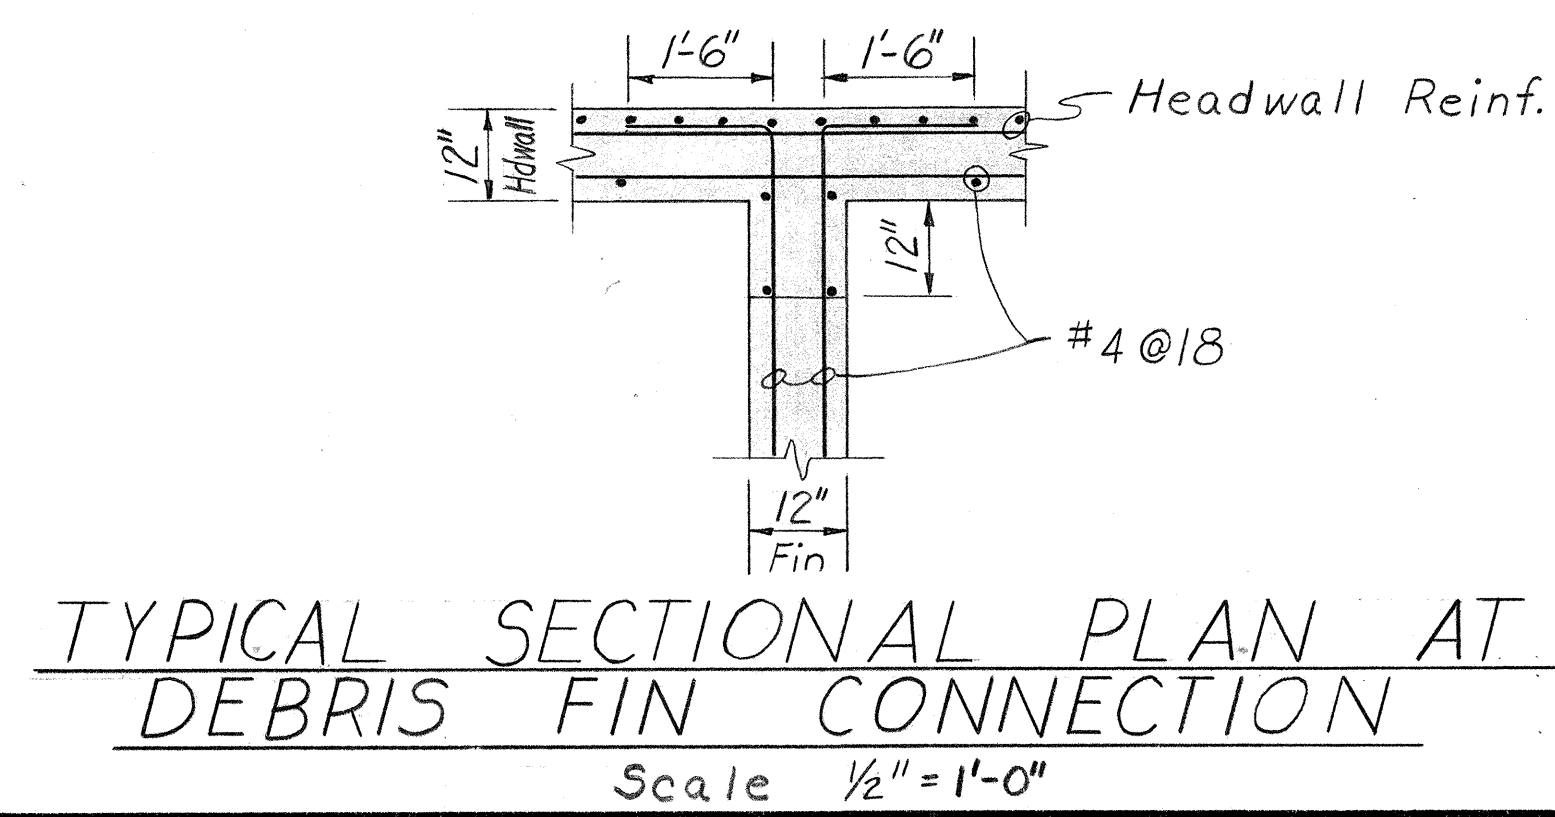

TYPICAL SECTIONAL PLAN AT DEBRIS FIN CONNECTION
Scale 1/2" = 1'-0"

STATE OF HAWAII
DEPARTMENT OF TRANSPORTATION
HIGHWAYS DIVISION

DRAINAGE STRUCTURE DETAILS
TRIPLE 168" SECTIONAL PLATE
PIPE CULVERTS @ STA. 350+80


INTERSTATE ROUTE H-1
PROJ. No. I-HI-1(32)-3, UNIT 1

Scale: As Shown Date: Sept., 1966
SHEET No. 23 OF 73 SHEETS


DATE	_____
SURVEY PLOTTED BY	_____
DRAWN BY	_____
DESIGNED BY	_____
CHECKED BY	_____
ORIGINAL PLAN	_____
NOTE BOOK	_____
No.	_____

FED. ROAD DIST. NO.	STATE	FED. AID PROJ. NO.	FISCAL YEAR	SHEET NO.	TOTAL SHEETS
HAWAII	HAW.	I-HI-1(32)	1966	24	73


UNIT 1

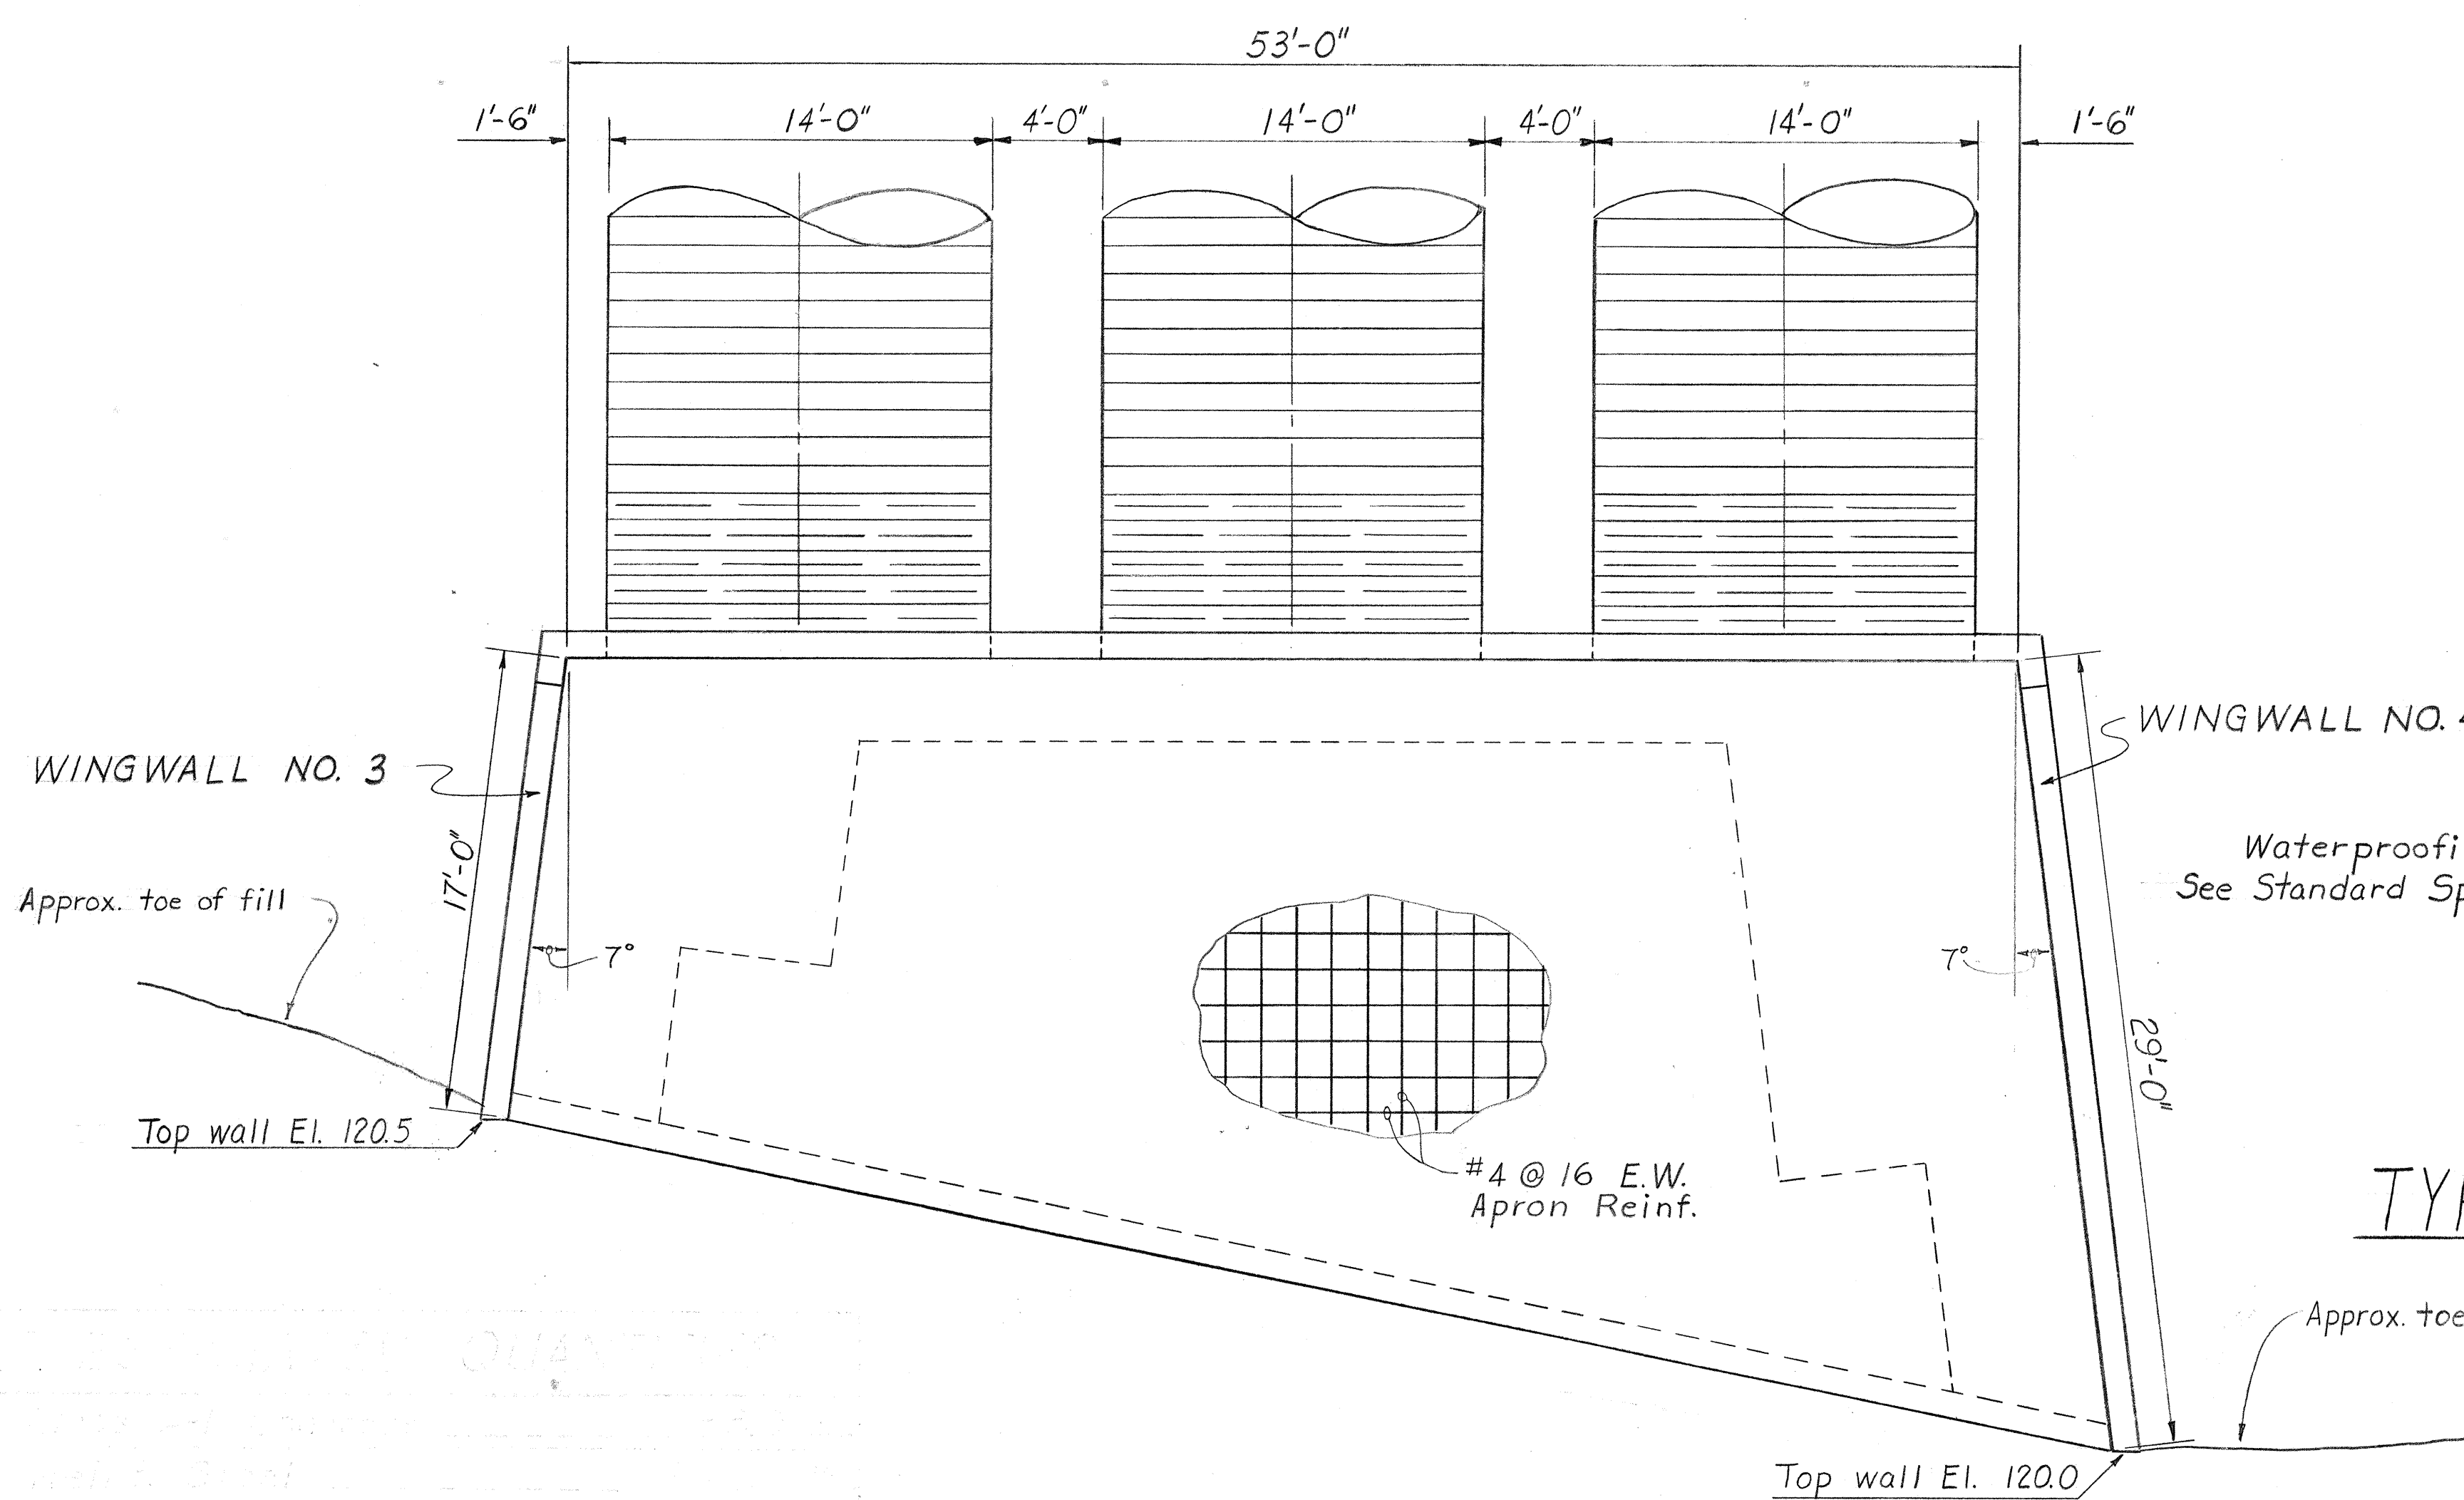


OUTLET PLAN
Scale 1" = 5'-0"

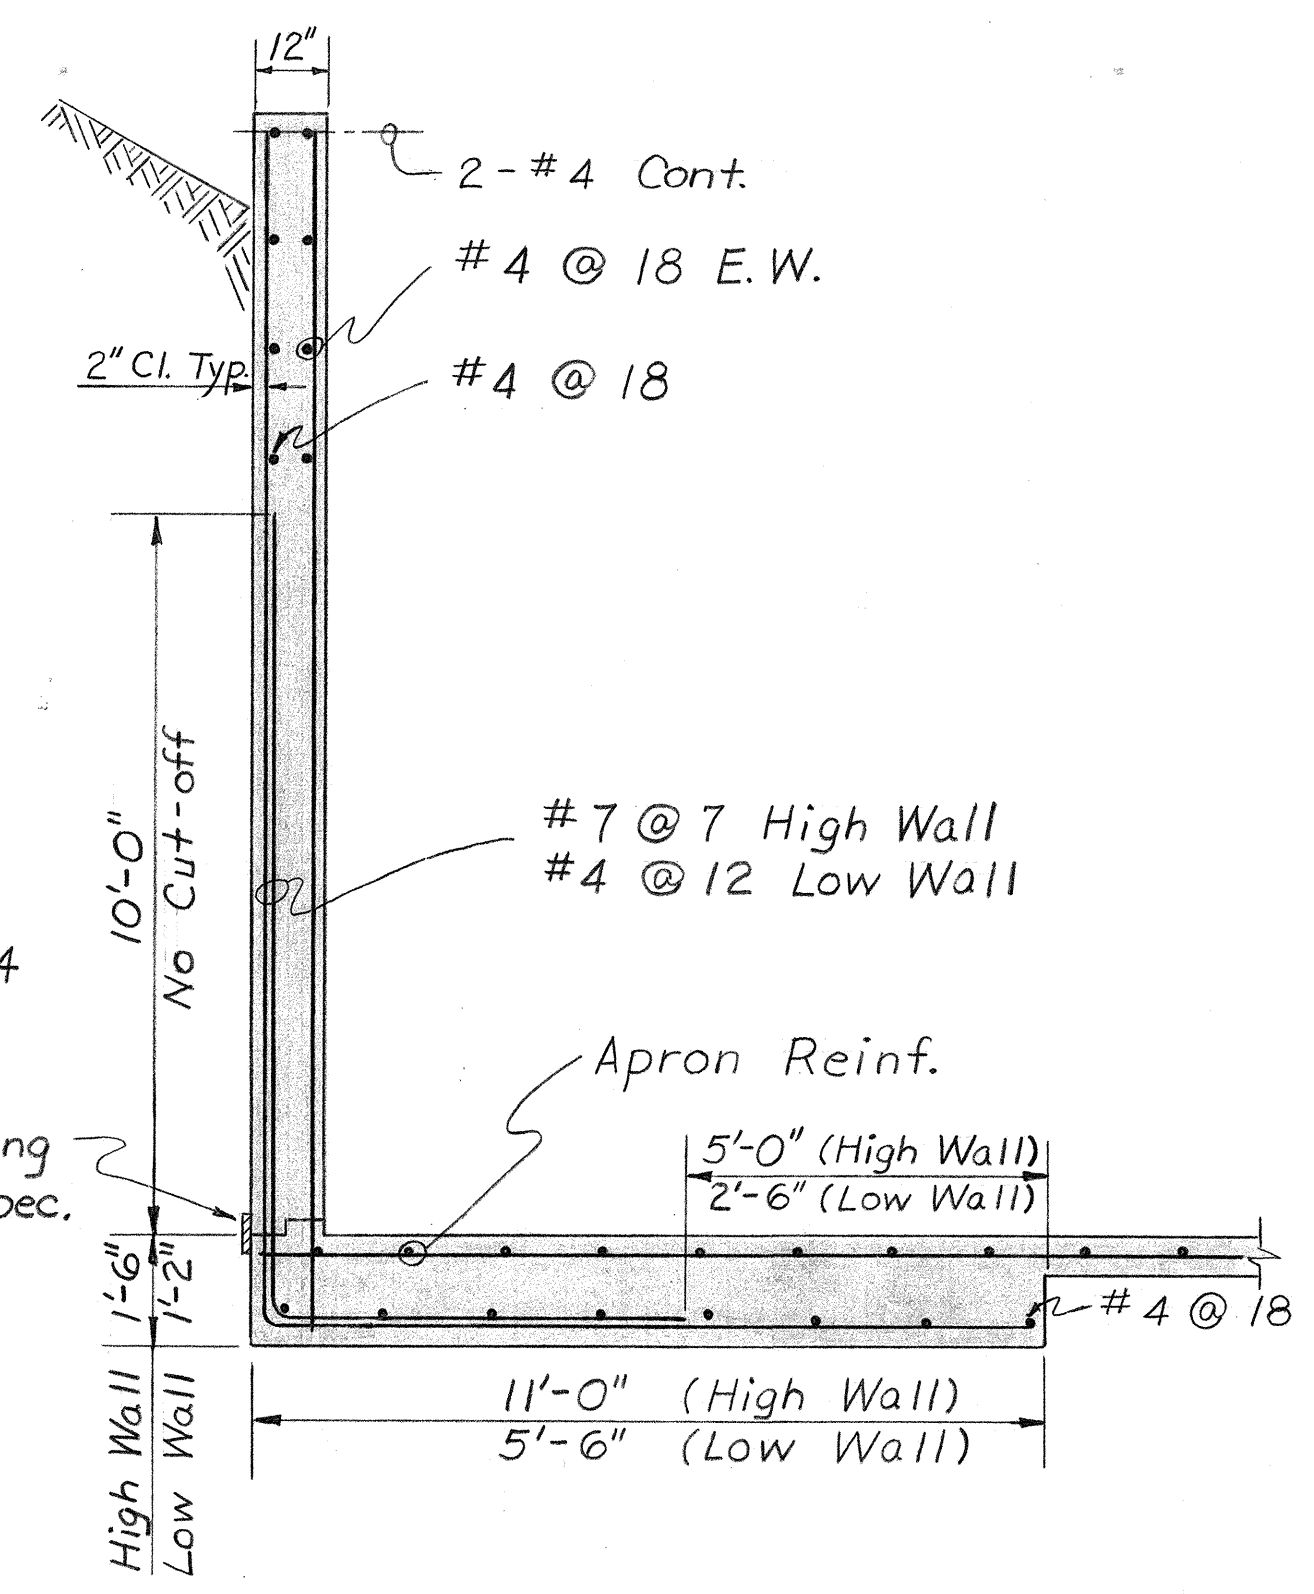


TYPICAL WINGWALL SECTION
No Scale

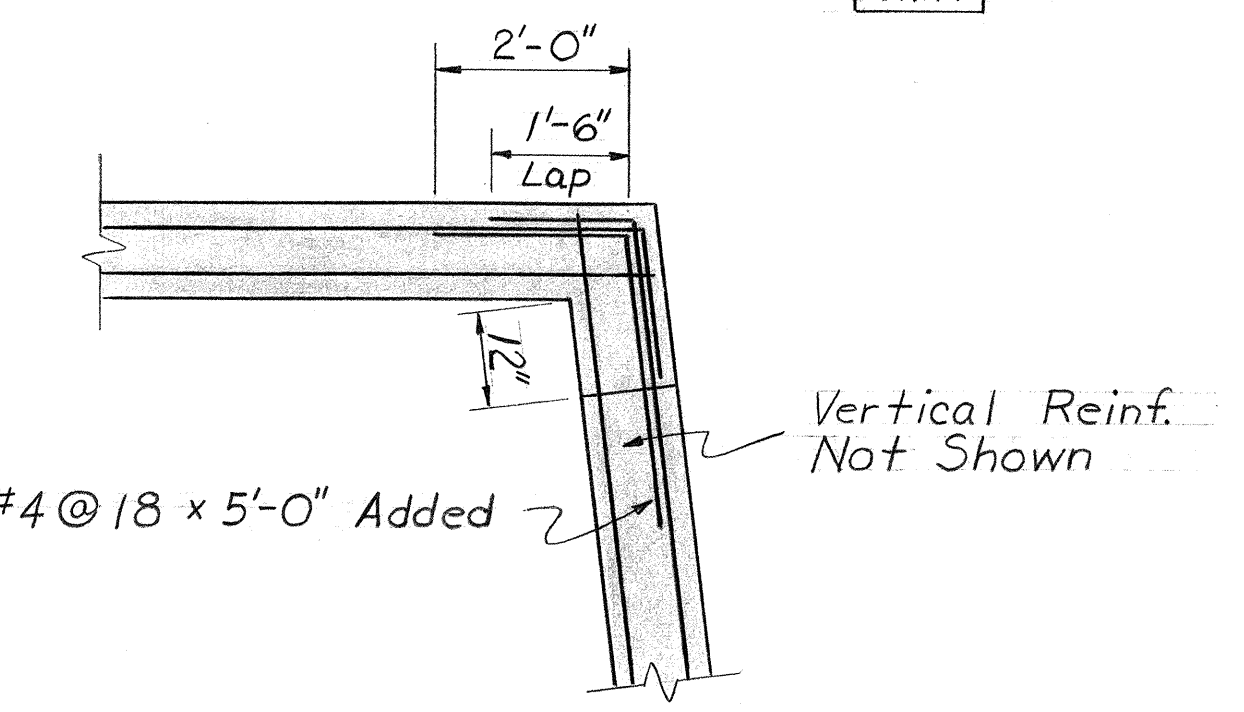


TYPICAL CORNER REINF. DETAIL AT HEADWALL
Scale 1/2" = 1'-0"

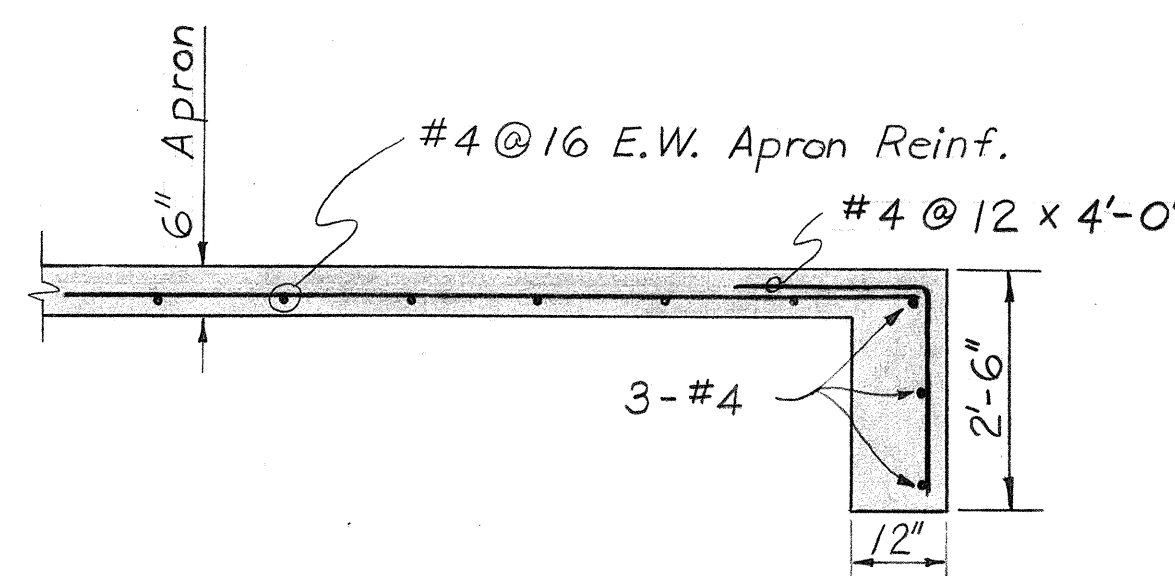

TYPICAL APRON CUT-OFF SECT.
Scale 1/2" = 1'-0"

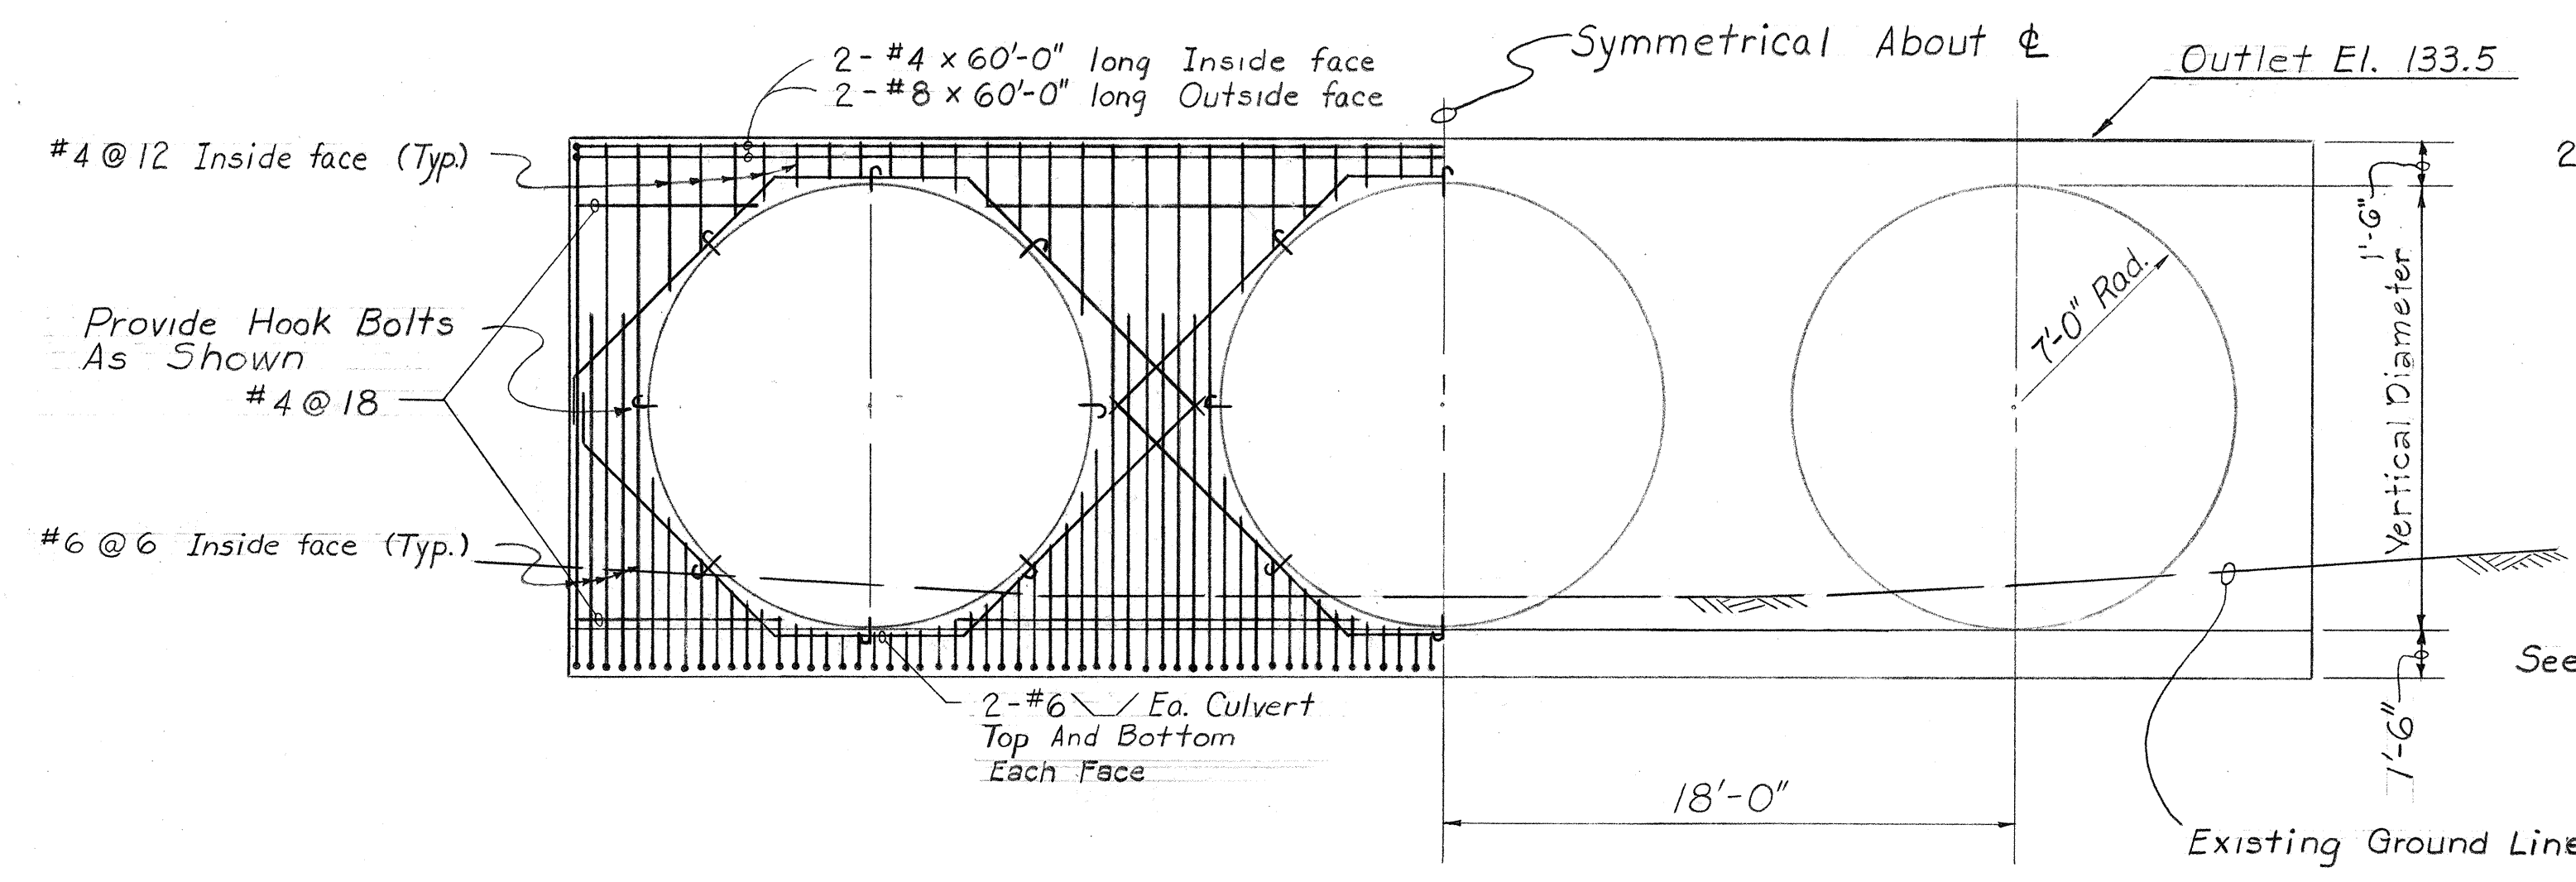

OUTLET HEADWALL ELEVATION
Scale 1" = 5'-0"

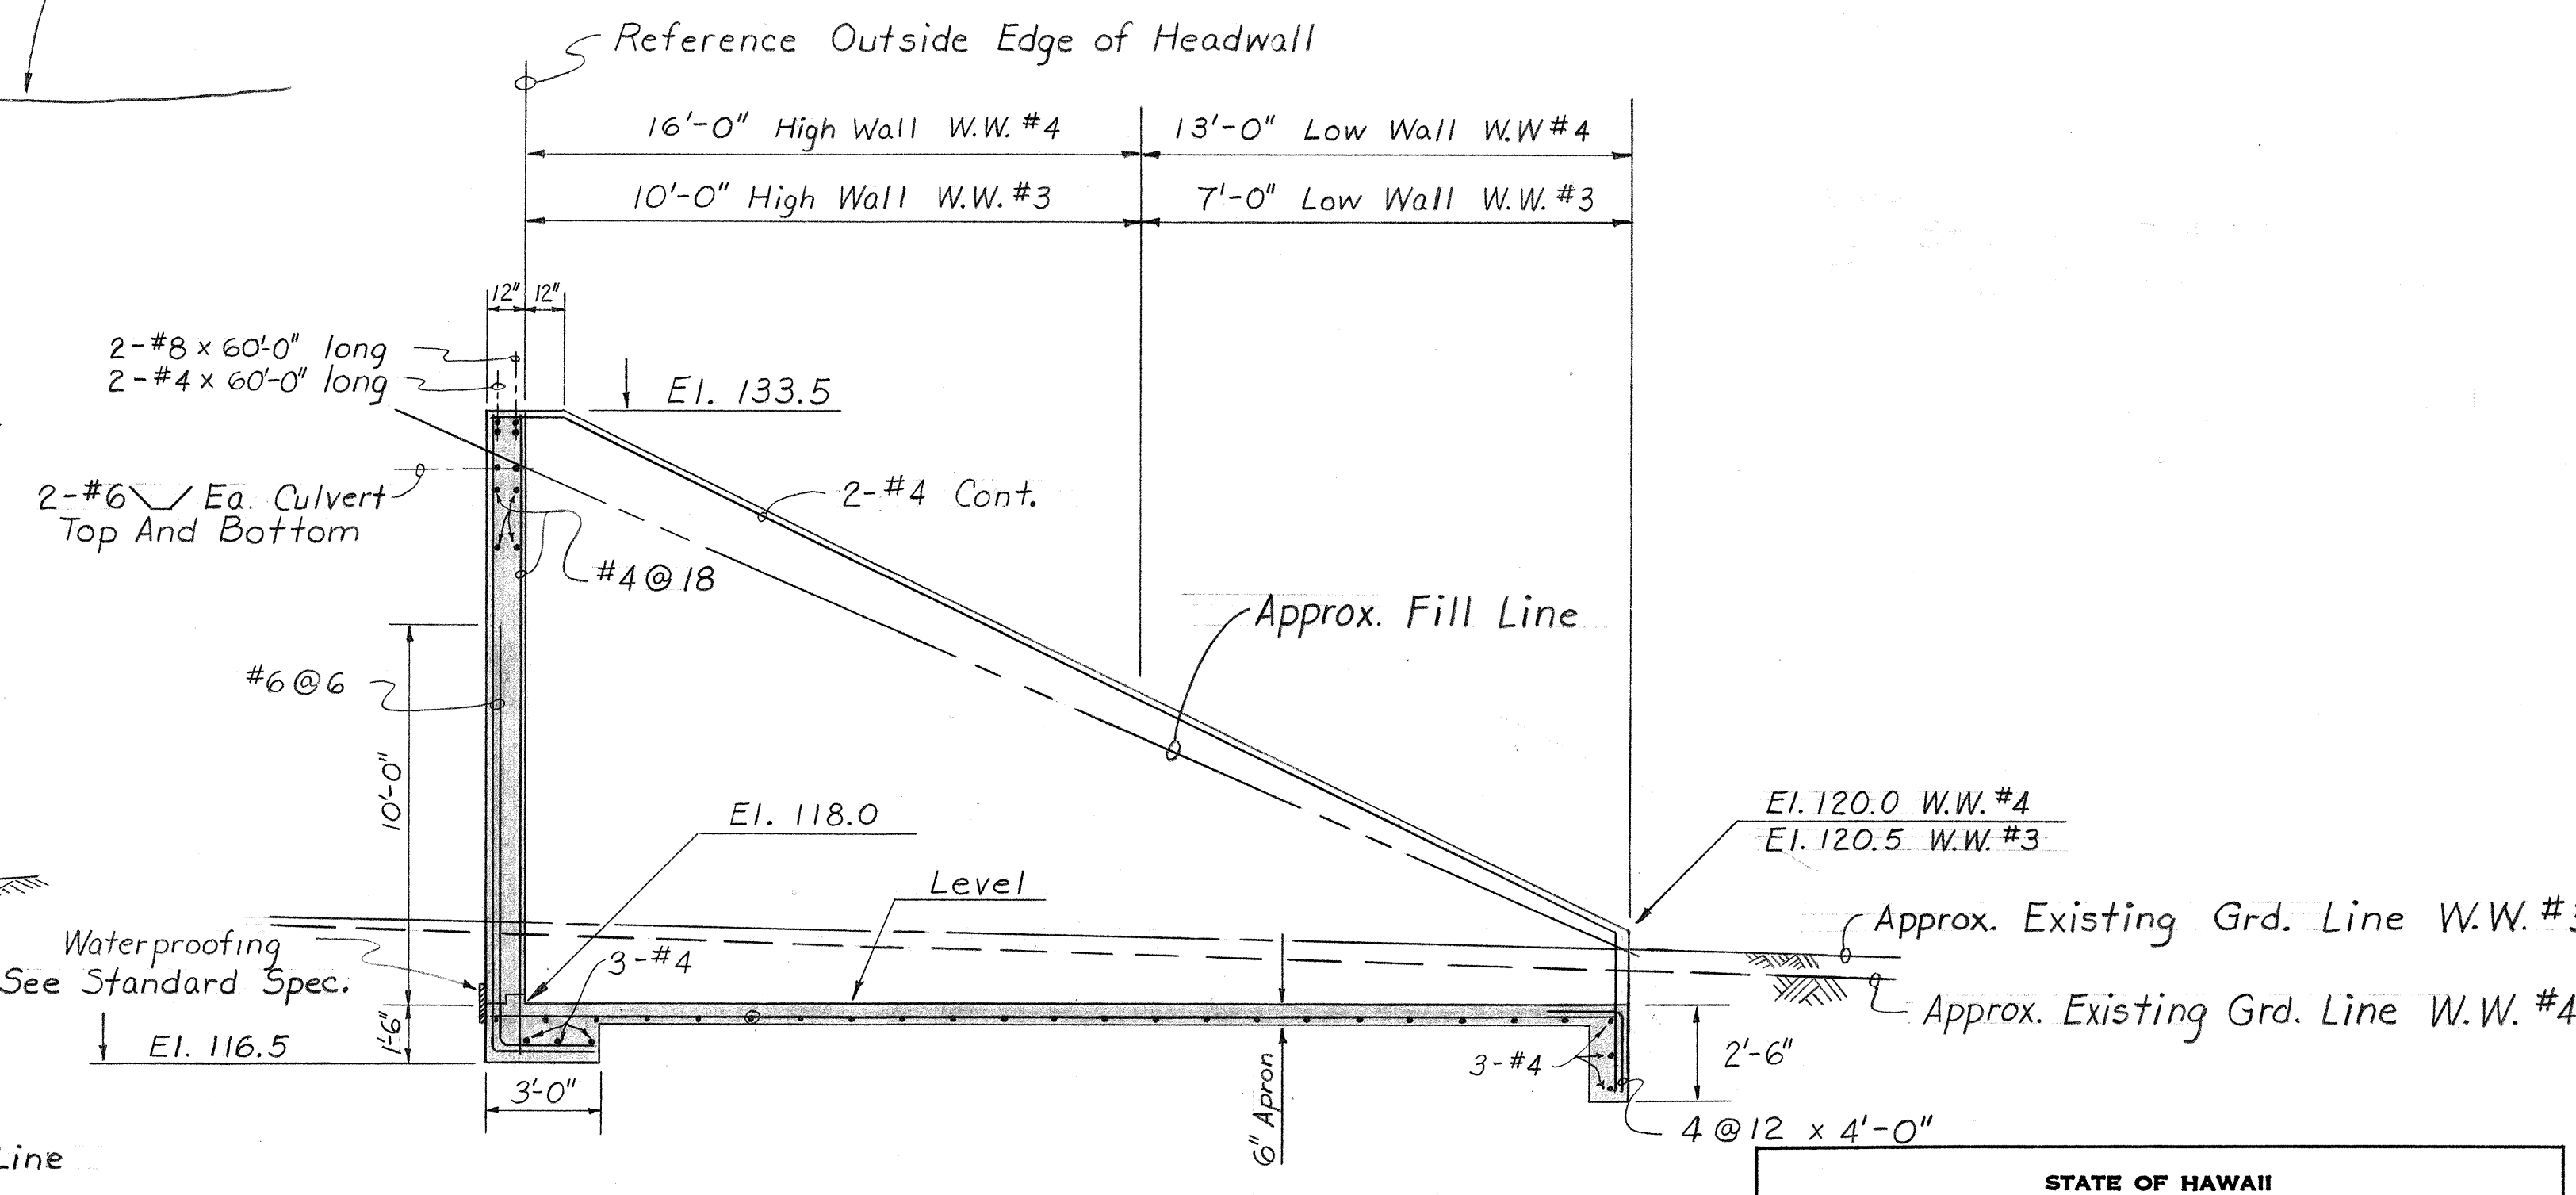


ELEVATION ~ WINGWALL NO. 3 & 4
Scale 1/4" = 1'-0"

SURVEY PLOTTED BY	DATE
DRAWN BY	
DESIGNED BY	
QUANTITIES BY	
CHECKED BY	
ORIGINAL PLAN	
NOTE BOOK	
No.	


STATE OF HAWAII
DEPARTMENT OF TRANSPORTATION
HIGHWAYS DIVISION
DRAINAGE STRUCTURE DETAILS
TRIPLE 168" SECTIONAL PLATE
PIPE CULVERTS @ STA. 350+80
INTERSTATE ROUTE H-1
PROJ. No. I-HI-1(32); UNIT 1
Scale: As Shown Date: Sept. 1966
SHEET No. 22 OF 19 SHEETS

Revised: Jan. 24, 1967


FED. ROAD DIST. NO.	STATE	FED. AID PROJ. NO.	FISCAL YEAR	SHEET NO.	TOTAL SHEETS
HAWAII	HAW.	I-HI-1(32) 5 UNIT 1	1966	25	73

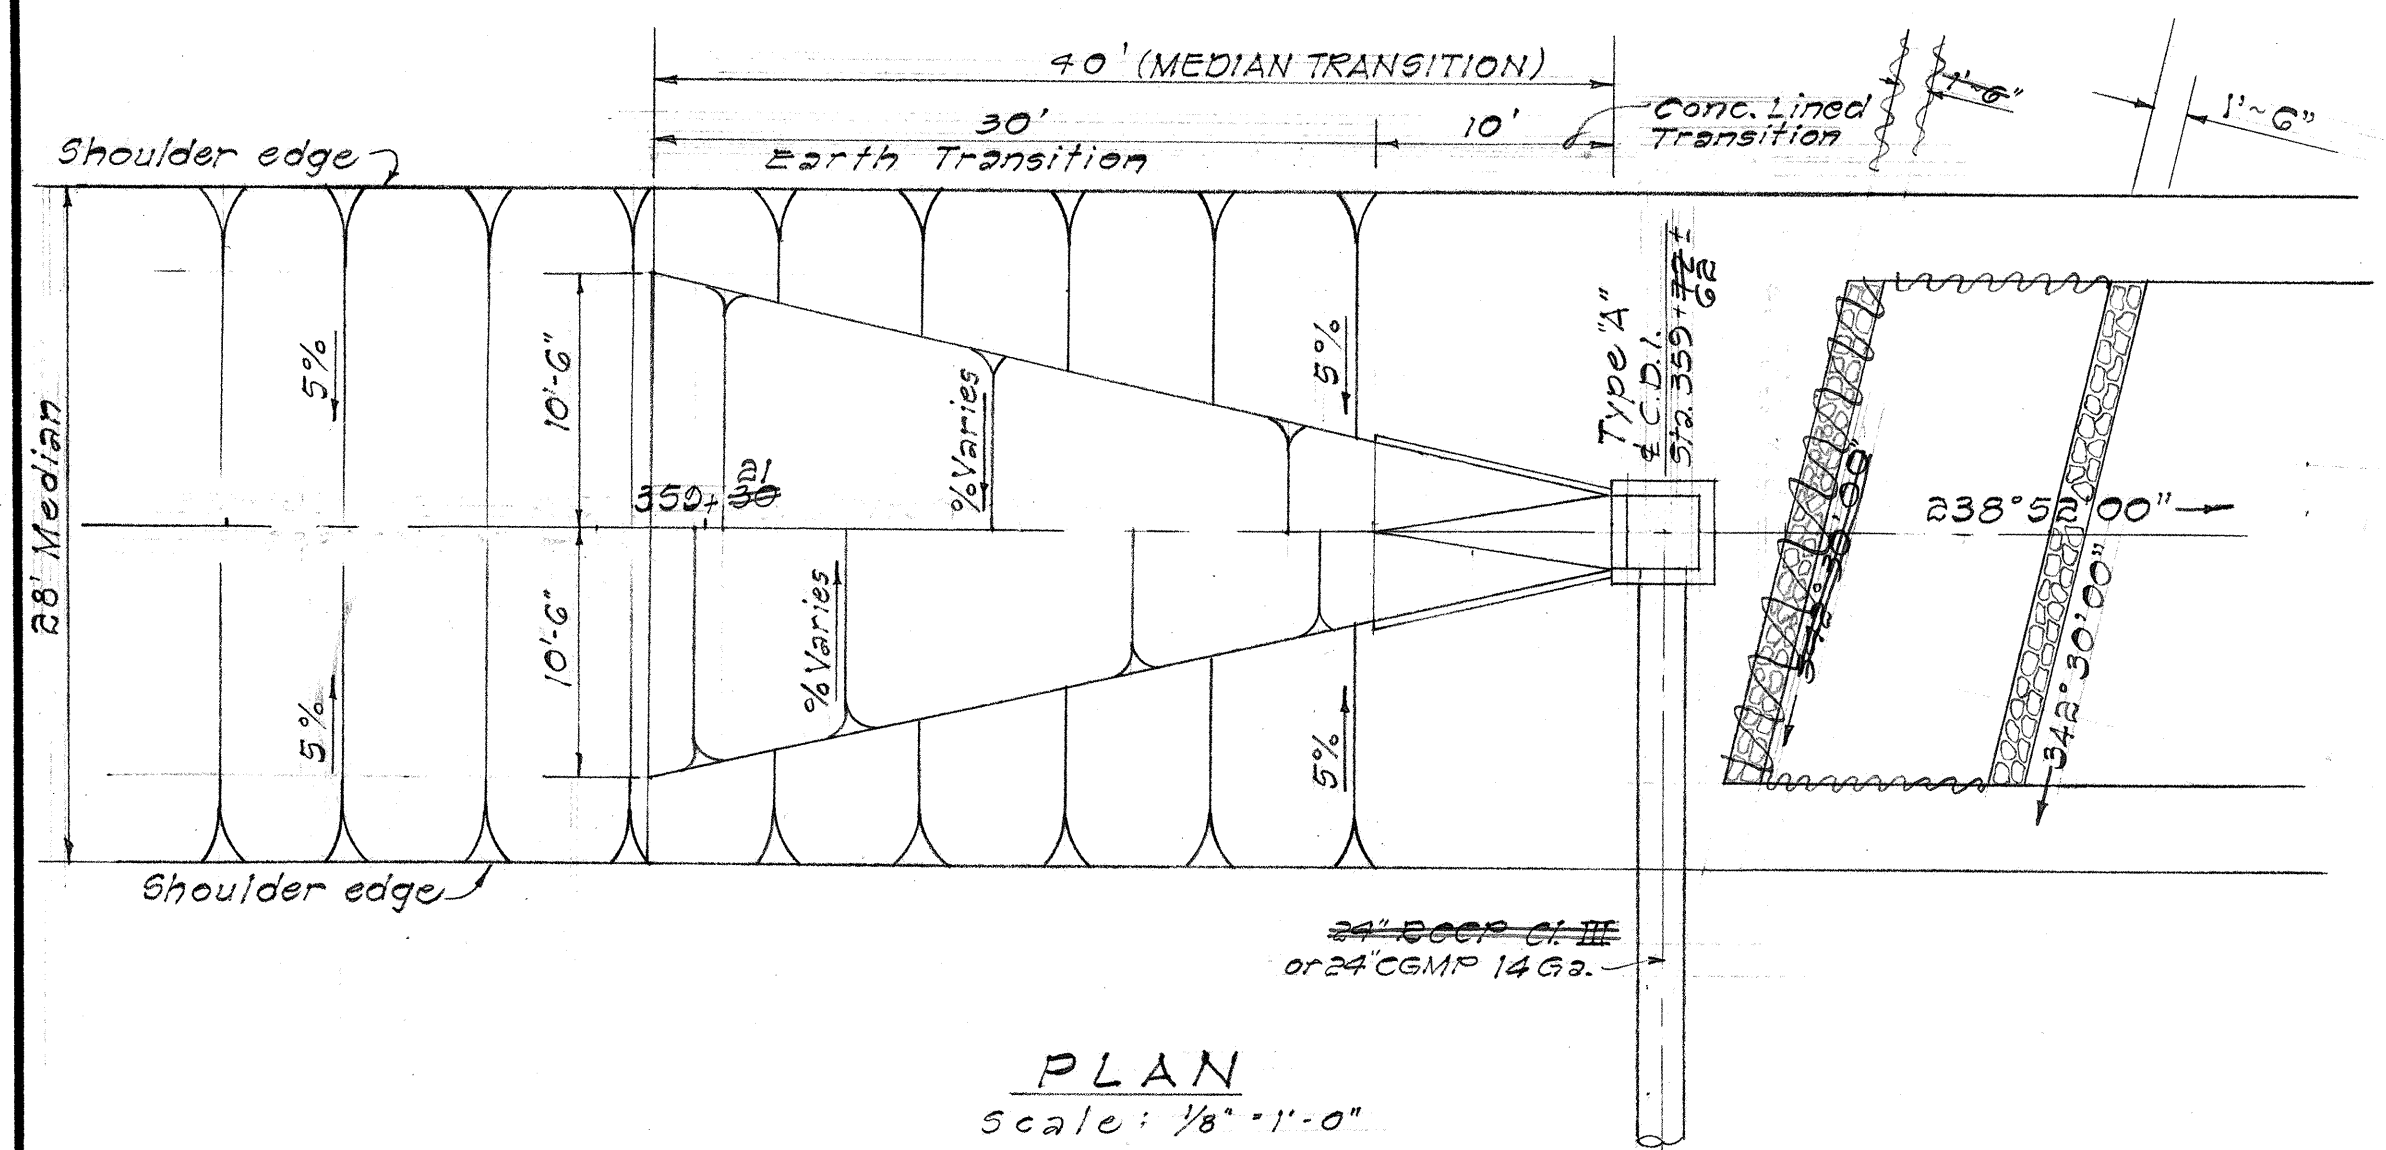


PLAN
Scale: 1/8" = 1'-0"

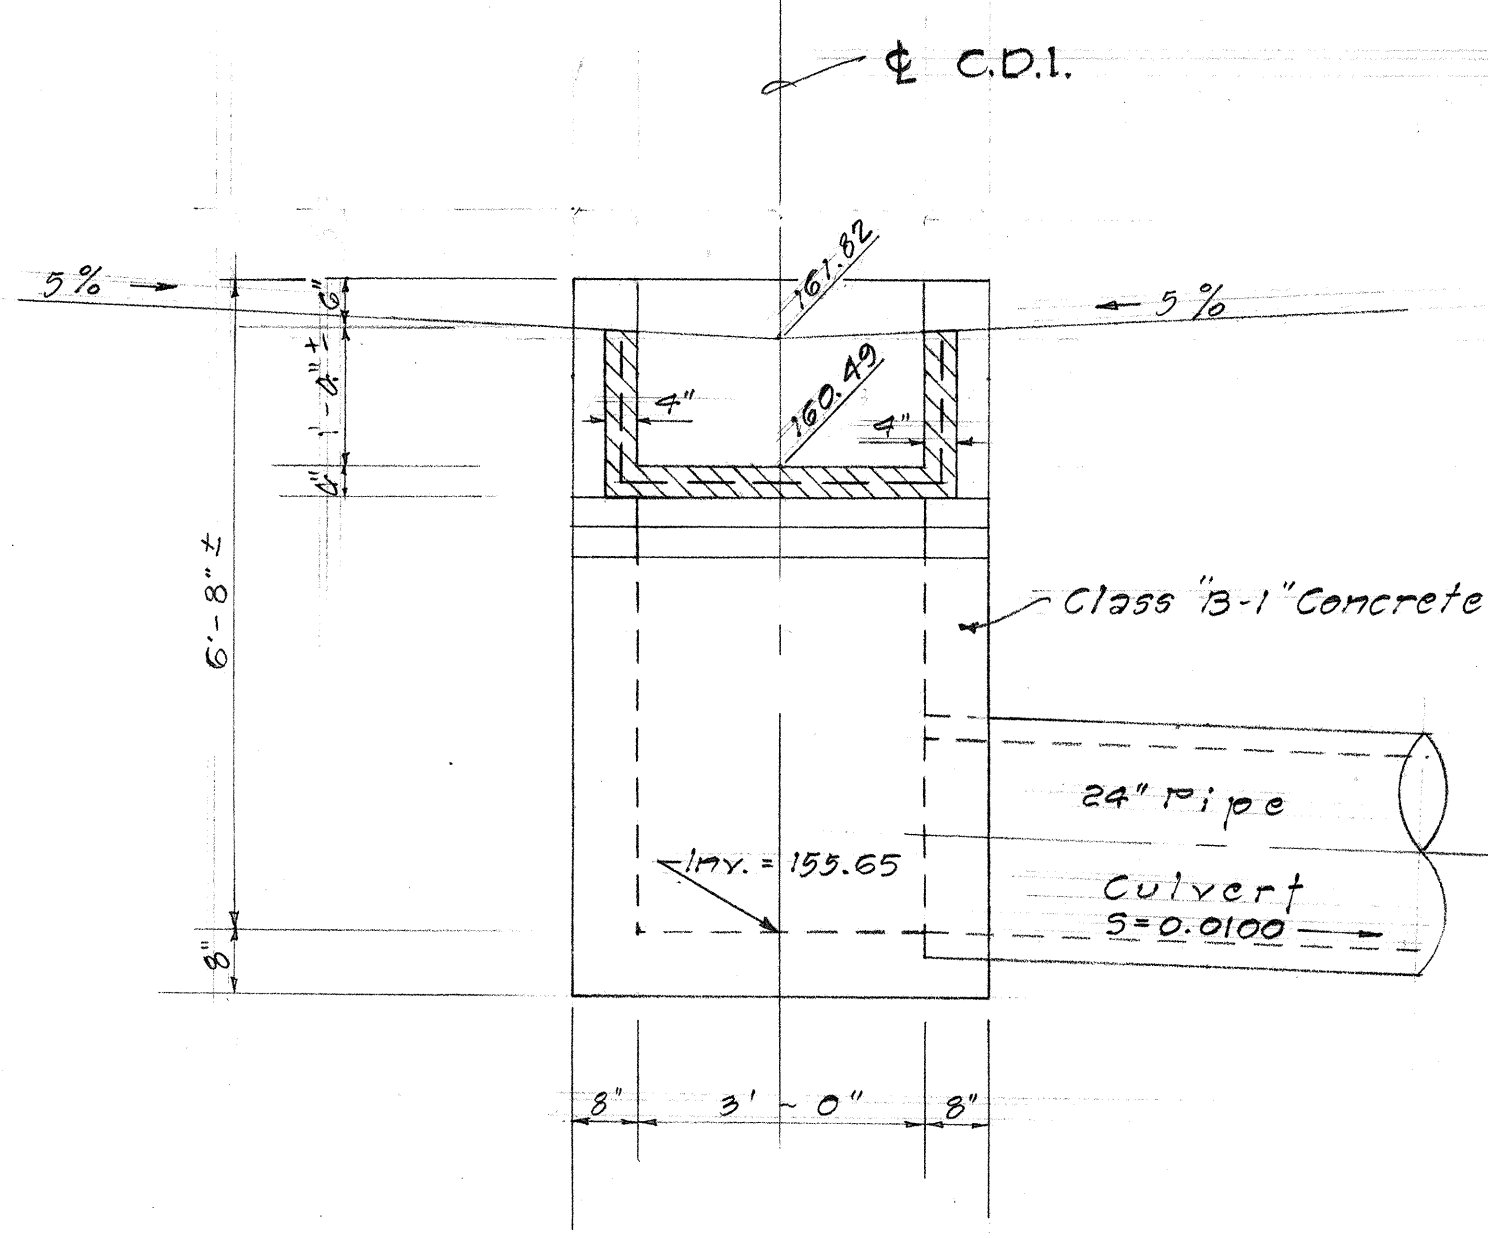


SECTION A-A
Scale: 1/8" = 1'-0"

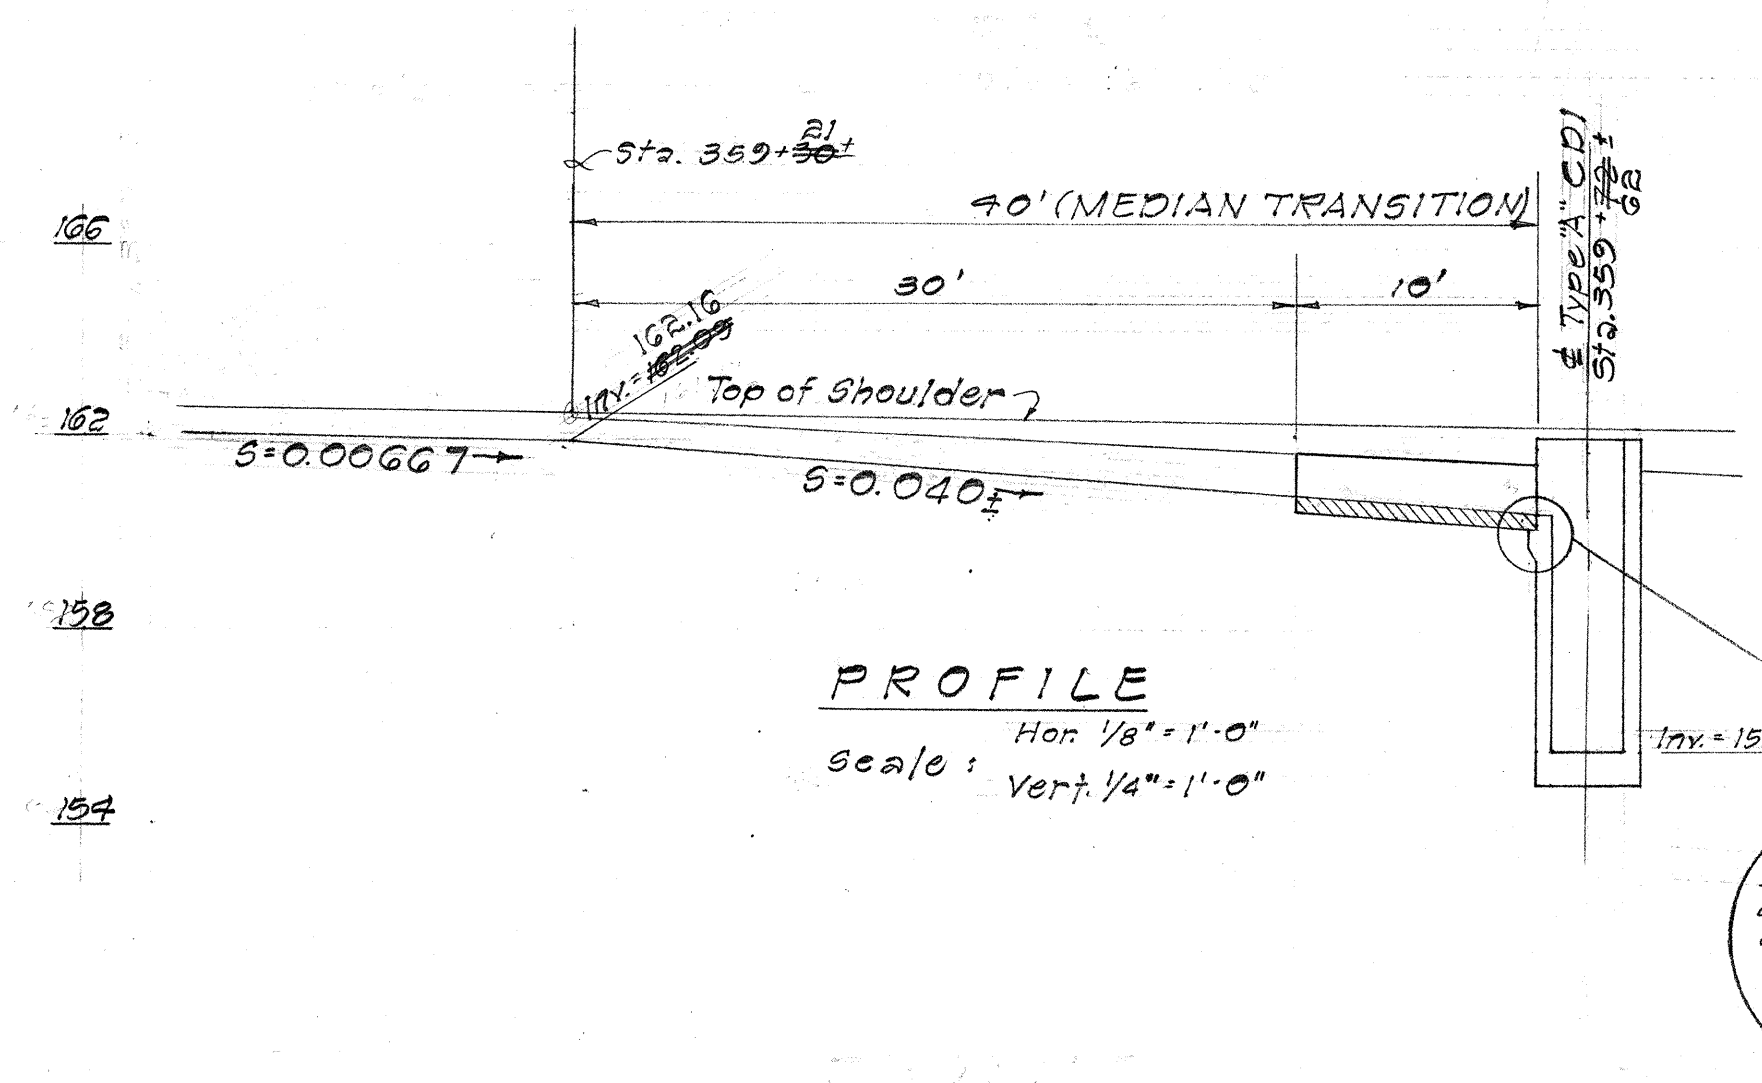


PROFILE
Scale: 1/8" = 1'-0"

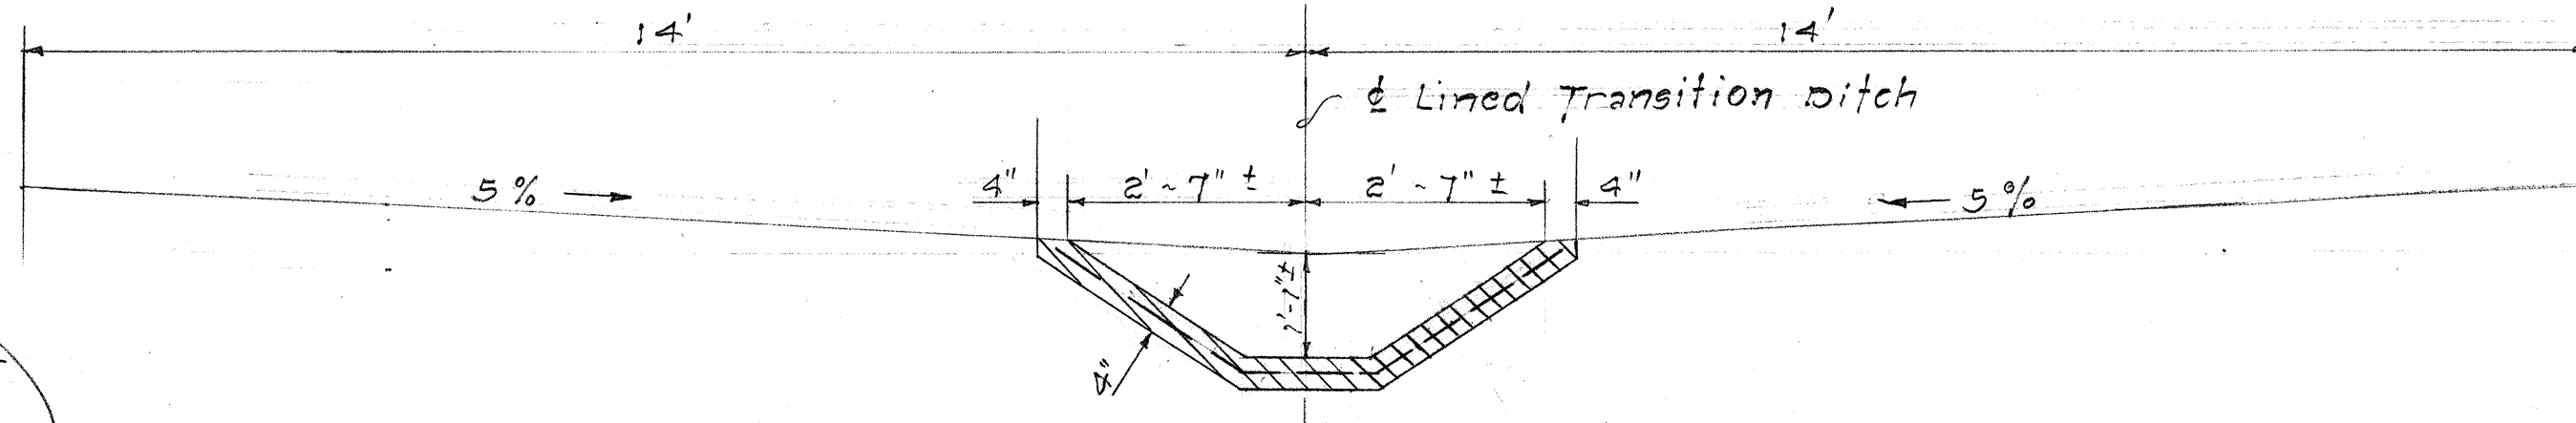


SECTION B-B
Scale: 1/8" = 1'-0"

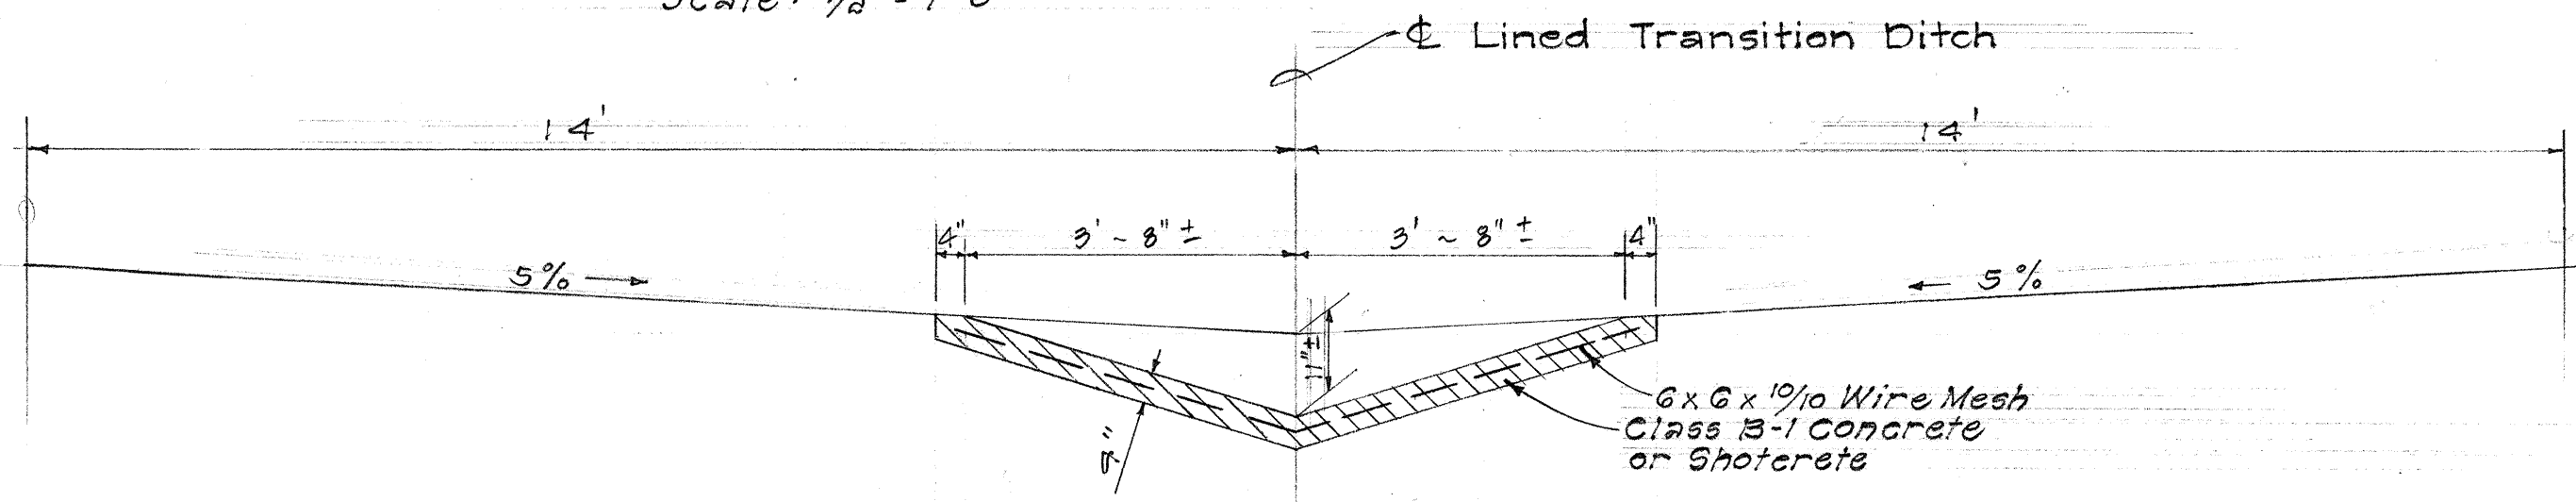

SECTION C-C
Scale: 1/8" = 1'-0"

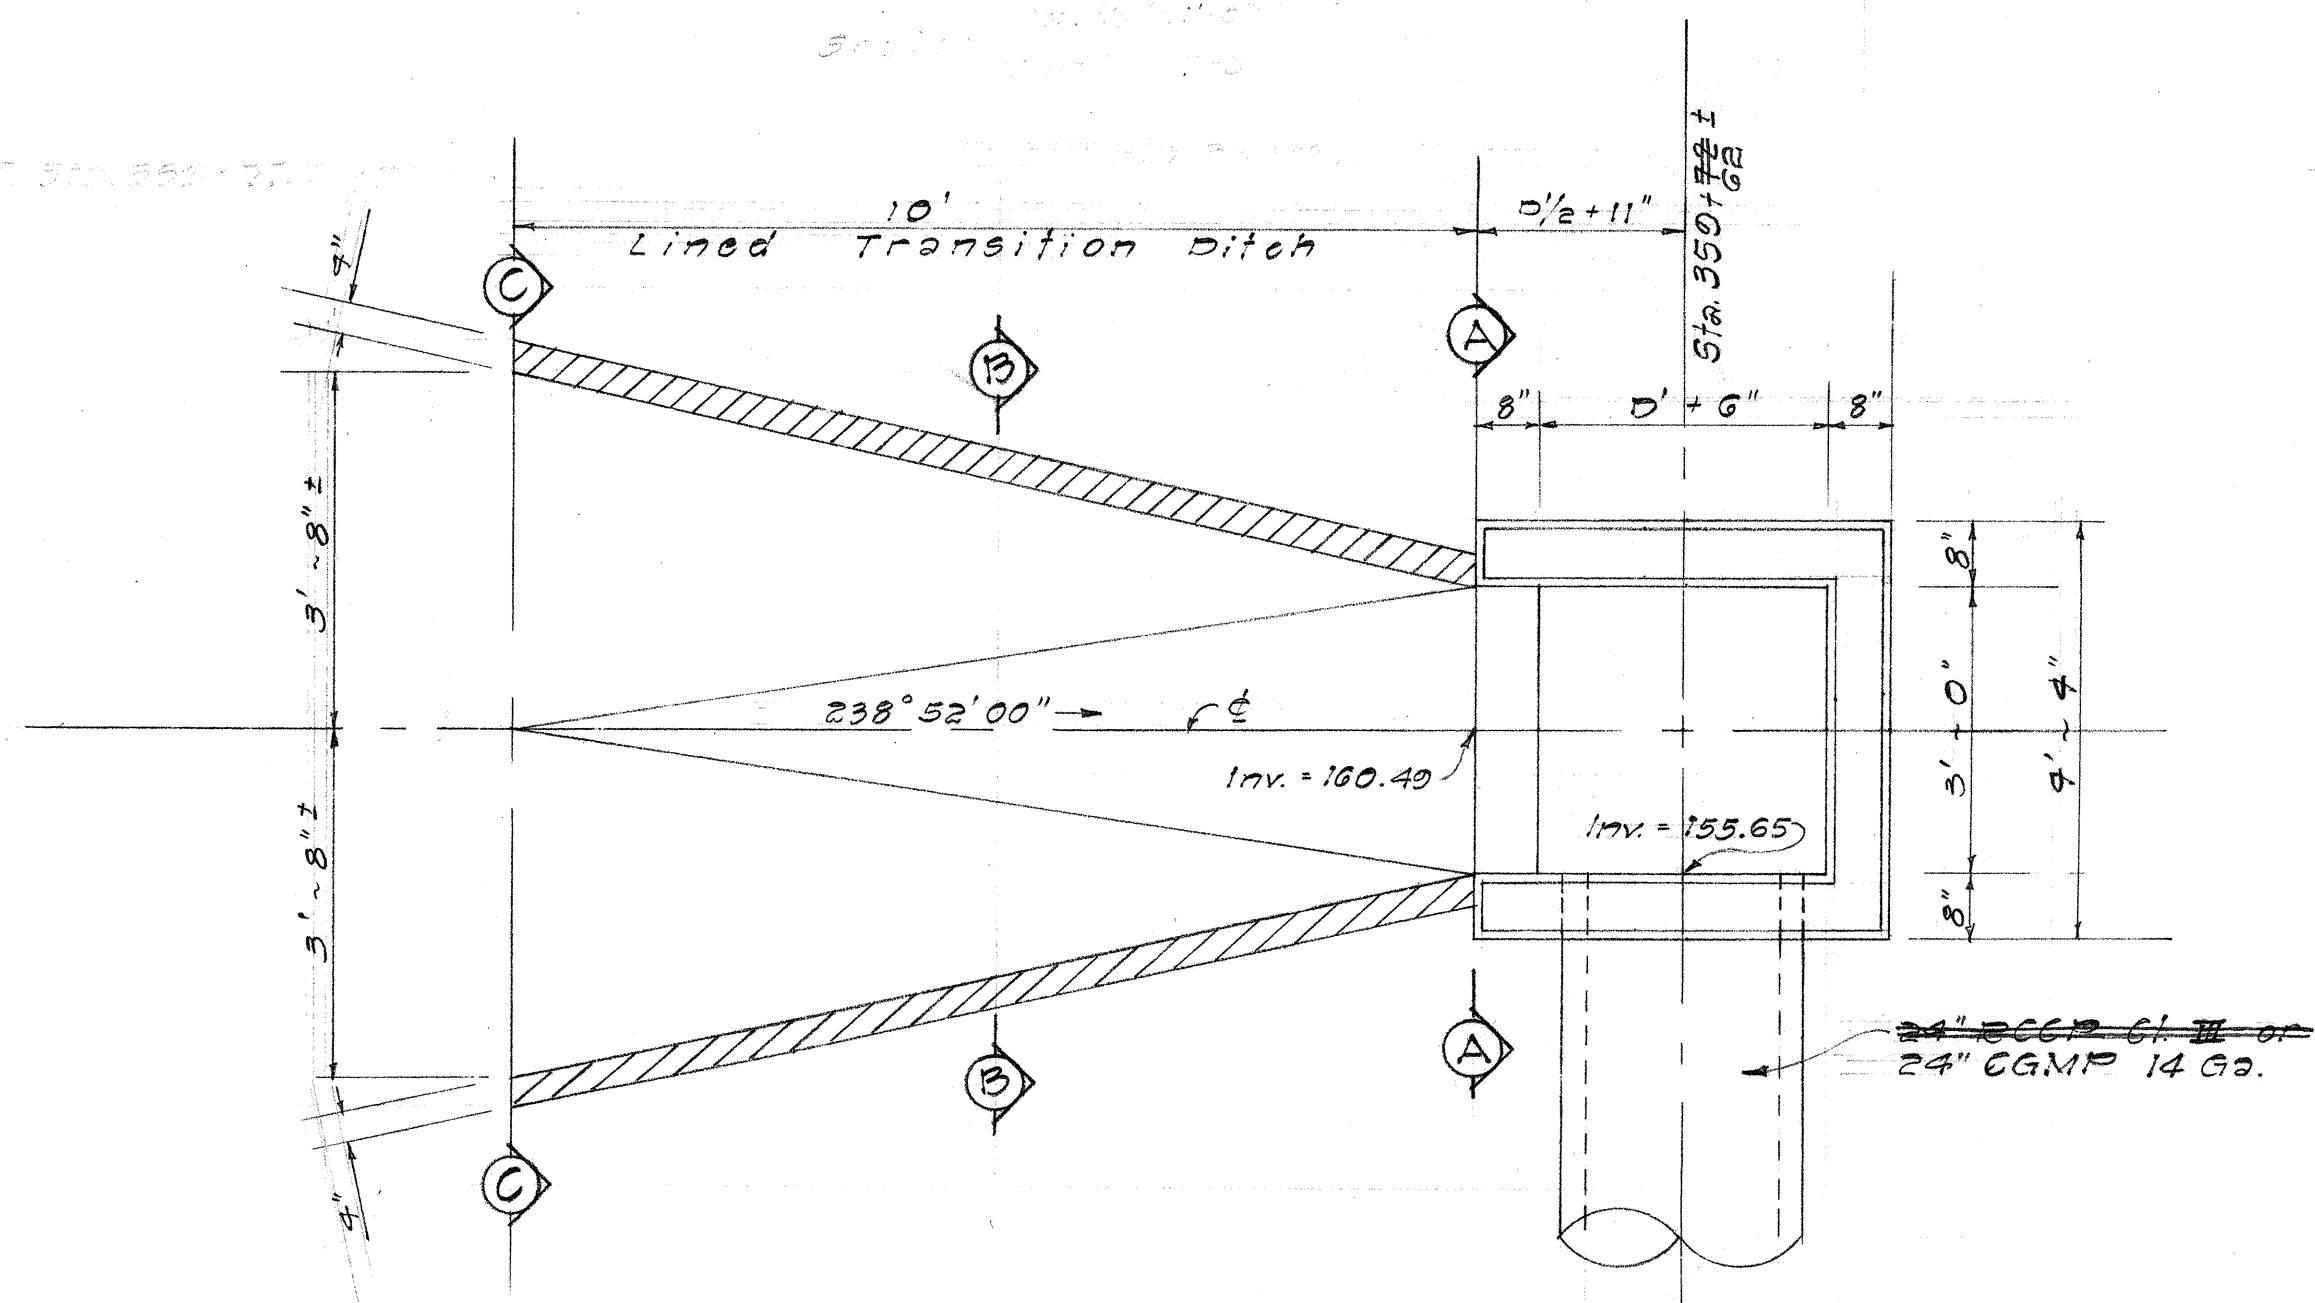

DETAILED PLAN VIEW CONCRETE LINED TRANSITION
Scale: 1/8" = 1'-0"

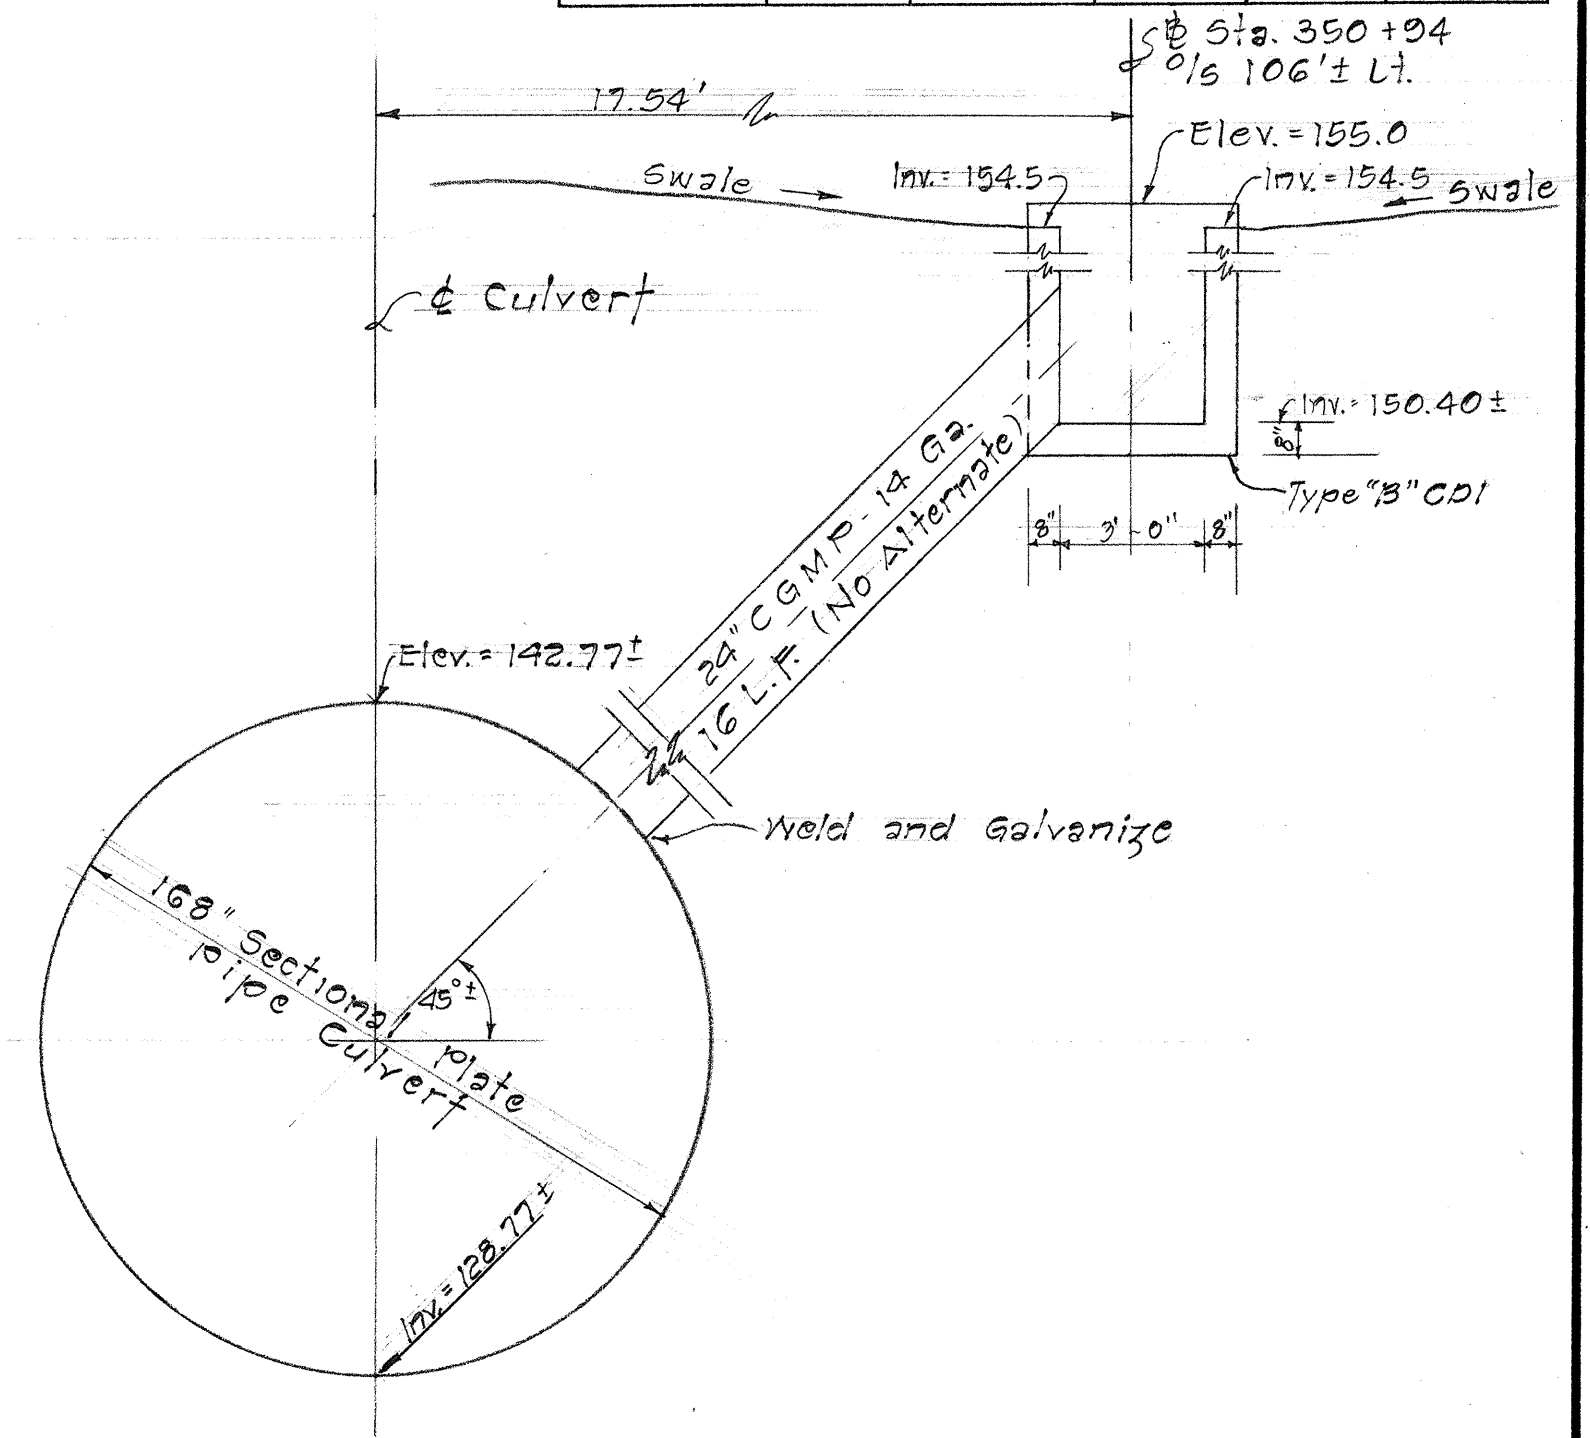

CONNECTION DETAIL OF C.D.I. @ STA. 350+94 TO 168" SECTIONAL PLATE PIPE CULVERT
Not to Scale

MEDIAN DRAIN AT STA 350+72.2

THIS SHEET SUPERSEDES SHEET NO. 60

STATE OF HAWAII
DEPARTMENT OF TRANSPORTATION
HIGHWAYS DIVISION




DRAINAGE DETAILS
CDI @ STA. 350+94 ± & STA. 350+72 ±

INTERSTATE ROUTE H-1
PROJ. No. I-HI-1(32) 5, UNIT 1



Scale: As Shown Date: Sept., 1966
SHEET No. 25 OF 73 SHEETS

DATE	
DESIGNED BY	
DRAWN BY	
CHECKED BY	
NOTED BY	
ORIGINAL PLAN	
NOTE BOOK	
No.	


FED. ROAD DIST. NO.	STATE	FED. AID PROJ. NO.	FISCAL YEAR	SHEET NO.	TOTAL SHEETS
HAWAII	HAW.	I-HI-1(32)-5 UNIT 1	1966	26	73

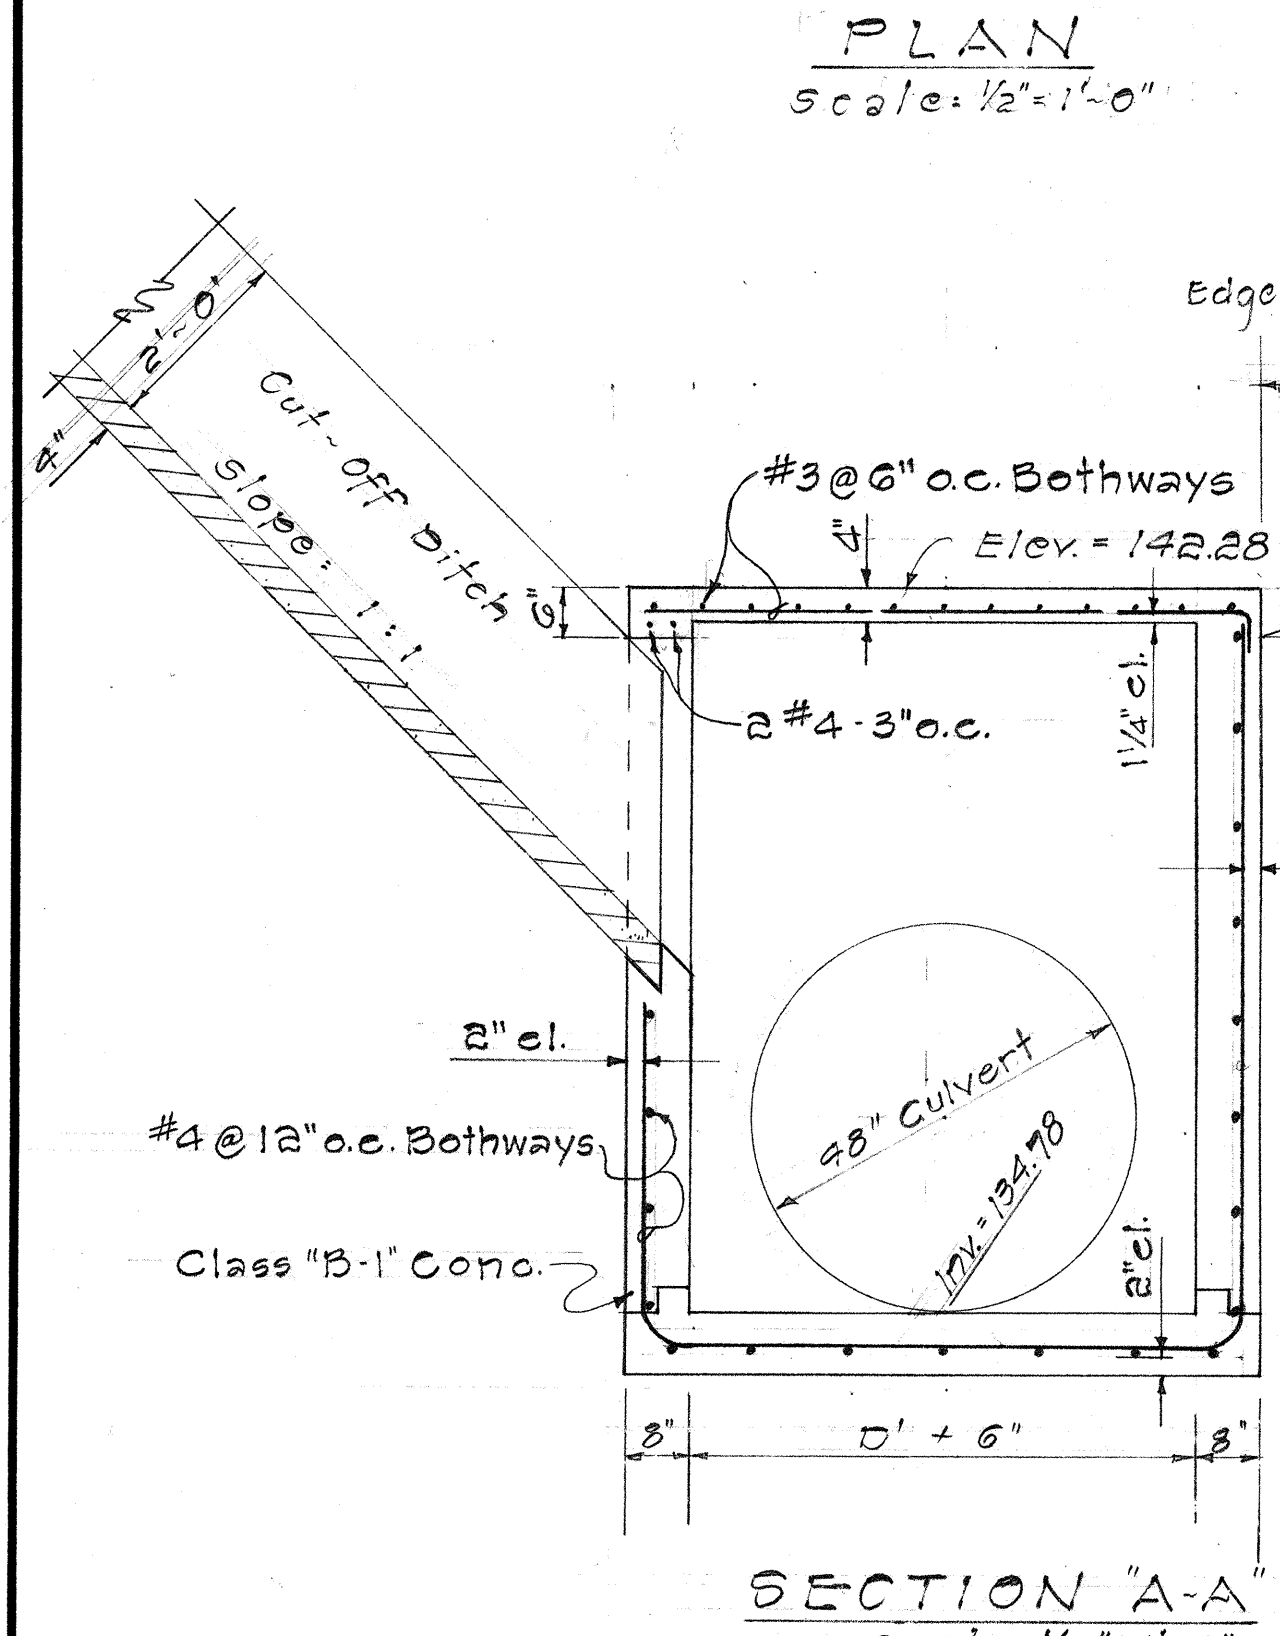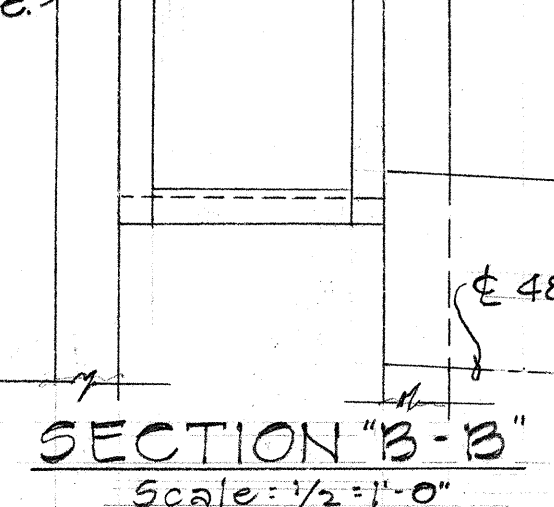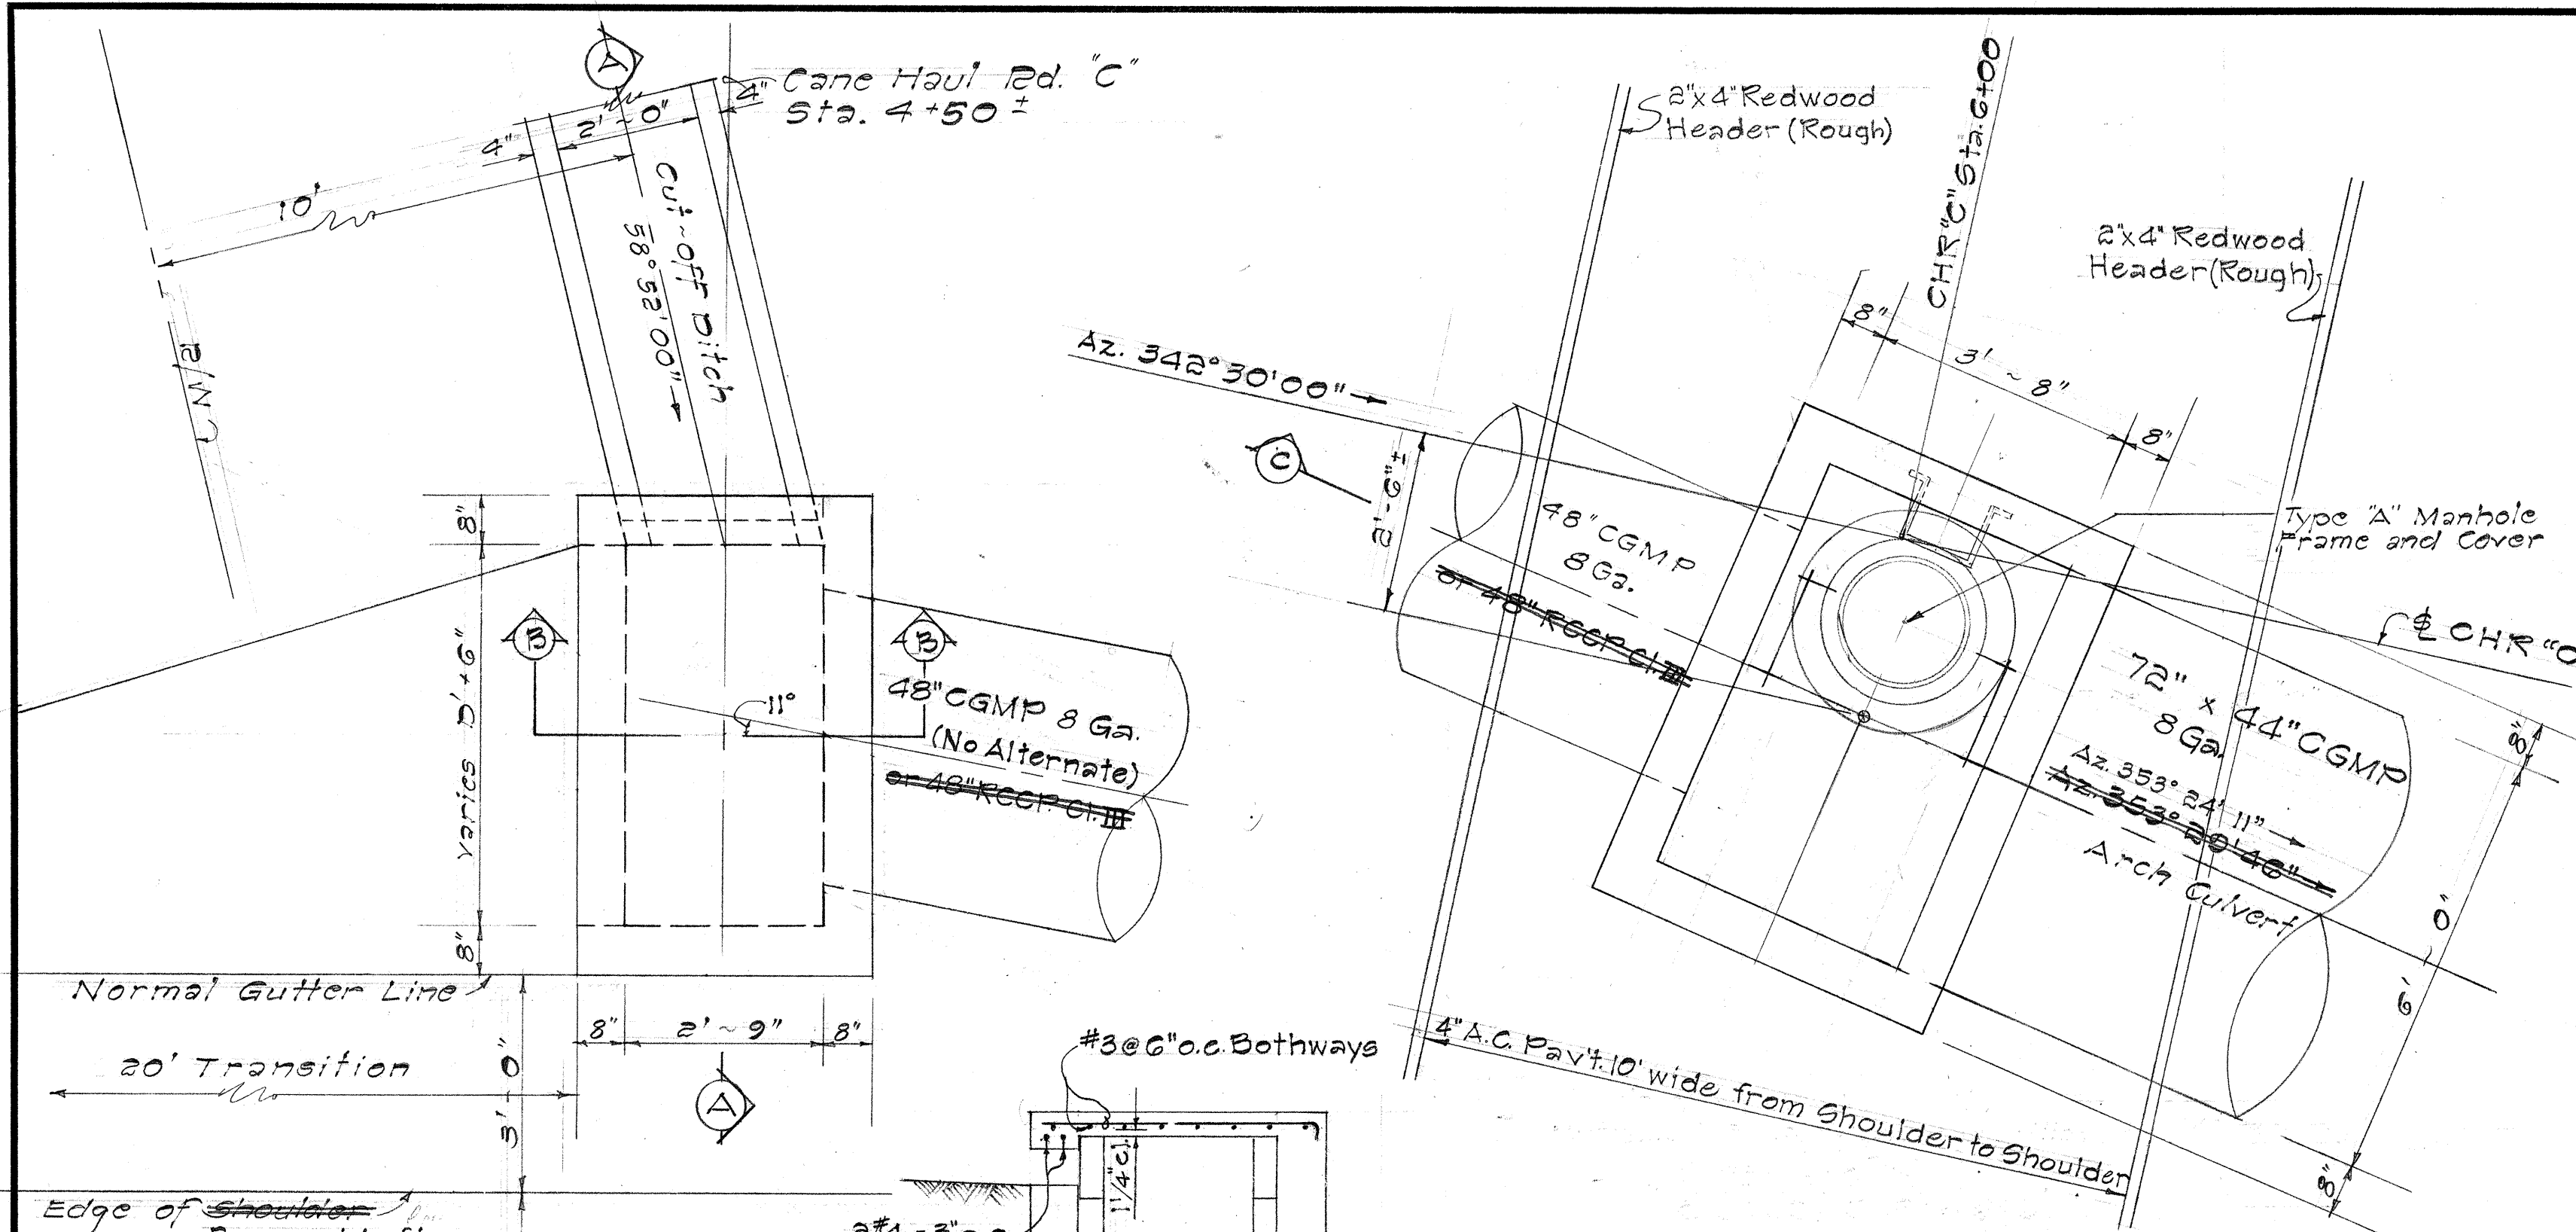


DETAIL of CDI
@ CHR "C" Sta. 4+50± Lt.

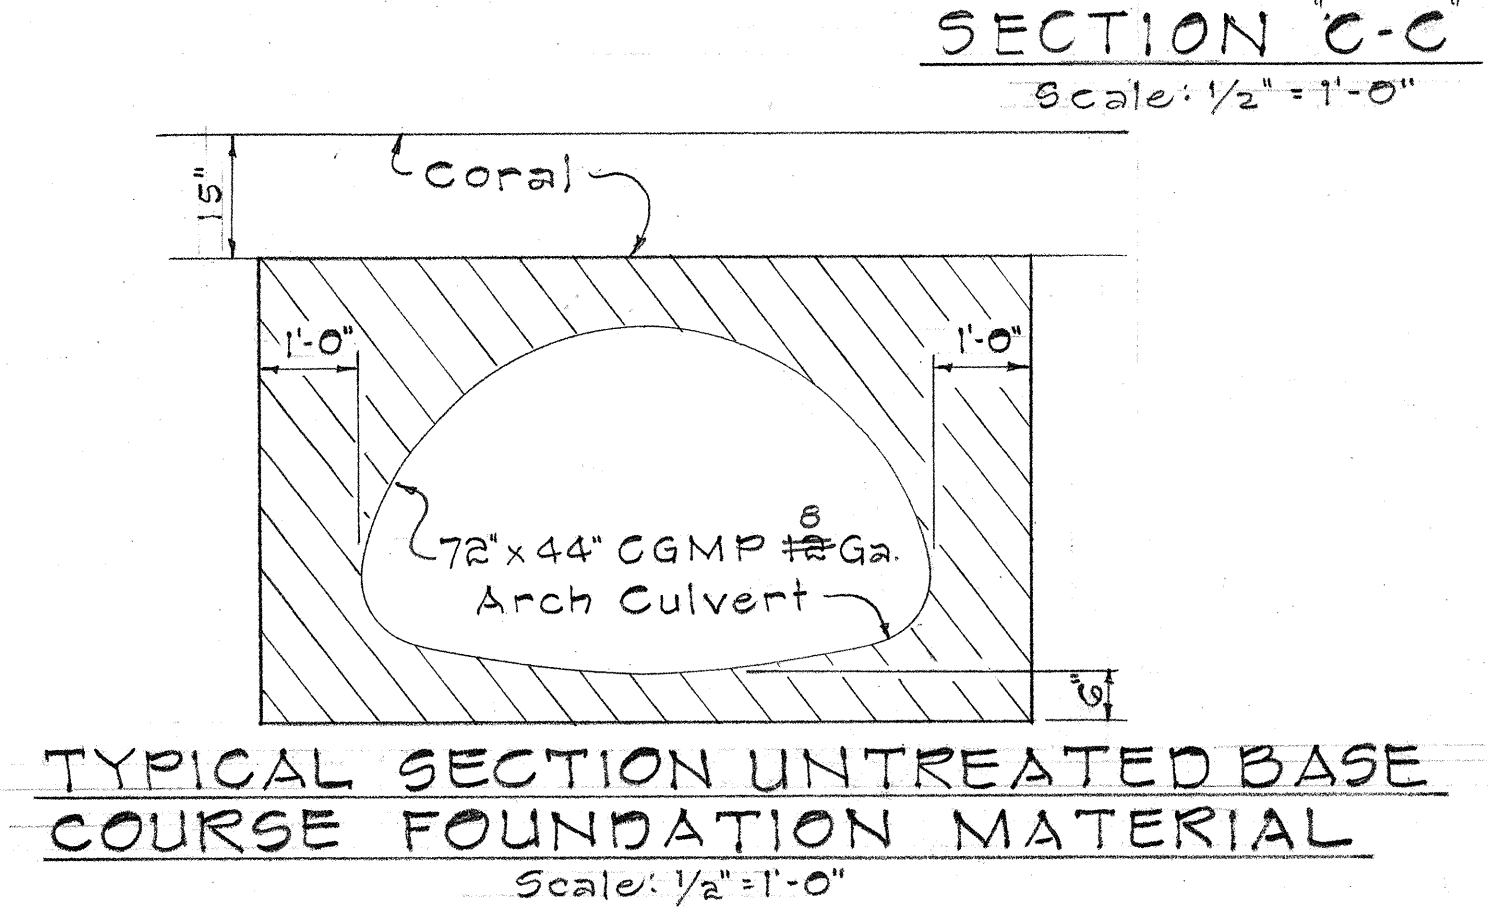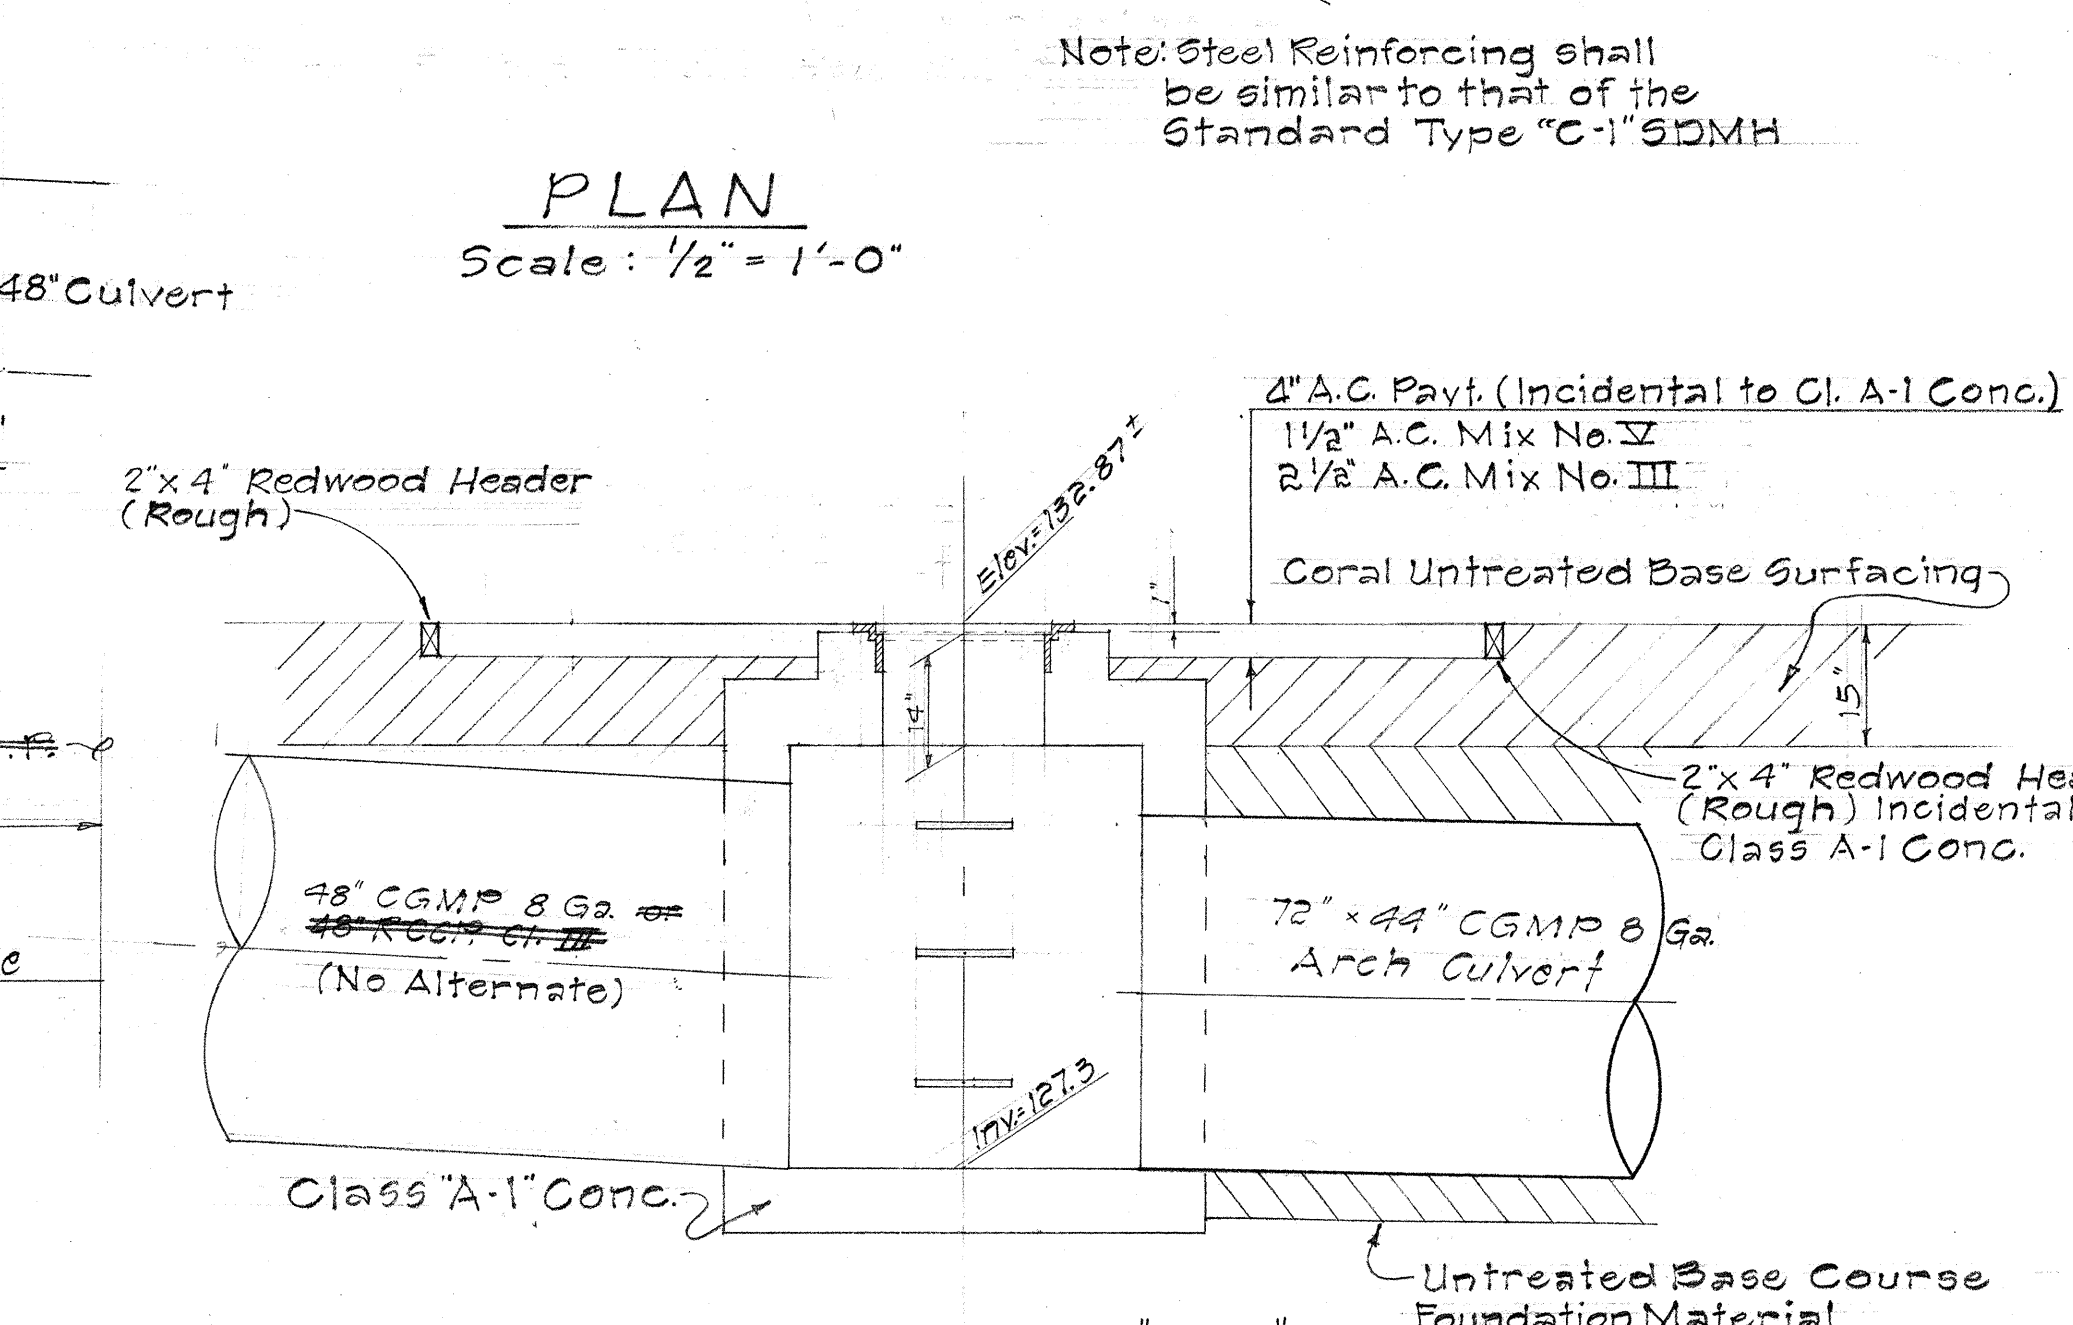


DETAIL OF SDMH @ CHR "C" STA. 6+00±

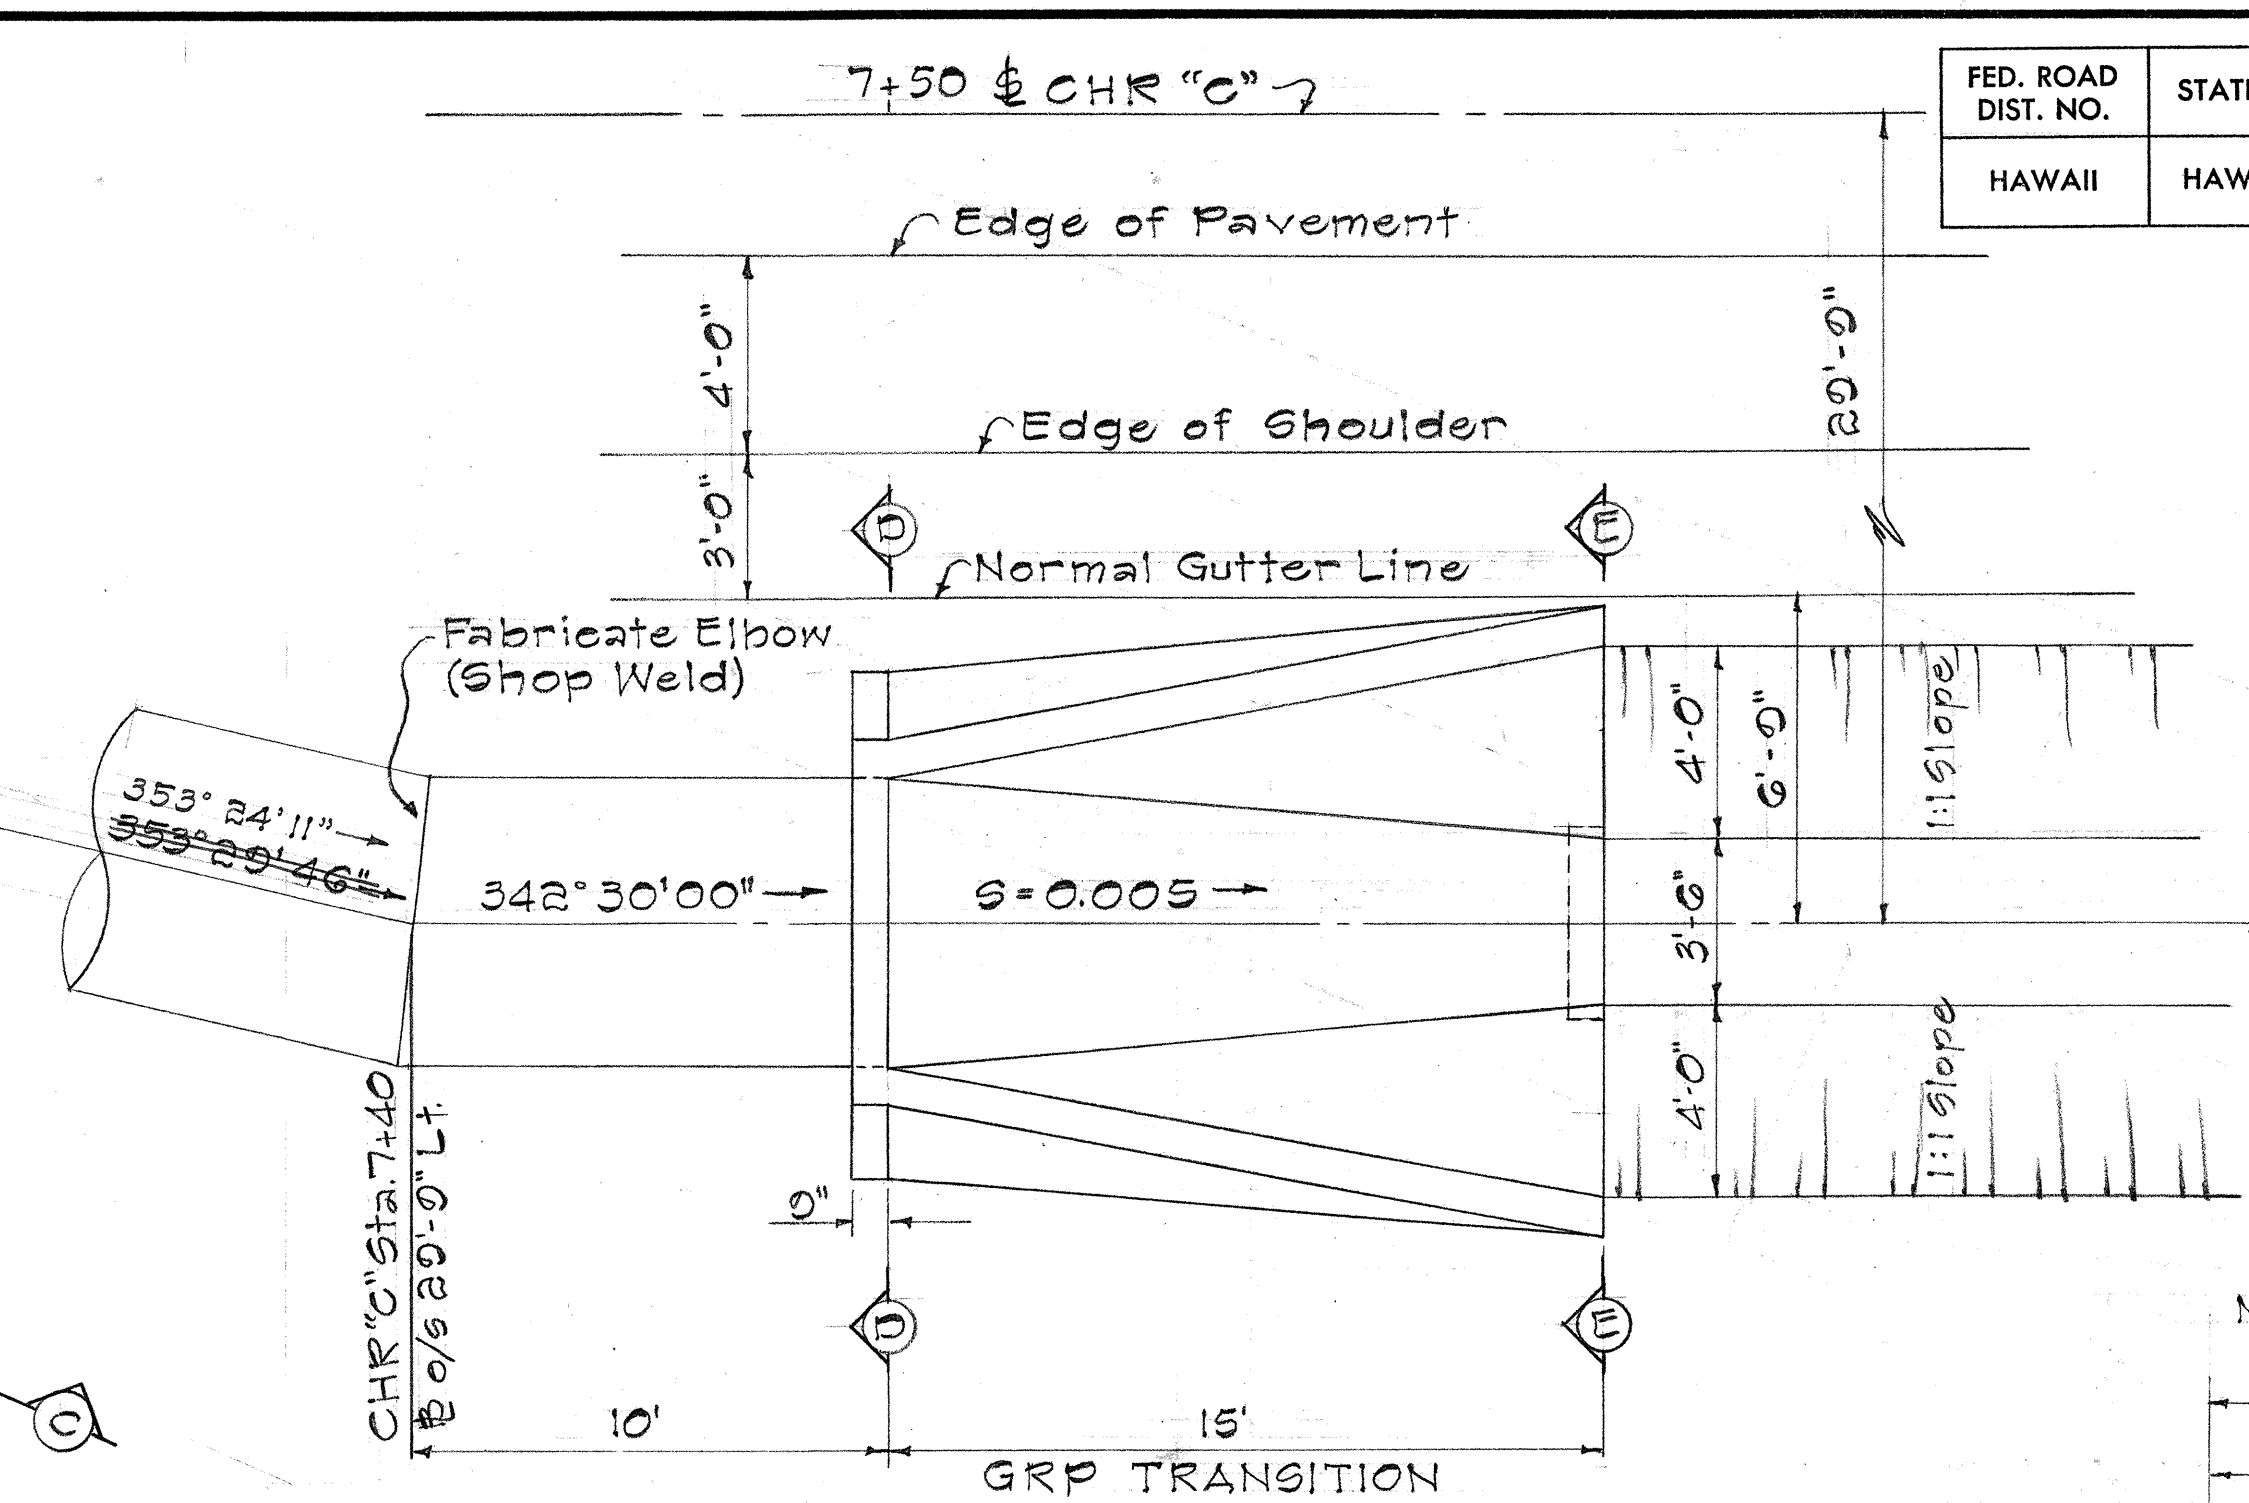


PLAN
Scale: 1/4" = 1'-0"

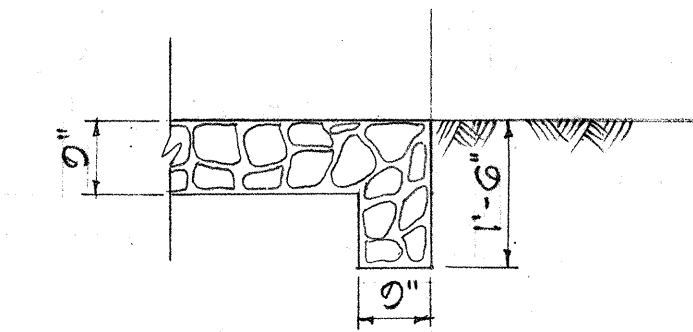

SECTION "F-F"
Scale: 1/2" = 1'-0"

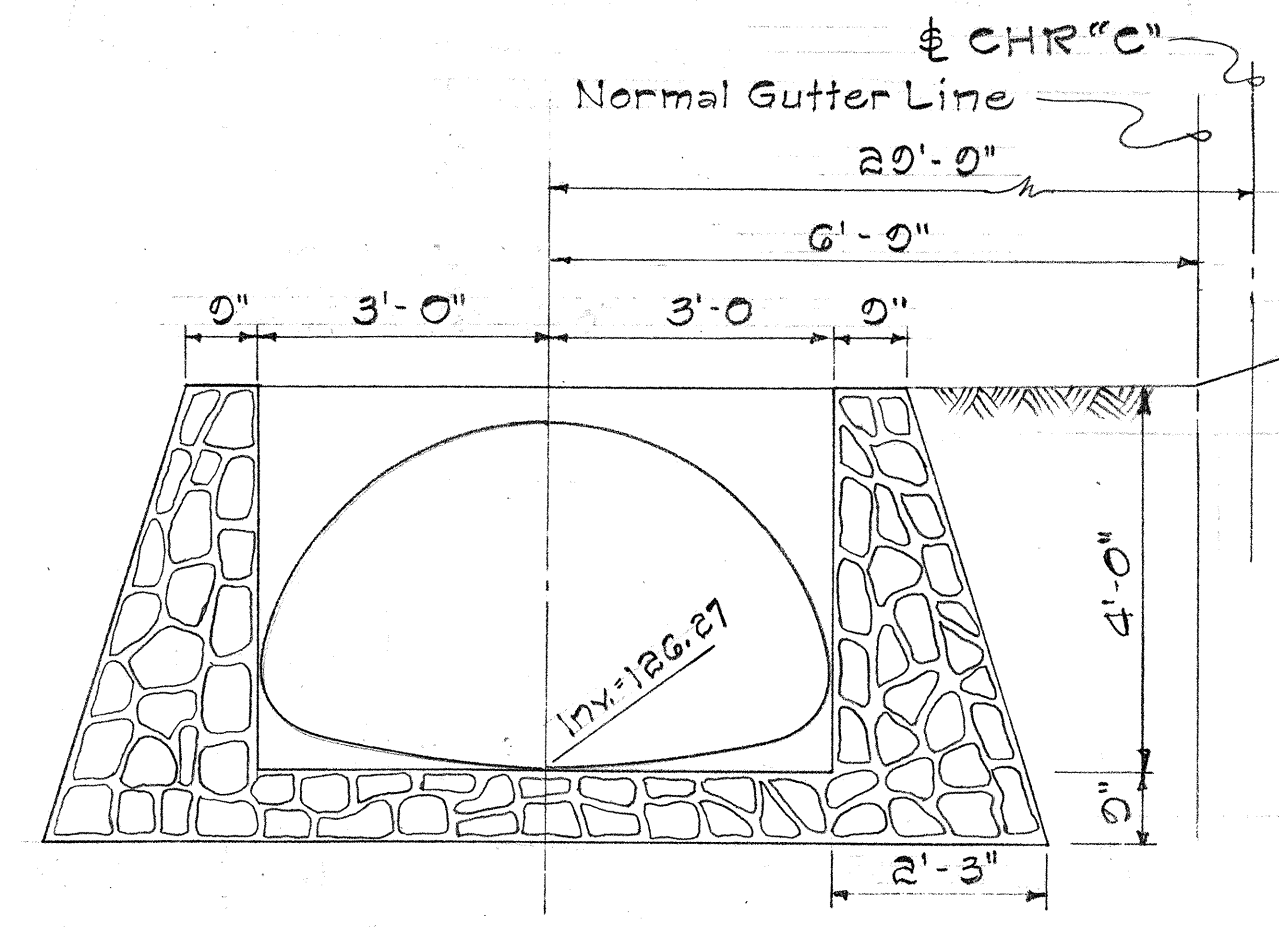

SECTION "D-D"
Scale: 1/2" = 1'-0"

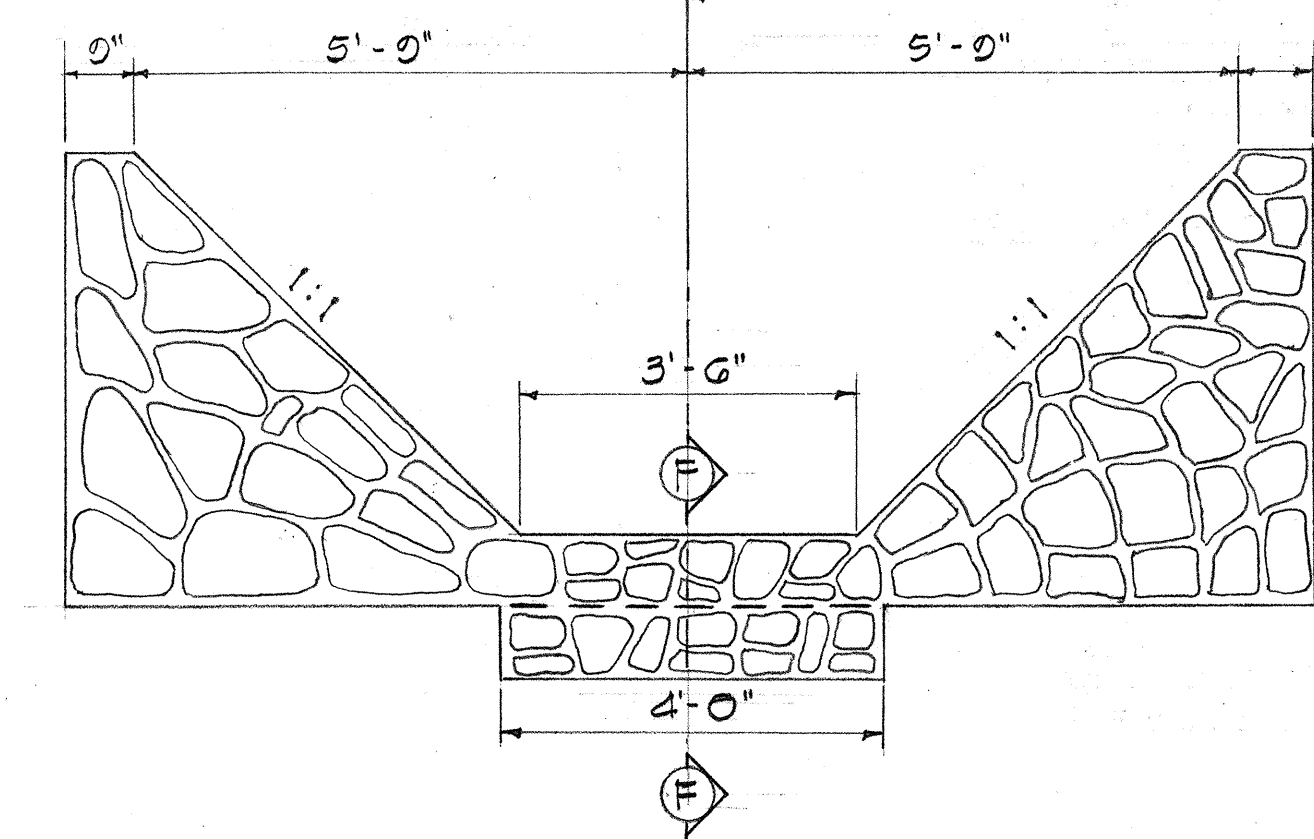

SECTION "E-E"
Scale: 1/2" = 1'-0"

DETAIL OF GRP TRANSITION
DITCH @ CHR "C" STA. 7+50±

STATE OF HAWAII
DEPARTMENT OF TRANSPORTATION
HIGHWAYS DIVISION



**DRAINAGE STRUCTURES
DETAILS CANE HAUL RD. "C"**

INTERSTATE ROUTE H-1
PROJ. No. I-HI-1(32)-5, UNIT 1


Scale: As Shown Sept. 1966
SHEET No. 26 OF 73 SHEETS

DATE	_____
DESIGNED BY	_____
DRAWN BY	_____
CHECKED BY	_____
NOTED BY	_____
ORIGINAL PLAN	_____
NOTE BOOK	_____


FED. ROAD DIST. NO.	STATE	FED. AID PROJ. NO.	FISCAL YEAR	SHEET NO.	TOTAL SHEETS
HAWAII	HAW.	I-HI-1(32):5 UNIT 1	1966	27	73

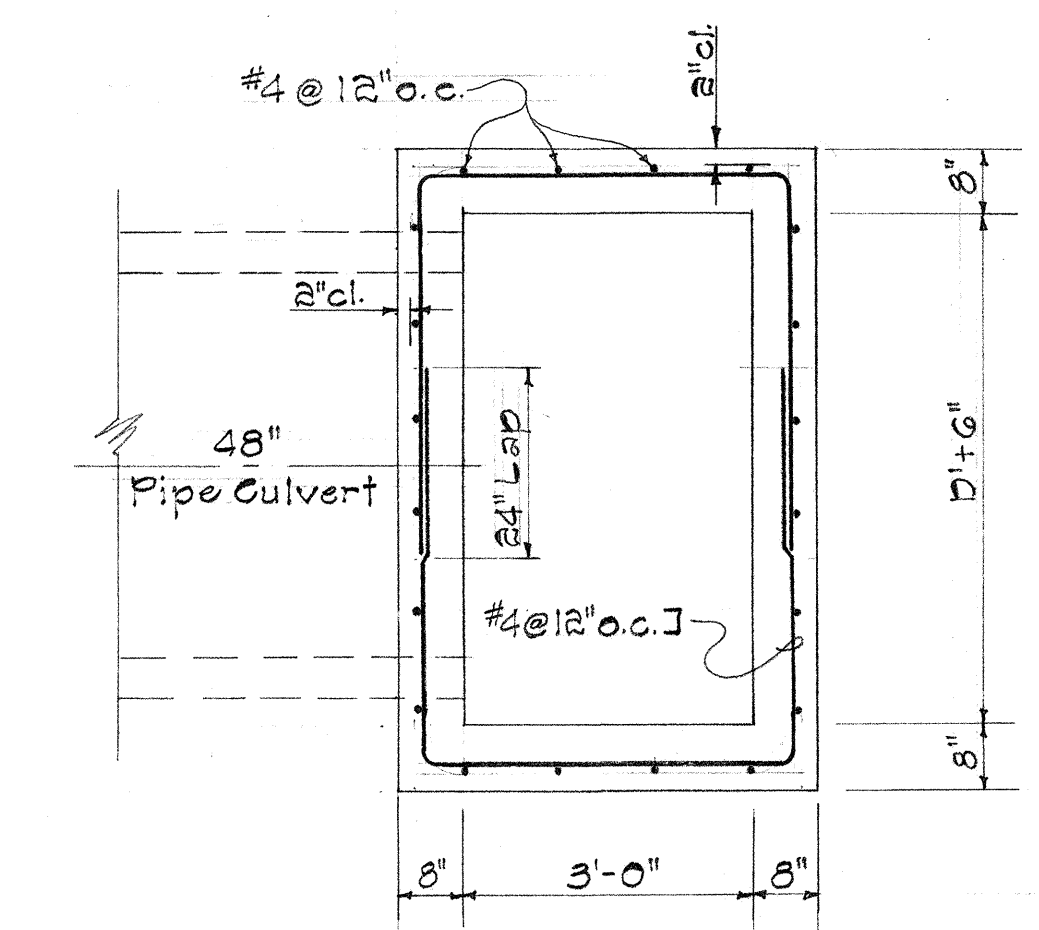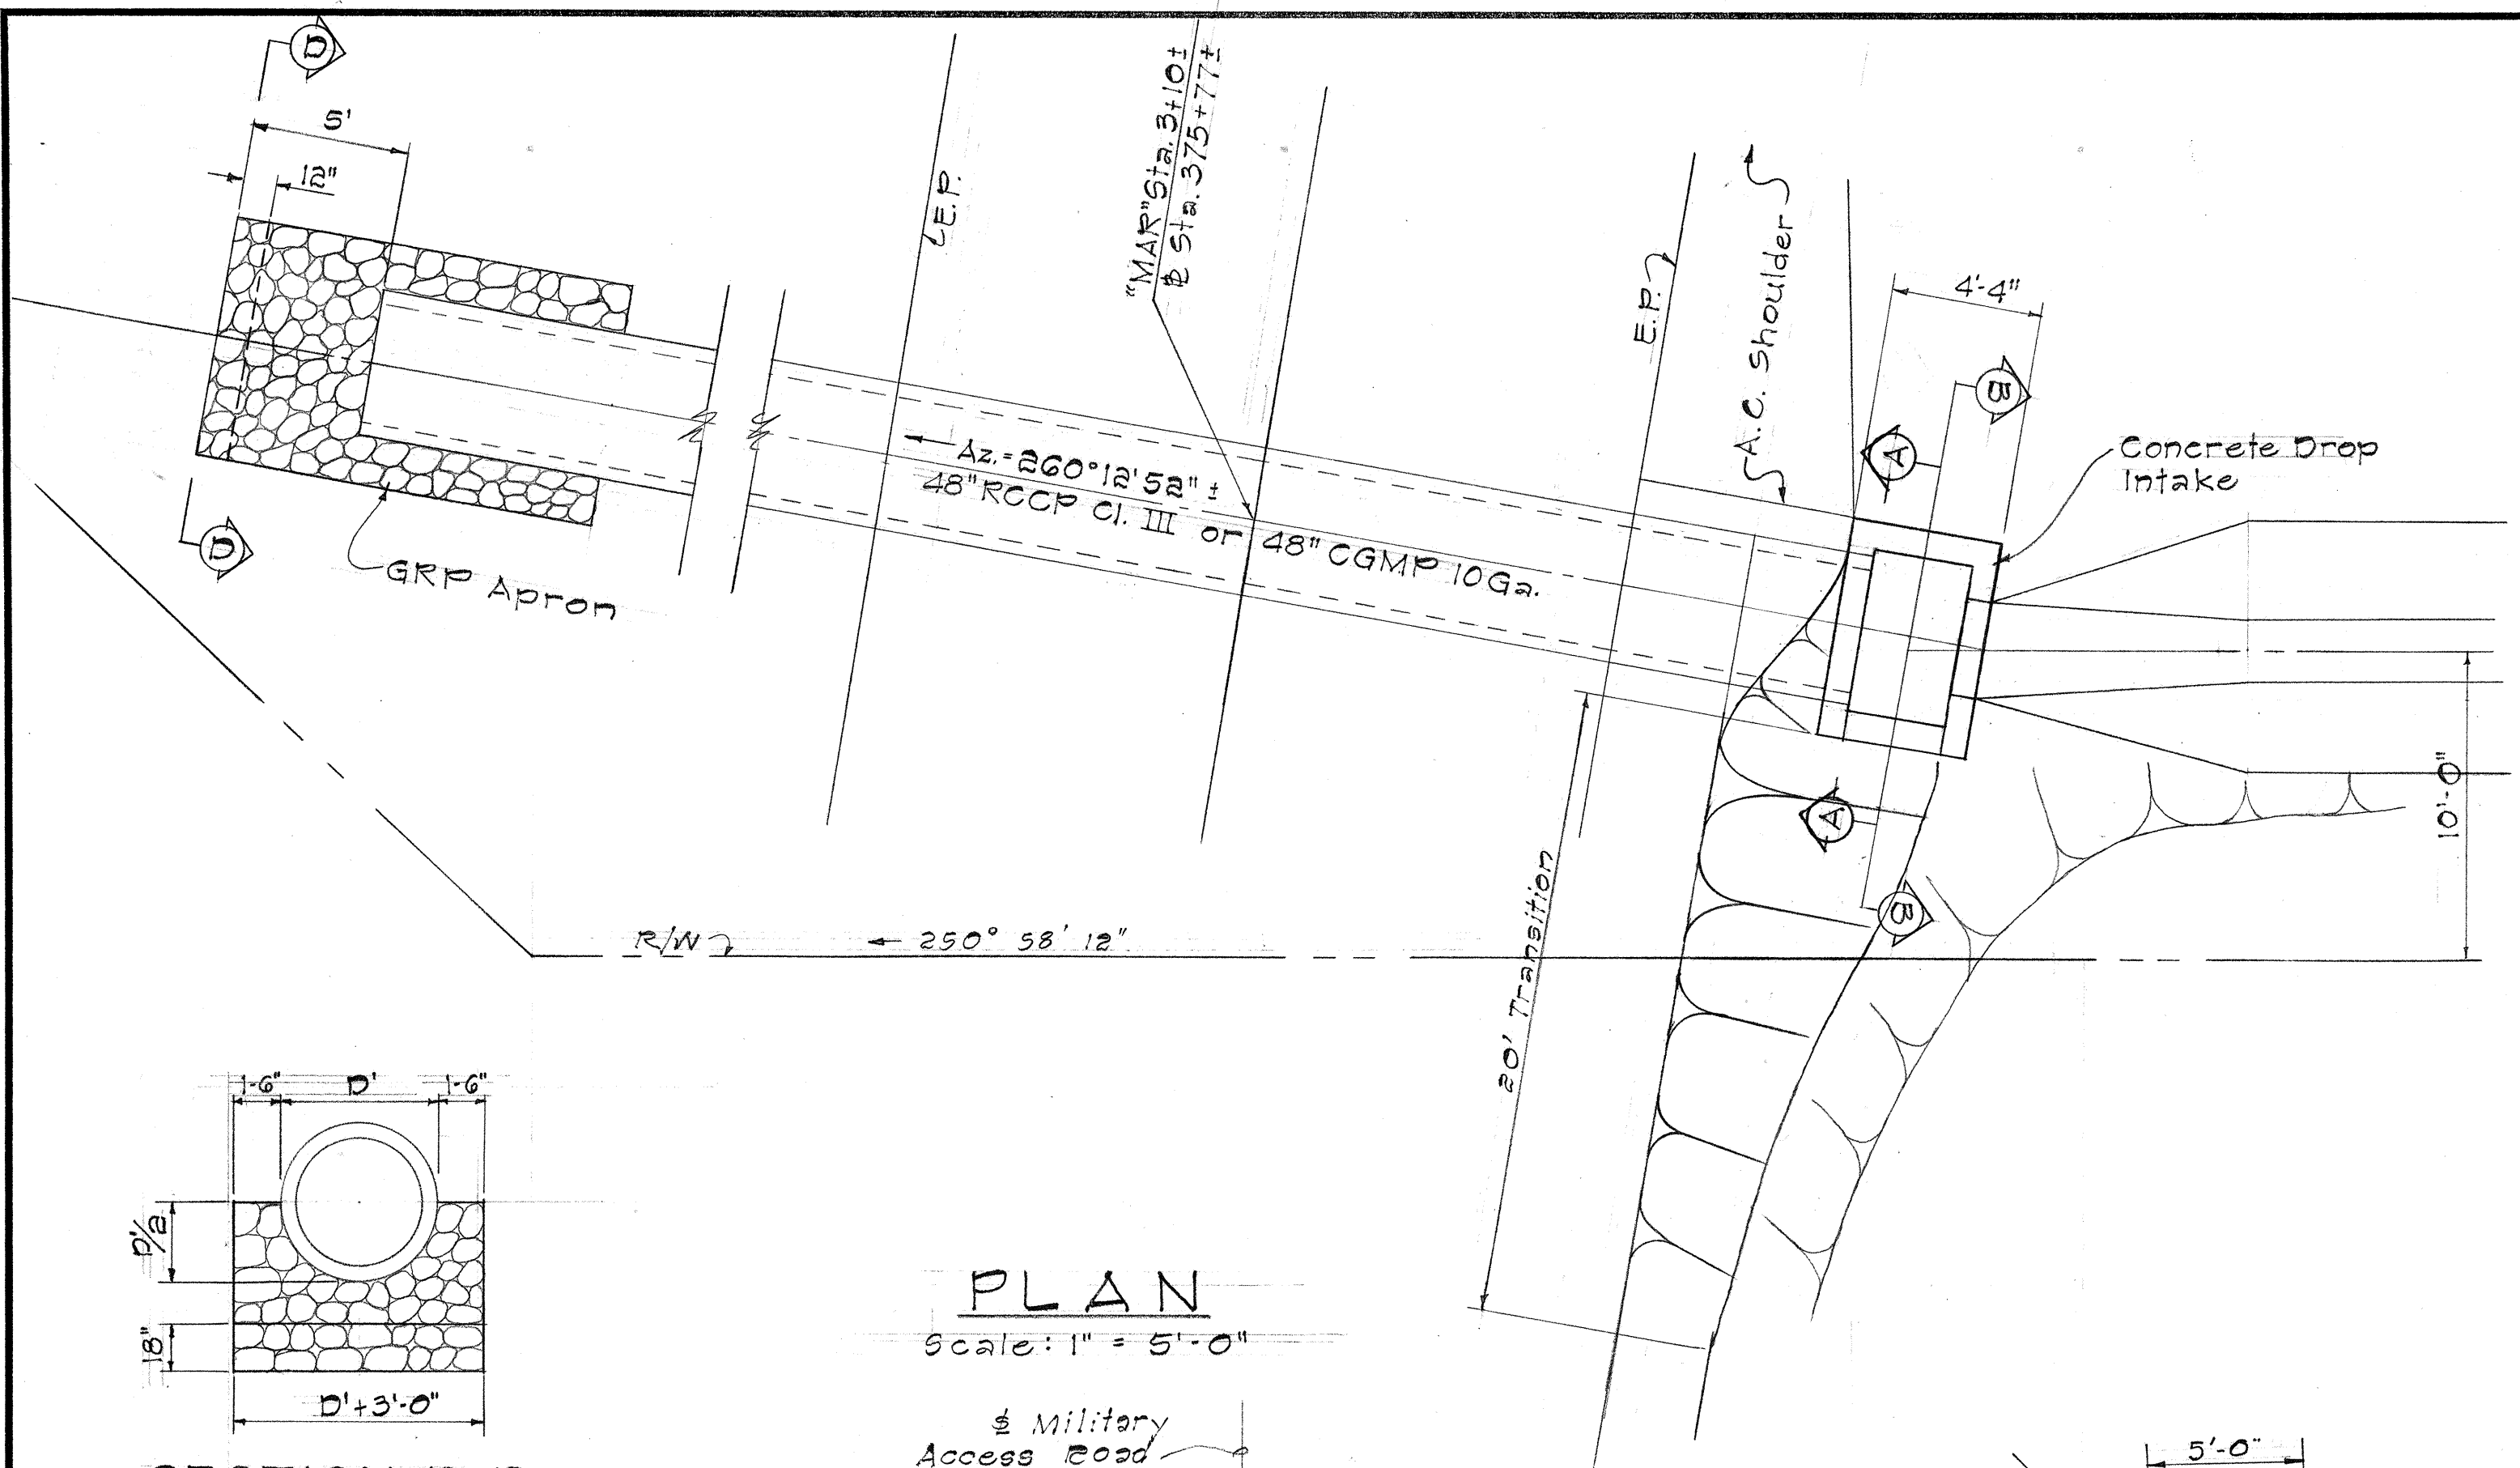


SECTION C-C
Scale: 1/8" = 1'-0"

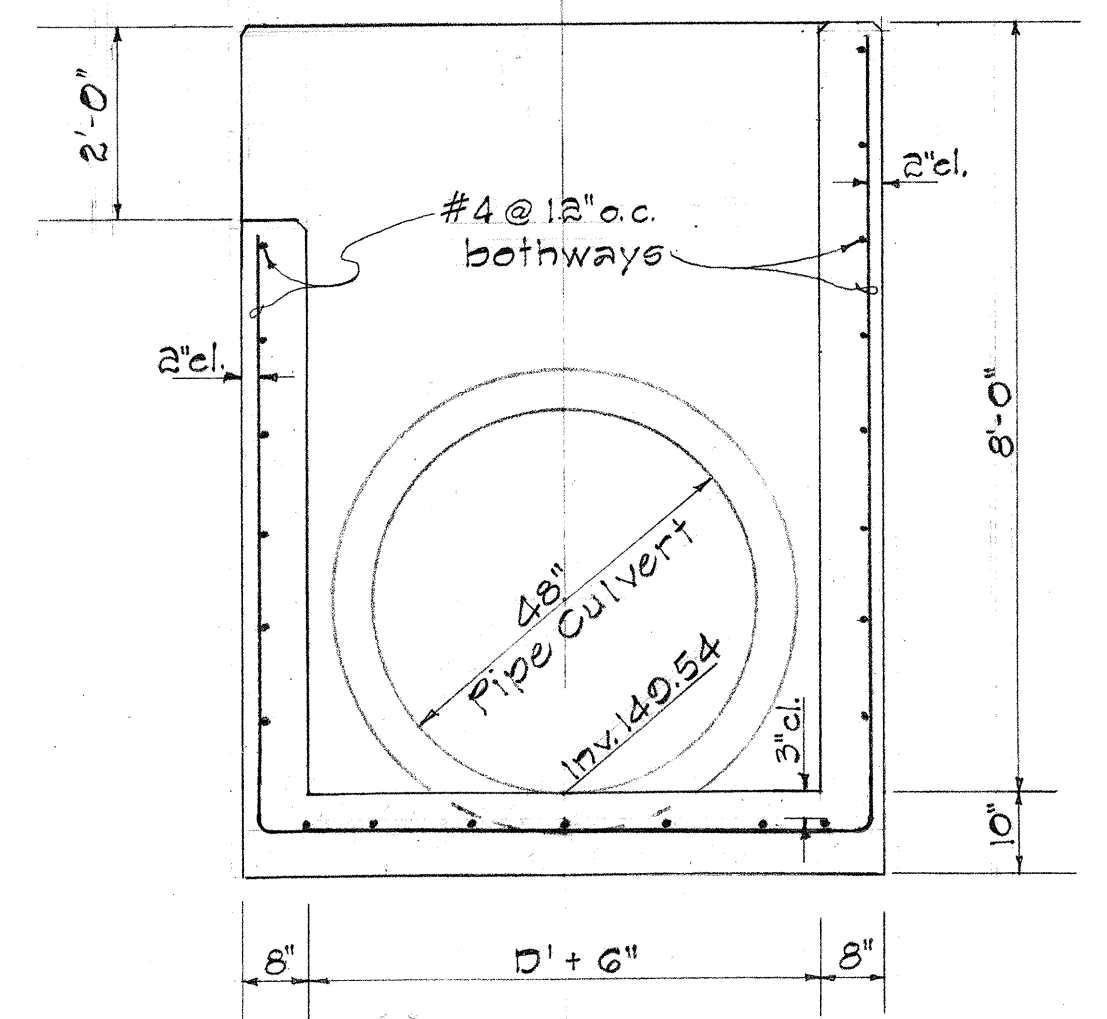

SECTION A-A
Scale: 1/8" = 1'-0"

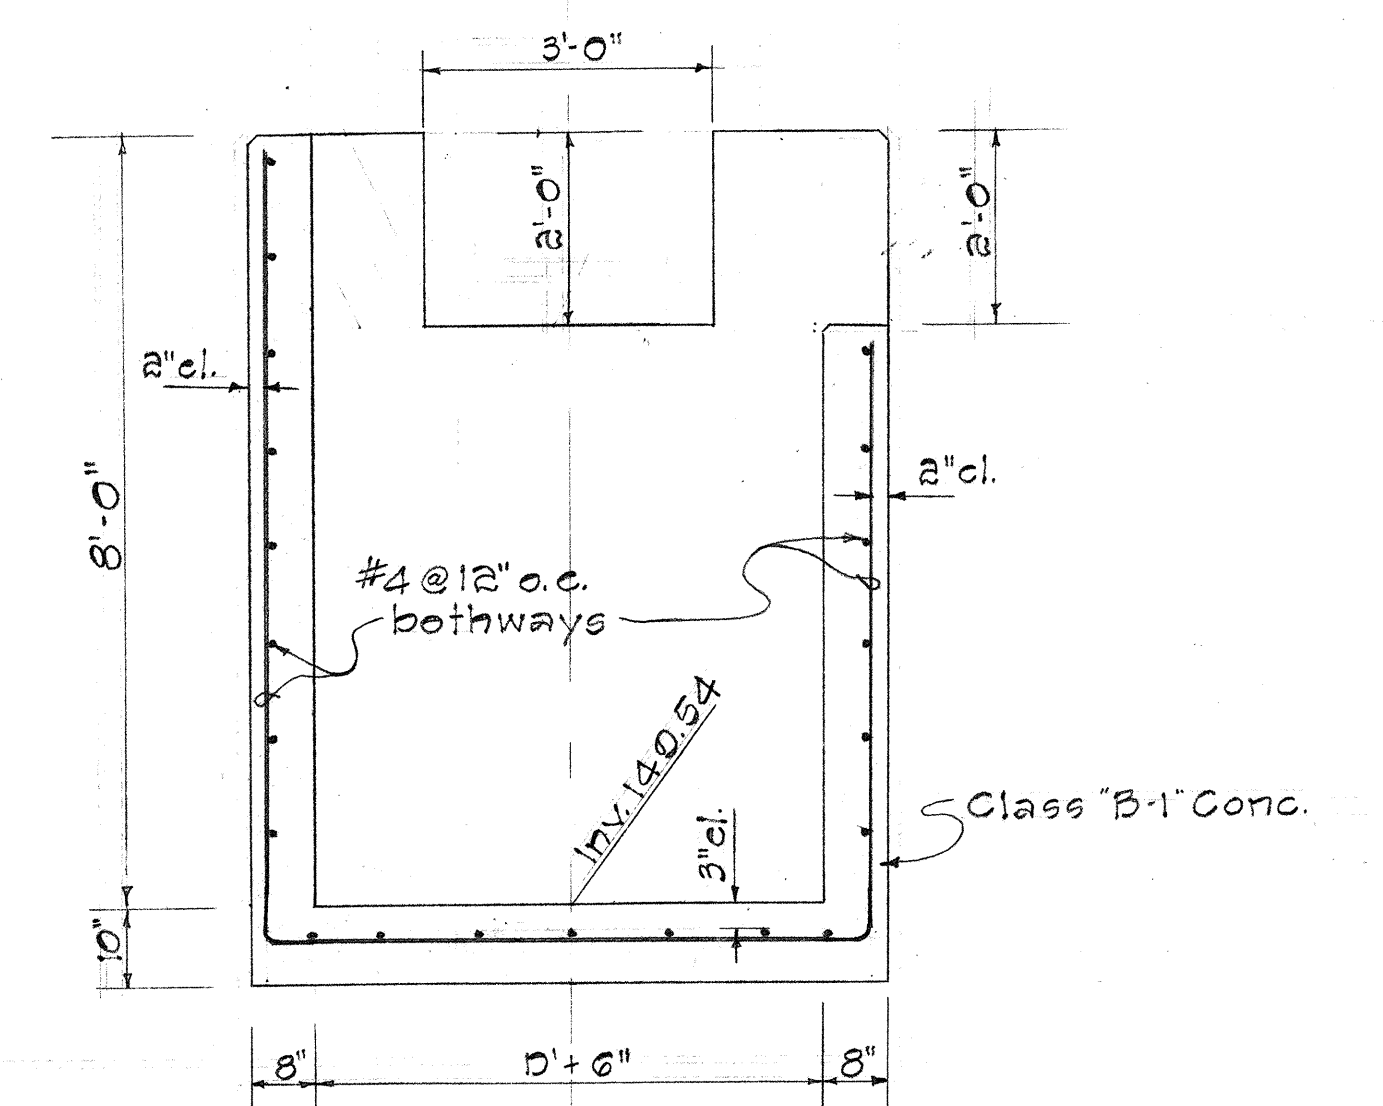

SECTION B-B
Scale: 1/8" = 1'-0"

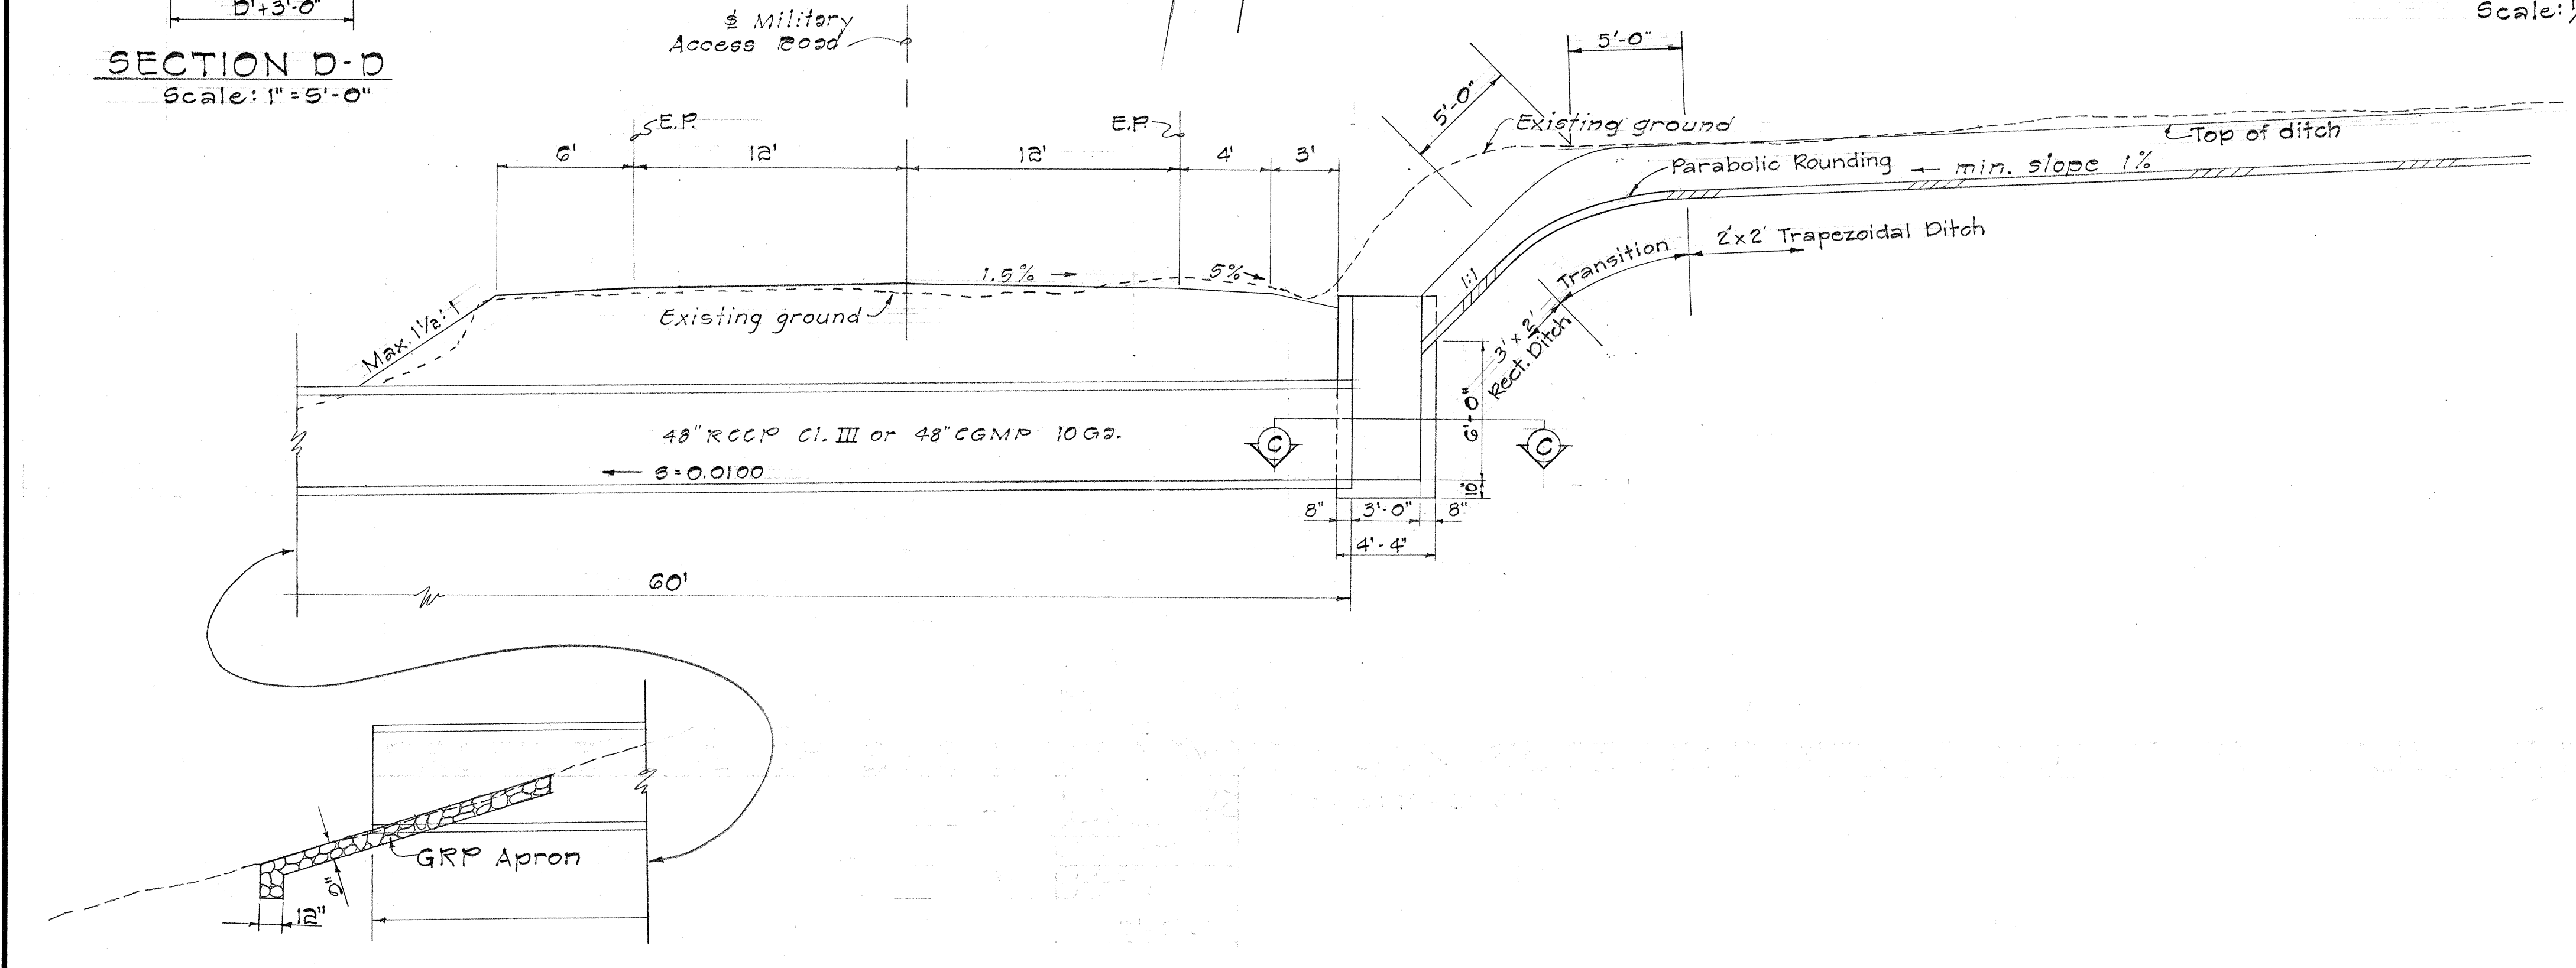

PROFILE AT & OF 2x2 LINED DITCH, CONCRETE DROP INTAKE AND 48" PIPE CULVERT
Scale: 1" = 5'-0"







SURVEY PLOTTED BY	DATE
DRAWN BY	
CHECKED BY	
NOTED BY	
NO.	

STATE OF HAWAII
DEPARTMENT OF TRANSPORTATION
HIGHWAYS DIVISION


DRAINAGE DETAILS
CULVERT CROSSING @
MAR STA. 3+10±

INTERSTATE ROUTE H-1
PROJ. No. I-HI-1(32):5, UNIT 1

Scale: As Shown Date: Sept. 1966
SHEET No. D-12 OF 19 SHEETS

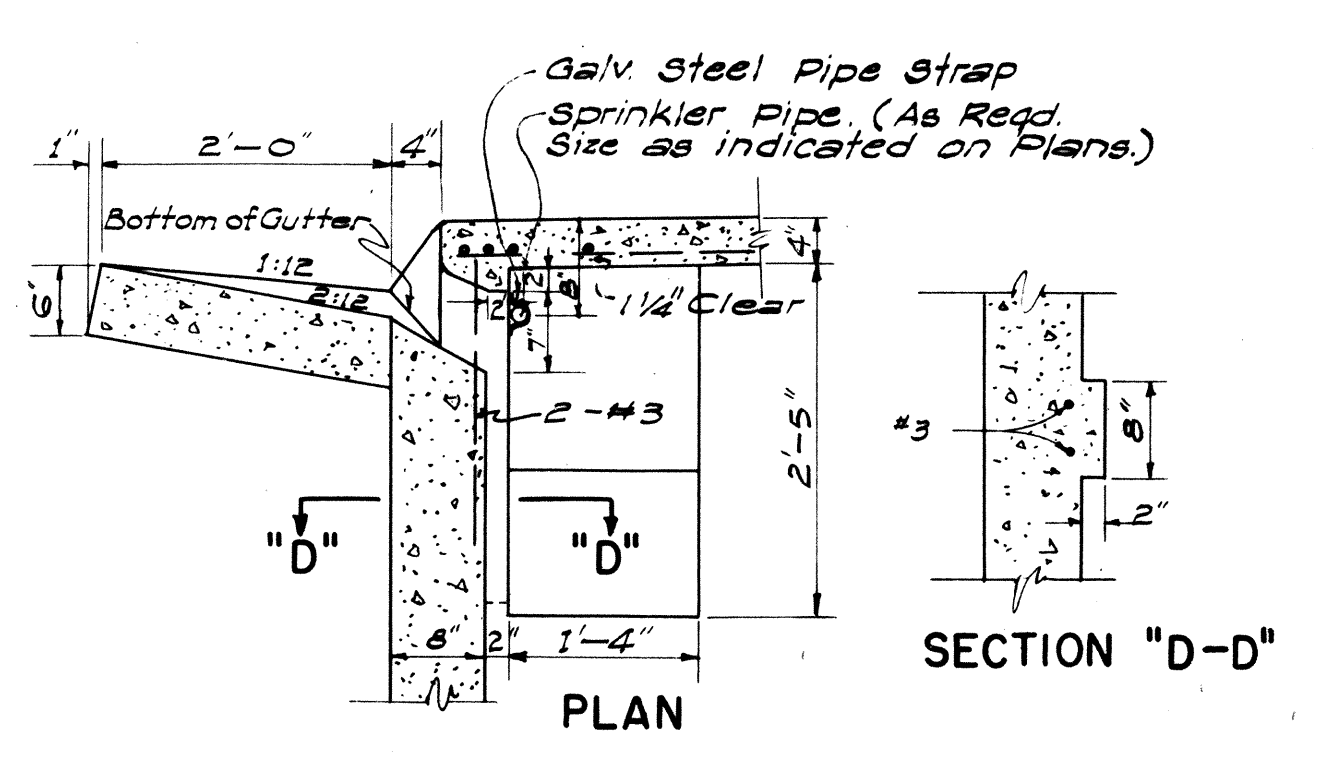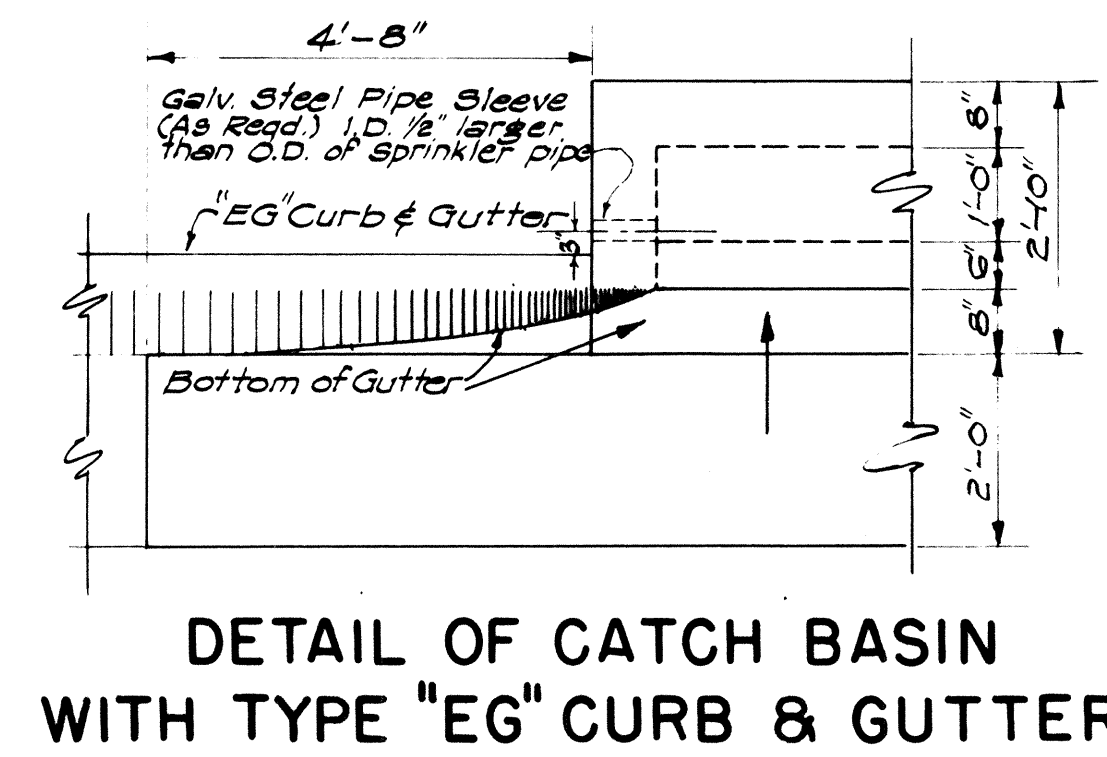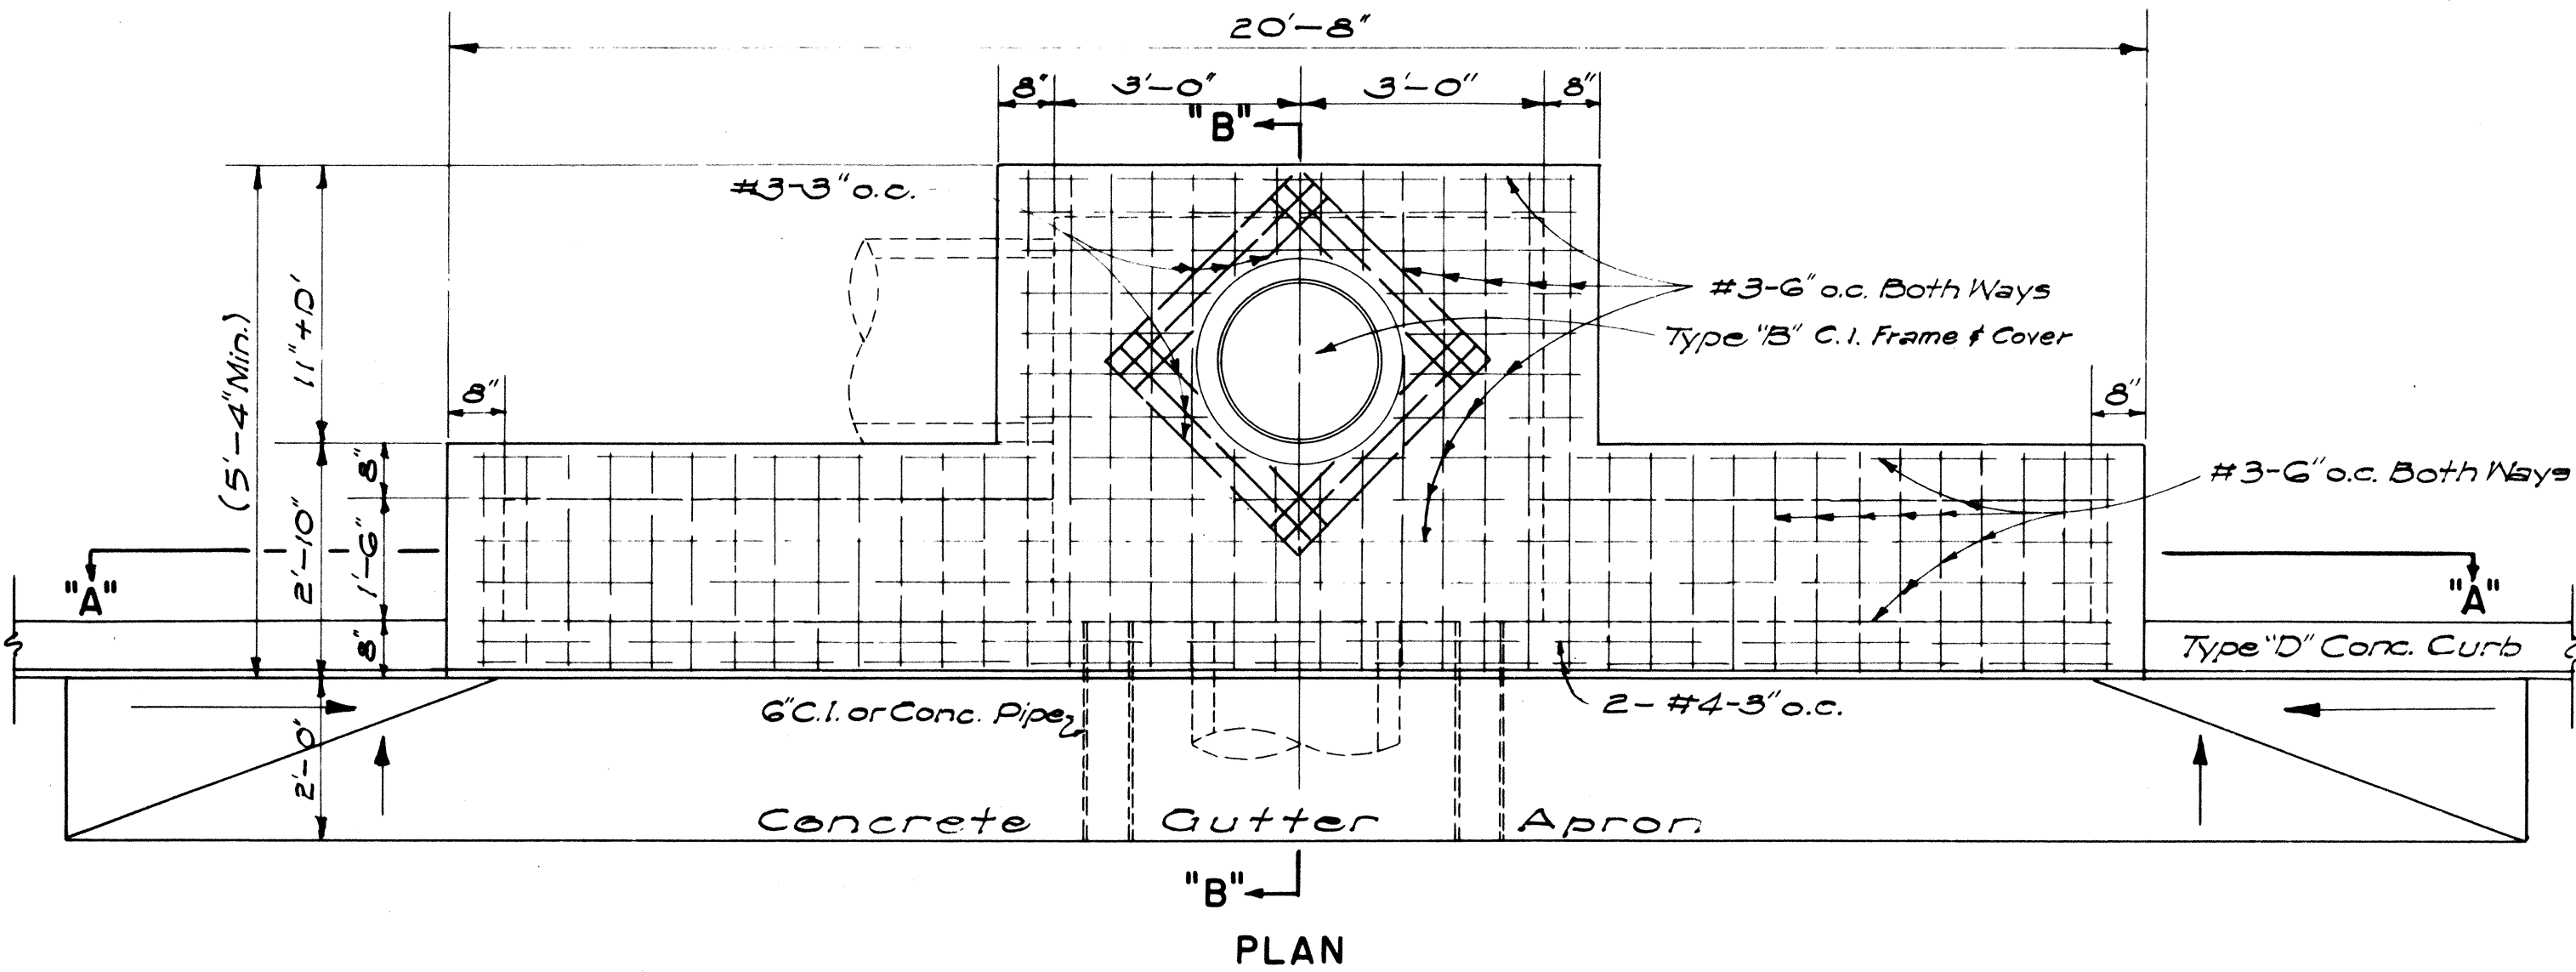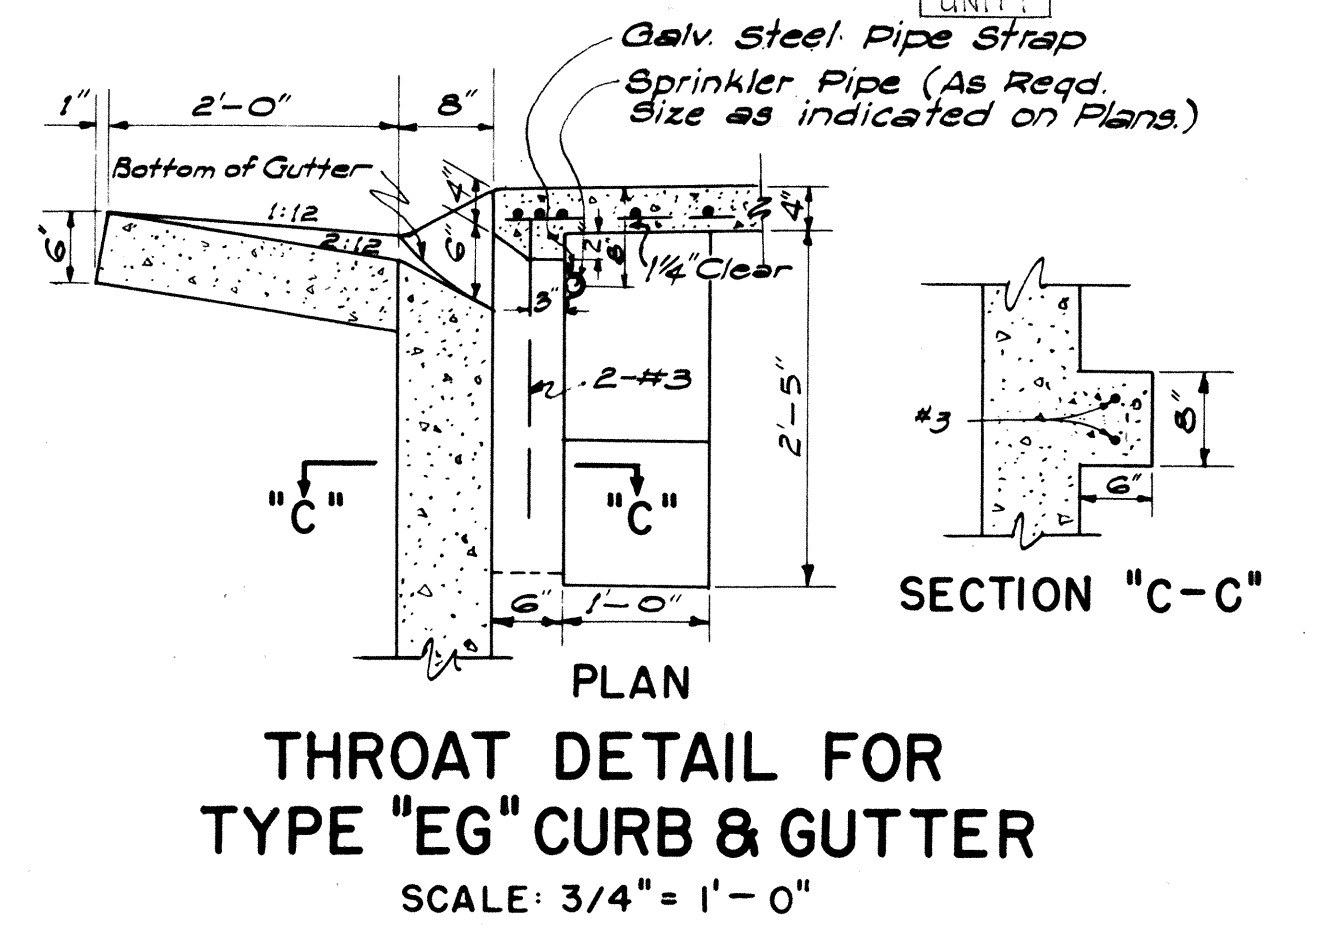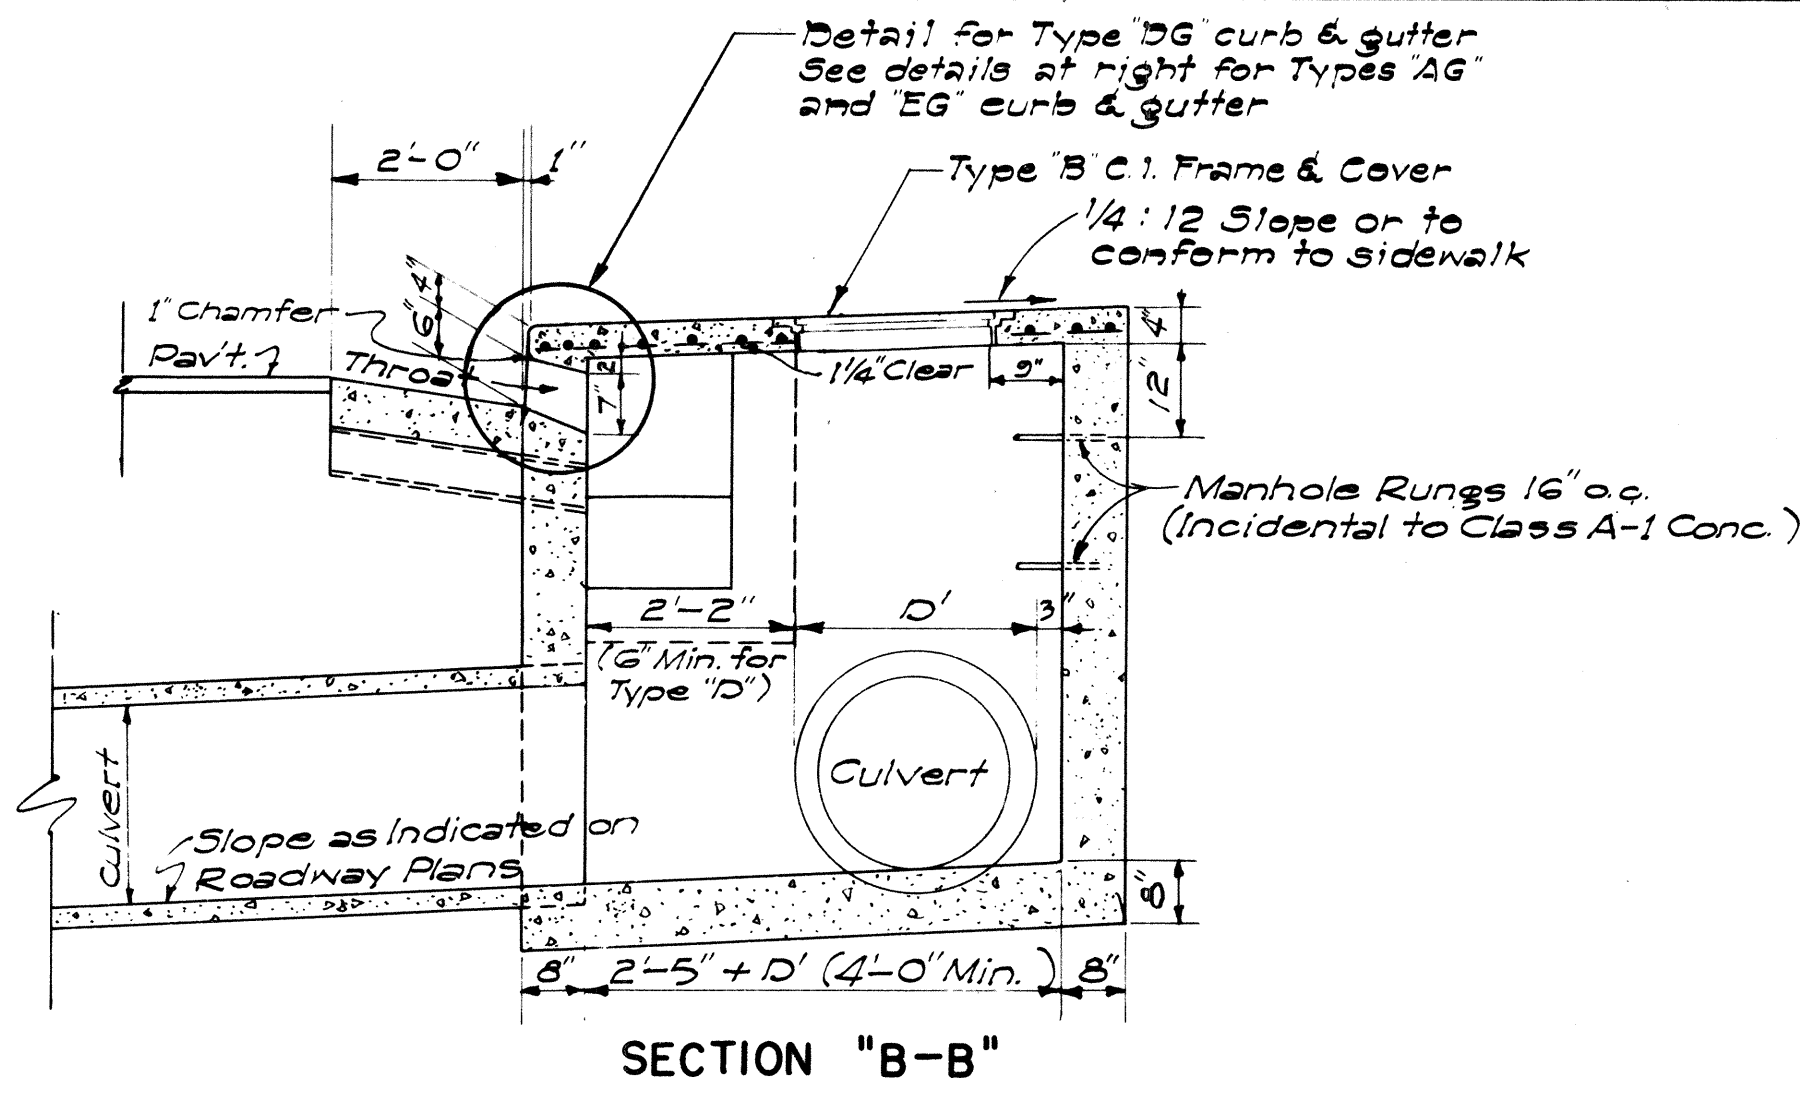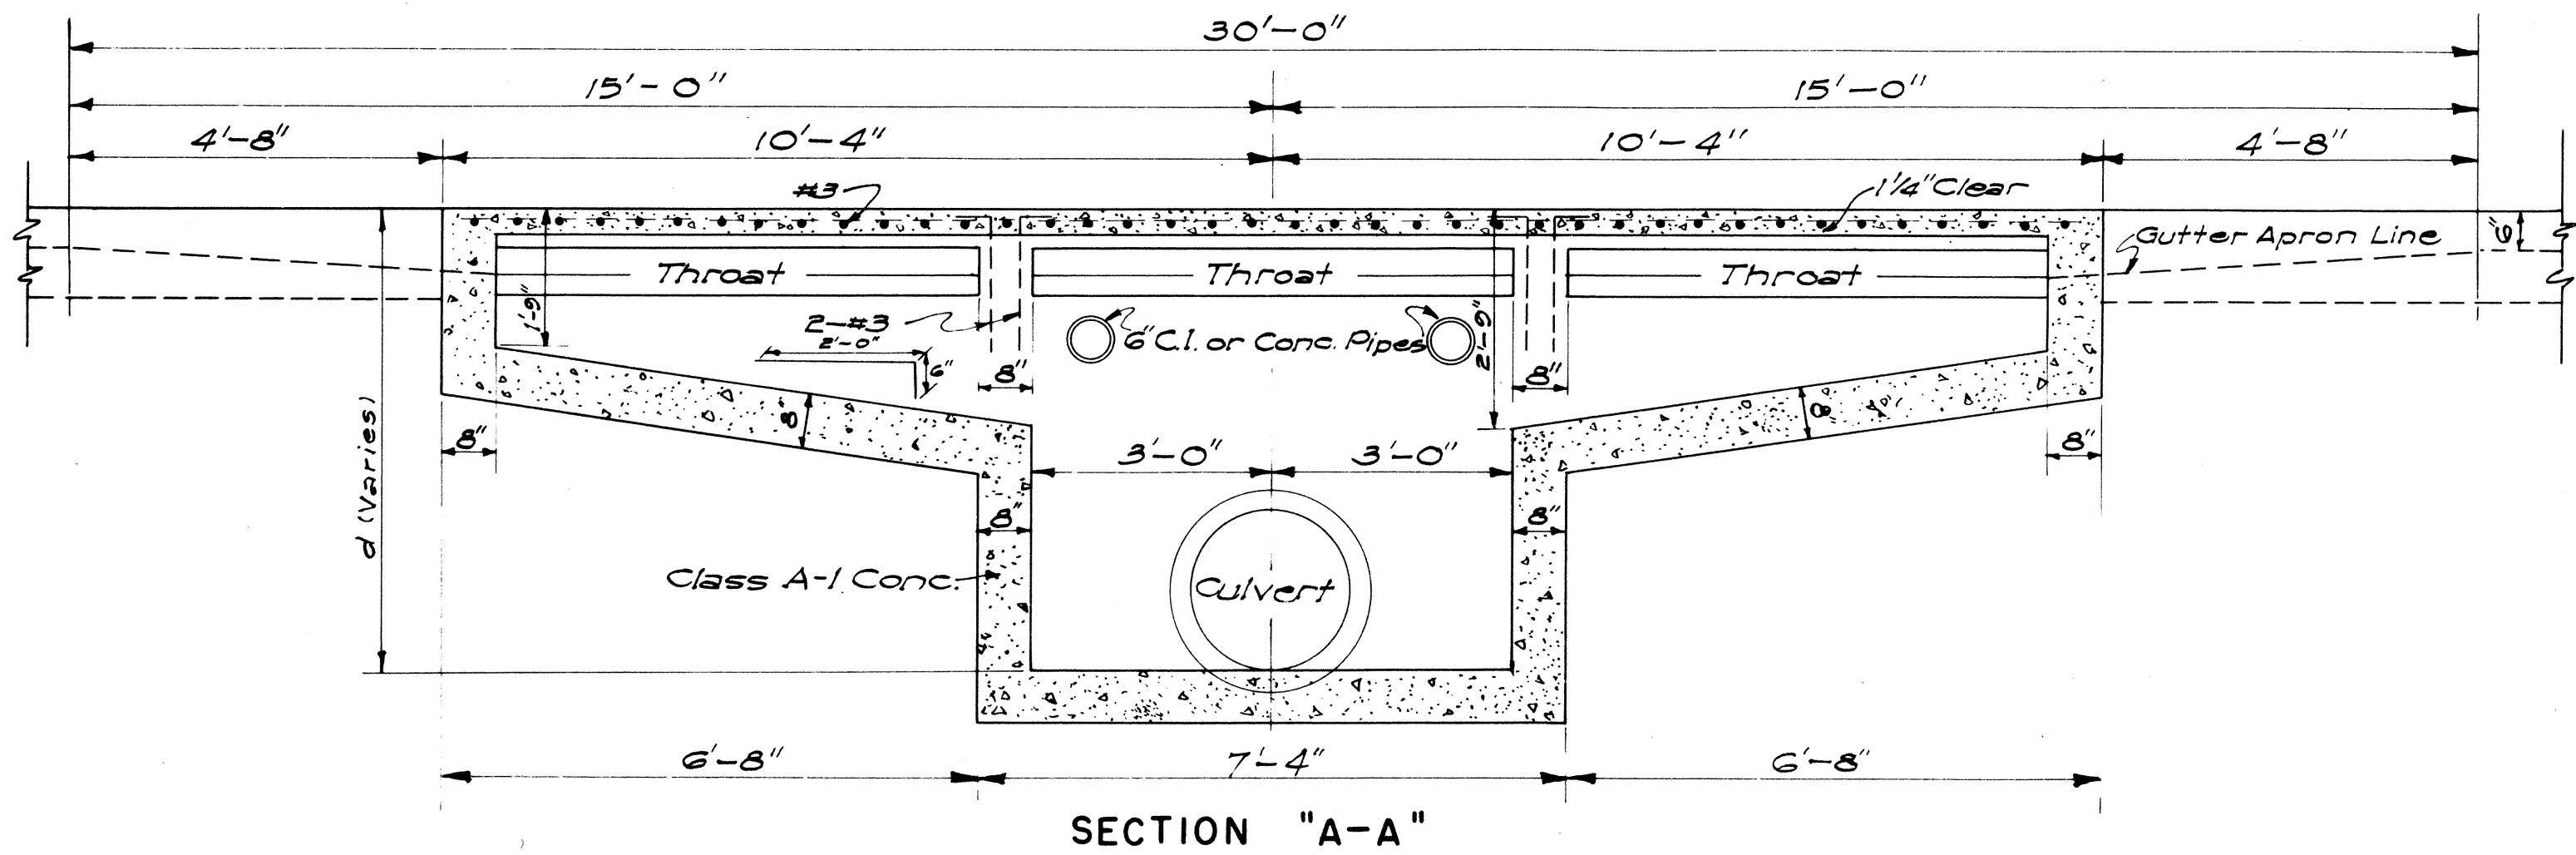

DETAIL OF TYPE "A" CATCH BASIN
SCALE: 1/2" = 1'-0"


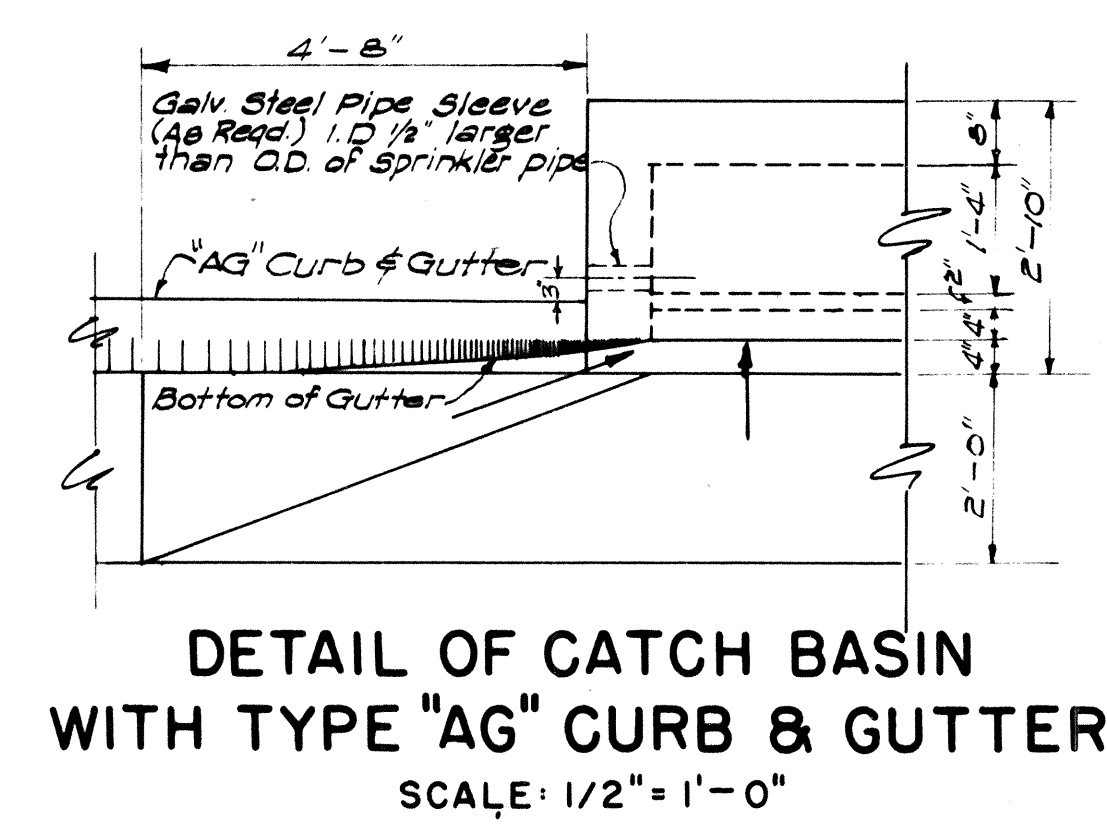


ESTIMATED QUANTITIES

Type	Class A-1 Conc.	Struct. Exc.	Reinf. Steel	Gutter Length
"A"	7.5 cy	24.7 cy	145 lb.	30'-0"
"B"	6.0 cy	21.5 cy	108 lb.	23'-4"
"C"	6.0 cy	21.5 cy	108 lb.	23'-4"
"D"	4.0 cy	16.5 cy	77 lb.	16'-8"


NOTES:

- Quantities based on d = 5.75' and D = 30'
- Quantities do not include concrete for Gutter Apron.
- The Contractor shall install two 6" Cast Iron or Concrete Pipes as incidental to Class A-1 Concrete for Construction Drainage.
- Culvert shall leave C.B. from any position and any direction indicated by plans or ordered by the Engineer. Culvert may both enter and leave C.B. so that C.B. will also act as Manhole.
- The Contractor shall install Galvanized Steel Pipe Sleeves and Straps as incidental to Sprinkler System.

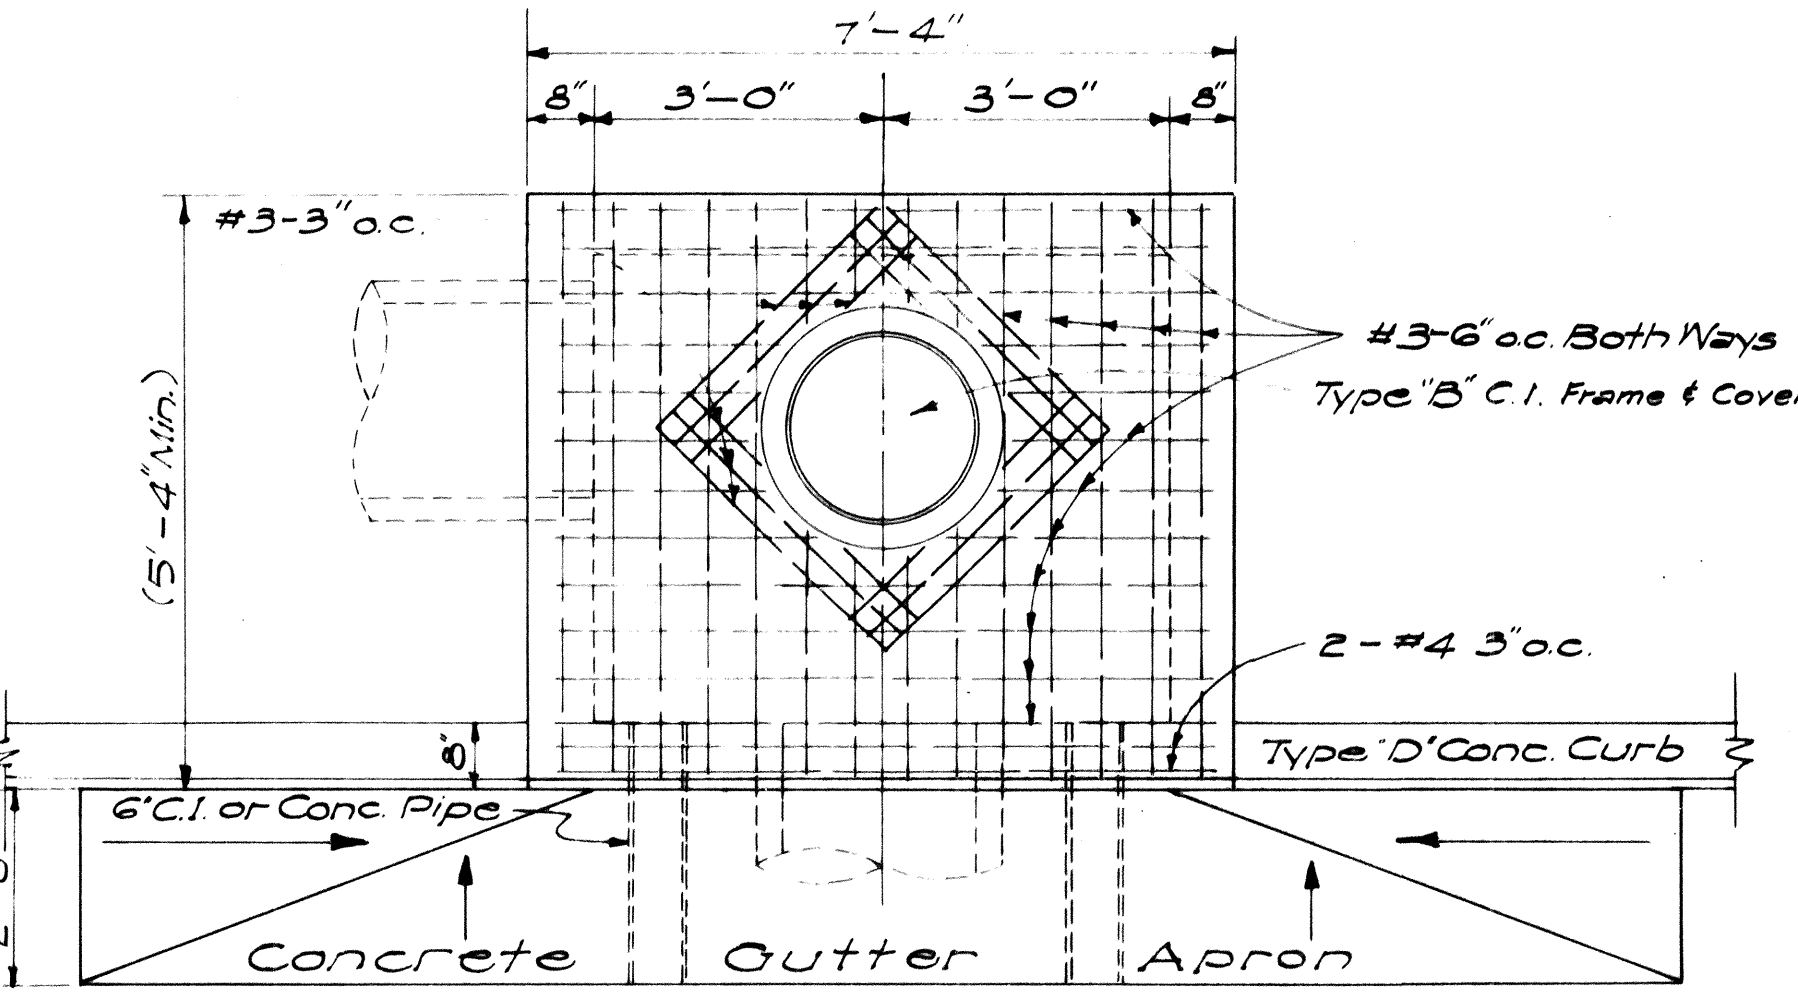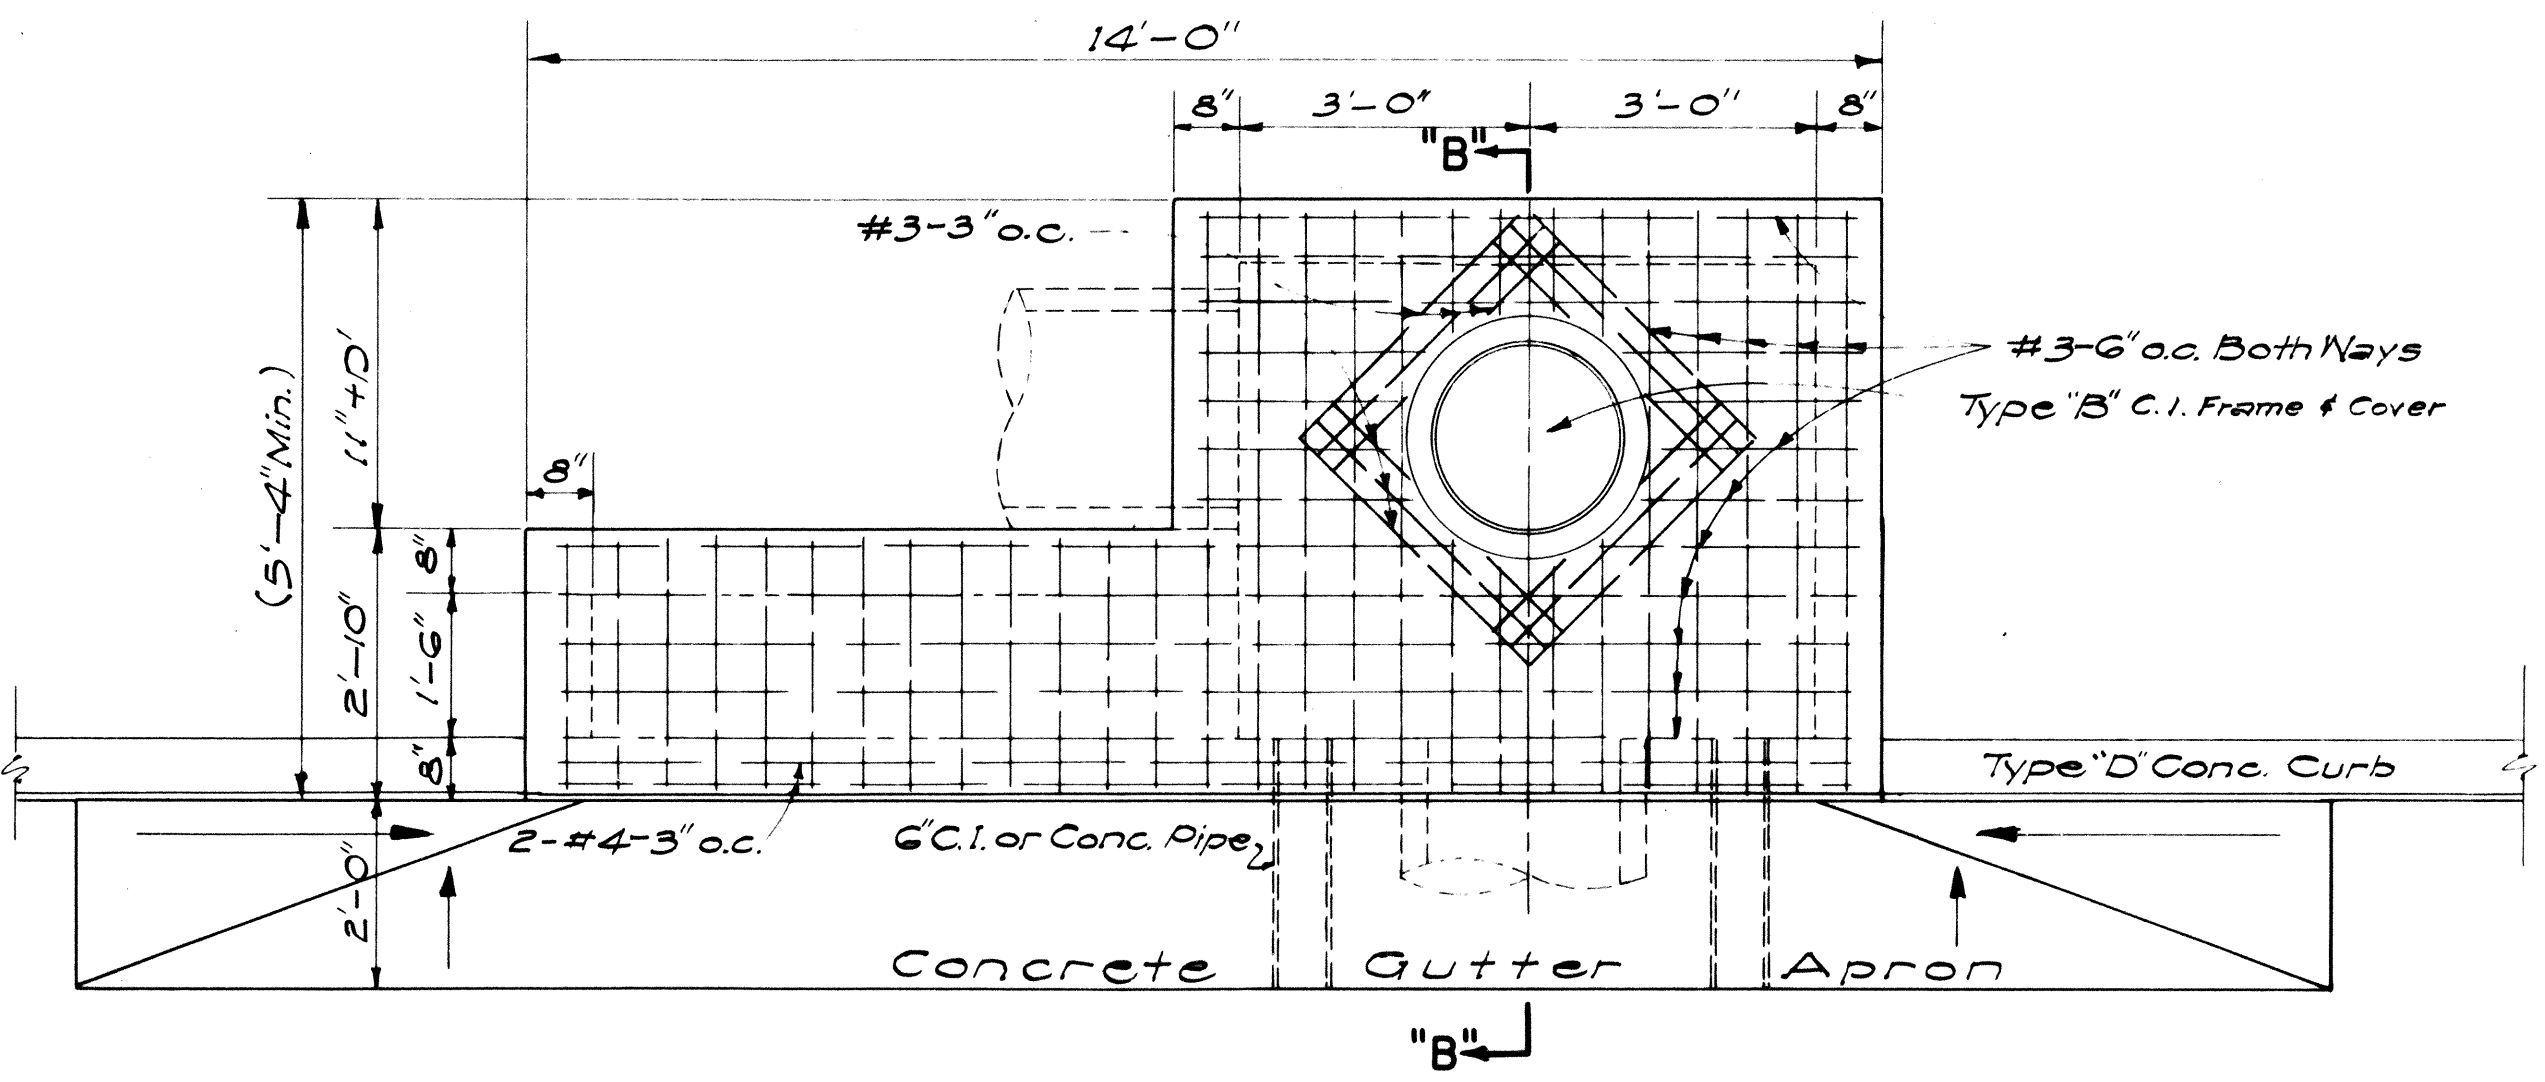

DETAIL OF TYPE "B" CATCH BASIN
SCALE: 1/2" = 1'-0"
NOTE: TYPE "C" C.B. SIMILAR BUT OPPOSITE HAND

DETAIL OF TYPE "D" CATCH BASIN
SCALE: 1/2" = 1'-0"



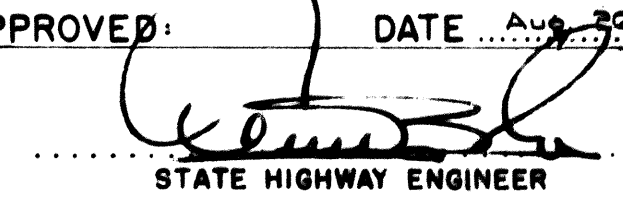
APPROVED:  DATE: 4-25-1952
STATE HIGHWAY ENGINEER

STATE OF HAWAII
DEPARTMENT OF TRANSPORTATION
HIGHWAYS DIVISION
STANDARD DETAILS
CATCH BASINS

SCALES AS NOTED
SHEET No. 28 OF 73 SHEETS

DATE: 2/17/50
DESIGNED BY: J. V. V.
DRAWN BY: J. V. V.
CHECKED BY: J. V. V.
NOTE BOOK
No. 1

ORIGINAL PLAN	SURVEY PLOTTED BY.....	DATE.....
NOTE BOOK	DESIGNED BY.....	".....
	DRAWN BY.....	".....
	TRACED BY.....	".....
	QUANTITIES BY.....	".....
No.....	CHECKED BY.....	".....

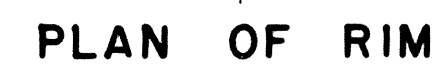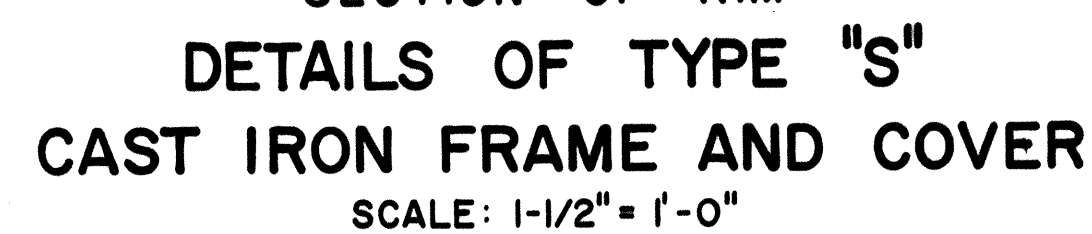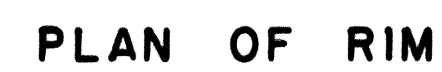


SCALE : 1-1/2" = 1'-0"



SCALE: 1-1/2" = 1'-0"

TYPE C C.I. FRAME AND GRATING
SCALE: 3/4" = 1'-0"

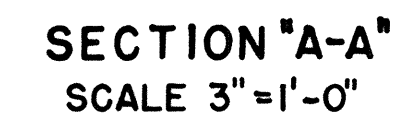


SCALE: 1-1/2" = 1'-0"

SHEET N^o 10-14 OF 10 SHEETS


THE TYPE "W" CAST IRON FRAME AND COVER SHOWN ON THIS SHEET IS EQUIVALENT TO THE CITY AND COUNTY OF HONOLULU, BOARD OF WATER SUPPLY'S CAST IRON MANHOLE FRAME AND COVER, 20" SIZE.

FED. AID DIST. NO.	STATE	FED. AID PROJ. NO.	FISCAL YEAR	SHEET NO.	TOTAL SHEETS
HAWAII	HAWAII	7-HI-1(32)-5 UNIT 1	1966	30	73

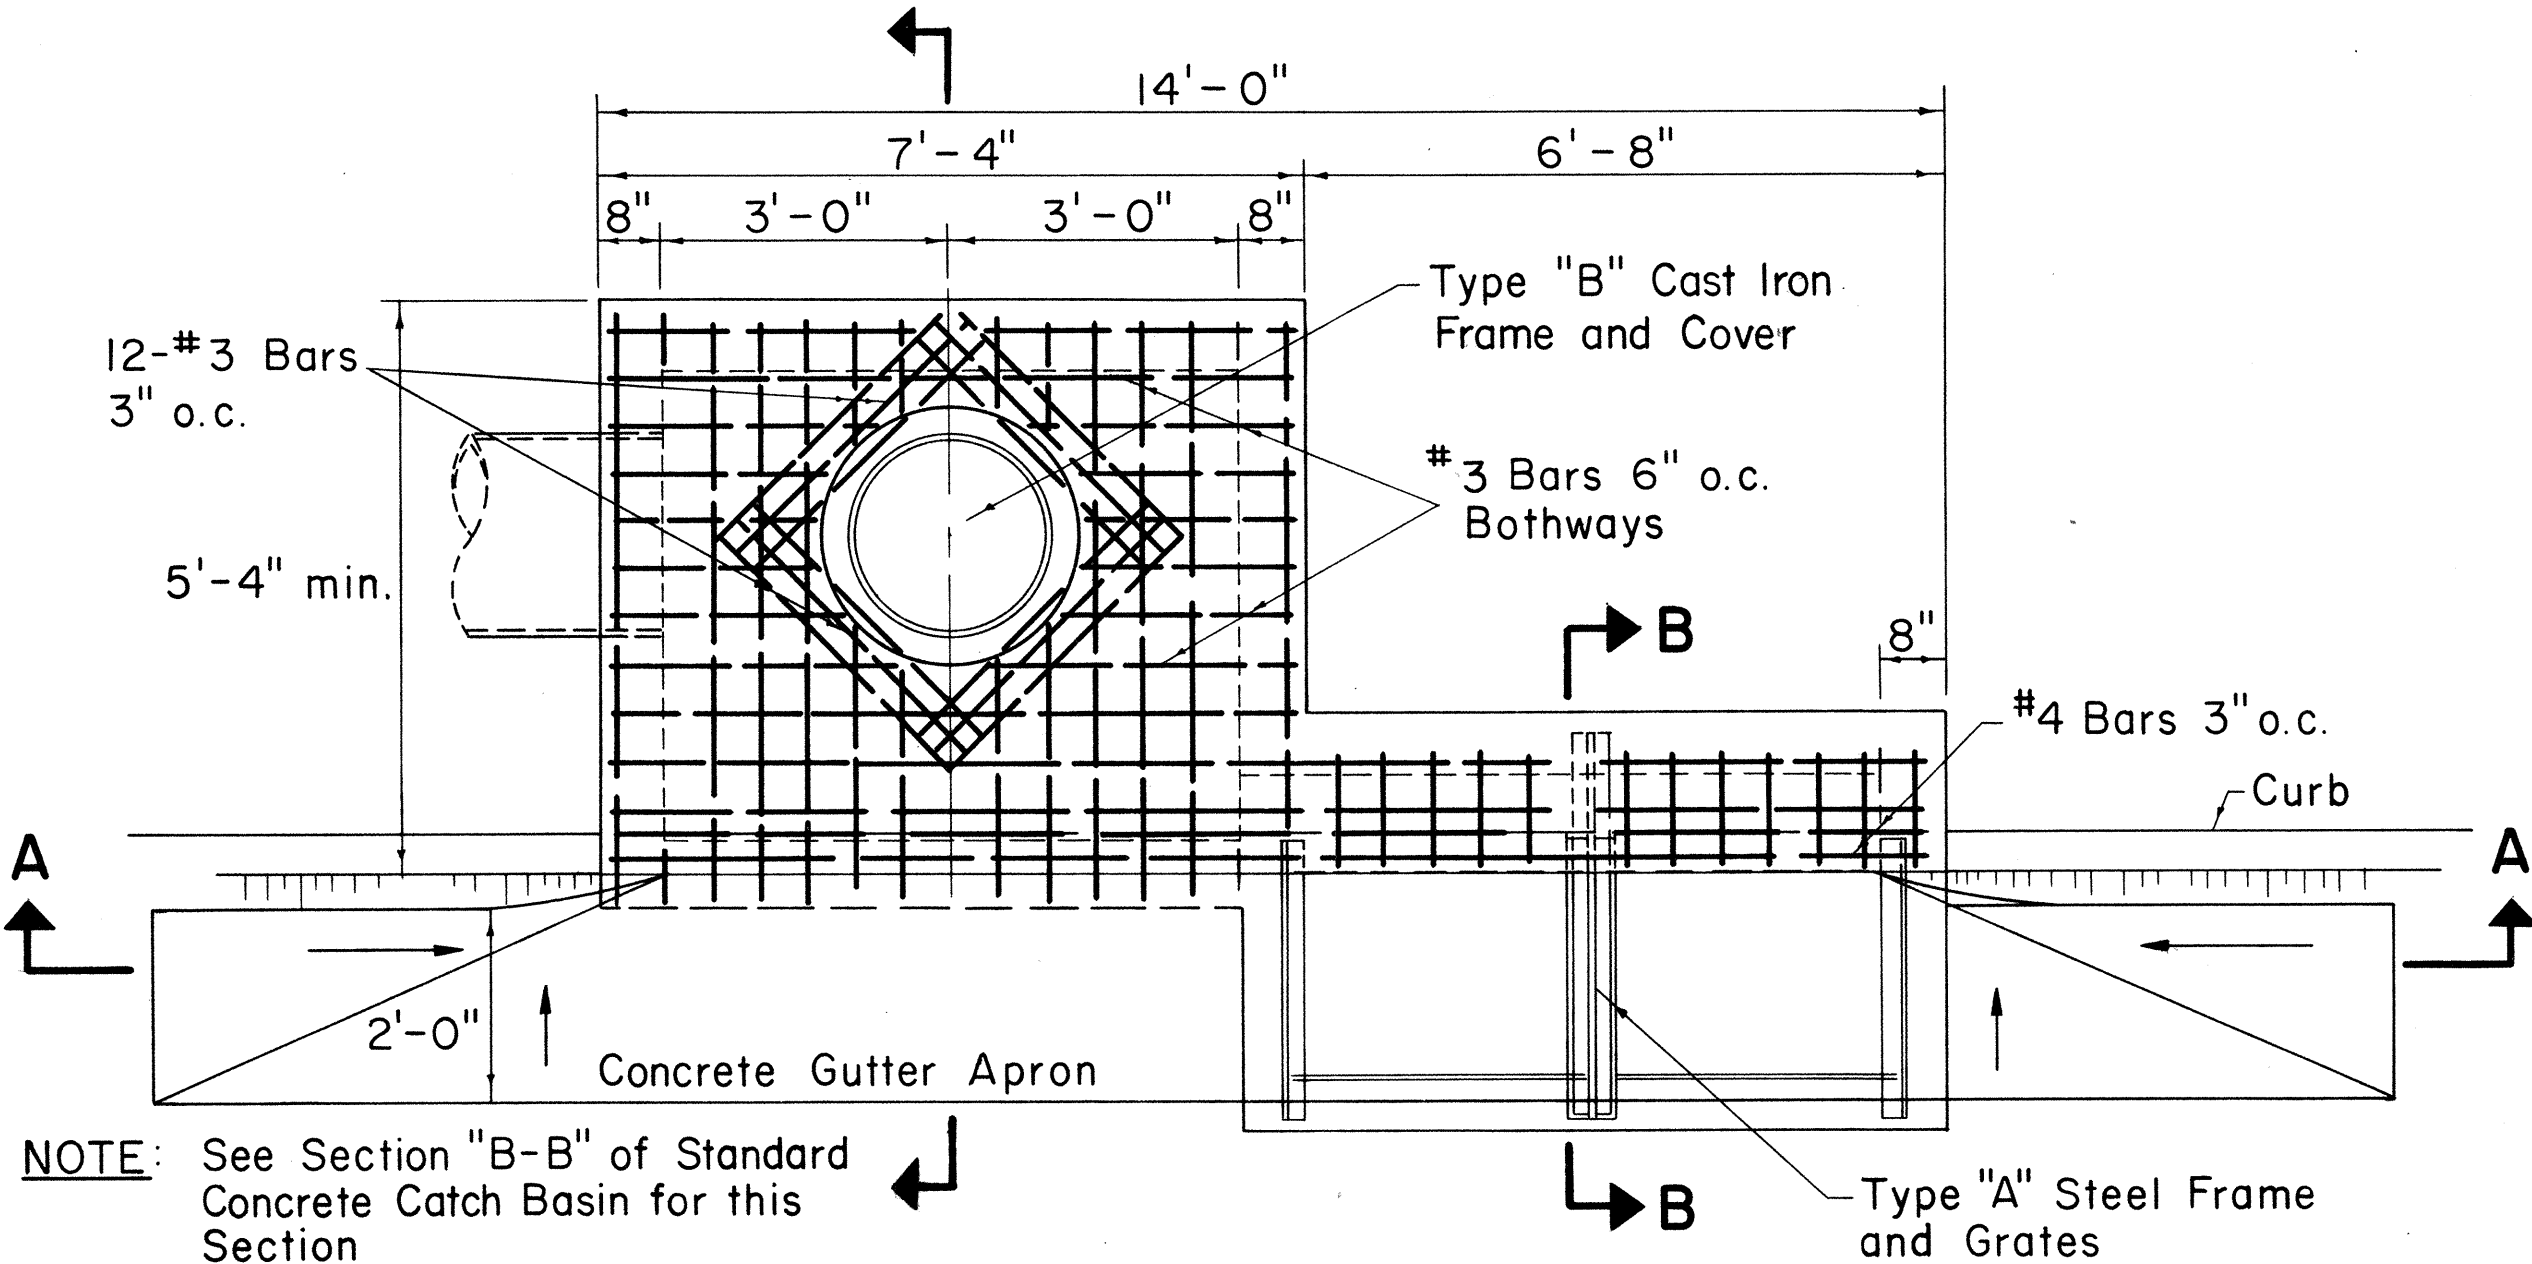


NOTE: See Section "B-B" of Standard Concrete Catch Basin for this Section

PLAN

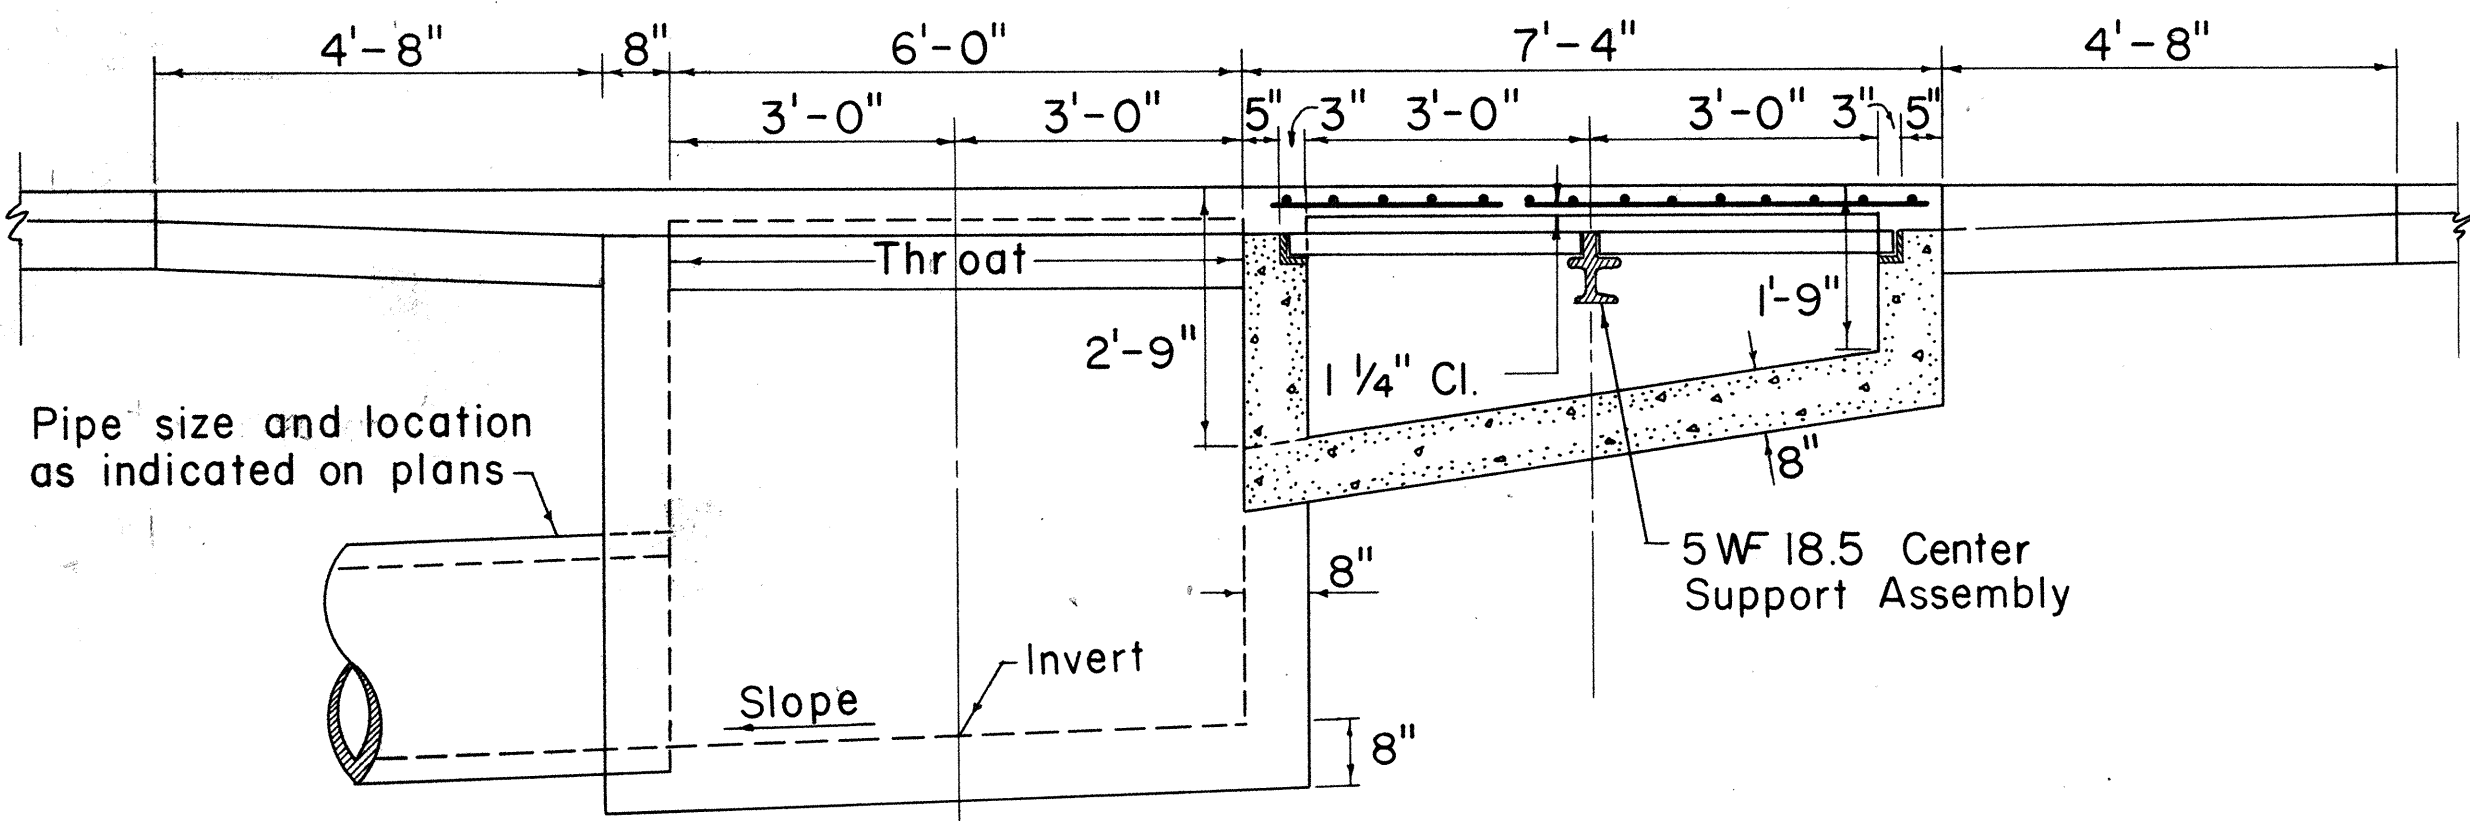


SECTION A-A

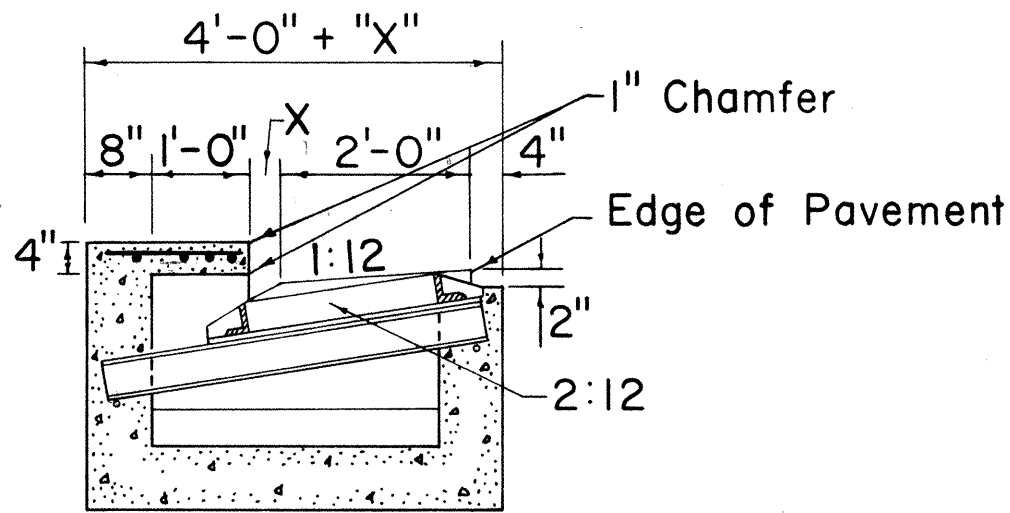


SECTION B-B

DETAIL OF TYPE "CG" CATCH BASIN


Scale: 1/2" = 1'-0"

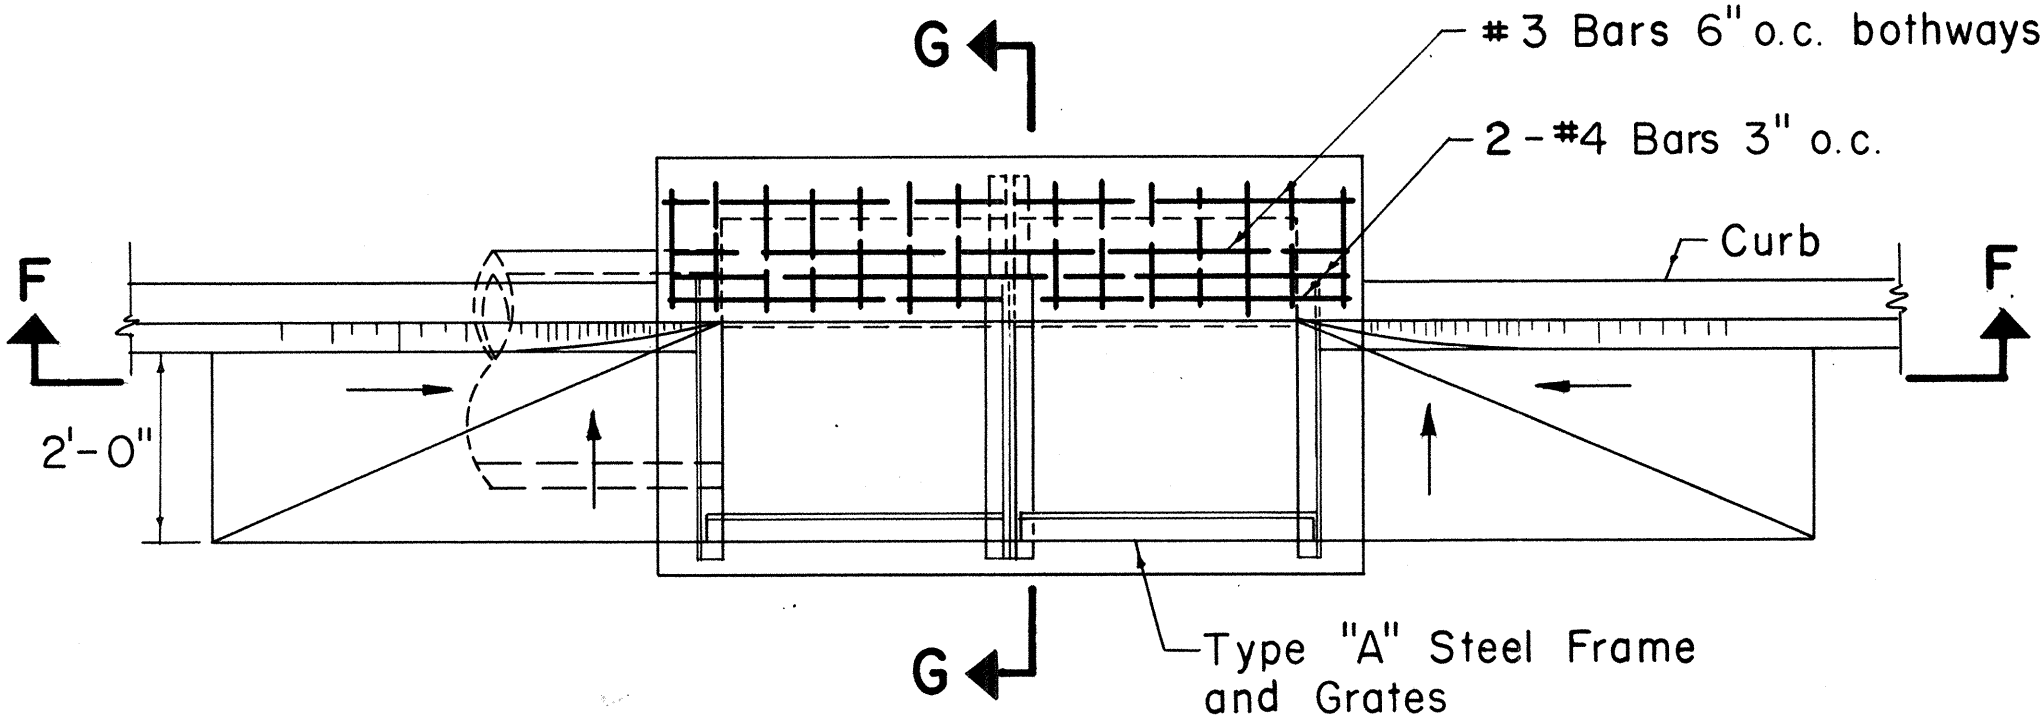

PLAN

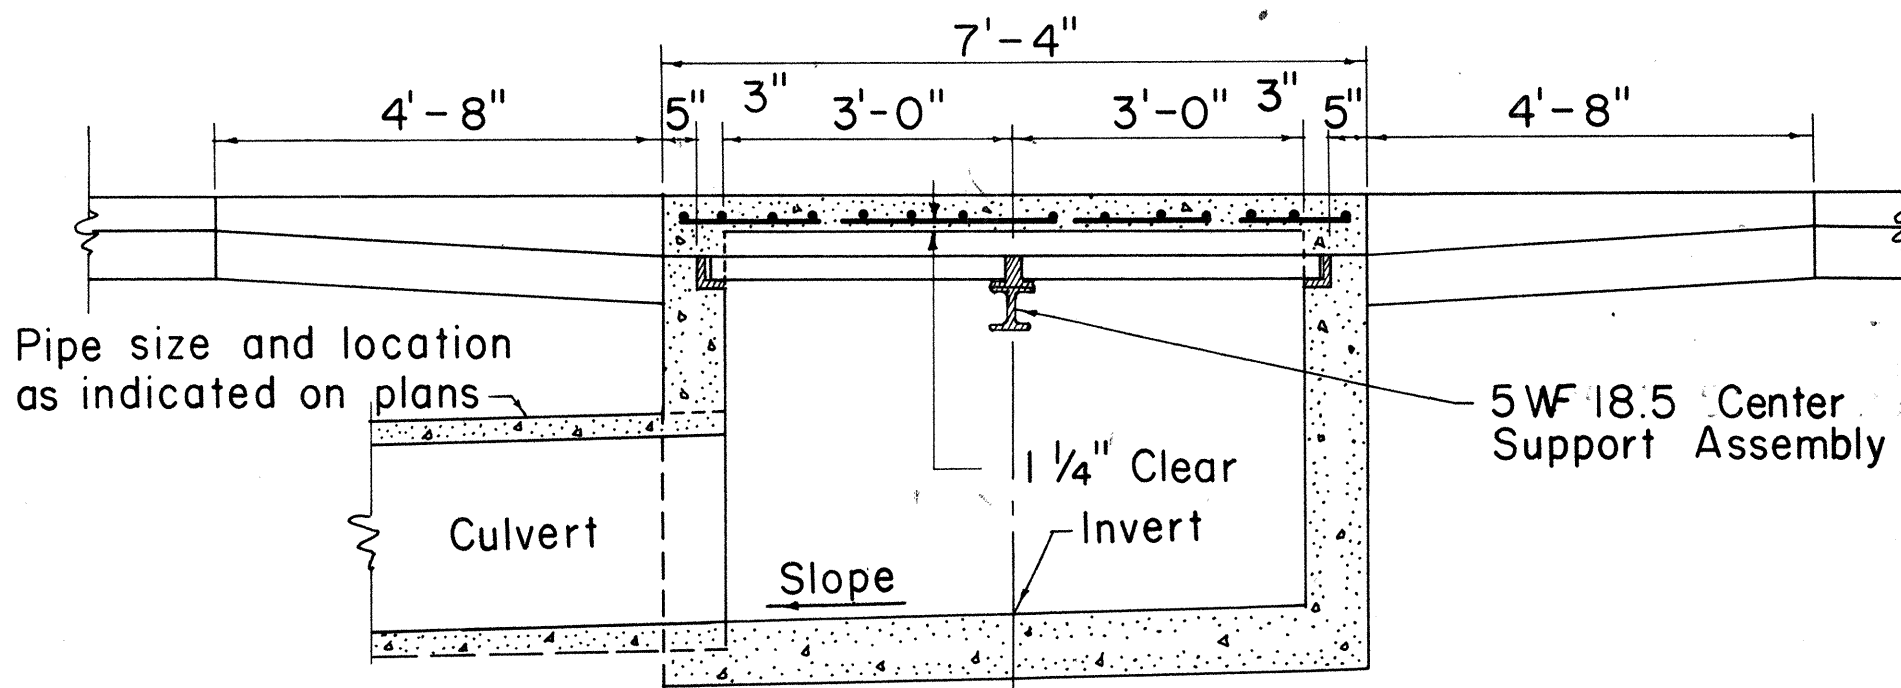


SECTION F-F

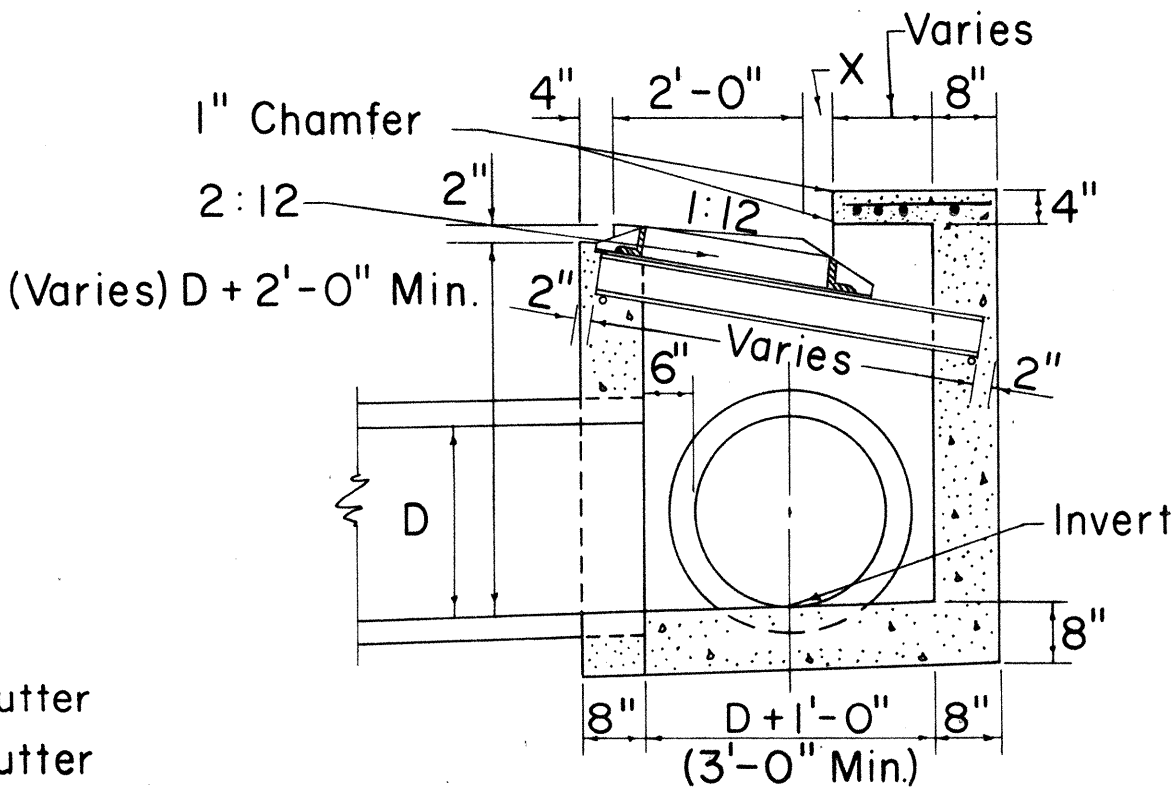


SECTION G-G

DETAIL OF TYPE "DG" CATCH BASIN

Scale: 1/2" = 1'-0"

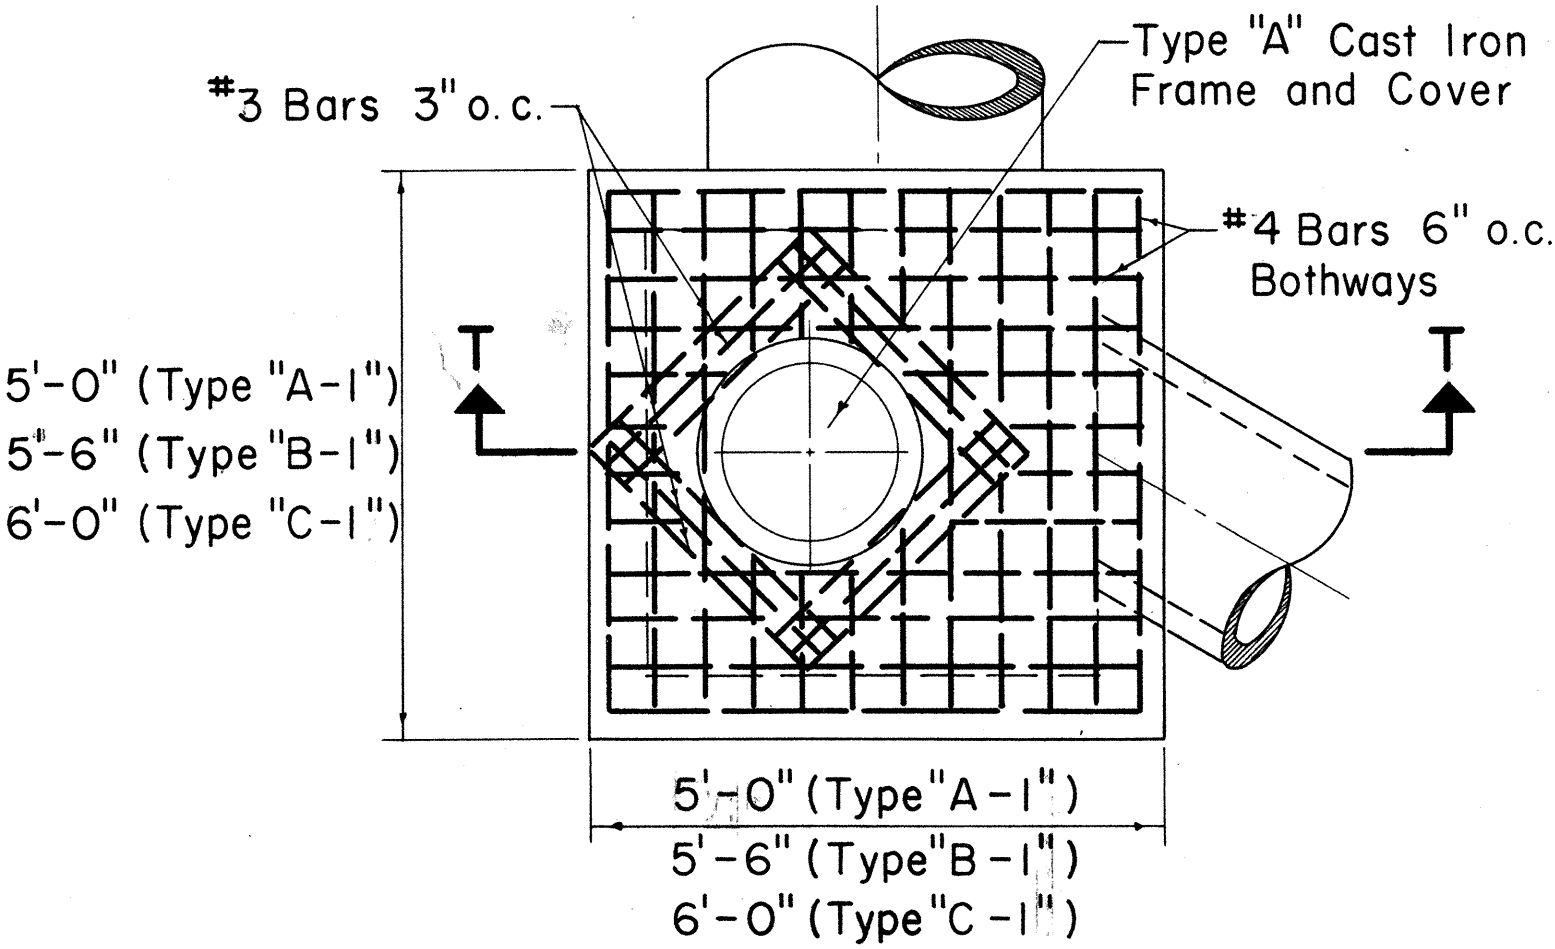

PLAN

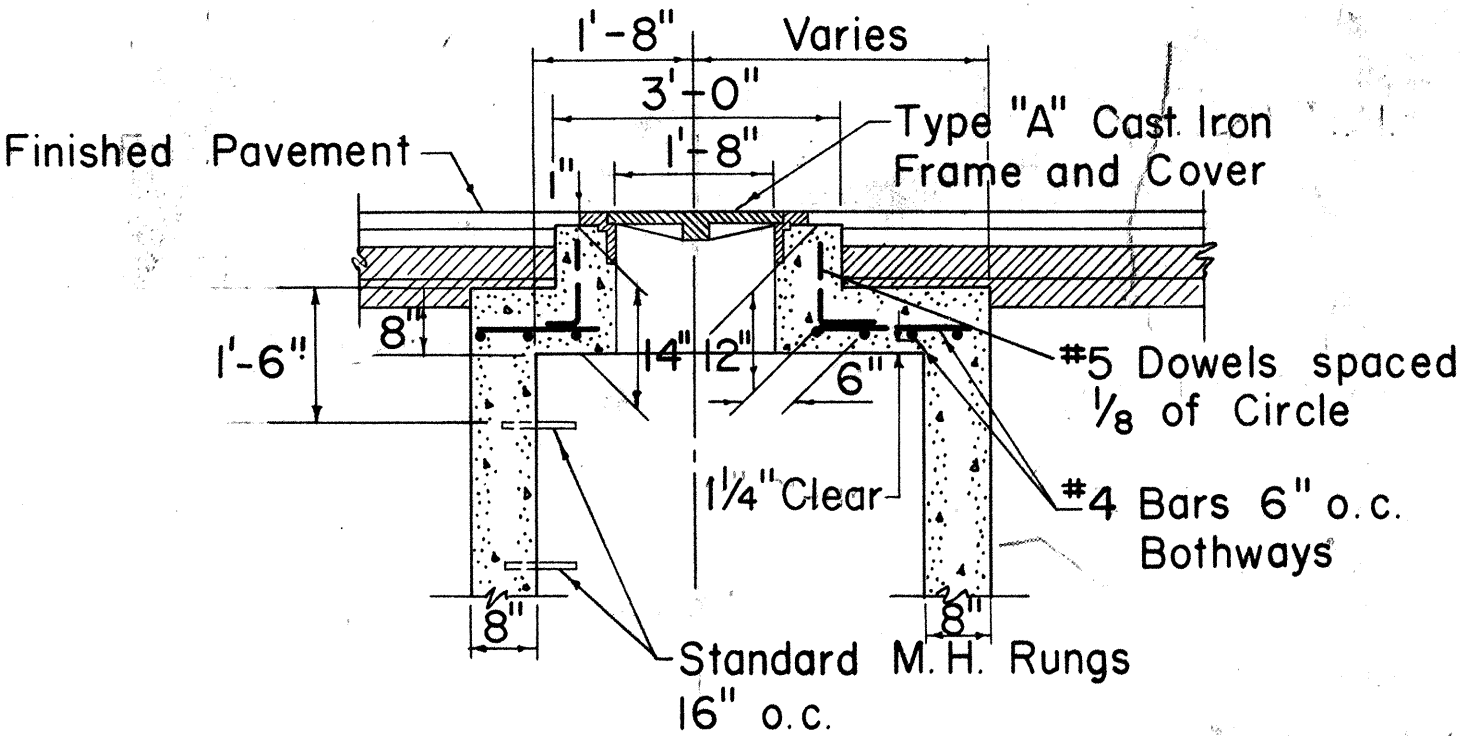

SECTION T-T

TYPE "A-I", "B-I", & "C-I" STORM DRAIN MANHOLE TOP DETAIL UNDER PAVEMENT (BOTTOM DETAIL SIMILAR TO TYPE "A", "B", & "C")

Scale: 1/2" = 1'-0"


APPROVED:

DIRECTOR OF TRANSPORTATION DATE

STATE OF HAWAII
DEPARTMENT OF TRANSPORTATION
HIGHWAYS DIVISION

STANDARD DETAILS
CATCH BASINS AND
STORM DRAIN MANHOLES
Scale: As Noted Date
SHEET NO. 30 OF 73 SHEETS

DATA FOR OUTLET DITCH				
D	W	H	T=H+H	
18"	24"	2'-0"	4'-0"	
24"	30"	2'-0"	4'-6"	
30"	30"	2'-6"	5'-0"	
36"	36"	3'-0"	6'-0"	

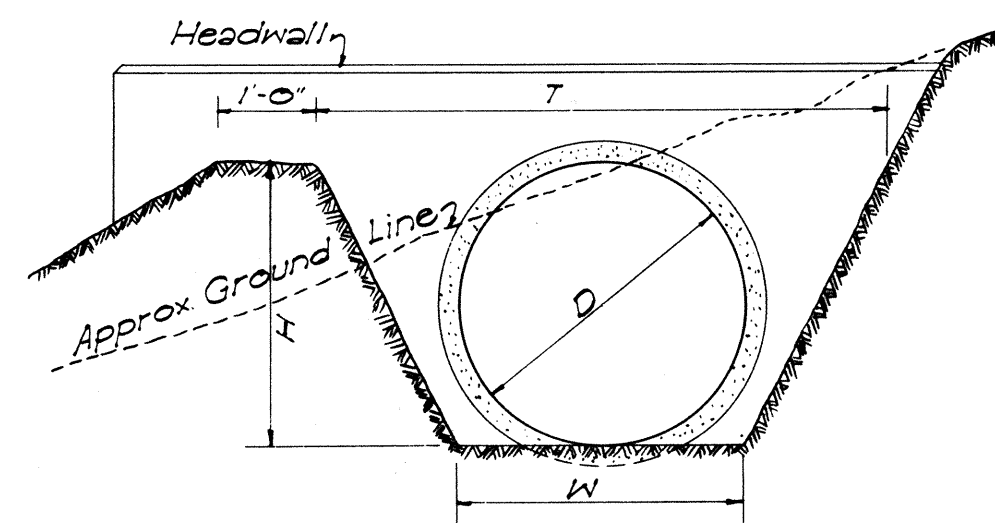



DETAIL OF OUTLET DITCH

Scale: 1/2" = 1'-0"

DATA FOR MASONRY DROP INTAKE					Where Variables Equal
D	D	L=D+G	Cu Yds		
23"	18"	2'-5"	3.02	4'-6"	
30"	24"	3'-0"	3.61	5'-0"	
37"	30"	3'-7"	4.21	5'-6"	
44"	36"	4'-2"	4.85	6'-0"	

NOTE:

Dimension "X" is assumed as 2'-4" in figuring the above quantities.

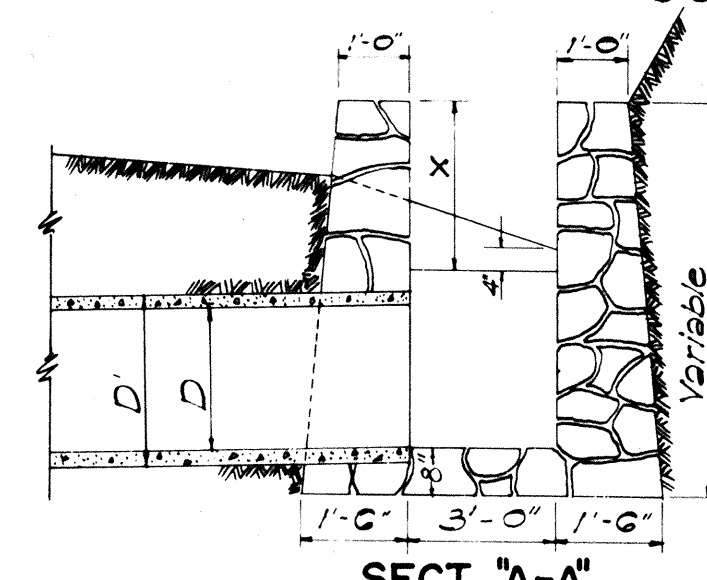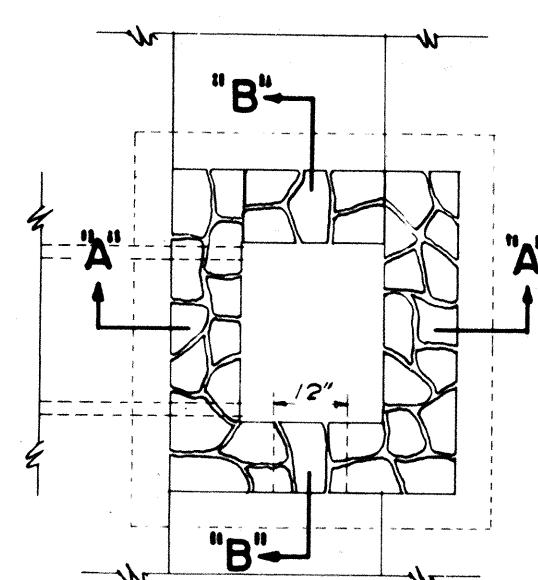


SECT. "A-A"

SECT. "B-B"


DETAIL OF MASONRY DROP INTAKE

Scale: 3/8" = 1'-0"

DATA-MASONRY HEADWALL					Cast-in-Place Conc. Culvert	Conc. Pipe Culvert	Corrugated Pipe Culvert
D	H	B	L		Cu Yds	Cu Yds	Cu Yds
18"	3'-6"	1'-0"	6'-0"		0.85	0.93	0.93
24"	4'-0"	2'-0"	7'-6"		1.28	1.45	1.41
30"	4'-6"	2'-3"	9'-0"		1.83	2.06	2.00
36"	5'-0"	2'-6"	10'-6"		2.40	2.84	2.72

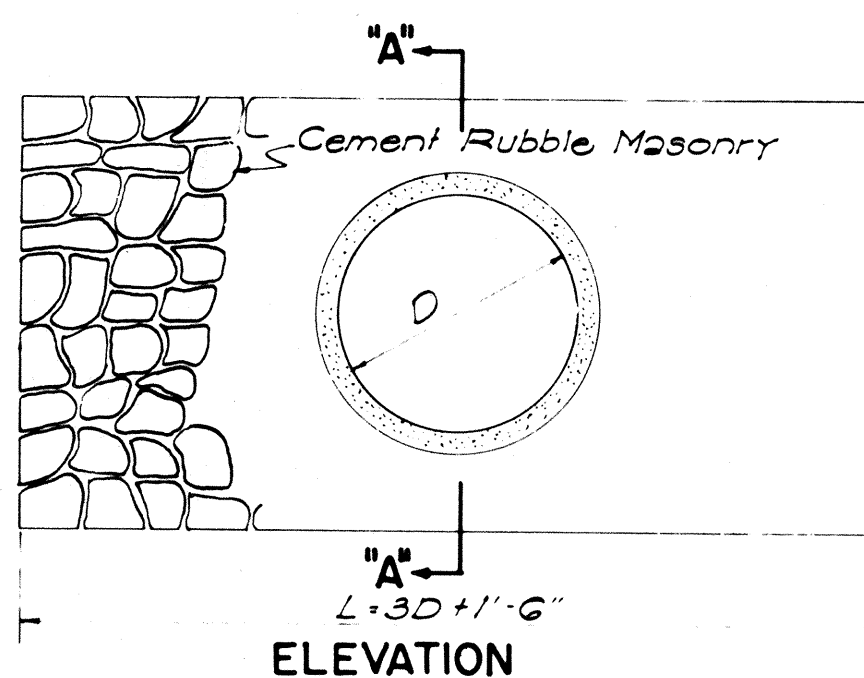


ELEVATION

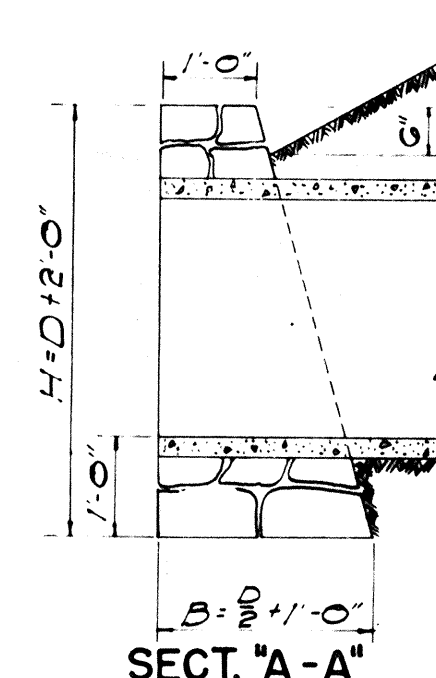

SECT. "A-A"

DETAIL OF MASONRY HEADWALL


Scale: 1/2" = 1'-0"

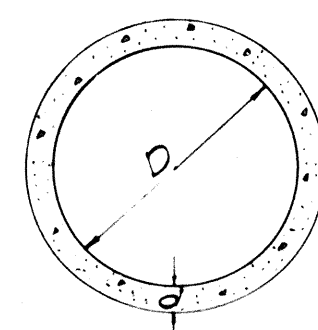

SECTION

CONC. PIPE CULVERT


NOTE:
Thickness of reinforcing and concrete used are to conform with the approved design as provided by the Specifications.

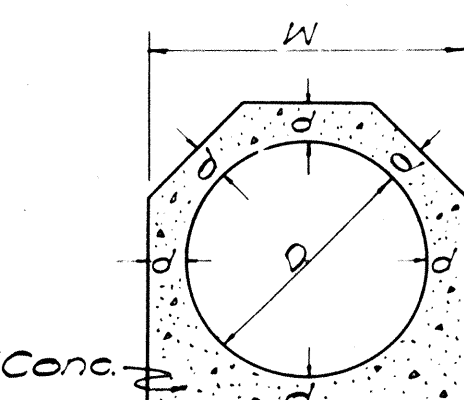


SECTION

CAST-IN-PLACE CONC. CULVERT

DATA-CAST-IN-PLACE CONC. CULVERT				
D	W	H	Cu Yds per ft	
18"	4'	2'-2"	0.11	
24"	4 1/2'	2'-0"	0.14	
30"	5'	3'-4"	0.19	
36"	5 1/2'	3'-11"	0.26	

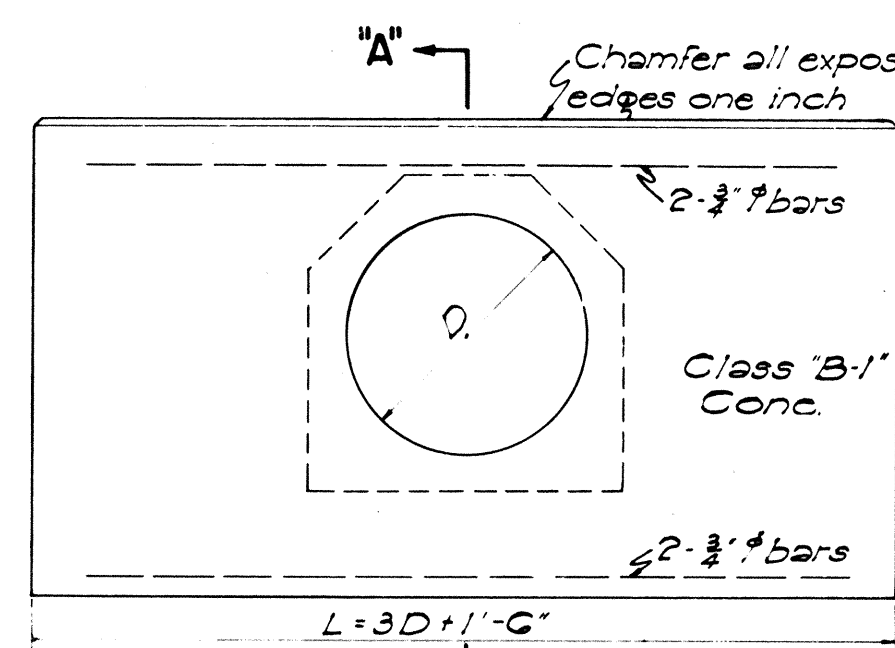

ELEVATION

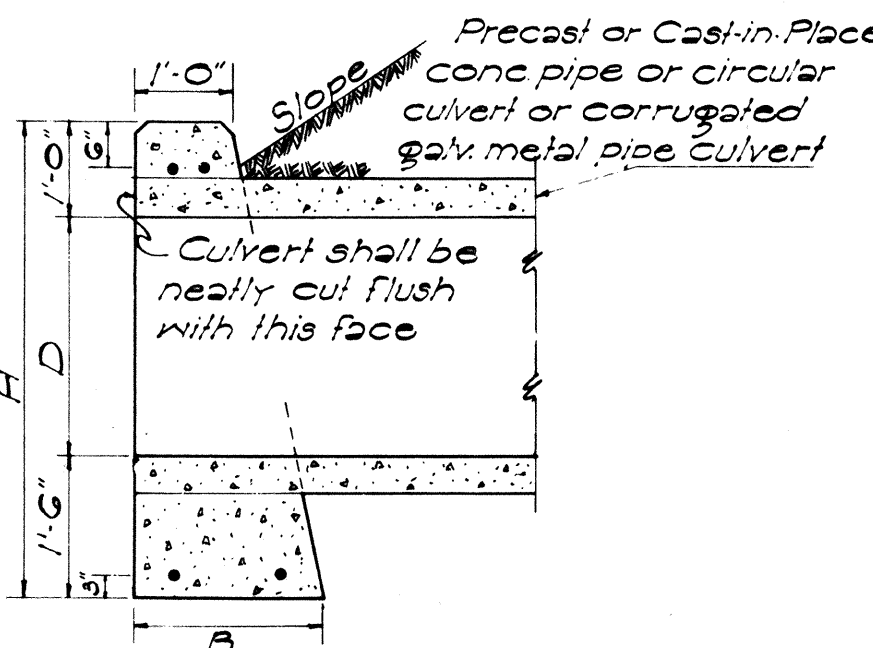


SECTION "A-A"

DATA FOR CONC. HEADWALL					Cast-in-Place Conc. Culvert	Conc. Pipe Culvert	Steel For One Headwall
D	B	L	H		Cu Yds	Cu Yds	No of Bars Size Length Lbs.
18"	1'-6"	6'-0"	4'-0"		0.92	1.00	4 3/4" 5'-6" 33
24"	1'-6"	7'-6"	4'-6"		1.25	1.38	4 3/4" 7'-0" 42
30"	2'-0"	9'-0"	5'-0"		1.95	2.17	4 3/4" 8'-6" 51
36"	2'-0"	10'-6"	5'-6"		2.45	2.74	4 3/4" 10'-0" 60
42"	2'-6"	12'-0"	6'-0"		3.87	4.26	4 3/4" 11'-6" 69
48"	2'-6"	13'-6"	6'-6"		4.66	5.11	4 3/4" 13'-0" 78

DETAIL OF CONCRETE HEADWALL

Scale: 1/2" = 1'-0"

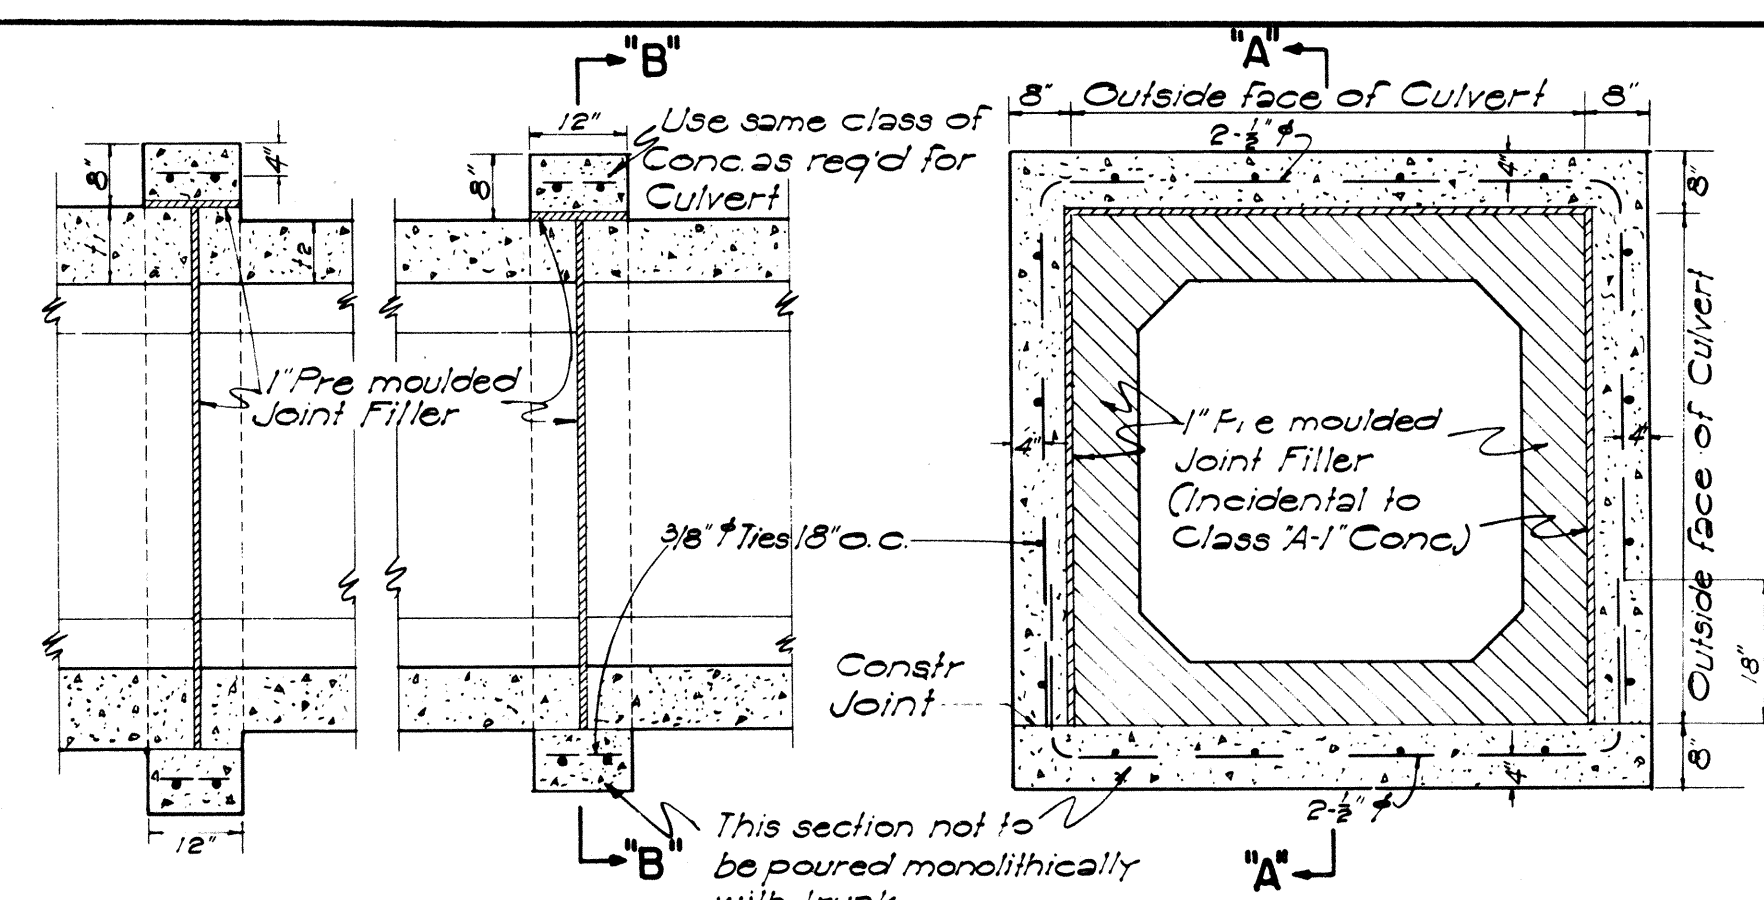

SECTION "A-A"


CONC. COLLAR FOR CONC. BOX CULVERT

Scale: 1/2" = 1'-0"

SECTION "B-B"

REINFORCING BARS

All reinforcing bars for concrete shall be Billet Steel bars, ASTM A15, intermediate grade. Steel shall be made by the open-hearth process. All bars shall be deformed type conforming to ASTM A-305.

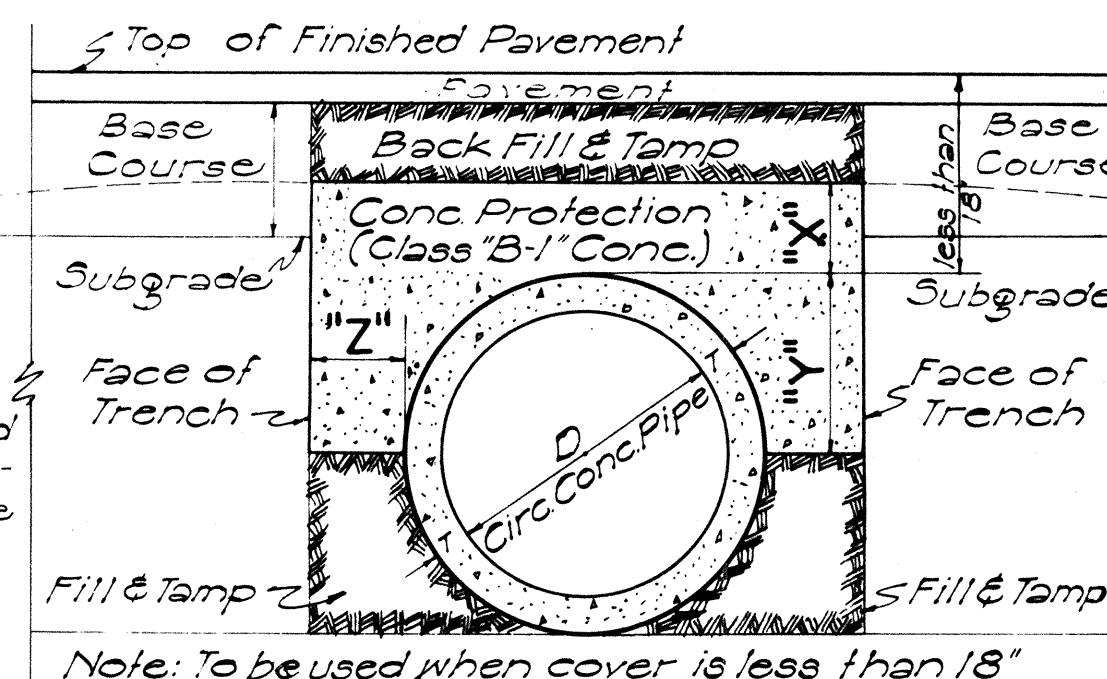

Note: To be used when cover is less than 18"

DATA FOR CONCRETE PROTECTION OVER CULVERTS		
X	Y	Z
6" for 18"D		Z must be from pipe to face of trench
7" " 24"D		
8" " 30"D		
9" " 36"D		
10" " 42"D		
11" " 48"D		
12" " 54"D		


SECT. OF CULVERT WITH CONC. PROTECTION

Scale: 1" = 1'-0"

DATA-CONC. DROP INTAKE					Where Variables Equal
D	D	L=D+G	S	Cu Yds	
23"	18"	2'-5"	8"	1.41	4'-6"
30"	24"	3'-0"	8"	1.72	5'-0"
37"	30"	3'-7"	8"	2.32	5'-6"
44"	36"	4'-2"	8"	2.73	6'-0"
51"	42"	4'-9"	10"	3.54	6'-6"
58"	48"	5'-4"	10"	4.01	7'-0"

Note: Dimension "X" is assumed as 2'-4" in figuring the above quantities

Note: This type of structure shall also be used for the Drop Intakes of Siphons connected with Irrigation Ditches or Flumes with appropriate changes to dimensions. In this case all joints must be made water tight.

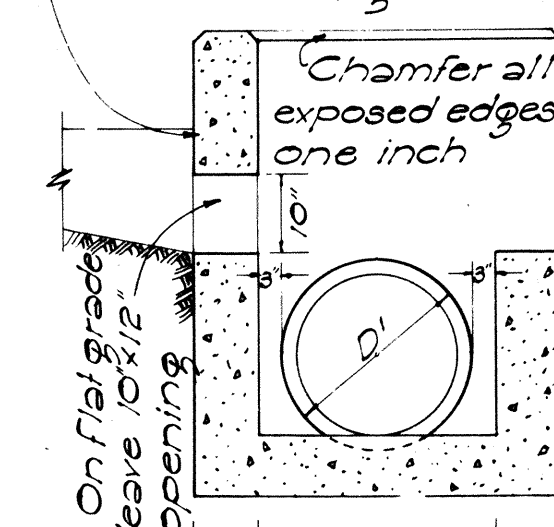


SECTION "B-B"

Where drainage comes from both sides lower this wall to same elevation as shown for opposite wall.

Excavate recess in roadway excavation slope for inlet to dimensions and form designated by Engineer. This is 'Unclassified' Excavation.

Top limits of structure excavation other than at bridges.

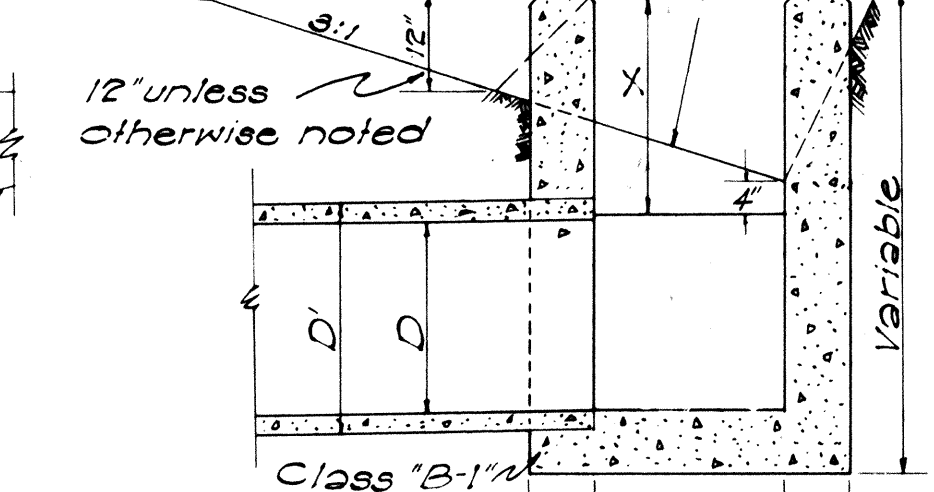

SECTION "A-A"

DETAIL OF CONCRETE DROP INTAKE

Scale: 1/2" = 1'-0"

STATE OF HAWAII
DEPARTMENT OF TRANSPORTATION
HIGHWAYS DIVISION

STANDARD DETAILS
DROP INTAKES, RETAINING WALLS,
HEADWALLS, CONSTRUCTION JOINTS


SCALES AS NOTED

SHEET No 32 OF 73 SHEETS






FED. ROAD DIST. NO.	STATE	FED. AID PROJ. NO.	FISCAL YEAR	SHEET NO.	TOTAL SHEETS
HAWAII	HAW.	HI-1(32)	1966	33	73

UNIT 1

Revised: Jan. 24, 1967

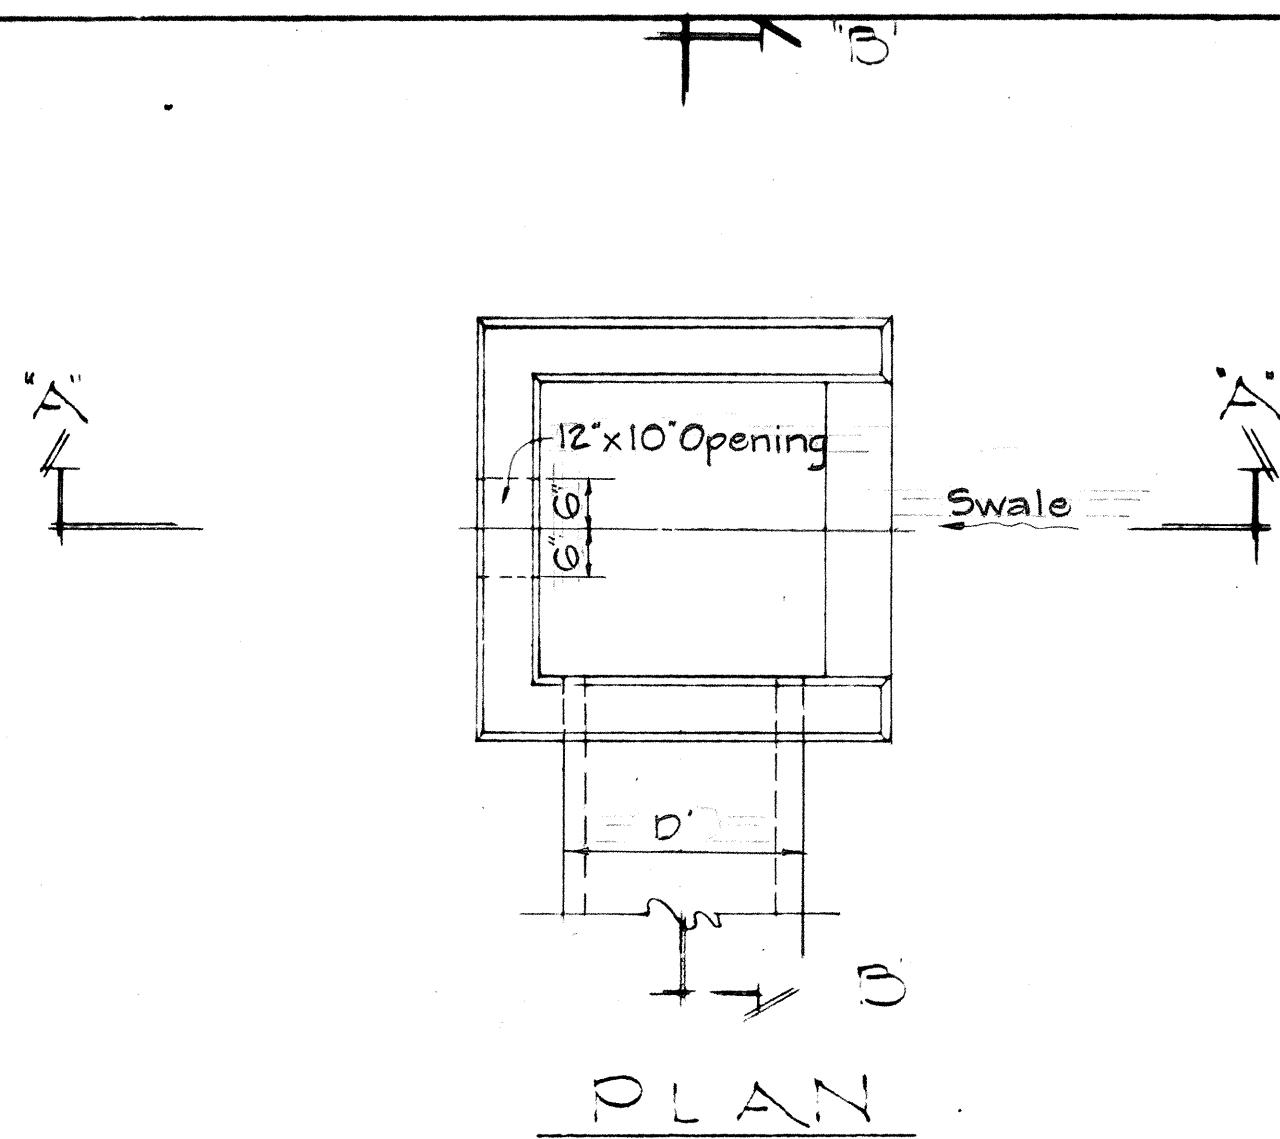


NOTE: 12'x10' opening not required when C.D.I. is located at termination of swale.

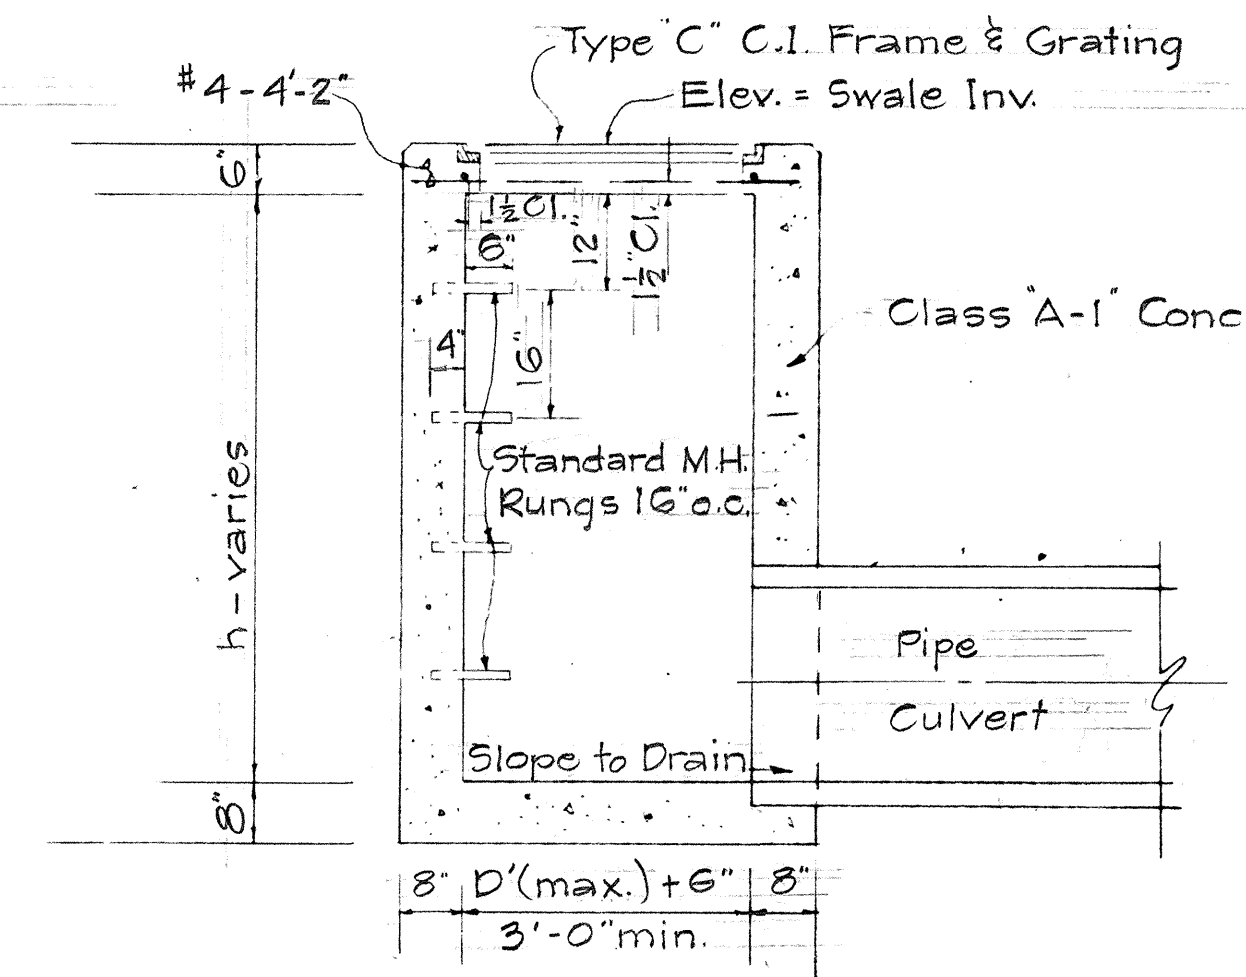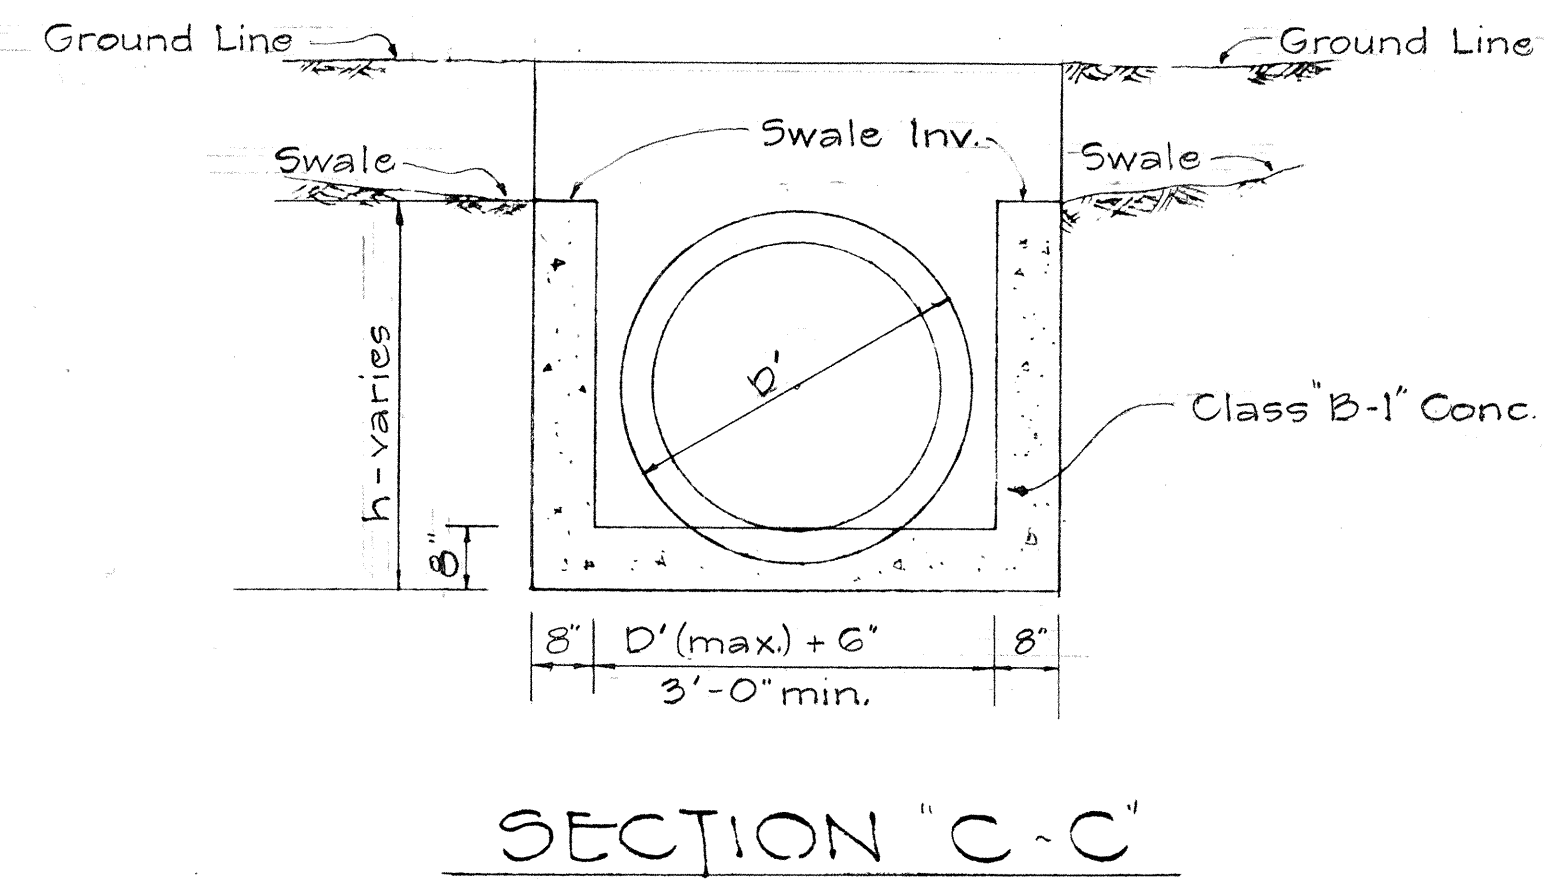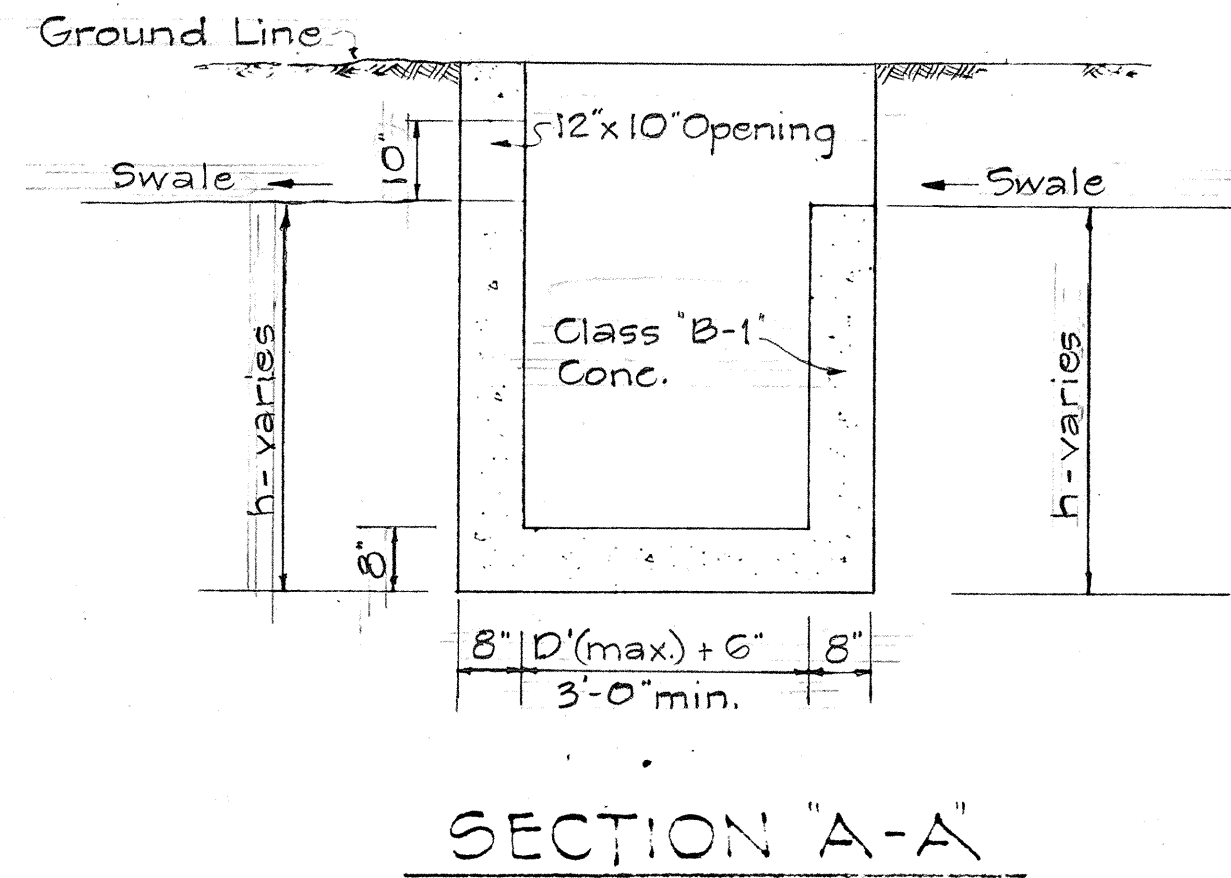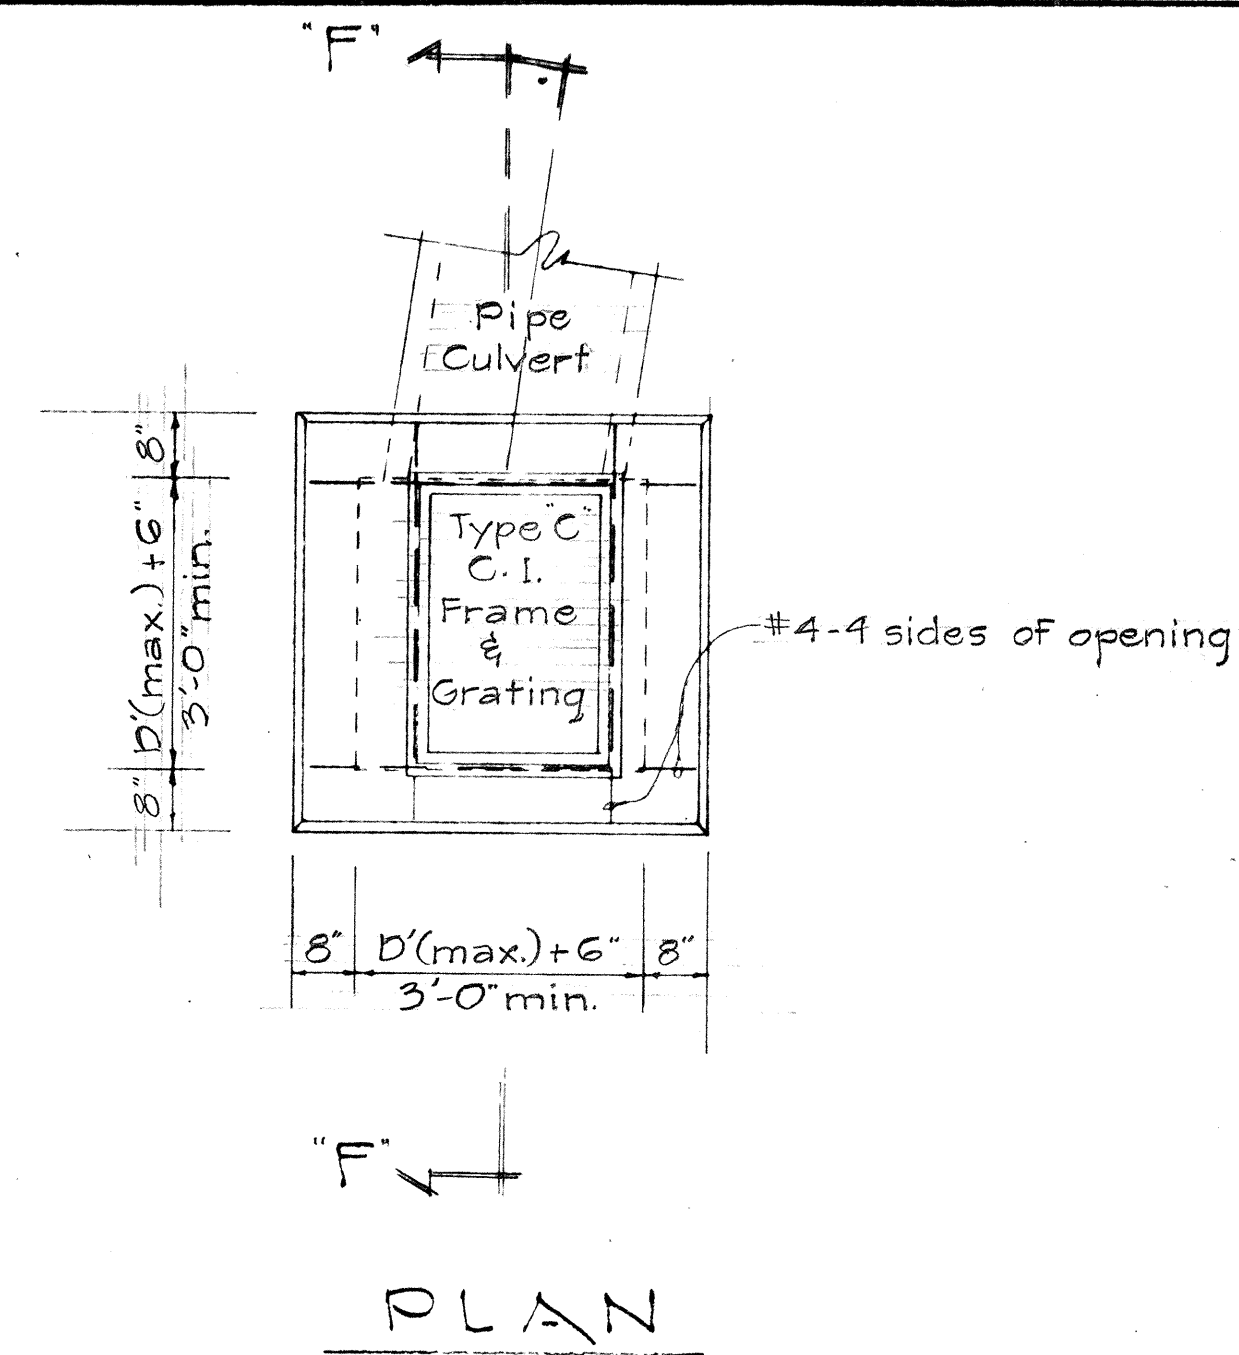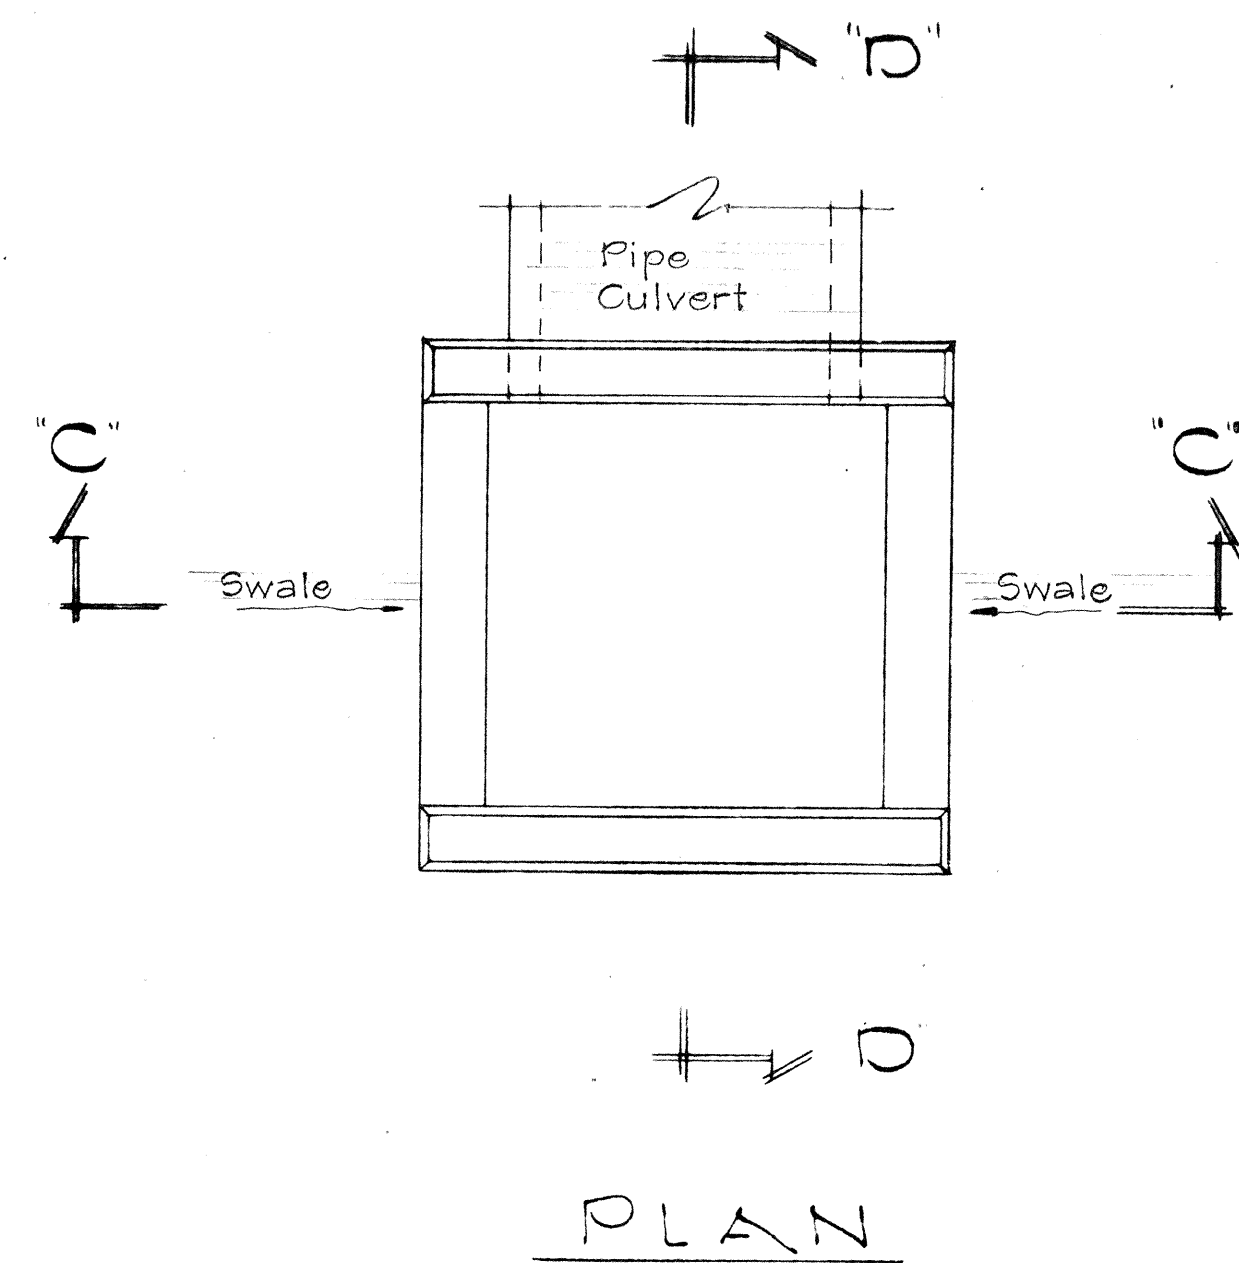


TYPE "C" GRATED
CONCRETE DROP INTAKE
SCALE: 1/2" = 1'-0"

NOTES:

- See Plans for alignment & inverts of all culverts, ditches and swales entering C.D.I.
- Exposed edges above the ground line of Concrete Drop Intakes shall be chamfered one (1) inch.
- Swales and Ditches shall have a ten (10) feet transition into C.D.I.
- Standard Manhole Rungs @ 16" o.c. shall be provided for structures having "h" greater than 3'-0" and shall be incidental to class A-1 or B-1 Concrete.
- Location of Standard Manhole Rungs to be determined by the Engineer.

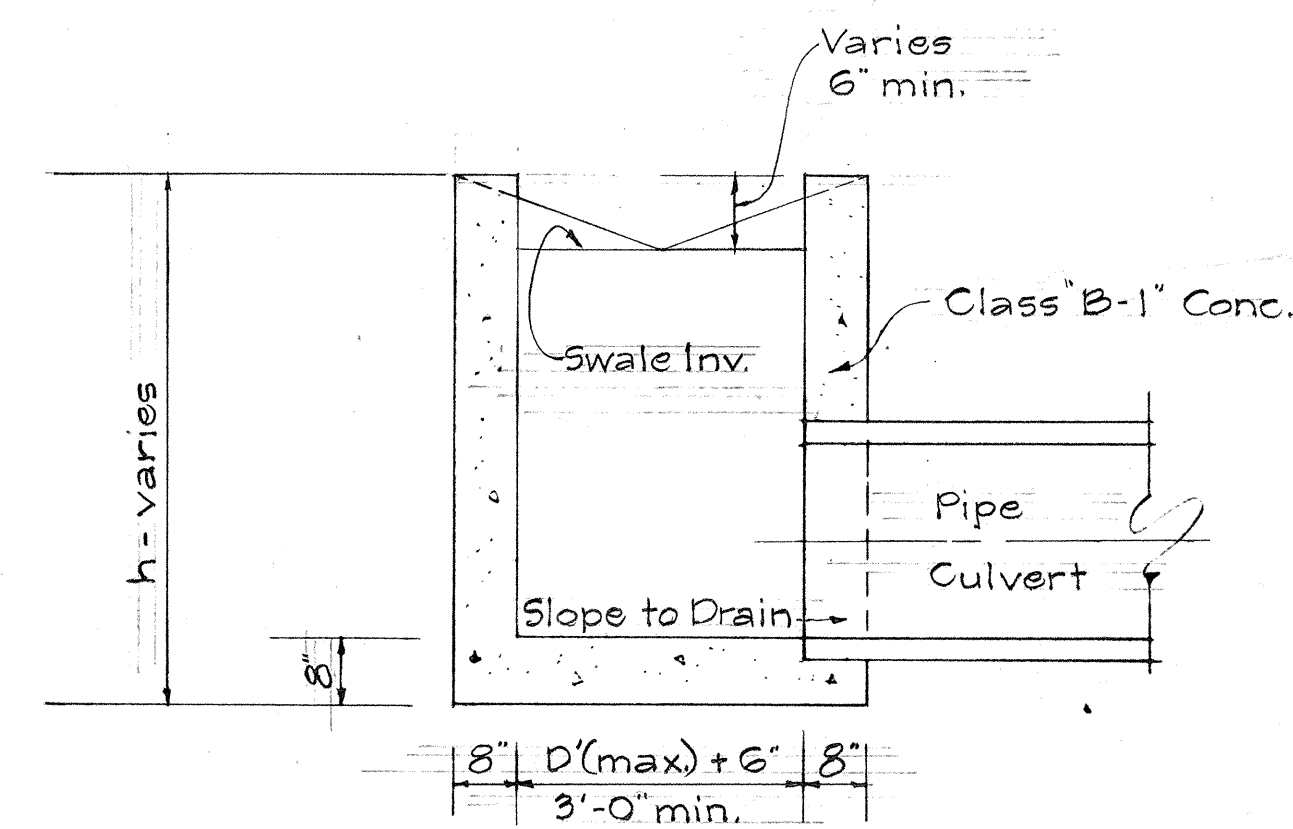

TYPE "A"
CONCRETE DROP INTAKE
SCALE: 1/2" = 1'-0"

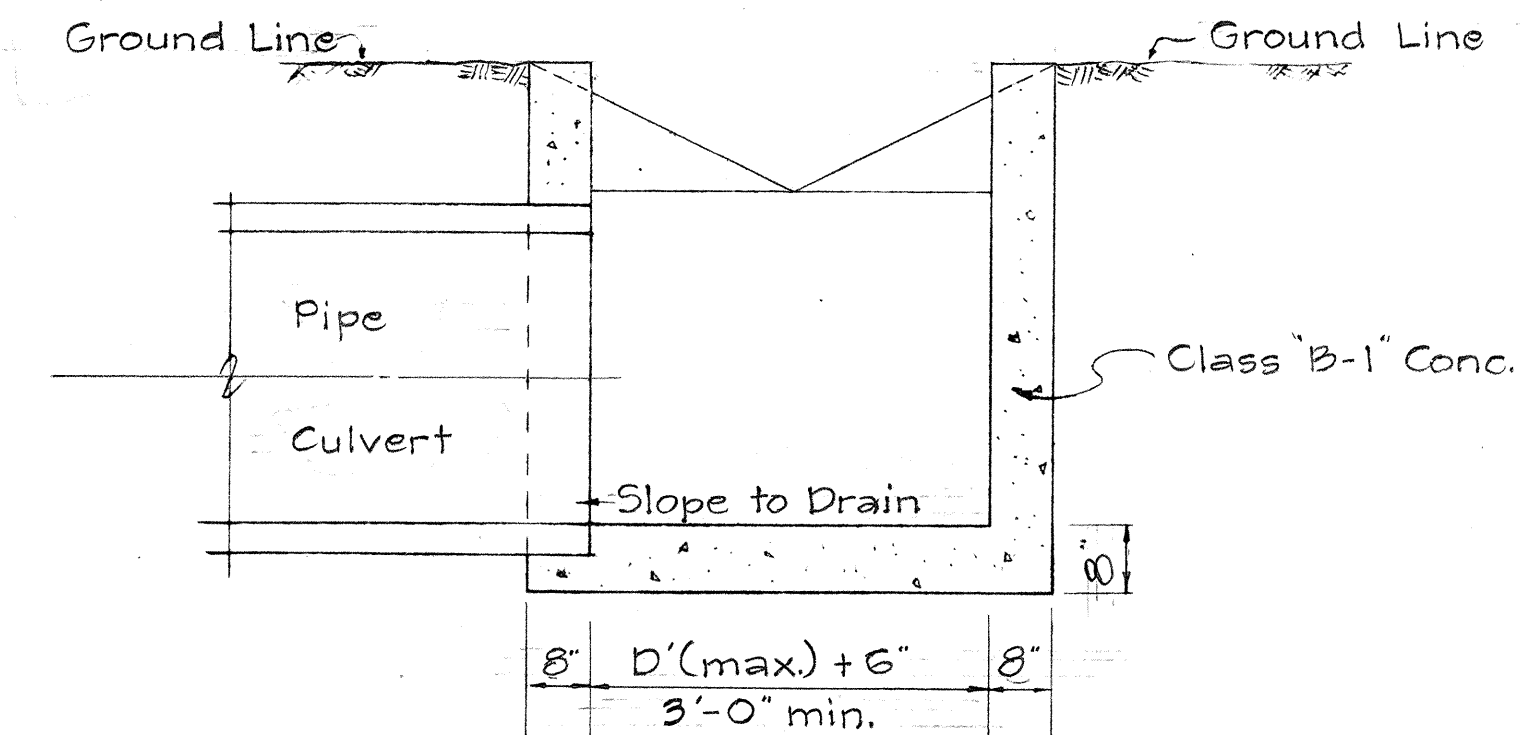

TYPE "B"
CONCRETE DROP INTAKE
SCALE: 1/2" = 1'-0"

THIS SHEET SUPERSEDES SHEET NO. 68

STATE OF HAWAII
DEPARTMENT OF TRANSPORTATION
HIGHWAYS DIVISION

DETAILS OF
CONCRETE DROP INTAKE TYPE "A", "B", & "C"

INTERSTATE ROUTE H-1
PROJ. No. I-HI-1(32): 5, UNIT 1







Scale: As Shown Date: Sept. 1966

SHEET No. 33 OF 73 SHEETS

C. O. 33

C. O. 68

FED. ROAD DIST. NO.	STATE	FED. AID PROJ. NO.	FISCAL YEAR	SHEET NO.	TOTAL SHEETS
HAWAII	HAW.	I-HI-1(32) 3 UNIT 1	1966	34	73

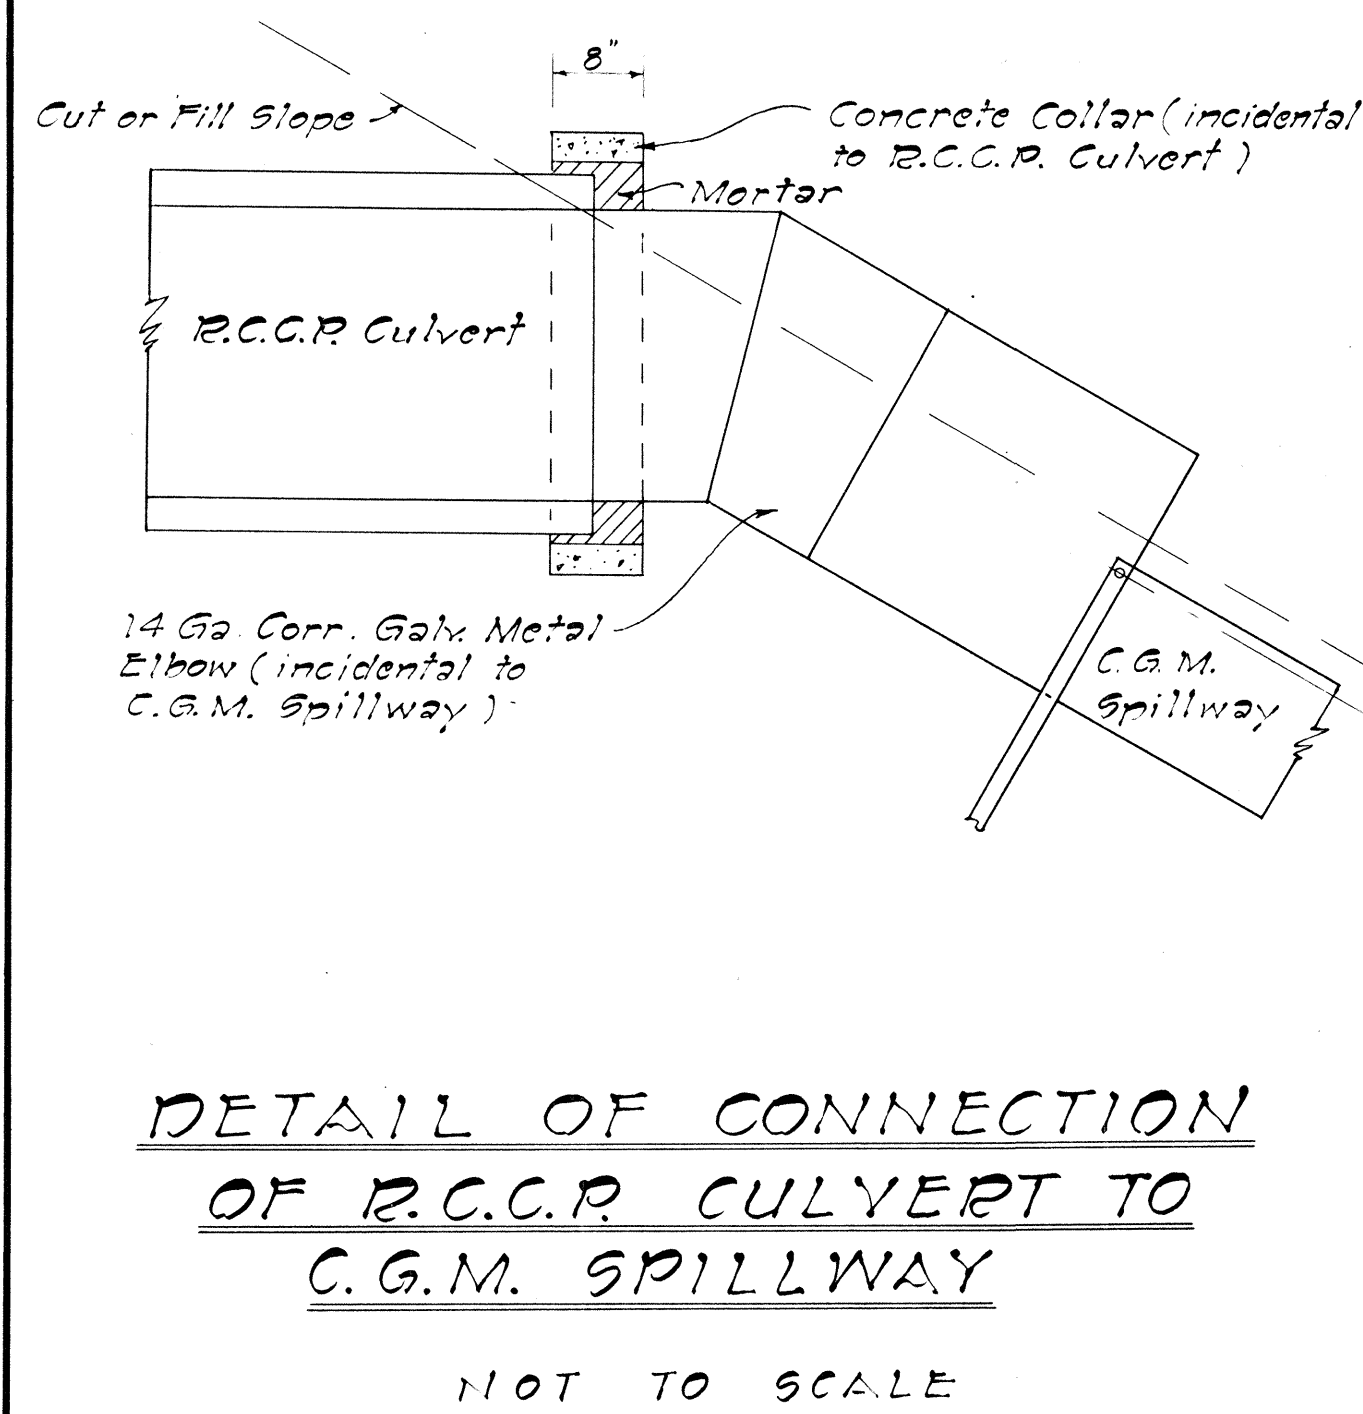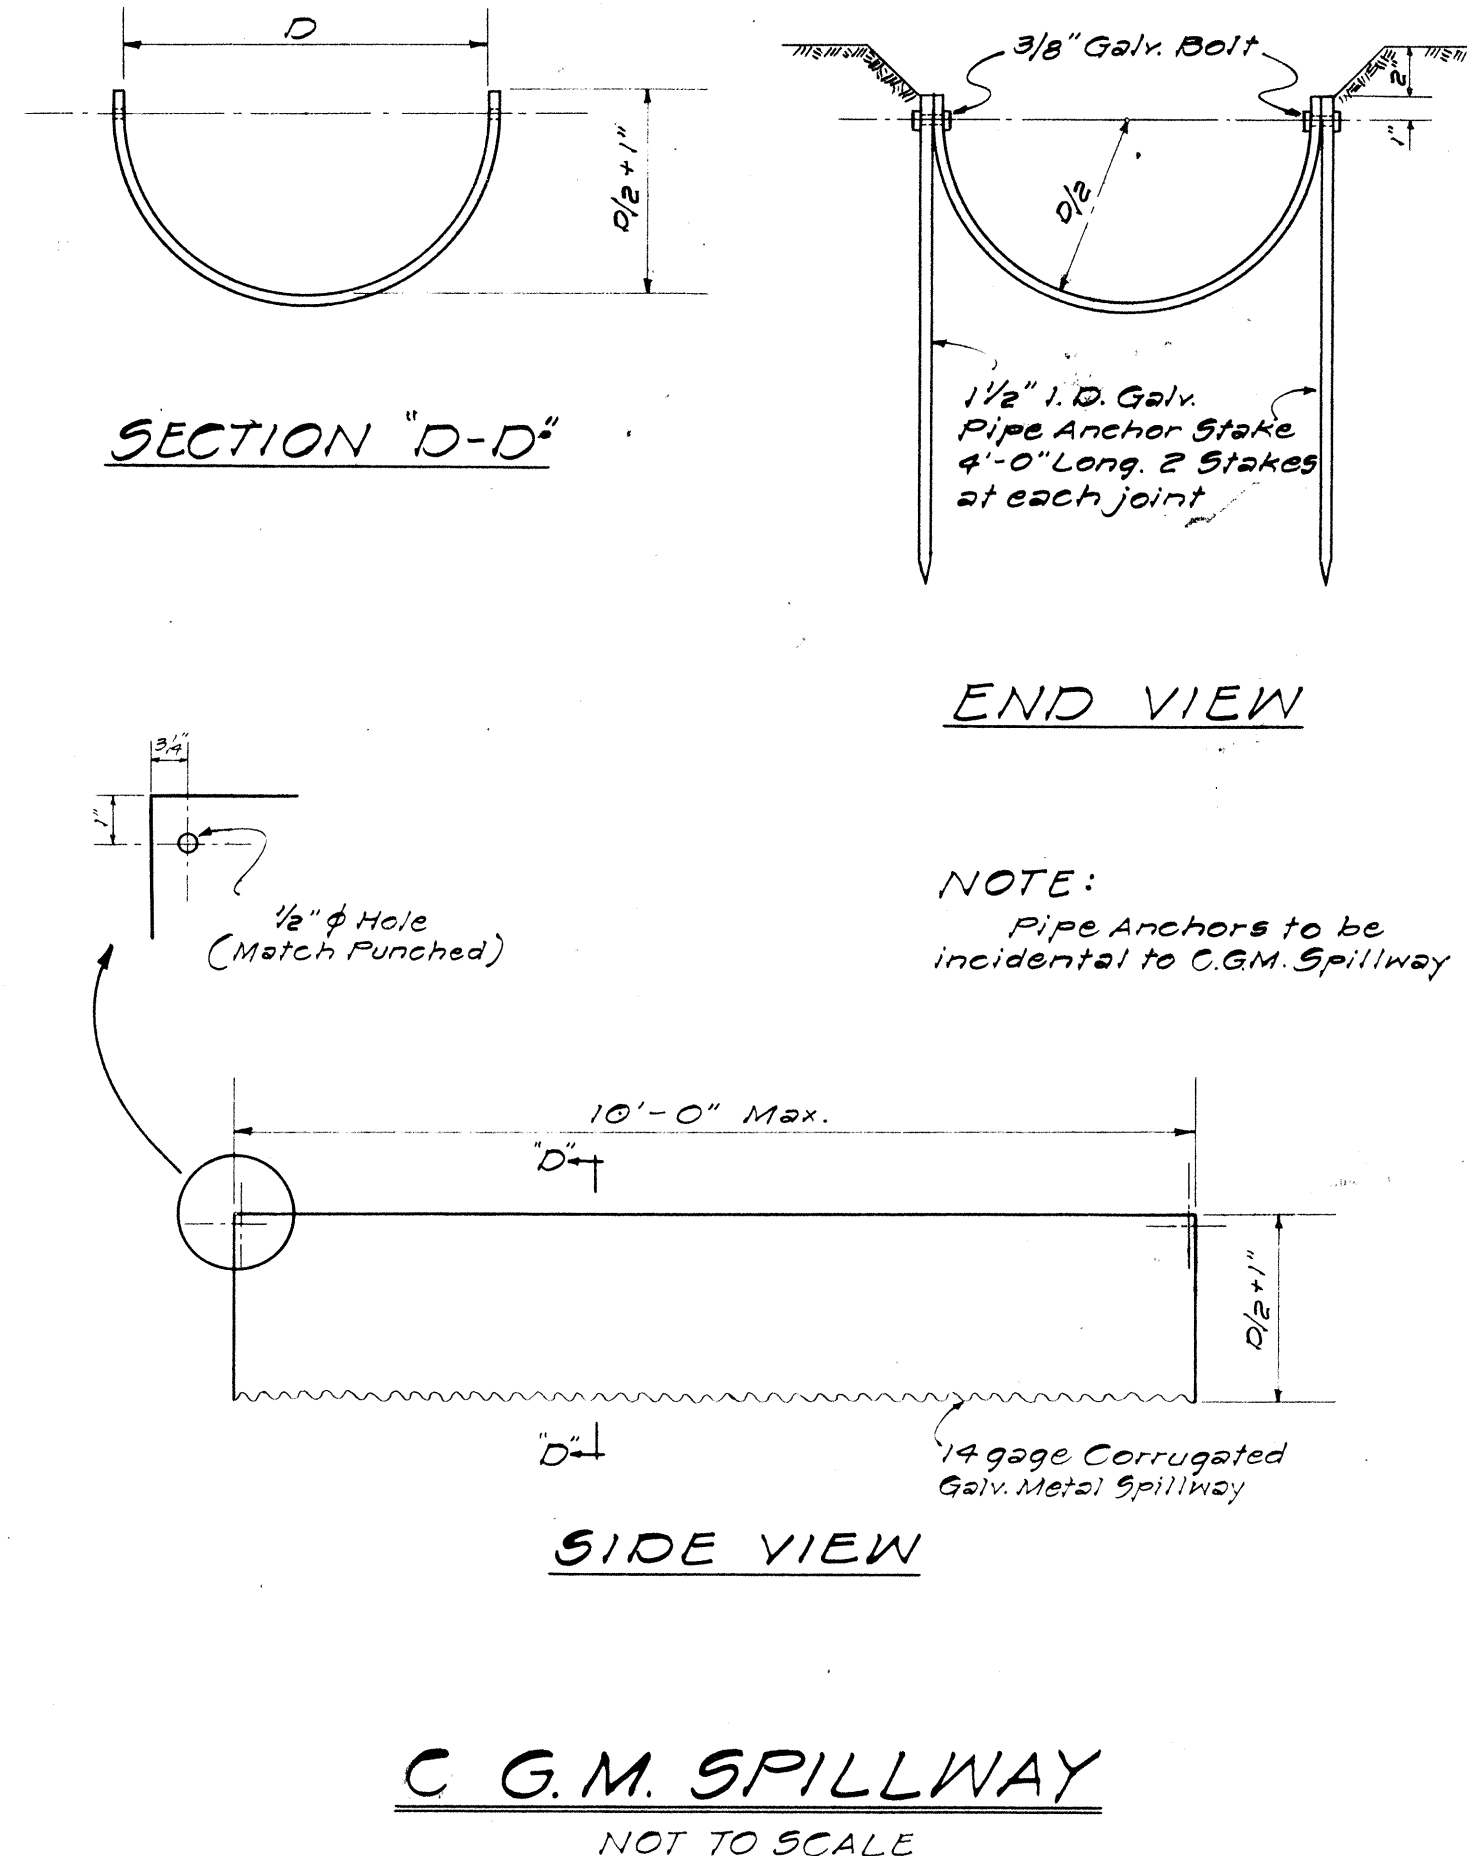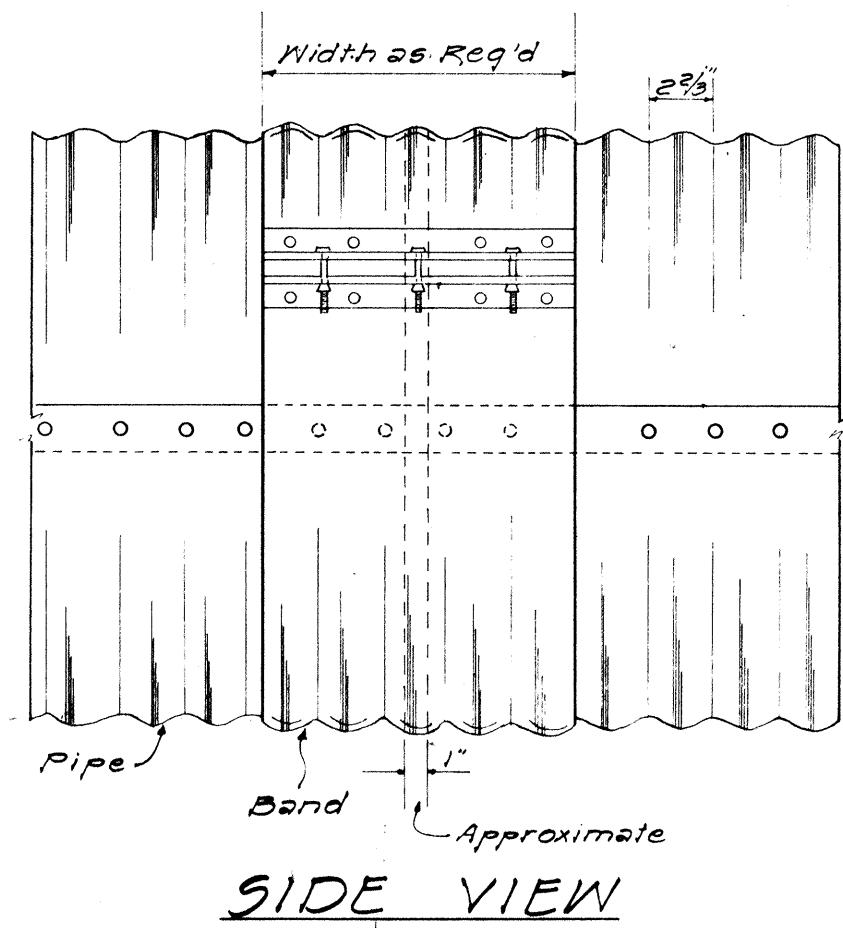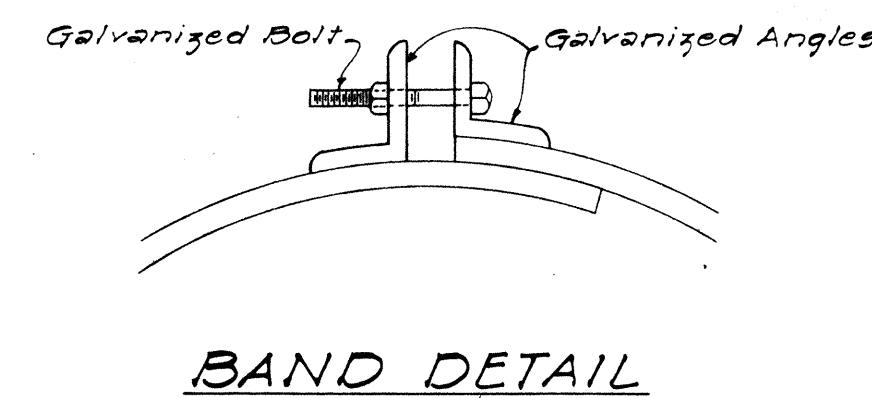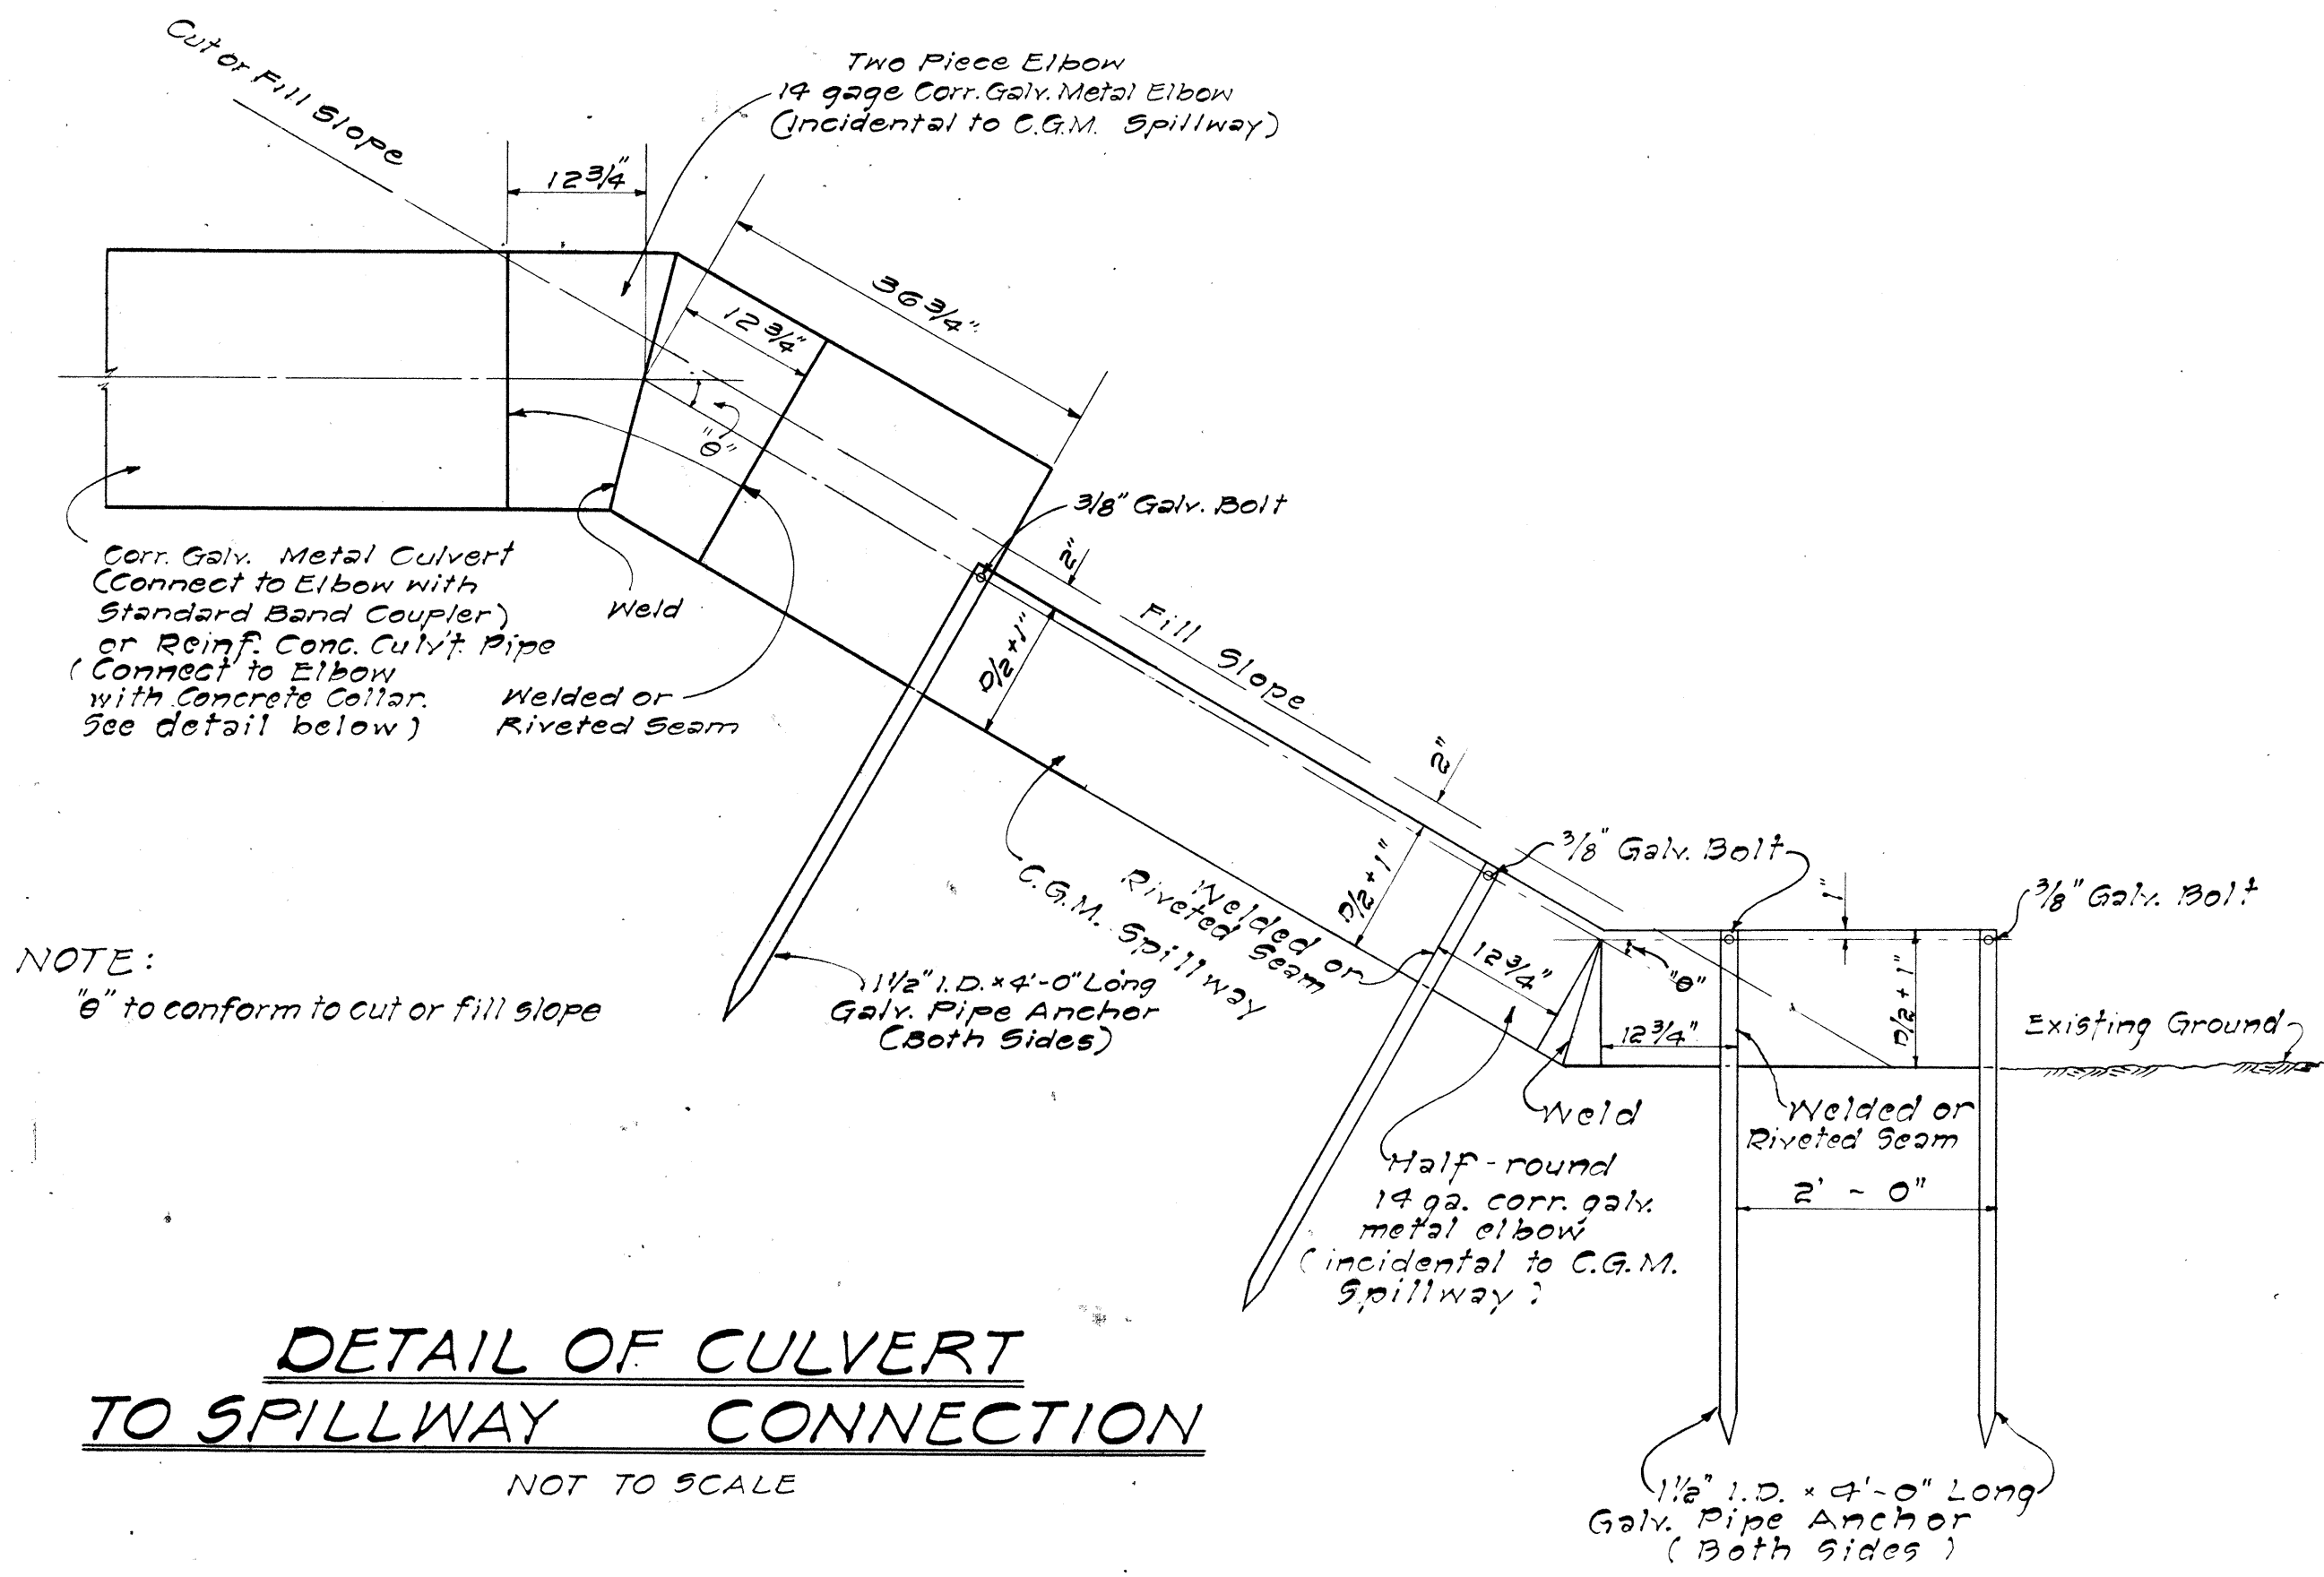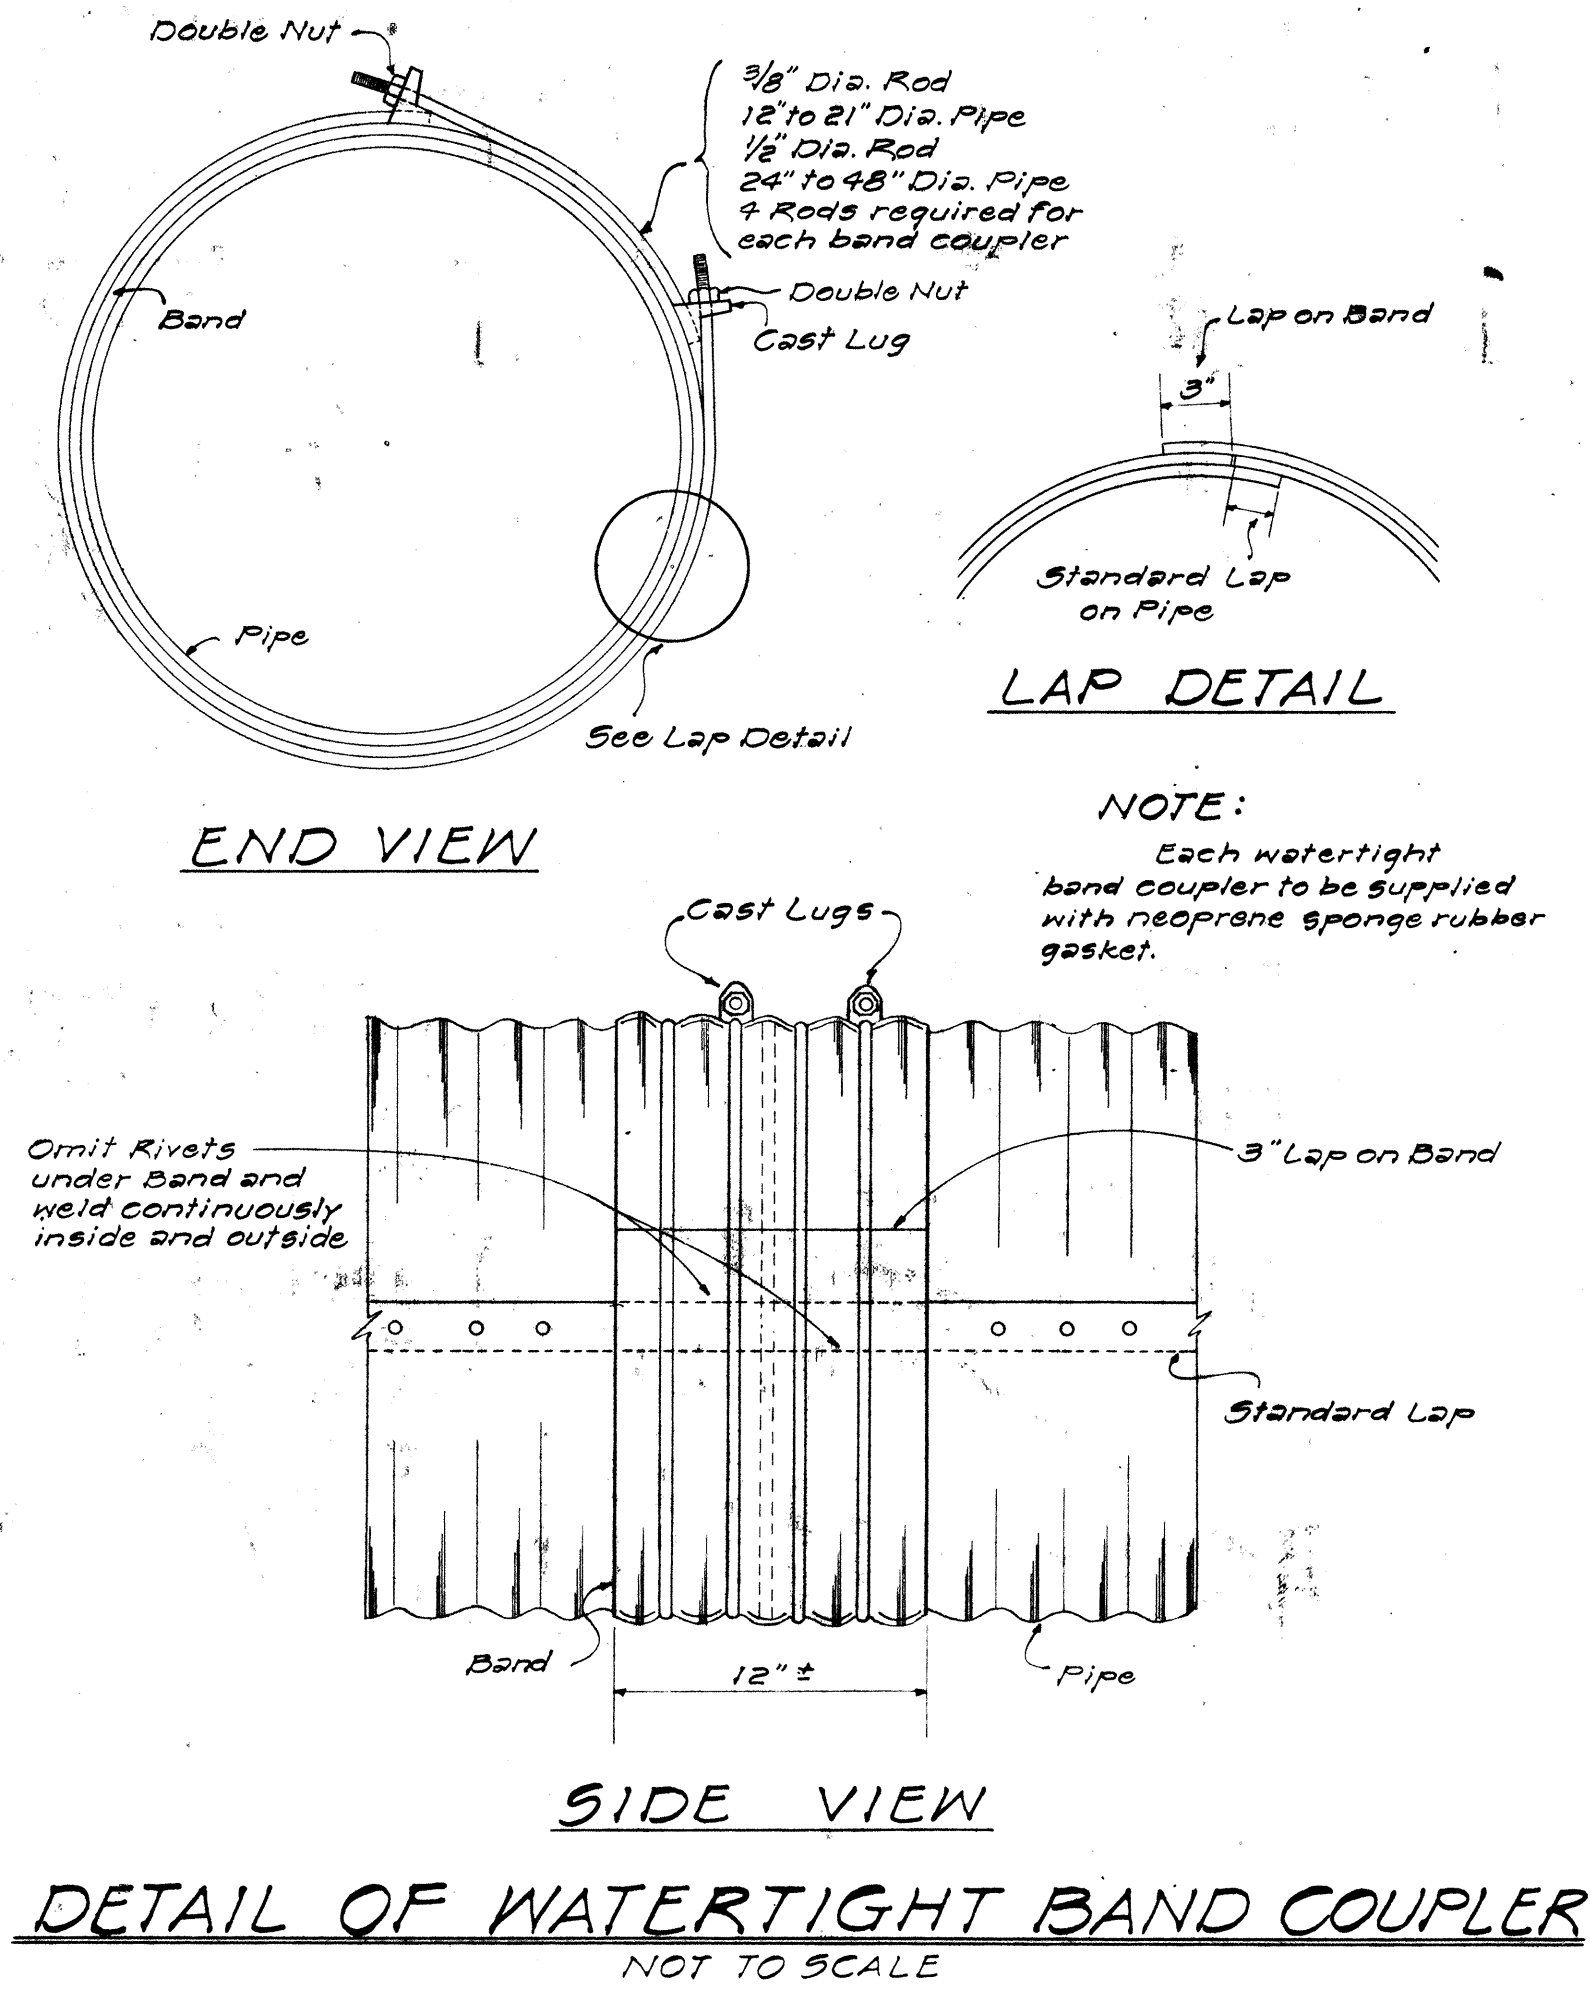

STATE OF HAWAII
DEPARTMENT OF TRANSPORTATION
HIGHWAYS DIVISION

DETAILS OF C.G.M.
COUPLERS, AND C.G.M. SPILLWAY
INTERSTATE ROUTE H-1
PROJ. No. I-HI-1(32) 3 UNIT 1
Scale: As Shown Date: Sept. 1966
SHEET No. D-10 OF 10 SHEETS

ORIGINAL PLAN	DATE
DESIGNED BY	5-24-66
TRACED BY	Y.
NOTE BOOK	Q.M.
QUANTITIES BY	
CHECKED BY	
No.	