

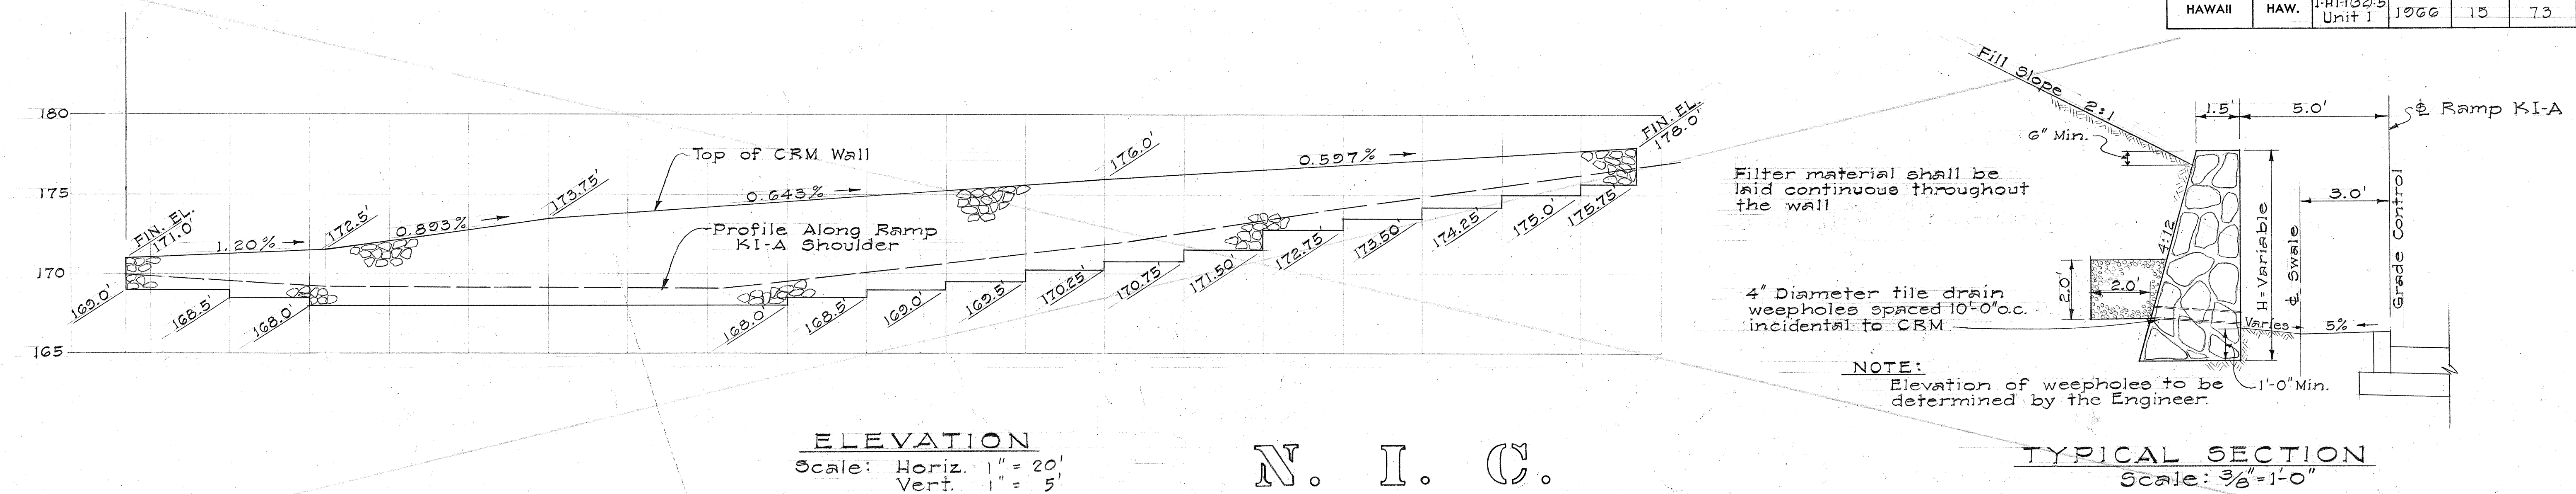
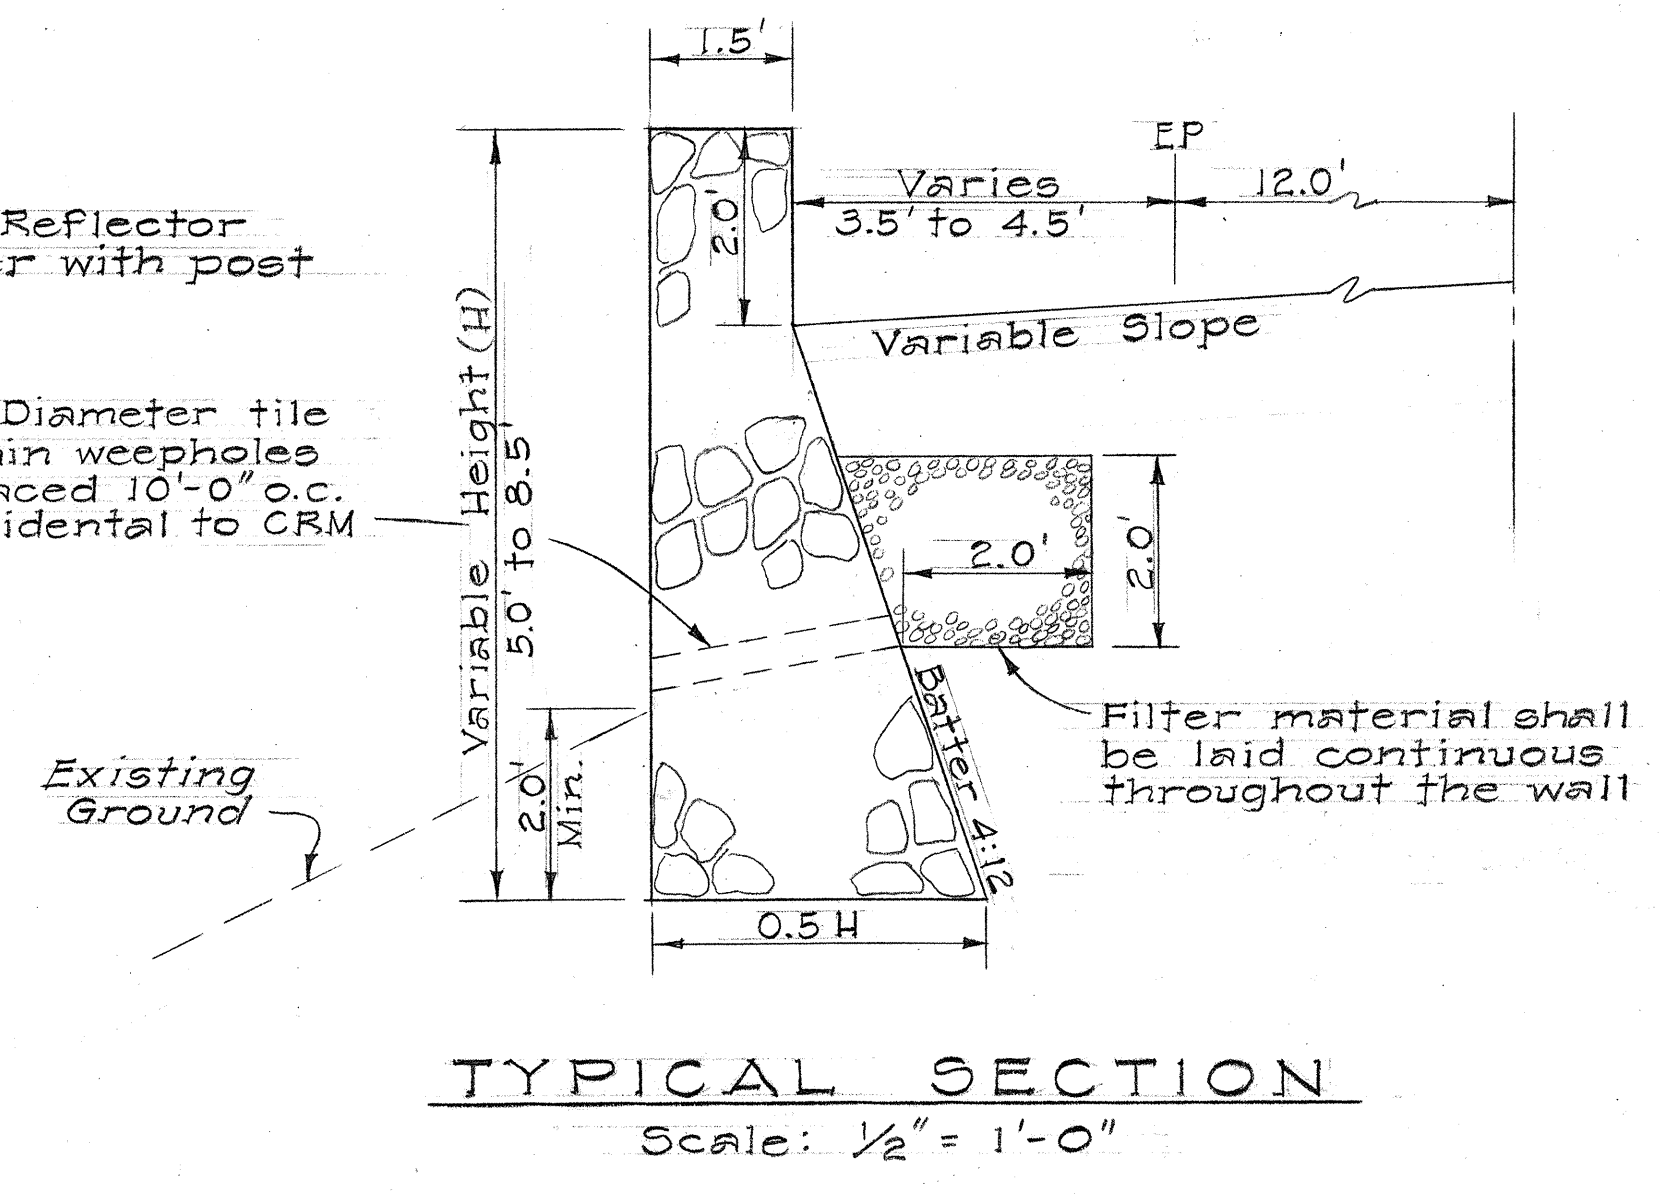
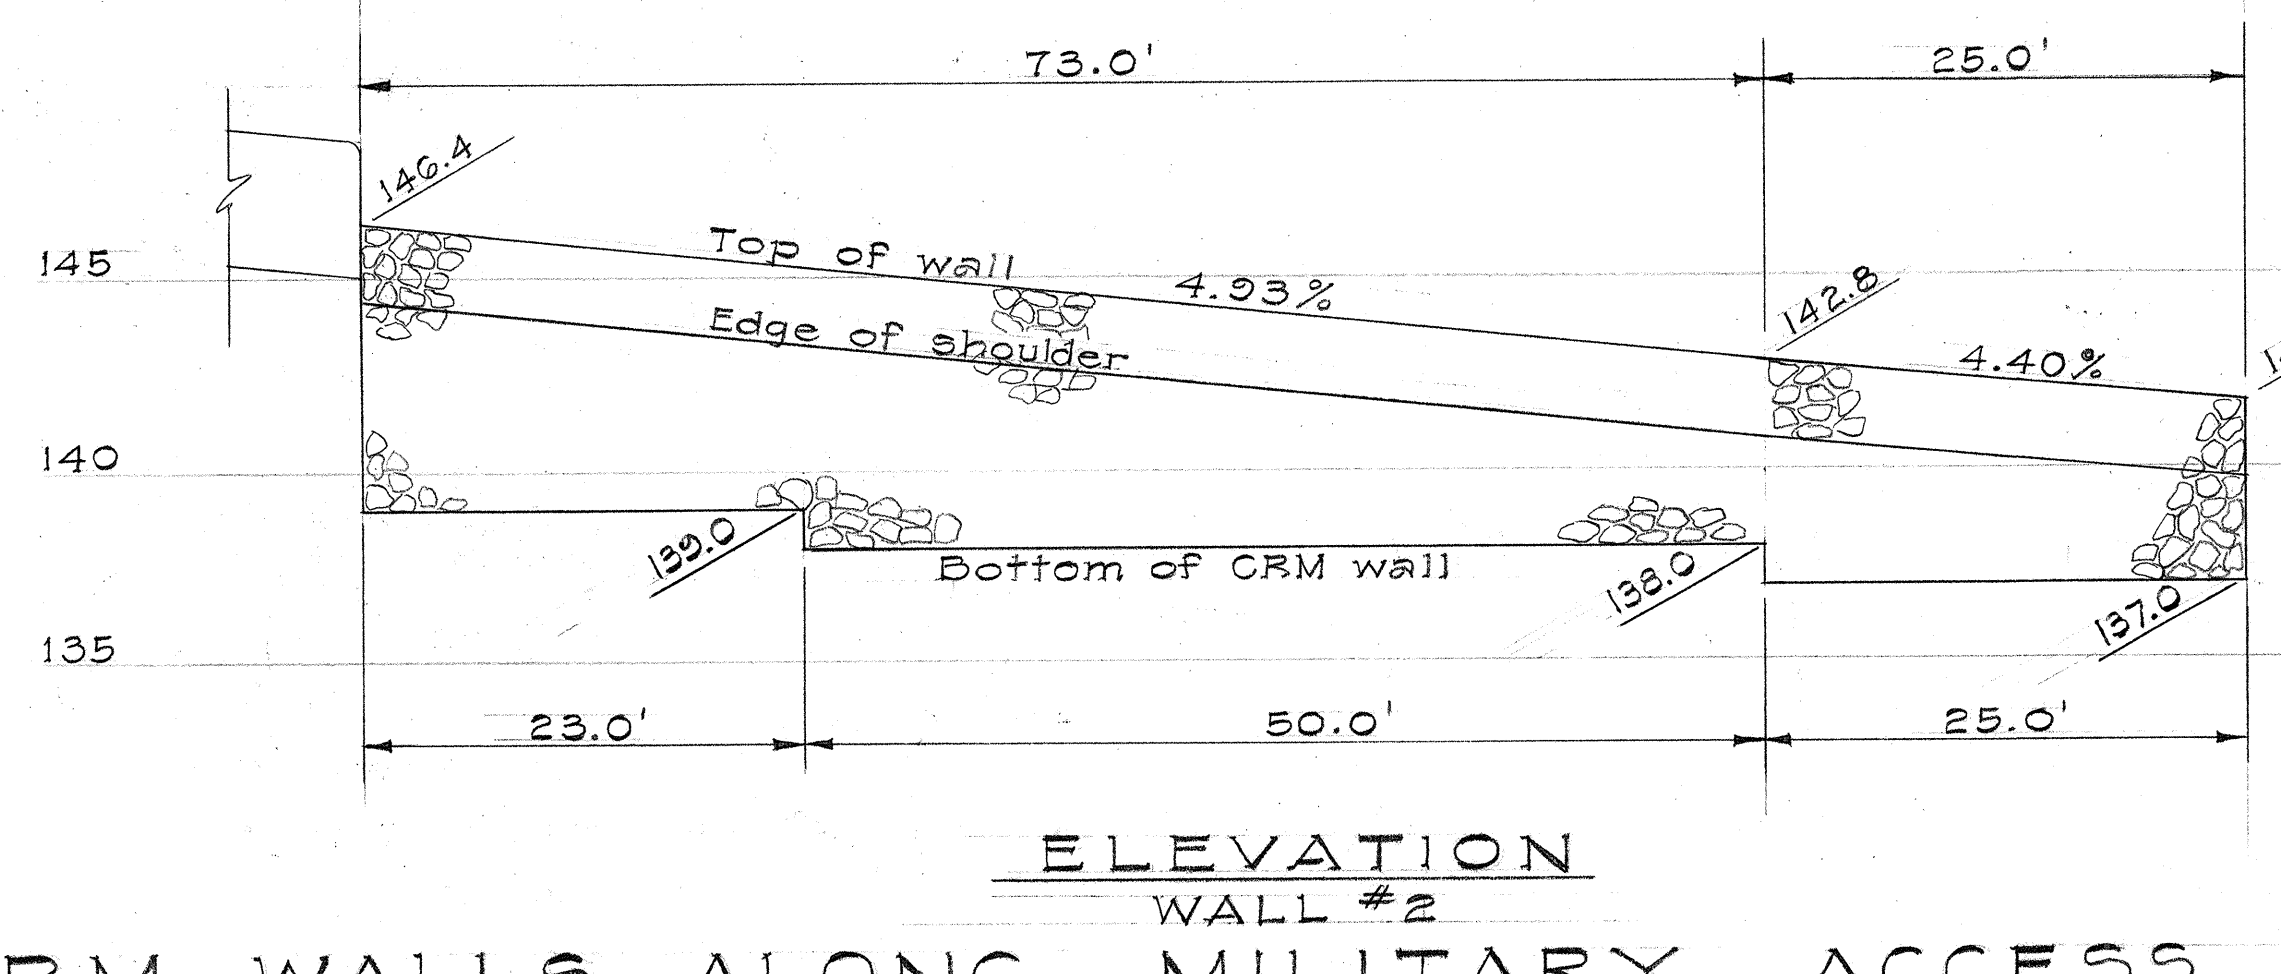
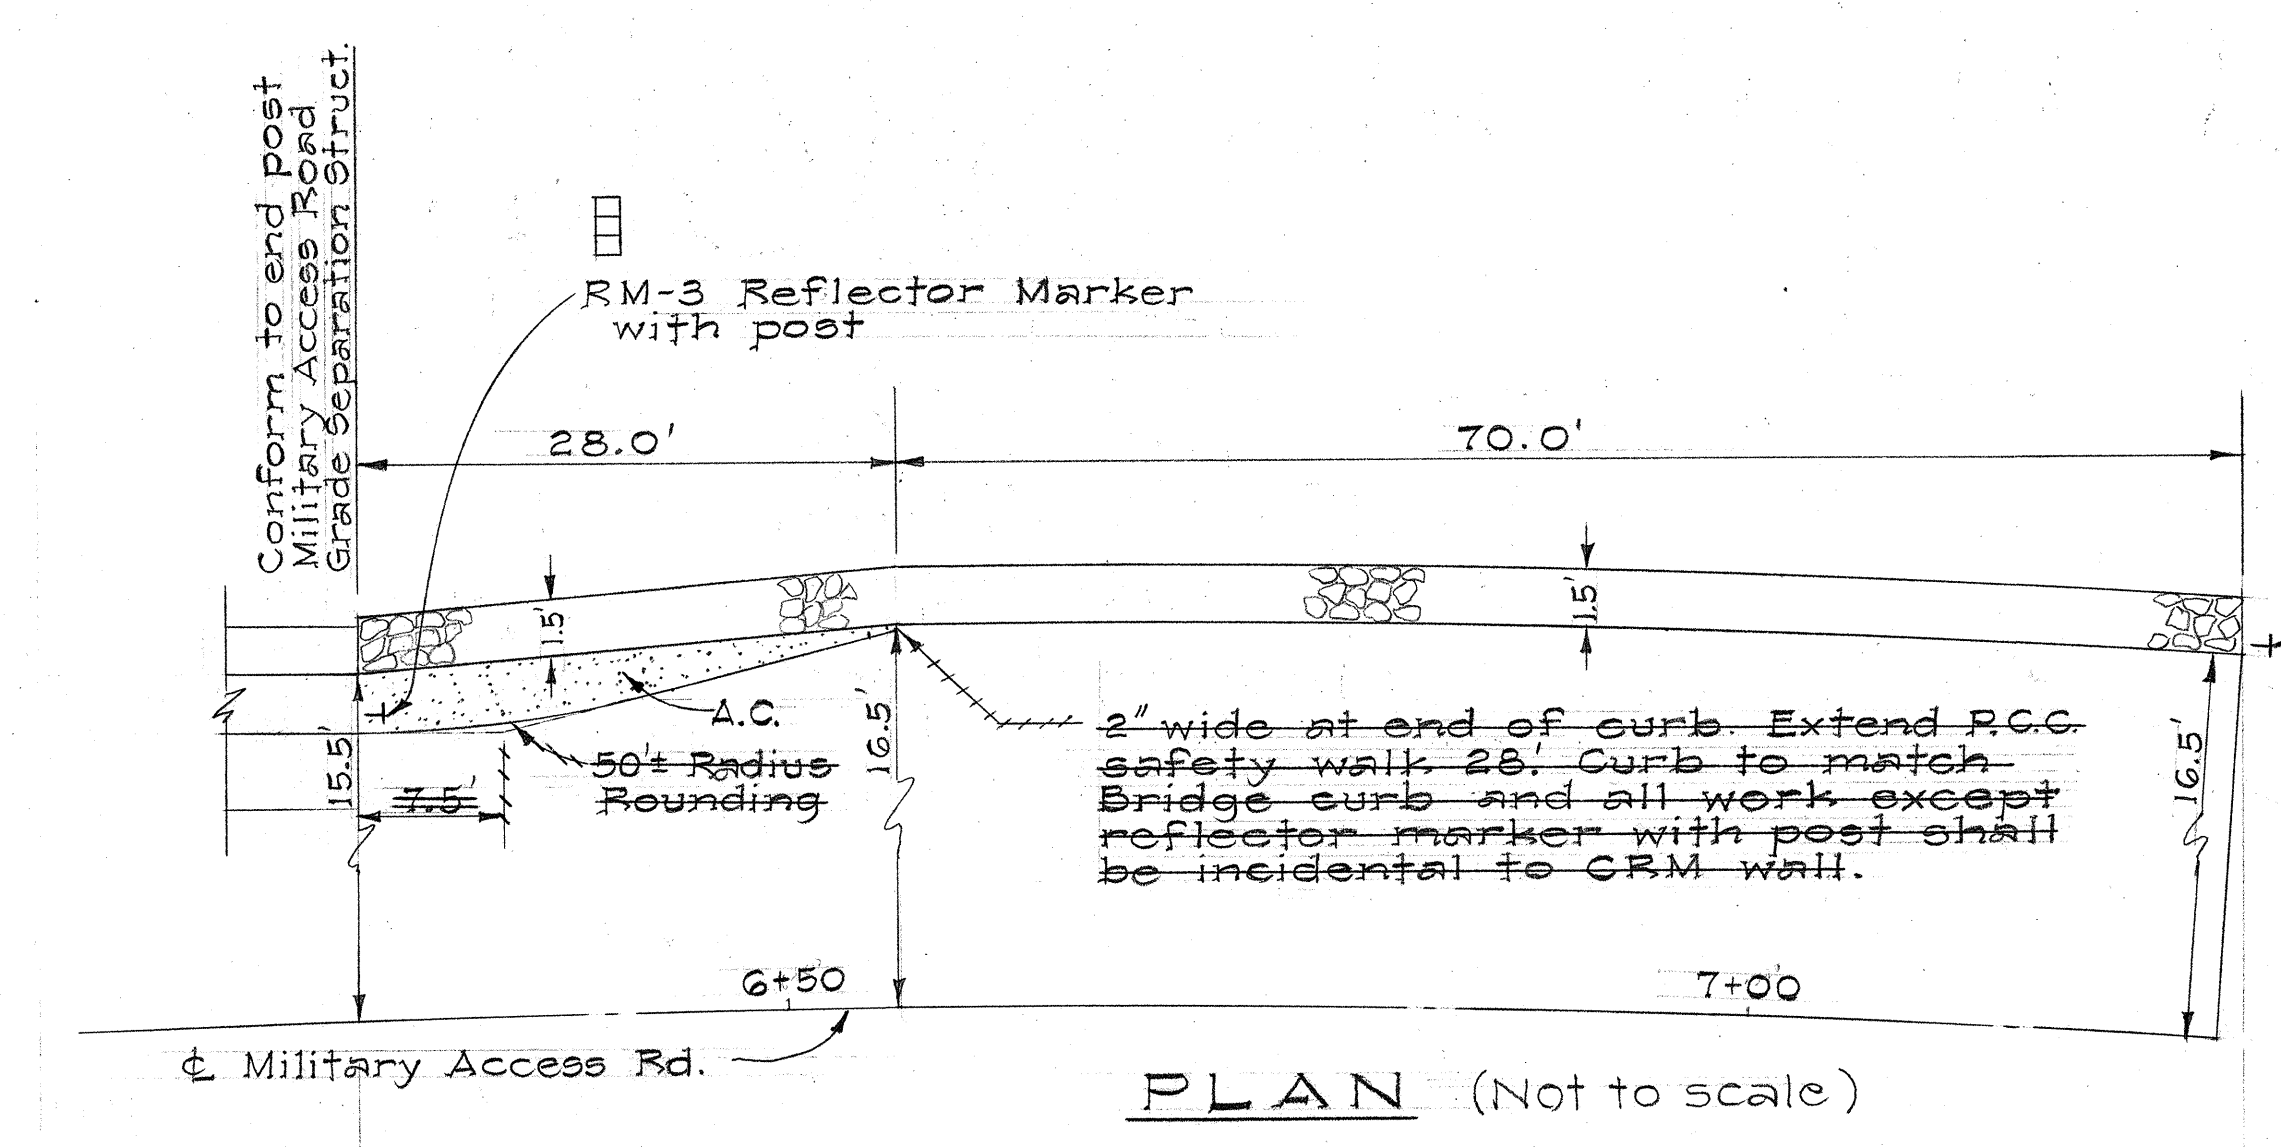


FED. ROAD DIST. NO.	STATE	FED. AID PROJ. NO.	FISCAL YEAR	SHEET NO.	TOTAL SHEETS
HAWAII	HAW.	I-HI-1(32):5 Unit 1	1966	15	73

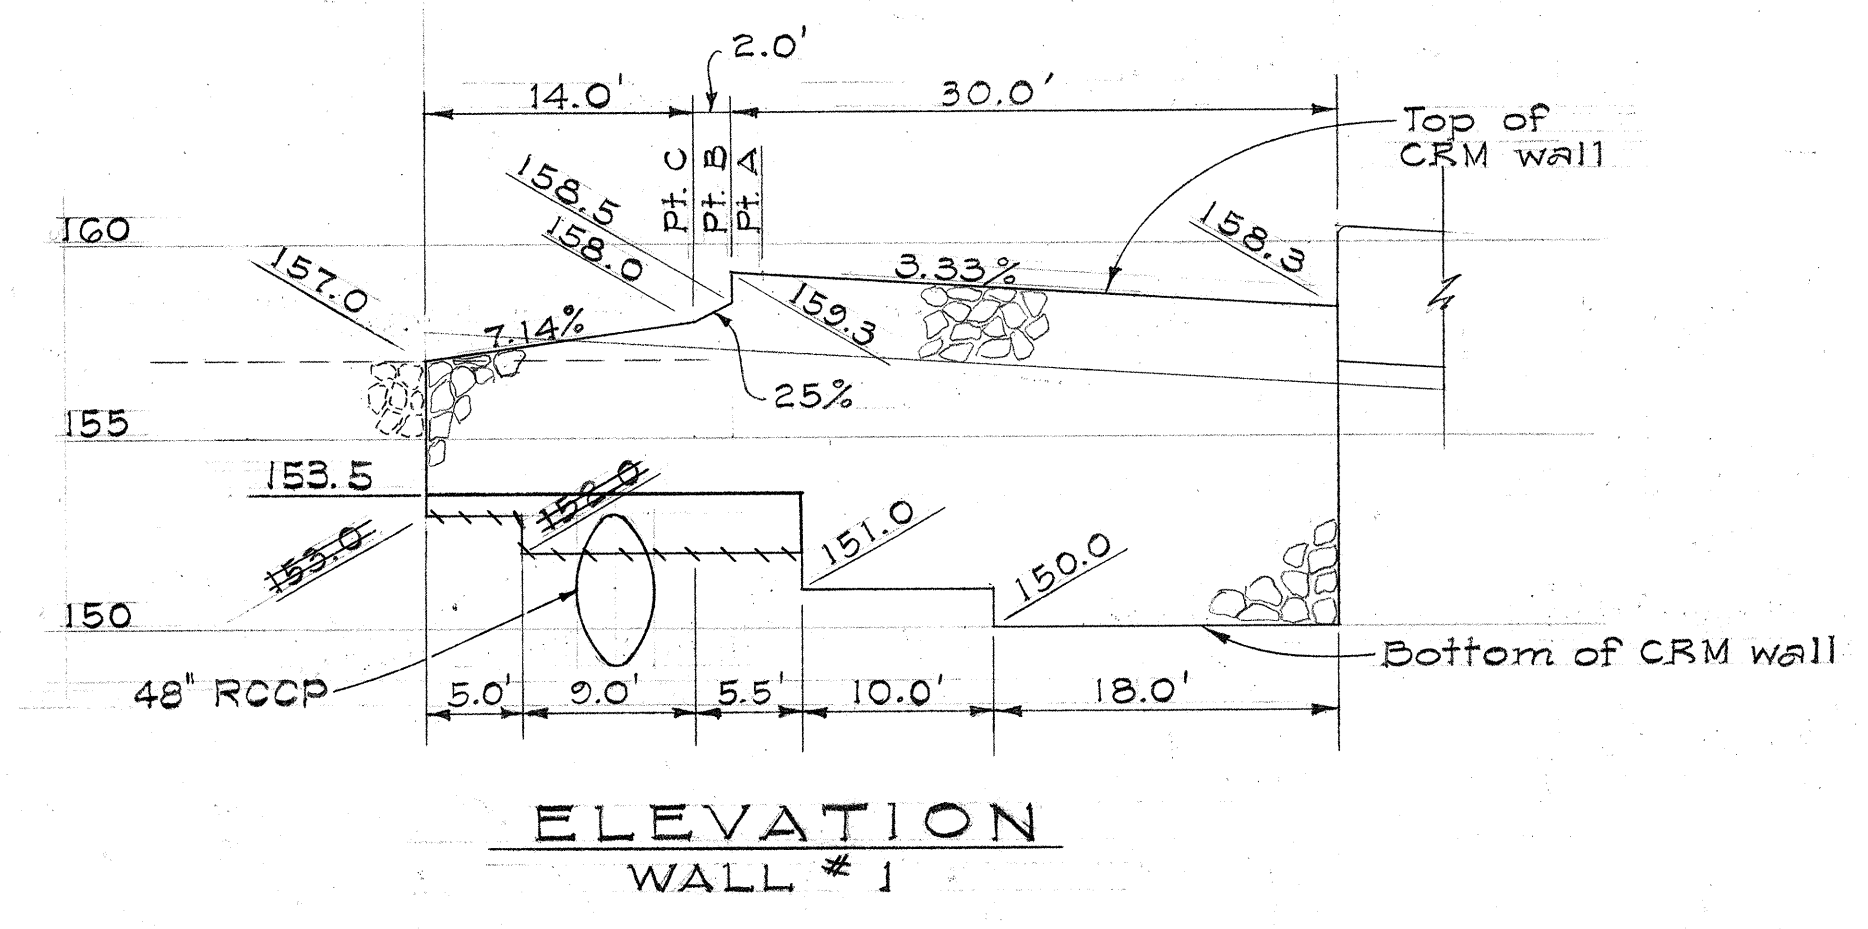

N. I. C. CRM WALL ALONG RAMP (KI-A)

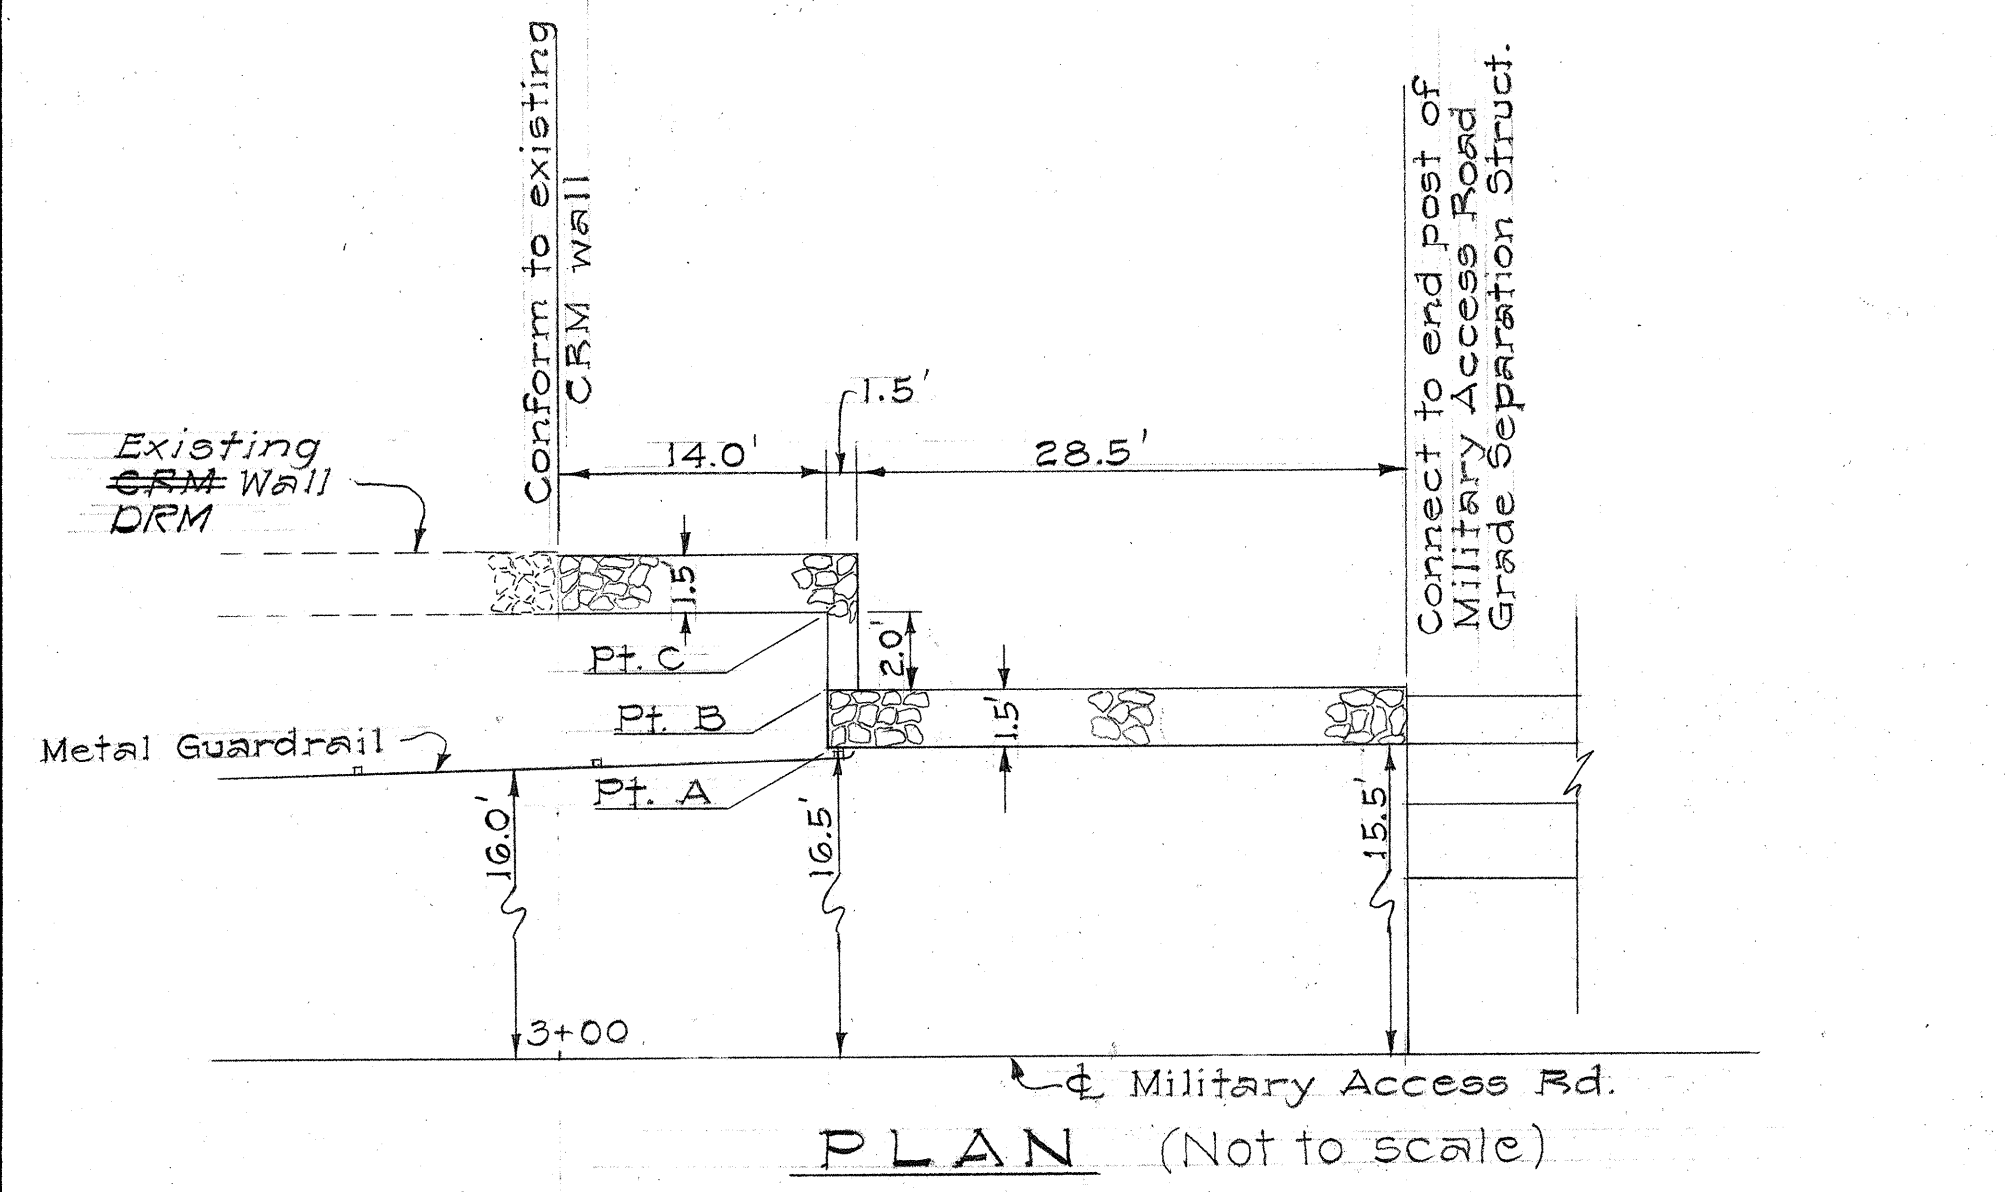

CRM WALLS ALONG MILITARY ACCESS ROAD Scale: Horiz. 1" = 10' Vert. 1" = 5'

STATE OF HAWAII
DEPARTMENT OF TRANSPORTATION
HIGHWAYS DIVISION

MISC. ROADWAY DETAILS

INTERSTATE ROUTE H-1
F.A.I. Proj. No. I-HI-1(32):5, Unit 1

Scale: As Noted Date: Sept. 1966

SHEET No. OF SHEETS